



Northern Charm
Boxwood does not
tolerate salt well. Use
caution along Old
Shakopee Road
where salt spay
would occur.

IRRIGATION NOTES:

- 1. ENTIRE SITE SHALL BE FULLY IRRIGATED. THE CONTRACTOR SHALL SUBMIT IRRIGATION SHOP DRAWINGS FOR REVIEW AND APPROVAL BY THE LANDSCAPE ARCHITECT PRIOR TO INSTALLATION.
- 2. SEE MECHANICAL AND ELECTRICAL PLANS AND SPECIFICATIONS FOR IRRIGATION WATER, METER, AND POWER CONNECTIONS.
- 3. CONTRACTOR TO VERIFY LOCATION OF ALL UNDERGROUND/ABOVE GROUND FACILITIES PRIOR TO ANY EXCAVATION/INSTALLATION. ANY DAMAGE TO UNDERGROUND/ABOVE GROUND FACILITIES SHALL BE THE RESPONSIBILITY OF THE CONTRACTOR AND COSTS ASSOCIATED WITH CORRECTING DAMAGES SHALL BE BORNE ENTIRELY BY THE CONTRACTOR.
- 4. SERVICE EQUIPMENT AND INSTALLATION SHALL BE PER LOCAL UTILITY COMPANY STANDARDS AND SHALL BE PER NATIONAL AND LOCAL CODES. EXACT LOCATION OF SERVICE EQUIPMENT SHALL BE COORDINATED WITH THE LANDSCAPE ARCHITECT OR EQUIVALENT AT THE JOB SITE.
- 5. CONTRACTOR SHALL COORDINATE WITH LOCAL UTILITY COMPANY FOR THE PROPOSED ELECTRICAL SERVICE AND METERING FACILITIES.
- 6. IRRIGATION WATER LINE CONNECTION SIZE IS 1-½" AT BUILDING. VERIFY WITH MECHANICAL PLANS.COVAGE.
- 7. ALL MAIN LINES SHALL BE 18" BELOW FINISHED GRADE.
- 8. ALL LATERAL LINES SHALL BE 12" BELLOW FINISHED GRADE.
- 9. ALL EXPOSED PVC RISERS, IF ANY, SHALL BE GRAY IN COLOR.
- 10. CONTRACTOR SHALL LAY ALL SLEEVES AND CONDUIT AT 2'-0" BELOW THE FINISHED GRADE OF THE TOP OF PAVEMENT. EXTEND SLEEVES TO 2'-0" BEYOND PAVEMENT.
- 11. CONTRACTOR SHALL MARK THE LOCATION OF ALL SLEEVES AND CONDUIT WITH THE SLEEVING MATERIAL "ELLED" TO 2'-0" ABOVE FINISHED GRADE AND CAPPED.
- 12. FABRICATE ALL PIPE TO MANUFACTURE'S SPECIFICATIONS WITH CLEAN AND SQUARE CUT JOINTS. USE QUALITY GRADE PRIMER AND SOLVENT CEMENT FORMULATED FOR INTENDED TYPE OF CONNECTION.
- 13. BACKFILL ALL TRENCHES WITH SOIL FREE OF SHARP OBJECTS AND DEBRIS.
- 14. ALL VALVE BOXES AND COVERS SHALL BE BLACK IN COLOR.
- 15. GROUP VALVE BOXES TOGETHER FOR EASE WHEN SERVICE IS REQUIRED. LOCATE IN PLANT BED AREAS WHENEVER POSSIBLE.
- 16. IRRIGATION CONTROLLER LOCATION SHALL BE VERIFIED ON-SITE WITH OWNER'S REPRESENTATIVE.
- 17. CONTROL WIRES: 14 GAUGE DIRECT BURIAL, SOLID COPPER IRRIGATION WIRE. RUN UNDER MAIN LINE. USE MOISTURE-PROOF SPLICES AND SPLICE ONLY AT VALVES OR PULL BOXES. RUN SEPARATE HOT AND COMMON WIRE TO EACH VALVE AND ONE (1) SPARE WIRE AND GROUND TO FURTHEST VALVE FROM CONTROLLER. LABEL OR COLOR CODE ALL WIRES.
- 18. AVOID OVER SPRAY ON BUILDINGS, PAVEMENT, WALLS AND ROADWAYS BY INDIVIDUALLY ADJUSTING RADIUS OR ARC ON SPRINKLER HEADS AND FLOW CONTROL ON AUTOMATIC VALVE.
- 19. ADJUST PRESSURE REGULATING VALVES FOR OPTIMUM PRESSURE ON SITE.
- 20. USE SCREENS ON ALL HEADS.
- 21. A SET OF AS-BUILT DRAWINGS SHALL BE MAINTAINED ON-SITE AT ALL TIMES IN AN UPDATED CONDITION.
- 22. ALL PIPE 3" AND OVER SHALL HAVE THRUST BLOCKING AT EACH TURN.
- 23. ALL AUTOMATIC REMOTE CONTROL VALVES WILL HAVE 3" MINIMUM DEPTH OF 3/4" WASHED GRAVEL UNDERNEATH VALVE AND VALVE BOX. GRAVEL SHALL EXTENT 3" BEYOND PERIMETER OF VALVE BOX.
- 24. THERE SHALL BE 3" MINIMUM SPACE BETWEEN BOTTOM OF VALVE BOX COVER AND TOP OF VALVE STRUCTURE.

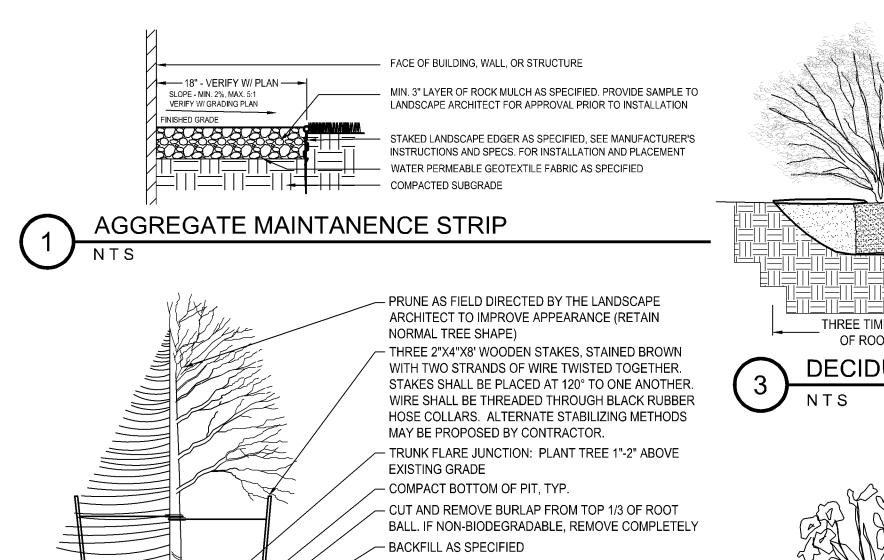

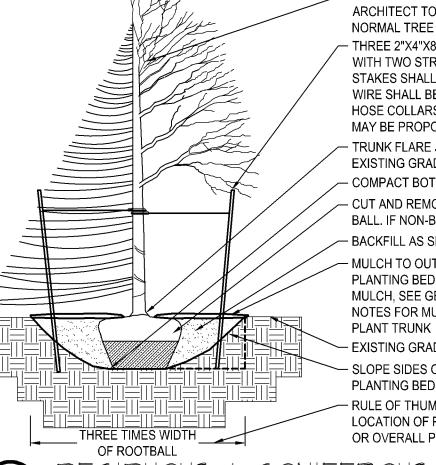

- MULCH TO OUTER EDGE OF SAUCER OR TO EDGE OF PLANTING BED, IF APPLICABLE. ROCK OR ORGANIC MULCH, SEE GENERAL LANDSCAPE NOTES AND PLAN NOTES FOR MULCH TYPE. KEEP MULCH MIN. 2" FROM


- EXISTING GRADE

- SLOPE SIDES OF HOLE OR VERTICAL SIDES AT EDGE OF PLANTING BED

- RULE OF THUMB - MODIFY EXCAVATION BASED ON LOCATION OF PLANT MATERIAL AND DESIGN OF BEDS

OR OVERALL PLANT PLACEMENT

DECIDUOUS & CONIFEROUS TREE PLANTING

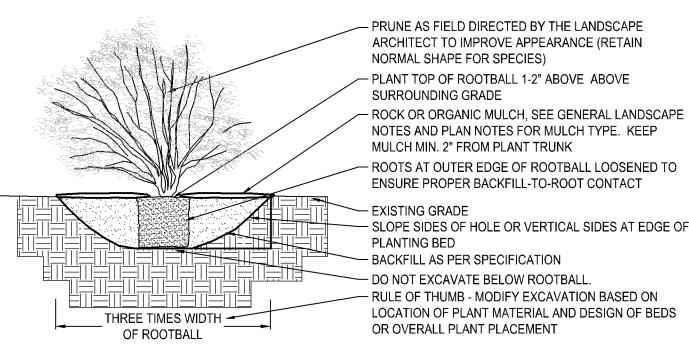

- PRUNE AS FIELD DIRECTED BY THE LANDSCAPE ARCHITECT TO IMPROVE APPEARANCE (RETAIN NORMAL SHAPE FOR SPECIES)


- PLANT TOP OF ROOTBALL 1-2" ABOVE ABOVE SURROUNDING GRADE

MULCH MIN. 2" FROM PLANT TRUNK ROOTS AT OUTER EDGE OF ROOTBALL LOOSENED TO ENSURE PROPER BACKFILL-TO-ROOT CONTACT

- SLOPE SIDES OF HOLE OR VERTICAL SIDES AT EDGE OF PLANTING BED - BACKFILL AS PER SPECIFICATION

- DO NOT EXCAVATE BELOW ROOTBALL. - RULE OF THUMB - MODIFY EXCAVATION BASED ON LOCATION OF PLANT MATERIAL AND DESIGN OF BEDS OR OVERALL PLANT PLACEMENT

DECIDUOUS & CONIFEROUS SHRUB PLANTING

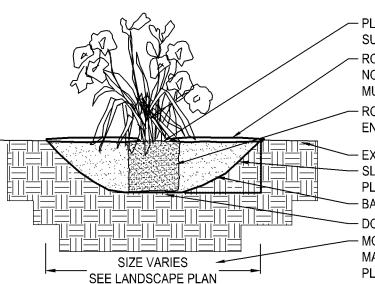

PLANT TOP OF ROOTBALL 1-2" ABOVE ABOVE SURROUNDING GRADE - ROCK OR ORGANIC MULCH, SEE GENERAL LANDSCAPE NOTES AND PLAN NOTES FOR MULCH TYPE. KEEP

MULCH MIN. 2" FROM PLANT STEM ROOTS AT OUTER EDGE OF ROOTBALL LOOSENED TO ENSURE PROPER BACKFILL-TO-ROOT CONTACT

- EXISTING GRADE - SLOPE SIDES OF HOLE OR VERTICAL SIDES AT EDGE OF

PLANTING BED - BACKFILL AS PER SPECIFICATION

DO NOT EXCAVATE BELOW ROOTBALL.

- MODIFY EXCAVATION BASED ON LOCATION OF PLANT MATERIAL AND DESIGN OF BEDS OR OVERALL PLANT PLACEMENT

PERENNIAL BED PLANTING



Matt Pavek Pat Sarve 763-213-3944 952-250-200

> ARCHITECTURE, INC 333 Washington Ave N, Suite 210 Minneapolis, Minnesota 55401 612,676,2700 www.djr-inc.com

0

Δ

Ω


I HEREBY CERTIFY THAT THIS PLAN. SPECIFICATION, OR REPORT WAS PREPARED BY ME OR UNDER MY DIRECT SUPERVISION AND THAT I AM A DULY LICENSED LANDSCAPE ARCHITECT UNDER THE LAWS OF THE STATE OF MINNESOTA.

DATE 10/26/16 LICENSE NO. 24904

ISSUE/SUBMITTAL SUMMARY DATE DESCRIPTION 10/26/16 CITY SUBMITTAL

REVISION SUMMARY DATE DESCRIPTION

LANDSCAPE DETAILS & NOTES

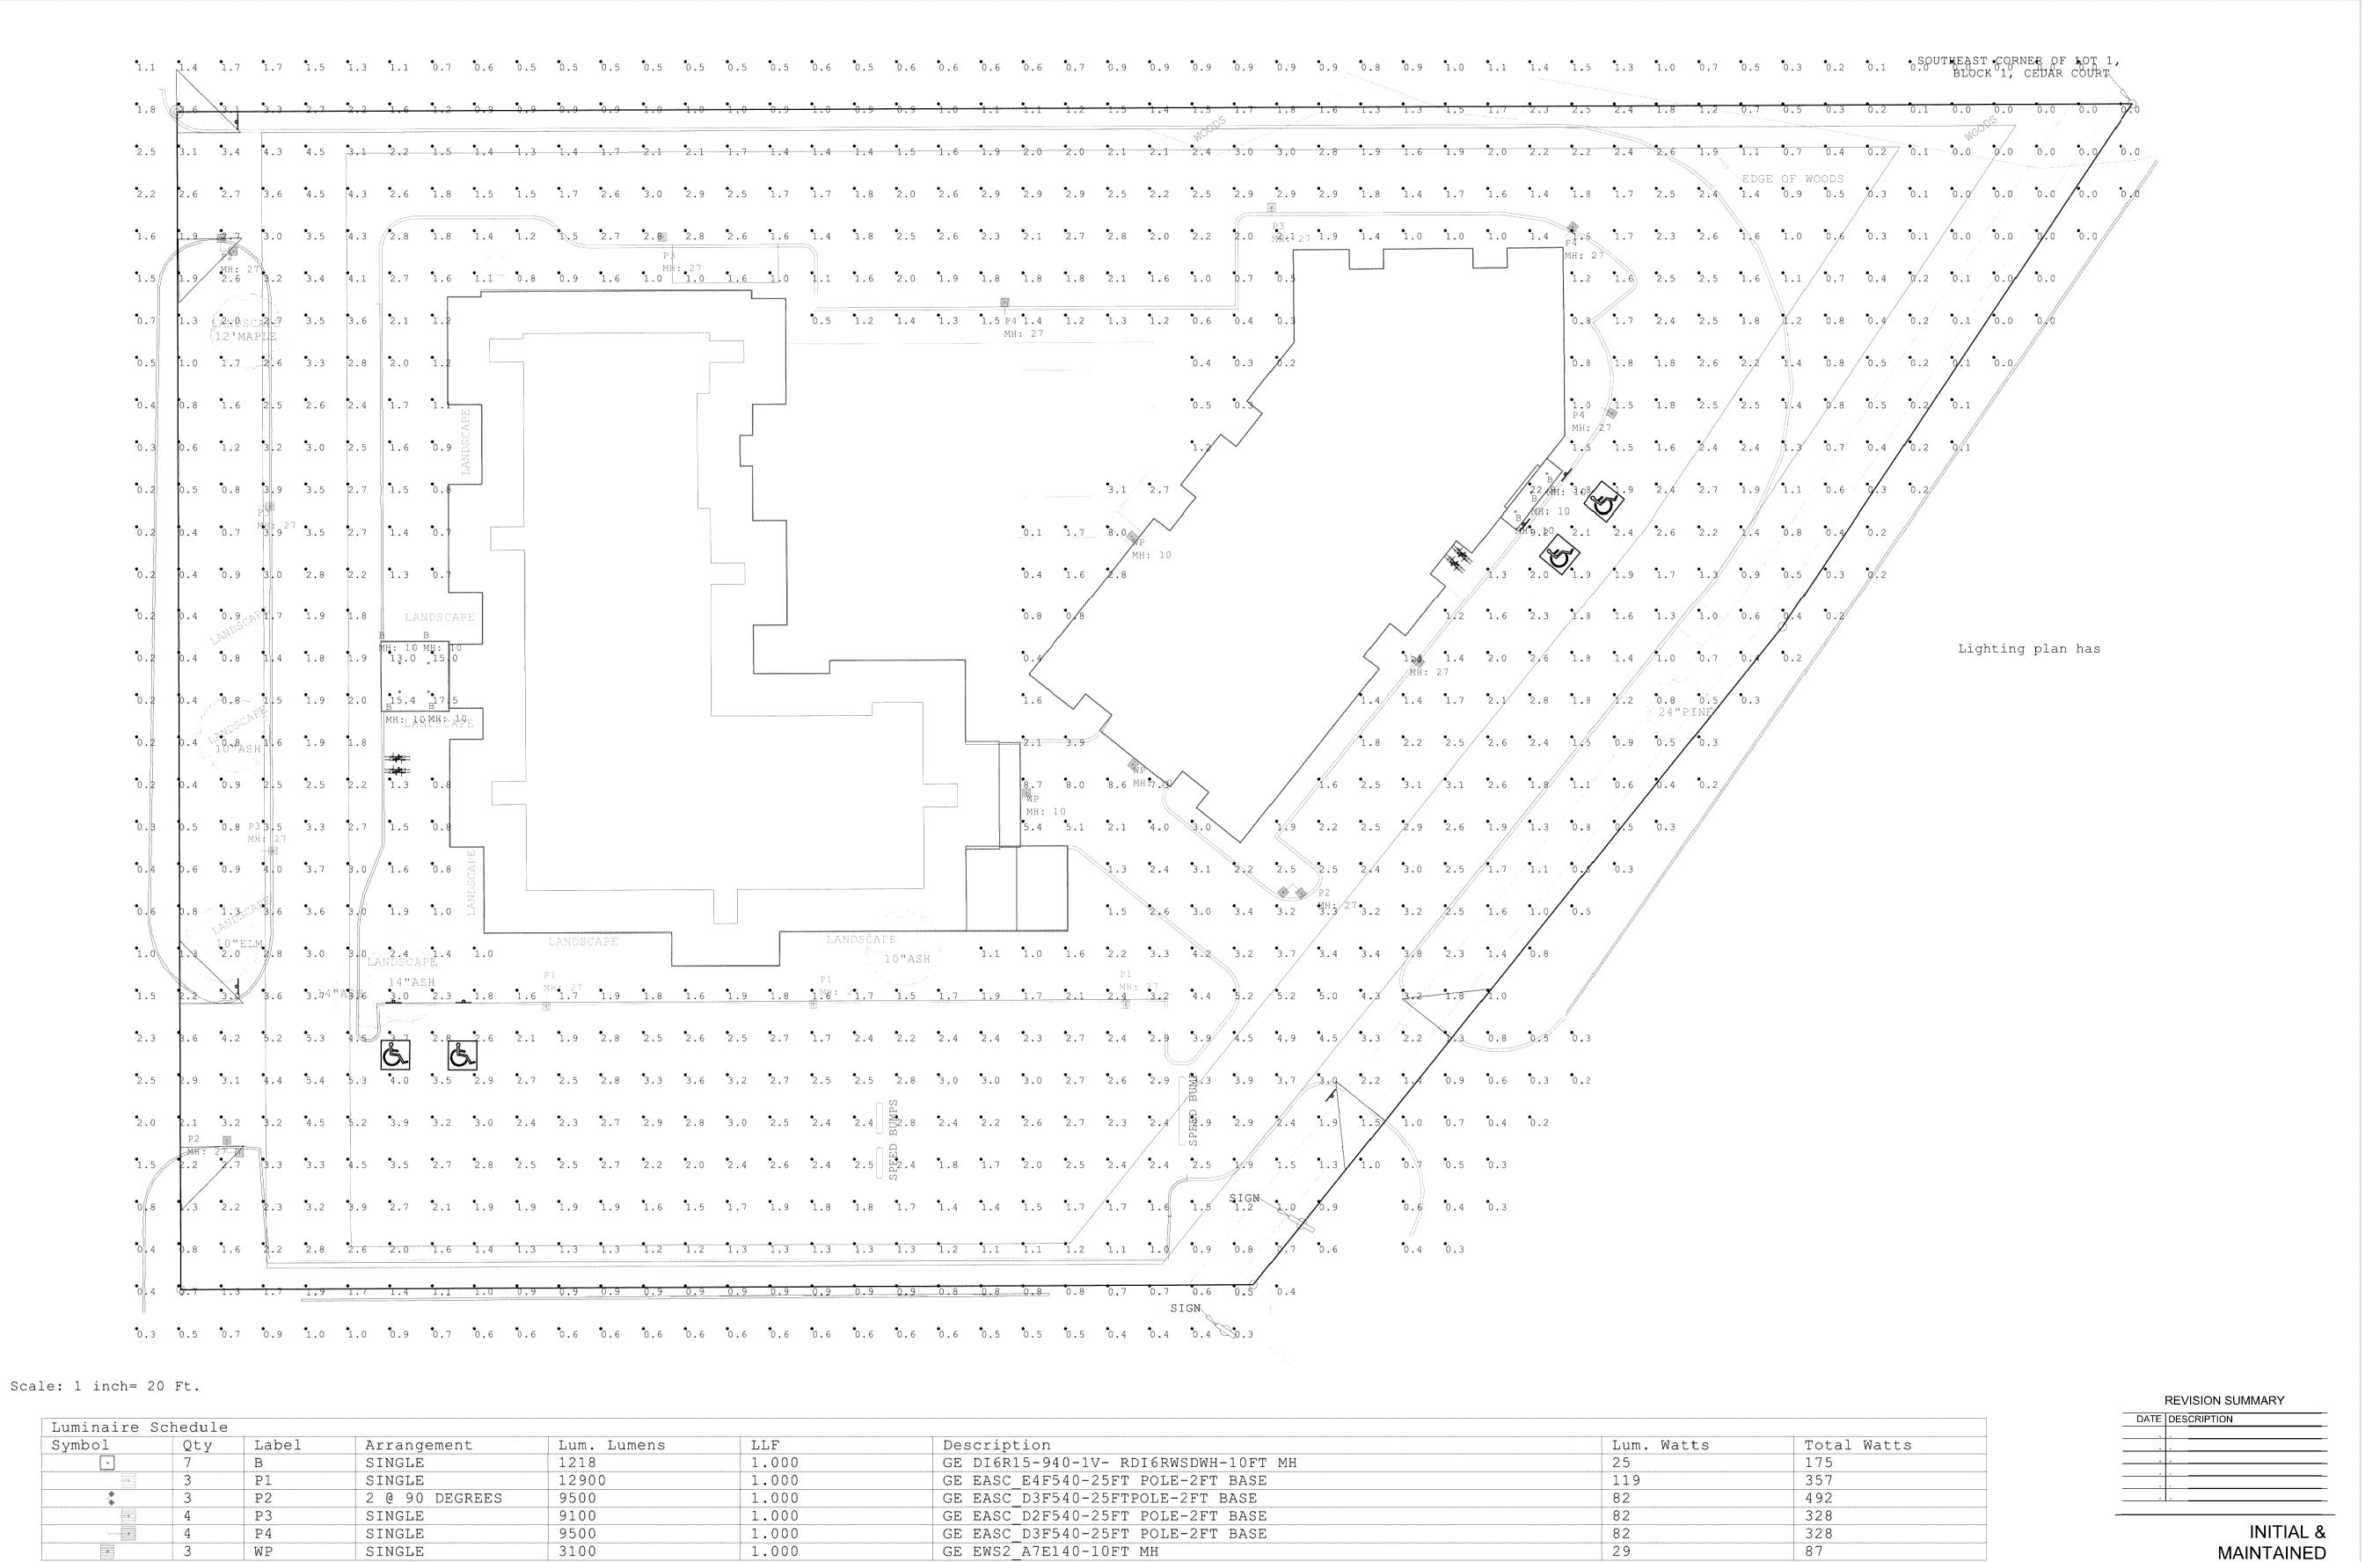

LPD Area Summary

Label

SITE

Calculation Summary							
Label	CalcType	Units	Avg	Max	Min	Avg/Min	Max/Min
SITE	Illuminance	Fc	1.83	22.9	0.0	N.A.	N.A.
East Lot	Illuminance	Fc	2.16	3.8	1.3	1.66	2.92
North lot	Illuminance	Fc	2.12	3.0	1.0	2.12	3.00
South lot	Illuminance	Fc	2.40	5.3	1.0	2.40	5.30

Area Total Watts LPD
101014 1767 0.017

These drawings are for conceptual use only and are not intended for construction. Values represented are an approximation generated from manufacturers photometric inhouse or independent lab tests with data supplied by lamp manufacturers.

Architect changes

Architect changes

Luma Sales Associates

Lighting and Controls

Drawn By: Kathy Frey

Date:10/19/2016

Sales Agent: Steve Hahn

Scale: 1" = 20'

2 8

Revisions

9101 Old Cedar Ave S Bloomington MN

LIGHTING PLAN

LS952-2321-3-Intia

