

# GATE 10 VESTIBULE ADDITION

# BLOOMINGTON, MN

# 7801 COMPUTER AVENUE SOUTH

## PROJECT TEAM

### OWNER

SEAGATE TECHNOLOGY
1801 COMPUTER AVENUE SOUTH
BLOOMINGTON, MN 55435

### RCHITECT

REPRISE DESIGN, INC. 12400 PORTLAND AVENUE SOUTH SUITE 100 BURNSVILLE, MN 55337

# CONTACT: JOHN NIGHTINGALE (952) 562-3736

MECHANICAL ENGINEER
SEAGATE TECHNOLOGY
1801 COMPUTER AVENUE SOUTH
BLOOMINGTON, MN 55435

#### ELECTRICAL ENGINEER SEAGATE TECHNOLOGY 1801 COMPUTER AVENUE SOUTH

BLOOMINGTON, MN 55435

STRUCTURAL ENGINEER

VOIGT AND ASSOCIATES, INC
4635 NICOLS ROAD, SUITE 204

EAGAN, MINNESOTA 55122

CONTACT: PAUL VOIGT

EMAIL: engineering evoigtandassociates.com
(651) 686-7727

# CODE SUMMARY

## PROJECT DESCRIPTION: VESTIBULE ADDITION

PROPOSED USE: ACCESSORY

APPLICABLE GOVERNING STANDARDS:
INTERNATIONAL BUILDING CODE (IBC), 2015 EDITION
MINNESOTA STATE BUILDING CODE (MSBC), 2015 EDITION
(NOTE: ALL REFERENCES ARE IBC UNLESS NOTED OTHERWISE)

OCCUPANCY CLASSIFICATION: GROUP "B" - ACCESSORY

### TYPE OF CONSTRUCTION: TYPE II-B

AREA OF WORK: 64 SF (NON-SPRINKLED)
(MN RULES CHAPTER 1306 SUB P.2 ITEM B)

### EXISTING BUILDING IS SPRINKLED

EXIT DOORS


ALLOWABLE BUILDING HEIGHT: EXISTING - N/A

ALLOWABLE BUILDING AREA: EXISTING - N/A

THE EXISTING EXIT DOOR WIDTH IS MAINTAINED WITH THE NEW

PANIC HARDWARE ON NEW VESTIBULE DOORS

PROJECT LOCATION MAP

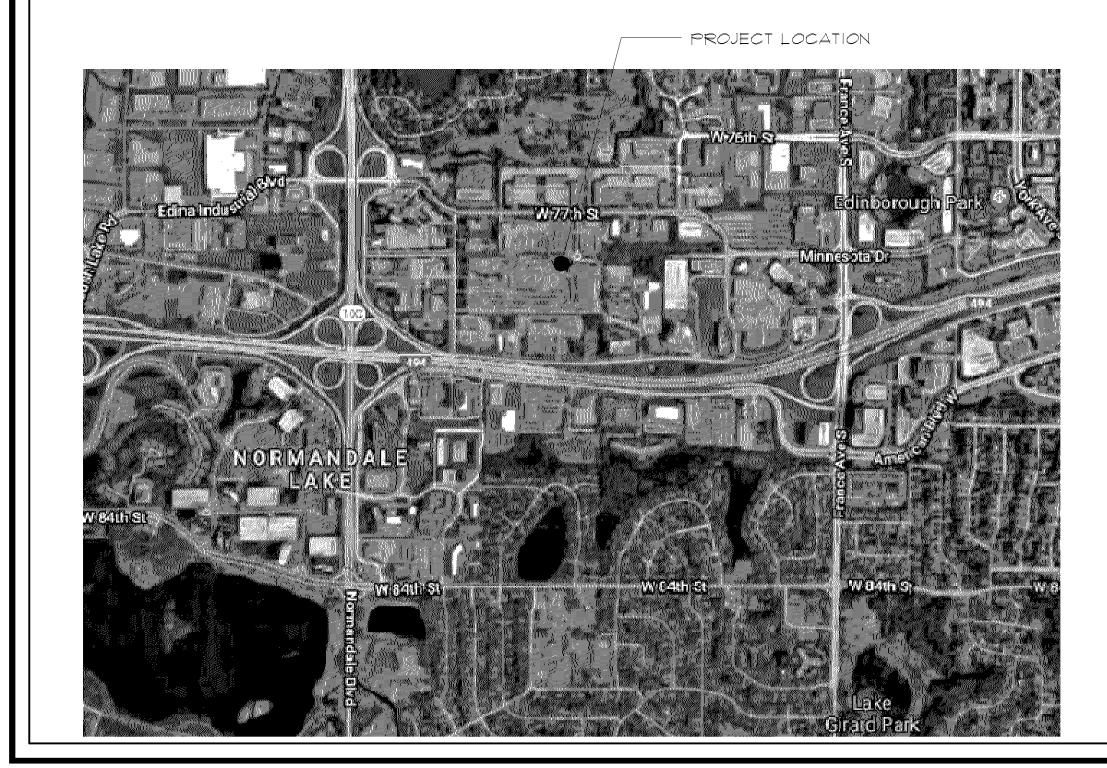

# DESCRIPTION NORTH NORTH ARROW **MANAGERS** - ROOM NAME OFFICE (120) -ROOM NUMBER SECTION REFERENCE ELEVATION REFERENCE DETAIL REFERENCE BUBBLE ELEVATION REFERENCE EXIST, ELEVATION REFERENCE PARTITION TYPE REFERENCE KEYNOTE REFERENCE WINDOW TYPE REFERENCE REVISION REFERENCE DOOR TAG


DRAFTING SYMBOLS


## GENERAL NOTES

I, THE CONTRACTOR SHALL REPORT ANY DISCREPANCIES IN THE DRAWINGS OR AT THE JOB SITE TO THE ARCHITECT IMMEDIATELY UPON DISCOVERY OF SUCH INCONSISTENCIES TO DETERMINE A COURSE OF ACTION TO CORRECT ANY CONFLICTS BETWEEN THE CONTRACT DOCUMENTS AND EXISTING CONDITIONS AND DETERMINE COST RESPONSIBILITIES.

- 2. DO NOT SCALE DRAWING.
- 3. SUBMIT ALL COLOR SAMPLES TO OWNER FOR APPROVAL PRIOR TO CONSTRUCTION, ALLOW AMPLE TIME FOR SELECTIONS AND APPROVALS.
- 4. THE CONTRACTOR SHALL BE RESPONSIBLE FOR THE COMPLETE SECURITY OF THE SITE WHILE THE JOB IS IN PROGRESS 4 UNTIL THE JOB IS COMPLETED.
- 5. ALL DEBRIS BY GENERAL CONTRACTOR & OWNER MATERIALS SHALL BE REMOVED FROM THE PREMISES
  BY THE GENERAL CONTRACTOR OR RESPONSIBLE CONTRACTOR & ALL AREAS SHALL BE LEFT IN A
  CLEAN (BROOM) CONDITION AT ALL TIMES.
- 6. CONTRACTOR SHALL TAKE ALL NECESSARY PRECAUTIONS TO ENSURE THE SAFETY OF THE OCCUPANTS & WORKERS AT ALL TIMES.
- 1. THE CONTRACTOR IS SOLELY RESPONSIBLE FOR ALL CONSTRUCTION MEANS AND SHALL MAINTAIN THE STRUCTURAL INTEGRITY OF ANY CONSTRUCTION UNTIL ALL FINISHED LOAD CARRYING SYSTEMS ARE
- 8. THE CONTRACTOR SHALL BE RESPONSIBLE FOR 4 SHALL REPLACE OR REMEDY ANY FAULTY, IMPROPER OR INFERIOR MATERIALS OR WORKMANSHIP OR ANY DAMAGE WHICH SHALL APPEAR WITHIN ONE (1) YEAR AFTER THE COMPLETION 4 ACCEPTANCE OF THE WORK UNDER THIS CONTRACT.
- 9. DESIGN-BUILD SUB-CONTRACTORS ARE TO VERIFY THAT ALL APPLICABLE WORK IS IN THEIR SCOPE OF WORK AND THERE-FOR IN THEIR PERSPECTIVE BID. IT IS THE RESPONSIBILITY OF THE DESIGN-BUILD SUB-CONTRACTOR TO COORDINATE THIS WITH OTHER SELECTED DESIGN-BUILD SUB-CONTRACTORS.

DRAV	VING INDEX
ARCHI	TECTURAL
G-001	COVER SHEET
A-100	FLOOR PLAN & DETAILS
A-200	EXTERIOR ELEVATIONS
A-300	WALL SECTIONS
STRUC	TURAL
<b>91</b>	PLANS
<del>\$</del> 2	DETAILS AND SECTIONS
<b>9</b> 3	GENERAL STRUCTURAL NOTES
MECHA	·
BY OT	HERS
ELECT	RICAL
BY OT	HERS

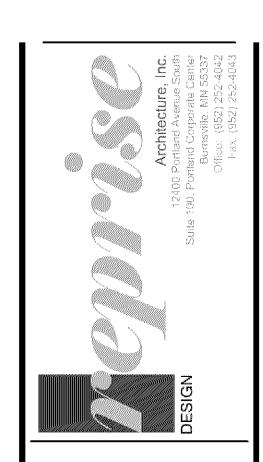

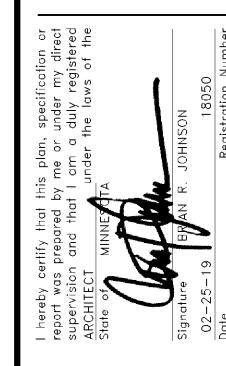

E TECHNOLOGY

GATE 10 VESTIBULI
7801 COMPUTER A
BLOOMINGTON, MN

E ISSUED


PERMIT SET 02/28/19

DRAWN BY


CHECKED BY

G-001


18252

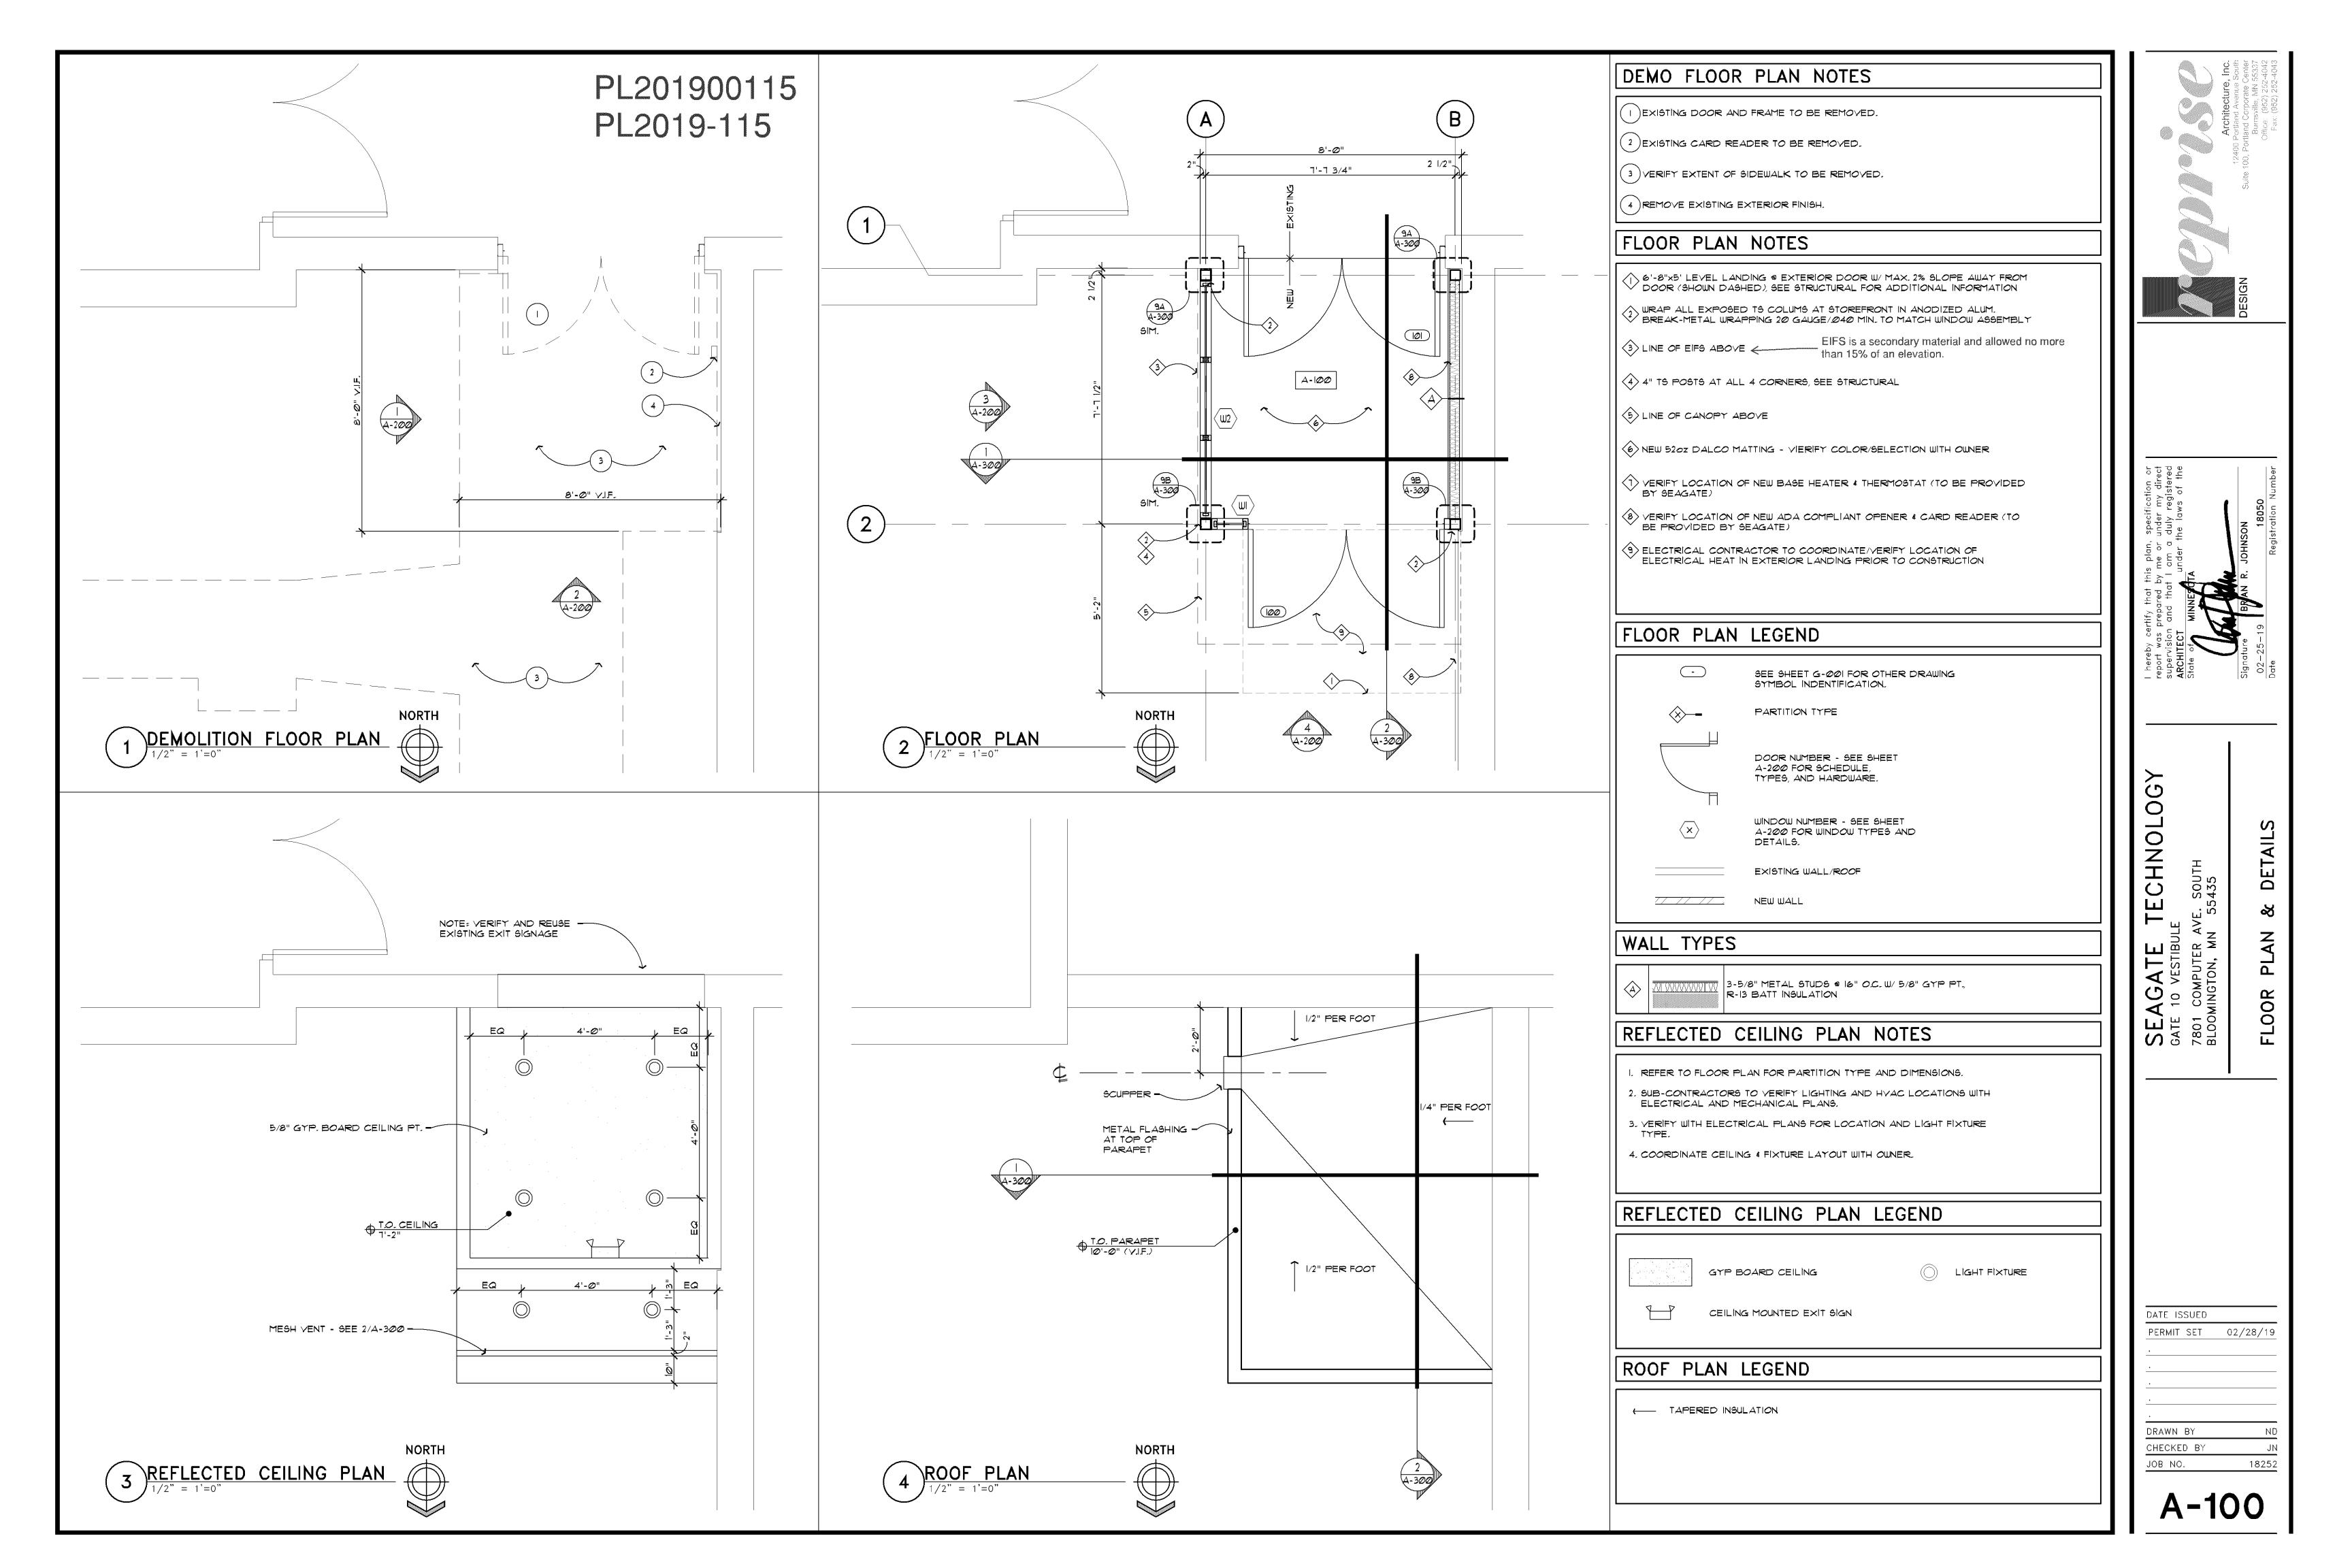


#### HARDWARE SCHEDULE DESCRIPTION CATALOG NUMBER GROUP DESCRIPTION CATALOG NUMBER HARDWARE SET I CONT. HINGE 00 EPT HARDWARE SET 2 CONT. HINGE POWER TRANSFER POWER TRANSFER C CYLINDER S REQUIRED CYLINDER 45 REQUIRED NOTES NOTES FUNCTION: LATCHBOLT ELEC PANIC FUNCTION: LATCHBOLT ELEC PANIC EL-24-V-E0 EL-24-V-E0 RETRACTED INSIDE BY RETRACTED INSIDE BY EXIT DEVICE PUSH PAD AND OUTSIDE BY HARDWARE HARDWARE EXIT DEVICE PUSH PAD AND OUTSIDE BY ELEC PANIC LEC PANIC EL-24-V-NL-0P EL-24-V-NL-*O*P KEY IN CYLINDER. KEY IN CYLINDER. DOOR LOCKS WHEN DOOR LOCKS WHEN HARDWARE KEY IS REMOVED AND DOOR IS CLOSED, THIS IARDWARE KEY IS REMOVED AND DOOR IS CLOSED, THIS NTERFACE BOX NTERFACE BOX DOOR HAS A POWER DOOR HAS A POWER OPERATOR, INTERIOR OPERATOR, INTERIOR 30 DEG OFFSET PULL 90 DEG OFFSET PULL ACTUATOR ALWAYS ACTUATOR ALWAYS ACTIVE TO UNLOCK ACTIVE TO UNLOCK DH STOP OH STOP AND OPEN THE DOOR. AND OPEN THE DOOR. A VALID CREDENTIAL A VALID CREDENTIAL SURFACE CLOSER SURFACE CLOSER 4050 TOP JAMB 4*0*50 TOP JAMB JILL UNLOCK THE JILL UNLOCK THE DOOR AND MAKE THE DOOR AND MAKE THE SURF. AUTO SURF. AUTO EXTERIOR ACTUATOR EXTERIOR ACTUATOR ACTIVE. OPERATOR PERATOR ACTUATOR, WALL ACTUATOR, WALL 8310-8<del>5</del>3 3310-853 BY SECURITY SUPPLIER CARD READER RAIN DRIP POWER SUPPLY PS914 900-2RS WEATHERSTRIP BY DR/FR SUPPLIER ELEVATION DRAWING DOOR SWEEP WIRE DIAGRAM POINT TO POINT HRESHOLD BY SECURITY SUPPLIER CARD READER POWER SUPPLY LEVATION DRAWING POINT TO POINT JIRE DIAGRAM

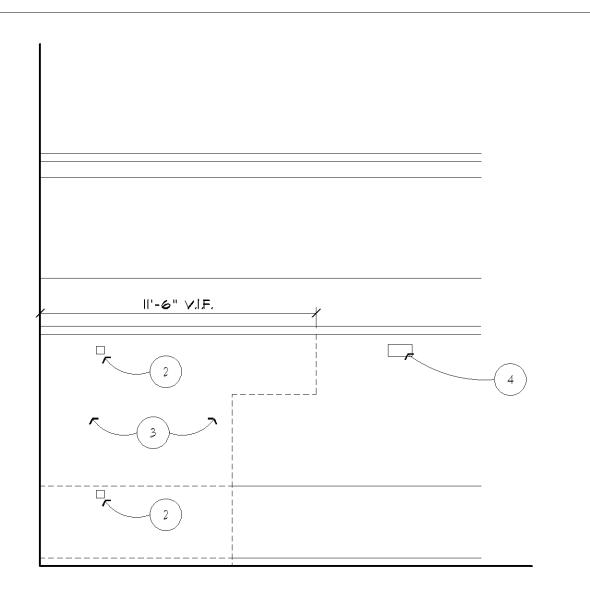




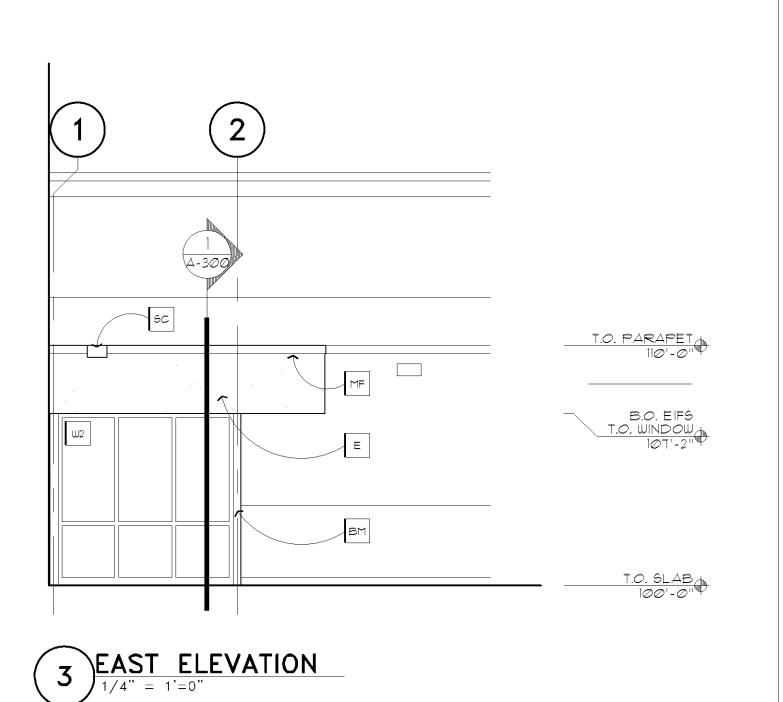

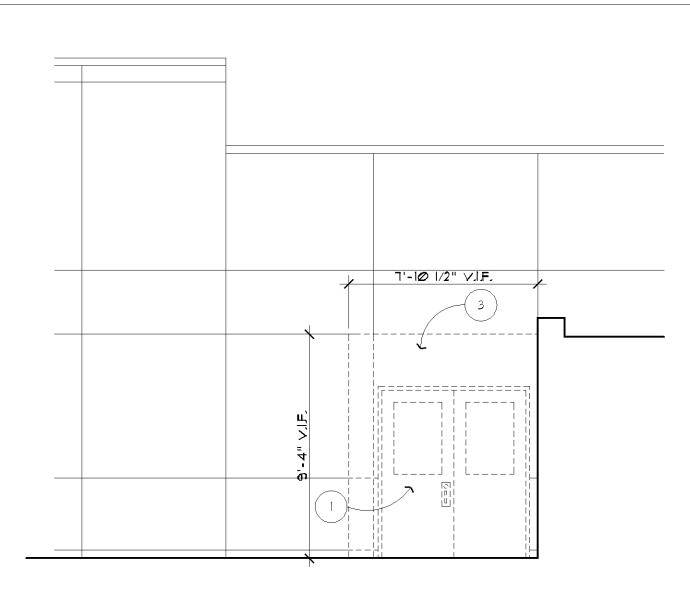

2 DEMOLITION NORTH ELEVATION

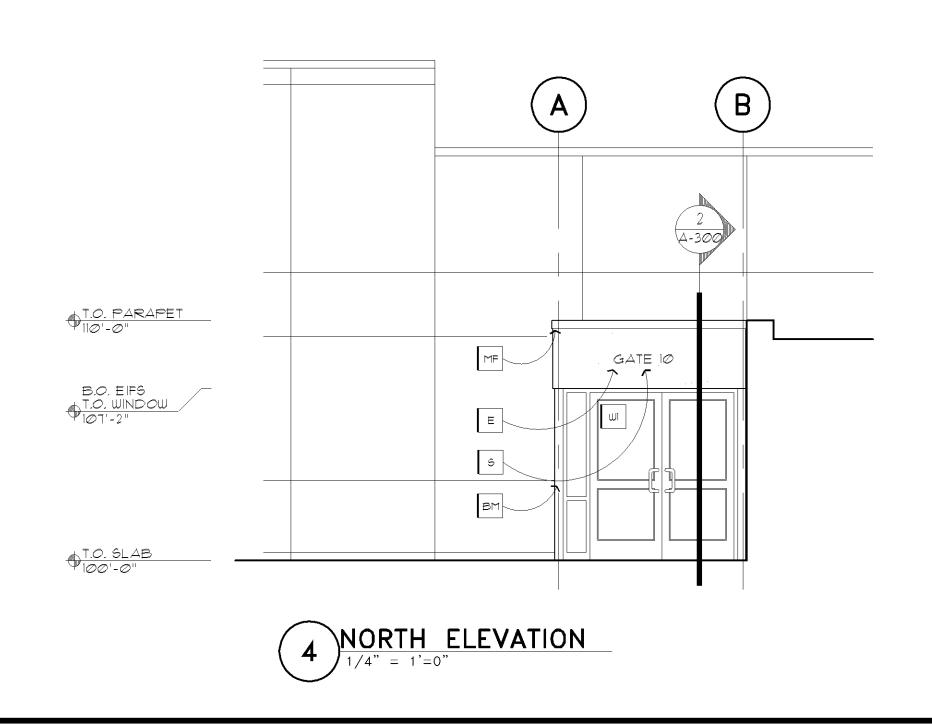

### DEMO KEY NOTES

- 1 REMOVE EXISTING DOOR AND FRAME.
- 2 REMOVE EXISTING ELECTRICAL U.N.O. lighting must be 90 degree cutoff and provide at least 2 FC.
- (3) REMOVE EXISTING EXTERIOR FINISH.
- 4 EXISTING LIGHT TO REMAIN


### KEY NOTES

- BM BRAKE METAL-TO MATCH ANOD, ALUMINUM STOREFRONT COLOR
- E EXTERIOR FINISH SYSTEM FINISH AND COLOR TO MATCH EXISTING EXTERIOR WALL FINISH
- MF METAL FASCIA COLOR TO MATCH EXISTING PARAPET CAP FLASHING
- SC SCUPPER PREFINISHED METAL TO MATCH EXISTING PARAPET CAP FLASHING COLOR
- S SIGNAGE TO BE PROVIDED BY SEAGATE

## DOOR SCHEDULE

DOOR NUMBER	DOOR SIZE	DOOR		FRAME		HARDWARE
		TYPE	ΕIN	TYPE	FIN	
100	6'-0"×1'-0"	Д	<u> </u>	W1	-	HARDWARE SET 2
101	6'-0"×7'-0"	Δ	ΗM	ALUM	-	HARDWARE SET 1


## DOOR AND FRAME TYPES

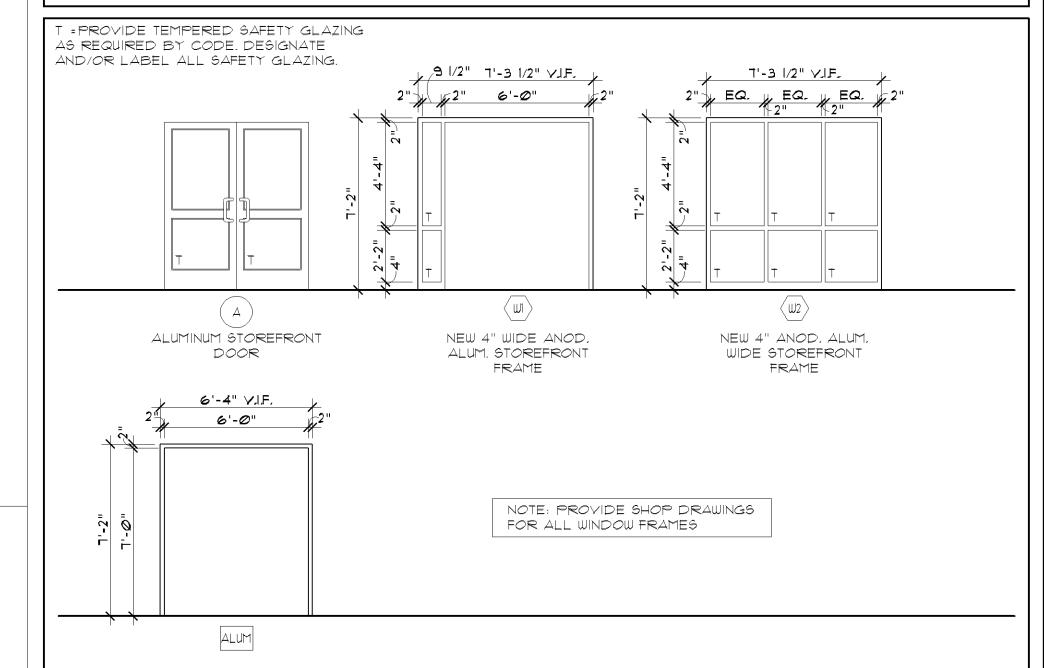


# ABBREVIATIONS, DOOR AND FRAME

AL	ALUMINUM	9C	SOLID CORE
HM	HOLLOW METAL	STL	STAINLESS STEEL
PΤ	PAINT	WD	WOOD

PL201900115 PL2019-115

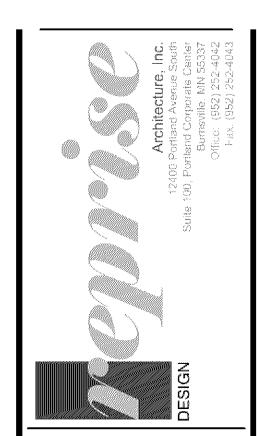

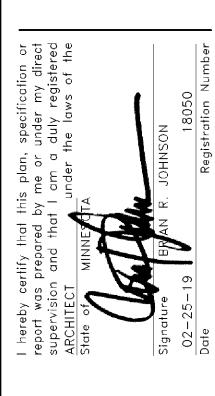

SEAGATE TECHNOL GATE 10 VESTIBULE 7801 COMPUTER AVE. SOUTH BLOOMINGTON, MN 55435

ELEVATIONS

EXTERIOR


DATE ISSUED


PERMIT SET 02/28/19

.
.

DRAWN BY
CHECKED BY
JOB NO. 182


A-200

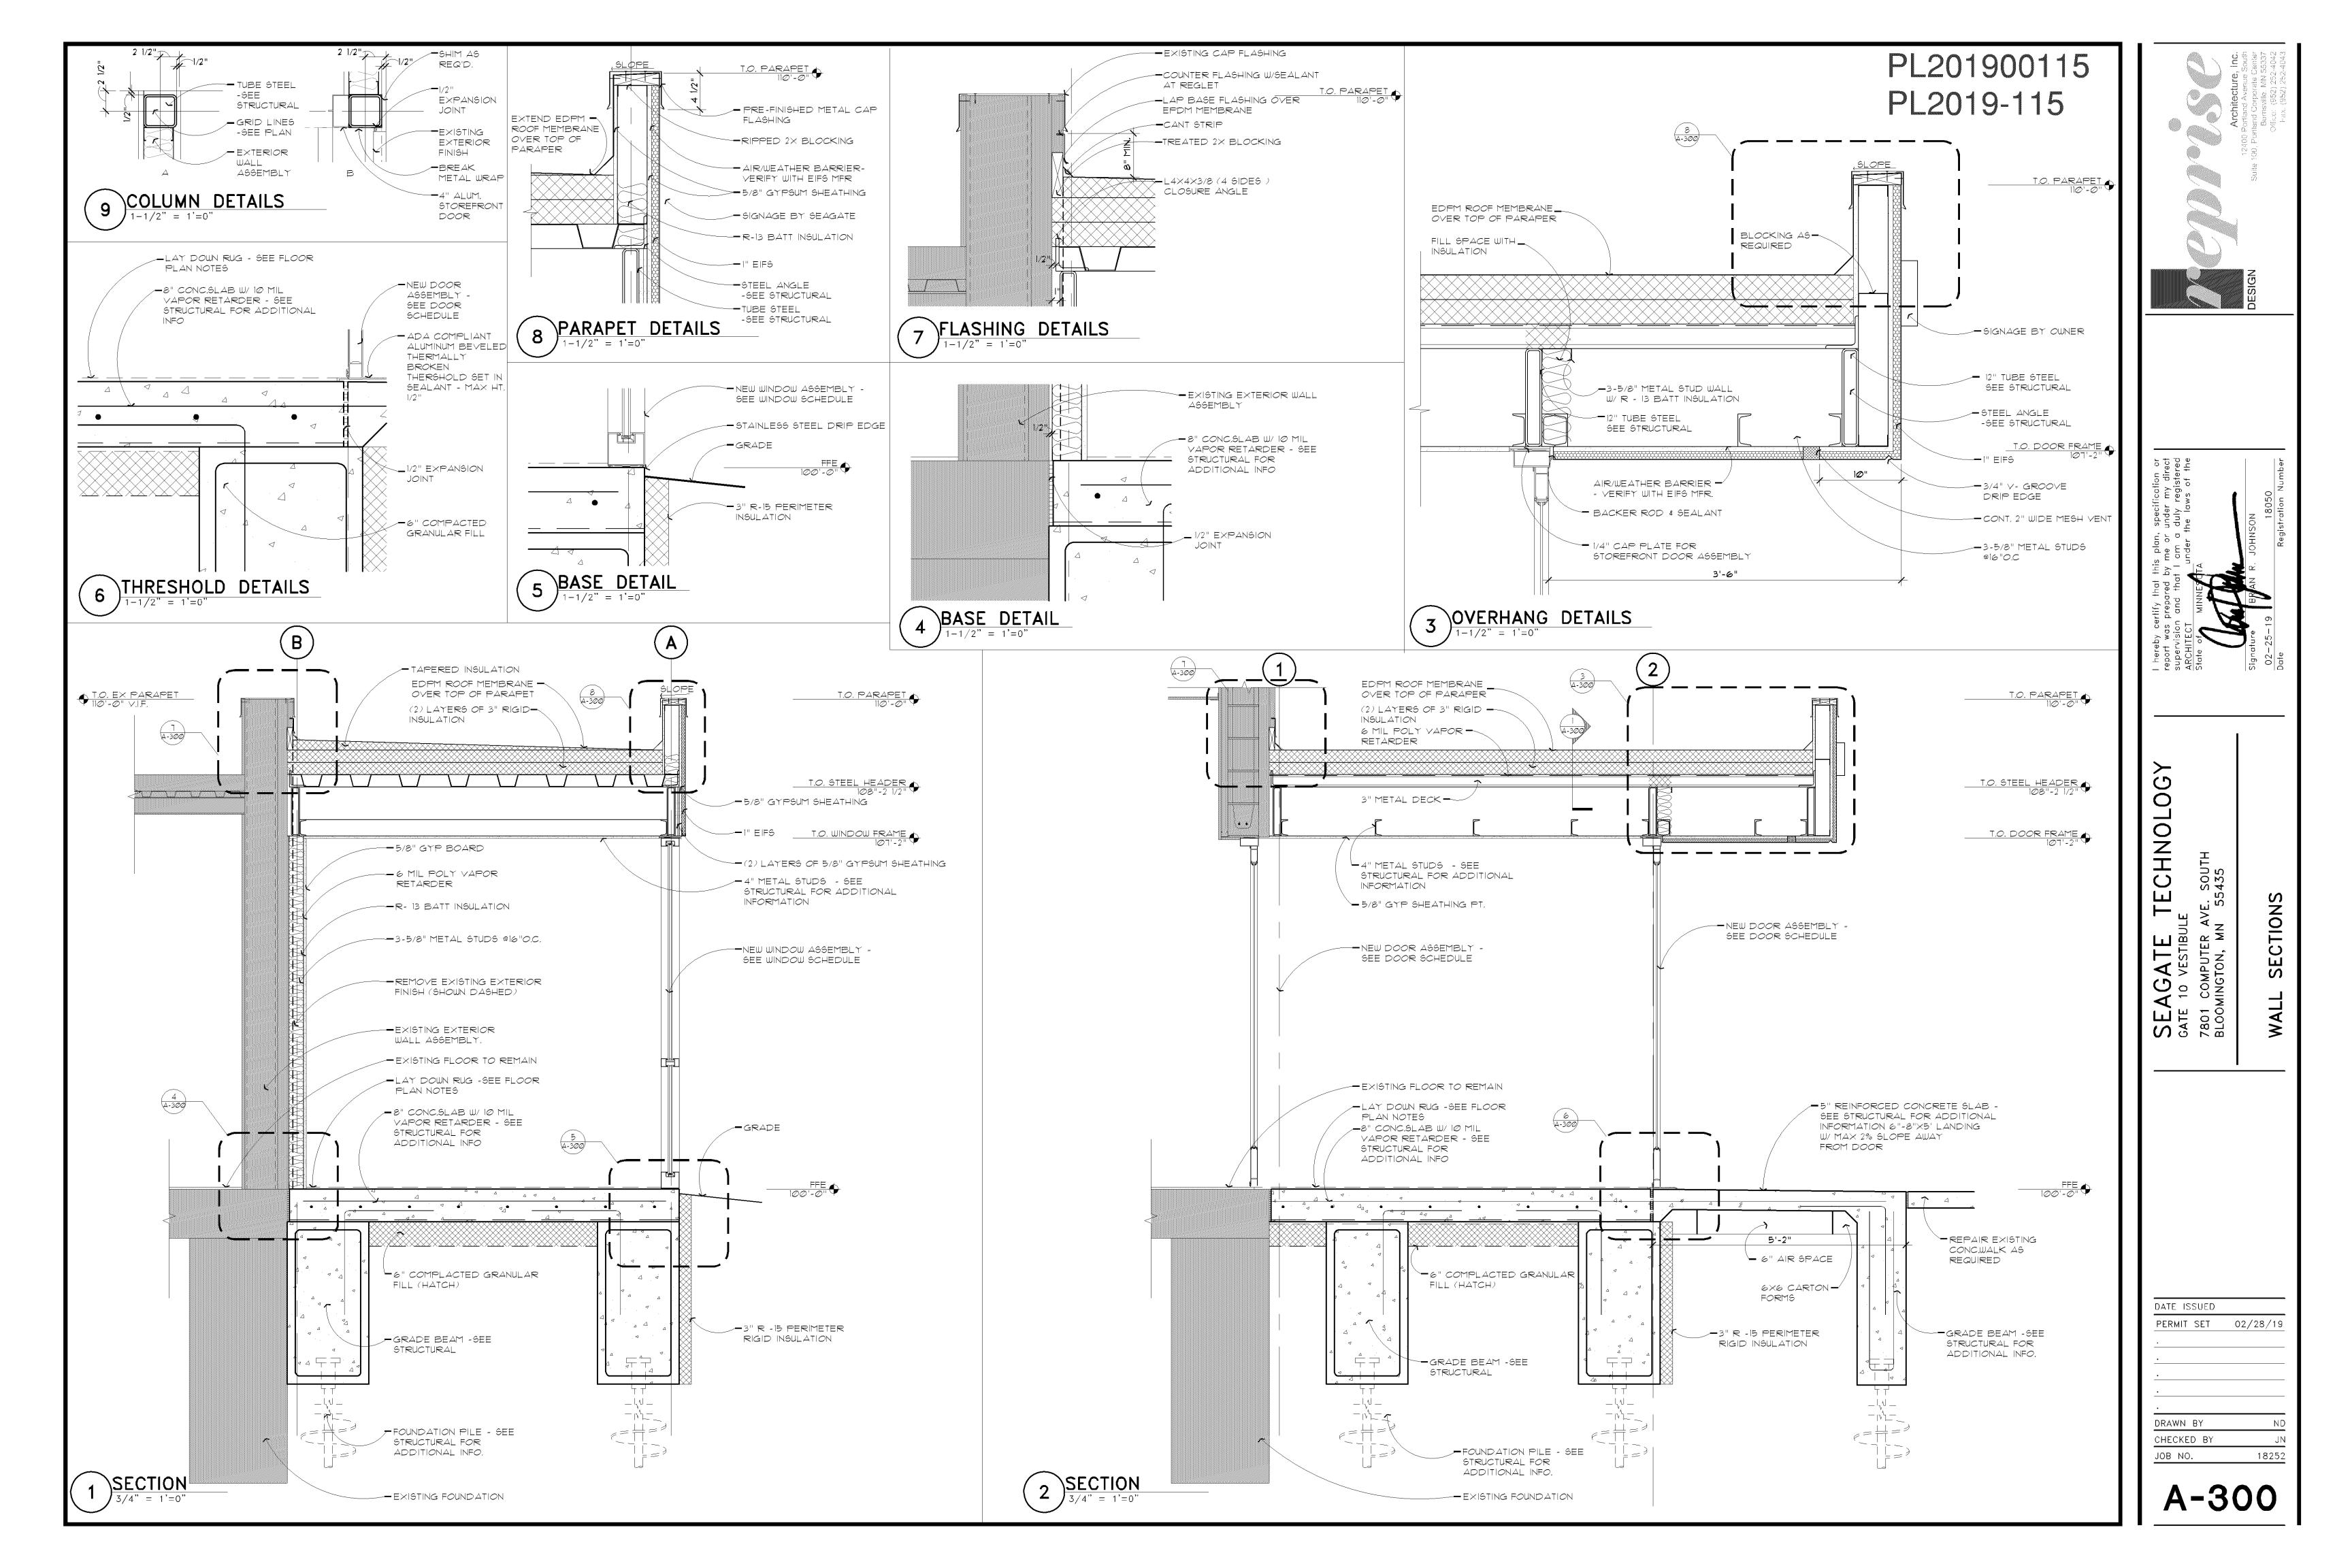

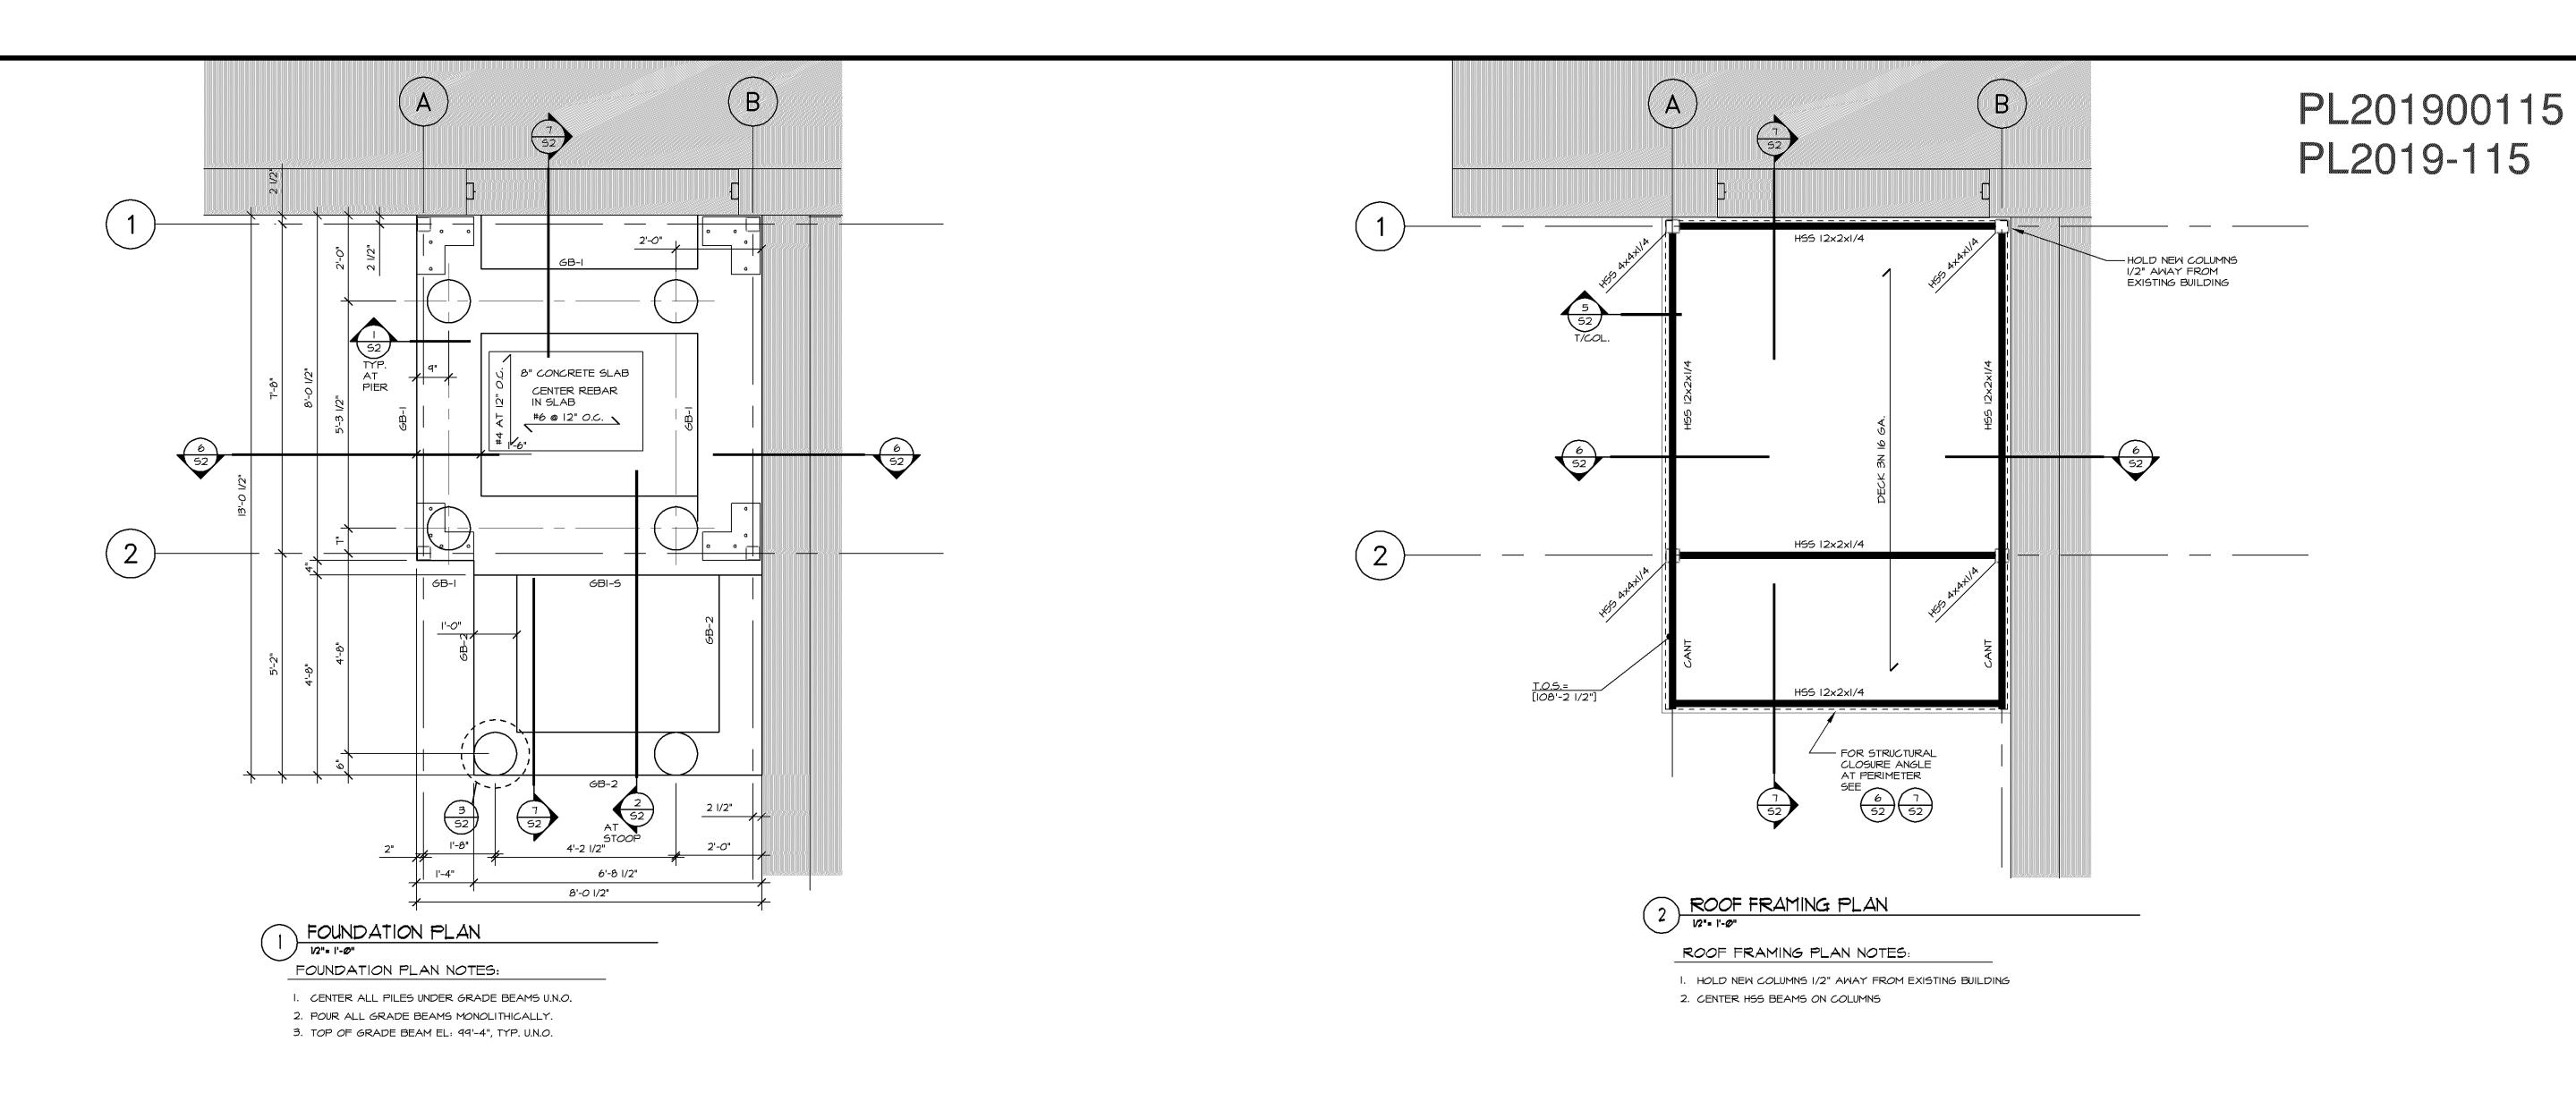


CONCRETE GRADE BEAM SCHEDULE							
BEAM	SIZE		REINFORCING		STIRRUPS (EACH SIDE OF BEAM, U.N.O.)		
MARK	М*	D	воттом	TOP	SIZE/TYPE *	SPACING (MAX)	
GB-I	18	42	(3) #6	(3) #6	#4 HOOP STIRRUPS	18" O.C.	
GBI-S AT STOOP	22	42	(3) #6	(3) #6	#4 HOOP STIRRUPS	18" O.C.	
<i>G</i> B-2	12	42	(3) #6	(3) #6	#4 HOOP STIRRUPS	18" O.C.	

SEE DETAIL 6/52 AND 7/52 FOR ADDITIONAL INFORMATION.
 DO NOT SPLICE LONGITUDINAL BARS.
 \* 3. PROVIDE (2) EXTRA STIRRUPS EA SIDE OF ALL HELICAL PIERS.

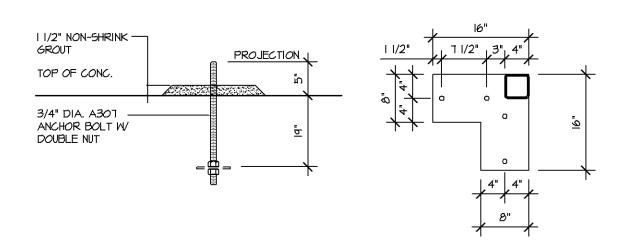

3 TYPICAL BASE PLATE AND ANCHOR BOLT DETAILS

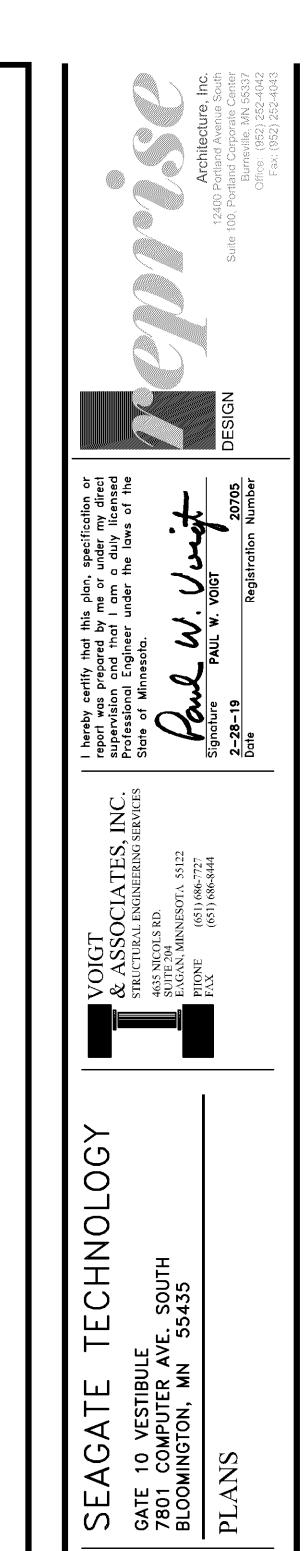

DATE ISSUED

2-28-19


MLH


PERMIT

DRAWN BY

CHECKED BY PWV/AWM

JOB NO. VA-19-011

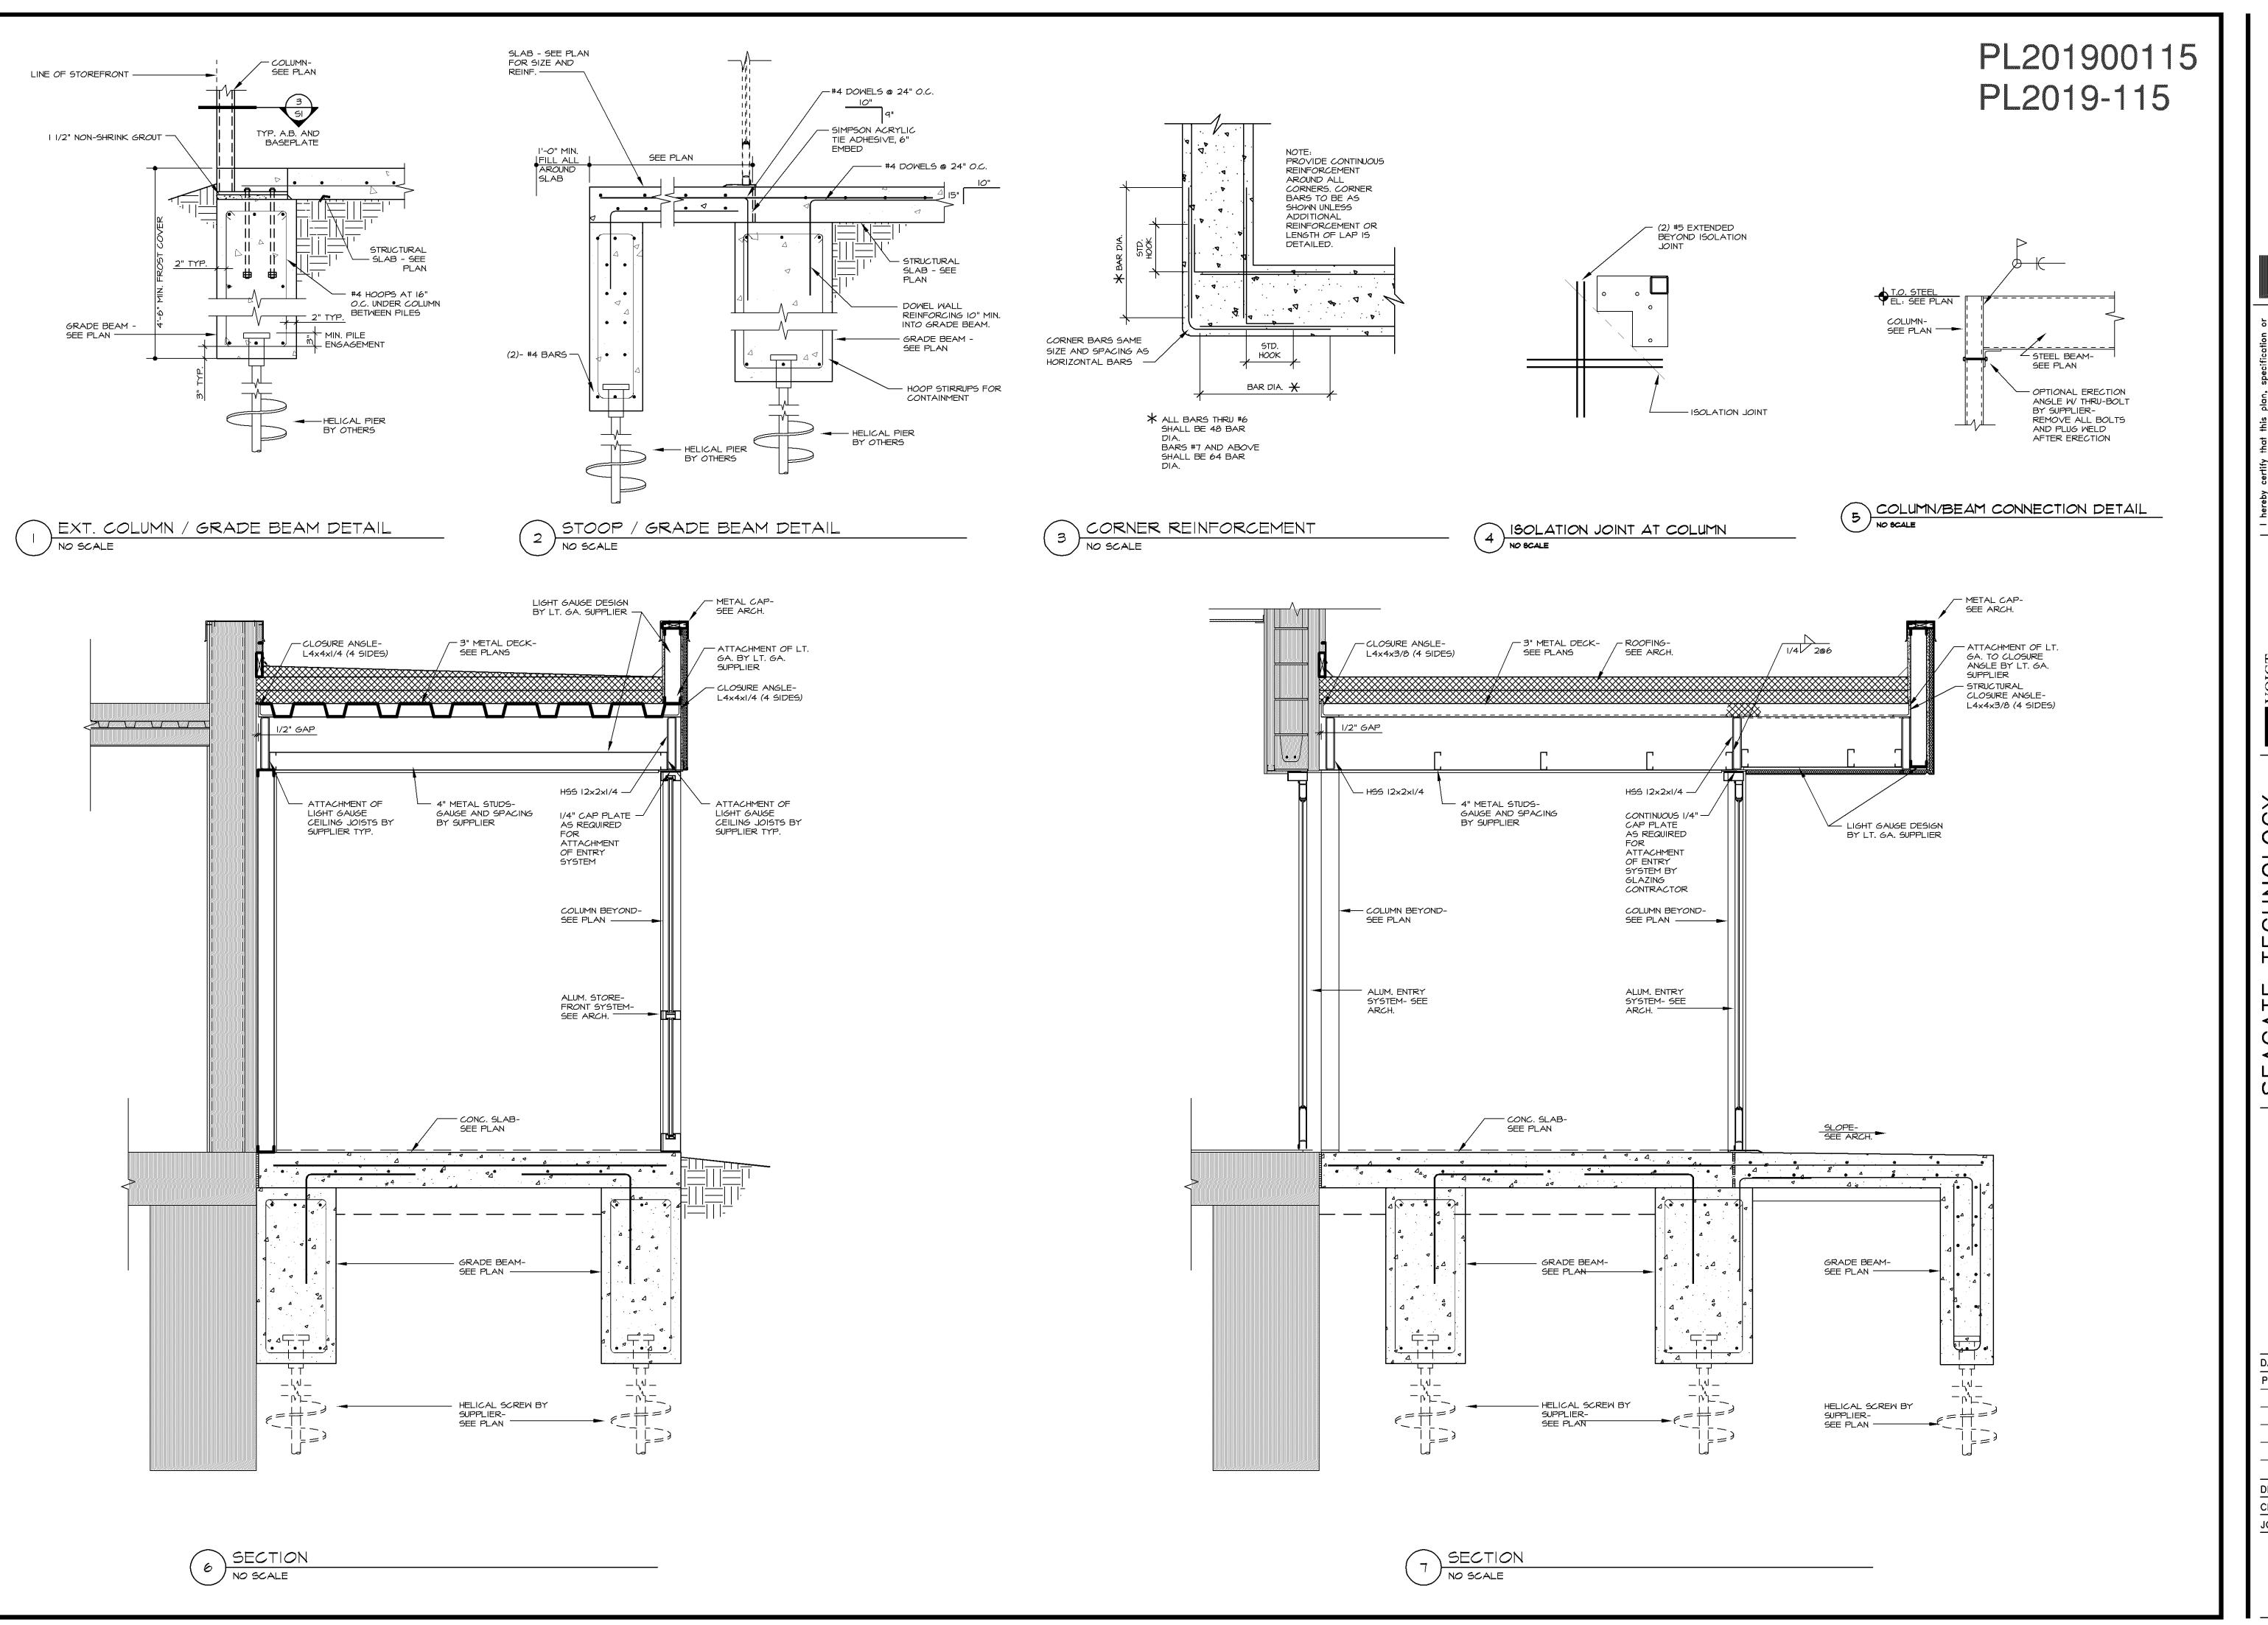

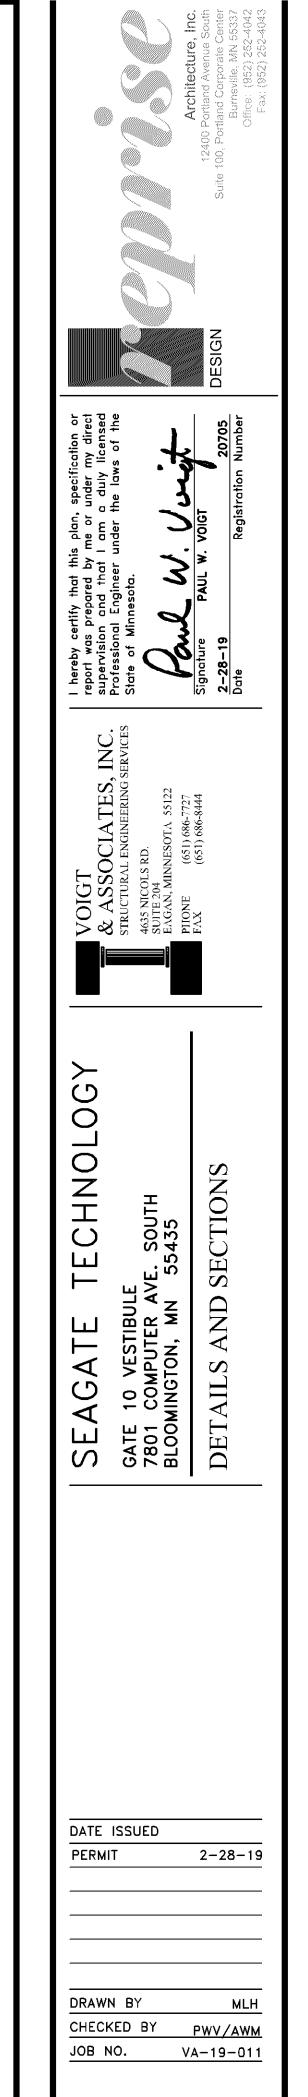

### <u>DESIGN LOADS</u> - DESIGN LIVE LOADS:

PUBLIC AREAS, CORRIDORS AND STAIRS 100 PSF \* 50 PSF GROUND SNOW \*\* 90 MPH

\* PLUS DRIFTING AND/OR SLIDING SNOW \*\* EXPOSURE B

<u>HELICAL PIERS</u> HELICAL PIERS TO HAVE WORKING CAPACITY OF 20K VERTICAL AND 2K LATERAL. PIER SIZE, LENGTH AND CONFIGURATION TO BE DESIGNED BY SUPPLIER. RECORDS OF PERIMETER LENGTHS, ELEVATIONS, AND DRIVING RESISTANCE SHALL BE KEPT BY SUPPLIER AND PROVIDED TO THE ENGINEER AND OWNER.

#### BACKFILLING - BOTH SIDES OF FOUNDATION WALLS SHALL BE BACKFILLED SIMULTANEOUSLY SO AS TO PREVENT OVERTURNING OR LATERAL MOVEMENT OF WALLS.

COLD WEATHER EXCAVATION
- FROST SHOULD NOT BE ALLOWED TO PENETRATE INTO THE SOILS BELOW ANY PROPOSED STRUCTURE.

- MINTER EXCAVATION SHOULD BE LIMITED TO AREAS SMALL ENOUGH TO BE REFILLED TO A GRADE HIGHER THAN FOOTING GRADE ON THE SAME DAY.
- TRENCHING BACK DOWN TO UNFROZEN SOILS FOR FOUNDATION CONSTRUCTION CAN THEN BE PERFORMED JUST PRIOR TO FOOTING PLACEMENT
- THE EXCAVATED TRENCHES SHOULD BE PROTECTED FROM FREEZING BY MEANS OF INSULATING OR HEATING DURING THE FOUNDATION
- BACKFILLING OF THE TRENCHES SHOULD BE PERFORMED IMMEDIATELY AFTER THE BELOW-GRADE FOUNDATION CONSTRUCTION IS FINISHED. ANY INTERIOR FOOTINGS, OR FOOTINGS DESIGNED WITHOUT FROST
- PROTECTION SHOULD BE EXTENDED BELOW FROST DEPTH. UNLESS ADEQUATE PRECAUTIONS ARE TAKEN TO PREVENT FROST INTRUSION UNTIL THE BUILDING CAN BE ENCLOSED AND HEATED. ANY FROST WHICH FORMS IN LOOSE LAYER, OR SNOW WHICH
- ACCUMULATES, SHOULD BE COMPLETELY REMOVED FROM THE FILL AREA PRIOR TO COMPLETION AND ADDITIONAL SOIL PLACEMENT. FROZEN SOILS, OR SOILS CONTAINING FROZEN MATERIAL OR SNOW SHOULD
- NEVER BE USED AS FILL MATERIAL. AFTER THE STRUCTURE HAS BEEN ENCLOSED, ALL FLOOR SLAB AREAS SHOULD BE SUBJECTED TO AMPLE PERIODS OF HEATING TO ALLOW THAWING OF THE SOIL SYSTEM.
- THE FLOOR SLAB AREAS SHOULD BE CHECKED AT RANDOM AND REPRESENTATIVE LOCATIONS FOR REMNANT AREAS OF FROST, AND DENSITY TESTS SHOULD BE PERFORMED TO DOCUMENT FILL COMPACTION PRIOR TO SLAB PLACEMENT.

# <u>DESIGN STRESSES</u> - NOTE ALL MATERIALS MAY NOT BE USED ON THIS JOB. - CONCRETE

STRENGTH AT <u>28 DAYS (PSI)</u>	TYPE MIX	LOCATION
3000 4000	STD. WT. STD. WT. AIR-ENTRAINED	INTERIOR SLABS AND WALLS EXTERIOR SLABS AND WALL
3000	STD. WT	FOOTINGS

= 50,000 PSI ASTM A572

= 36,000 PSI ASTM A36

= 36,000 PSI ASTM A36

FV = 120,000 PSI ASTM A325

Fv = 60,000 PSI ASTM A307\*\*

Fy = 70,000 PSI

ASTM AI85

= 46,000 PSI ASTM A500 GRADE B

= 36,000 PSI ASTM A53 GRADE B

_	MASONRY
-	REINFORCEMENT
	TAILEDE EL ANIZE GUAI

f'm = 1500 PSI (AT 28 Days) Fy = 60,000 PSI ASTM A615 WIDE FLANGE SHAPES STRUCTURAL TUBING

STANDARD STEEL PIPE PLATES BOLTS ANCHOR BOLTS

MISC. STRUCTURAL SHAPES WELD ELECTRODE MELDED WIRE FABRIC

- CONCRETE WORK SHALL CONFORM TO ALL REQUIREMENTS OF ACI 301. - TOLERANCES SHALL CONFORM TO ACI IIT.

# CONCRETE COVERAGE FOR REINFORCEMENT - FOOTINGS

- EXPOSED EXTERIOR CONCRETE

THE REINFORCING STEEL CONTRACTOR SHALL FABRICATE ALL REINFORCEMENT AND FURNISH ALL ACCESSORIES, CHAIRS, SPACER BARS AND SUPPORTS NECESSARY TO SECURE THE REINFORCEMENT UNLESS SHOWN OTHERWISE ON THE PLANS AND/OR DETAILS. CONCRETE REINFORCEMENT SHALL BE PLACED ACCORDING TO THE CRSI

"RECOMMENDED PRACTICE FOR PLACING REINFORCING BARS" COMPRESSION AND TENSION LAP SPLICES FOR CAST-IN-PLACE CONCRETE SHALL BE 36 BAR DIAMETERS MINIMUM UNLESS OTHERWISE NOTED. TENSION LAP SPLICES FOR REINFORCED MASONRY SHALL BE 48 BAR DIAMETERS MINIMUM, UNLESS OTHERWISE NOTED.

HORIZONTAL REINFORCING STEEL IN FOOTINGS AND CONCRETE WALLS

SHALL BE CONTINUOUS AROUND CORNERS. ALL LAPS IN WWF SHOULD BE ONE MESH PLUS TWO INCHES AT SPLICES. PROVIDE (2) #5 REINFORCING BARS EACH SIDE AROUND OPENINGS IN CONCRETE WALLS AND SLABS. BARS SHALL EXTEND 24" BEYOND THE CORNERS OF THE OPENINGS. ALSO PROVIDE (2) #5 DIAGONAL BARS AT EACH CORNER OF OPENING.

### TOP BARS SHALL BE HOOKED AT END SPANS. CONSTRUCTION AND CONTROL JOINTS IN CONCRETE - CONSTRUCTION JOINTS SHALL BE MADE AS DETAILED ON THE DRAWINGS.

- MAXIMUM SPACING FOR CONTROL JOINTS IN SLABS ON GRADE SHALL BE
- A 12'-O" MAXIMUM SPACING OF CONTROL JOINTS MAY NOT INSURE COMPLETE CONTROL OF SHRINKAGE CRACKS. A CLOSER SPACING MAY BE USED BY REQUEST OF OWNER IF MORE COMPLETE SHRINKAGE CRACK
- CONTROL IS DESIRED. CONTRACTOR TO VERIFY WITH OWNER. CONSTRUCTION JOINTS IN CONCRETE FOUNDATION WALLS SHALL BE LOCATED SO NO SINGLE POUR IS LONGER THAN 30 FEET.

STRUCTURAL STEEL
- FABRICATIONS AND ERECTION OF STRUCTURAL STEEL MEMBERS IS TO BE IN ACCORDANCE WITH A.I.S.C. CODE OF STANDARD PRACTICE. ALL CONNECTIONS SHALL BE BOLTED OR WELDED AND SHALL DEVELOP THE FULL STRENGTH OF THE STRUCTURAL MEMBERS, UNLESS NOTED OTHERWISE. (MINIMUM OF (2) BOLTS PER CONNECTION).

- ALL WELDING SHALL BE BY QUALIFIED WELDERS AND SHALL CONFORM TO THE STANDARDS OF THE AMERICAN WELDING SOCIETY, DI.I-98 STRUCTURAL WELDING CODE - STEEL. WELDING OF GALVANIZED PARTS IS - ELECTRODES FOR ALL FIELD AND SHOP WELDING SHALL CONFORM TO
- MATCHING FILLER METAL REQUIREMENTS OF AWS DI.I-98. FIELD CONNECTIONS ARE TO BE BOLTED. USE 3/4" DIA. HIGH STRENGTH BOLTS AND NUTS (A325X) UNLESS SHOWN OTHERWISE ON PLANS. STEEL COLUMN BASE PLATES SHALL BE SIZE SHOWN ON PLAN WITH 3/4" DIAMETER ANCHOR BOLTS (A307) AND I" NON-SHRINK GROUT FOR UNIFORM
- UNLESS NOTED OTHERWISE, STRUCTURAL STEEL SUPPLIER IS TO FURNISH (3) 1/2" x 3 1/2" x 1/4" SHOP WELDED ANGLE FRAMES AT ALL ROOF OPENINGS. VERIFY SIZE AND LOCATION WITH MECHANICAL CONTRACTOR. - ALL STRUCTURAL STEEL AND MISCELLANEOUS METALS SHALL BE PRIME PAINTED WITH ONE COAT OF TNEMEC #49 PRIMER OR EQUAL. TOUCH UP ALL
- FOR THE WORK OF OTHER TRADES SHALL NOT BE ALLOWED, EXCEPT BY WRITTEN PERMISSION FROM THE ARCHITECT. GROUT UNDER BEAM BEARING PLATES AND COLUMN BASE PLATES SHALL BE "NON-SHRINK" AND SHALL ATTAIN A MINIMUM COMPRESSIVE STRENGTH OF 10.000 PSI.

CUTS, HOLES (OPENINGS), ETC. REQUIRED IN STRUCTURAL STEEL MEMBERS

### STEEL POOF DECK - STEEL DECK SHALL BE PAINTED.

- END JOINTS OF DECK SHALL BE STAGGERED WITH 2" MINIMUM END LAPS. - DECK SHALL BE I I/2" - 22 GAGE WIDE RIB DECK, TYPE B.

### - METAL DECK- SEE PLAN FOR SIZE AND GAGE

DISTURBED AREAS AFTER ERECTION.

LIGHT GAGE STUDS AND JOISTS ALL STUD (AND/OR) JOIST FRAMING MEMBERS SHALL BE DESIGNED BY SUPPLIER. ALL STUDS, JOISTS AND ACCESSORIES SHALL BE PRIMED WITH RUST-INHIBITIVE PAINT MEETING THE PERFORMANCE REQUIREMENTS OF TT-P-

COATING. ALL FRAMING MEMBERS SHALL MEET THE REQUIREMENTS OF ASTM A446. WITH A MINIMUM YIELD OF 33,000 PSI FOR 18 GA. OR LIGHTER, 50,000 PSI FOR

636C, OR SHALL BE FORMED FROM STEEL HAVING AG-60 GALVANIZED

- 16 GA, OR HEAVIER. ALL TRACKS SHALL MEET THE REQUIREMENTS OF A446, GRADE 33, WITH A
- MINIMUM YIELD OF 33,000 PSI. ALL WELDING IS TO BE DONE PER MANUFACTURERS RECOMMENDATIONS ON ROD TYPE AND AMPERAGE.
- TRACKS SHALL BE SECURELY ANCHORED TO CONCRETE OR CMU. JOISTS SHALL BE SET SQUARE AND PLUMB INTO TRACKS AND SECURELY FASTENED TO WEB AND FLANGES. UNLESS DETAILED OTHERWISE, MAKE FIELD CONNECTIONS USING (3) #12 PAN HEAD SCREWS OR 1/8" BY 1 1/2" LONG FILLET WELDS.
- NO SPLICES IN STUDS SHALL BE PERMITTED. BRACE ALL WALLS WITH COLD ROLLED CHANNEL THROUGH THE STUD PUNCHOUTS AT 4'-O" O.C. MAXIMUM.

### CONSTRUCTION PROCEDURE

- THE STRUCTURE SHALL BE ADEQUATELY BRACED AND SHORED DURING ERECTION AGAINST WIND AND ERECTION LOADS. STRUCTURAL MEMBERS ARE DESIGNED FOR "INPLACE" LOADS.
- COMPLY WITH ALL APPLICABLE CITY, COUNTY, STATE AND FEDERAL LAWS, INCLUDING THE OCCUPATIONAL SAFETY AND HEATH ACT (OSHA) AND
- REGULATIONS ADOPTED PURSUANT THERETO. THE CONTRACT STRUCTURAL DRAWINGS AND SPECIFICATIONS REPRESENT THE FINISHED STRUCTURE. UNLESS OTHERWISE NOTED, THEY DO NOT INDICATE THE MEANS OR METHOD OF CONSTRUCTION. PROVIDE ALL MEASURES NECESSARY TO PROTECT THE STRUCTURE, WORKMEN OR OTHER PERSONS DURING CONSTRUCTION. SUCH MEASURES SHALL INCLUDE, BUT ARE NOT LIMITED TO BRACING, SHORING FOR CONSTRUCTION EQUIPMENT, SHORING FOR THE BUILDING, SHORING FOR EACH BANKS, FORMS, SCAFFOLDING, PLANKING, SAFETY NETS, SUPPORT AND BRACING FOR CRANES AND GIN POLES, ETC.
- ENGAGE PROPERTY QUALIFIED PERSONS TO DETERMINE WHERE AND HOW TEMPORARY PRECAUTIONARY MEASURES SHALL BE USED AND INSPECT SAME IN THE FIELD. OBSERVATION VISITS TO THE SITE BY ENGINEER'S FIELD REPRESENTATIVE SHALL NOT INCLUDE INSPECTION OF THE ABOVE ITEMS.
- SUPERVISE AND DIRECT THE WORK SO AS TO MAINTAIN SOLE RESPONSIBILITY FOR ALL CONSTRUCTION MEANS, METHODS, TECHNIQUES, SEQUENCES AND PROCEDURES. AS A PART OF THIS RESPONSIBILITY, RETAIN THE SERVICES OF A LICENSED STRUCTURAL ENGINEER TO DESIGN AND SUPERVISE ANY SCAFFOLDING FOR WORKMEN, AND ALL SHORING OF FORMS AND ELEMENTS OF THE CONSTRUCTION.

#### PLACEMENT OF ANCHOR BOLT, PIPE SLEEVES, PADS AND OPENINGS FOR EQUIPMENT SHALL BE COORDINATED BETWEEN THE GENERAL

CONTRACTOR AND THE OTHER SUBCONTRACTORS. ALL CORE DRILLING SHALL BE DONE UNDER THE SUPERVISION OF THE GENERAL CONTRACTOR. NO REINFORCING SHALL BE CUT. VERIFY LOCATION OF REINFORCING BEFORE CORE DRILLING. THERE SHALL NOT BE ANY CORE DRILLING THROUGH BEAMS OR COLUMNS. MAXIMUM CORE HOLD THROUGH SLABS SHALL BE PIPE DIAMETER PLUS I".

COORDINATION WITH ARCHITECTURAL DRAWINGS

THE CONTRACTOR SHALL VERIFY ALL DIMENSIONS AND ELEVATIONS WITH THE ARCHITECTURAL DRAWINGS. WHERE DISCREPANCIES OCCUR IT IS THE CONTRACTORS RESPONSIBILITY TO NOTIFY THE ARCHITECT PRIOR TO

#### SHOP DRAWINGS SHOP DRAMINGS, UNLESS NOTED OTHERWISE, SHALL BE SUBMITTED FOR

- REVIEW PRIOR TO FABRICATION SHOP DRAWINGS TO BE PREPARED UNDER SUPERVISION OF A REGISTERED PROFESSIONAL ENGINEER, INCLUDING COMPLETE DETAILS AND SCHEDULES FOR FABRICATION AND ASSEMBLY OF STRUCTURAL STEEL MEMBERS,
- PROCEDURES AND DIAGRAMS. - FABRICATORS SHALL DRAW THEIR OWN ERECTION PLANS, COPYING THE STRUCTURAL PLANS AND USING THEM AS ERECTION DRAWINGS IS NOT
- ACCEPTABLE. PRIOR TO SUBMITTAL, THE CONTRACTOR SHALL REVIEW THE SHOP DRAWINGS AND MAKE ANY CORRECTIONS REQUIRED. THE CONTRACTOR SHALL STAMP AND SIGN THE DRAWINGS AS EVIDENCE THAT HE HAS
- REVIEWED THEM. - SHOP DRAWINGS SHALL BE FURNISHED FOR ALL STRUCTURAL COMPONENTS.
- TURN AROUND TIME FOR SHOP DRAWINGS SHALL BE ONE WEEK FROM DATE RECEIVED IN THE ENGINEERS OFFICE. - SHOP DRAWINGS FOR ALL STRUCTURAL COMPONENTS AND SYSTEMS SHALL BE SUBMITTED TO THE ENGINEER FOR REVIEW PRIOR TO FABRICATION AND CONSTRUCTION.


STRUCTURAL DRAWINGS - THESE DRAWINGS SHOW INTENT OF DESIGN, AND ARE NOT INTENDED TO CONFLICT WITH THE CONVENTION OF PROFESSIONAL CONSTRUCTION PRACTICES, BE EXCLUSIVE IN USE, NOR PURPORT TO INDICATE EVERY ITEM OF WORK OR MATERIAL NECESSARY FOR A COMPLETE AND SATISFACTORY PROJECT. ALL QUESTIONS REGARDING DESIGN INTENT OR MATERIALS SHOULD BE BROUGHT TO THE ARCHITECTS AND ENGINEERS ATTENTION IMMEDIATELY. DO NOT PROCEED WITH ANY DEGREE OF UNCERTAINTY WITH ANY ITEM OR PHASE OF THE WORK.

<u>SPECIAL INSPECTIONS</u>
- SPECIAL INSPECTIONS SHALL BE PROVIDED IN ACCORDANCE WITH THE IBC. THE SPECIAL INSPECTOR SHALL BE EMPLOYED BY THE OWNER AND SHALL MEET THE QUALIFICATIONS OF THE CODE ..

# NEW WORK IN CONJUCTION WITH EXISTING CONSTRUCTION THE CONTRACTOR SHALL VERIFY, BY FIELD CHECK, ALL SIZES, DIMENSIONS,

- ELEVATIONS, LOCATIONS, ETC. OF ELEMENTS OF THE EXISTING CONSTRUCTION WHICH ARE RELATIVE TO THE NEW CONSTRUCTION. - ALL DIMENSIONS INVOLVING NEW WORK TYING INTO OR GOVERNED BY EXISTING CONSTRUCTION SHALL BE FIELD CHECKED BY THE CONTRACTOR AND FURNISHED TO THE SUBCONTRACTOR PRIOR TO FABRICATION OF ANY WORK. THE VERIFIED DIMENSIONS SHALL APPEAR AND BE NOTED AS SUCH ON THE FIRST SHOP DRAWING SUBMITTED.
- THE ENGINEER HAS MADE ASSUMPTIONS CONCERNING THE SOUNDNESS OF THE EXISTING BUILDINGS AND THESE ASSUMPTIONS ARE THAT THIS BUILDING WAS DESIGNED AND CONSTRUCTED IN CONFORMITY WITH GOOD DESIGN AND CONSTRUCTION PRACTICES. THE CONTRACTOR SHALL TAKE EXTRAORDINARY PRECAUTIONS CONCERNING PRESERVATION OF THE BUILDING DURING DEMOLITION AND NEW CONSTRUCTION WORK. FURTHER, HE SHALL AGREE TO ASSUME ALL RESPONSIBILITY FOR THE PRESERVATION OF THIS PROPERTY.
- THE CONTRACTOR SHALL NOTIFY THE ARCHITECT/ENGINEER IMMEDIATELY OF ANY DISCREPANCIES BETWEEN CONSTRUCTION DOCUMENTS AND ACTUAL FIELD CONDITIONS.
- ALL HOLES THROUGH EXISTING CONCRETE OR MASONRY CONSTRUCTION SHALL BE CORE DRILLED OR SAW CUT. NEW OPENINGS MUST BE MADE WITH ENGINEER'S APPROVAL. CUTTING OF EXISTING STRUCTURAL STEEL IS PROHIBITED WITHOUT APPROVAL FROM THE ENGINEER.

PL201900115 PL2019-115

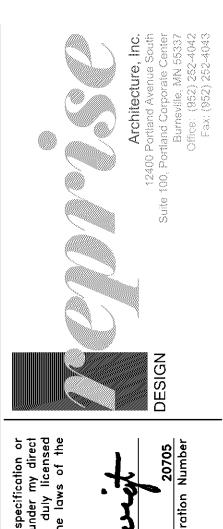

 $\circ$ 

GA' 78( BL(

DATE ISSUED PERMIT 2-28-19

DRAWN BY CHECKED BY PWV/AWM JOB NO. VA-19-011