

Hydrant coverage shall be provided within 50' of the FDC and within 150' of all portions of the structure.

Emergency responder radio coverage meeting the requirements of appendix L in the 2015 MSFC shall be provided throughout the property and within the structures.

Provide emergency vehicle access around the structure and adequate turning radius to accommodate BFD Ladder 1

Provide an Environmental Health Plan Review Application

Provide specification sheets for all new and used equipment being proposed for use in this facility

Provide floor, wall and ceiling finish schedule of kitchen and service area

APPLICATION
WITHDRAWN

CASE FILE #PL201800255

MERCURY STUDIOS, INC.

MERCURY STUDIOS, INC.
2548 W. CORTEZ ST. CHICAGO, IL 60622
Ph 773-395-8216 Fax 773-395-8218 merstudio@aol.com

PROJECT

PORTILLO'S HOT DOGS
BLOOMINGTON, MN

SHEET TITLE

SITE ARIAL
PLAN

SCALE

N.T.S.

DATE

8-10-18

REV. 9-10-18

REV. 9-12-18

REV. 9-20-18

REV. 10-2-18

DRAWN BY

SHEET



COPYRIGHT © 2018 MERCURY STUDIOS, INC. ALL RIGHTS RESERVED. THESE DOCUMENTS ARE THE PROPERTY OF MERCURY STUDIOS, INC. AND ARE NOT TO BE REPRODUCED OR TRANSMITTED IN ANY FORM OR BY ANY MEANS, ELECTRONIC OR MECHANICAL, INCLUDING PHOTOCOPYING, RECORDING, OR BY ANY INFORMATION STORAGE AND RETRIEVAL SYSTEM. WITHOUT THE WRITTEN PERMISSION OF MERCURY STUDIOS, INC. ANY REPRODUCTION OR TRANSMISSION OF THESE DOCUMENTS IS PROHIBITED. MERCURY STUDIOS, INC. ASSUMES NO LIABILITY FOR ANY ERRORS OR OMISSIONS IN THESE DOCUMENTS. MERCURY STUDIOS, INC. IS NOT A DESIGN PROFESSIONAL AND DOES NOT PROVIDE DESIGN SERVICES. ANY DESIGN SERVICES PROVIDED BY MERCURY STUDIOS, INC. ARE PROVIDED AS A CONSULTING SERVICE ONLY. MERCURY STUDIOS, INC. IS NOT A DESIGN PROFESSIONAL AND DOES NOT PROVIDE DESIGN SERVICES. ANY DESIGN SERVICES PROVIDED BY MERCURY STUDIOS, INC. ARE PROVIDED AS A CONSULTING SERVICE ONLY.

MERCURY STUDIOS, INC.
2548 W. CORTEZ ST. CHICAGO, IL 60622
Ph 773-395-8216 Fax 773-395-8218 mercury@aol.com

PROJECT

PORTILLO'S HOT DOGS
BLOOMINGTON, MN

SHEET TITLE

CONCEPT
1ST FLOOR
PLAN

SCALE

3/16" = 1'-0"

DATE

8-10-18
REV. 9-10-18
REV. 9-12-18
REV. 9-20-18
REV. 10-2-18

DRAWN BY

SHEET

A-1.0A

CASE FILE #PL201800255


Insure kitchen hood suppression system is an approved UL300 listed system connected to the building sprinkler system.


Provide a minimum of ceramic tile to six feet in height and two feet beyond all two- and three- compartment sinks, dish washing machines, and food preparation areas designated on the plan. Stainless steel may be used in place of ceramic tile. (City Code Sec. 14.45c (a)(4)(C))

All trash and recycling must be stored within the principle structure of the building

Provide reliable heat in the room.

Must meet MN Accessibility Code

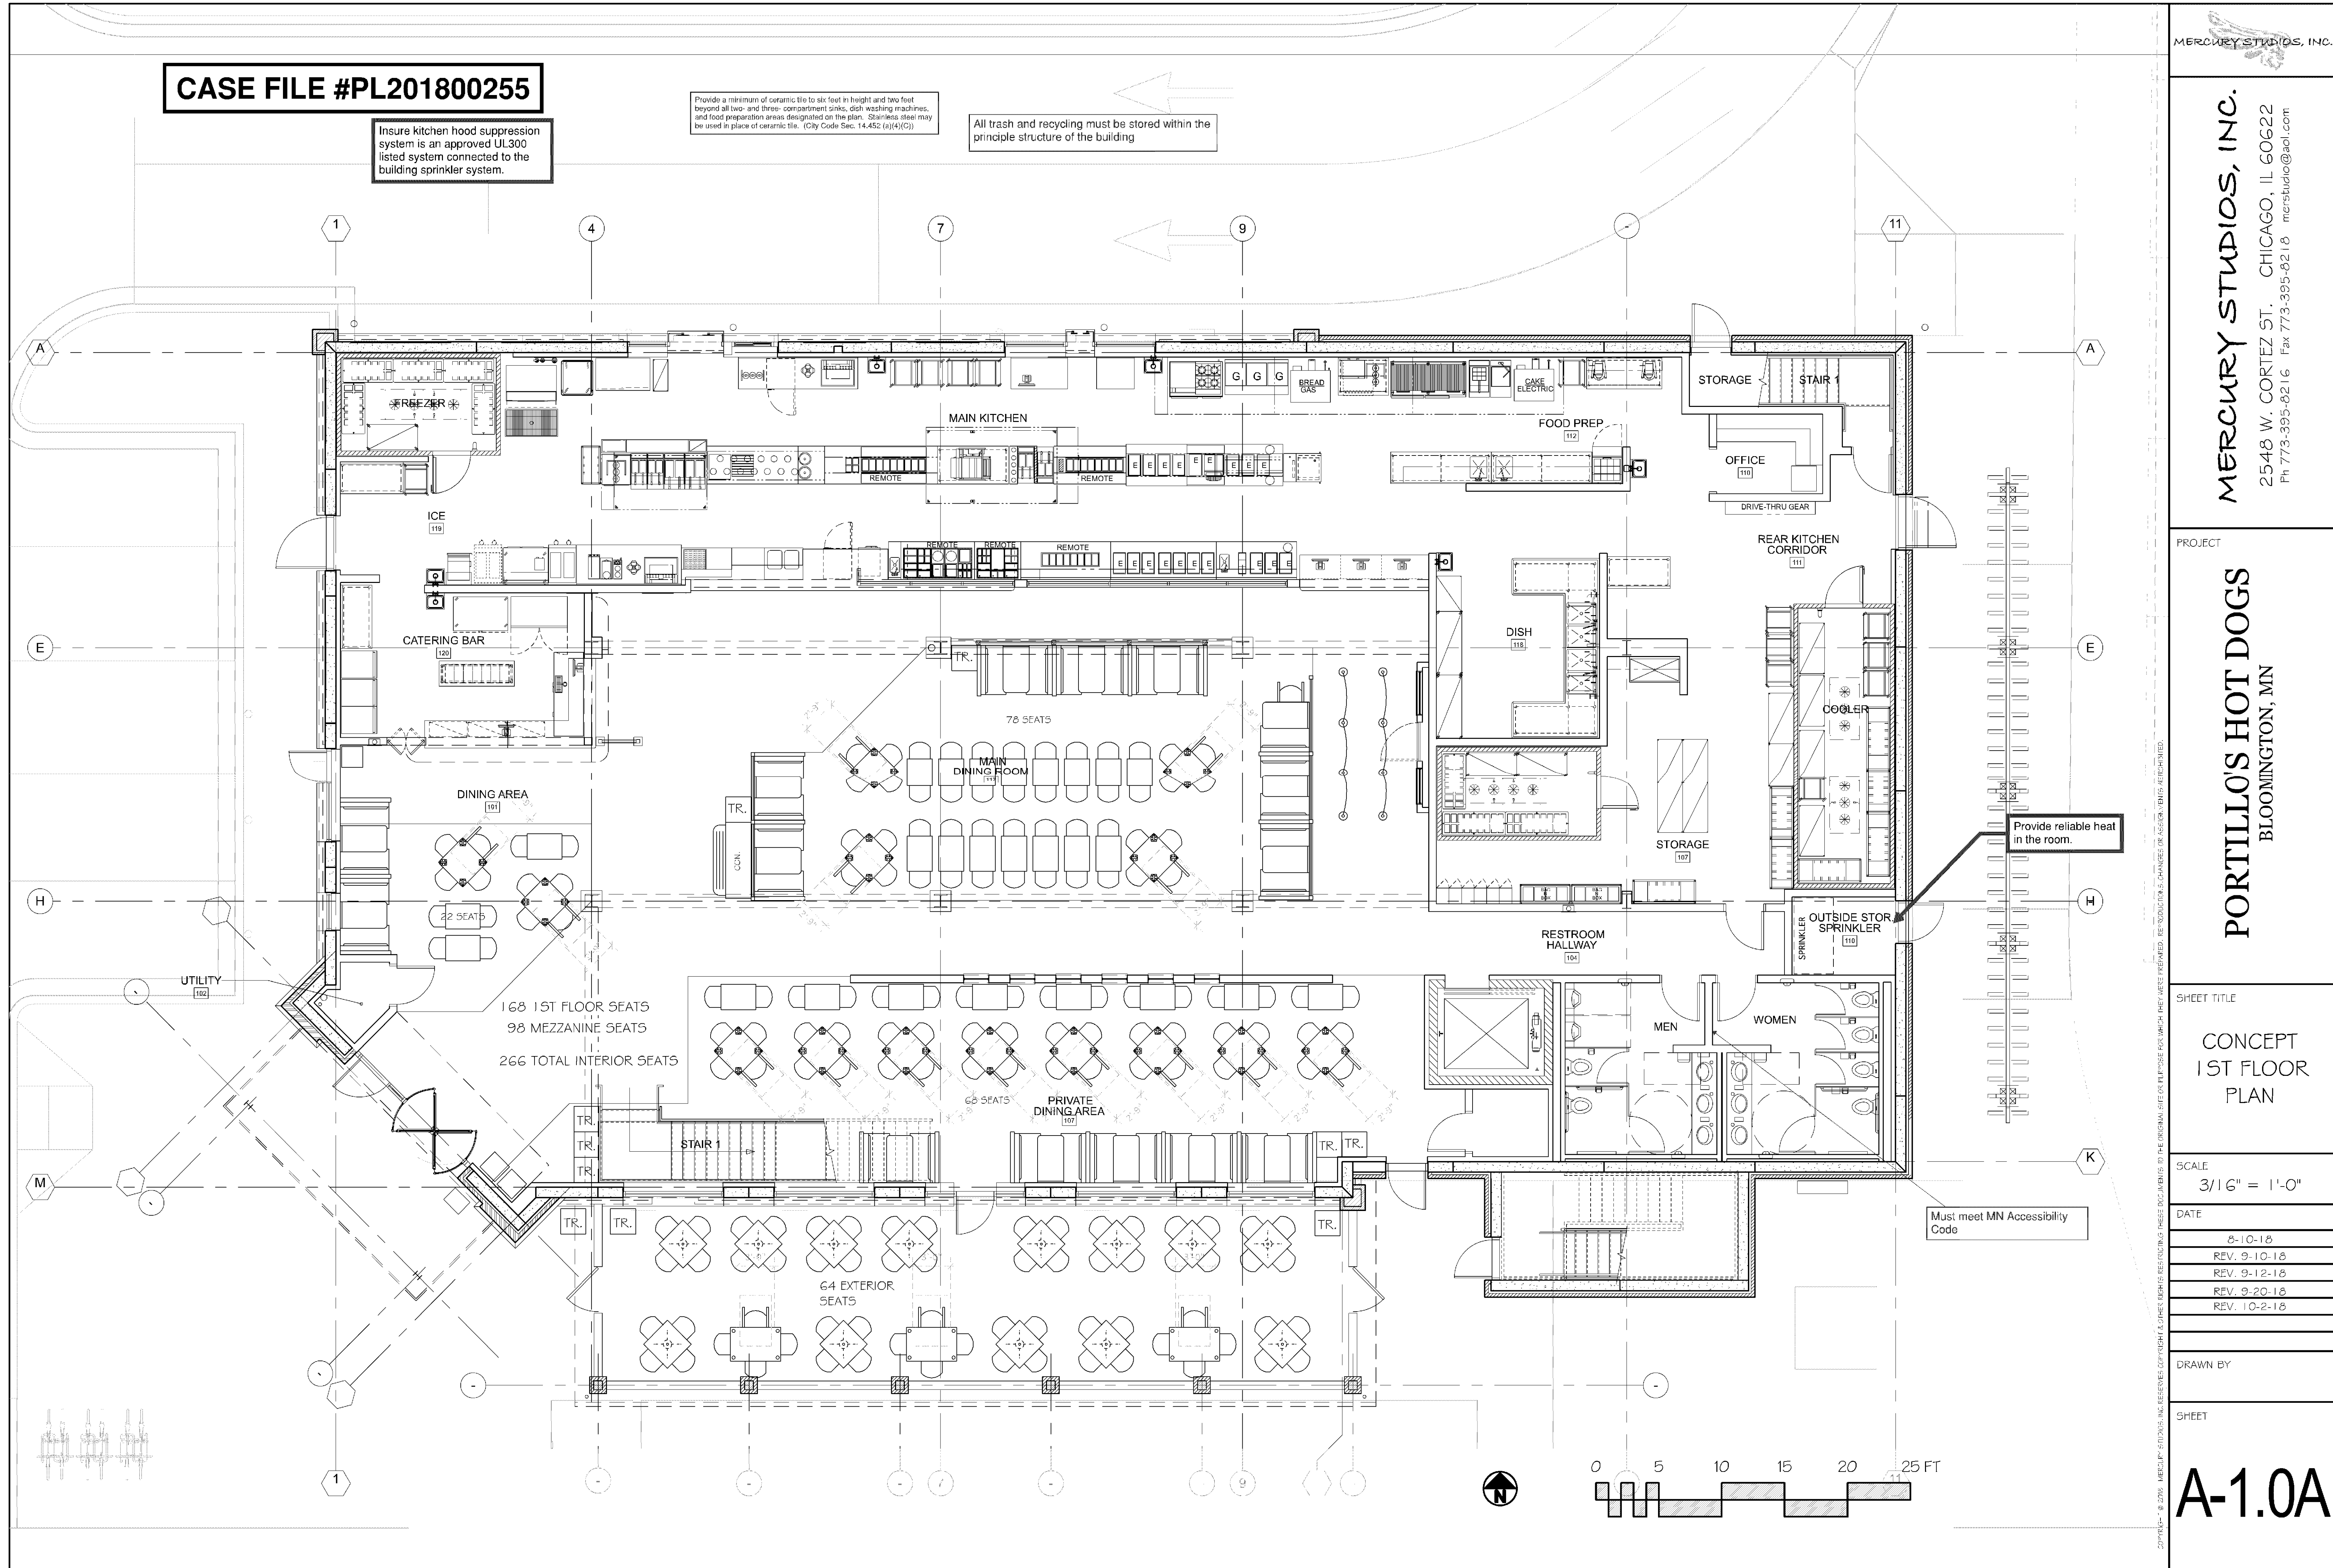

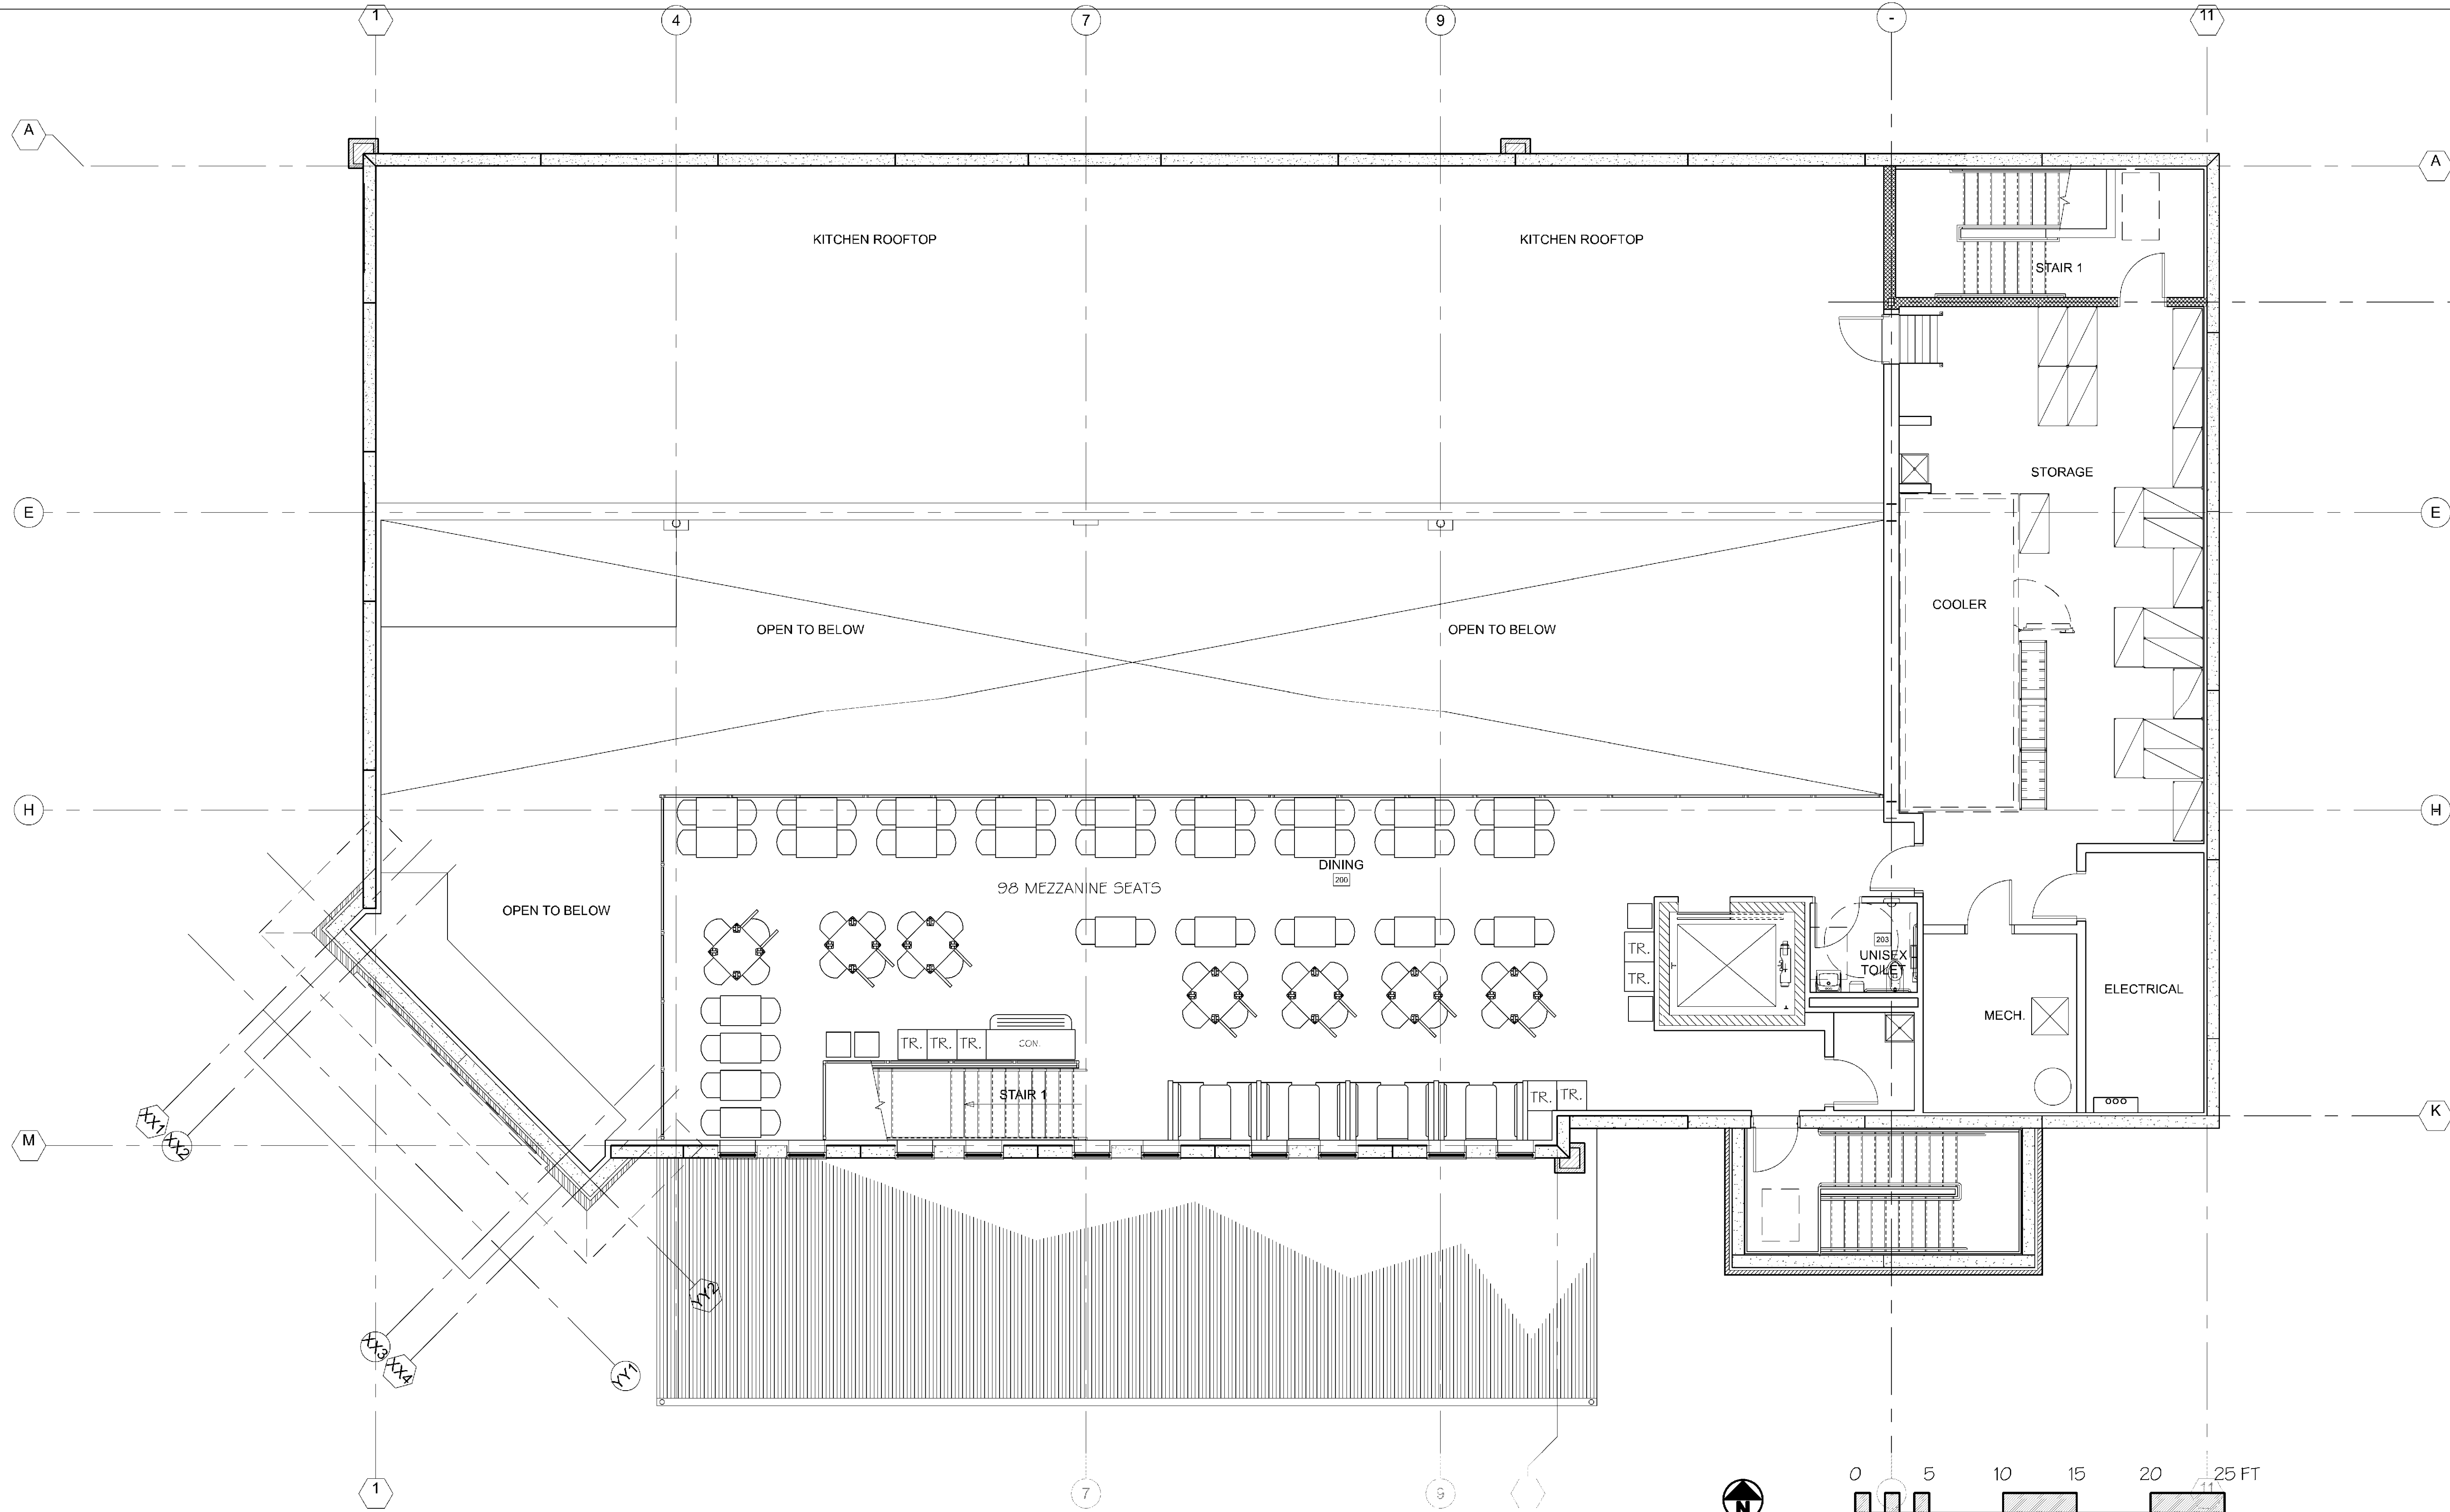

4" WOOD CAP WRAPPED WITH PAC-CLAD FOREST GREEN ALUM. BREAK METAL

1/2" DEEP REVEAL CAST INTO PRECAST PANELS PT-18

PAC-CLAD FOREST GREEN ALUM. CAP

E.F.I.S. CORNICE (INSTALL BLOCKING AS NEEDED FOR THE LED BAND) PT-11

E.F.I.S. CORNICE PAINTED TO MATCH PT-11

GOLD LED BAND

TOP/ ARCHITECTURAL FEATURE EL. +34'-4"

TOP/ROOF EL. +25'-4"

ARM MOUNTED UPLIGHT

TOP/ROOF EL. +15'-8"

TOP/ENTRY ROOF EL. +11'-6"

PAC-CLAD FOREST GREEN BREAK METAL WRAPPED SOFFIT. SEE WALL SECTION 10/A5.4

STEEL COLUMN & BEAM ORNAMENTAL STEEL BRACKET PT-3

CULTURED STONE BASE

THINBRICK SOLDIER COURSE APPLIED ON TOP OF PRECAST BR-2(TH)

DK. GREEN ANODIZED ALUMINUM STOREFRONT WINDOWS & DOORS

STAINLESS STEEL DOORS AND H.M. FRAMES

T/FIN. DRIVEWAY EL. -0'-1"

BOT/FOOTING EL. -4'-0"

BRICK PIERS BR-1

BRICK PIERS ACCENT STRIPE BR-2

GOOSENECK LIGHT FIXTURE

TOP/ROOF EL. +16'-8"

PRECAST WALL PANEL PT-16

OUTLINE OF ROOFTOP EQUIPMENT

GOLD LED BAND

TOP/COPING EL. +29'-0"

WEST - PATIO ELEVATION

Scale: 3/16" = 1'-0"



0 5 10 15 20 25 FT

 SOUTH WEST - ENTRY ELEVATION
Scale: 3/16" = 1'-0"


2 SOUTH - FRONT DOOR ELEVATION

Scale: 3/16" = 1'-0"


1-4.0

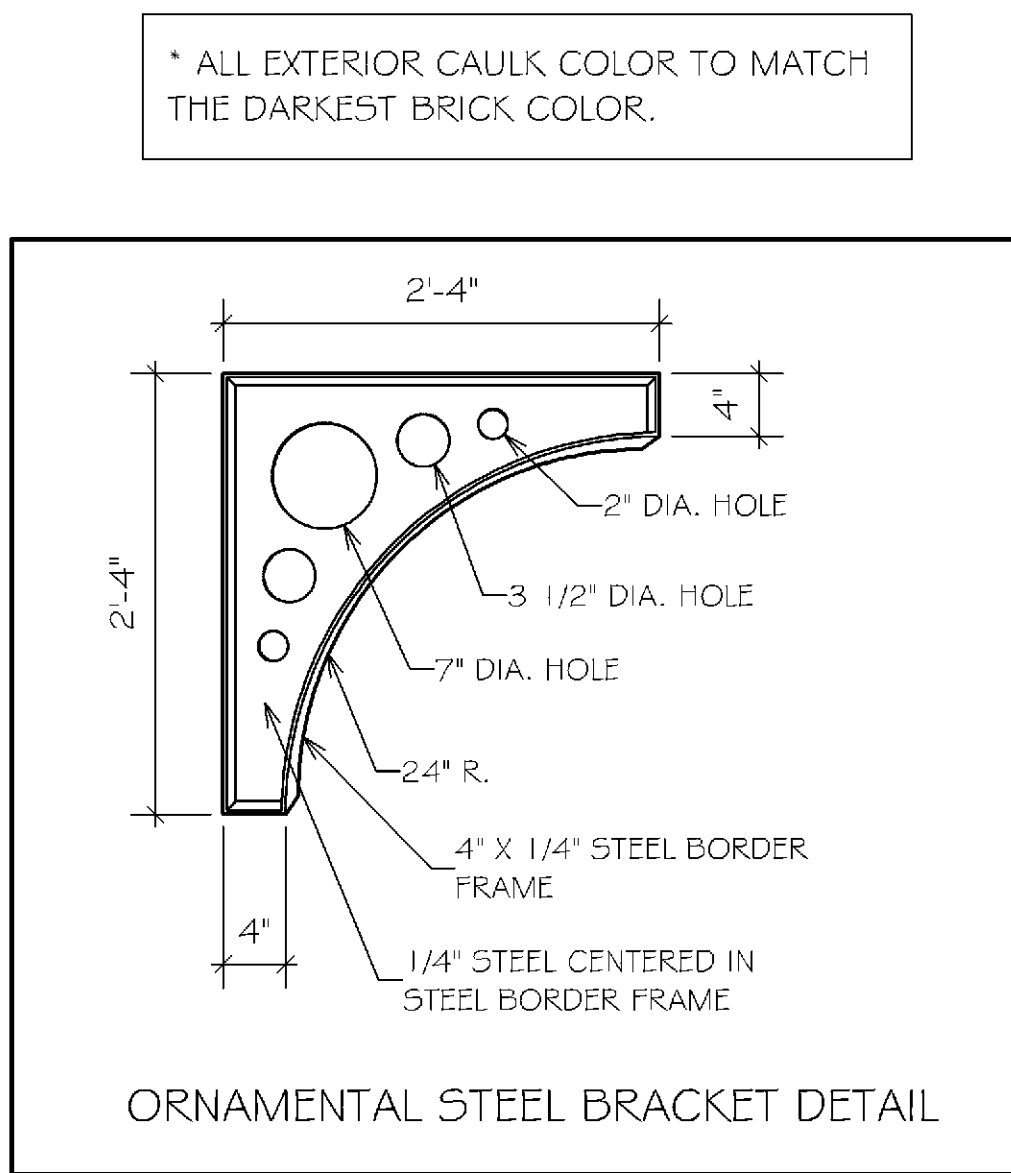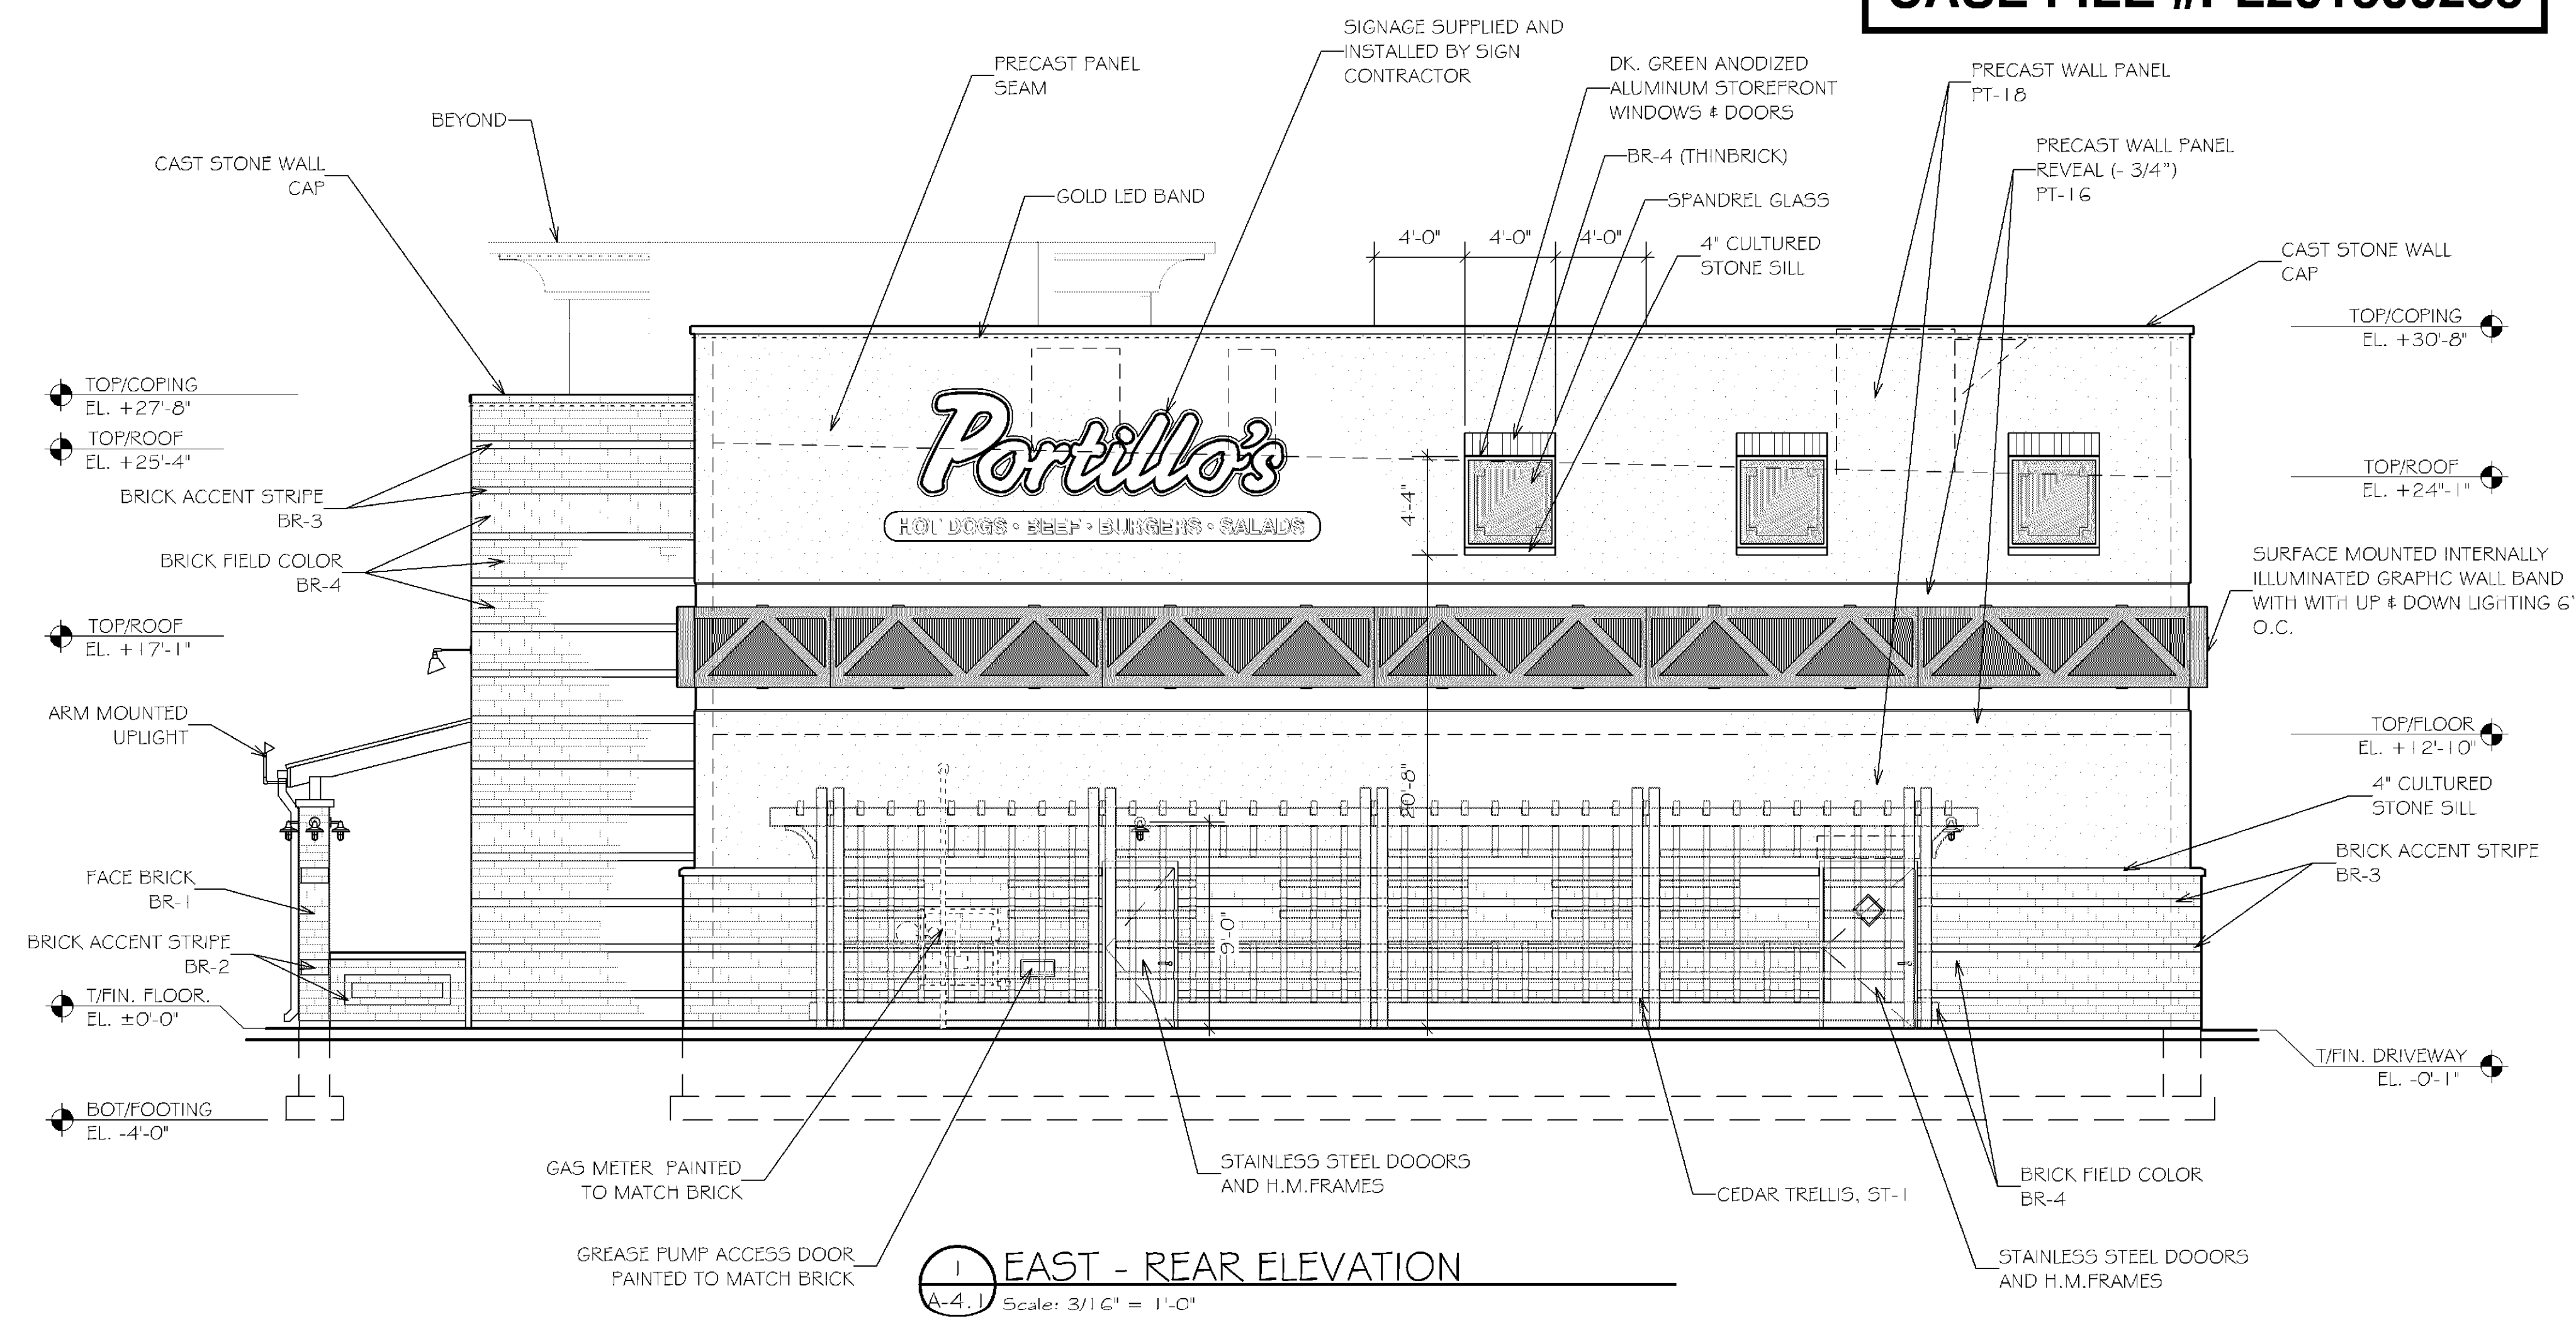

- BR-1
SIOUX CITY BRICK - SAVANNAH WELLINGTON
- BR-2
SIOUX CITY BRICK - SMOKED TUDOR
- BR-3
SIOUX CITY BRICK - EBONITE SMOOTH
- BR-4
SIOUX CITY BRICK - BROWN
- * ALL BRICKS ARE 12" UTILITY (3 5/8 x 3 5/8 x 1 5/8)
- PT-3
SHERWIN WILLIAMS #5W6991, BLACK MAGIC
- PT-11
SHERWIN WILLIAMS #6461, ISLE OF FINE
- PT-16
SHERWIN WILLIAMS #5W6374, TORCHLIGHT
- PT-17
SHERWIN WILLIAMS #5W2861, AVOCADO
- PT-18
SHERWIN WILLIAMS #5W6355, TRUE PENNY
- * BUILDING SIGNAGE IS TO BE SUBMITTED AND APPROVED UNDER SEPARATE SIGN PERMIT DRAWINGS.
- * GHOST SIGNAGE IS TO BE SUBMITTED AND REVIEWED AS PART OF THE ARCHITECTURAL REVIEW APPROVAL PROCESS.

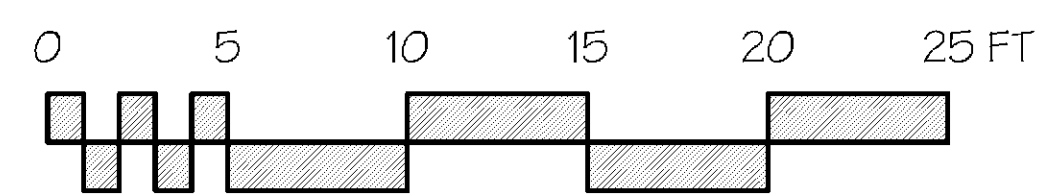

1 EAST - REAR ELEVATION
A-4.1 Scale: 3/16" = 1'-0"

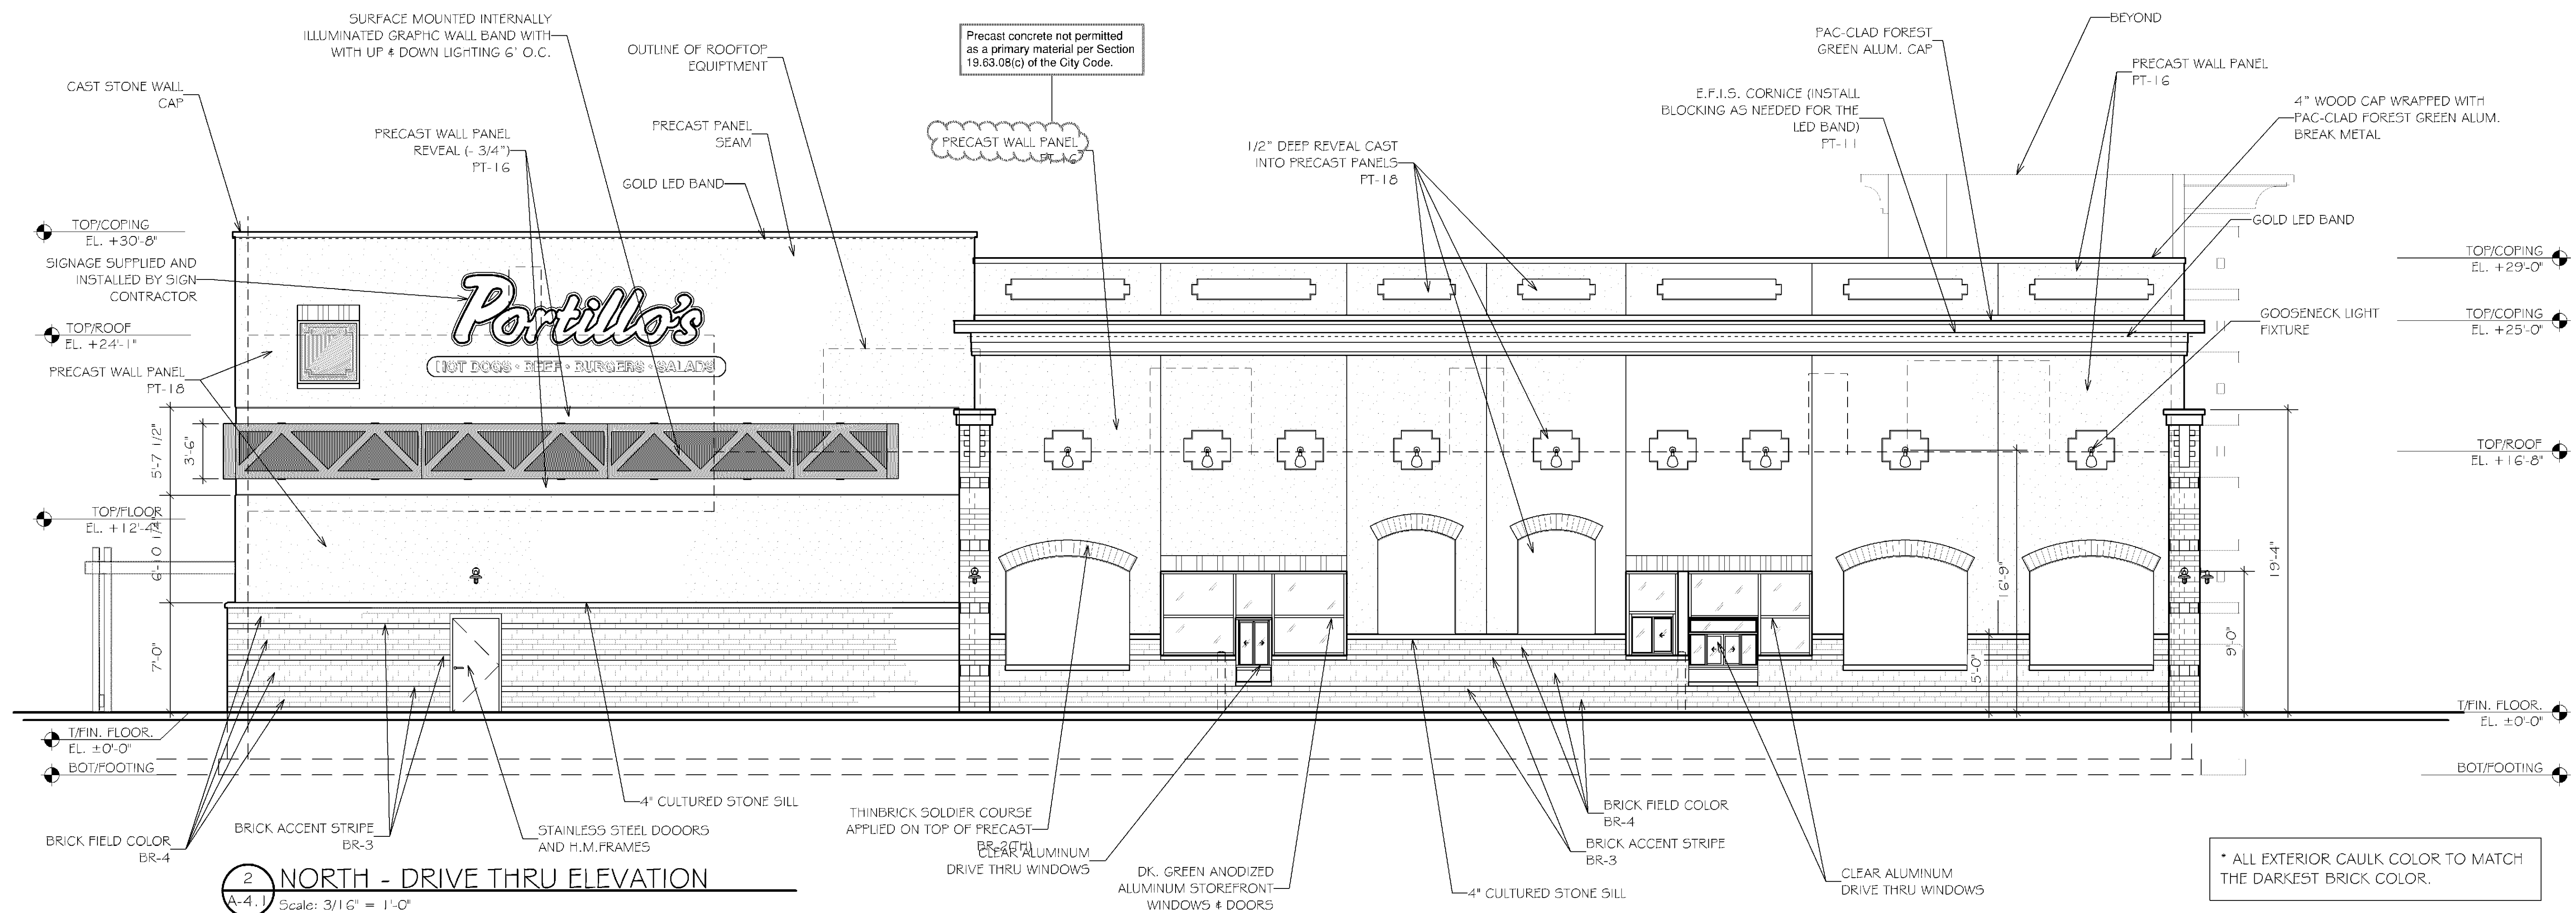

2 NORTH - DRIVE THRU ELEVATION
A-4.1 Scale: 3/16" = 1'-0"

* ALL EXTERIOR CAULK COLOR TO MATCH THE DARKEST BRICK COLOR.

MERCURY STUDIOS, INC.
2548 W. CORTEZ ST. CHICAGO, IL 60622
Ph 773-395-8216 Fax 773-395-8218 merstudio@aol.com

PROJECT
PORTILLO'S HOT DOGS
BLOOMINGTON, MN

SHEET TITLE
CONCEPT
ELEVATIONS

SCALE
3/16" = 1'-0"

DATE
8-10-18
REV. 9-10-18
REV. 9-12-18
REV. 9-20-18
REV. 10-2-18

DRAWN BY

SHEET

A-4.1

 SOUTH WEST - ENTRY ELEVATION
Scale: 3/16" = 1'-0"



2 SOUTH - FRONT DOOR ELEVATION
A-4.0 Scale: 3/16" = 1'-0"

© 2019 MERCURY SOLUTIONS, INC. RESERVES COPYRIGHT & OTHER RIGHTS REGARDING THESE DOCUMENTS TO THE ORIGINAL SITE OR PURPOSE FOR WHICH THEY WERE PREPARED. REPRODUCTION, CHANGES OR ASSIGNMENTS PROHIBITED.

MERCURY STUDIOS, INC.
2548 W. CORTEZ ST. CHICAGO, IL 60622
Ph 773-395-8216 Fax 773-395-8218 merstudio@aol.com

PROJECT

PORTILLO'S HOT DOGS
BLOOMINGTON, MN

SHEET TITLE

COLOR
CONCEPT
ELEVATIONS

SCALE
3/16" = 1'-0"


DATE

8-10-18
REV. 9-10-18
REV. 9-12-18
REV. 9-20-18
REV. 10-2-18


DRAWN BY

SHEET

A-4.1

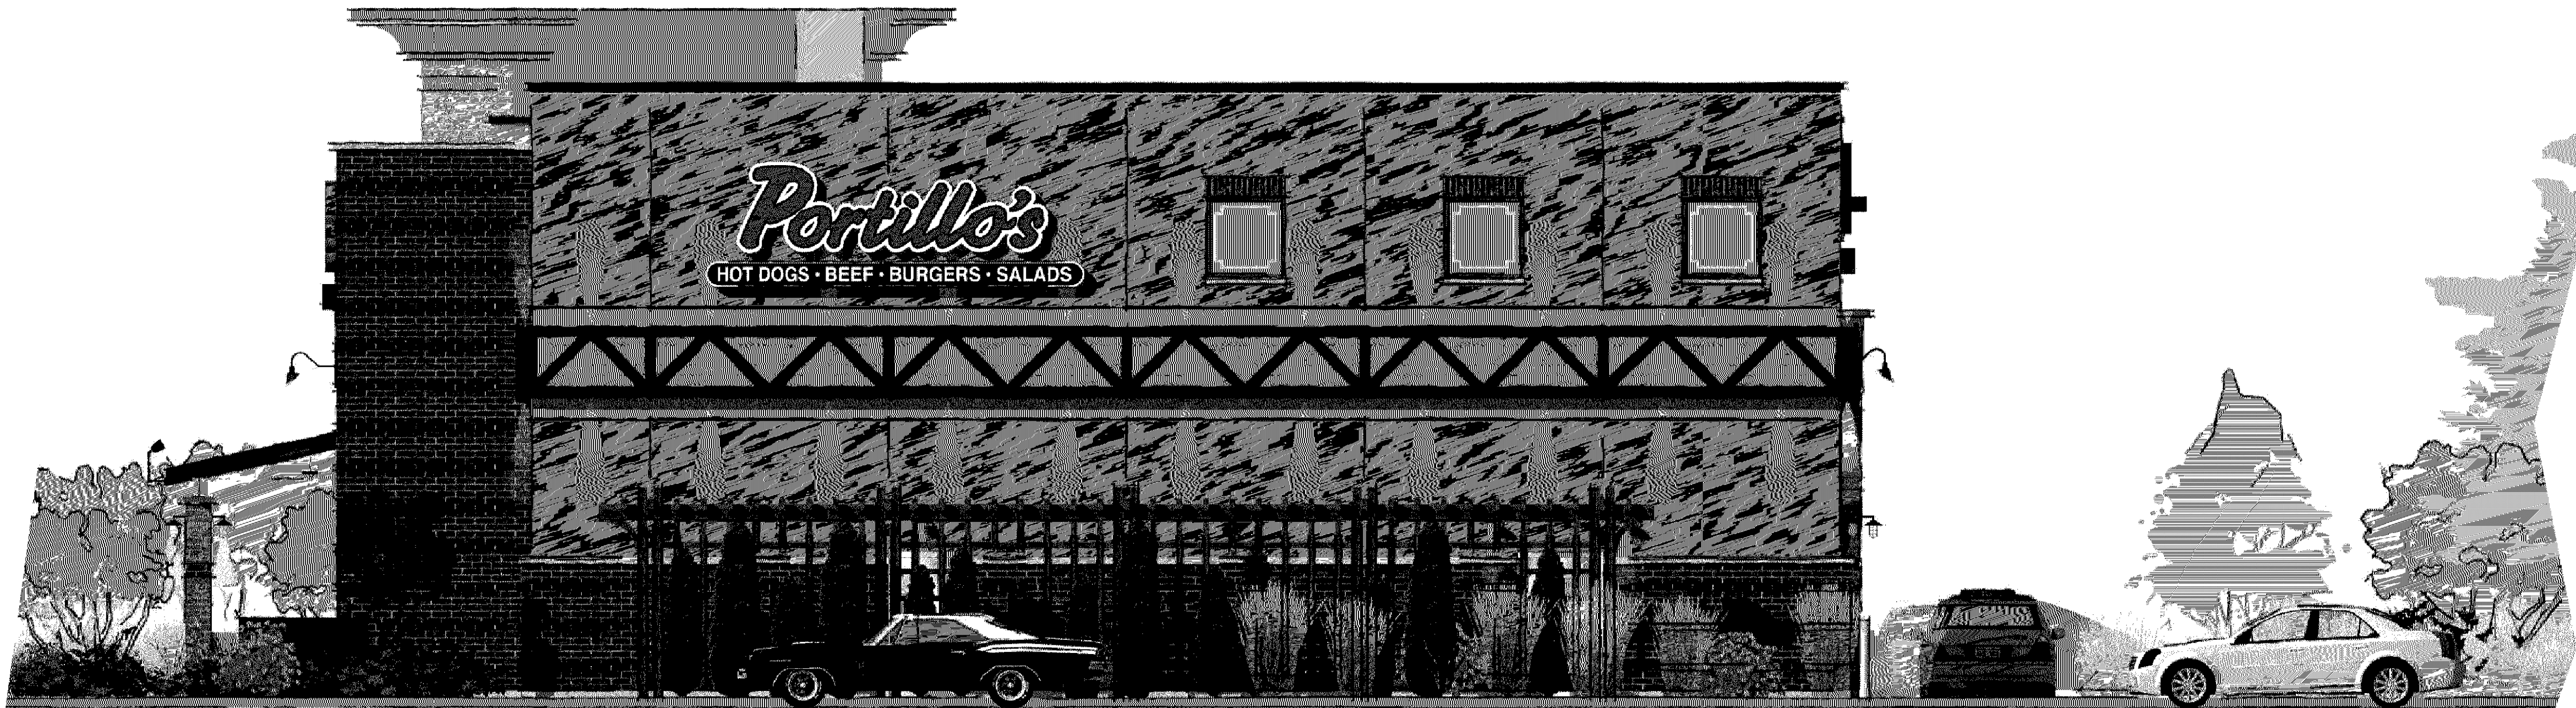


1 EAST - REAR ELEVATION
A-4.1 Scale: 3/16" = 1'-0"

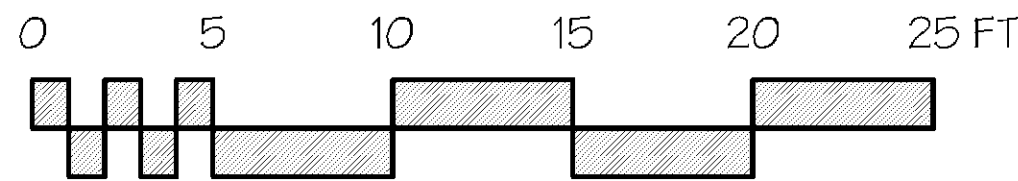

2 NORTH - DRIVE THRU ELEVATION
A-4.1 Scale: 3/16" = 1'-0"

© 2018 MERCURY STUDIOS, INC. ALL RIGHTS RESERVED. THIS DOCUMENT IS THE PROPERTY OF MERCURY STUDIOS, INC. AND IS NOT TO BE REPRODUCED OR TRANSMITTED IN ANY FORM OR BY ANY MEANS, ELECTRONIC OR MECHANICAL, WITHOUT PERMISSION IN WRITING FROM MERCURY STUDIOS, INC.

MERCURY STUDIOS, INC.
2548 W. CORTEZ ST. CHICAGO, IL 60622
Ph 773-395-8216 Fax 773-395-8218 merstudio@aol.com

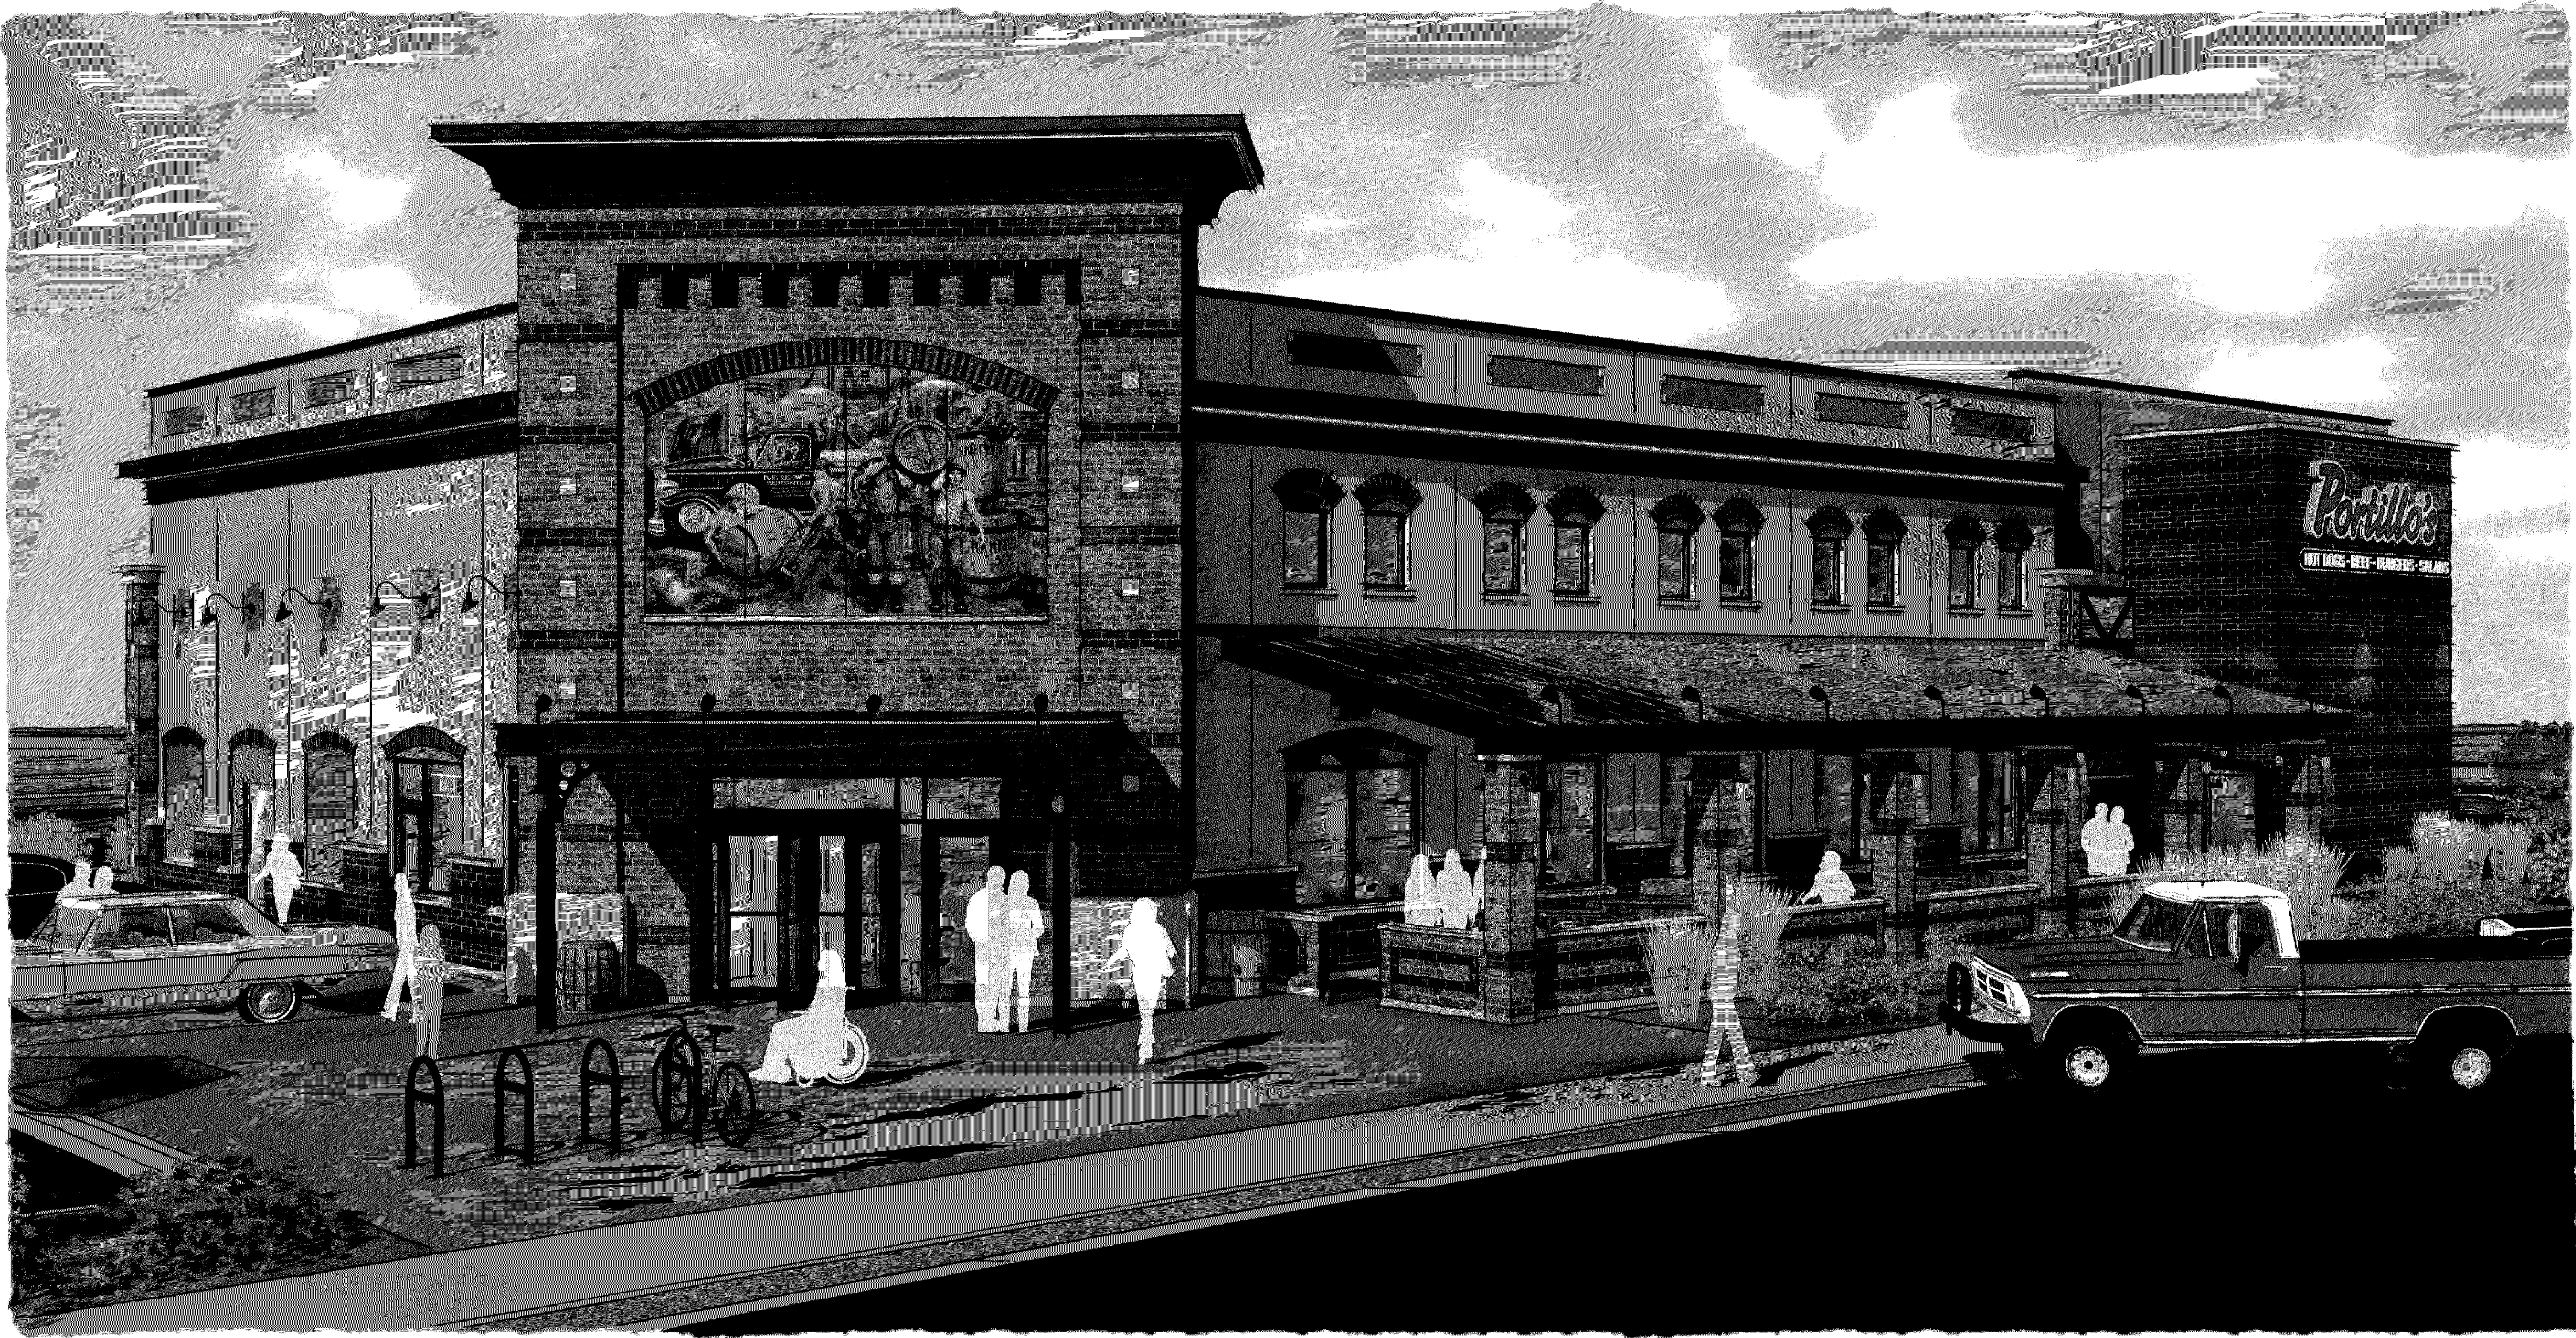

PROJECT

PORTILLO'S HOT DOGS
BLOOMINGTON, MN

SHEET TITLE

PERSPECTIVE

SCALE

N.T.S.

DATE

8-10-18
REV. 9-10-18
REV. 9-12-18
REV. 9-20-18
REV. 10-2-18

DRAWN BY

 
SHEET

© 2018 MERCURY STUDIOS, INC. ALL RIGHTS RESERVED. THIS DOCUMENT IS THE PROPERTY OF MERCURY STUDIOS, INC. AND IS NOT TO BE REPRODUCED OR TRANSMITTED IN ANY FORM OR BY ANY MEANS, ELECTRONIC OR MECHANICAL, WITHOUT PERMISSION IN WRITING FROM MERCURY STUDIOS, INC.




BLOOMINGTON, MN

EXTERIOR FINISHES




(PT-3)
SW6991 "BLACK MAGIC"

WROUGHT IRON

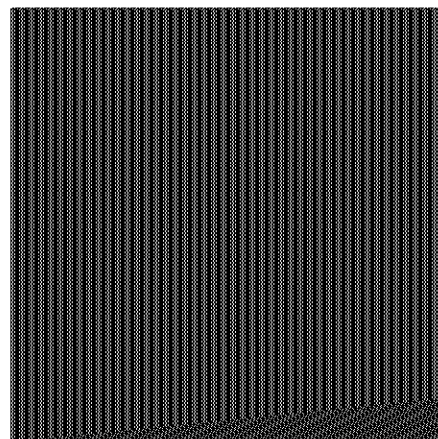

(PT-11)
SW6461 "ISLE OF PINE"


 
TRIM COLOR




PAC-CLAD FOREST GREEN

ALUM. BREAK METAL

CULTURED LIMESTONE

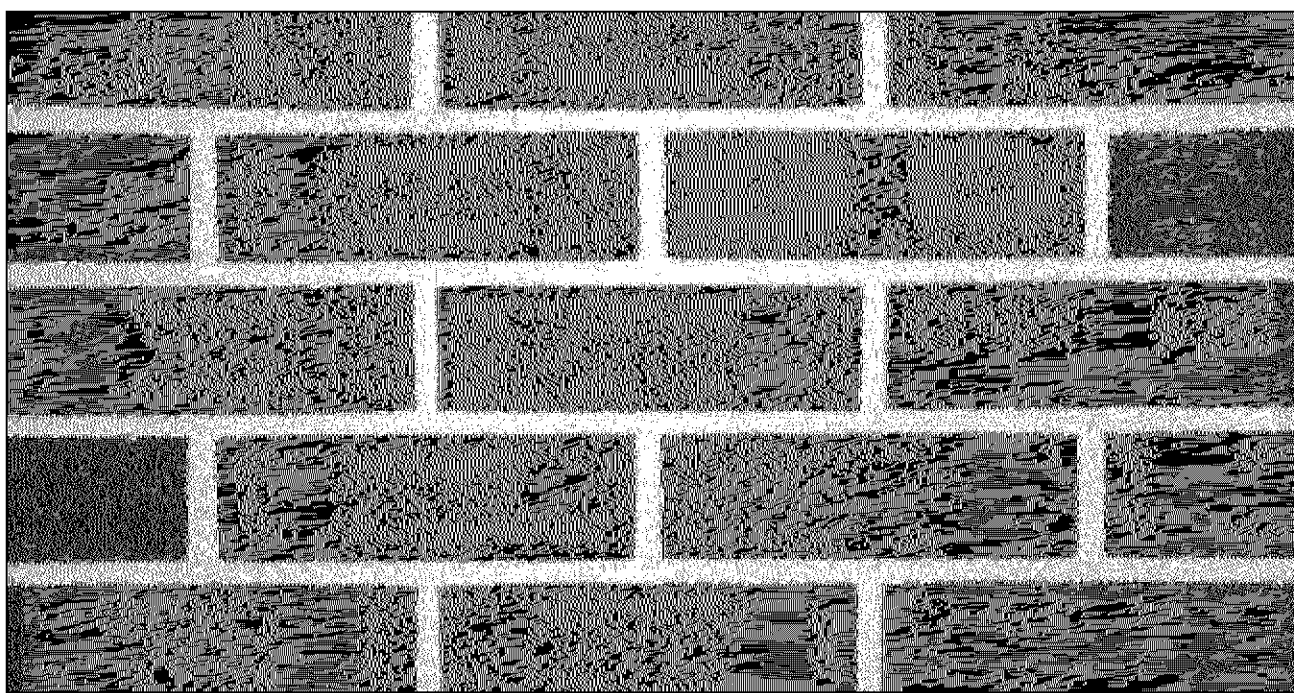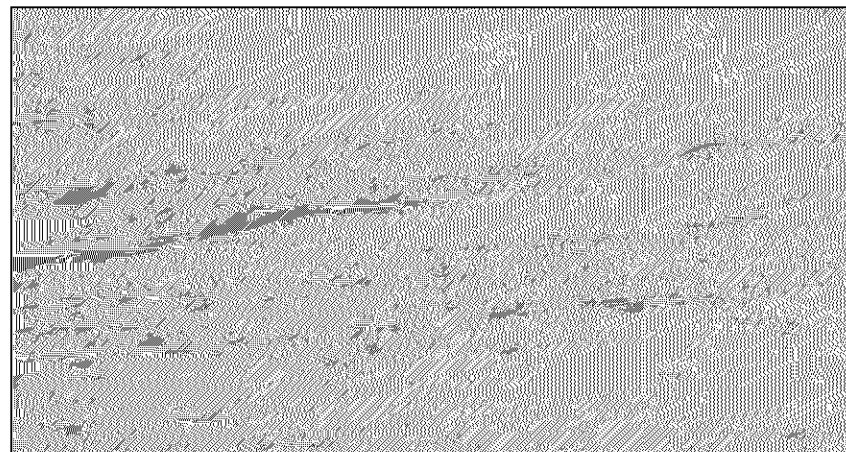


BR-1
SIOUX CITY BRICK - SAVANNAH
WELLINGTON

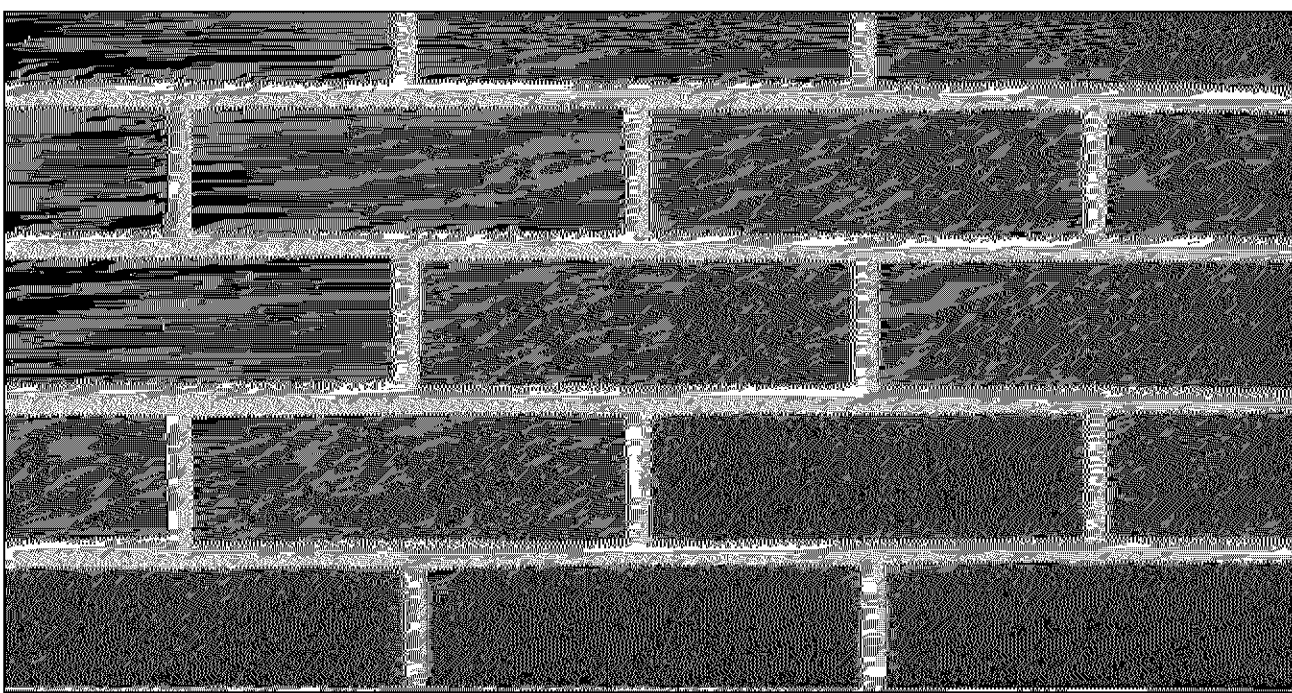


BR-4
SIOUX CITY BRICK - BROWN
SMOOTH



BR-2
SIOUX CITY BRICK - SMOKED TUDOR

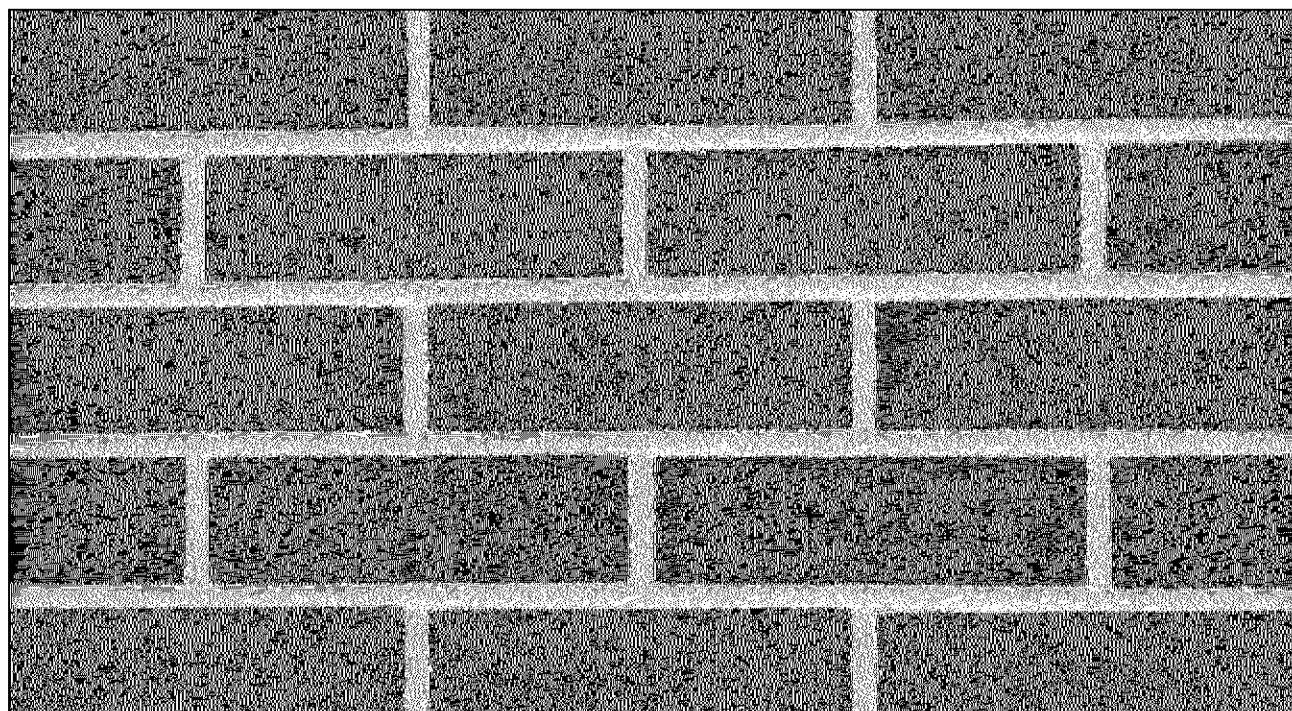


BR-3
SIOUX CITY BRICK - EBONITE
SMOOTH

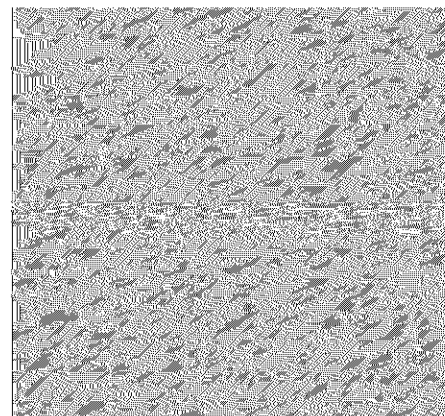


(PT-16) SW6374
"TORCHLIGHT"

FRONT FIELD COLOR

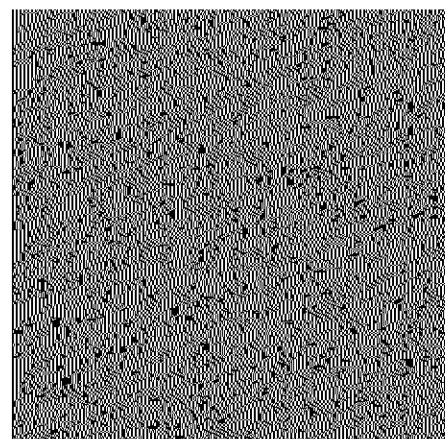

(PT-17) SW2861
"AVOCADO"

REAR FIELD COLOR

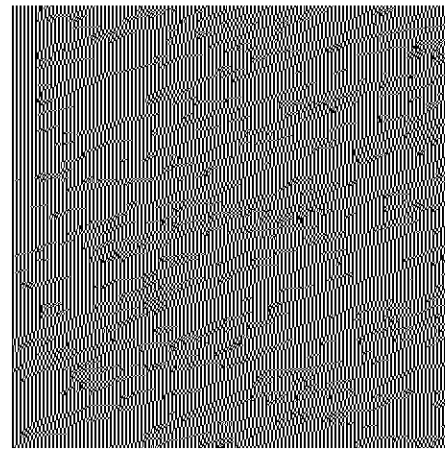

(PT-18) SW6355
"TRUE PENNY"

FRONT ACCENT COLOR
REAR FIELD COLOR

GALVANIZED ROOFING

