








CASE #PL2020-79

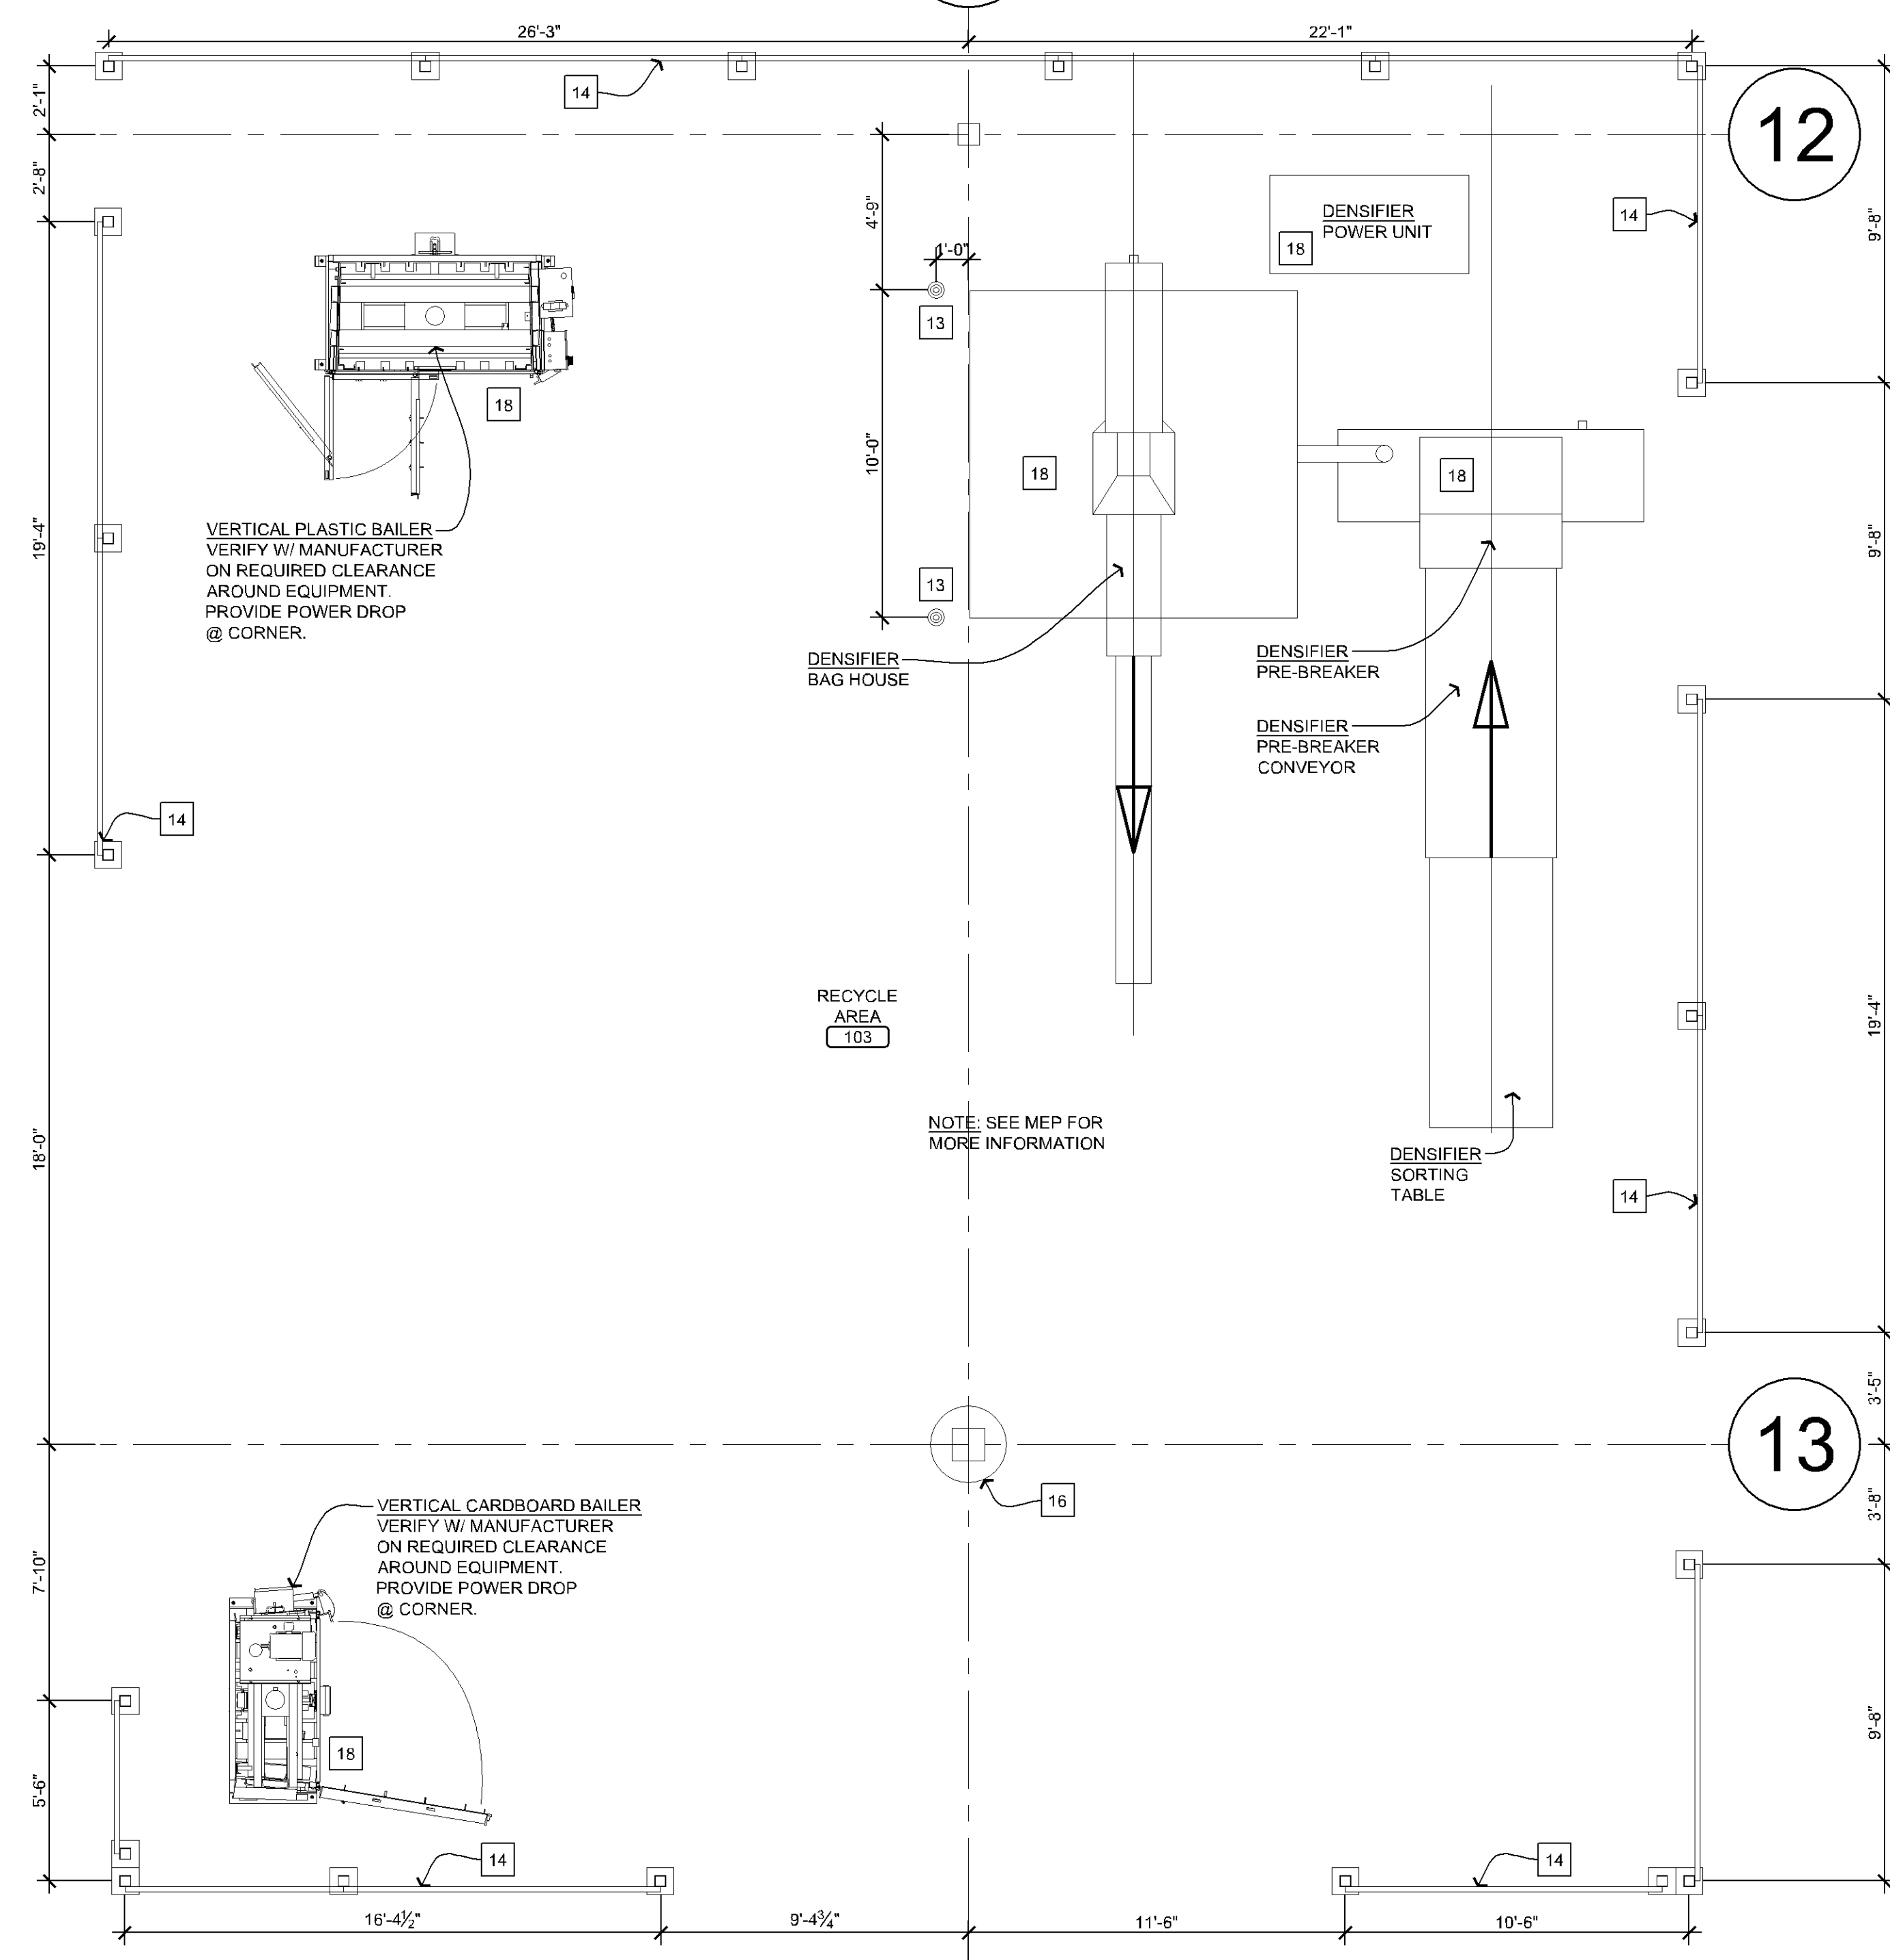


1 ENLARGED NEW FLOOR PLAN  
SCALE: 1/4" = 1'-0"

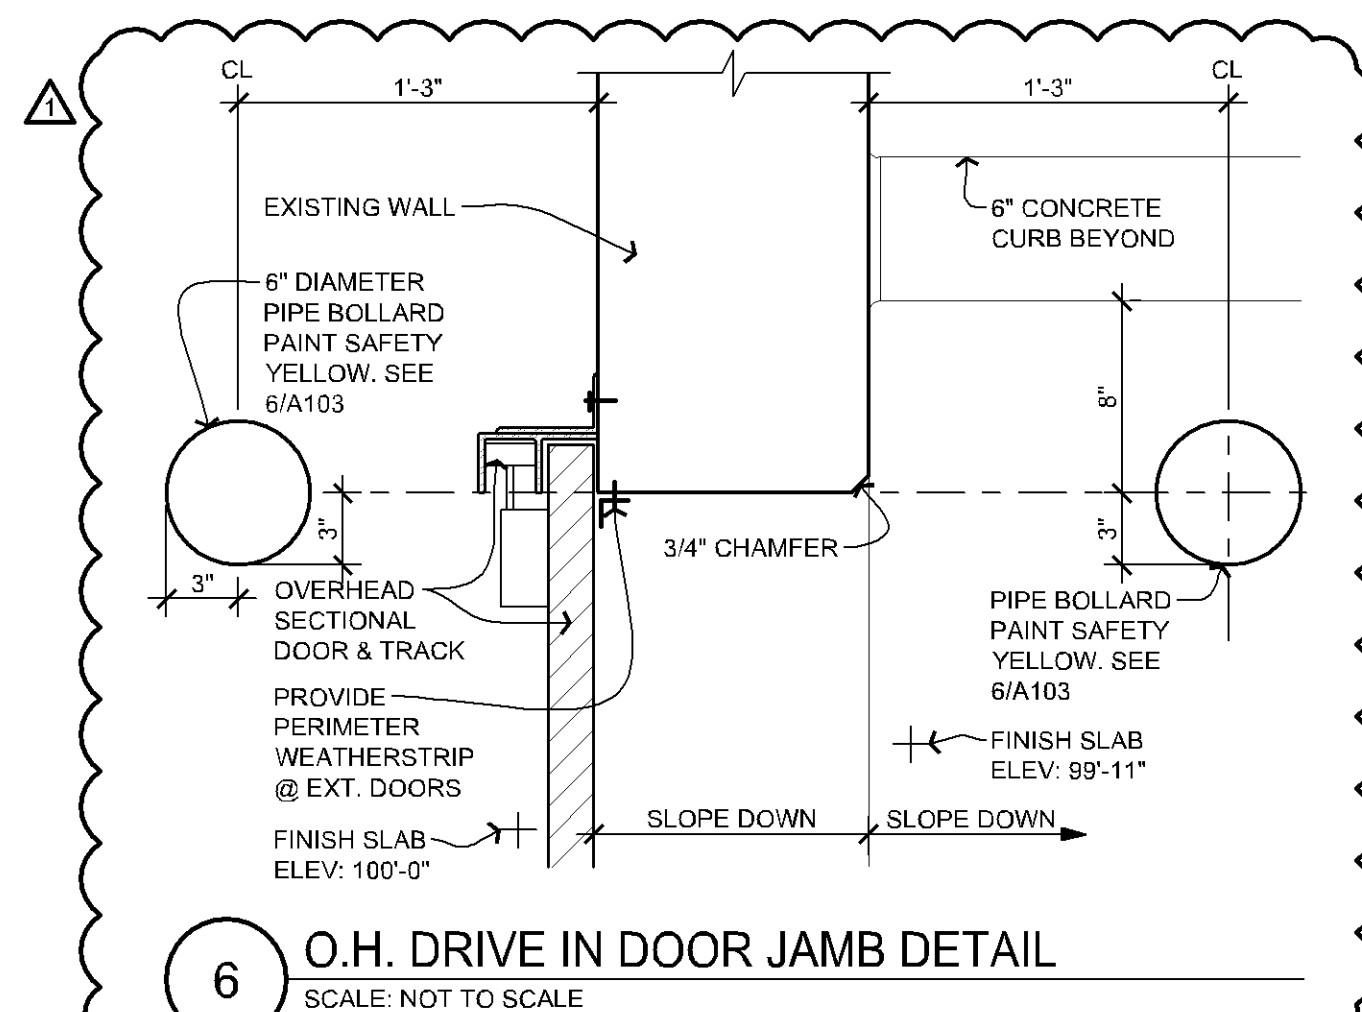


4 ENLARGED RECYCLING AREA  
SCALE: 1/4" = 1'-0"

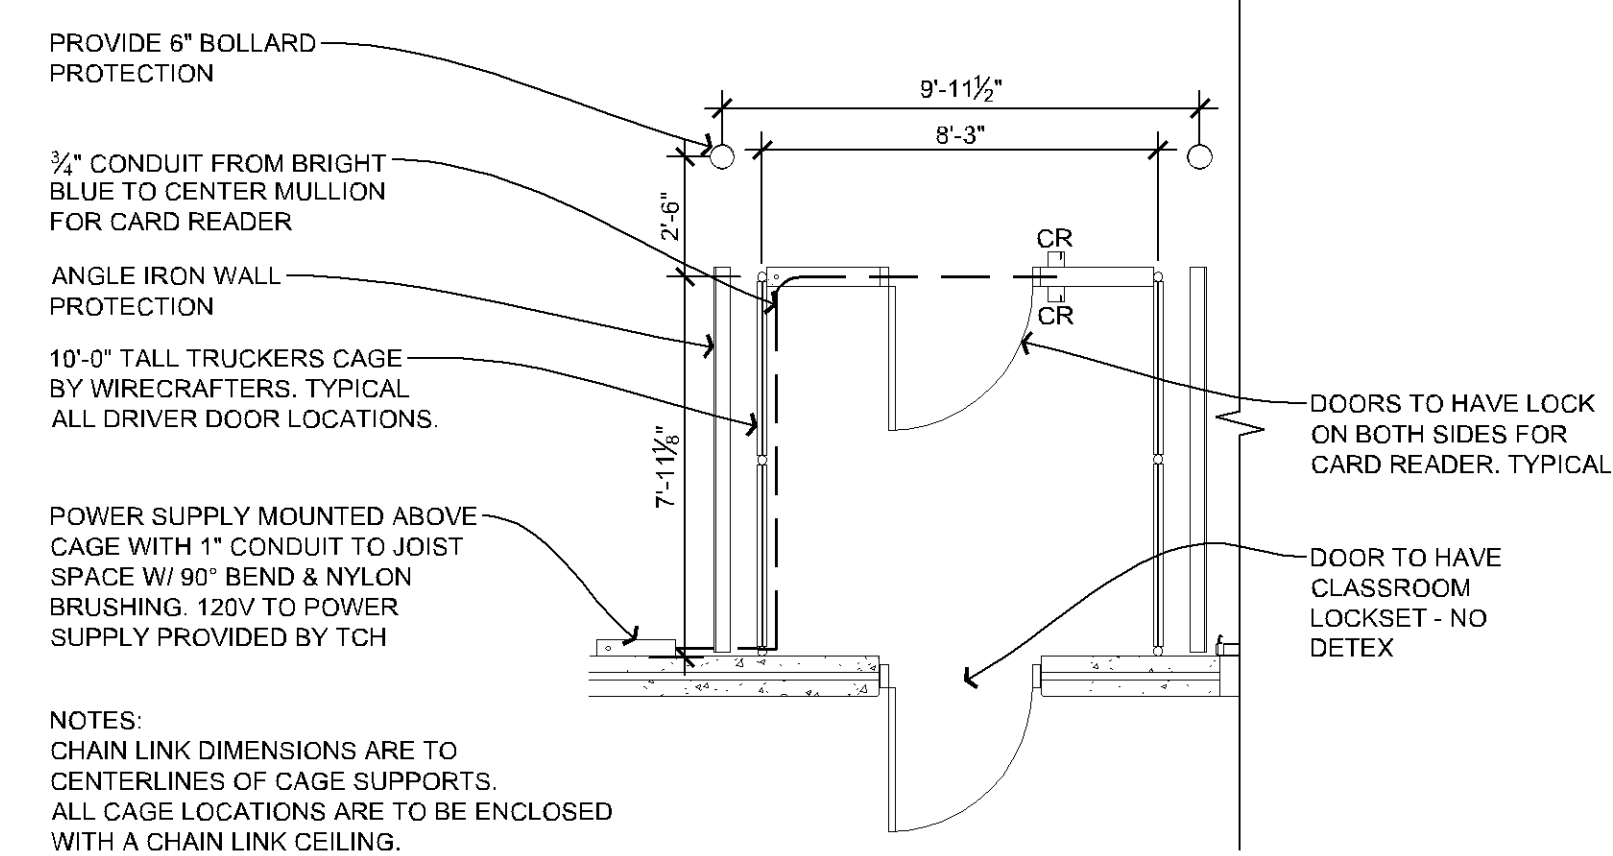


5 TRUCKER'S CAGE DOORS  
SCALE: 1/4" = 1'-0"

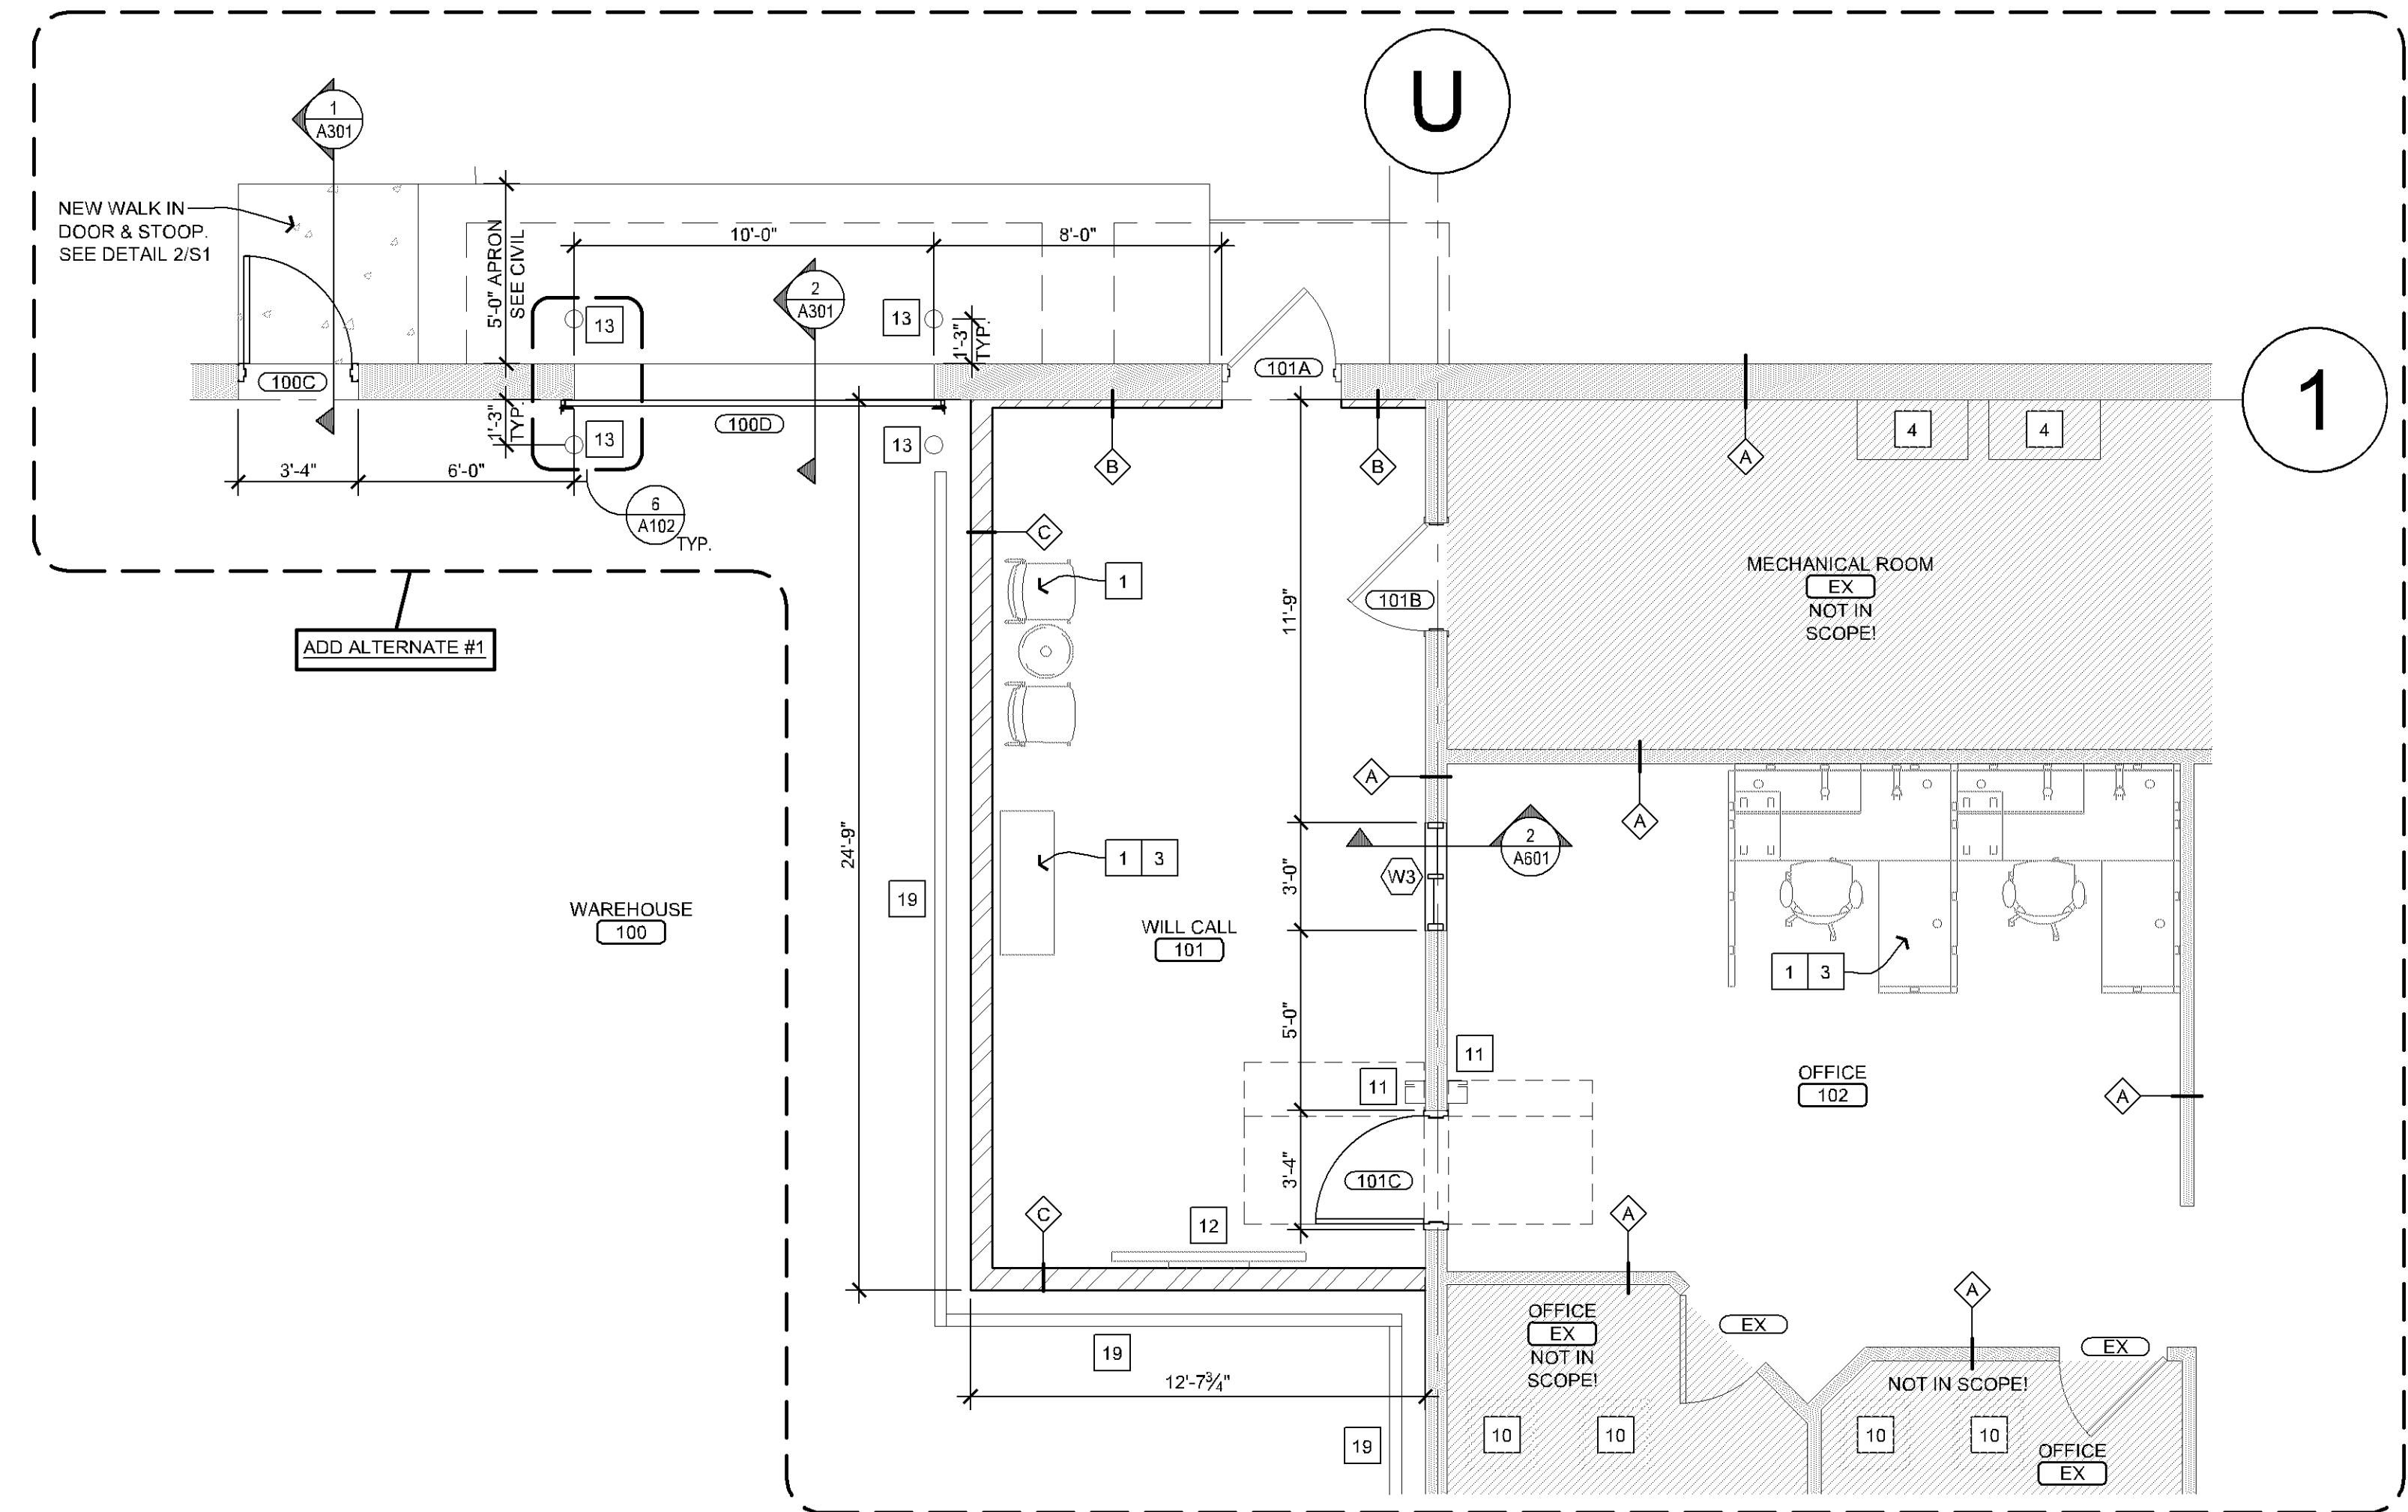

2 ENLARGED NEW FLOOR PLAN  
SCALE: 1/4" = 1'-0"

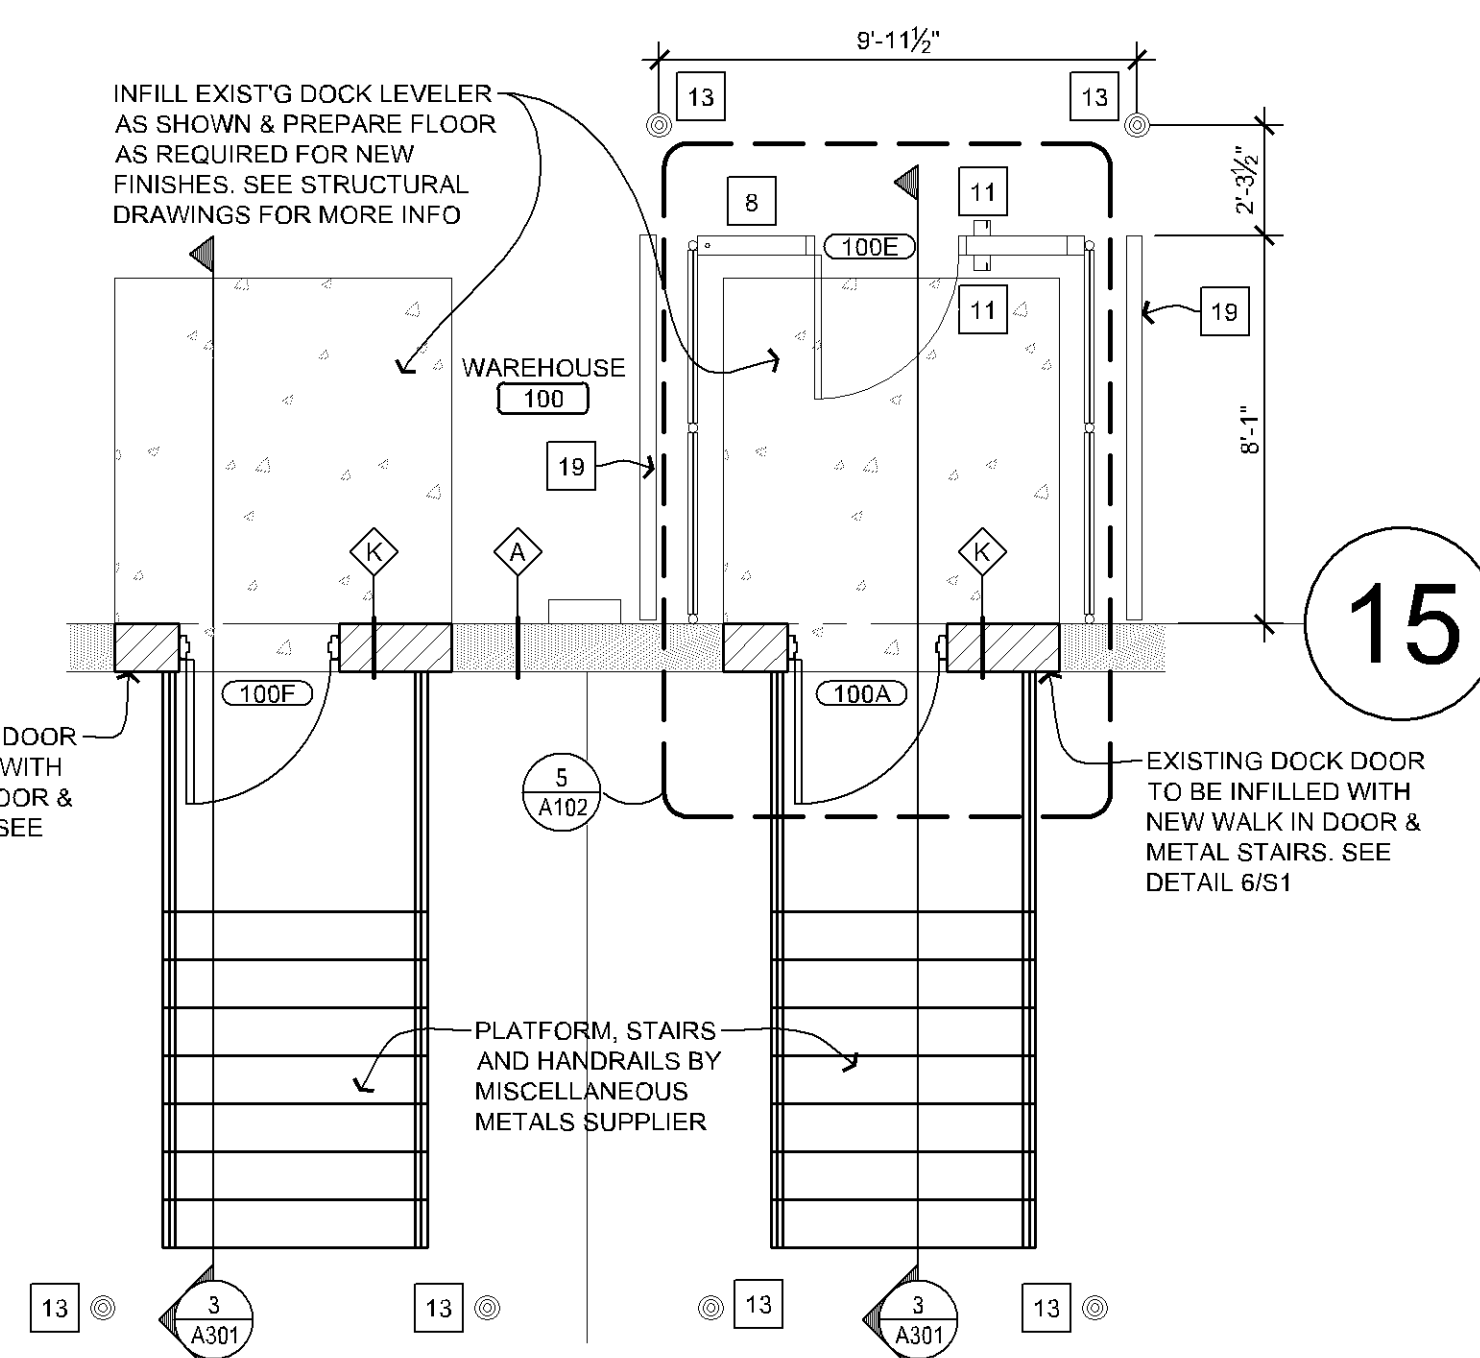

3 ENLARGED NEW FLOOR PLAN  
SCALE: 1/4" = 1'-0"

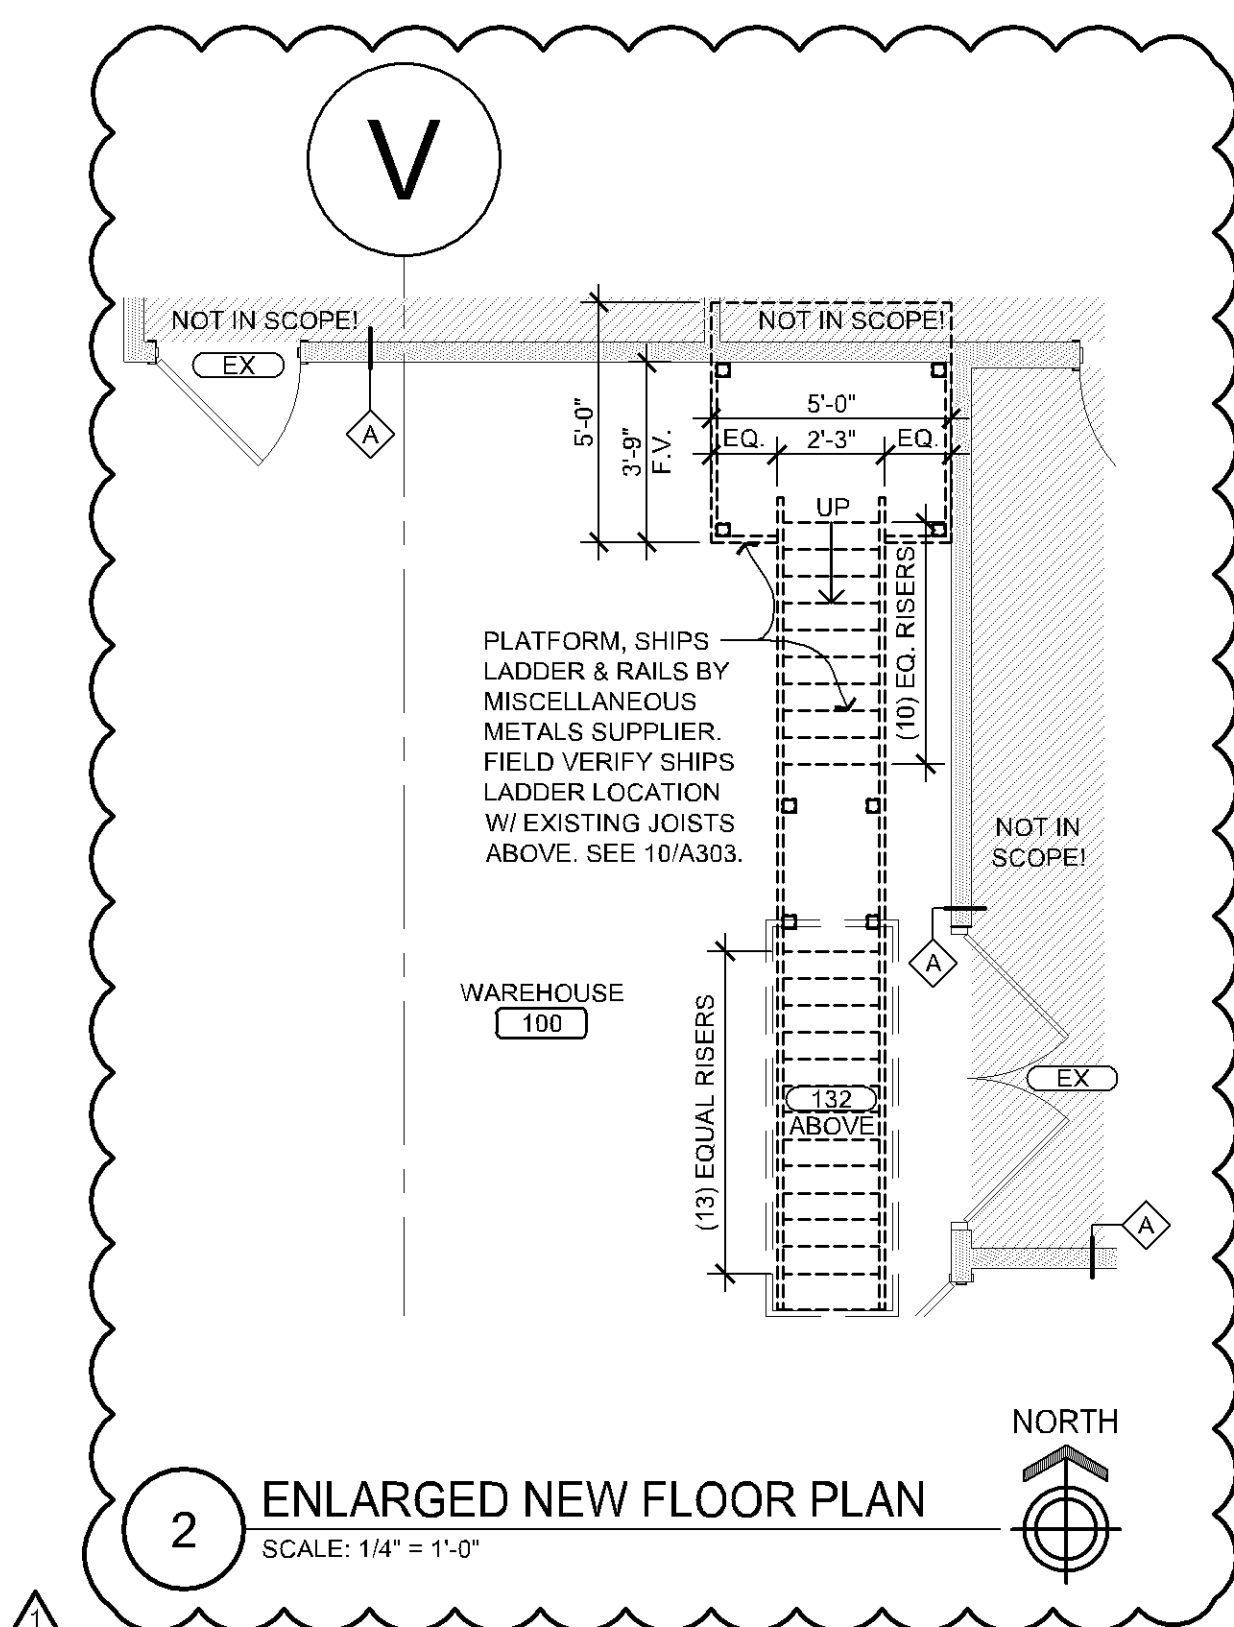

4 ENLARGED NEW FLOOR PLAN  
SCALE: 1/4" = 1'-0"

WALL LEGEND	
	EXISTING WALL
	EXISTING CONDITIONS BY OTHERS TO REMAIN
	NEW FULL HEIGHT METAL STUD WALL
	NEW CMU WALL

- GENERAL NOTES**
- DO NOT SCALE THIS DRAWING IF THERE ARE ANY DISCREPANCIES CONTACT THE ARCHITECT PRIOR TO COMMENCING WORK.
  - G.C. TO VERIFY ALL DIMENSIONS AND NOTIFY ARCHITECT OF ANY DISCREPANCIES PRIOR TO CONSTRUCTION.
  - IF EXISTING EXTERIOR THRESHOLD EXCEEDS ADA MAXIMUM HEIGHT OF 1/2" REMOVE AND REPLACE WITH ACCESSIBLE THRESHOLD. RAISED THRESHOLDS AND FLOOR LEVEL CHANGES AT ACCESSIBLE DOORWAYS TO BE BEVELED WITH A SLOPE NO GREATER THAN 1:12 LOCATION WITH TENANT.
  - G.C. TO PROVIDE ALL WALL BLOCKING AND BACKING. VERIFY LOCATION WITH TENANT.
  - G.C. TO PROVIDE AND INSTALL NON COMBUSTIBLE WOOD BACKING WHEN REQUIRED BY CODE.
  - PAINTING OF ALL WALL SURFACES TO BE COMPLETED PRIOR TO THE INSTALLATION OF ANY WALL TRIM OR PANELING.
  - REMOVAL OF EXCESS GROUT WILL BE DONE WITH WATER. THE USE OF SULFURIC OR MURIATIC ACID IS PROHIBITED. IF THESE ACIDS ARE USED, THE INSTALLER WILL BE REQUIRED TO REMOVE THE ACID AND RESTORE THE GROUT AT THEIR EXPENSE (IF APPLICABLE).
  - G.C. SHALL DOCUMENT AS-BUILT INSTALLATION CONDITIONS & PROVIDE OWNER WITH AS-BUILT DRAWINGS AT PROJECT COMPLETION.
  - ALL GYPSUM BOARD TO BE PREPARED TO LEVEL 4 FINISH STANDARDS PER GYPSUM ASSOCIATION STANDARDS.
  - ALL FIXTURES/FURNITURE IS TENANT SUPPLIED AND INSTALLED. UNO
  - USE CEMENT BOARD AT ALL WALL TILE LOCATIONS.
  - ALL TILE TO BE INSTALLED PER TILE COUNCIL OF AMERICA STANDARDS.
  - FLOOR SLAB IS TO BE PINNED AND TRENCHING COMPACTED PRIOR TO POURING BACK AFTER UNDERGROUND PLUMBING.

- KEY NOTES**
- NEW FURNITURE
  - NEW COUNTER/MILLWORK
  - NEW EQUIPMENT
  - EXISTING ELECTRICAL EQUIPMENT TO REMAIN
  - EXISTING GUARDRAIL TO REMAIN
  - EXISTING EQUIPMENT TO REMAIN
  - SOFT BARRIER/CURTAIN
  - NEW TRUCKERS CAGE BY WIRECRAFTERS. SEE 5A102.
  - NEW CLOSET SHELF
  - EXISTING GUARDRAIL TO REMAIN
  - NEW CARD READER
  - NEW TV W/ WOOD BLOCKING
  - COORDINATE W/ ELECTRICAL
  - NEW 8" PIPE BOLLARD, PAINT SAFETY YELLOW. SEE 6A103
  - NEW GUARDRAIL OR REDEFINE EXISTING GUARDRAIL
  - NEW DRINKING FOUNTAIN W/ BOTTLE FILLER
  - NEW 4" HIGH CONCRETE COLUMN PROTECTION
  - NEW HOLLMAN CCL LAMINATE LOCKERS, (4) UNITS W/ KEYPAD ACCESS
  - EXISTING EQUIPMENT RELOCATED
  - NEW ANGLE IRON WALL PROTECTION. SEE 4A103.
  - NEW CONCRETE SLAB INFILL. SEE PLUMBING DRAWINGS & DETAIL S154 FOR MORE INFORMATION.
  - PATCH & REPAIR EXISTING SLAB INFILL AS REQUIRED FOR NEW FINISHES.
  - COORDINATE EXACT LOCATIONS WITH BEST BUY CONSTRUCTION MANAGER.
  - BRAKE METAL AT COLUM TO MATCH ADJACENT WINDOW RAIL. FINISH VERIFY FINISH TO MATCH GR. BLACK ANDODDED
  - APS RESOURCE POLY COLUMN PROTECTOR
  - STEEL BENT PLATE COLUMN PROTECTION BY MISCELLANEOUS METALS SUPPLIER. COORDINATE SIZING DETAILS W/ BEST BUY CONST. MANAGER.
  - WALLS TO HAVE THE TOP & BOTTOM TRACKS. PENETRATIONS SEALED W/ ACoustical SEALANT. JUNCTION BOXES SHOULD BE STAGGERED & SEALED.
  - HIGHLIGHTED WALLS SHOULD HAVE ACoustical SEALANT AT BOTTOM
  - TRACK AND RAIL EXTENSION. SEE 6A103 BY SENTRY OR EQUAL. VERIFY FINAL LOCATIONS MAINTAIN 75" MAXIMUM SPACING.
  - 3"x3"x3/8" STEEL ANGLE ANCHORED TO FLOOR 12" O.C. PAINT BLACK. SEE DETAIL 7A103.

WALL TYPES					
	EXISTING WALL - PATCH AND REPAIR AS REQUIRED AND PREP FOR NEW FINISHES		3-5/8" METAL STUDS @ 16" O.C. TO 12'-0" AFF. PROVIDE SOUND BATT INSULATION.		6" 14 GA. METAL STUDS @ 12" O.C. OFFICE SIDE: 5/8" GYP. BD. FROM FLOOR TO DECK. WAREHOUSE SIDE: 5/8" GYP. BD. FROM FLOOR TO 12'-0" AFF.
	EXISTING EXT. WALL W/ 1-5/8" METAL STUDS @ 16" O.C.		BOTH SIDES: 5/8" GYP. BD. FROM FLOOR TO 12'-0" AFF. WALLS SEALED ONLY.		6" 14 GA. METAL STUDS @ 12" O.C. PROVIDE SOUND BATT INSULATION.
	OFFICE SIDE: RIGID INSUL. 4 MIL. POLY VAPOR BARRIER. 5/8" GYP. BD. FROM FLOOR TO 6" ABOVE FINISH CEILING.		3-5/8" METAL STUDS @ 16" O.C. TO 12'-0" AFF. PROVIDE SOUND BATT INSULATION.		BOTH SIDES: 5/8" GYP. BD. FROM FLOOR TO DECK.
	OFFICE SIDE: 5/8" GYP. BD. FROM FLOOR TO 6" ABOVE FINISH CEILING.		OFFICE SIDE: 5/8" GYP. BD. FROM FLOOR TO 12'-0" AFF.		RESTROOM SIDE: 5/8" EXT. DENSGLASS BD. FROM FLOOR TO 6'-2" AFF & 5/8" GYP. BD. FROM 6'-2" AFF TO DECK.
	WAREHOUSE SIDE: 5/8" GYP. BD. FROM FLOOR TO DECK.		RESTROOM SIDE: 5/8" EXT. DENSGLASS BD. FROM FLOOR TO 6'-2" AFF & 5/8" GYP. BD. FROM 6'-2" AFF TO 6" ABOVE FINISH CEILING.		12" CMU - CORE FILLED W/ INSUL. FROM FLOOR TO TOP OF OPENING.
	3-5/8" METAL STUDS @ 16" O.C. TO 12'-0" AFF.		3-5/8" METAL STUDS @ STAGGERED 16" O.C. TO 12'-0" AFF. PROVIDE SOUND BATT INSULATION.		6" 14 GA. METAL STUDS @ 12" O.C. PROVIDE SOUND BATT INSULATION.
	BOTH SIDES: 5/8" GYP. BD. FROM FLOOR TO 12'-0" AFF.		BOTH SIDES: 5/8" EXT. DENSGLASS BD. FROM FLOOR TO 6'-2" AFF & 5/8" GYP. BD. FROM 6'-2" AFF TO 6" ABOVE FINISH CEILING.		BOTH SIDES: 5/8" GYP. BD. FROM FLOOR TO DECK.
	COMM ROOM SIDE: F.R.T. PLYWOOD, WALLS SEALED ONLY				

reprise

Architecture, Inc.

12400 Portland Avenue South

Suite 100, Portland Corporate Center

Office: (855) 232-4432

Fax: (855) 232-4432

DESIGN

Signature: [Signature]

06/01/20

10650

Registration Number

STARGATE - BLOOMINGTON

TENANT REMODELING IN EXISTING TENANT SPACE

6203 8<sup>TH</sup> WEST 11<sup>TH</sup> STREET

BLOOMINGTON, MN 55436

ENLARGED FLOOR PLANS & DETAILS

BEST BUY

DATE ISSUED: 05/22/20


PERMIT SET: 06/01/20

DRAWN BY: JPH/ND

CHECKED BY: JH

JOB NO.: 19246

A102

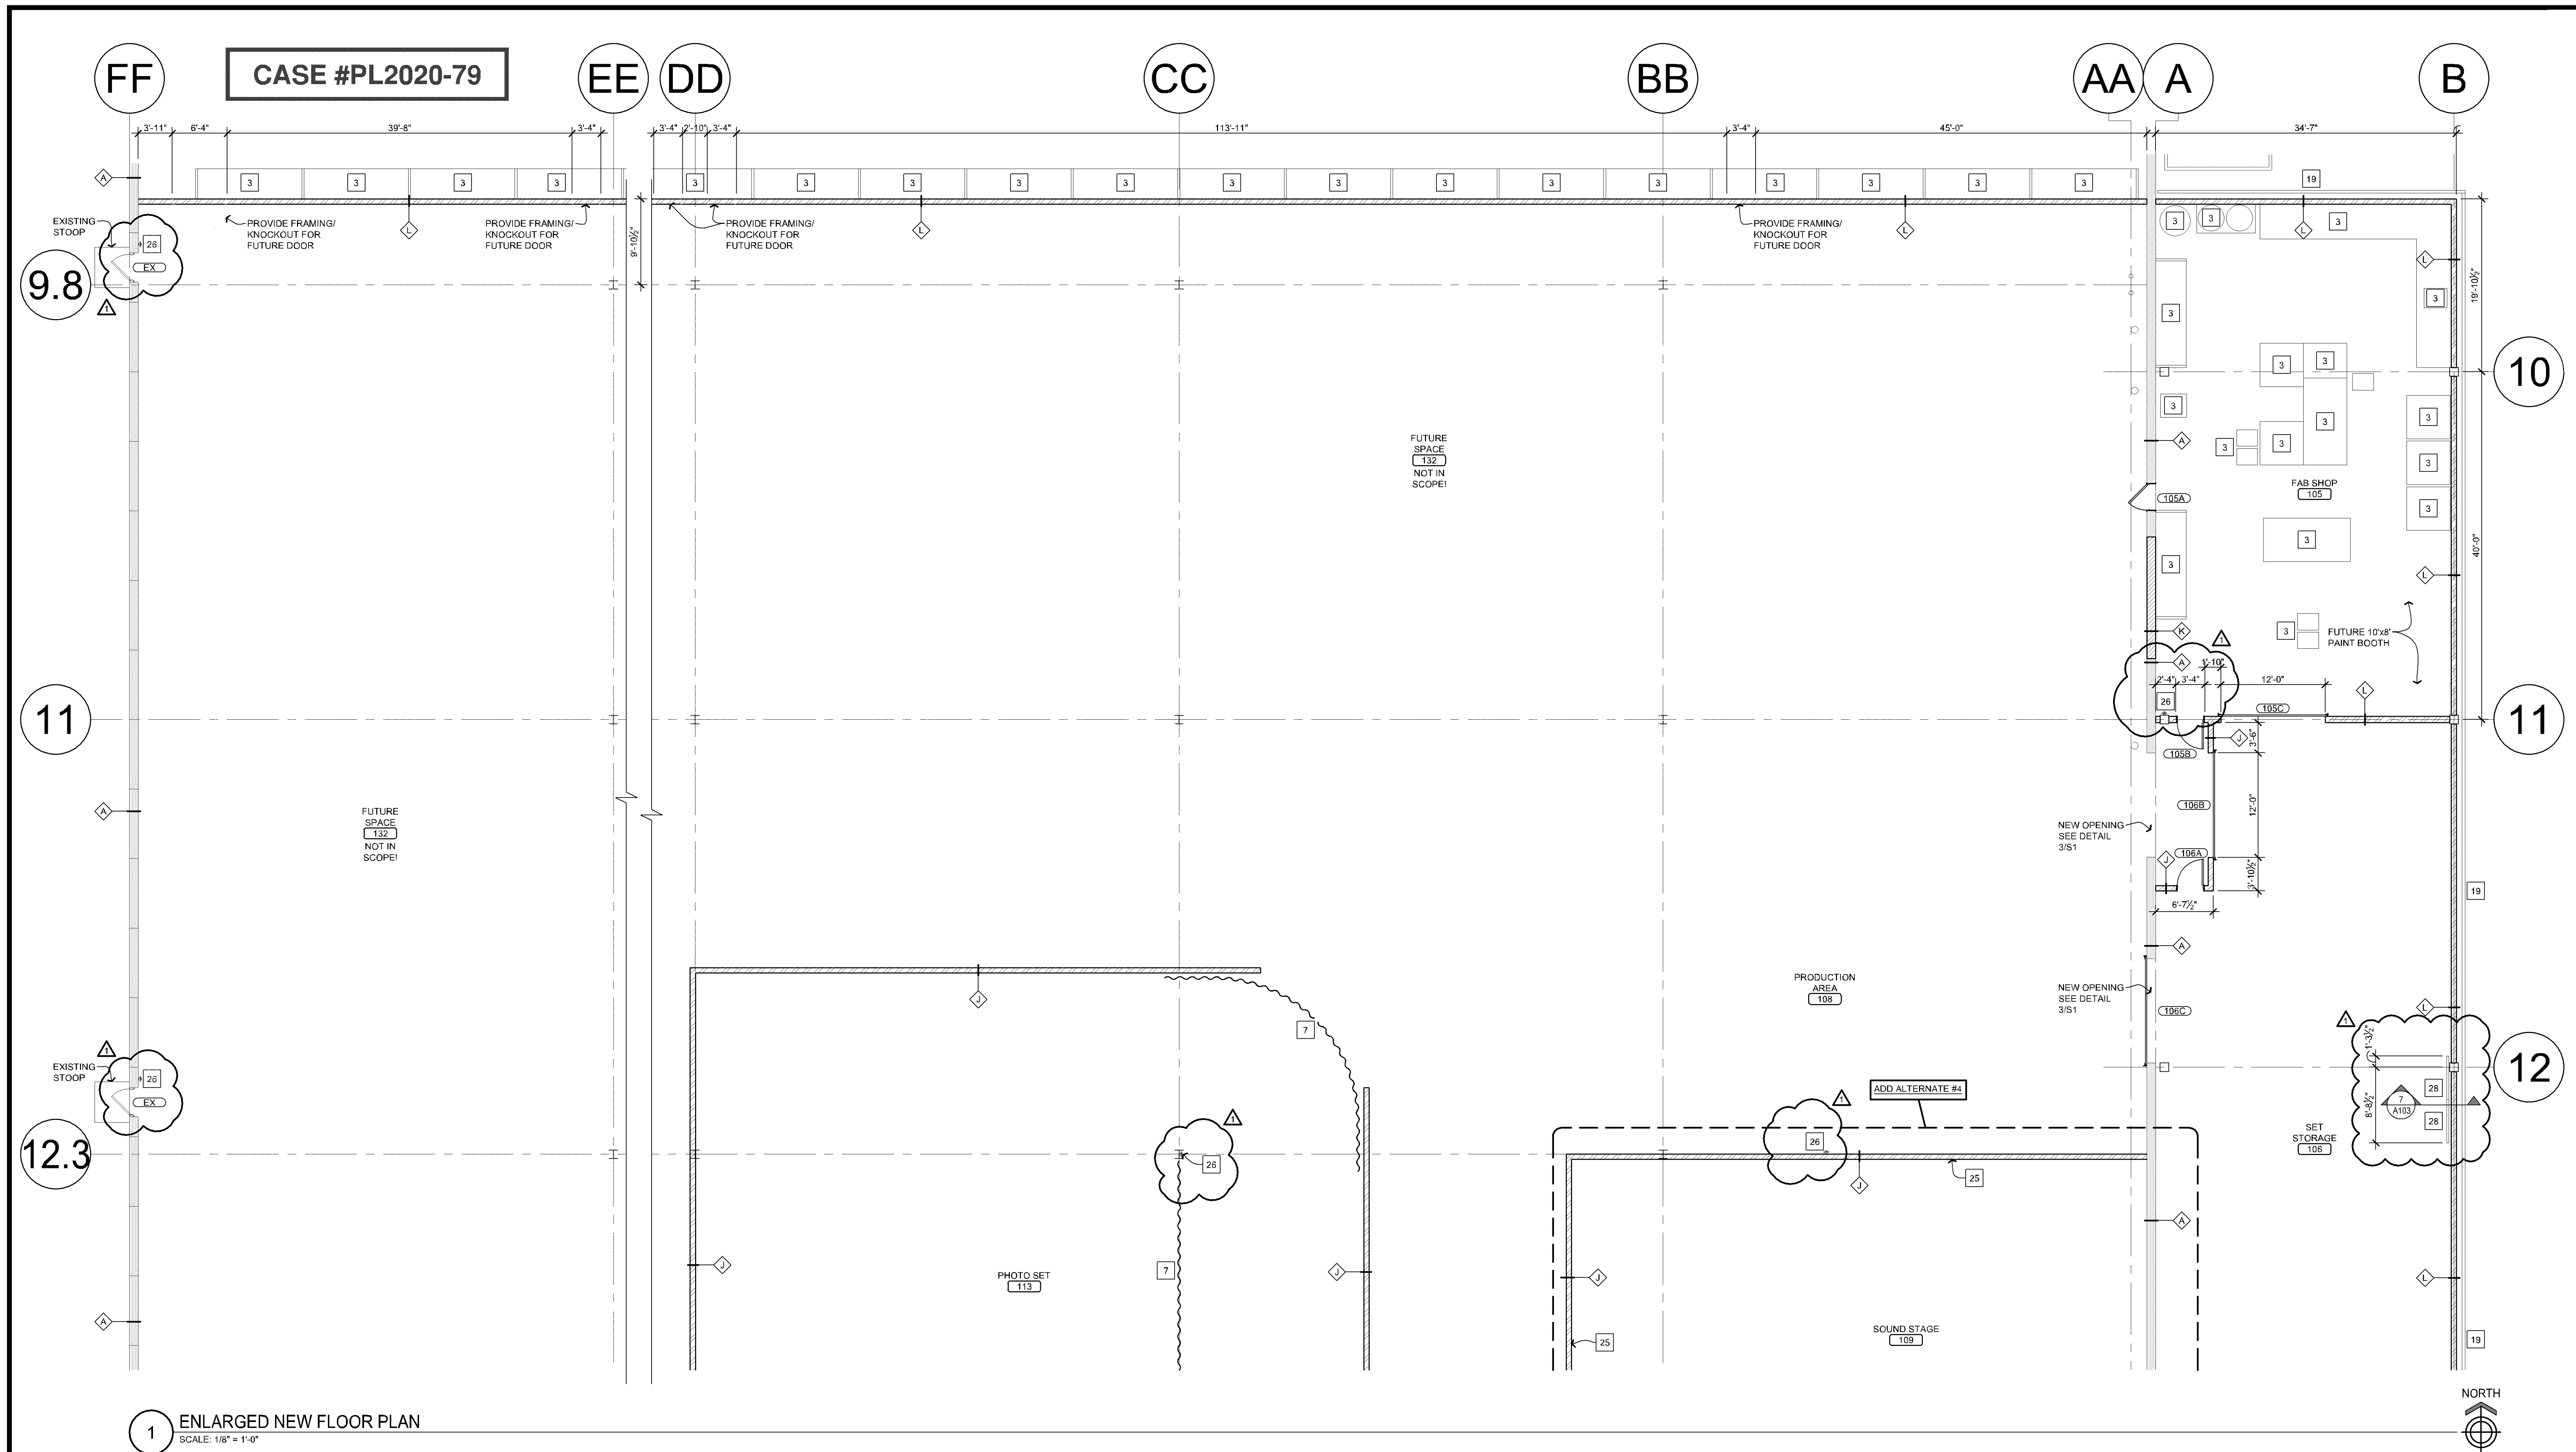

1 ENLARGED NEW FLOOR PLAN  
SCALE: 1/8" = 1'-0"

APPROVED  
Zoning Review Only  
08/06/2020 NMJ

#### GENERAL NOTES

- DO NOT SCALE THIS DRAWING IF THERE ARE ANY DISCREPANCIES CONTACT THE ARCHITECT PRIOR TO COMMENCING WORK.
- G.C. TO VERIFY ALL DIMENSIONS AND NOTIFY ARCHITECT OF ANY DISCREPANCIES PRIOR TO CONSTRUCTION.
- IF EXISTING EXTERIOR THRESHOLD EXCEEDS ADA MAXIMUM HEIGHT OF 1/2" REMOVE AND REPLACE WITH ACCESSIBLE THRESHOLD. RAISED THRESHOLDS AND FLOOR LEVEL CHANGES AT ACCESSIBLE DOORWAYS TO BE BEVELED WITH A SLOPE NO GREATER THAN 1:12.
- G.C. TO PROVIDE ALL WALL BLOCKING AND BACKING. VERIFY LOCATION WITH TENANT.
- G.C. TO PROVIDE AND INSTALL NON COMBUSTIBLE WOOD BACKING WHEN REQUIRED BY CODE.
- PAINTING OF ALL WALL SURFACES TO BE COMPLETED PRIOR TO THE INSTALLATION OF ANY WALL TRIM OR PANELING.
- REMOVAL OF EXCESS GROUT WILL BE DONE WITH WATER. THE USE OF SULFURIC OR MURIATIC ACID IS PROHIBITED. IF THESE ACIDS ARE USED, THE INSTALLER WILL BE REQUIRED TO REMOVE THE ACID AND RESTORE THE GROUT AT THEIR EXPENSE (IF APPLICABLE).
- G.C. SHALL DOCUMENT AS-BUILT INSTALLATION/CONDITIONS & PROVIDE OWNER WITH AS-BUILT DRAWINGS AT PROJECT COMPLETION.
- ALL GYPSUM BOARD TO BE PREPARED TO LEVEL 4 FINISH STANDARDS PER GYPSUM ASSOCIATION STANDARDS.
- ALL FIXTURES/FURNITURE IS TENANT SUPPLIED AND INSTALLED. UNO
- USE CEMENT BOARD AT ALL WALL TILE LOCATIONS.
- ALL TILE TO BE INSTALLED PER TILE COUNCIL OF AMERICA STANDARDS.
- FLOOR SLAB IS TO BE PINNED AND TRENCHING COMPACTED PRIOR TO POURING BACK AFTER UNDERGROUND PLUMBING.

#### WALL LEGEND

- EXISTING WALL/
- EXISTING CONDITIONS BY OTHERS TO REMAIN
- NEW FULL HEIGHT METAL STUD WALL
- NEW CMU WALL

#### KEY NOTES

- NEW FURNITURE
- NEW COUNTERMILLWORK
- NEW EQUIPMENT
- EXISTING ELECTRICAL EQUIPMENT TO REMAIN
- EXISTING GUARDRAIL TO REMAIN
- EXISTING EQUIPMENT TO REMAIN
- SOFT BARRIER/CURTAIN
- NEW TRUCKERS CAGE BY WIRECRAFTERS. SEE S&A102.
- NEW CLOSET SHELF
- EXISTING FURNITURE TO REMAIN
- NEW CARD READER
- NEW TV W/ WOOD BLOCKING. COORDINATE W/ ELECTRICAL
- NEW 6" PIPE BOLLARD, PAINT AS KEY YELLOW. SEE S&A103.
- NEW GUARDRAIL OR REPURPOSE EXISTING GUARDRAIL
- NEW DRINKING FOUNTAIN W/ BOTTLE FILLER
- NEW 4" HIGH CONCRETE COLUMN PROTECTION WALL. SEE S&A103.
- NEW HOLLMAN CCI LAMINATE LOCKERS, (4) UNITS W/ KEYPAD ACCESS
- EXISTING EQUIPMENT RELOCATED
- NEW ANGLE IRON WALL PROTECTION. SEE 4/A103.
- NEW CONCRETE SLAB INFILL. SEE PLUMBING DRAWINGS & DETAIL S&A FOR MORE INFORMATION.
- PATCH & REPAIR EXISTING SLAB INFILL AS REQUIRED FOR NEW FINISHES.
- COORDINATE EXACT LOCATIONS WITH BEST BUY CONSTRUCTION MANAGER.
- BRAKE METAL AT COLUMN TO MATCH ADJACENT WINDOW RAIL FINISH. VERIFY FINISH TO MATCH GR. BLACK ANODIZED
- APS RESOURCE POLY COLUMN PROTECTOR
- STEEL BENT PLATE COLUMN PROTECTION BY MISCELLANEOUS METALS SUPPLIER. COORDINATE SIZING DETAILS W/ BEST BUY CONST. MANAGER.
- WALLS TO HAVE THE TOP & BOTTOM TRACKS. PENETRATIONS SEALED W/ ACQUISICAL SEALANT. JUNCTION BOXES SHOULD BE STAGGERED & SEALED.
- HIGHLIGHTED WALLS SHOULD HAVE ACQUISICAL SEALANT AT BOTTOM TRACK AND WINDOW GLASS SEALS
- NEW FIRE EXTINGUISHERS (1) EACH BY SENTRY OR EQUAL. VERIFY FIRM LOCATIONS MAINTAIN 75' MAXIMUM SPACING.
- 3"x3"x8" STEEL ANGLE ANCHORED TO FLOOR 12" O.C. PAINT BLACK. SEE DETAIL 7A103.

#### WALL TYPES

EXISTING WALL - PATCH AND REPAIR AS REQUIRED AND PREP FOR NEW FINISHES	3-5/8" METAL STUDS @ 16" O.C. TO 12'-0" AFF. PROVIDE SOUND BATT INSULATION.	6" 14 GA. METAL STUDS @ 12" O.C.	EXISTING EXT. WALL W/ 3-5/8" METAL STUDS @ 16" O.C.
EXISTING EXT. WALL W/ 1-5/8" METAL STUDS @ 16" O.C.	BOTH SIDES: 5/8" GYP. BD. FROM FLOOR TO 12'-0" AFF. PROVIDE SOUND BATT INSULATION.	OFFICE SIDE: 5/8" GYP. BD. FROM FLOOR TO DECK.	OFFICE SIDE: 4 MIL. POLY VAPOR BARRIER, 5/8" GYP. BD. FROM FLOOR TO 6" ABOVE FINISH CEILING.
OFFICE SIDE: RIGID INSUL. 4 MIL. POLY VAPOR BARRIER, 5/8" GYP. BD. FROM FLOOR TO 6" ABOVE FINISH CEILING.	COMM ROOM SIDE: F. R.T. PLYWOOD, WALLS SEALED ONLY.	WAREHOUSE SIDE: 5/8" GYP. BD. FROM FLOOR TO 12'-0" AFF.	EDIT ROOM SIDE: 5/8" GYP. BD. TO 12'-0" AFF. PROVIDE SOUND BATT INSULATION.
6" 14 GA. METAL STUDS @ 12" O.C.	OFFICE SIDE: 5/8" GYP. BD. FROM FLOOR TO 6" ABOVE FINISH CEILING.	BOTH SIDES: 5/8" GYP. BD. FROM FLOOR TO DECK.	3-5/8" METAL STUDS @ 16" O.C. TO 12'-0" AFF. PROVIDE SOUND BATT INSULATION.
OFFICE SIDE: 5/8" GYP. BD. FROM FLOOR TO 6" ABOVE FINISH CEILING.	WAREHOUSE SIDE: 5/8" GYP. BD. FROM FLOOR TO DECK.	RESTROOM SIDE: 5/8" EXT. DENSGLASS BD. FROM FLOOR TO 6'-2" AFF & 5/8" GYP. BD. FROM 6'-2" AFF TO 6" ABOVE FINISH CEILING.	OFFICE SIDE: 5/8" GYP. BD. FROM FLOOR TO 12'-0" AFF.
3-5/8" METAL STUDS @ 16" O.C. TO 12'-0" AFF.	BOTH SIDES: 5/8" GYP. BD. FROM FLOOR TO DECK.	12" CMU - CORE FILLED W/ INSUL. FROM FLOOR TO TOP OF OPENING.	RESTROOM SIDE: 5/8" EXT. DENSGLASS BD. FROM FLOOR TO 4'-7" AFF & 5/8" GYP. BD. FROM 4'-7" AFF TO 6" ABOVE FINISH CEILING.
COMM ROOM SIDE: F. R.T. PLYWOOD, WALLS SEALED ONLY.	3-5/8" METAL STUDS @ STAGGERED 16" O.C. TO 12'-0" AFF. PROVIDE SOUND BATT INSULATION.	6" 14 GA. METAL STUDS @ 12" O.C. PROVIDE SOUND BATT INSULATION.	NOTE: G.C. TO PROVIDE ROUGH LUMBER, PLYWOOD BLOCKING, ETC. THAT IS PRESSURE TREATED FIRE RETARDANT WOOD BEARING U.L. LABELING WHERE REQUIRED.
RESTROOM SIDE: 5/8" EXT. DENSGLASS BD. FROM FLOOR TO 6'-2" AFF & 5/8" GYP. BD. FROM 6'-2" AFF TO 6" ABOVE FINISH CEILING.	BOTH SIDES: 5/8" GYP. BD. FROM FLOOR TO 12'-0" AFF.	BOTH SIDES: 5/8" GYP. BD. FROM FLOOR TO DECK.	

STARGATE - BLOOMINGTON  
TENANT REMODELING IN EXISTING TENANT SPACE  
6203 8<sup>TH</sup> WEST 11<sup>TH</sup> STREET  
BLOOMINGTON, MN 55436  
ENLARGED FLOOR PLANS

BEST BUY


DATE ISSUED  
PERMIT SET 05/22/20  
ADDENDUM 1 05/01/20  
DRAWN BY JPH/ND  
CHECKED BY JH  
JOB NO. 19246

A104

reprise Architecture, Inc.  
12400 Portland Avenue South  
Suite 100, Portland Corporate Center  
Office: (952) 220-4432  
Fax: (952) 220-4434  
DESIGN  
I hereby certify that this plan, specification or schedule was prepared by me or under my direct supervision and that I am a duly registered architect under the laws of the State of Minnesota.  
Signature: [Signature]  
Name: [Name]  
Registration Number: 18050  
Date: 08/01/20



**APPROVED**  
Zoning Review Only  
08/06/2020 NMJ

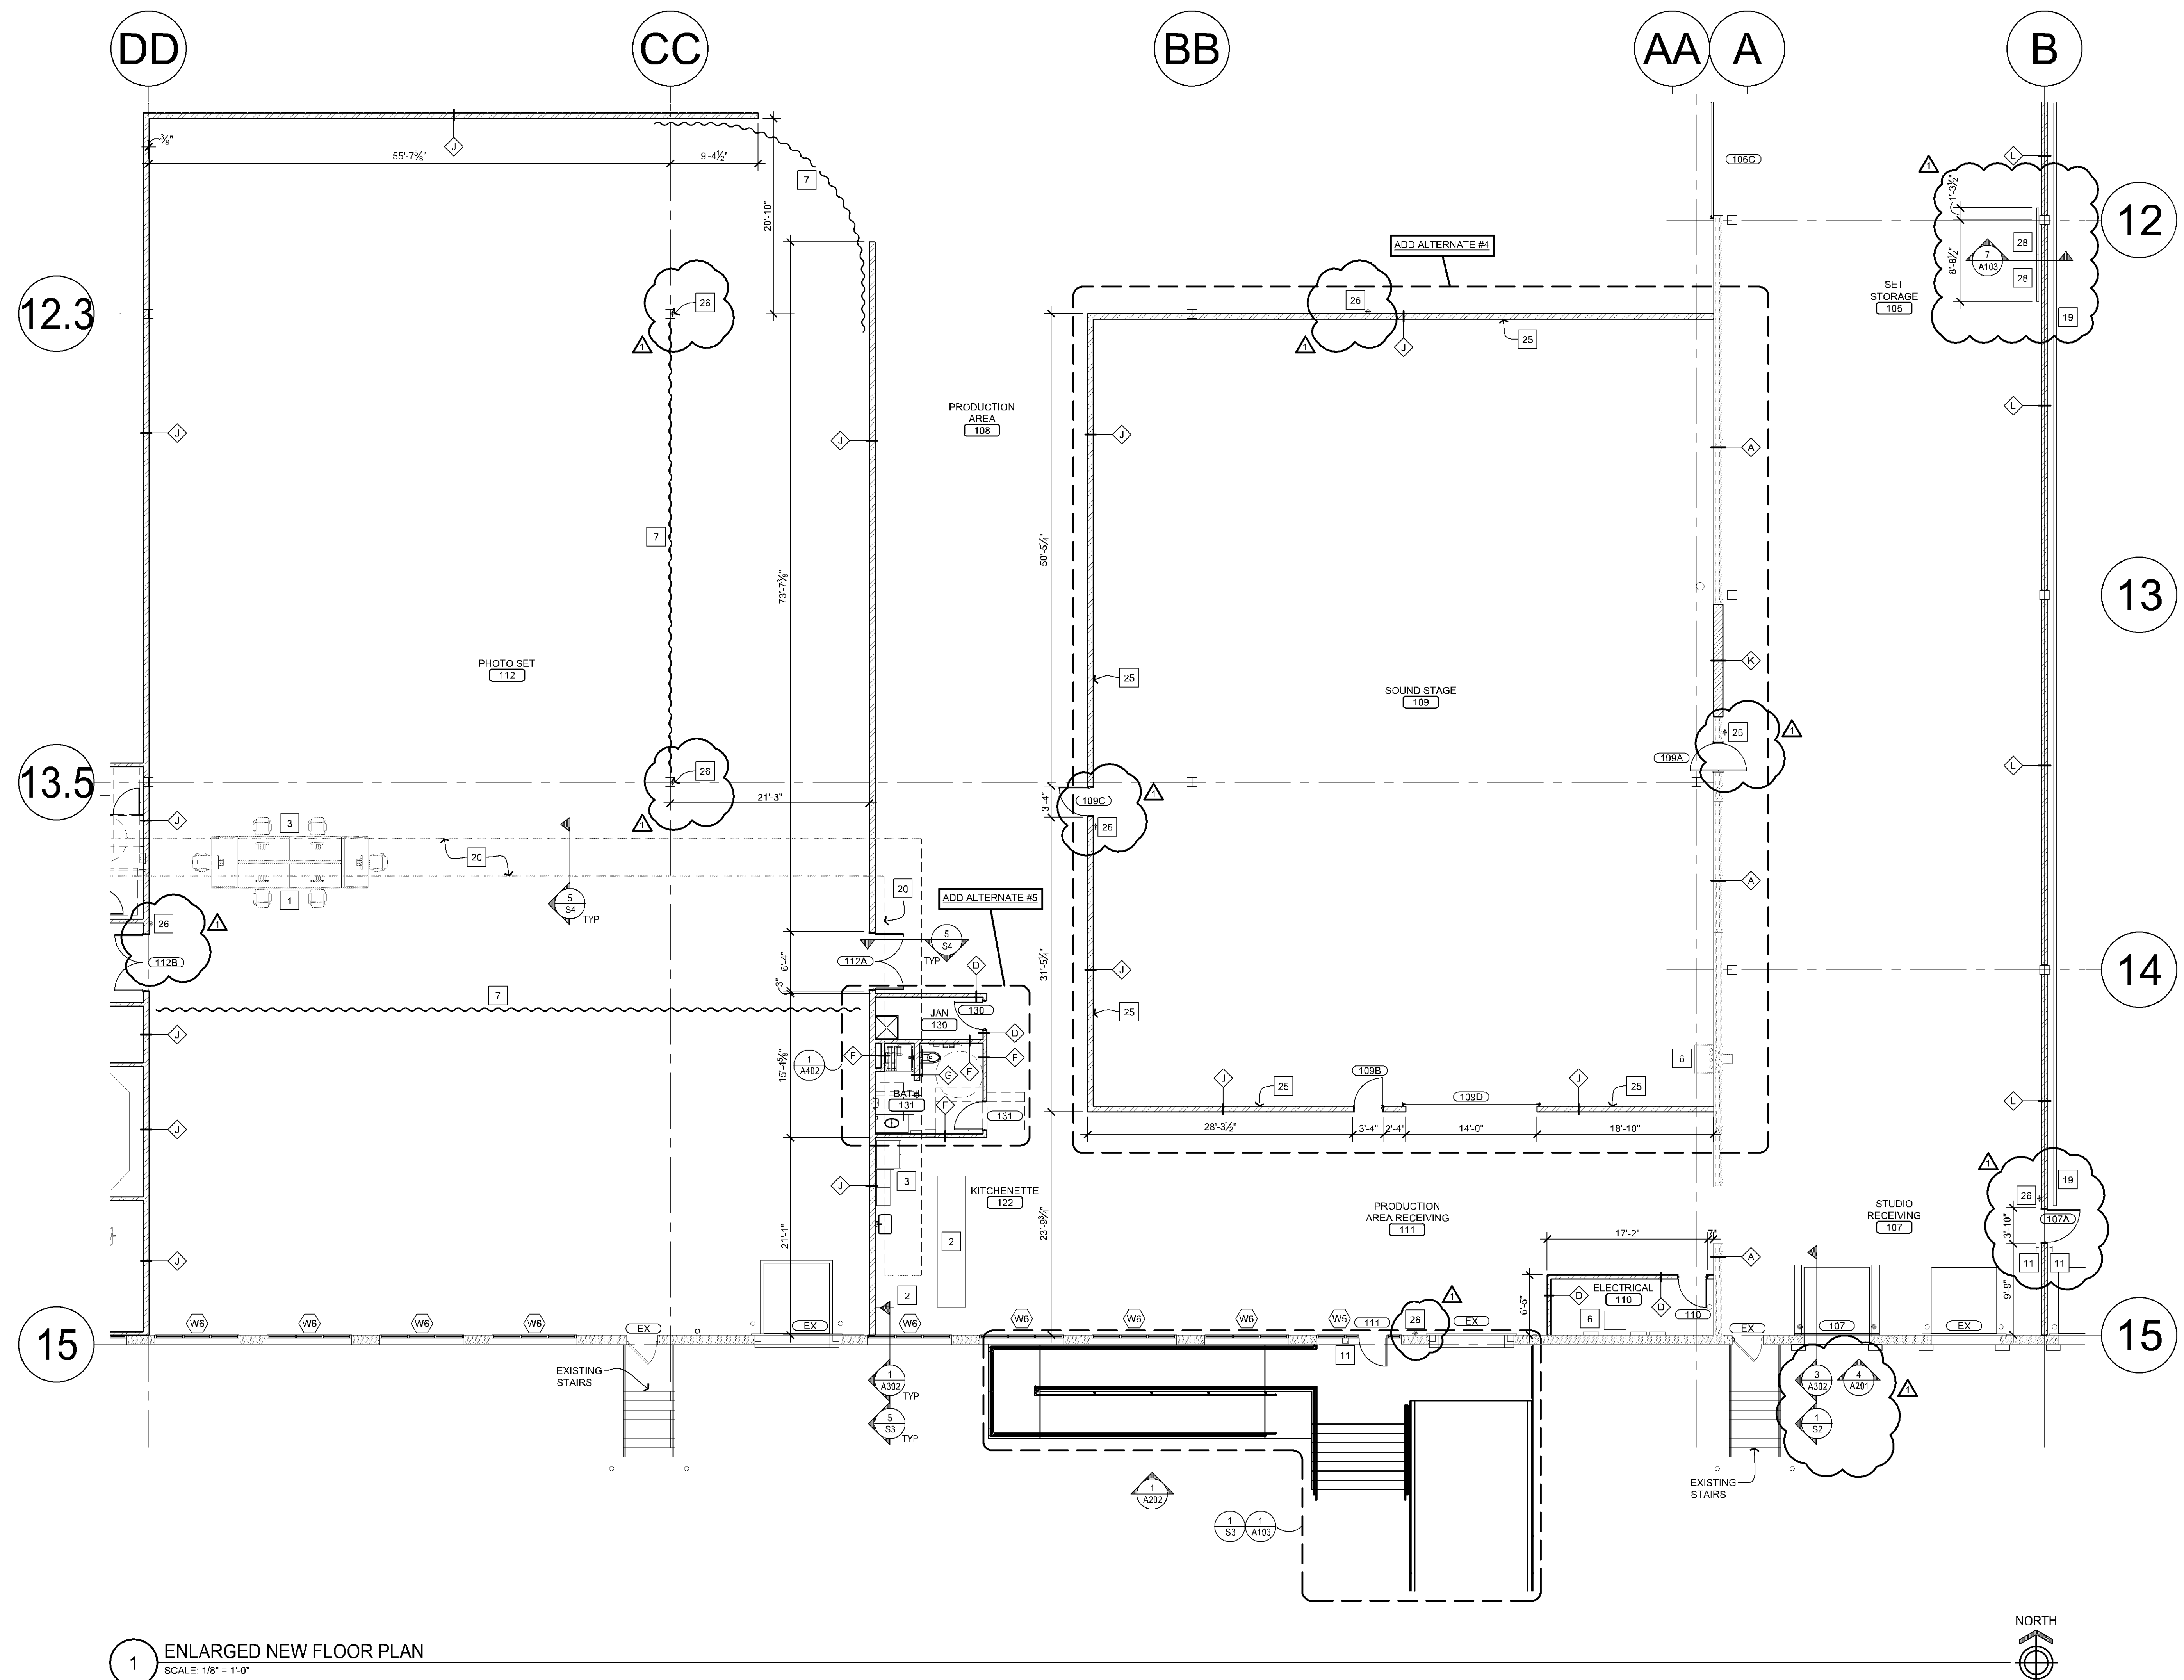

1 ENLARGED NEW FLOOR PLAN  
SCALE: 1/8" = 1'-0"

DO NOT SCALE THIS DRAWING IF THERE ARE ANY DISCREPANCIES CONTACT THE ARCHITECT PRIOR TO COMMENCING WORK	
ALL DIMENSIONS SHALL BE TO FACE UNLESS THE ARCHITECT INDICATES ANY DISCREPANCIES PRIOR TO CONSTRUCTION.	
IF EXISTING EXTERIOR THRESHOLD EXCEEDS ADA MAXIMUM HEIGHT OF 1/2" ABOVE FINISH FLOOR, EXISTING THRESHOLD SHALL BE REMOVED AND REPLACED WITH NEW THRESHOLD. RAMPED THRESHOLDS AND FLOOR LEVEL CHANGES AT ACCESSIBLE DOORWAYS TO BE DEVELOPED WITH A SLOPE NO GREATER THAN 1:12.	
ALL EXISTING DOORWAYS TO BE REFINISHED TO MATCH EXISTING DOORWAY LOCATION WITH TENANT.	
REMOVE AND INSTALL NON COMBUSTIBLE WOOD BACKING WHEN REQUIRED BY CODE.	
PAINING OF ALL WALL SURFACES TO BE COMPLETED PRIOR TO THE INSTALLATION OF ANY TYPE OF PANELING.	
REMOVAL OF EXCESS GROUT WILL BE DONE WITH WATER. THE USE OF SULFURIC OR MURATIC ACID IS PROHIBITED. IF THESE ACIDS ARE USED, THE CONTRACTOR SHALL BE RESPONSIBLE FOR THE ACID AND RESTORE THE GROUT AT THEIR EXPENSE (IF APPLICABLE).	
THE CONTRACTOR SHALL BE RESPONSIBLE FOR OBTAINING ALL PERMITS AND PROVIDE OWNER WITH AS-BUILT DRAWINGS AT PROJECT COMPLETION.	
ALL GYPSUM BOARD TO BE PREPARED TO LEVEL 4 FINISH STANDARDS	
ALL FUTURE FURNITURE IS TENANT SUPPLIED AND INSTALLED. UNLESS OTHERWISE NOTED, ALL WALL TILE LOCATIONS.	
USE CEMENT BASED TILE AT ALL WALL TILE LOCATIONS.	
TO BE INSTALLED TO MEET OR EXCEED ALL CURRENT AMERICA STANDARD	
FLOOR SLAB IS TO BE FINISHED TRENCHING COMPACTED PRIOR TO CONSTRUCTION OF UNDERGROUND PLUMBING	

1	NEW FURNITURE	15	NEW DRINKING FOUNTAIN W/ BOTTLE FILLER
2	NEW COUNTER/MILLWORK	16	NEW #4 HIG CONCRETE COLUMN PROTECTION W/ Driped OR SEE DETAIL 7/10/9
3	NEW EQUIPMENT	17	NEW HOLLMAN C&I LAMINATE LOCKERS, (4) UNITS W/ KEYPAD ACCESS
4	EXISTING ELECTRICAL EQUIPMENT TO REMAIN	18	EXISTING EQUIPMENT RELOCATED
5	EXISTING GUARDRAIL TO REMAIN	19	NEW ANGLE IRON WALL PROTECTION, SEE 4/10/3.
6	EXISTING EQUIPMENT TO REMAIN	20	NEW CONCRETE SLAB INFILL, SEE PLUMBING DRAWINGS & DETAIL, 5/54 FOR MORE INFORMATION.
7	SOFT BARRIER/CURTAIN	21	PATCH & REPAIR EXISTING SLAB INFILL AS REQUIRED FOR NEW FINISHES.
8	NEW TRUCKERS CAVE W/ WIRECRAFTERS, SEE 5/410/2.	22	COORDINATE EXACT LOCATION TO BEST BUY CONSTRUCTION MANAGER.
9	NEW CLOSET SHELF	23	BRAKE METAL AT COLUMN TO MATCH ADJACENT WINDOZ RAIL.
10	EXISTING FOUNTAIN TO REMAIN	24	FINISH, VERIFY FINISH TO MATCH CLC BLACK ANODIZED
11	NEW CARD READER	25	APS RESOURCE POLY COLUMN PROTECTOR
12	NEW TV W/ WOOD BLOCKING, COORDINATE W/ ELECTRICAL	26	STEEL BENT PLATE COLUMN PROTECTION BY MISCELLANEOUS METALS SUPPLIER, COORDINATE WITH BEST BUY CONST. MANAGER
13	NEW #2 PIPE BOLLARD, PAINT TO MATCH EXISTING GUARDRAIL, SEE 5/410/3	27	WALLS TO HAVE THE TOP 8" BOTTOM TRUCKS/ PENETRATIONS SEALED W/ ACOUSTICAL SEALANT, JUNCTION BOXES SHOULD BE STAGGERED & SEALED
14	EXISTING GUARDRAIL	28	HIGHLIGHTED WALLS SHOULD HAVE ACOUSTICAL SEALANT AT BOTTOM TRUCK AND JUNCTION BOXES
		29	NEW FIRE EXTINGUISHING, 10-0-0 BY CENTURY ORIGINAL, VERIFY FINISH LOCATIONS MAINTAIN 75 MAXIMUM SPACING
		30	NEW 1/2" STEEL ANGLE TO HORIZON TO FLOOR 12" O.C. PAINT BLACK, SEE DETAIL 7/10/3.

		EXISTING WALL - PATCH AND REPAIR AS REQUIRED AND PREP FOR NEW FINISHES.			3/8" METAL STUDS @ 16" O.C. TO 12" O" AFF. PROVIDE SOUND BATT INSULATION			6" 14 GA. METAL STUDS @ 12" O.C. OFFICE SIDE: 5/8" GYP. BD. FROM FLOOR TO DECK.			EXISTING EXT. WALL W/ 3/8" METAL STUDS @ 16" O.C.
		EXISTING EXT. WALL W/ 1/2-5/8" METAL STUDS @ 16" O.C.			BOTH SIDES: 5/8" GYP. BD. FROM FLOOR TO 12" O" AFF.  COMM ROOM SIDE: F.R.T. PLYWOOD, WALLS SEALED ONLY.			WAREHOUSE SIDE: 5/8" GYP. BD. FROM FLOOR TO 12" O" AFF.			OFFICE SIDE: 5/8" GYP. BD. FROM FLOOR TO 12" O" AFF. PROVIDE SOUND BATT INSULATION
		6" 14 GA. METAL STUDS @ 12" O.C.  OFFICE SIDE: 5/8" GYP. BD. FROM FLOOR TO 6" ABOVE FINISH CEILING.  WAREHOUSE SIDE: 5/8" GYP. BD. FROM FLOOR TO DECK.			3/8" METAL STUDS @ 16" O.C. TO 12" O" AFF. PROVIDE SOUND BATT INSULATION			BOTH SIDES: 5/8" GYP. BD. FROM FLOOR TO DECK.			EDIT ROOM SIDE: 5/8" GYP. BD. TO 12" O" AFF. PROVIDE SOUND BATT INSULATION
		BOTH SIDES: 5/8" GYP. BD. FROM FLOOR TO 12" O" AFF.  COMM ROOM SIDE: F.R.T. PLYWOOD, WALLS SEALED ONLY.			3/8" METAL STUDS @ 16" O.C. TO 12" O" AFF. PROVIDE SOUND BATT INSULATION			RESTROOM SIDE: 5/8" EXT. DENSGLASS BD. FROM FLOOR TO 6" O" AFF & 5/8" GYP. BD. FROM 6" O" AFF TO 6" ABOVE FINISH CEILING			OFFICE SIDE: 5/8" GYP. BD. FROM FLOOR TO 12" O" AFF.
		BOTH SIDES: 5/8" GYP. BD. FROM FLOOR TO 12" O" AFF.  COMM ROOM SIDE: F.R.T. PLYWOOD, WALLS SEALED ONLY.			3/8" METAL STUDS @ 16" O.C. TO 12" O" AFF. PROVIDE SOUND BATT INSULATION			RESTROOM SIDE: 5/8" EXT. DENSGLASS BD. FROM FLOOR TO 6" O" AFF & 5/8" GYP. BD. FROM 6" O" AFF TO 6" ABOVE FINISH CEILING			OFFICE SIDE: 5/8" GYP. BD. FROM FLOOR TO 12" O" AFF.
reprise

Architecture, Inc.  
15049  
Barnstable, MA 05537  
Office: 1-850-252-4413  
Suite 100, Portland Corporate Center  
1-850-252-4413

DESIGN

I hereby certify that this plan, specification or contract was prepared by me or under my direct supervision and that I am a duly registered ARCHITECT in the State of MINNESOTA.


*Barbara R. Johnson*  
BARBARA R. JOHNSON  
18050  
06/01/2020  
Registration Number

**STARGATE - BLOOMINGTON**  
TENANT REMODELING IN EXISTING TENANT SPACE  
6203 'B' WEST 11TH STREET  
BLOOMINGTON, MN 55438

---


**ENLARGED FLOOR PLANS**

# BEST BUY

DATE ISSUED	
PERMIT SET	05/22/20
ADDENDUM 1 	06/01/20
DRAWN BY JPH/ND	
CHECKED BY JH	
JOB NO. 19246	

A105

CASE #PL2020-79

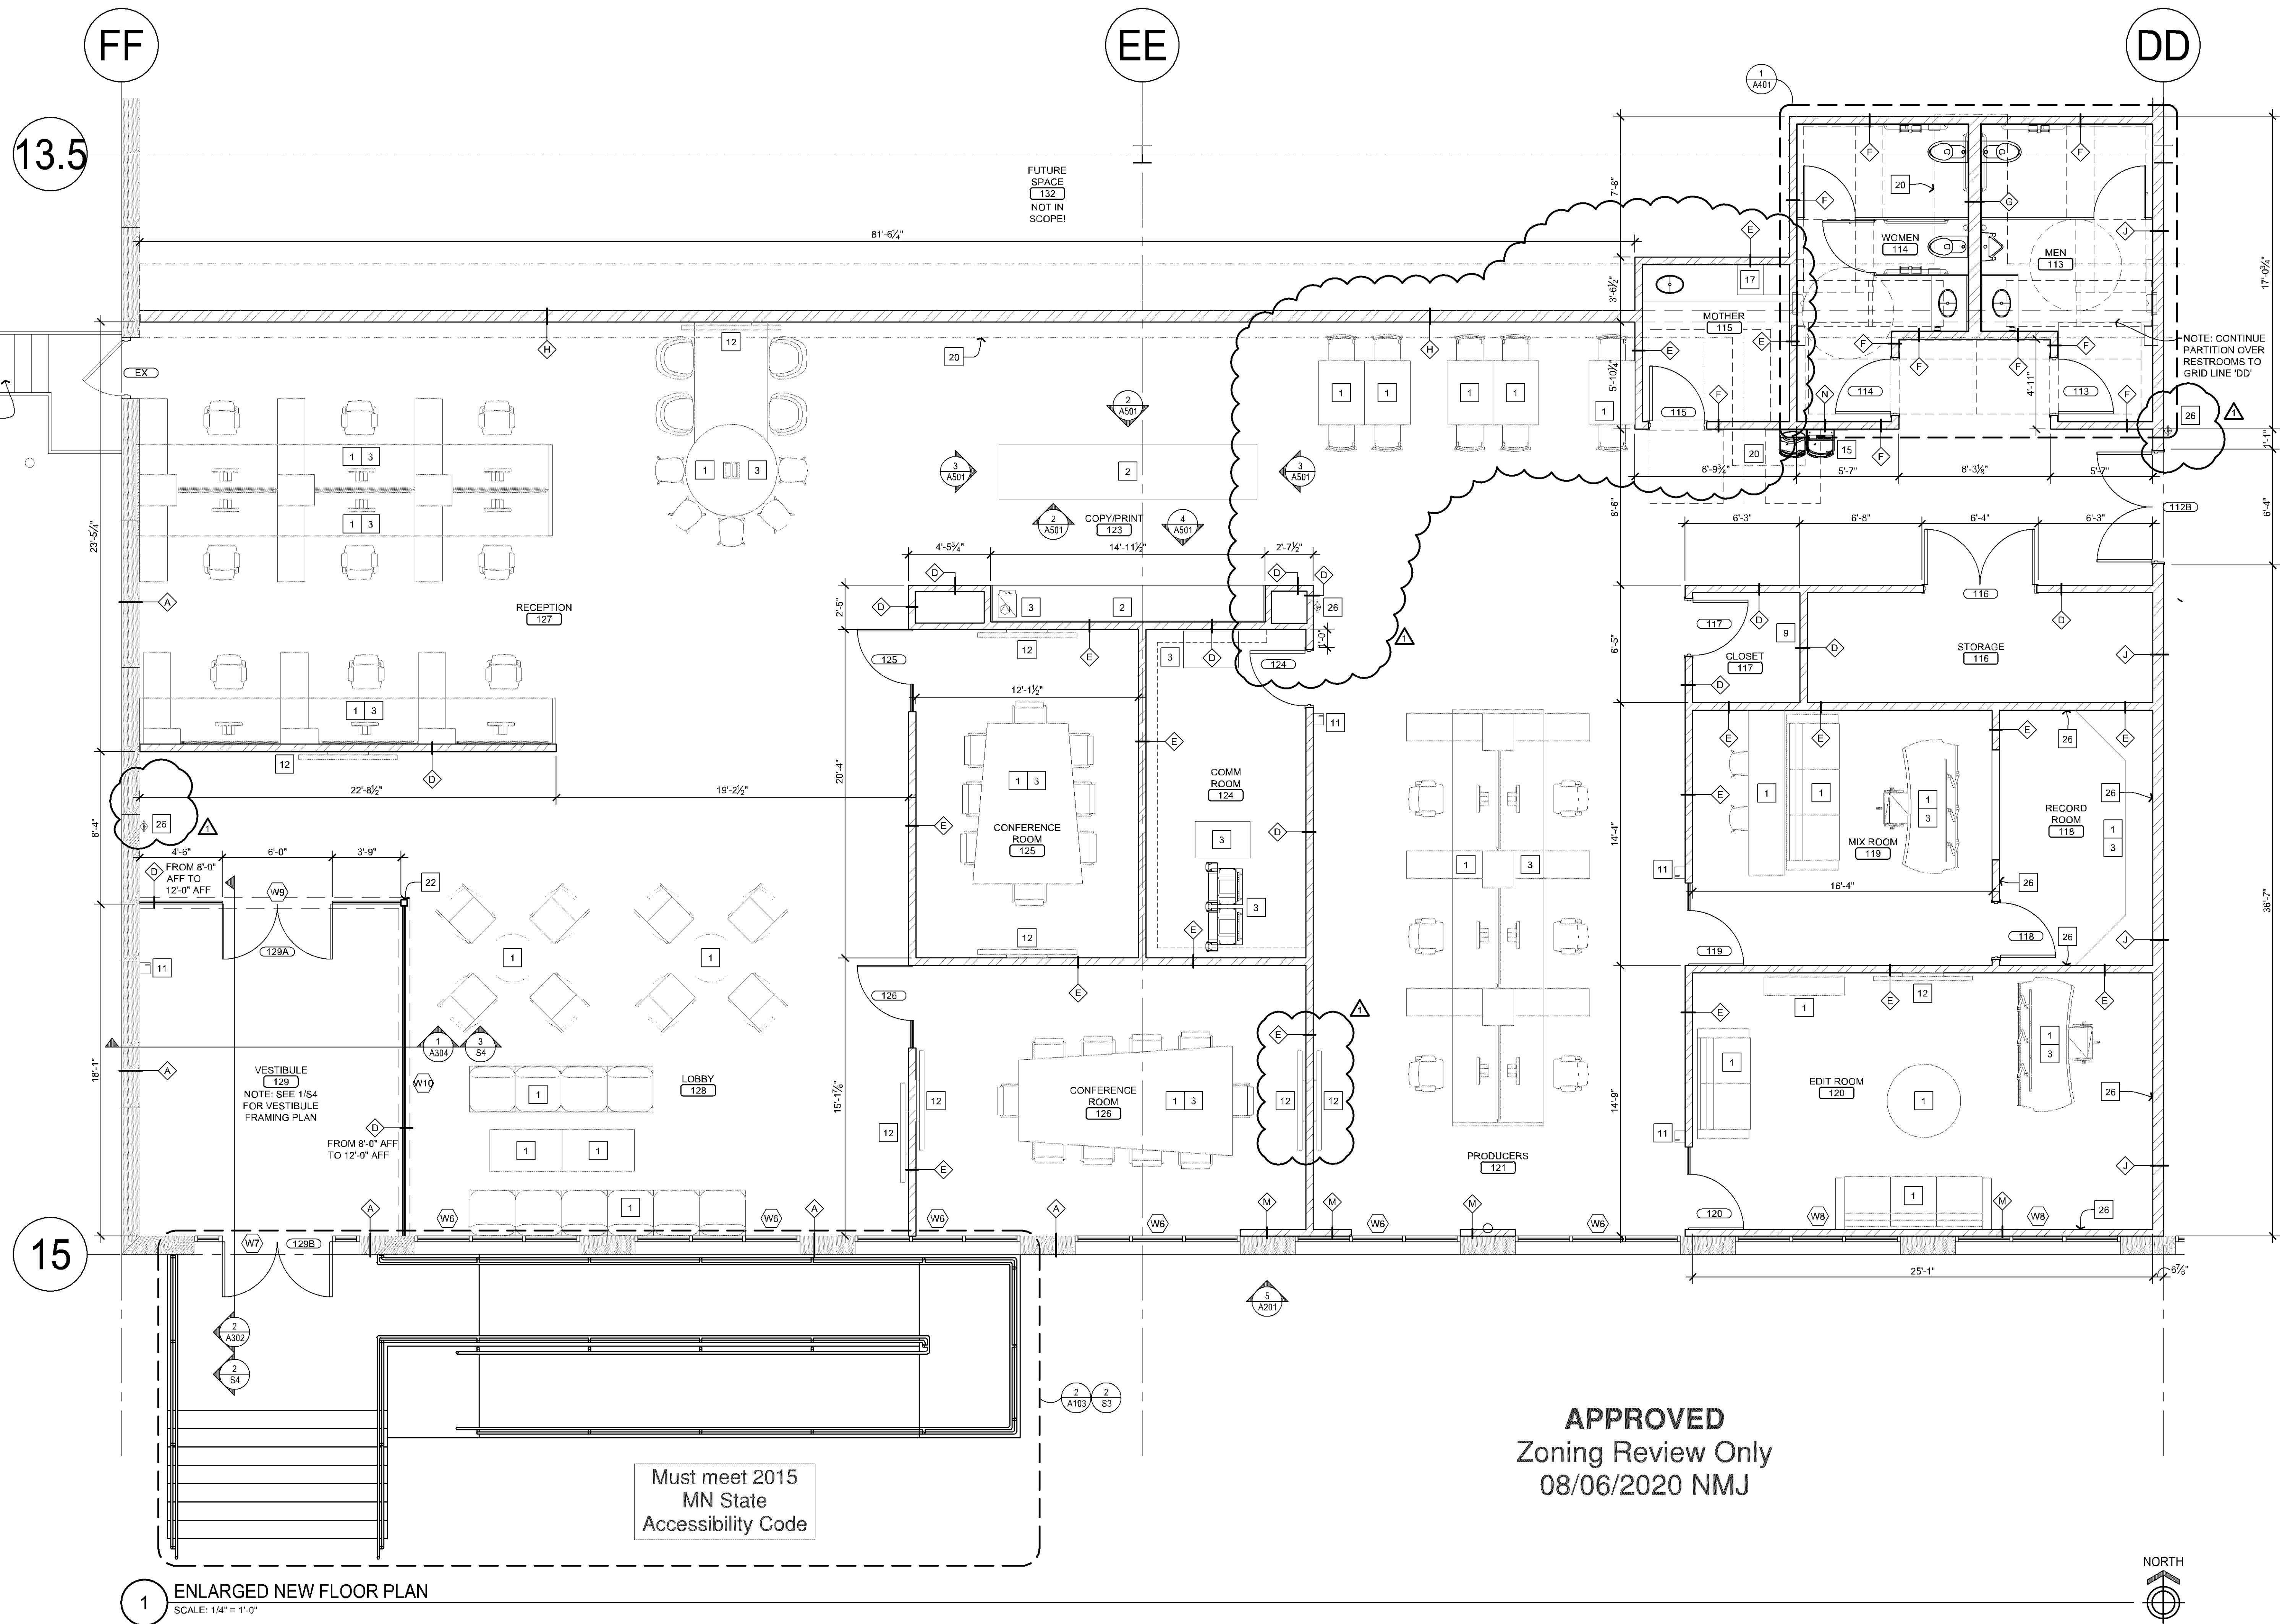

APPROVED  
Zoning Review Only  
08/06/2020 NMJ



#### GENERAL NOTES

- DO NOT SCALE THIS DRAWING IF THERE ARE ANY DISCREPANCIES CONTACT THE ARCHITECT PRIOR TO COMMENCING WORK.
- G.C. TO VERIFY ALL DIMENSIONS AND NOTIFY ARCHITECT OF ANY DISCREPANCIES PRIOR TO CONSTRUCTION.
- IF EXISTING EXTERIOR THRESHOLD EXCEEDS ADA MAXIMUM HEIGHT OF 1/2" REMOVE AND REPLACE WITH ACCESSIBLE THRESHOLD. RAISED THRESHOLDS AND FLOOR LEVEL CHANGES AT ACCESSIBLE DOORWAYS TO BE BEVELED WITH A SLOPE NO GREATER THAN 1:12.
- G.C. TO PROVIDE ALL WALL BLOCKING AND BACKING. VERIFY LOCATION WITH TENANT.
- G.C. TO PROVIDE AND INSTALL NON COMBUSTIBLE WOOD BACKING WHEN REQUIRED BY CODE.
- PAINTING OF ALL WALL SURFACES TO BE COMPLETED PRIOR TO THE INSTALLATION OF ANY WALL TRIM OR PANELING.
- REMOVAL OF EXCESS GROUT WILL BE DONE WITH WATER. THE USE OF SULFURIC OR MURIATIC ACID IS PROHIBITED. IF THESE ACIDS ARE USED, THE INSTALLER WILL BE REQUIRED TO REMOVE THE ACID AND RESTORE THE GROUT AT THEIR EXPENSE (IF APPLICABLE).
- G.C. SHALL DOCUMENT AS-BUILT INSTALLATION/CONDITIONS & PROVIDE OWNER WITH AS-BUILT DRAWINGS AT PROJECT COMPLETION. ALL GYPSUM BOARD TO BE PREPARED TO LEVEL 4 FINISH STANDARDS PER GYPSUM ASSOCIATION STANDARDS.
- ALL FIXTURES/FURNITURE IS TENANT SUPPLIED AND INSTALLED. UNO
- USE CEMENT BOARD AT ALL WALL TILE LOCATIONS.
- ALL TILE TO BE INSTALLED PER TILE COUNCIL OF AMERICA STANDARDS.
- FLOOR SLAB IS TO BE PINNED AND TRENCHING COMPACTED PRIOR TO POURING BACK AFTER UNDERGROUND PLUMBING.

#### WALL LEGEND

- EXISTING WALL/ EXISTING CONDITIONS BY OTHERS TO REMAIN
- NEW FULL HEIGHT METAL STUD WALL
- NEW CMU WALL

#### KEY NOTES

- NEW FURNITURE
- NEW COUNTER/MILLWORK
- NEW EQUIPMENT
- EXISTING ELECTRICAL EQUIPMENT TO REMAIN
- EXISTING GUARDRAIL TO REMAIN
- EXISTING EQUIPMENT TO REMAIN
- SOFT BARRIER/CURTAIN
- NEW TRUCKERS CAGE BY WIRECRAFTERS. SEE S/A102.
- NEW CLOSET SHELF
- EXISTING FURNITURE TO REMAIN
- NEW CARD READER
- NEW TV W/ WOOD BLOCKING
- COORDINATE W/ ELECTRICAL
- NEW 8" PIPE BOLLARD, PAINT BLACK, YELLOW SEE S/A103
- NEW GUARDRAIL OR REPAIR EXISTING GUARDRAIL
- NEW DRINKING FOUNTAIN W/ BOTTLE FILLER
- NEW 4" HIGH CONCRETE COLUMN PROTECTION
- NEW HOLLAND COT LAMINATE LOCKERS, (4) UNITS W/ KEYPAD ACCESS
- EXISTING EQUIPMENT RELOCATED
- NEW ANGLE IRON WALL PROTECTION. SEE 4/A103.
- NEW CONCRETE SLAB INFILL. SEE PLUMBING DRAWINGS & DETAIL S14 FOR MORE INFORMATION.
- PATCH & REPAIR EXISTING SLAB INFILL AS REQUIRED FOR NEW FINISHES.
- COORDINATE EXACT LOCATIONS WITH BEST BUY CONSTRUCTION MANAGER.
- BRAKE METAL AT COLUMNS TO MATCH ADJACENT WINDOW RAIL FINISH. VERIFY FINISH TO MATCH GRN BLACK ANODIZED
- APS RESOURCE POLY COLUMN PROTECTOR
- STEEL BENT PLATE COLUMN PROTECTION BY MISCELLANEOUS METALS SUPPLIER. COORDINATE SIZING DETAILS W/ BEST BUY CONST. MANAGER.
- WALLS TO HAVE THE TOP & BOTTOM TRACKS. PENETRATIONS SEALED W/ ACUSTICAL SEALANT. JUNCTION BOXES SHOULD BE STAGGERED & SEALED.
- HIGHLIGHTED WALLS SHOULD HAVE ACUSTICAL SEALANT AT BOTTOM TRACK AND JUNCTION BOXES.
- NEW FIRE EXTINGUISHERS, (16) GUY BENTLEY OR EQUAL. VERIFY FINAL LOCATIONS MAINTAIN 75" MAXIMUM SPACING.
- 3"X3"X8" STEEL ANGLE ANCHORED TO FLOOR 12" O.C. PAINT BLACK. SEE DETAIL 7A103.

#### WALL TYPES

EXISTING WALL - PATCH AND REPAIR AS REQUIRED AND PREP FOR NEW FINISHES	3-5/8" METAL STUDS @ 16" O.C. TO 12'-0" AFF. PROVIDE SOUND BATT INSULATION.	6" 14 GA. METAL STUDS @ 12" O.C.	EXISTING EXT. WALL W/ 1-5/8" METAL STUDS @ 16" O.C.
OFFICE SIDE: RIGID INSUL. 4 MIL. POLY VAPOR BARRIER, 5/8" GYP. BD. FROM FLOOR TO 6" ABOVE FINISH CEILING.	BOTH SIDES: 5/8" GYP. BD. FROM FLOOR TO 12'-0" AFF. PROVIDE SOUND BATT INSULATION.	OFFICE SIDE: 5/8" GYP. BD. FROM FLOOR TO DECK.	WAREHOUSE SIDE: 5/8" GYP. BD. FROM FLOOR TO 12'-0" AFF.
6" 14 GA. METAL STUDS @ 12" O.C.	OFFICE SIDE: 5/8" GYP. BD. FROM FLOOR TO 6" ABOVE FINISH CEILING.	WAREHOUSE SIDE: 5/8" GYP. BD. FROM FLOOR TO 12'-0" AFF.	6" 14 GA. METAL STUDS @ 12" O.C. PROVIDE SOUND BATT INSULATION.
OFFICE SIDE: 5/8" GYP. BD. FROM FLOOR TO 6" ABOVE FINISH CEILING.	WAREHOUSE SIDE: 5/8" GYP. BD. FROM FLOOR TO DECK.	RESTROOM SIDE: 5/8" EXT. DENSGLASS BD. FROM FLOOR TO 6'-2" AFF & 5/8" GYP. BD. FROM 6'-2" AFF TO 6" ABOVE FINISH CEILING.	BOTH SIDES: 5/8" GYP. BD. FROM FLOOR TO DECK.
3-5/8" METAL STUDS @ 16" O.C. TO 12'-0" AFF.	3-5/8" METAL STUDS @ 16" O.C. TO 12'-0" AFF. PROVIDE SOUND BATT INSULATION.	12" CMU - CORE FILLED W/ INSUL. FROM FLOOR TO TOP OF OPENING.	6" 14 GA. METAL STUDS @ 12" O.C. PROVIDE SOUND BATT INSULATION.
BOTH SIDES: 5/8" GYP. BD. FROM FLOOR TO 12'-0" AFF.	BOTH SIDES: 5/8" EXT. DENSGLASS BD. FROM FLOOR TO 6'-2" AFF & 5/8" GYP. BD. FROM 6'-2" AFF TO 6" ABOVE FINISH CEILING.	NOTE: G.C. TO PROVIDE ROUGH LUMBER, PLYWOOD BLOCKING, ETC. THAT IS PRESSURE TREATED FIRE RETARDANT WOOD BEARING U.L. LABELING WHERE REQUIRED.	RESTROOM SIDE: 5/8" EXT. DENSGLASS BD. FROM FLOOR TO 4'-7" AFF & 5/8" GYP. BD. FROM 4'-7" AFF TO 6" ABOVE FINISH CEILING.


STARGATE - BLOOMINGTON  
TENANT REMODELING IN EXISTING TENANT SPACE  
6203 8<sup>TH</sup> WEST 11<sup>TH</sup> STREET  
BLOOMINGTON, MN 55436  
ENLARGED FLOOR PLANS

BEST BUY

DATE ISSUED  
PERMIT SET 05/22/20  
ADDENDUM 1 06/01/20  
DRAWN BY JPH/ND  
CHECKED BY JH  
JOB NO. 19246


A106

reprise Architecture, Inc.  
12400 Portland Avenue South  
Suite 100, Portland Corporate Center  
Office: (952) 222-4432  
Fax: (952) 224-4431  
DESIGN  
I hereby certify that this plan, specification or schedule was prepared by me or under my direct supervision and that I am a duly registered architect under the laws of the State of Minnesota.  
Signature: [Signature]  
Date: 8/6/2020  
Registration Number: 18650

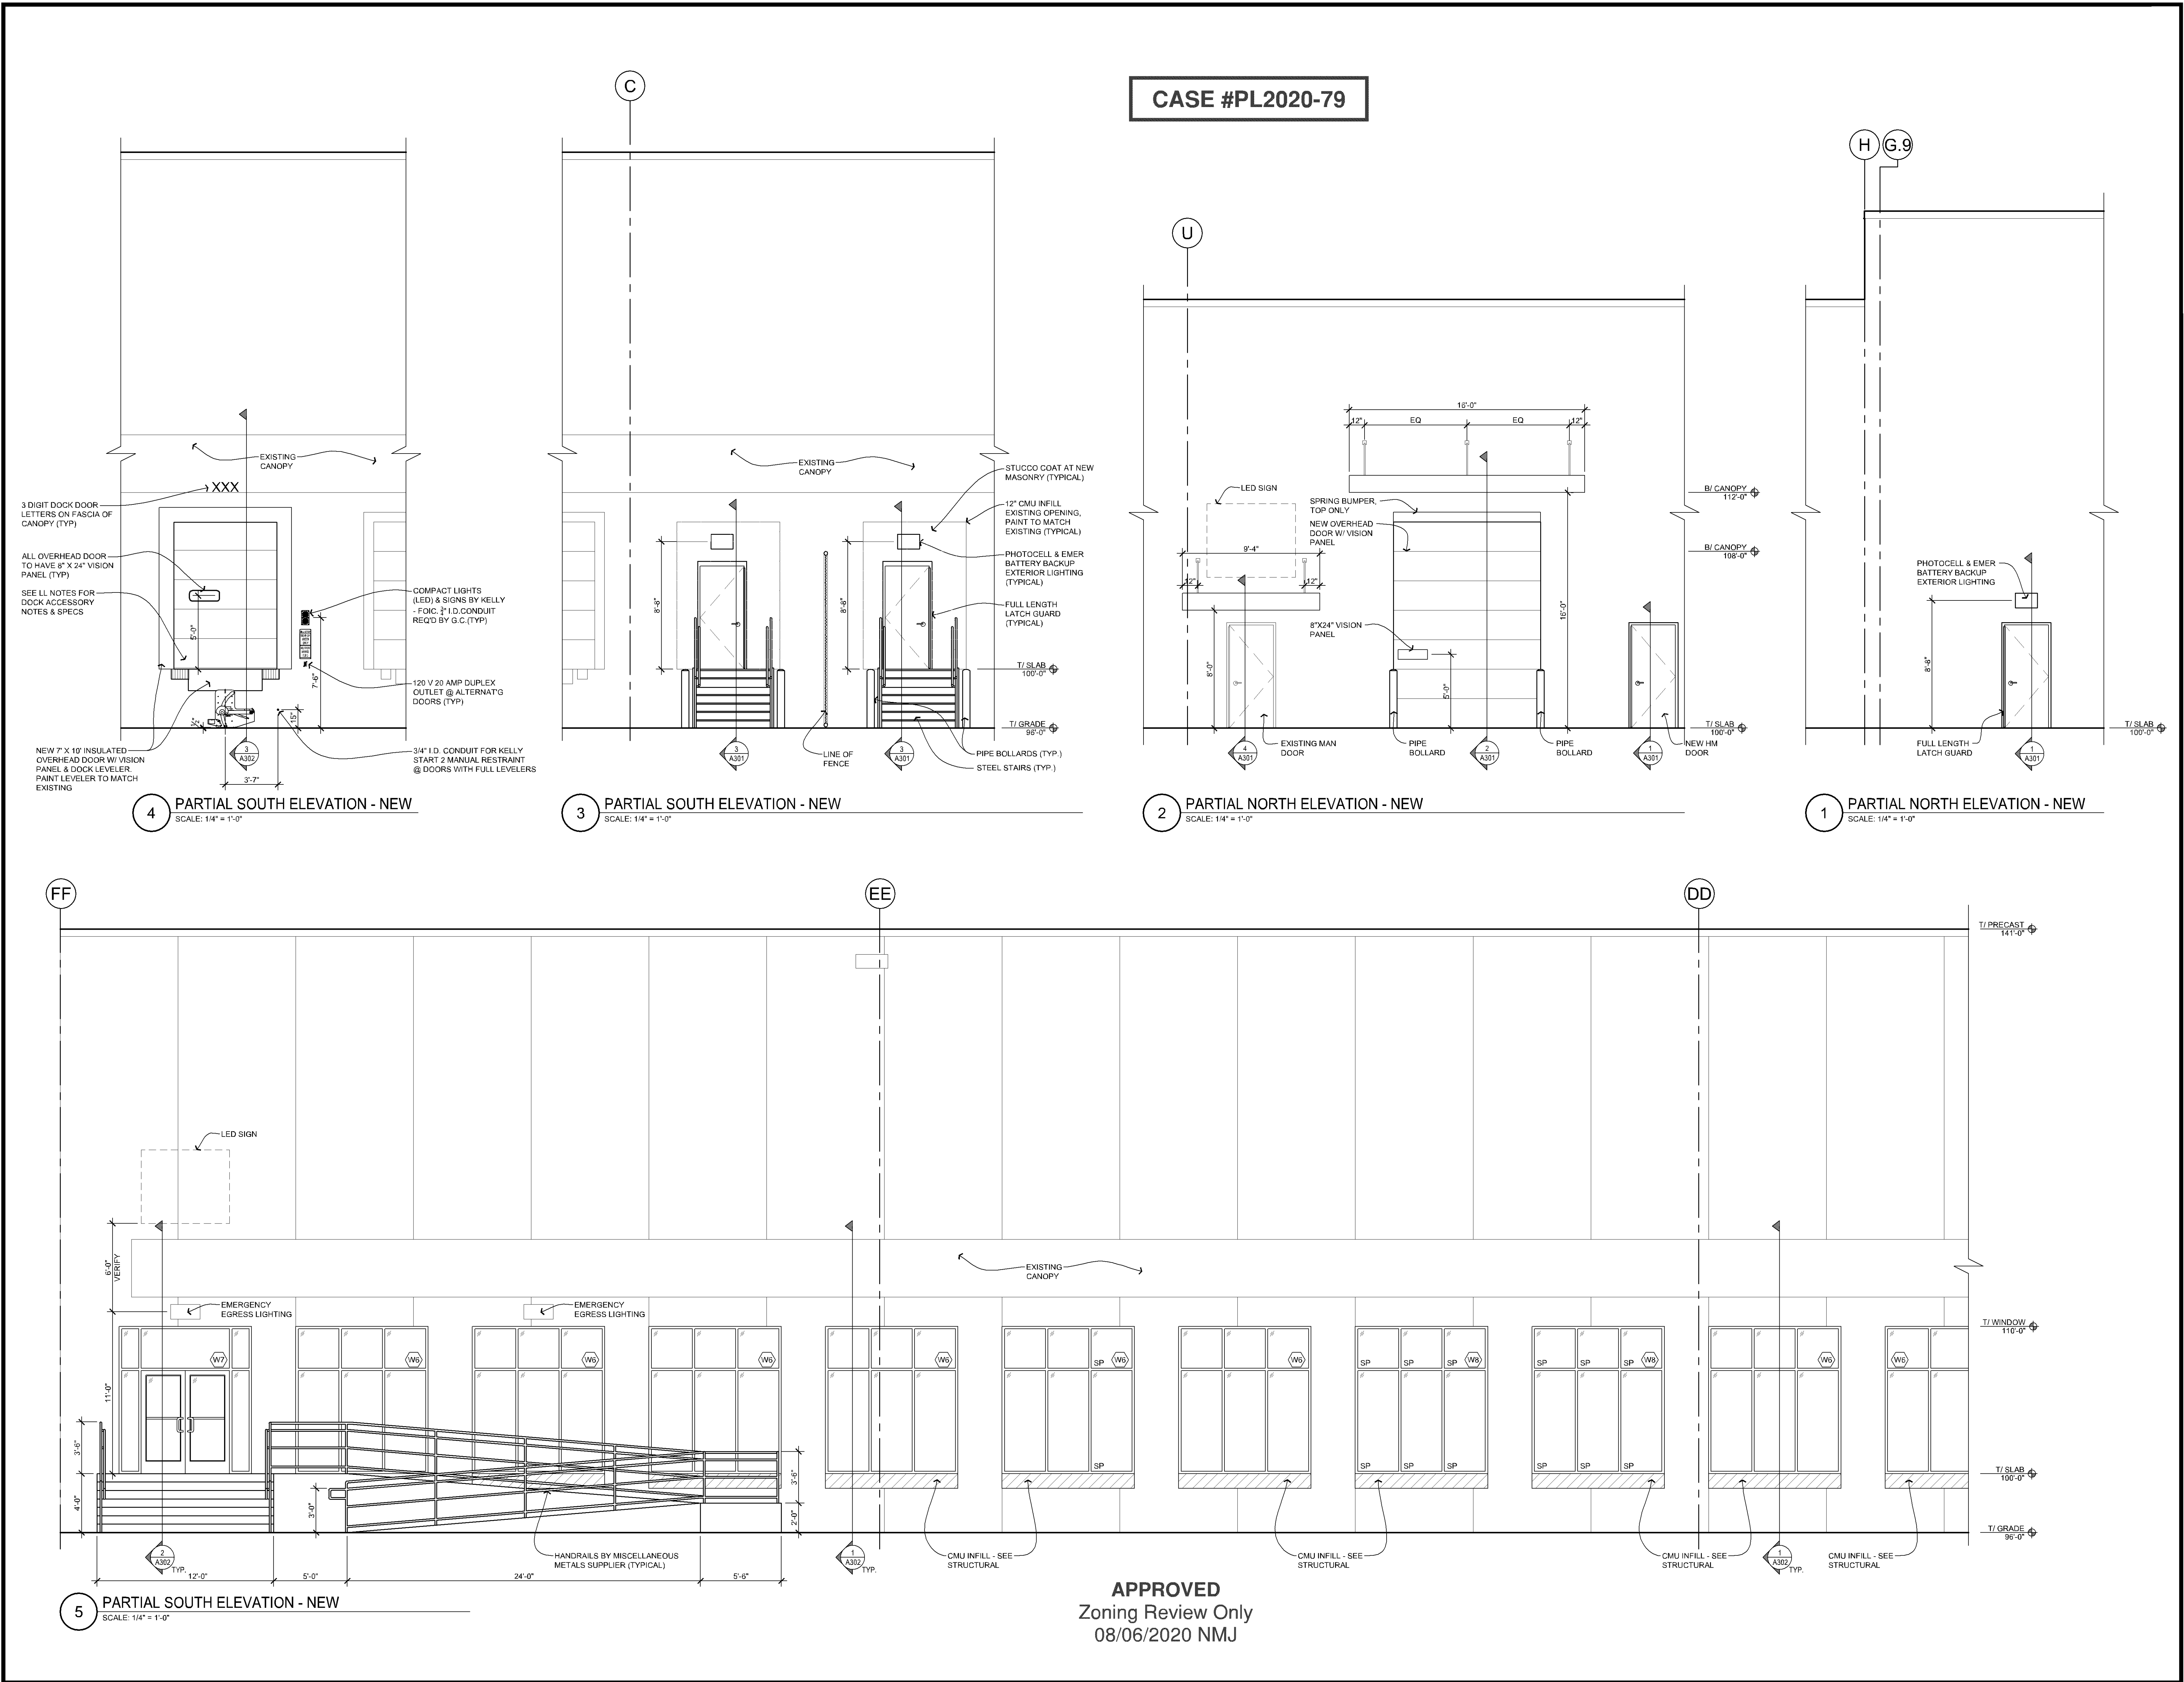




CASE #PL2020-79

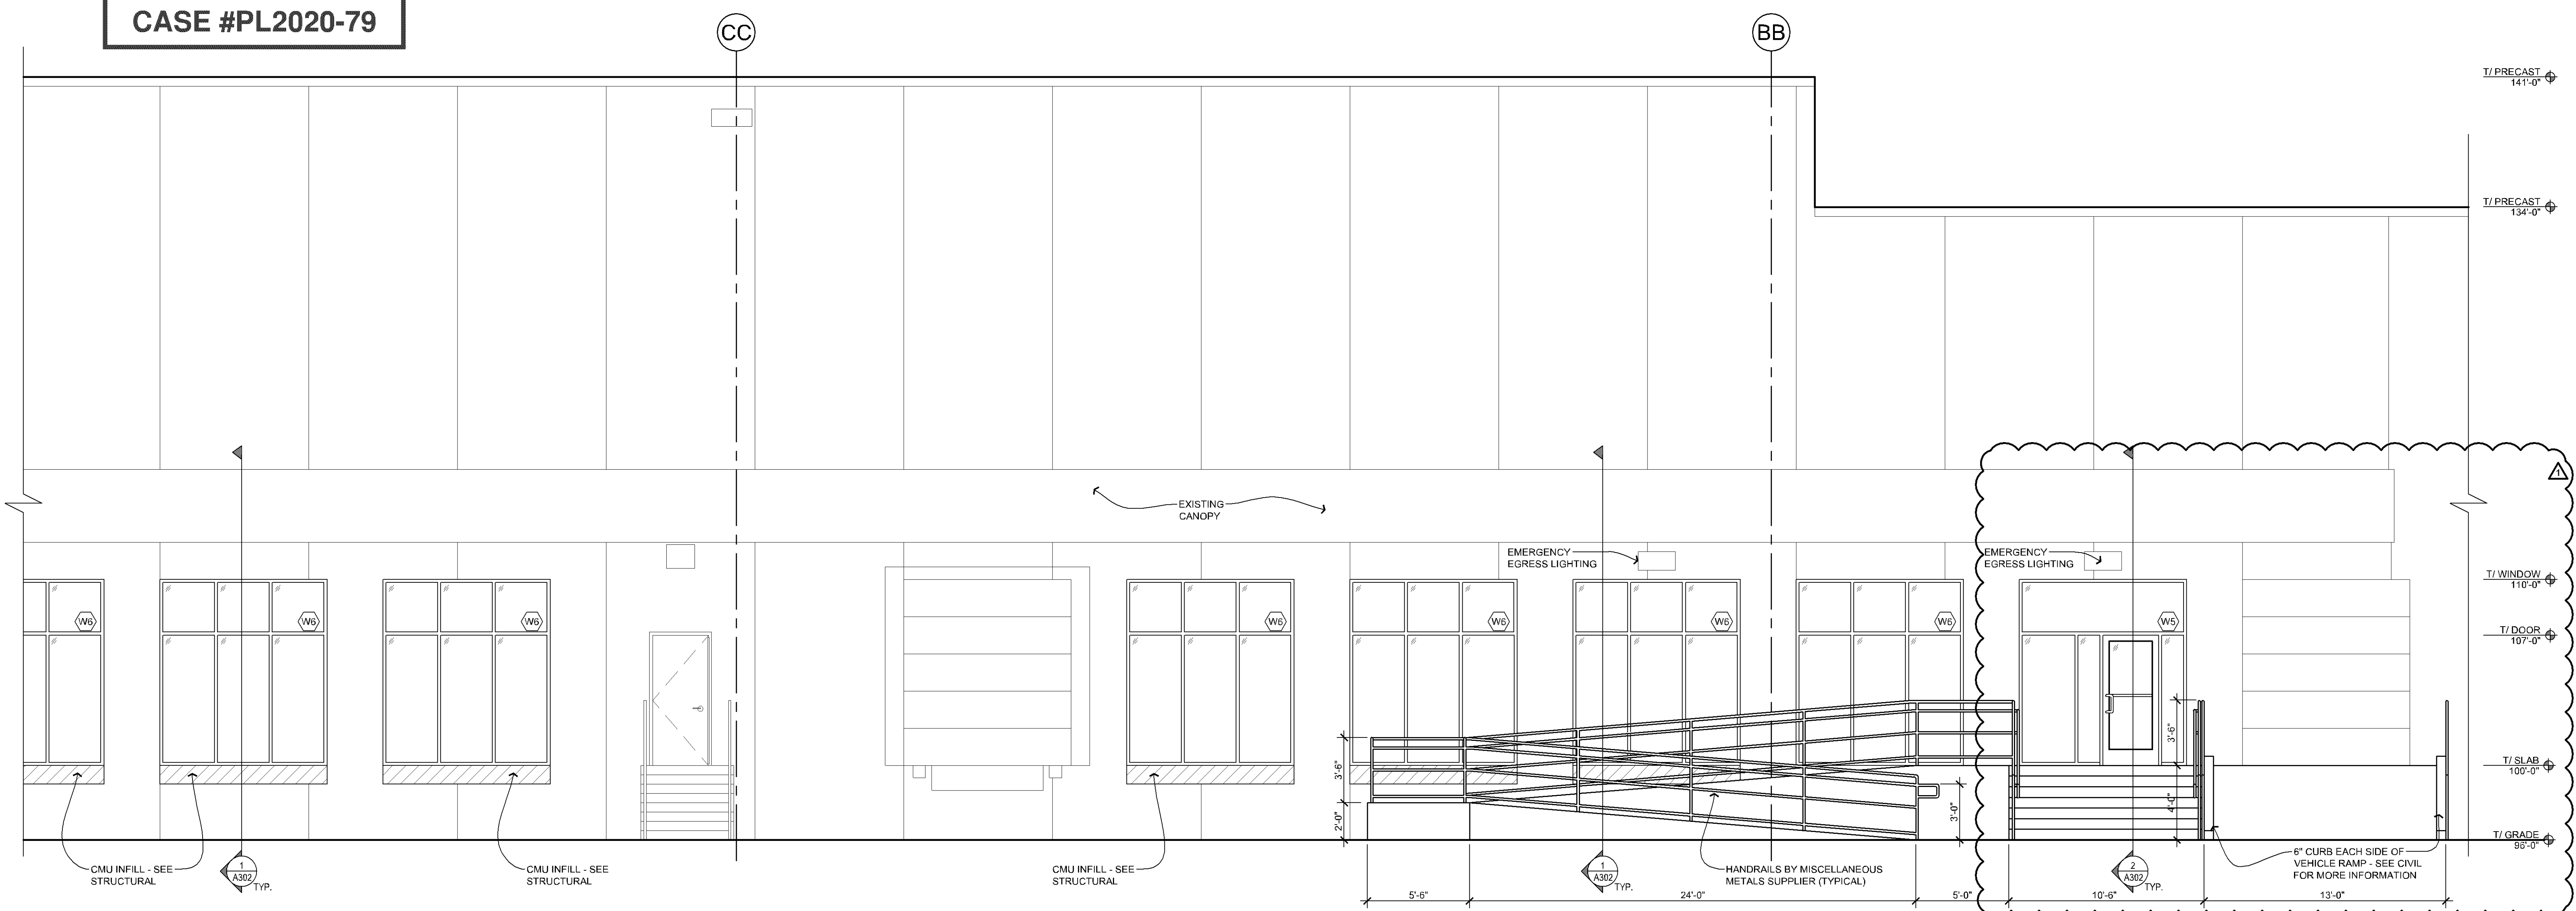

1 PARTIAL SOUTH ELEVATION - NEW  
SCALE: 1/4" = 1'-0"

**APPROVED**  
Zoning Review Only  
08/06/2020 NMJ

Must meet 2015  
MN State  
Accessibility Code

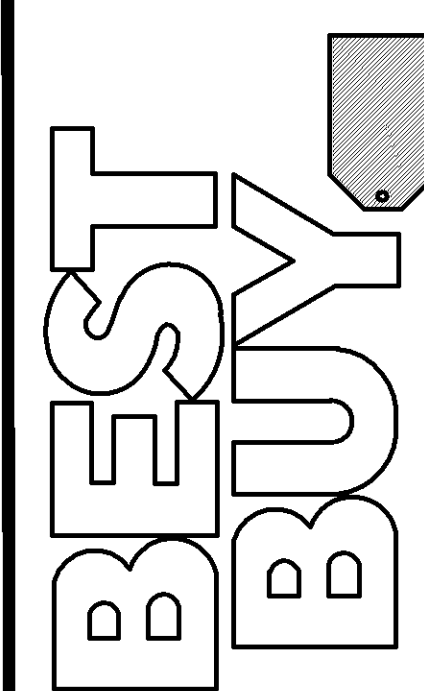

**STARGATE - BLOOMINGTON**  
TENANT REMODELING IN EXISTING TENANT SPACE  
6203 8<sup>TH</sup> WEST 11<sup>TH</sup> STREET  
BLOOMINGTON, MN 55438  
**PARTIAL EXTERIOR ELEVATIONS**

DATE ISSUED	
PERMIT SET	05/22/20
ADDENDUM 1	06/01/20
DRAWN BY	JPH/ND
CHECKED BY	JH
JOB NO.	19246

A202

I hereby certify that this plan, specification or schedule was prepared by me or under my direct supervision and that I am a duly registered architect under the laws of the State of Minnesota.  
Signature: *[Signature]*  
Date: 06/01/20  
Title: Architect  
Registration Number: 18650

