

The property located at 611 West 98th Street shall comprise the boundaries for this USD.

The property will have a newly built Bank of America located within its boundaries. This building will utilize wall signage, freestanding signage, and informational signage throughout the property. Details of all signage on the property are listed within this USD. Please see attached prints for exact locations and specific details for each sign:

Freestanding Signage:

Front yard monument sign: Sign will be 5' 2 ½" x 12' 9" and will be 8' in overall height. This sign will include 67 total square feet of signage. Quantity 1. Sign number 1 on the plan set

Directional signs: Signs will be 1'3" x 2' 1" and will be 3' in overall height. The signs will 3 square feet each. Quantity 2. Sign numbers 12 and 13 on the plan set

Informational signs: Signs will be 12" x 18" and will be 7' in overall height. The signs will be 1.5 square feet. Quantity 2
Signs will be 18" x 18" and will be 8'2" in overall height. The signs will be 2 square feet. Quantity 1
Sign numbers 14 and 15 on the plan set

Wall Signage:

East Elevation Primary wall: Sign will be 4' 6" x 11' 1". The sign will be 50 square feet. Quantity 1. Sign number 2 on the plan set. Total wall square footage 954, allowable signage is 8% or 76 square feet

North Elevation Secondary wall: Sign will be 2'7" x 15' 9". The sign will be 41 square feet. Quantity 1. Sign number 3 on the plan set. Total wall square footage 1440, allowable signage is 4% or 58 square feet

South Elevation Secondary wall: Sign will be 2'7" x 15' 9". The sign will be 41 square feet. Quantity 1. Sign number 4 on the plan set. Total wall square footage 1440, allowable signage is 4% or 58 square feet

West Elevation Primary wall: Sign will be 2'7" x 15' 9". The sign will be 41 square feet. Quantity 1. Sign number 5 on the plan set. Total wall square footage 954, allowable signage is 8% or 76 square feet

Drive Thru Canopy: Signs will be 7 ¾" x 4' 5". Sign will be 3 square feet. Quantity 3. Sign numbers 16, 17, and 18 on the plan set.

1517 94th Lane NE Minneapolis, MN 55449


763-571-2995

www.scoutdoor.com

APPROVED
Zoning Review Only
04/20/2021 NMJ

CASE #PL2021-72

BANK OF AMERICA

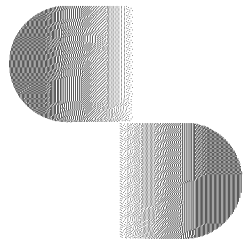


Stratus™

stratusunlimited.com

888.503.1569

APPROVED
Zoning Review Only
04/20/2021 NMJ


WEST 98TH STREET
(VARIABLE WIDTH RIGHT-OF-WAY)

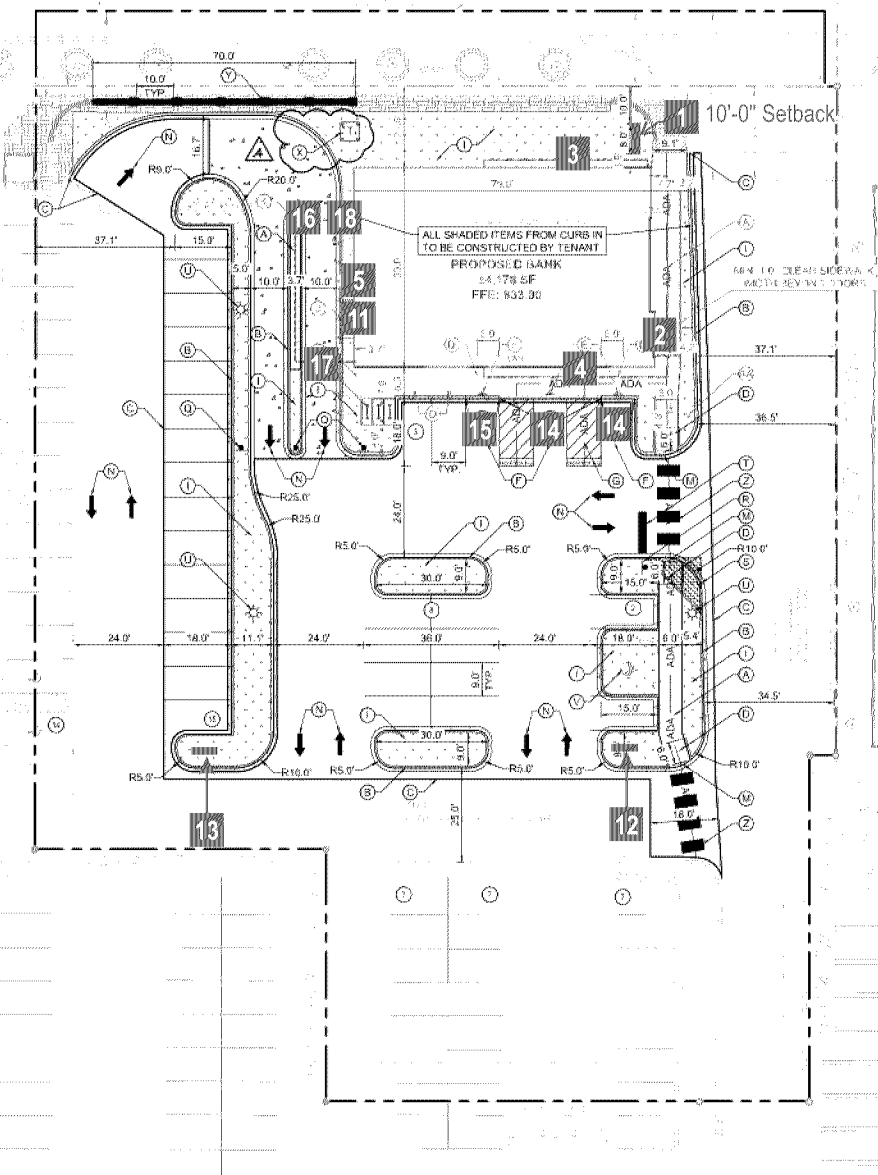

Item	Description	Qty	Page #
1	B4.1-FWng - 8'-0" Monument w/ Foundation	1	7
2	C3ng Illum. Ch. Letters on Non-Illum. Backer	1	8
3	D5ng - 9" Illum. Ch. Letters on Non-Illum. Backer	1	9
4	D5ng - 9" Illum. Ch. Letters on Non-Illum. Backer	1	9
5	D5ng - 9" Illum. Ch. Letters on Non-Illum. Backer	1	9
6	Door Vinyl - Standard w/ ADA Decal	1	10
7	AUTOMATIC DOOR DECAL	2	10
8	Security Camera Vinyl	1	11
9	White Address Numerals	1	11
10	CARD READER DECAL AUTOMATIC DOORS	1	11
11	No Smoking Plaque - Informational Sign	1	12
12	P1ng - D/F Directional	1	13
13	P1ng - D/F Directional	1	14
14	ADA - Reserved Parking Only	2	15
15	RP1ng Pole Mounted Regulatory - LEV	1	16
16	SS1ng - Informational Regulatory	1	17
17	SS2ng - Informational Regulatory	1	17
18	SS3ng - Directional Regulatory	1	17

NOTE:
INSTALLATION LOCATIONS TBD
FOR SIGNS #11, #12, #13 & #14

SIGN #1 NOTE:
10'-0" Setback from ROW
to Leading Edge of Sign
from 98th Street and Driveway.
Pending City Council Approval.


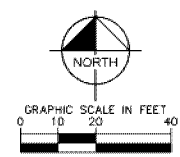


Drawing prepared by: SITE PLAN		Drawing prepared for: BANK OF AMERICA		Revision Description: Drawings are the exclusive property of STRATUS. Any unauthorized use or duplication is not permitted.	
Location: 611 W 98th St. Bloomington, MN 55420-4715	Proj #: 4305 Loc #: 6110	Rev #:	Req#:	Date:	Reg. By:
File Path: Active\BANKS\B\Bank Of America\2020\Locations\4305_6110_Bloomington_MN_R6.cdr		Original	326276	05/08/20	MH Sb
		Rev 1	326745	05/27/20	MH NPP
		Rev 2	327028	06/06/20	MH Sb
		Rev 3	327276	06/14/20	MH Sb
		Rev 4	329078	08/17/20	MH Sb
		Rev 5	337194	03/16/20	MH Lv
		Rev 6	337496	03/23/20	MH Lv
		Rev 7	000000	00/00/00	XXX XXX
		Rev 8	000000	00/00/00	XXX XXX
		Rev 9	000000	00/00/00	XXX XXX
		Rev 10	000000	00/00/00	XXX XXX

APPROVED
Zoning Review Only
04/20/2021 NMJ

Proposed Sign Schedule

Item	Description	Qty	Page #
1	B4.1-FWng - 8'-0" Monument w/ Foundation	1	7
2	C3ng Illum. Ch. Letters on Non-Illum. Backer	1	8
3	D5ng - 9" Illum. Ch. Letters on Non-Illum. Backer	1	9
4	D5ng - 9" Illum. Ch. Letters on Non-Illum. Backer	1	9
5	D5ng - 9" Illum. Ch. Letters on Non-Illum. Backer	1	9
6	Door Vinyl - Standard w/ ADA Decal	1	10
7	AUTOMATIC DOOR DECAL	2	10
8	Security Camera Vinyl	1	11
9	White Address Numerals	1	11
10	CARD READER DECAL AUTOMATIC DOORS	1	11
11	No Smoking Plaque - Informational Sign	1	12
12	P1ng - D/F Directional	1	13
13	P1ng - D/F Directional	1	14
14	ADA - Reserved Parking Only	2	15
15	RP1ng Pole Mounted Regulatory - LEV	1	16
16	SS1ng - Informational Regulatory	1	17
17	SS2ng - Informational Regulatory	1	17
18	SS3ng - Directional Regulatory	1	17

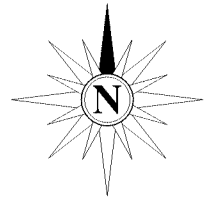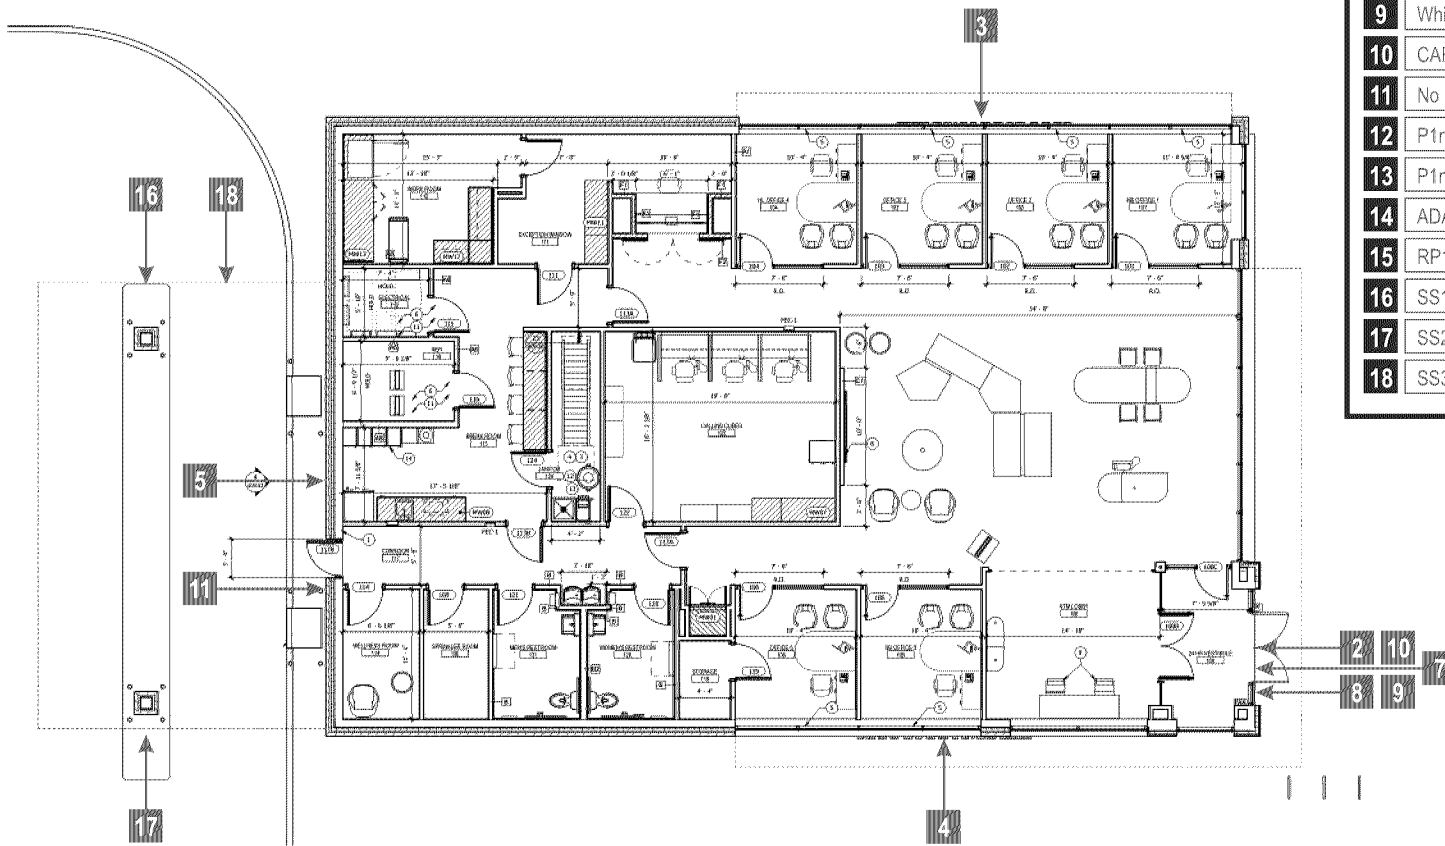

Drawing prepared by:

FLOOR PLAN

Drawing prepared for:

Location:
611 W 98th St.
Bloomington, MN 55420-4715


Proj #:
4305
Loc #:
6110



File Path:
Active\BANKS\B\Bank Of America\2020\Locations\4305_6110_Bloomington_MN_R6.cdr

Rev #:	Req#:	Date:	Req. By:	Drawn By:	Revision Description:	Rev #:	Req#:	Date:	Req. By:	Drawn By:
Original	326276	05/08/20	MH	Sb	Drawings are the exclusive property of STRATUS. Any unauthorized use or duplication is not permitted.					
Rev 1	326745	05/27/20	MH	NPP	Rev Sign1 and 2 - Ltrs on Backer, plus addition changes.	Rev 7	000000	00/00/00	XXX	XXX
Rev 2	327028	06/06/20	MH	Sb	Various Changes - See Request	Rev 8	000000	00/00/00	XXX	XXX
Rev 3	327276	06/14/20	MH	Sb	Change Signs 4 & 5 to D5ng	Rev 9	000000	00/00/00	XXX	XXX
Rev 4	329078	08/17/20	MH	Sb	Added bank hours and clearance bar height	Rev 10	000000	00/00/00	XXX	XXX
Rev 5	337194	03/16/20	MH	Lv	Added sign 7 - Caution automatic door decal					
Rev 6	337496	03/23/20	MH	Lv	Update site plan - update sign one & re-named elevations					


APPROVED
Zoning Review Only
04/20/2021 NMJ

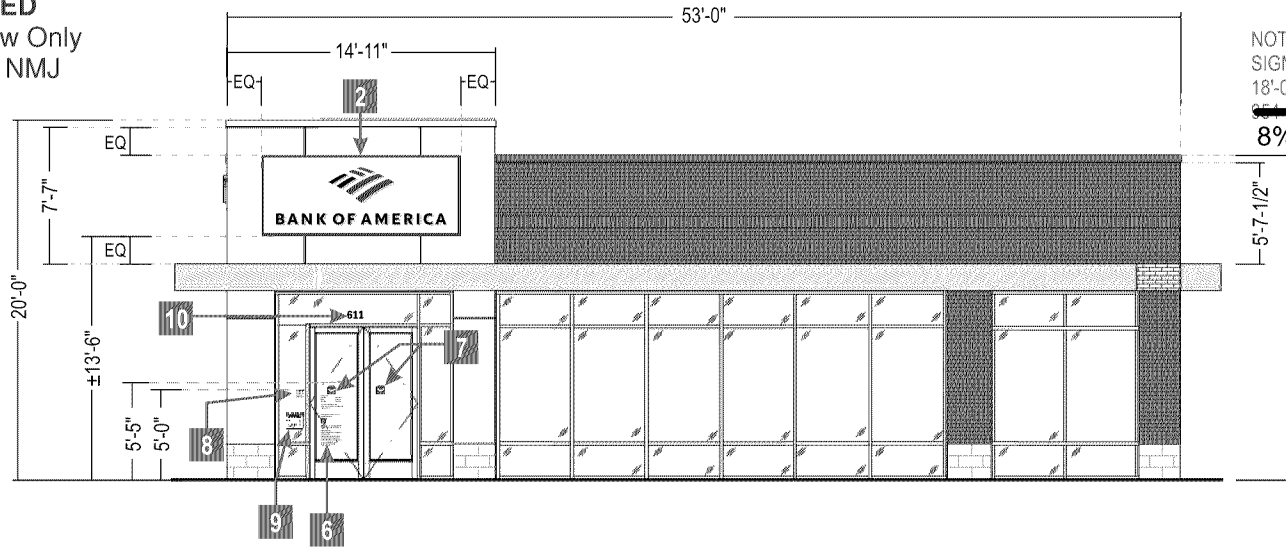

NOTE:
SIGN AREA CALCULATIONS
18'-0" HEIGHT x 53'-0" WIDTH = 954 SQFT
~~1100 SQ FT - 12% ALLOWED BY CODE = 124 MAXIMUM SQ FT~~
8% allowed = 76 square feet

PRIMARY ELEVATION (EAST)

SCALE: 3/32"=1'-0"

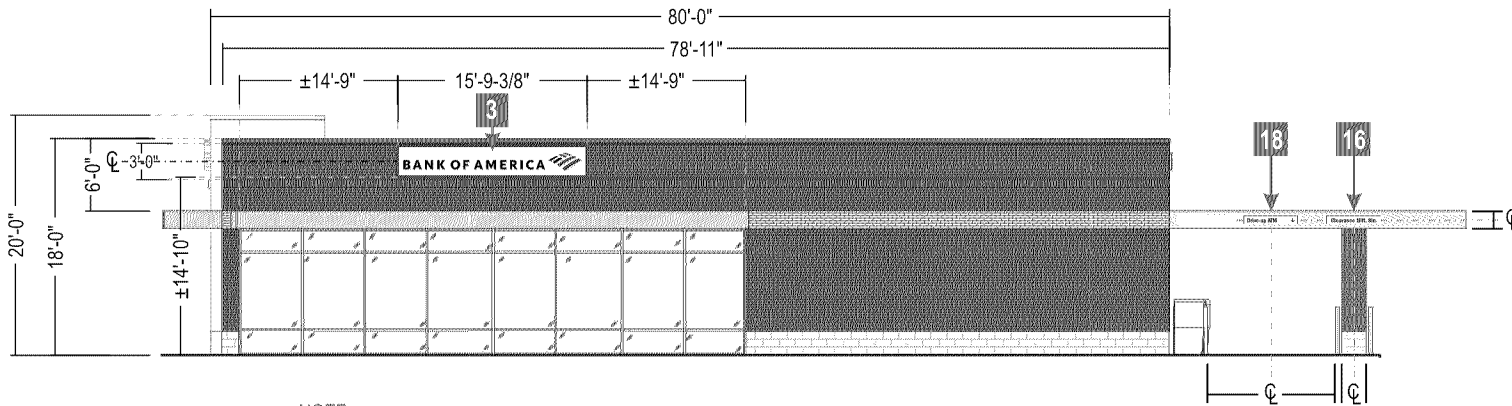

NOTE:
SIGN AREA CALCULATIONS
18'-0" HEIGHT x 80'-0" WIDTH = 1440 SQ FT FACIA
~~1100 SQ FT - 12% ALLOWED BY CODE = 124 MAXIMUM SQ FT~~
4% allowed = 58 square feet

SECONDARY ELEVATION (NORTH)

SCALE: 1/16"=1'-0"

Drawing prepared by:

ELEVATION

Drawing prepared for:


Location: 611 W 98th St.
Bloomington, MN 55420-4715
File Path: Active\BANKS\B\Bank Of America\2020\Locations\4305_6110_Bloomington_MN_R6.cdr

Proj #: 4305
Loc #: 6110



Rev #:	Req#:	Date:	Req. By:	Drawn By:	Revision Description:	Rev #:	Req#:	Date:	Req. By:	Drawn By:
Original	326276	05/08/20	MH	Sb	Drawings are the exclusive property of STRATUS. Any unauthorized use or duplication is not permitted.					
Rev 1	326745	05/27/20	MH	NPP	Rev Sign1 and 2 - Ltrs on Backer, plus addition changes.	Rev 7	000000	00/00/00	XXX	XXX
Rev 2	327028	06/06/20	MH	Sb	Various Changes - See Request	Rev 8	000000	00/00/00	XXX	XXX
Rev 3	327276	06/14/20	MH	Sb	Change Signs 4 & 5 to D5ng	Rev 9	000000	00/00/00	XXX	XXX
Rev 4	329078	08/17/20	MH	Sb	Added bank hours and clearance bar height	Rev 10	000000	00/00/00	XXX	XXX
Rev 5	337194	03/16/20	MH	Lv	Added sign 7 - Caution automatic door decal					
Rev 6	337496	03/23/20	MH	Lv	Update site plan - update sign one & re-named elevations					


APPROVED
Zoning Review Only
04/20/2021 NMJ

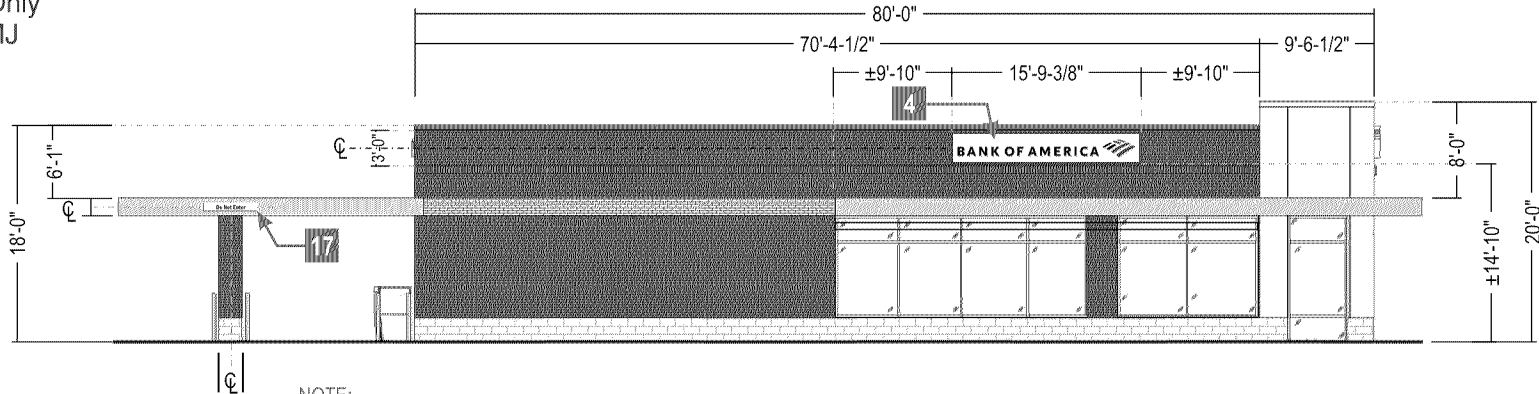

NOTE:
SIGN AREA CALCULATIONS
18'-0" HEIGHT x 80'-0" WIDTH = 1440 SQ FT FACIA
~~1440 SQ FT x 40% ALLOWED BY CODE = 576 MAXIMUM SQ FT~~

SECONDARY ELEVATION (SOUTH) 4% allowed= 58 square feet

SCALE: 1/16"=1'-0"

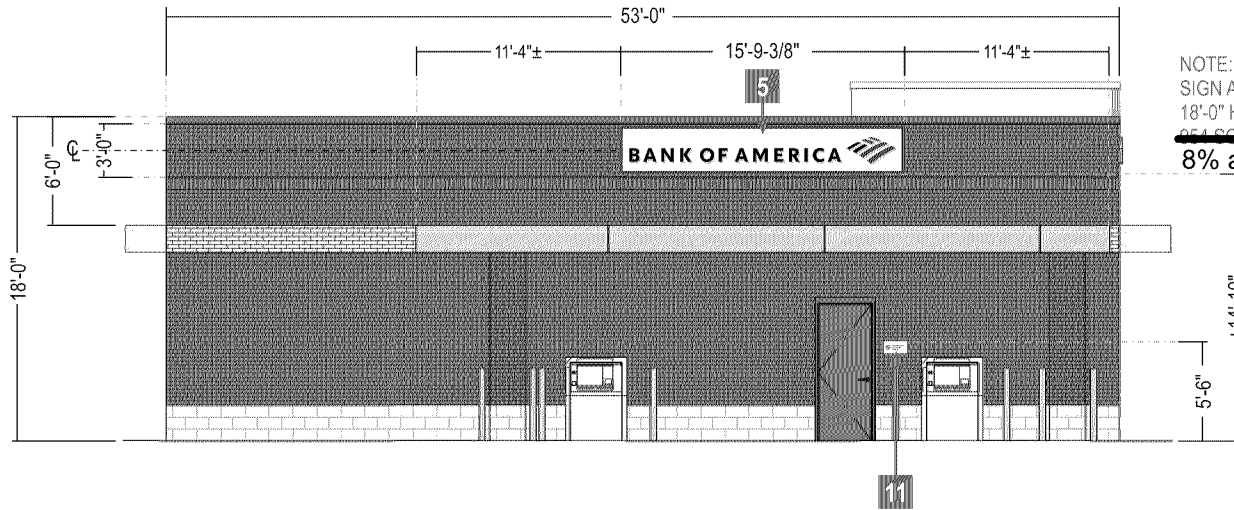

NOTE:
SIGN AREA CALCULATIONS
18'-0" HEIGHT x 53'-0" WIDTH = 954 SQFT
~~954 SQ FT x 40% ALLOWED BY CODE = 381 MAXIMUM SQ FT~~
8% allowed= 76 square feet

PRIMARY ELEVATION (WEST)

SCALE: 3/32"=1'-0"

Drawing prepared by: **ELEVATION**

Location: 611 W 98th St. Bloomington, MN 55420-4715
 Proj #: 4305
 Loc #: 6110
 File Path: Active\BANKS\B\Bank Of America\2020\Locations\4305_6110_Bloomington_MN_R6.cdr

Drawing prepared for: **BANK OF AMERICA**

Rev #:	Req#:	Date:	Req. By:	Drawn By:	Revision Description:	Req. #:	Req#:	Date:	Req. By:	Drawn By:
Original	326276	05/08/20	MH	Sb		Rev 7	000000	00/00/00	XXX	XXX
Rev 1	326745	05/27/20	MH	NPP	Rev Sign1 and 2 - Ltrs on Backer, plus addition changes.	Rev 8	000000	00/00/00	XXX	XXX
Rev 2	327028	06/06/20	MH	Sb	Various Changes - See Request	Rev 9	000000	00/00/00	XXX	XXX
Rev 3	327276	06/14/20	MH	Sb	Change Signs 4 & 5 to D5ng	Rev 10	000000	00/00/00	XXX	XXX
Rev 4	329078	08/17/20	MH	Sb	Added bank hours and clearance bar height					
Rev 5	337194	03/16/20	MH	Lv	Added sign 7 - Caution automatic door decal					
Rev 6	337496	03/23/20	MH	Lv	Update site plan - update sign one & re-named elevations					

Pg. 6



APPROVED
Zoning Review Only
04/20/2021 NMJ

STRUCTURAL STEEL SPECIFICATIONS:

- SUPPORT MEMBERS SHALL BE FREE FROM DEFECTS. TUBE SHALL MEET ASTM A500 GRADE B, WITH A MINIMUM YIELD STRENGTH OF 46000 PSI. PIPE SHALL MEET ASTM A53 GRADE B, WITH A MINIMUM YIELD STRENGTH OF 35000 PSI. PLATE AND ANGLE SHALL MEET ASTM A36.
- STRUCTURAL BOLTS SHALL BE ZINC COATED A325 UNLESS OTHERWISE NOTED.
- WELDS SHALL BE MADE WITH E70XX ELECTRODES BY PERSONS QUALIFIED IN ACCORDANCE WITH AWS STANDARDS WITHIN THE PAST TWO YEARS.
- REINFORCING BARS SHALL CONFORM TO ASTM A615 GRADE 60 WITH DEFORMATIONS IN ACCORDANCE WITH ASTM A-305. WELDING OF REINFORCING BARS IS PROHIBITED.
- ANCHOR BOLTS SHALL BE ASTM F1554-07 GRADE 55 ROUND STOCK. EXPOSED SURFACES SHALL BE GALVANIZED OR HAVE BITUMINOUS COATING TO PREVENT CORROSION.

NOTE: SIGN IS TO BE WIRED WITH 14 GAGE STRANDED 1,000 WIRE THHN PER DIAGRAM ON BALLAST. ELECTRICAL LEADS TO BE 14 GAGE SOLID 600 V WIRE THHN. SIGN MUST BE GROUNDED WITH 14 GAGE SOLID 600 V GREEN WIRE THHN.

THIS SIGN IS INTENDED TO BE INSTALLED IN ACCORDANCE WITH THE REQUIREMENTS OF ARTICLE 600 OF THE NATIONAL ELECTRICAL CODE AND/OR OTHER APPLICABLE LOCAL CODES. THIS INCLUDES PROPER GROUNDING AND BONDING OF SIGN.

SIGN INTERIOR TO BE PAINTED FLAT WHITE FOR MAXIMUM REFLECTIVITY

PROTECT ANCHOR BOLTS, NUTS, AND WASHERS FROM CORROSION WITH BITUMINOUS COATING


USE WHITE SILICONE TO CONCEAL LIGHT LEAKS

TOLERANCE: ± 1/16" ON ALL DIMENSIONS

THIS SIGN TO BEAR THIS MARK



ELECTRIC SIGN

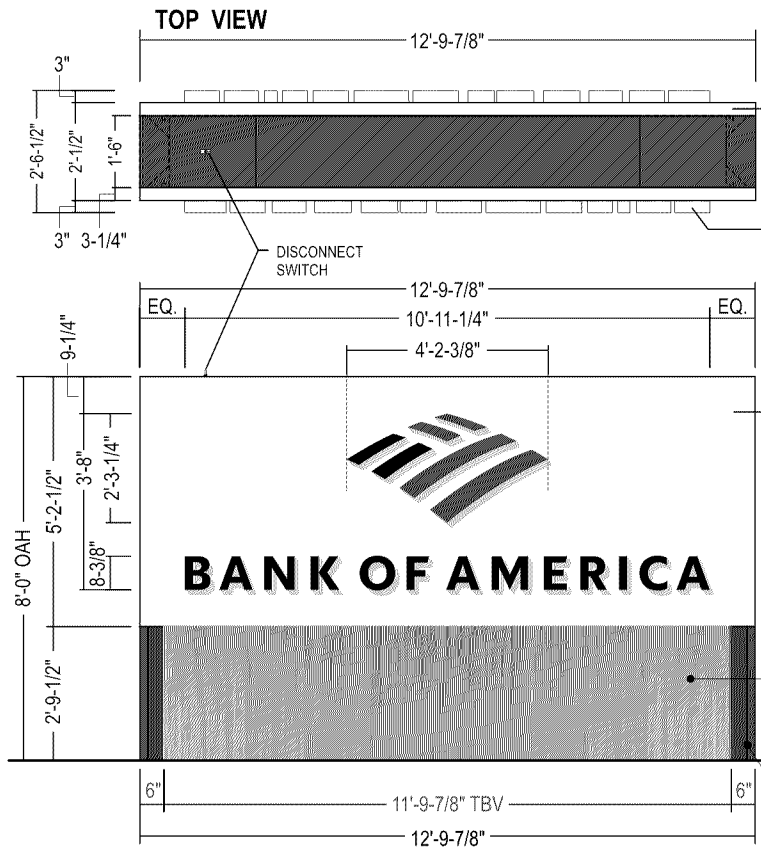

PAINT GARBO SILVER - MATTHEWS #MP02650R14405 LVG FULL GLOSS.

- CHANNEL LETTER FACES, PLASKOLITE 2406 LD.
- TRANSLUCENT BLUE - 3M 3630-8530 w/ OVERLAM 3M 3660M.
- TRANSLUCENT RED - 3M 3630-2413 w/ OVERLAM 3M 3660M.
- LETTER & LOGO RETURNS .040" ALUMINUM COIL BRITE BRUSHED CLEAR by ALUMET SUPPLY


.125" ALUM. SIGN FACE PAINTED GARBO SILVER - MATTHEWS #MP02650R14405 LVG FULL GLOSS.

3" DEEP LETTERS & LOGO LED ILLUMINATED w/ DROP IN FACES

LETTER & LOGO RETURNS .040" ALUMINUM COIL BRITE BRUSHED CLEAR by ALUMET SUPPLY

4MM ALUCOBOND NATURAL BRUSHED 50 ACM

.125" ALUM. SHEET BRAKEFORMED ALUM. CLADDING PAINTED MATTHEWS RED #MP49696, SEMI-GLOSS FINISH

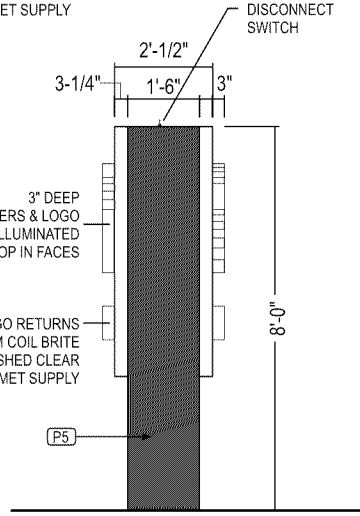

SIDE VIEW

1 B4.1-FWng - 8'-0" Monument with Foundation 66.8 SQ FT

QTY: 1

STANDARD SPECS - SEE COLOR SPECIFICATION LIBRARY

NOTE: PENDING CITY COUNCIL APPROVAL

SCALE: 1/4"=1'-0"

SIGN #1 NOTE:

10'-0" Setback from ROW to Leading Edge of Sign from 98th Street and Driveway. Pending City Council Approval.



FIELD VERIFICATION IS REQUIRED FOR ALL GROUND SIGNS TO ENSURE THAT THE RECOMMENDED SIGN WILL FIT IN THE RECOMMENDED LOCATION, TAKING INTO ACCOUNT ALL SET-BACKS, OBSTRUCTIONS, UNDERGROUND UTILITIES, ETC. IF A PROBLEM IS DETECTED BY THE FIELD VERIFICATION, AN IFR SHOULD BE SUBMITTED FOR MODIFICATION BY MONIGLE ASSOCIATES PRIOR TO ANY MANUFACTURING. INSTALL NEW SIGNAGE USING EXISTING PRIMARY ELECTRICAL. VERIFY IF ADDITIONAL CIRCUITS ARE REQUIRED FOR NEW SIGN. RESTORE GROUND MATERIAL TO BASE OF NEW SIGN.

Drawing prepared by:

RECOMMENDATION


Drawing prepared for:




Location: 611 W 98th St. Bloomington, MN 55420-4715
 Proj #: 4305
 Loc #: 6110
 File Path: Active\BANKS\B\Bank Of America\2020\Locations\4305_6110_Bloomington_MN_R6.cdr



Rev #:	Req#:	Date:	Req. By:	Drawn By:	Revision Description:	Rev #:	Req#:	Date:	Req. By:	Drawn By:
Original	326276	05/08/20	MH	Sb						
Rev 1	326745	05/27/20	MH	NPP	Rev Sign1 and 2 - Ltrs on Backer, plus addition changes.	Rev 7	000000	00/00/00	XXX	XXX
Rev 2	327028	06/06/20	MH	Sb	Various Changes - See Request	Rev 8	000000	00/00/00	XXX	XXX
Rev 3	327276	06/14/20	MH	Sb	Change Signs 4 & 5 to D5ng	Rev 9	000000	00/00/00	XXX	XXX
Rev 4	329078	08/17/20	MH	Sb	Added bank hours and clearance bar height	Rev 10	000000	00/00/00	XXX	XXX
Rev 5	337194	03/16/20	MH	Lv	Added sign 7 - Caution automatic door decal					
Rev 6	337496	03/23/20	MH	Lv	Update site plan - update sign one & re-named elevations					

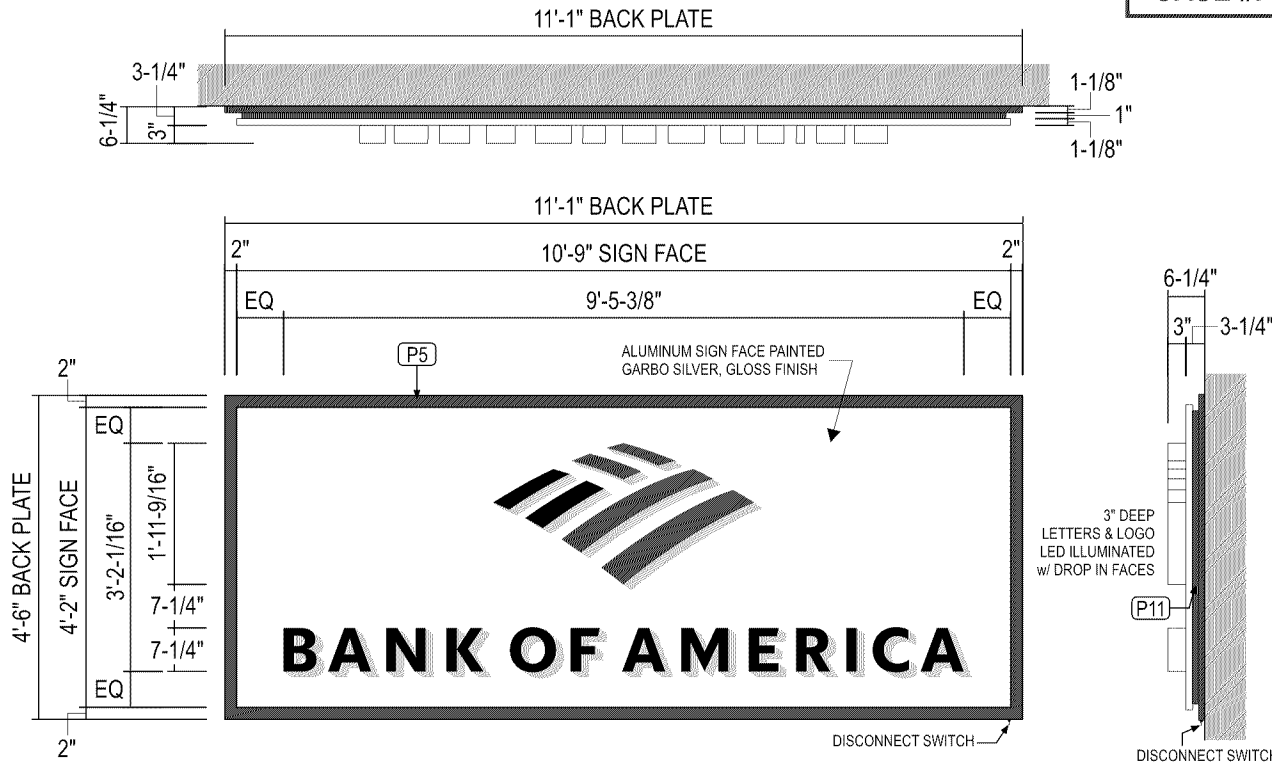

125" ALUMINUM BACKING SHEET.
1"X ALUMINUM TUBE FRAME AT PERIMETER OF BACKING SHEET.
HEADER PANEL TO HINGE w/ S.S. PIANO HINGE.
SIGN FACE TO BE 125" ALUMINUM FORM AS SHOWN. CHEM WELD 1"X1"X125" ALUMINUM TUBE FRAME AT PERIMETER TO FORM SIGN BOX.
125" ALUMINUM ANGLE FRAME.

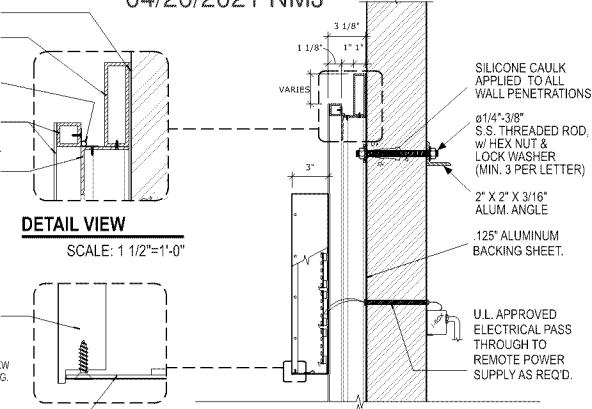

DETAIL VIEW
SCALE: 1 1/2"=1'-0"

LETTER FACE TO BE 1/2" ACRYLIC. ROUTE 3/8" FROM BACK TO FRONT LEAVING A 1/8" THICK BY 5/32" WIDE 'SHOULDER' AT THE FACE. FIRST SURFACE DECORATE w/ BoA BLUE/RED TRANSLUCENT FILM w/ OVER LAMINATE. EXPOSED RETURNS TO HAVE A MILL FINISH. SECURE w/ 3/8" SHORT SHANK FLATHEAD S.S. SCREWS INTO CENTER OF 3/8" ACRYLIC FACE RETURN. PRE DRILL ONLY TO SCREW DEPTH TO PREVENT TELEGRAPHING.

DETAIL VIEW
SCALE: 6"=1'-0"


LETTER RETURNS TO BE .040" ALUMINUM COIL BRITE BRUSHED CLEAR BY ALUMET SUPPLY. FORM AS SHOWN.

DETAIL VIEW
SCALE: 1 1/2"=1'-0"

LETTER BACKS TO BE .090" ALUMINUM. PAINT FINISH INTERIOR SURFACES w/ LIGHT ENHANCEMENT PAINT.
LED MODULE
WEEP HOLE & LIGHT SCREEN AS REQ'D.
125" ALUMINUM ANGLE FRAME.
1"X1" ALUMINUM ANGLE ON BOTTOM OF SIGN BOX. CHEM WELD TO 1"X1" TUBE FRAME. MECHANICALLY ATTACH TO 2"X2" ANGLE w/ COUNTERSUNK FLATHEAD S.S. SCREWS.

DETAIL VIEW
SCALE: 1 1/2"=1'-0"

DETAIL VIEW
SCALE: 1 1/2"=1'-0"

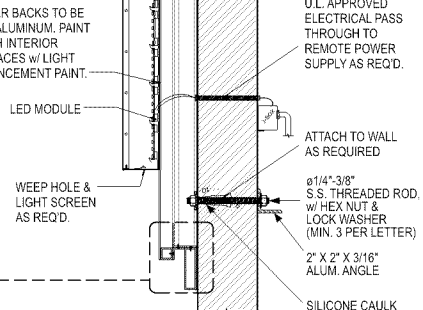

VERTICAL SECTION
SCALE: 3/4"=1'-0"

DESIGN LOADS:
115 MPH WIND LOAD
RISK CATEGORY II, EXPOSURE C.
2015 INTERNATIONAL BUILDING CODE, SECTION 16 WIND LOAD, ASCE 7-10

2 C3ng - ILLUMINATED CHANNEL LETTERS ON A NON-ILLUM. BACKER 49.89 SQ FT SIDE VIEW

QTY: 1
STANDARD SPECS - SEE COLOR SPECIFICATION LIBRARY

MATERIAL SPECIFICATIONS
PAINT
RED - MATTHEWS RED #MP49696, AKZO-NOBEL #SIGN 20129.
DK GRAY - (PMS 425) - MATTHEWS #MP58477
GARBO SILVER - MATTHEWS #MP02650R14405 LVG FULL GLOSS.
FILM
TRANSLUCENT BLUE - 3M 3630-8530 w/ OVERLAM 3M 3660M.
TRANSLUCENT RED - 3M 3630-2413 w/ OVERLAM 3M 3660M.
ACRYLIC
CHANNEL LETTER FACES, PLASKOLITE 2406 LD.
ALUMINUM
LETTER & SYMBOL RETURNS, .040" ALUMINUM COIL BRITE BRUSHED CLEAR BY ALUMET SUPPLY.

WALL TYPE	PREFERRED FOR ALL WALL TYPES WHEN POSSIBLE	EIFS WALL W/ FOAM INSULATION
SECTION		
ANCHOR TYPE	ø1/4"-3/8" THREADED ROD	ø1/4"-3/8" THREADED ROD W/ ALUMINUM OR PVC COMPRESSION SLEEVE

Drawing prepared by: **Stratus**

RECOMMENDATION





Location: 611 W 98th St, Bloomington, MN 55420-4715
 Proj #: 4305
 Loc #: 6110
 File Path: Active\BANKS\B\Bank Of America\2020\Locations\4305_6110_Bloomington_MN_R6.cdr

Drawing prepared for: **BANK OF AMERICA**

Rev #:	Req#:	Date:	Req. By:	Drawn By:	Revision Description:	Rev #:	Req#:	Date:	Req. By:	Drawn By:
Original	326276	05/08/20	MH	Sb						
Rev 1	326745	05/27/20	MH	NPP	Rev Sign1 and 2 - Ltrs on Backer, plus addition changes.	Rev 7	000000	00/00/00	XXX	XXX
Rev 2	327028	06/06/20	MH	Sb	Various Changes - See Request	Rev 8	000000	00/00/00	XXX	XXX
Rev 3	327276	06/14/20	MH	Sb	Change Signs 4 & 5 to D5ng	Rev 9	000000	00/00/00	XXX	XXX
Rev 4	329078	08/17/20	MH	Sb	Added bank hours and clearance bar height	Rev 10	000000	00/00/00	XXX	XXX
Rev 5	337194	03/16/20	MH	Lv	Added sign 7 - Caution automatic door decal					
Rev 6	337496	03/23/20	MH	Lv	Update site plan - update sign one & re-named elevations					

Pg. 8

APPROVED
Zoning Review Only
04/20/2021 NMJ

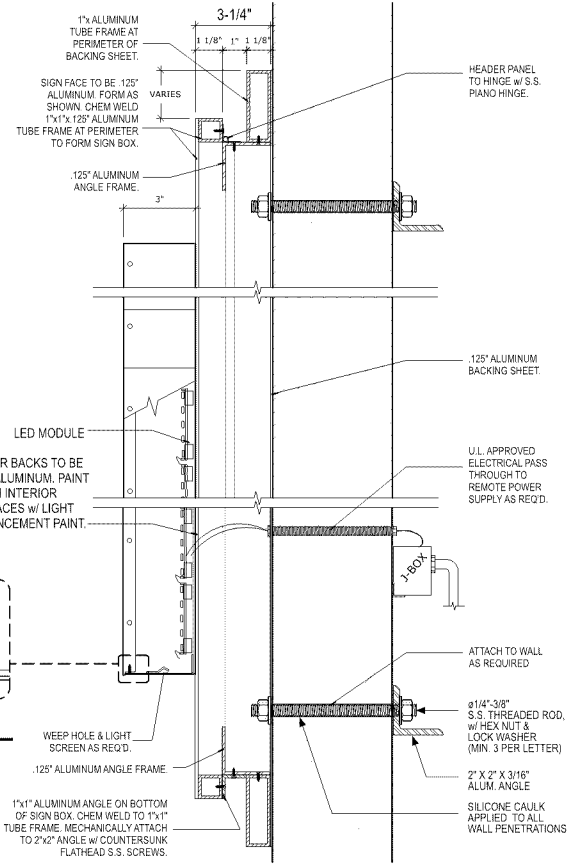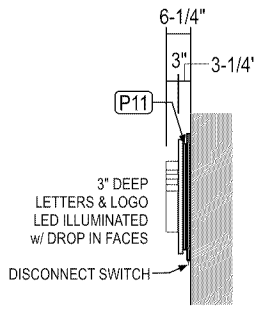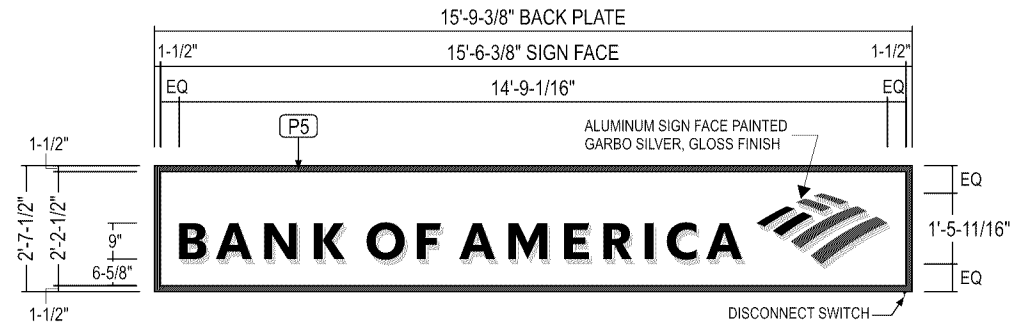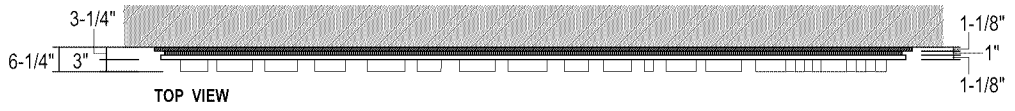

3 4 5 D5ng - 9" ILLUMINATED CHANNEL LETTERS on NON-ILLUM. BACKER PANEL 41.42 SQ FT

QTY: 3
STANDARD SPECS - SEE COLOR SPECIFICATION LIBRARY

MATERIAL SPECIFICATIONS
PAINT
 RED - MATTHEWS RED #MP49696, AKZO-NOBEL #SIGN 20129.
 DK GRAY - (PMS 425) - MATTHEWS #MP58477
 GARBO SILVER - MATTHEWS #MP02650R14405 LVG FULL GLOSS.
FILM
 TRANSLUCENT BLUE - 3M 3630-8530 w/ OVERLAM 3M 3660M.
 TRANSLUCENT RED - 3M 3630-2413 w/ OVERLAM 3M 3660M.
ACRYLIC
 CHANNEL LETTER FACES, PLASKOLITE 2406 LD.
ALUMINUM
 LETTER & SYMBOL RETURNS, .040" ALUMINUM COIL BRITE BRUSHED CLEAR BY ALUMET SUPPLY.


THIS SIGN IS INTENDED TO BE INSTALLED IN ACCORDANCE WITH THE REQUIREMENTS OF ARTICLE 600 OF THE NATIONAL ELECTRICAL CODE AND/OR OTHER APPLICABLE LOCAL CODES. THIS INCLUDES PROPER GROUNDING AND BONDING OF SIGN.

TOLERANCE: ± 1/16" ON ALL DIMENSIONS

USE WHITE SILICONE TO CONCEAL LIGHT LEAKS

LETTER FACE TO BE 1/2" ACRYLIC. ROUTE 3/8" FROM BACK TO FRONT LEAVING A 1/8" THICK BY 5/32" WIDE "SHOULDER" AT THE FACE. FIRST SURFACE DECORATE w/ B&A BLUERED TRANSLUCENT FILM w/ OVER LAMINATE. EXPOSED RETURNS TO HAVE A MILL FINISH. SECURE w/ 3/8" SHORT SHANK FLATHEAD S.S. SCREWS INTO CENTER OF 3/8" ACRYLIC FACE RETURN. PRE-DRILL ONLY TO SCREW DEPTH TO PREVENT TELEGRAPHING.

LETTER RETURNS TO BE .040" ALUMINUM COIL BRITE BRUSHED CLEAR BY ALUMET SUPPLY FORM AS SHOWN.

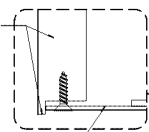

DETAIL VIEW
SCALE: 1/2"=1'-0"

DESIGN LOADS:
115 MPH WIND LOAD
RISK CATEGORY II, EXPOSURE C.
2015 INTERNATIONAL BUILDING CODE, ASCE 7-10

VERTICAL SECTION
SCALE: 1 1/2"=1'-0"

WALL TYPE	PREFERRED FOR ALL WALL TYPES WHEN POSSIBLE	EIFS WALL W/ FOAM INSULATION
SECTION		
ANCHOR TYPE	Ø1/4"-3/8" THREADED ROD	Ø1/4"-3/8" THREADED ROD W/ ALUMINUM OR PVC COMPRESSION SLEEVE

MATERIAL: White applied vinyl
3M #7725-10

APPLICATION: Apply all vinyl on first surface.

HANDICAP SYMBOL: Handicap symbol to be reverse silkscreened blue field on white 3M #7725-10 vinyl. Symbol of accessibility to reverse out white. Use UV inks manufactured by Sericol or approved equal. Blue field to match PMS 7462C, finish to meet 70% gloss ADA compliance requirements. When required, always apply handicap vinyl to exterior of glass. Use only on Handicap accessible entrance doors.

INSTALL NOTES:

ADA Signage Requirements:



- Doors shall be equipped with Automatic Door decals visible from either side of door (double sided)
- Decals shall be mounted 4'-2" +/- 12" from the floor to center line of decal

Standard Door Vinyl Applications:

- Decal is to be installed 5'-0" from floor to center line of sign
- "Bank of America" vinyl logo to be moved up 5" to accommodate automatic door decal

Decal or sign selection guidelines have been set based on door access and surrounding conditions, field verify existing surrounding wall and card reader conditions prior to install.

CASE #PL2021-72

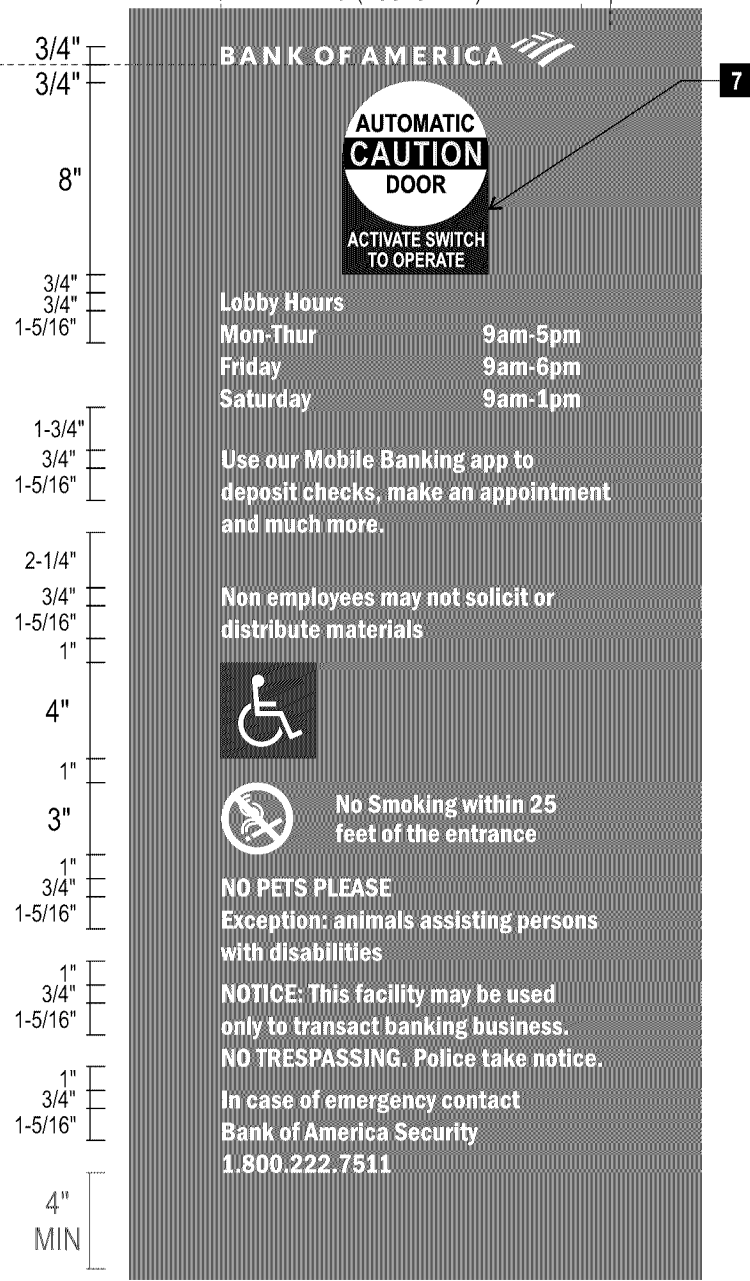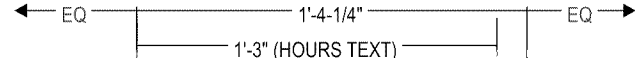


7 AUTOMATIC DOOR DECAL

QTY: 2 SCALE: 1 1/2"=1'-0"

DOUBLE-SIDED PERMANENT ADHESIVE VINYL LABEL. 8"X6" OVERALL SIZE

DECAL TO BE PROVIDED BY SYSTECH AND INSTALLED BY STRATUS

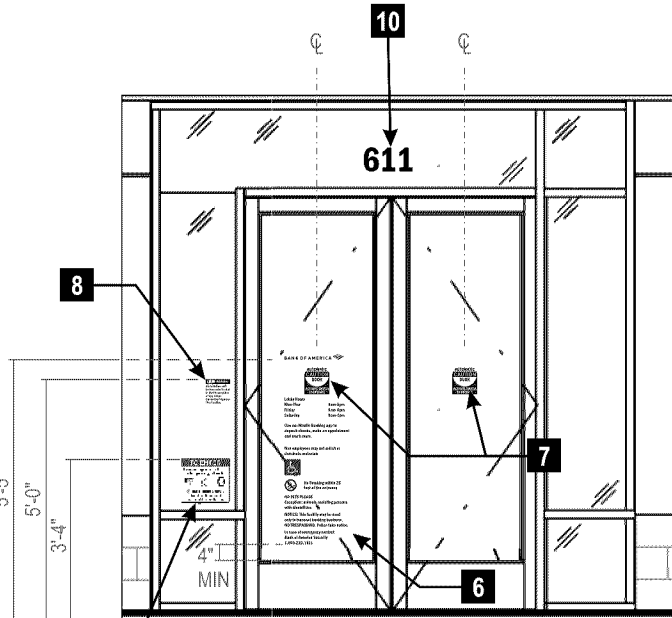

9 PROPOSED ELEVATION - LAYOUT VIEW

SCALE: 1/4"=1'-0"

6 DOOR VINYL - STANDARD w/ ADA DECAL

QTY: 1

SCALE: 1 1/2"=1'-0"

Drawing prepared by:

RECOMMENDATION


Drawing prepared for:

Location: 611 W 98th St.
Bloomington, MN 55420-4715
Proj #: 4305
Loc #: 6110
File Path:




Active\BANKS\B\Bank Of America\2020\Locations\4305_6110_Bloomington_MN_R6.cdr

Rev #:	Req#:	Date:	Req. By:	Drawn By:	Revision Description:	Rev #:	Req#:	Date:	Req. By:	Drawn By:
Original	326276	05/08/20	MH	Sb	Drawings are the exclusive property of STRATUS. Any unauthorized use or duplication is not permitted.					
Rev 1	326745	05/27/20	MH	NPP	Rev Sign1 and 2 - Ltrs on Backer, plus addition changes.	Rev 7	000000	00/00/00	XXX	XXX
Rev 2	327028	06/06/20	MH	Sb	Various Changes - See Request	Rev 8	000000	00/00/00	XXX	XXX
Rev 3	327276	06/14/20	MH	Sb	Change Signs 4 & 5 to D5ng	Rev 9	000000	00/00/00	XXX	XXX
Rev 4	329078	08/17/20	MH	Sb	Added bank hours and clearance bar height	Rev 10	000000	00/00/00	XXX	XXX
Rev 5	337194	03/16/20	MH	Lv	Added sign 7 - Caution automatic door decal					
Rev 6	337496	03/23/20	MH	Lv	Update site plan - update sign one & re-named elevations					

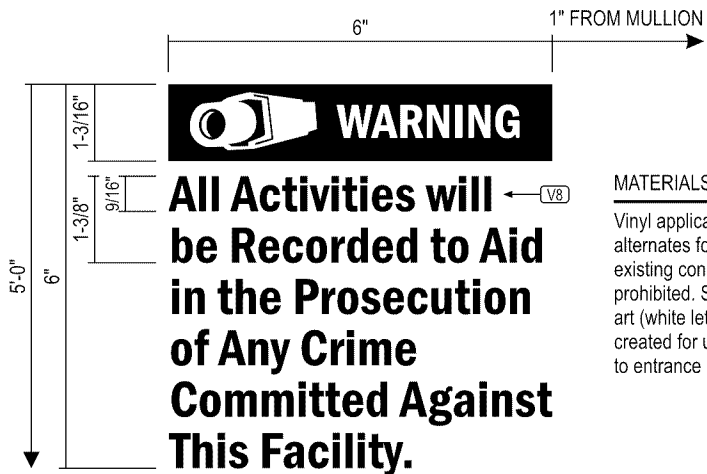

MATERIALS/APPLICATION
 Vinyl applications are to serve as alternates for Wall Signs where existing conditions are not ideal or prohibited. Standard window vinyl art (white letters) have been created for use on windows next to entrance doors.

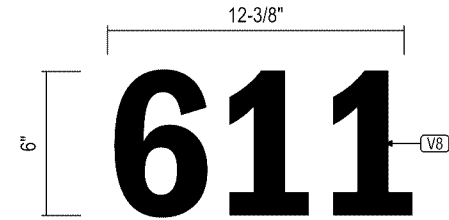

10 WHITE ADDRESS NUMERALS


QTY: 1
 FIRST SURFACE APPLICATION

SCALE: 1 1/2"=1'-0"

8 SECURITY CAMERA VINYL

QTY: 1
 VINYL SHOULD BE MOUNTED 1" FROM MULLION
 FIRST SURFACE APPLICATION

SCALE: 1:3

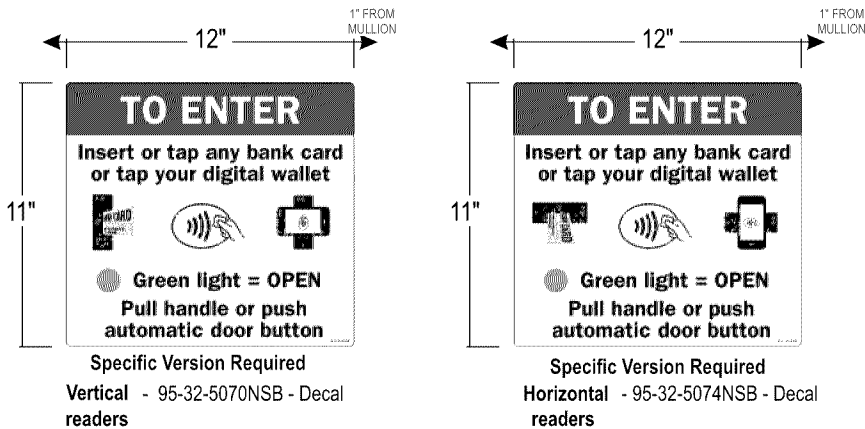


9 CARD READER DECAL AUTOMATIC DOORS

QTY: 1
 FIRST SURFACE APPLICATION

SCALE: 1-1/2"=1'-0"

- INSTALL HEIGHT: CARD READER DECAL HEIGHT MINIMUM STANDARD IS 40" ABOVE FINISHED FLOOR AND 1 INCH AWAY FROM DOOR MULLION.
 DECAL TO BE PROVIDED BY SYSTECH AND INSTALLED BY STRATUS

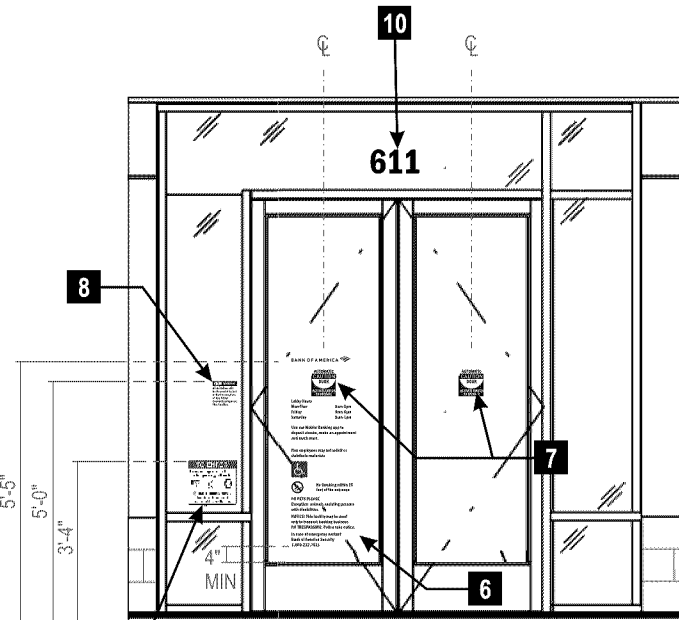

PROPOSED ELEVATION - LAYOUT VIEW

SCALE: 1/4"=1'-0"

Drawing prepared by:

RECOMMENDATION

Drawing prepared for:

Location: 611 W 98th St.
 Bloomington, MN 55420-4715


Proj #: 4305
 Loc #: 6110

File Path:



Active\BANKS\B\Bank Of America\2020\Locations\4305_6110_Bloomington_MN_R6.cdr

Rev #:	Req#:	Date:	Req. By:	Drawn By:	Revision Description:	Rev #:	Req#:	Date:	Req. By:	Drawn By:
Original	326276	05/08/20	MH	Sb						
Rev 1	326745	05/27/20	MH	NPP	Rev Sign1 and 2 - Ltrs on Backer, plus addition changes.	Rev 7	000000	00/00/00	XXX	XXX
Rev 2	327028	06/06/20	MH	Sb	Various Changes - See Request	Rev 8	000000	00/00/00	XXX	XXX
Rev 3	327276	06/14/20	MH	Sb	Change Signs 4 & 5 to D5ng	Rev 9	000000	00/00/00	XXX	XXX
Rev 4	329078	08/17/20	MH	Sb	Added bank hours and clearance bar height	Rev 10	000000	00/00/00	XXX	XXX
Rev 5	337194	03/16/20	MH	Lv	Added sign 7 - Caution automatic door decal					
Rev 6	337496	03/23/20	MH	Lv	Update site plan - update sign one & re-named elevations					

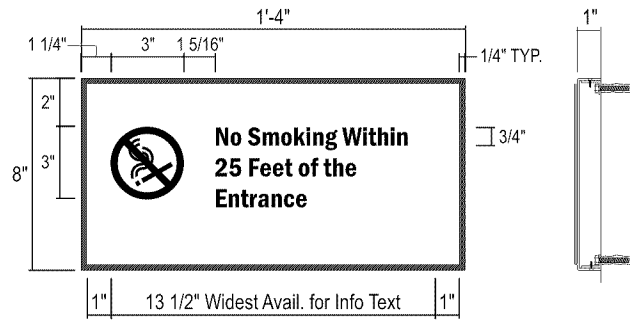


MATERIAL SPECIFICATIONS

PAINT
 RED - MATTHEWS RED #MP49696, AKZO-NOBEL #SIGN 20129.
 GARBO SILVER - MATTHEWS #MP02650R14405 LVG FULL GLOSS.
FILM
 TRANSLUCENT BLUE - 3M 3630-8530 w/ OVERLAM 3M 3660M.
 OPAQUE WHITE - 3M 7725-10.

11 NO SMOKING PLAQUE - INFORMATIONAL SIGN (0.89 S.F.)


QTY: 1

SCALE: 1 1/2"=1'-0"

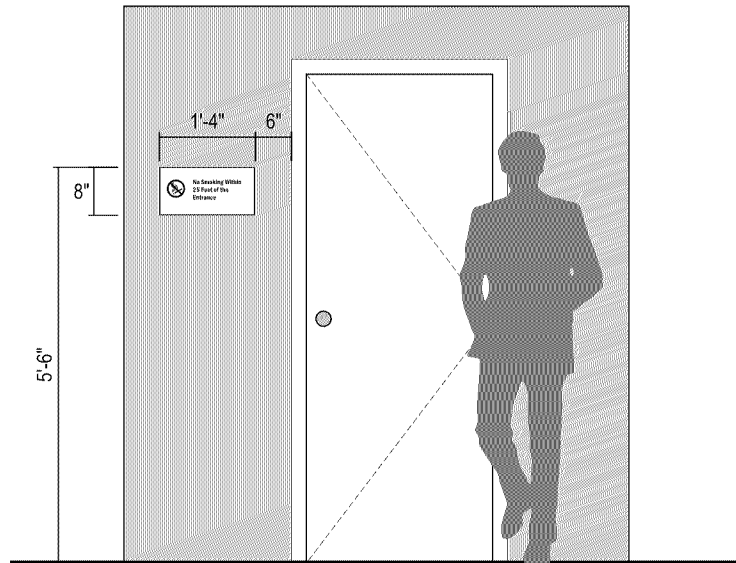

NO SMOKING PLAQUE - TYPICAL INSTALLATION (EXTERIOR)

SCALE: 3/8"=1'-0"

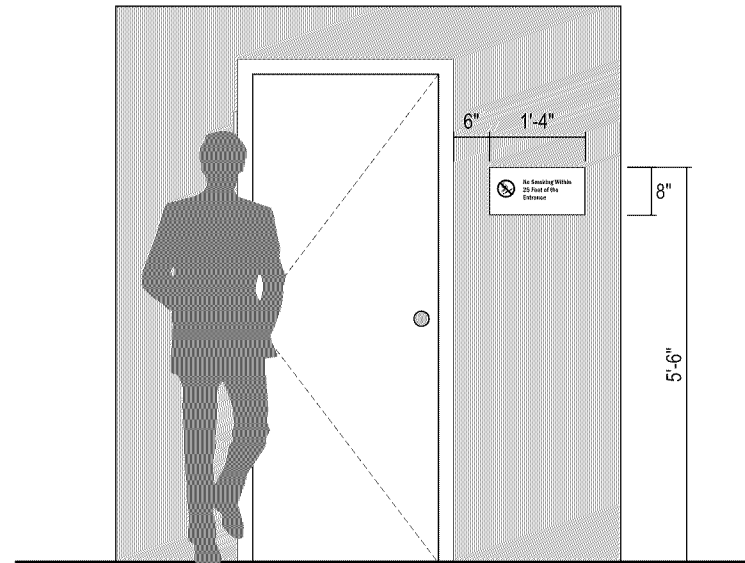

NO SMOKING PLAQUE - TYPICAL INSTALLATION (EXTERIOR)

SCALE: 3/8"=1'-0"

Drawing prepared by:

RECOMMENDATION

Drawing prepared for:

Location: 611 W 98th St.
 Bloomington, MN 55420-4715
 File Path: Active\BANKS\B\Bank Of America\2020\Locations\4305_6110_Bloomington_MN_R6.cdr

Proj #: 4305
 Loc #: 6110




Rev #:	Req#:	Date:	Req. By:	Drawn By:	Revision Description:	Rev #:	Req#:	Date:	Req. By:	Drawn By:
Original	326276	05/08/20	MH	Sb						
Rev 1	326745	05/27/20	MH	NPP	Rev Sign1 and 2 - Ltrs on Backer, plus addition changes.	Rev 7	000000	00/00/00	XXX	XXX
Rev 2	327028	06/06/20	MH	Sb	Various Changes - See Request	Rev 8	000000	00/00/00	XXX	XXX
Rev 3	327276	06/14/20	MH	Sb	Change Signs 4 & 5 to D5ng	Rev 9	000000	00/00/00	XXX	XXX
Rev 4	329078	08/17/20	MH	Sb	Added bank hours and clearance bar height	Rev 10	000000	00/00/00	XXX	XXX
Rev 5	337194	03/16/20	MH	Lv	Added sign 7 - Caution automatic door decal					
Rev 6	337496	03/23/20	MH	Lv	Update site plan - update sign one & re-named elevations					

CASE #PL2021-72

APPROVED
Zoning Review Only
04/20/2021 NMJ

DIRECTIONAL COPY AND ARROWS
REFLECTIVE FILM 3M #680-75 BLUE.


TYPEFACE TO BE FRANKLIN
GOTHIC DEMI CONDENSED. VERIFY
ALL COPY PRIOR TO FABRICATION.

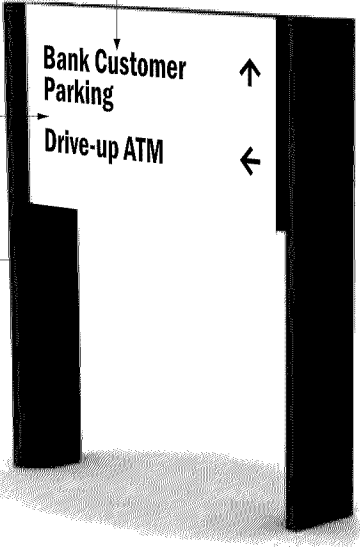

.125" ALUMINUM SIGN FACE.
WELD TO ALUM. ANGLE FRAME.
PAINT FINISH GARBO SILVER
MATTHEWS #MP02650 R14405
LVG FULL GLOSS.

.090" BREAK FORMED
ALUMINUM FRAME. FORM
AS SHOWN. CLADDING TO
ATTACH TO SUPPORT TUBE.

PAINT FINISH ALL
EXPOSED SURFACES
MATTHEWS RED #MP49696,
AKZO-NOBEL #SIGN 20129,
SEMI-GLOSS
WELD TO SUPPORT
TUBE VERTICALS.

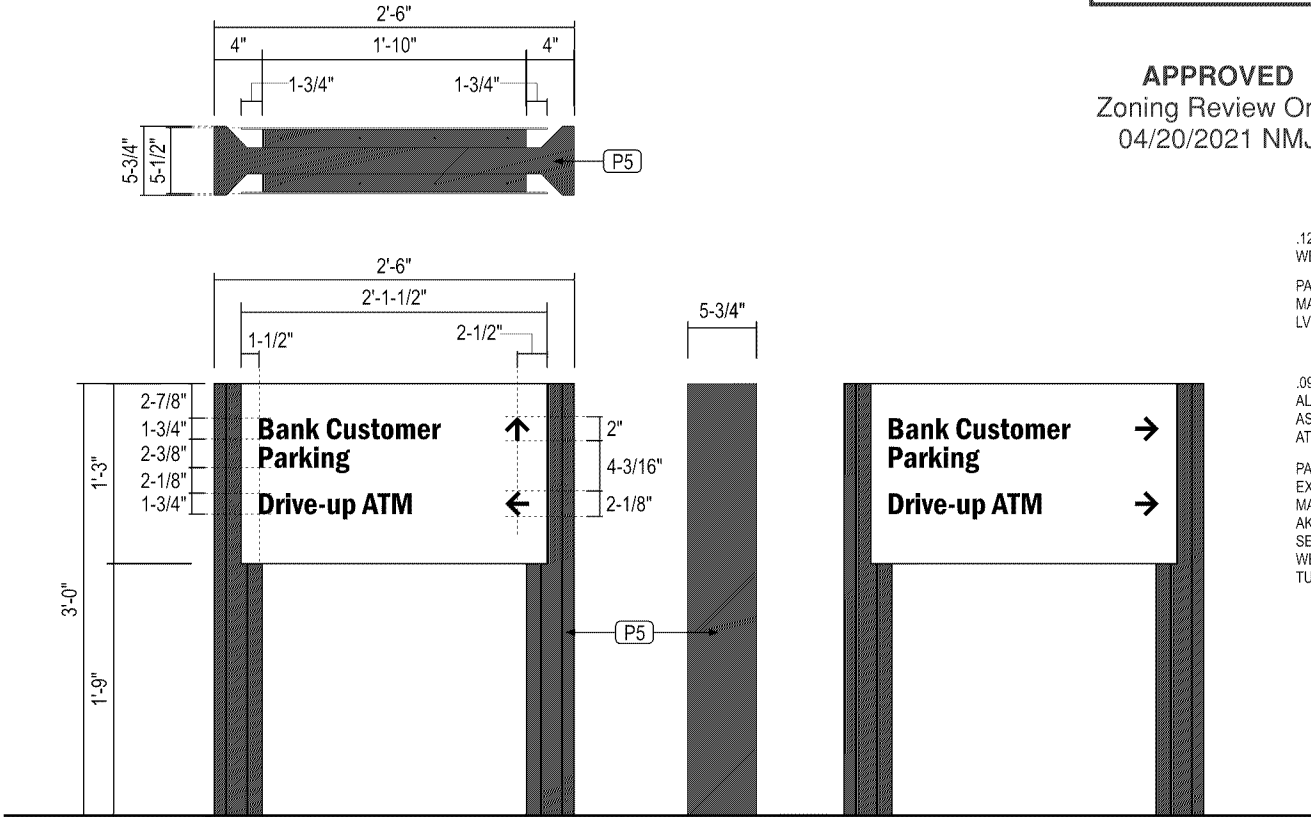

Side A

Side B

AUGERED FOUNDATION:
(2) 1'-0"Ø X 3'-6" DEEP
CONCRETE REQUIRED:
0.2 cu.yd.

FOUNDATION NOTE:
3000 PSI CONCRETE @ 28 DAYS
2000 PSF SOIL BEARING
150 PSF/FT SOIL LATERAL
BEARING UNDISTURBED SOIL

DESIGN LOADS:
115 MPH WIND LOAD
RISK CATEGORY II, EXPOSURE C.
2012 INTERNATIONAL BUILDING
CODE, ASCE 7-10

MATERIAL SPECIFICATIONS

PAINT
RED - MATTHEWS RED #MP49696, AKZO-NOBEL #SIGN 20129, SEMI-GLOSS.
GARBO SILVER - MATTHEWS #MP02650R14405 LVG FULL GLOSS.
FILM
REFLECTIVE BLUE - 3M #680-75 BLUE.

12 P1ng - D/F DIRECTIONAL (2.65 sf)

QTY: 1
STANDARD SPECS - SEE COLOR SPECIFICATION LIBRARY

SCALE: 3/4"=1'-0"

Drawing prepared by:

RECOMMENDATION

Drawing prepared for:

Location:
611 W 98th St.
Bloomington, MN 55420-4715
Proj #:
4305
Loc #:
6110
File Path:
Active\BANKS\B\Bank Of America\2020\Locations\4305_6110_Bloomington_MN_R6.cdr



Rev #:	Req#:	Date:	Req. By:	Drawn By:	Revision Description:	Rev #:	Req#:	Date:	Req. By:	Drawn By:
Original	326276	05/08/20	MH	Sb	Drawings are the exclusive property of STRATUS. Any unauthorized use or duplication is not permitted.					
Rev 1	326745	05/27/20	MH	NPP	Rev Sign1 and 2 - Ltrs on Backer, plus addition changes.	Rev 7	000000	00/00/00	XXX	XXX
Rev 2	327028	06/06/20	MH	Sb	Various Changes - See Request	Rev 8	000000	00/00/00	XXX	XXX
Rev 3	327276	06/14/20	MH	Sb	Change Signs 4 & 5 to D5ng	Rev 9	000000	00/00/00	XXX	XXX
Rev 4	329078	08/17/20	MH	Sb	Added bank hours and clearance bar height	Rev 10	000000	00/00/00	XXX	XXX
Rev 5	337194	03/16/20	MH	Lv	Added sign 7 - Caution automatic door decal					
Rev 6	337496	03/23/20	MH	Lv	Update site plan - update sign one & re-named elevations					





CASE #PL2021-72

APPROVED
Zoning Review Only
04/20/2021 NMJ

DIRECTIONAL COPY AND ARROWS
REFLECTIVE FILM 3M #680-75 BLUE.


TYPEFACE TO BE FRANKLIN
GOTHIC DEMI CONDENSED. VERIFY
ALL COPY PRIOR TO FABRICATION.

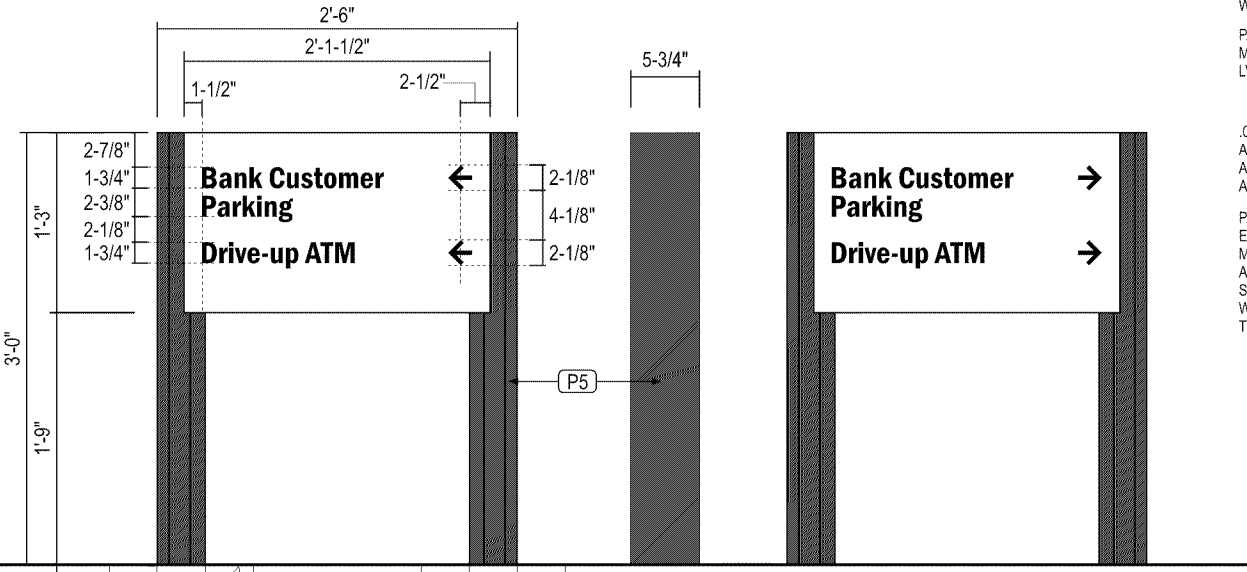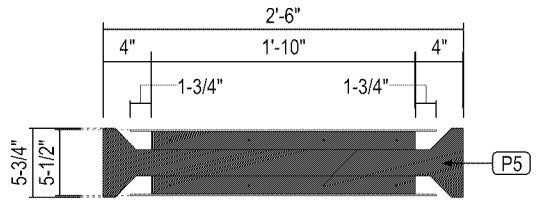

.125" ALUMINUM SIGN FACE.
WELD TO ALUM. ANGLE FRAME.
PAINT FINISH GARBO SILVER
MATTHEWS #MP02650 R14405
LVG FULL GLOSS.

.090" BREAK FORMED
ALUMINUM FRAME. FORM
AS SHOWN. CLADDING TO
ATTACH TO SUPPORT TUBE.

PAINT FINISH ALL
EXPOSED SURFACES
MATTHEWS RED #MP49696,
AKZO-NOBEL #SIGN 20129,
SEMI-GLOSS
WELD TO SUPPORT
TUBE VERTICALS.

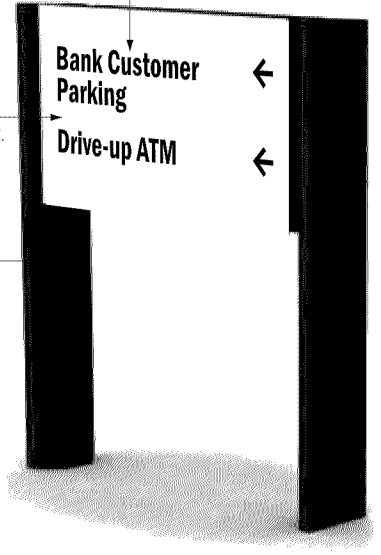

Side A

Side B

AUGERED FOUNDATION:
(2) 1'-0"Ø X 3'-6" DEEP
CONCRETE REQUIRED:
0.2 cu.yd.

FOUNDATION NOTE:
3000 PSI CONCRETE @ 28 DAYS
2000 PSF SOIL BEARING
150 PSF/FT SOIL LATERAL
BEARING UNDISTURBED SOIL

DESIGN LOADS:
115 MPH WIND LOAD
RISK CATEGORY II, EXPOSURE C.
2012 INTERNATIONAL BUILDING
CODE, ASCE 7-10

MATERIAL SPECIFICATIONS

PAINT
RED - MATTHEWS RED #MP49696, AKZO-NOBEL #SIGN 20129, SEMI-GLOSS.
GARBO SILVER - MATTHEWS #MP02650R14405 LVG FULL GLOSS.

FILM
REFLECTIVE BLUE - 3M #680-75 BLUE.

13 P1ng - D/F DIRECTIONAL (2.65 sf)


QTY: 1

STANDARD SPECS - SEE COLOR SPECIFICATION LIBRARY

SCALE: 3/4"=1'-0"

Drawing prepared by:		RECOMMENDATION		Drawing prepared for:		Revision Description: Drawings are the exclusive property of STRATUS. Any unauthorized use or duplication is not permitted.										
Location: 611 W 98th St. Bloomington, MN 55420-4715		Proj #: 4305 Loc #: 6110		BANK OF AMERICA		Original	326276	05/08/20	MH	Sb		Rev 7	000000	00/00/00	XXX	XXX
File Path: Active\BANKS\B\Bank Of America\2020\Locations\4305_6110_Bloomington_MN_R6.cdr						Rev 1	326745	05/27/20	MH	NPP	Rev Sign1 and 2 - Ltrs on Backer, plus addition changes.	Rev 8	000000	00/00/00	XXX	XXX
						Rev 2	327028	06/06/20	MH	Sb	Various Changes - See Request	Rev 9	000000	00/00/00	XXX	XXX
						Rev 3	327276	06/14/20	MH	Sb	Change Signs 4 & 5 to D5ng	Rev 10	000000	00/00/00	XXX	XXX
						Rev 4	329078	08/17/20	MH	Sb	Added bank hours and clearance bar height					
						Rev 5	337194	03/16/20	MH	Lv	Added sign 7 - Caution automatic door decal					
						Rev 6	337496	03/23/20	MH	Lv	Update site plan - update sign one & re-named elevations					



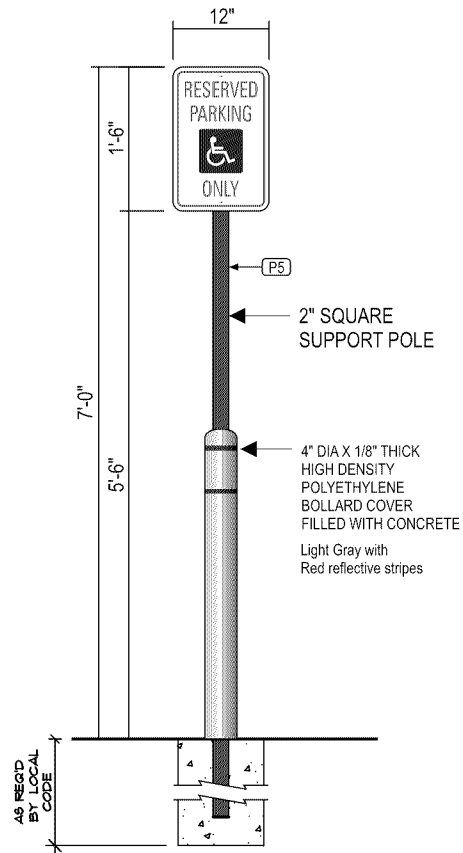

14 ADA - RESERVED PARKING ONLY

QTY: 2
NOTE: 9'-0" OVERALL POLE HEIGHT

SCALE: 1/2"=1'-0"

FACE DETAIL

SCALE: 1 1/2"=1'-0"

Drawing prepared by:

RECOMMENDATION


Drawing prepared for:

Location: 611 W 98th St.
Bloomington, MN 55420-4715
File Path: Active\BANKS\B\Bank Of America\2020\Locations\4305_6110_Bloomington_MN_R6.cdr


Proj #: 4305
Loc #: 6110



Rev #:	Req#:	Date:	Req. By:	Drawn By:	Revision Description:	Rev #:	Req#:	Date:	Req. By:	Drawn By:
Original	326276	05/08/20	MH	Sb	Drawings are the exclusive property of STRATUS. Any unauthorized use or duplication is not permitted.					
Rev 1	326745	05/27/20	MH	NPP	Rev Sign1 and 2 - Ltrs on Backer, plus addition changes.	Rev 7	000000	00/00/00	XXX	XXX
Rev 2	327028	06/06/20	MH	Sb	Various Changes - See Request	Rev 8	000000	00/00/00	XXX	XXX
Rev 3	327276	06/14/20	MH	Sb	Change Signs 4 & 5 to D5ng	Rev 9	000000	00/00/00	XXX	XXX
Rev 4	329078	08/17/20	MH	Sb	Added bank hours and clearance bar height	Rev 10	000000	00/00/00	XXX	XXX
Rev 5	337194	03/16/20	MH	Lv	Added sign 7 - Caution automatic door decal					
Rev 6	337496	03/23/20	MH	Lv	Update site plan - update sign one & re-named elevations					

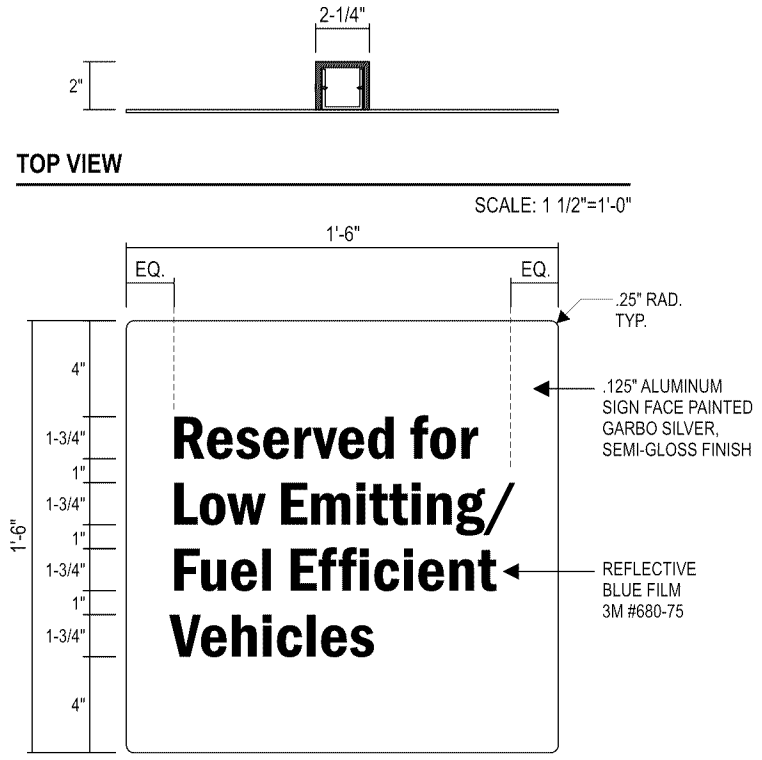

**LOW EMITTING/FUEL EFFICIENT VEHICLES
RP1ng REGULATORY SIGN / FACE DETAIL**
FONT: FRANKLIN GOTHIC DEMI CONDENSED SCALE: 1 1/2"=1'-0"

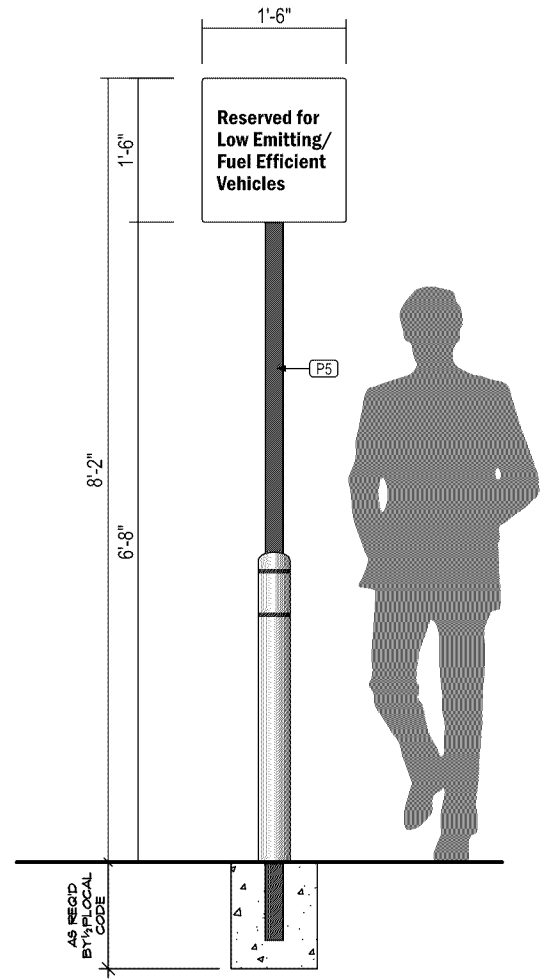

**RP1ng POLE MOUNTED REGULATORY - (2.25 sq. ft.)
15 LOW EMITTING/FUEL EFFICIENT VEHICLES**

QTY: 1 SCALE: 1/2"=1'-0"
4" DIA X 1/8" THICK HIGH DENSITY POLYETHYLENE
BOLLARD COVER FILLED WITH CONCRETE.
LIGHT GRAY w/ REFLECTIVE STRIPES.

Drawing prepared by: **RECOMMENDATION** Drawing prepared for:


Location: 611 W 98th St. Proj #: 4305
Bloomington, MN 55420-4715 Loc #: 6110

File Path: Active\BANKS\B\Bank Of America\2020\Locations\4305_6110_Bloomington_MN_R6.cdr

Stratus **BANK OF AMERICA**


Rev #:	Req#:	Date:	Req. By:	Drawn By:	Revision Description:	Rev #:	Req#:	Date:	Req. By:	Drawn By:
Original	326276	05/08/20	MH	Sb						
Rev 1	326745	05/27/20	MH	NPP	Rev Sign1 and 2 - Ltrs on Backer, plus addition changes.	Rev 7	000000	00/00/00	XXX	XXX
Rev 2	327028	06/06/20	MH	Sb	Various Changes - See Request	Rev 8	000000	00/00/00	XXX	XXX
Rev 3	327276	06/14/20	MH	Sb	Change Signs 4 & 5 to D5ng	Rev 9	000000	00/00/00	XXX	XXX
Rev 4	329078	08/17/20	MH	Sb	Added bank hours and clearance bar height	Rev 10	000000	00/00/00	XXX	XXX
Rev 5	337194	03/16/20	MH	Lv	Added sign 7 - Caution automatic door decal					
Rev 6	337496	03/23/20	MH	Lv	Update site plan - update sign one & re-named elevations					

Pg.16

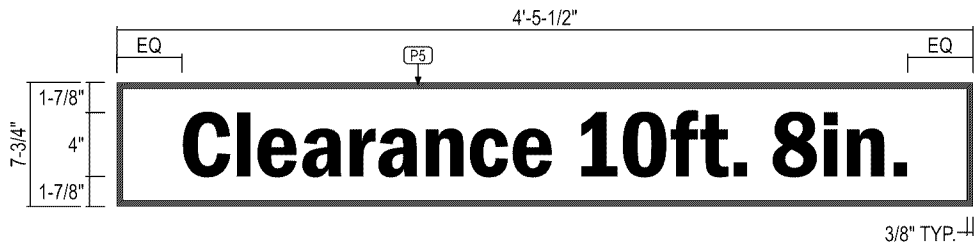


16 SS1ng - INFORMATIONAL REGULATORY @ D/U CANOPY 2.88 SQ FT
QTY: 1

SIDE VIEW
SCALE: 1"=1'-0"

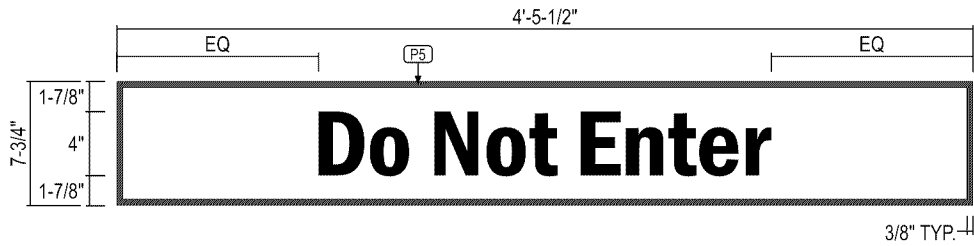

17 SS2ng - INFORMATIONAL REGULATORY @ D/U CANOPY 2.88 SQ FT
QTY: 1

SIDE VIEW
SCALE: 1"=1'-0"

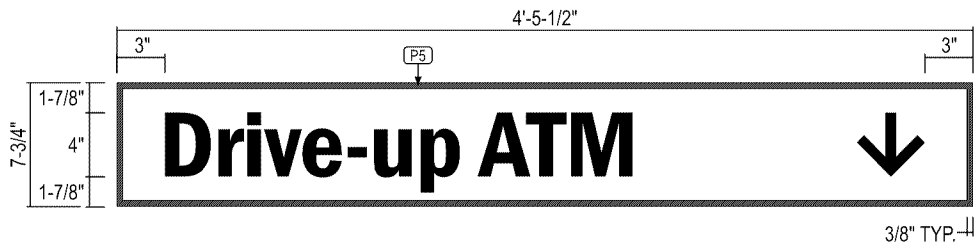

18 SS3ng - DIRECTIONAL REGULATORY @ D/U CANOPY 2.88 SQ FT
QTY: 1

SIDE VIEW
SCALE: 1"=1'-0"

APPROVED
Zoning Review Only
04/20/2021 NMJ

CASE #PL2021-72


.125" PAN FORMED BACKING SHEET w/ A 1" RETURN, WELD AND GRIND SMOOTH AT CORNERS. PRE-DRILL HOLES IN FACE TO ACCEPT WELDED THREADED STUDS ON BACK OF SIGN FACE. PAINT FINISH ALL EXPOSED SURFACES BANK OF AMERICA RED, SEMI-GLOSS FINISH. ATTACH TO MOUNTING ANGLES TOP AND BOTTOM. PAINT HEADS TO MATCH.

.125" ALUMINUM SIGN FACE. FORM AS SHOWN. WELD THREADED STUDS SECOND SURFACE FOR ATTACHMENT TO BACKING SHEET. PAINT FINISH ALL EXPOSED SURFACES GARBO SILVER, SEMI-GLOSS FINISH. BOLT ATTACH TO BACKING SHEET.

COPY TO BE 3M REFLECTIVE BLUE. TYPEFACE TO BE FRANKLIN-GOTHIC-DEMI-CONDENSED. VERIFY ALL COPY PRIOR TO FABRICATION.

MATERIAL SPECIFICATIONS

PAINT
RED - MATTHEWS RED #MP49696, AKZO-NOBEL #SIGN 20129, GARBO SILVER - MATTHEWS #MP02650R14405 LVG FULL GLOSS.
FILM
REFLECTIVE BLUE - 3M #680-75 BLUE.

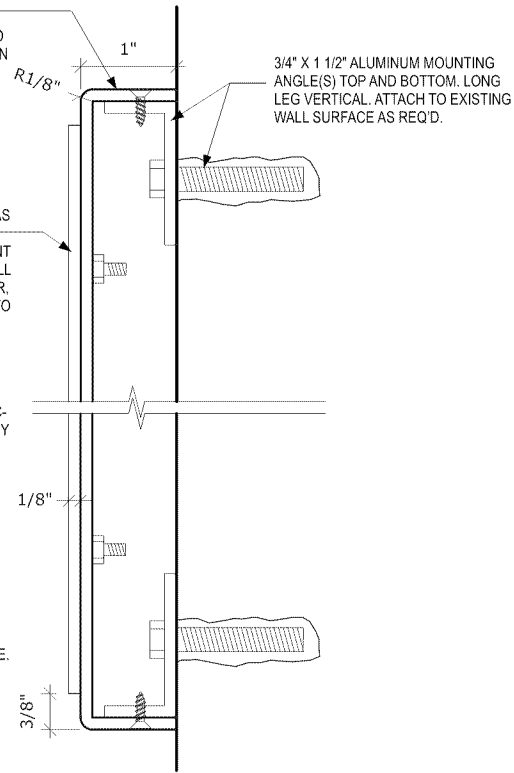

A VERTICAL SECTION
SCALE: 6"=1'-0"

WALL TYPE	PREFERRED FOR ALL WALL TYPES WHEN POSSIBLE	EIFS WALL W/ FOAM INSULATION
SECTION		
ANCHOR TYPE	Ø1/4"-3/8" THREADED ROD	Ø1/4"-3/8" THREADED ROD W/ ALUMINUM OR PVC COMPRESSION SLEEVE

Patch and repair existing wall surface to like new condition. For brick or stone walls fill holes with matching silicone. Repaint to match existing color finish. Measure and verify clearance height prior to fabrication - deduct 2" from actual height for sign copy. Field verify dimensions of the sign & surrounding space shown in the proposed image. If the field verification indicates that the sign will not fit, an IFR should be submitted for modification by Monigle Associates prior to any manufacturing.

Drawing prepared by: **RECOMMENDATION** Drawing prepared for:

Location: 611 W 98th St, Bloomington, MN 55420-4715
Proj #: 4305
Loc #: 6110

Stratus **BANK OF AMERICA**

File Path: Active\BANKS\B\Bank Of America\2020\Locations\4305_6110_Bloomington_MN_R6.cdr

Rev #:	Req#:	Date:	Req. By:	Drawn By:	Revision Description:	Rev #:	Req#:	Date:	Req. By:	Drawn By:
Original	326276	05/08/20	MH	Sb	Drawings are the exclusive property of STRATUS. Any unauthorized use or duplication is not permitted.					
Rev 1	326745	05/27/20	MH	NPP	Rev Sign1 and 2 - Ltrs on Backer, plus addition changes.	Rev 7	000000	00/00/00	XXX	XXX
Rev 2	327028	06/06/20	MH	Sb	Various Changes - See Request	Rev 8	000000	00/00/00	XXX	XXX
Rev 3	327276	06/14/20	MH	Sb	Change Signs 4 & 5 to D5ng	Rev 9	000000	00/00/00	XXX	XXX
Rev 4	329078	08/17/20	MH	Sb	Added bank hours and clearance bar height	Rev 10	000000	00/00/00	XXX	XXX
Rev 5	337194	03/16/20	MH	Lv	Added sign 7 - Caution automatic door decal					
Rev 6	337496	03/23/20	MH	Lv	Update site plan - update sign one & re-named elevations					