


- 1) Code requires post install inspection.
Call 952-563-8920 to schedule.
2) No change in fixture allowed without
a revised plan review and approval.

Case 8300A-11




[Handwritten signature]

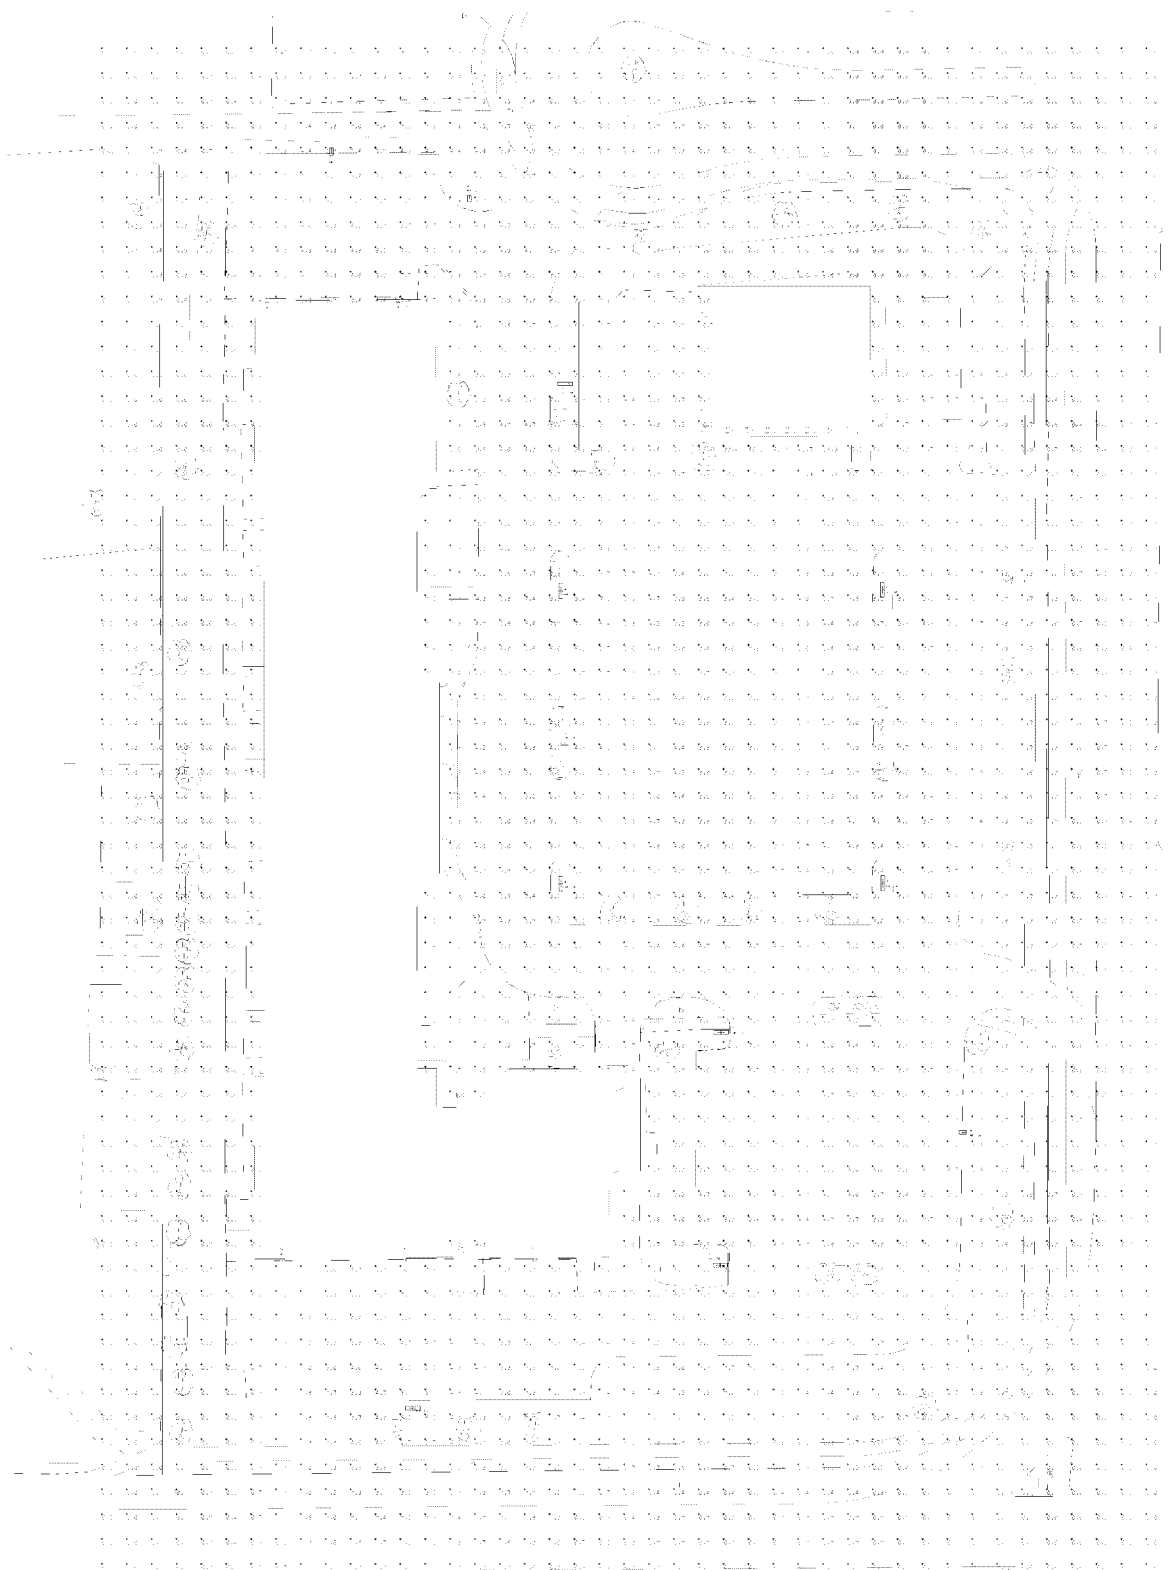

Symbol	Description	Symbol	Description	Symbol	Description
1	1" = 1' Scale	1	1" = 1' Scale	1	1" = 1' Scale
2	2" = 1' Scale	2	2" = 1' Scale	2	2" = 1' Scale
3	3" = 1' Scale	3	3" = 1' Scale	3	3" = 1' Scale
4	4" = 1' Scale	4	4" = 1' Scale	4	4" = 1' Scale
5	5" = 1' Scale	5	5" = 1' Scale	5	5" = 1' Scale
6	6" = 1' Scale	6	6" = 1' Scale	6	6" = 1' Scale
7	7" = 1' Scale	7	7" = 1' Scale	7	7" = 1' Scale
8	8" = 1' Scale	8	8" = 1' Scale	8	8" = 1' Scale
9	9" = 1' Scale	9	9" = 1' Scale	9	9" = 1' Scale
10	10" = 1' Scale	10	10" = 1' Scale	10	10" = 1' Scale

- 1) Code requires post install inspection.
Call 952-563-8920 to schedule.
- 2) No change in fixture allowed without
a revised plan review and approval.

Case 8300A-11

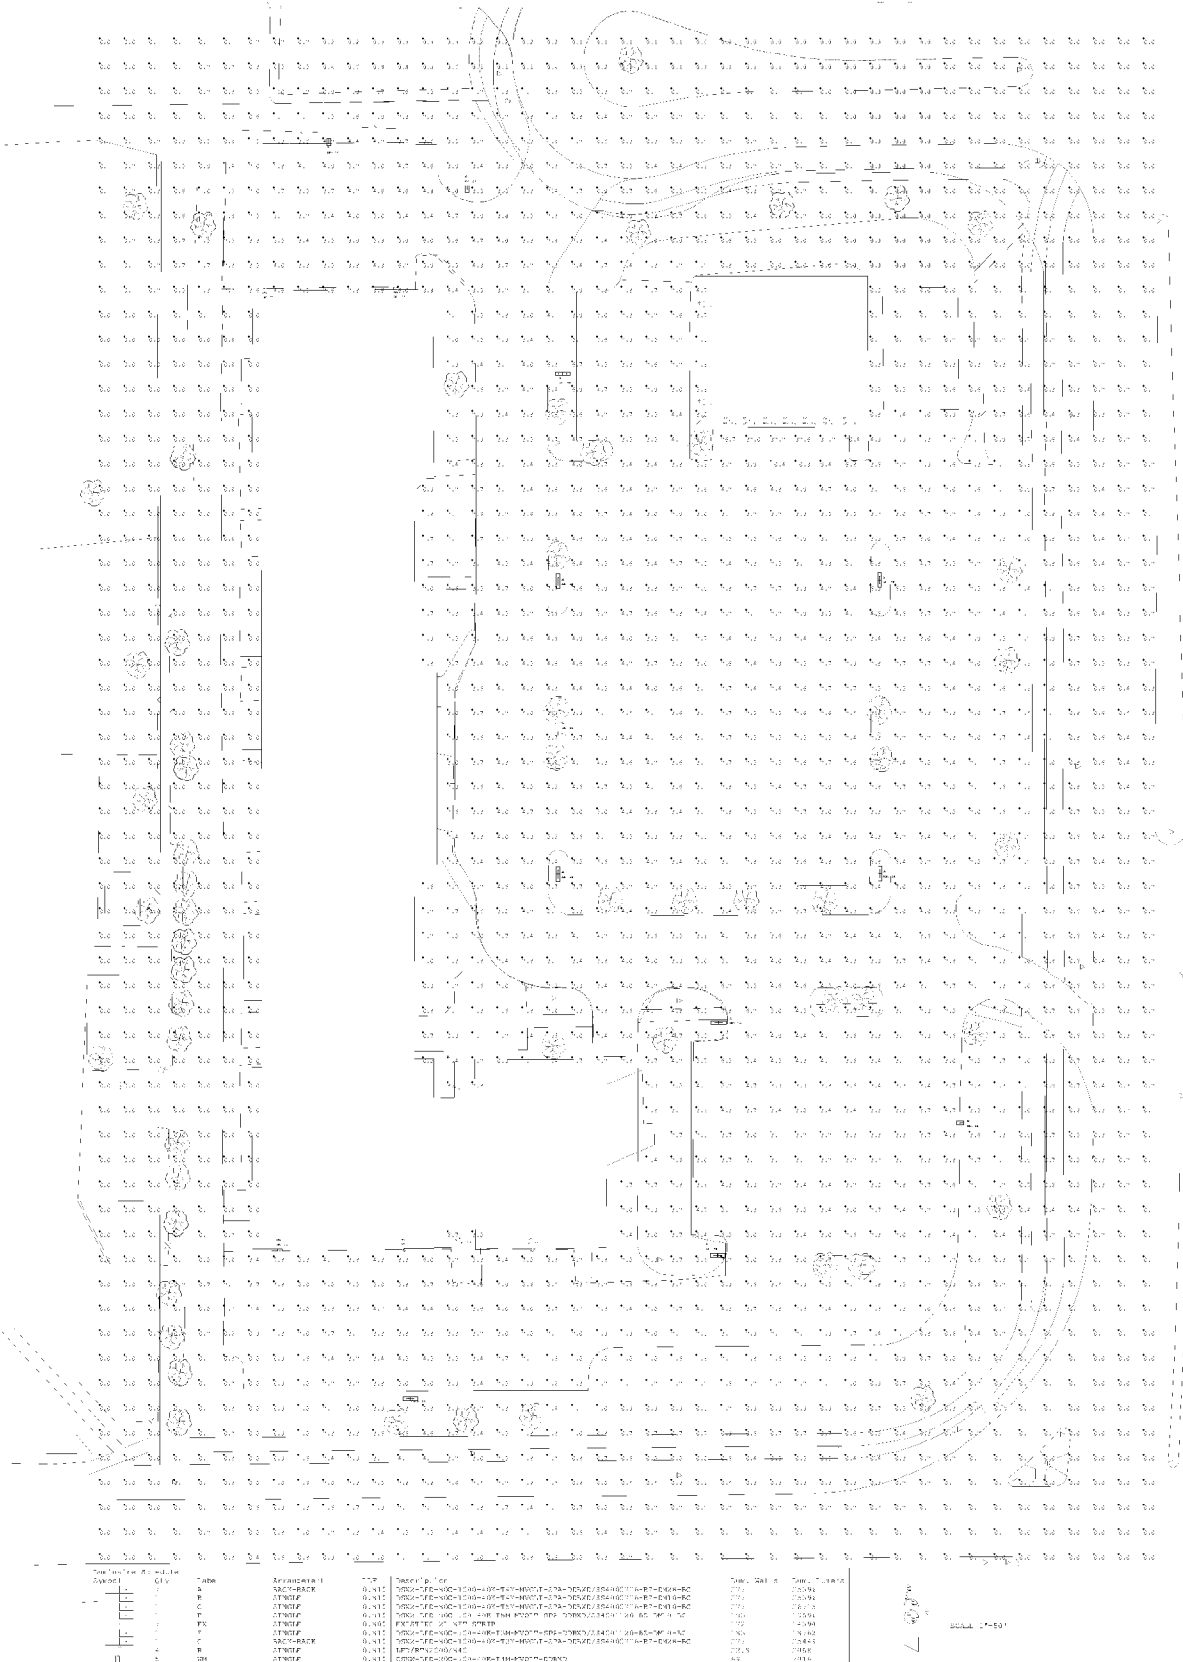



Exterior Lighting Compliance Certificate

Project Information

Energy Code: 2012 IECC
Project Title: Countryside Shopping Center
Project Type: Alteration
Permit No. TBD
Exterior Lighting Zone 4 (High activity metropolitan commercial district)

Construction Site:
7700 W Old Shakopee Rd
Bloomington, MN 55438

Owner/Agent:
Kevin Hoffman
Hoffman Development
13795 Frontier Court
Suite 200
Burnsville, MN 55337

Designer/Contractor:
Collin Poetting
Budget Lighting Inc.
15275 Minnetonka blvd
Minnetonka, MN 55345
952 939 1733
collin.poetting@gmail.com

Allowed Exterior Lighting Power

A Area/Surface Category	B Quantity	C Allowed Watts / Unit	D Tradable Wattage	E Allowed Watts (B X C)
Parking Lot (Parking area)	83712 ft2	0.13	Yes	10883
		Total Tradable Watts (a)		10883
		Total Allowed Watts =		10883
		Total Allowed Supplemental Watts (b) =		1300

(a) Wattage tradeoffs are only allowed between tradable areas/surfaces.

(b) A supplemental allowance equal to 1300 watts may be applied toward compliance of both non-tradable and tradable areas/surfaces.

Proposed Exterior Lighting Power

A Fixture ID : Description / Lamp / Wattage Per Lamp / Ballast	B Lamps/ Fixture	C # of Fixtures	D Fixture Watt.	E (C X D)
Parking Lot (Parking area 83712 ft2): Tradable Wattage				
LED 1: DSX2: Lithonia LED Lot Light: Other:	1	18	277	4986
LED 2: DSX2: Lithonia LED Wallpack: Other:	1	2	183	366
LED 3: CSXW: Lithonia Wallpack: Other:	1	5	69	345
LED 4: can: led/rt8/2000/840: LED Other Fixture Unit 25W:	1	4	24	96
	Total Tradable Proposed Watts =			5793

Exterior Lighting PASSES: Design 52% better than code

Exterior Lighting Compliance Statement

Compliance Statement: The proposed exterior lighting alteration project represented in this document is consistent with the building plans, specifications, and other calculations submitted with this permit application. The proposed exterior lighting systems have been designed to meet the 2012 IECC requirements in COMcheck Version 4.0.2.0 and to comply with the mandatory requirements listed in the Inspection Checklist.


Name - Title

Signature

Date

Landscape Plan for: BLOOMINGTON FEBBY CONVENIENCE CENTER BLOOMINGTON, MINNESOTA	Designer C. Kuntz-Francis Date 4-19-85 Plan No. 89-105 Scale 1" = 30'-0" Revised
---	--

 Minnesota Tree, Inc.
 1001 West 7th Street
 Minneapolis, MN 55408
 (612) 338-8800
 Fax: (612) 338-8801
 E-mail: info@mnstree.com
 Web: www.mnstree.com
 Landscape Design/Contracting



GENERAL NOTES:

1. ALL PLANT WITHIN 100' = 100% PLANT. $\frac{1}{2}$ "DEPTH OF 100' COULD BE 100' MEASUREMENT & ALL PLANT BEYOND 100' = 0% PLANT. $\frac{1}{2}$ "COULD BE 100' COULD BE 100' MEASUREMENT & ALL PLANT BEYOND 100' = 0% PLANT.
2. ALL PLANT WITHIN 100' PLANT. $\frac{1}{2}$ "COULD BE 100' COULD BE 100' MEASUREMENT & ALL PLANT BEYOND 100' = 0% PLANT.
3. ALL PLANT WITHIN 100' PLANT. $\frac{1}{2}$ "COULD BE 100' COULD BE 100' MEASUREMENT & ALL PLANT BEYOND 100' = 0% PLANT.
4. ALL PLANT WITHIN 100' PLANT. $\frac{1}{2}$ "COULD BE 100' COULD BE 100' MEASUREMENT & ALL PLANT BEYOND 100' = 0% PLANT.
5. ALL PLANT WITHIN 100' PLANT. $\frac{1}{2}$ "COULD BE 100' COULD BE 100' MEASUREMENT & ALL PLANT BEYOND 100' = 0% PLANT.

PLANT SCHEDULE

[illegible]

