


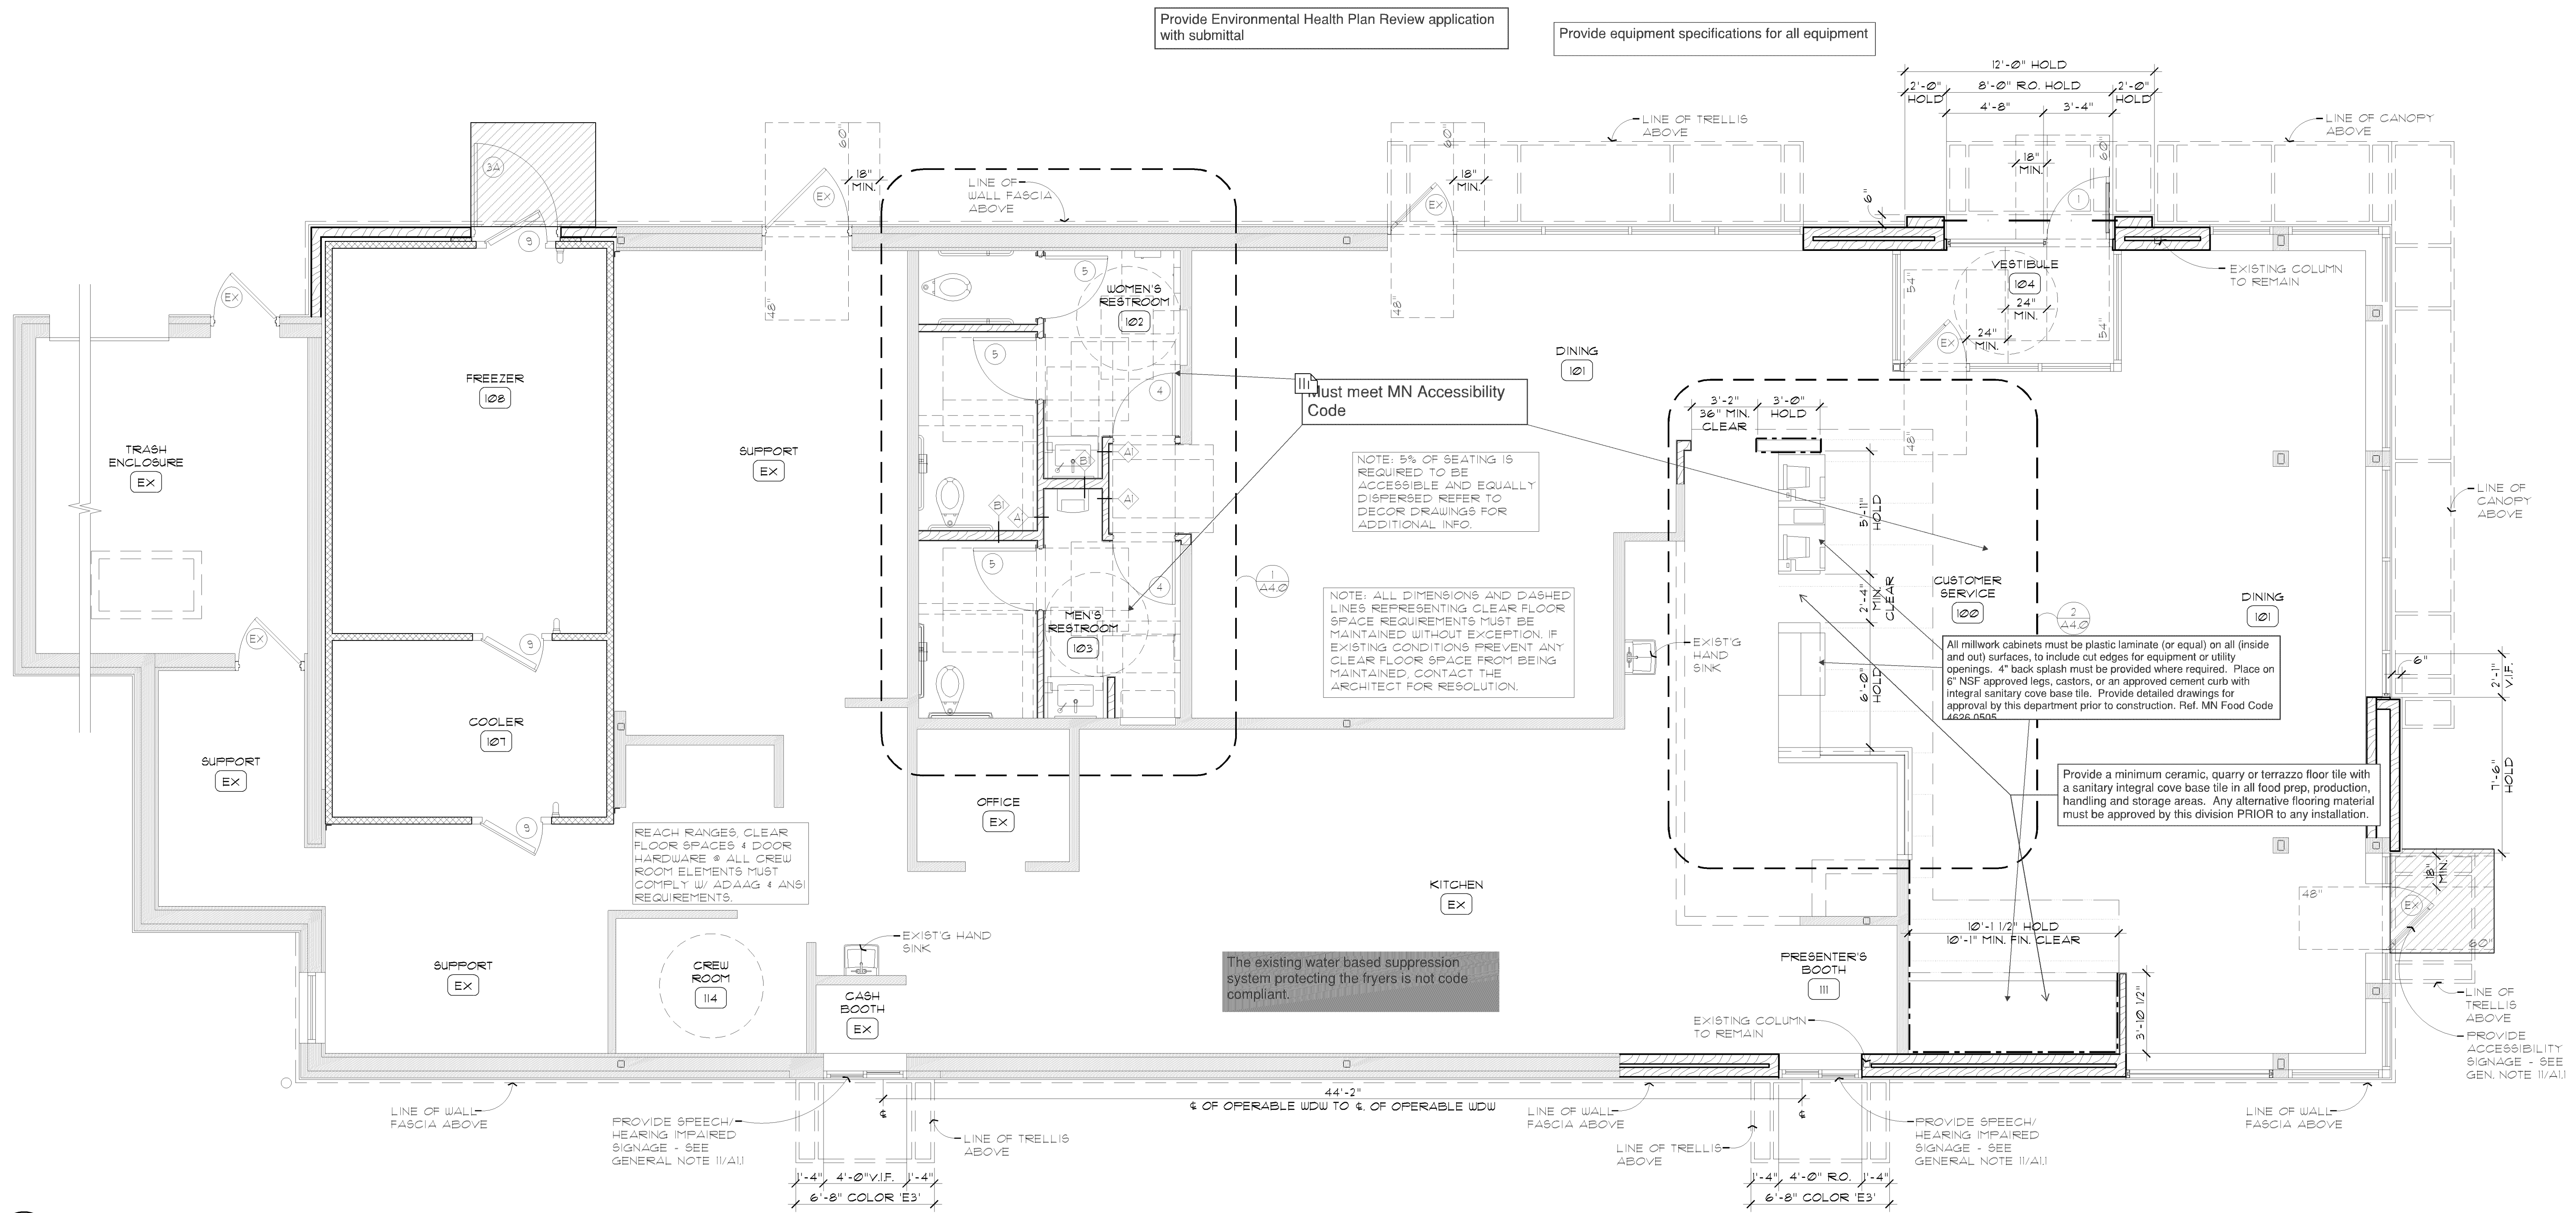


1 FLOOR PLAN

- GENERAL NOTES:
1. FIELD VERIFY ALL DIMENSIONS W/ EXISTING BUILDING CONDITIONS.
 2. DRIVE-THRU WINDOW SUPPLIER: READY ACCESS: SERIES 600 - 41 1/2" x 43 1/2" TELEPHONE 800-621-9045.
 3. PATCH AND REPAIR WALL/FLOOR TILE IF REQUIRED FOR KITCHEN EQUIPMENT RELOCATION. PATCH ALL DISTURBED SURFACES TO MATCH EXISTING.
 4. ASSUMED EXISTING EXTERIOR WALL CONSTRUCTION IS BLOCK WITH FACE BRICK. CONTRACTOR TO FIELD VERIFY AND NOTIFY ARCHITECT IF DIFFERENT.
 5. INTERIOR FINISHES IN NEW CONSTRUCTION AREA TO MATCH EXIST'G OR ACH APPROVED ALTERNATE - SEE SHEET A41 FOR DOOR AND WINDOW FINISHES.
 6. SEE EXTERIOR ELEVATIONS FOR WINDOW TYPES.
 7. NEW SLAB @ TRENCH CUT. DOVEL NEW SLAB INTO EXIST'G W/ #4 BARS SPACED @ 24" O.C. - EA. SIDE TO OVERLAP @ MECH. TRENCH. CENTER DOVEL IN SLAB & EMBED 4" (MIN) W/ EPOXY ADHESIVE. NEW SLAB TO MATCH OR EXCEED EXIST'G SLAB THICKNESS. SHOULD SLAB BE STRUCTURAL (THICKNESS EXCEEDS 4") & CONTAINS REINFORCING BARS) CONTACT ARCHITECT FOR RESOLUTION. AT MECH. TRENCH, RECOMPACT FILL W/ MECH. COMPACTOR IN 6" MAX. LIFTS.
 8. MAXIMUM OCCUPANCY SIGN TO BE POSTED PER LOCAL CODE. SIGN FURNISHED AND INSTALLED BY GC.
 9. ALL NEW HAND SINK LOCATIONS SHALL HAVE CEMENT BOARD BACKING 48" IN HEIGHT AFF.
 10. GC TO COORDINATE ALL REQUIRED BLOCKING FOR WALL HUNG EQUIPMENT, SHELVES, ETC. FOR PROPER INSTALLATION HEIGHTS.
 11. GC TO PROVIDE ADA SIGNAGE PACKAGE AND INSTALL SIGNS AT LOCATIONS AND POSITIONS INDICATED IN PACKAGE OR AS REQUIRED BY LOCAL CODES. SIGNAGE PACKAGE SUPPLIED BY: FORREST PERMA-SIGN 1-800-214-2765 9292 1ST ST. BOX 588 NEW ROCHELLE, NY 10802

WALL LEGEND:

[Pattern]	EXISTING TO REMAIN
[Pattern]	NEW WOOD STUD WALL
[Pattern]	NEW EXTERIOR BRICK
[Pattern]	CERAMIC TILE

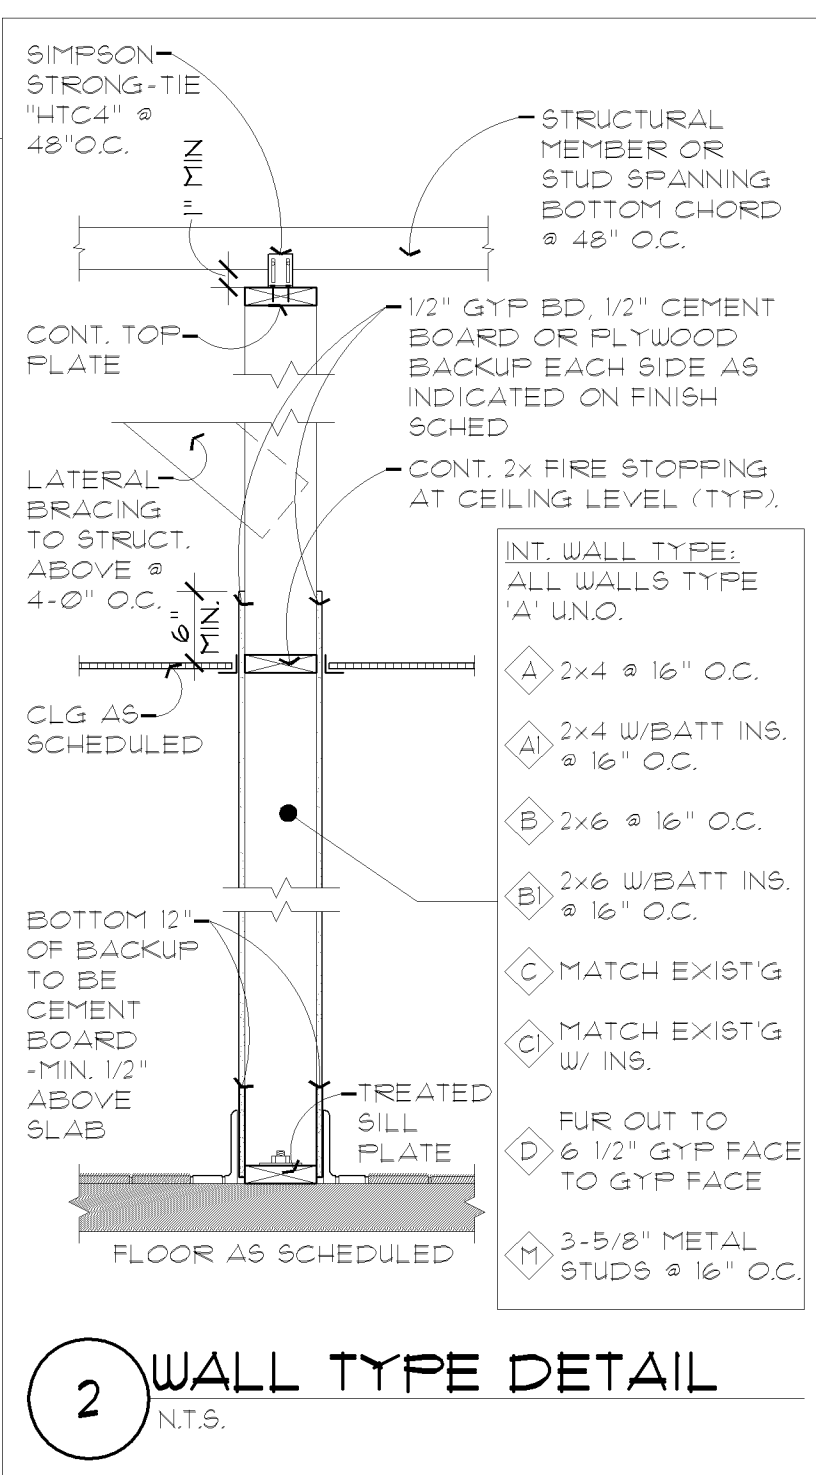

Provide Environmental Health Plan Review application with submittal

Provide equipment specifications for all equipment

Must meet MN Accessibility Code

NOTE: 5% OF SEATING IS REQUIRED TO BE ACCESSIBLE AND EQUALLY DISPERSED REFER TO DECOR DRAWINGS FOR ADDITIONAL INFO.

NOTE: ALL DIMENSIONS AND DASHED LINES REPRESENTING CLEAR FLOOR SPACE REQUIREMENTS MUST BE MAINTAINED WITHOUT EXCEPTION. IF EXISTING CONDITIONS PREVENT ANY CLEAR FLOOR SPACE FROM BEING MAINTAINED, CONTACT THE ARCHITECT FOR RESOLUTION.

The existing water based suppression system protecting the fryers is not code compliant.

Must meet current MN State Building Code




20% of budget must be applied to accessibility updates(remodels)?????

I hereby certify that this plan, specification or appendix is prepared by me or under my direct supervision and that I am a duly registered ARCHITECT under the laws of the State of MINNESOTA


Signature: BRIAN ROBERT JOHNSON
Date: XX/XX/XXXX
Registration Number: 18050

McDONALD'S RESTAURANT
2017 MAJOR REMODEL PROGRAM
State Site Code: 022-0316 Nat'l Number: 18751
7997 SOUTHTOWN CIR. BLOOMINGTON, MN


PREPARED FOR: McDonald's USA, LLC
DATE ISSUED: XX/XX/XXXX
DRAWN BY: XX
CHECKED BY: XX
JOB NO.: 17167

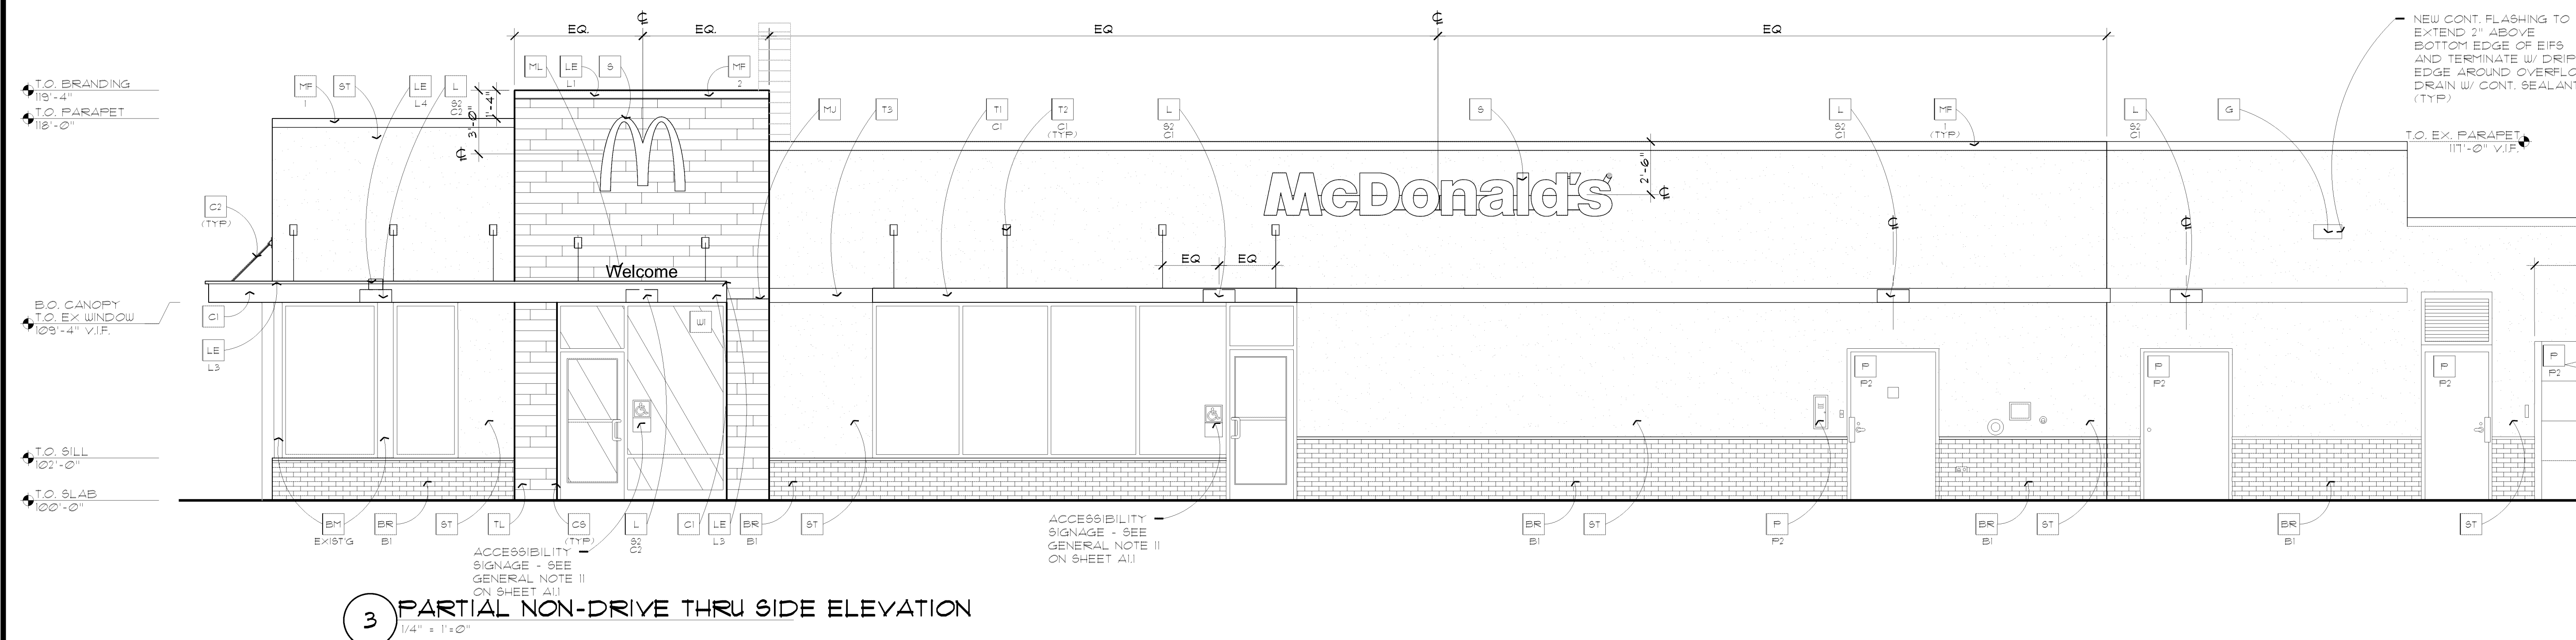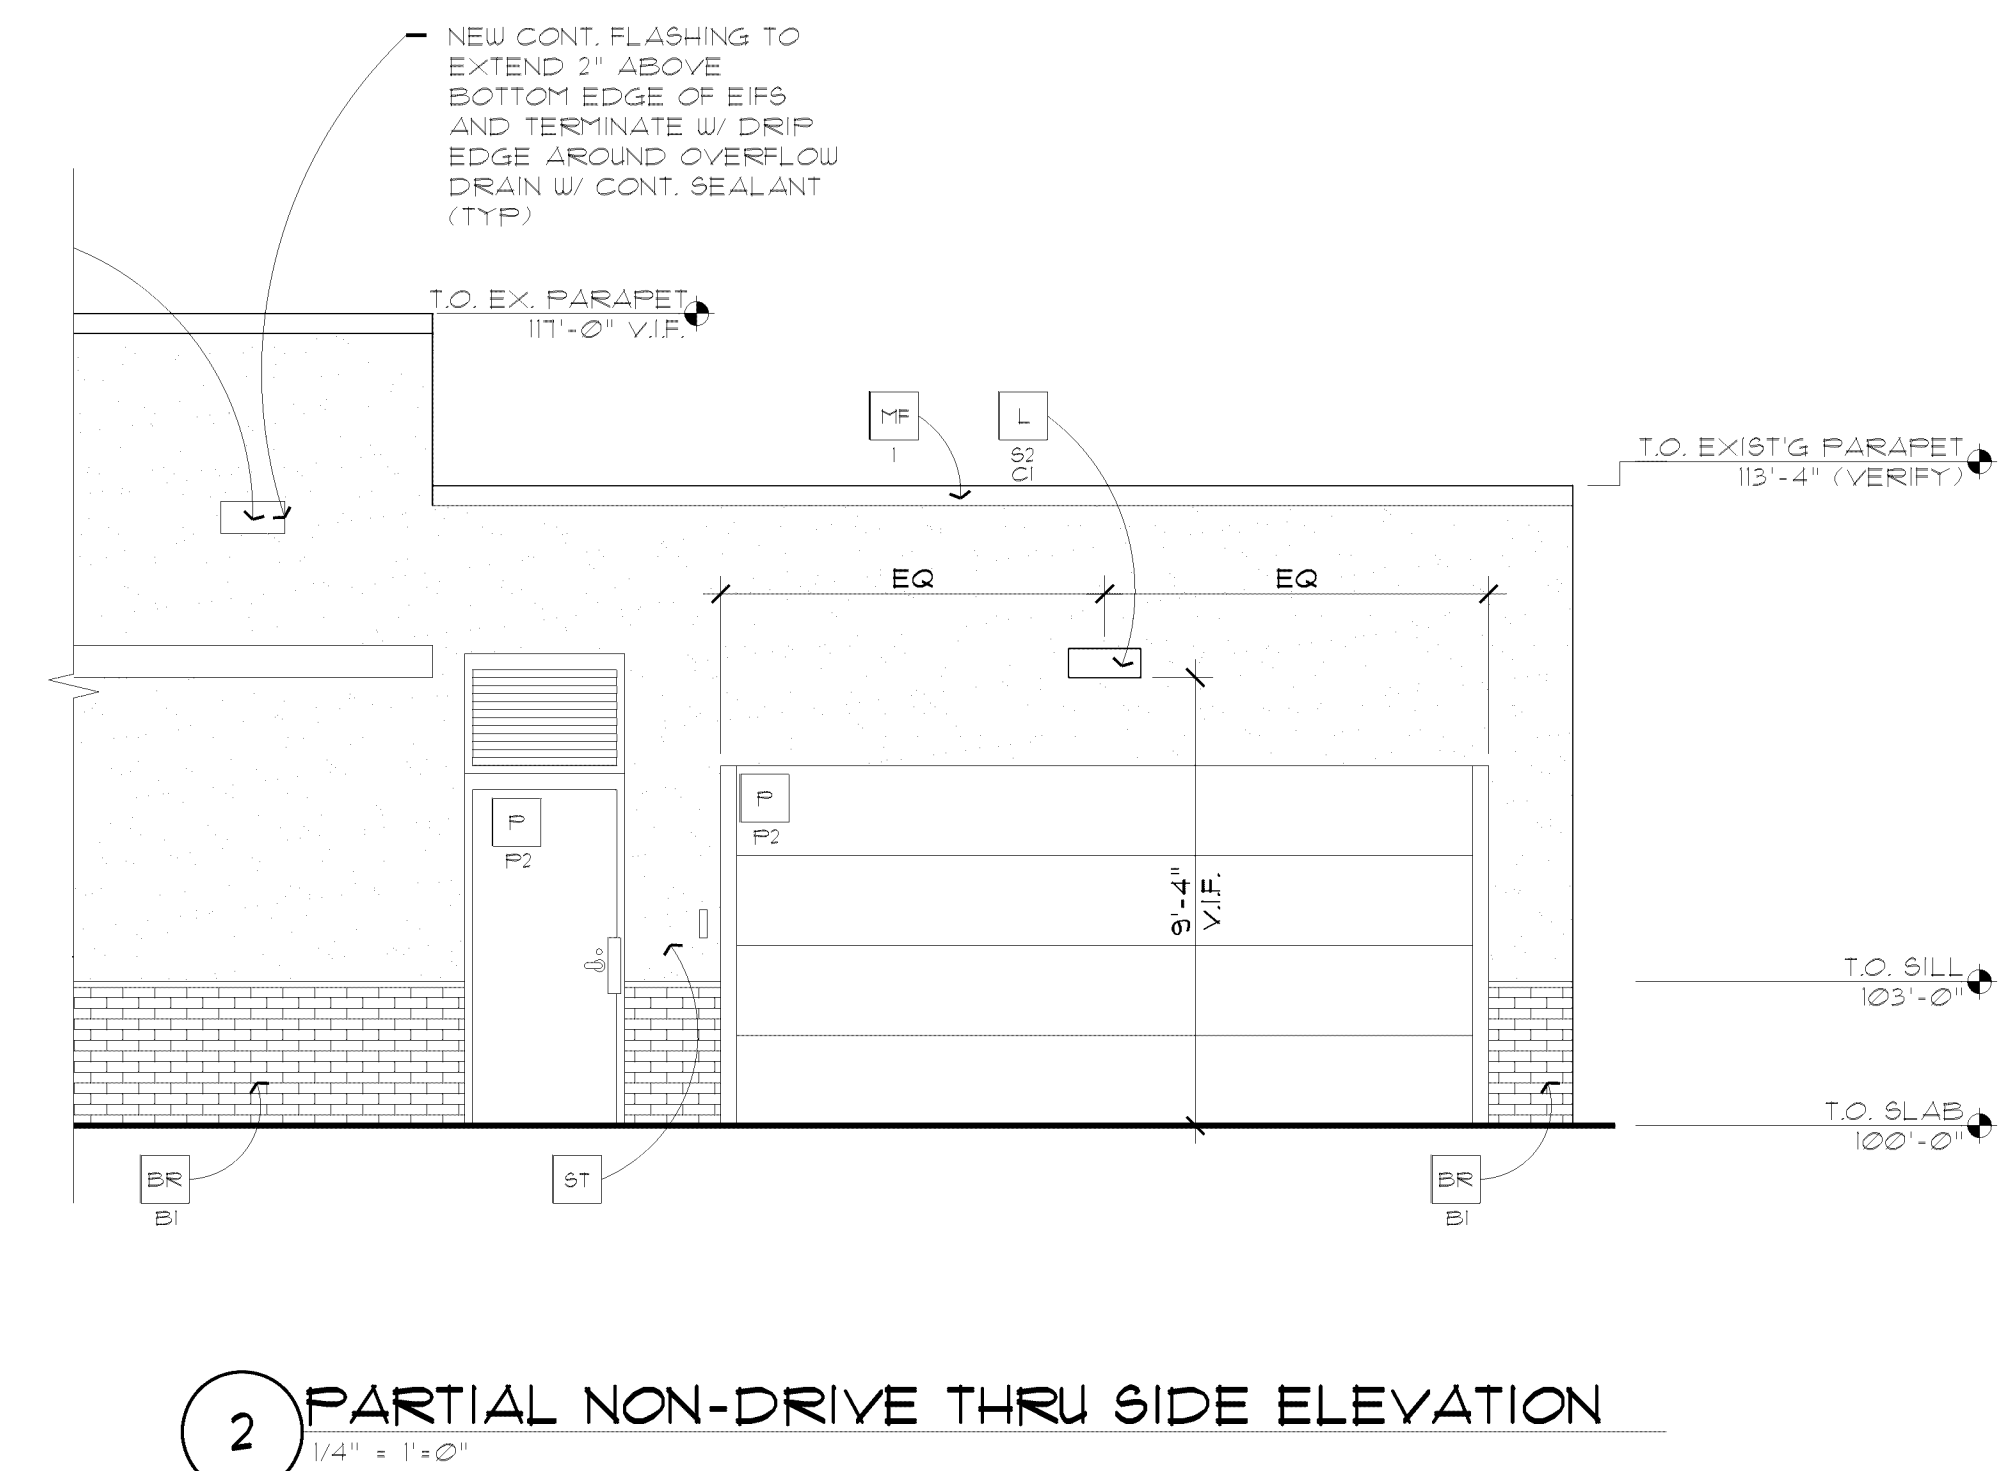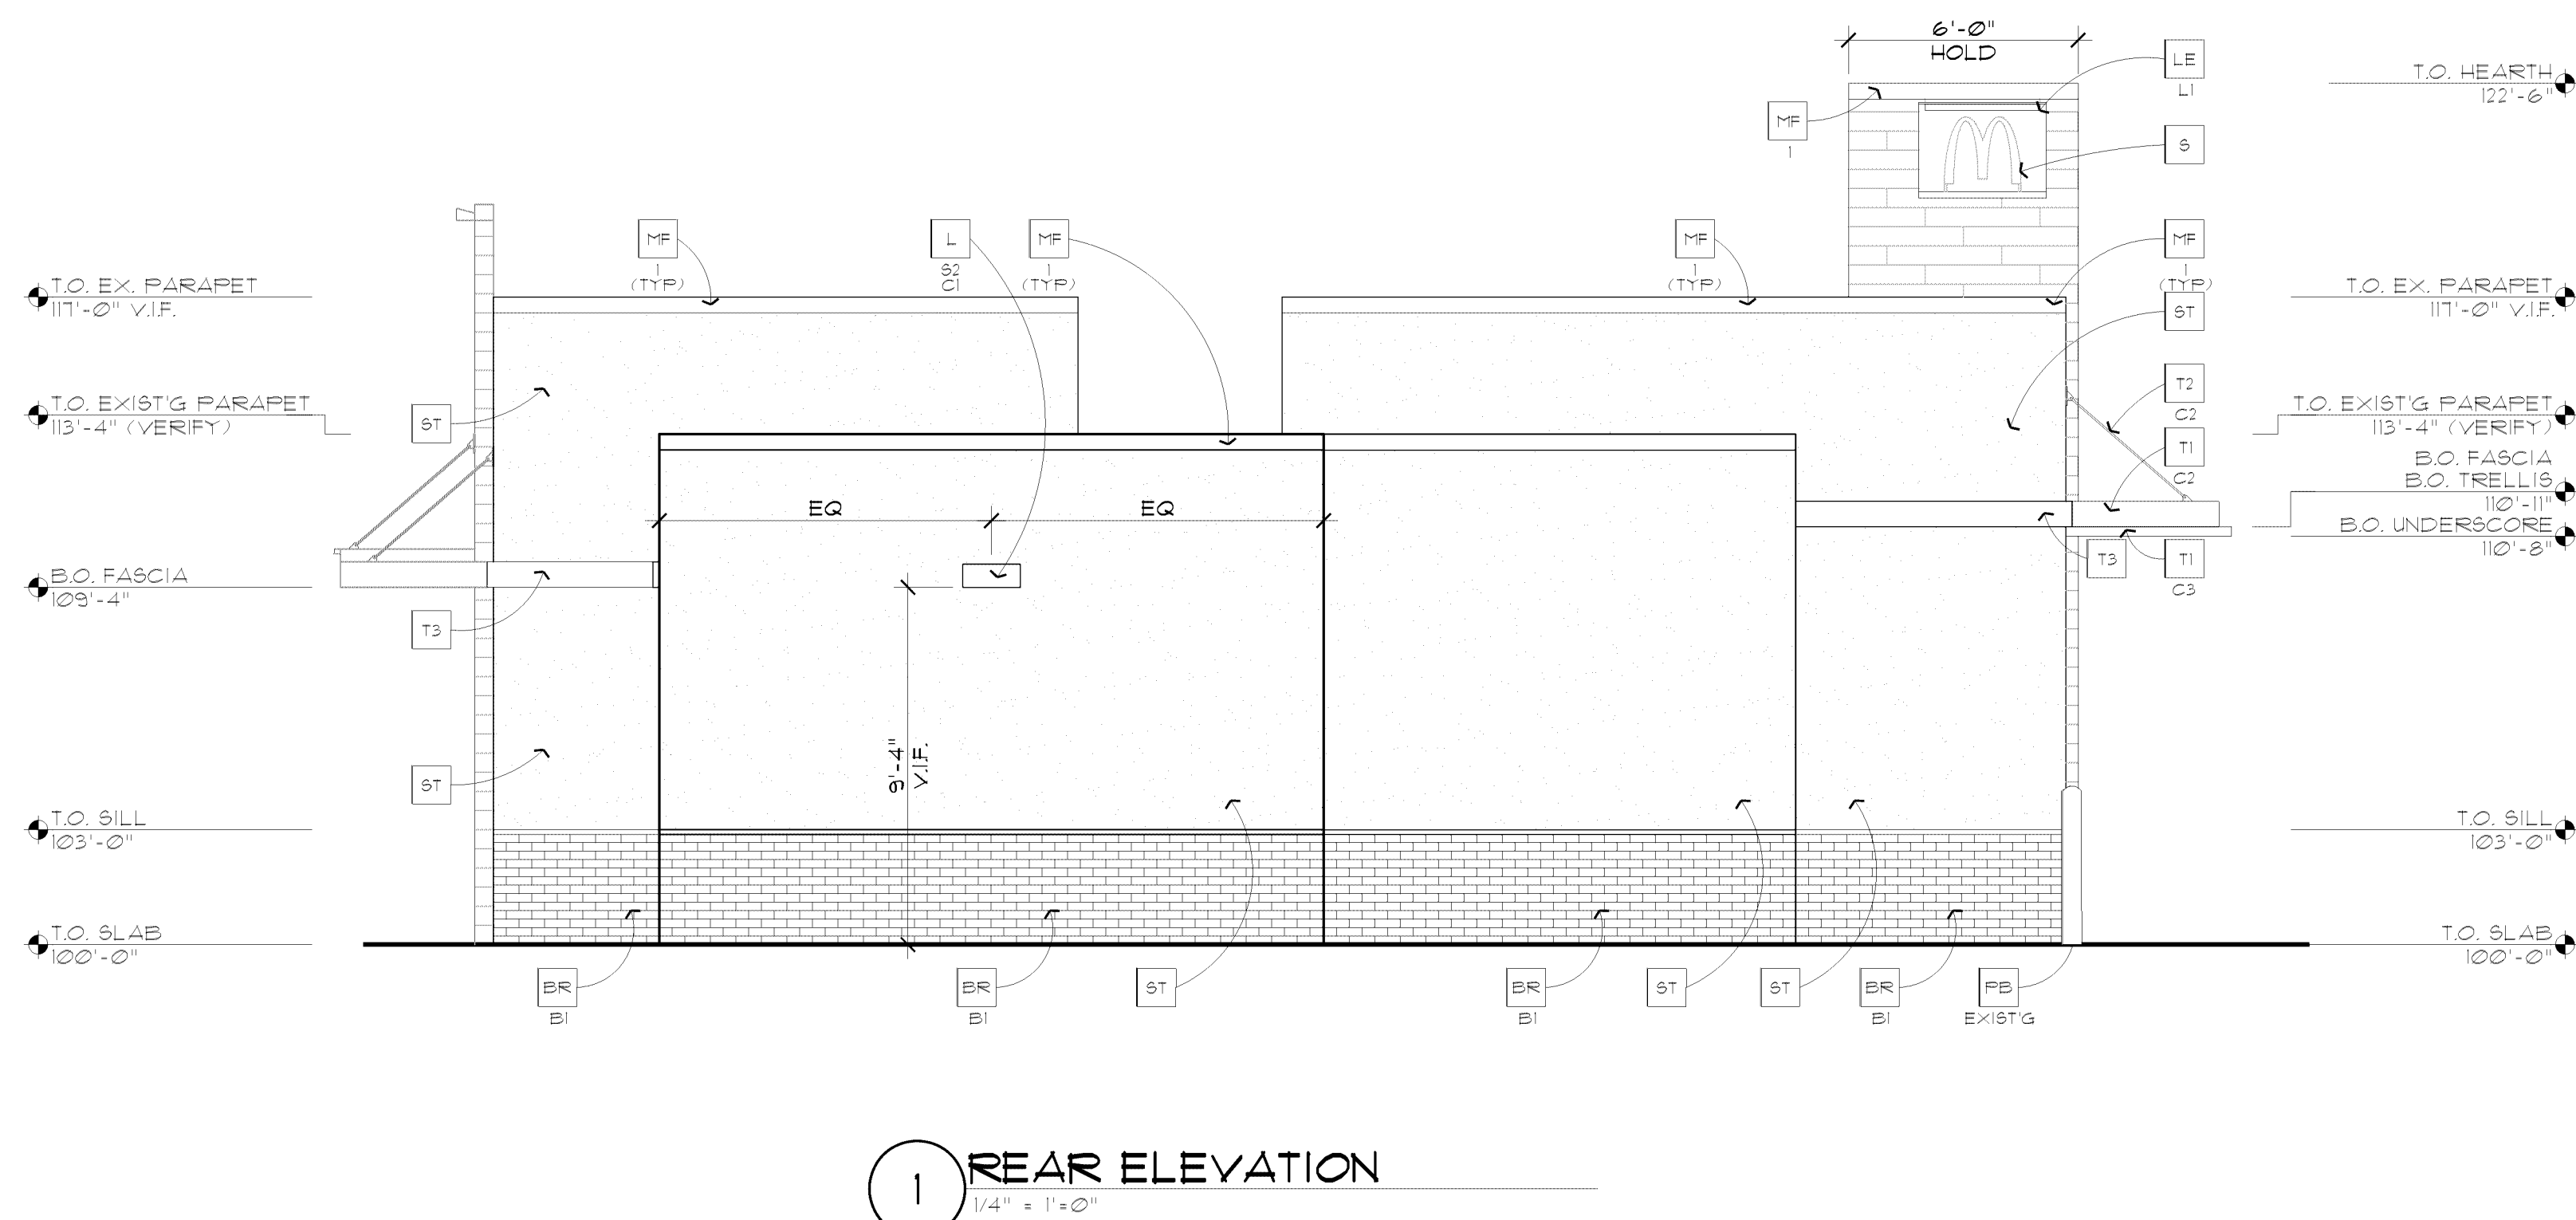


A2.1

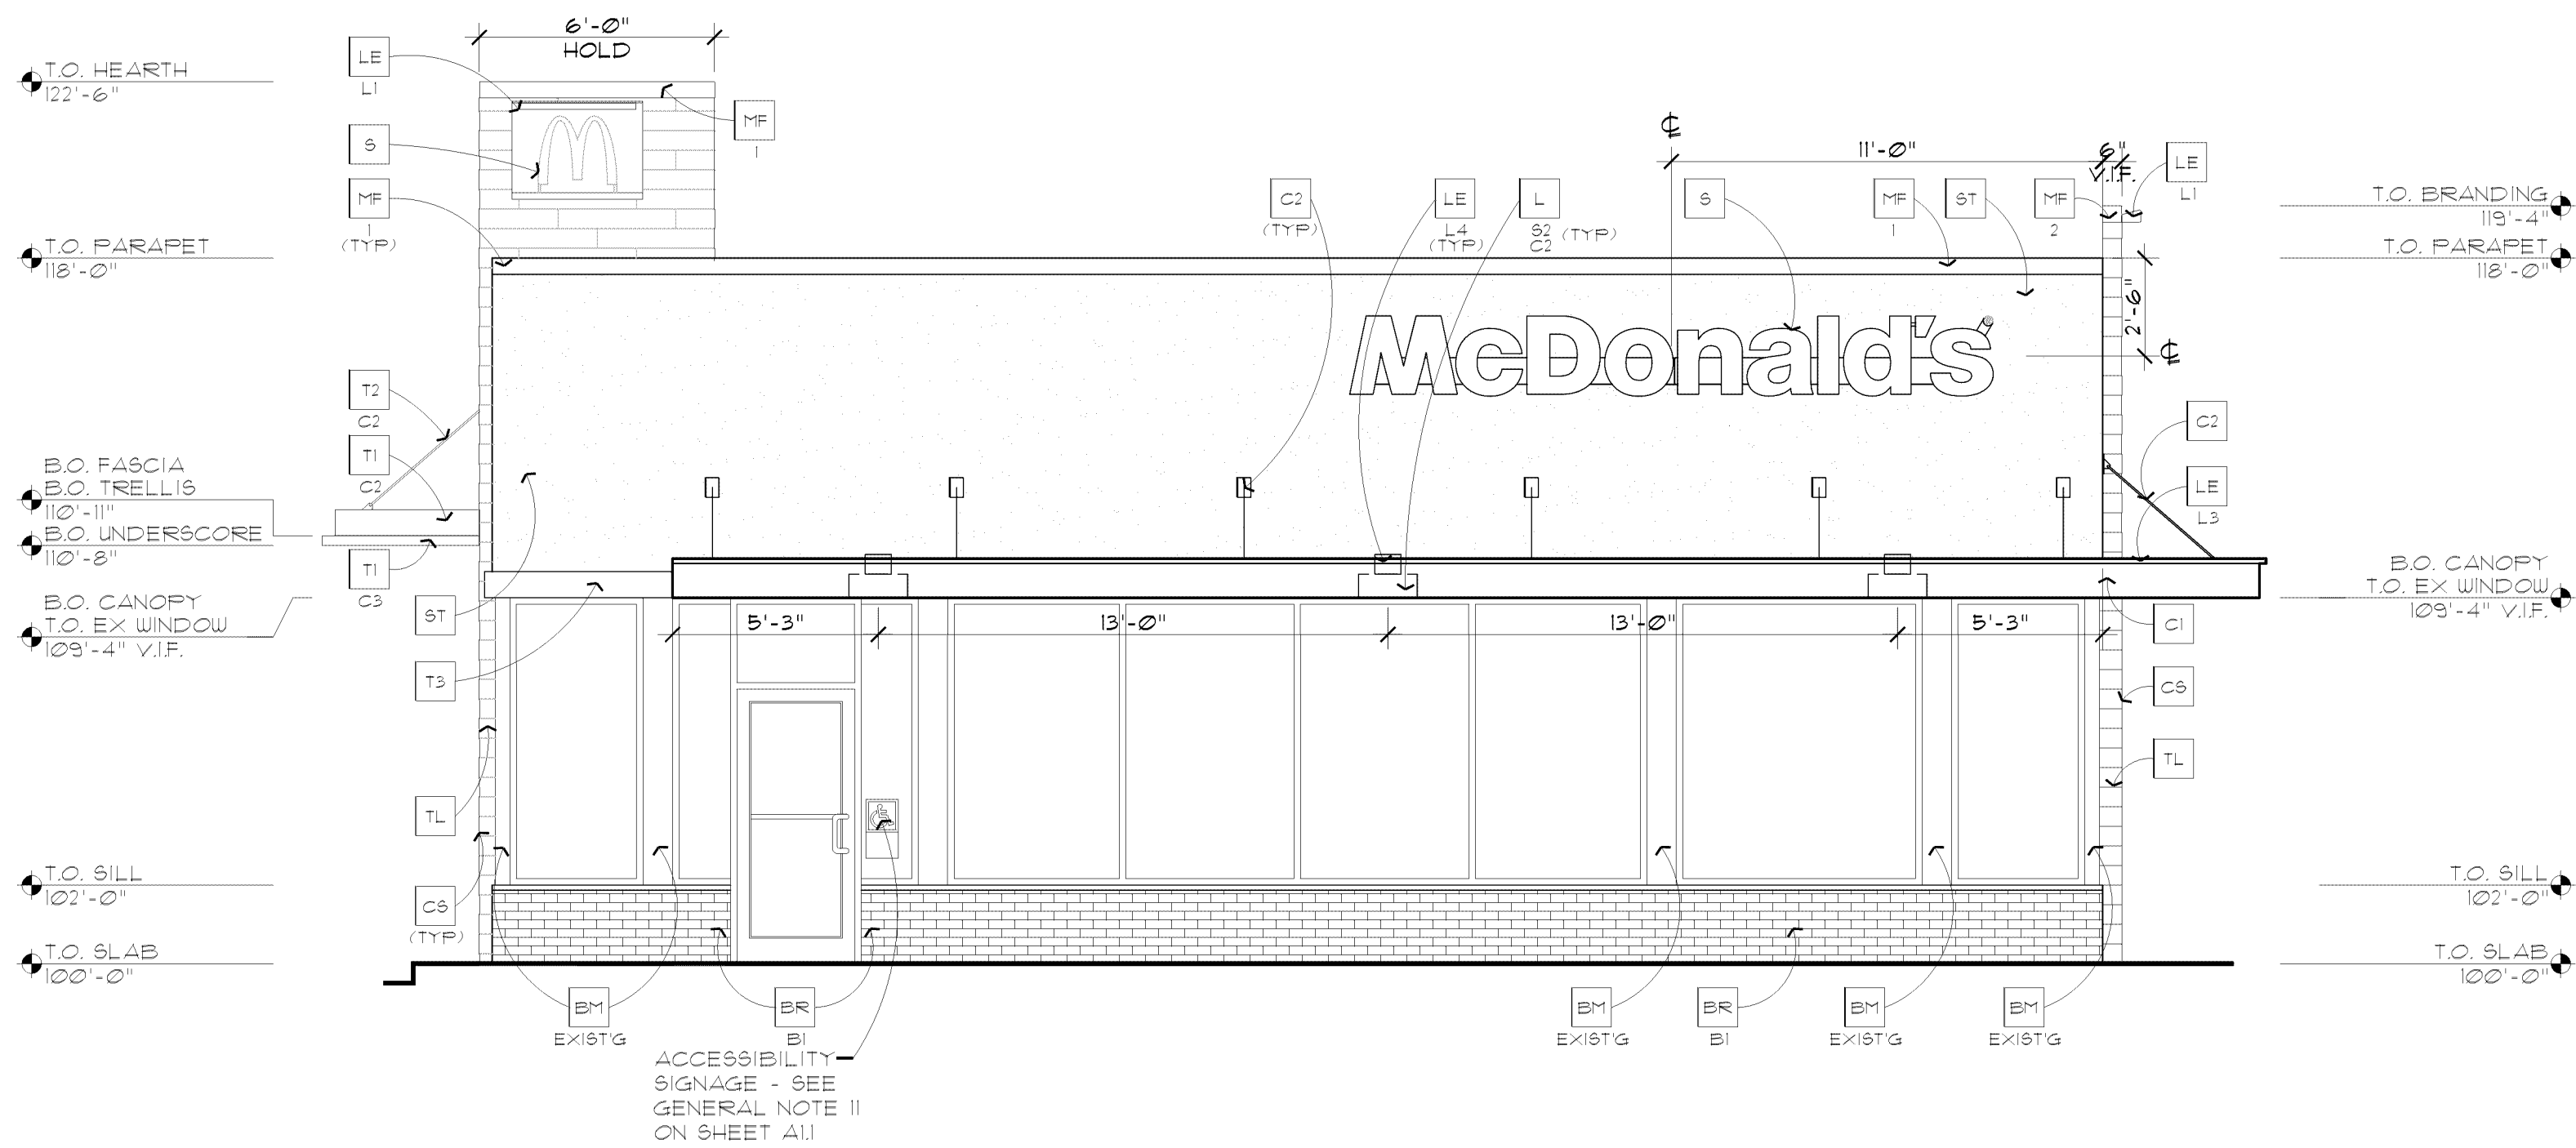

1 FRONT ELEVATION
1/4" = 1'-0"

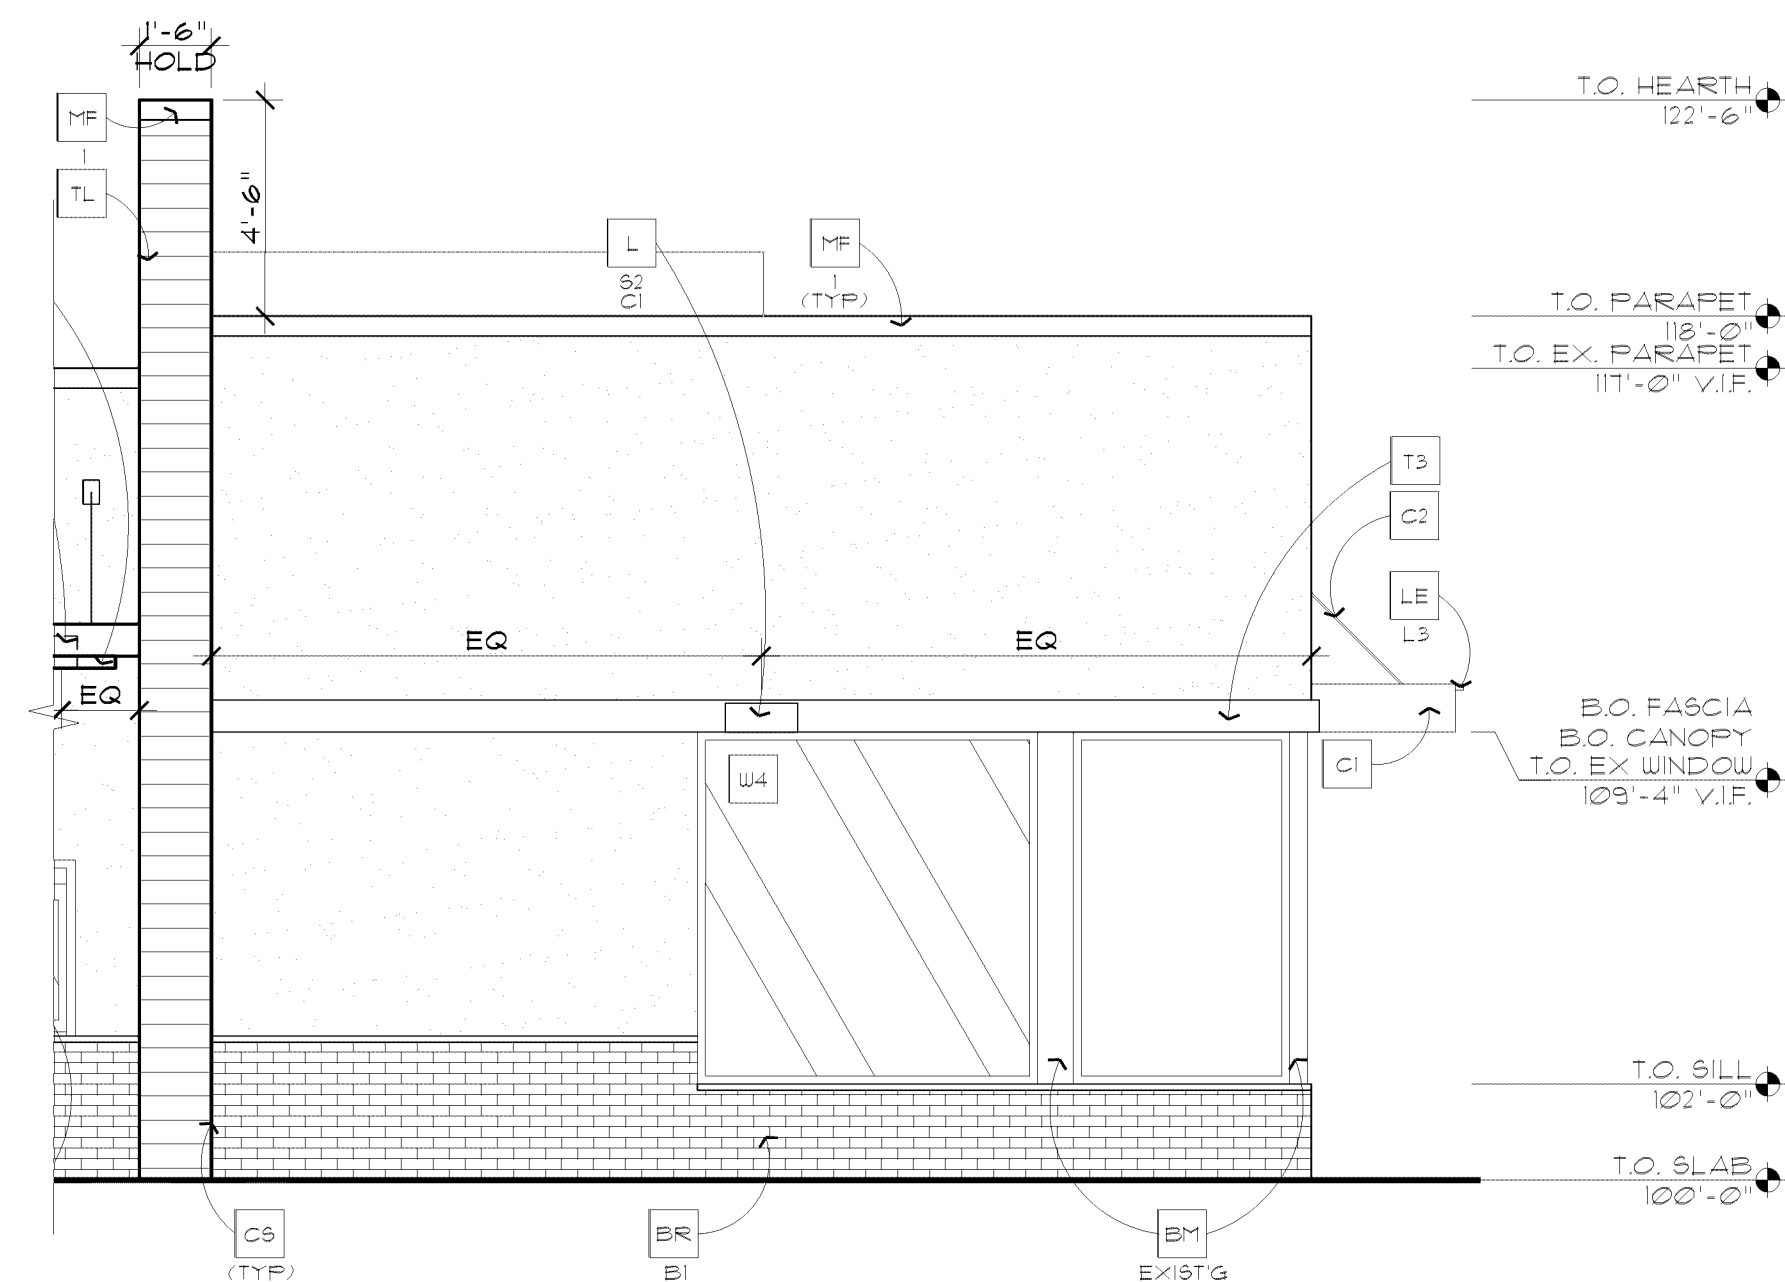

2 PARTIAL DRIVE-THRU SIDE ELEVATION
1/4" = 1'-0"

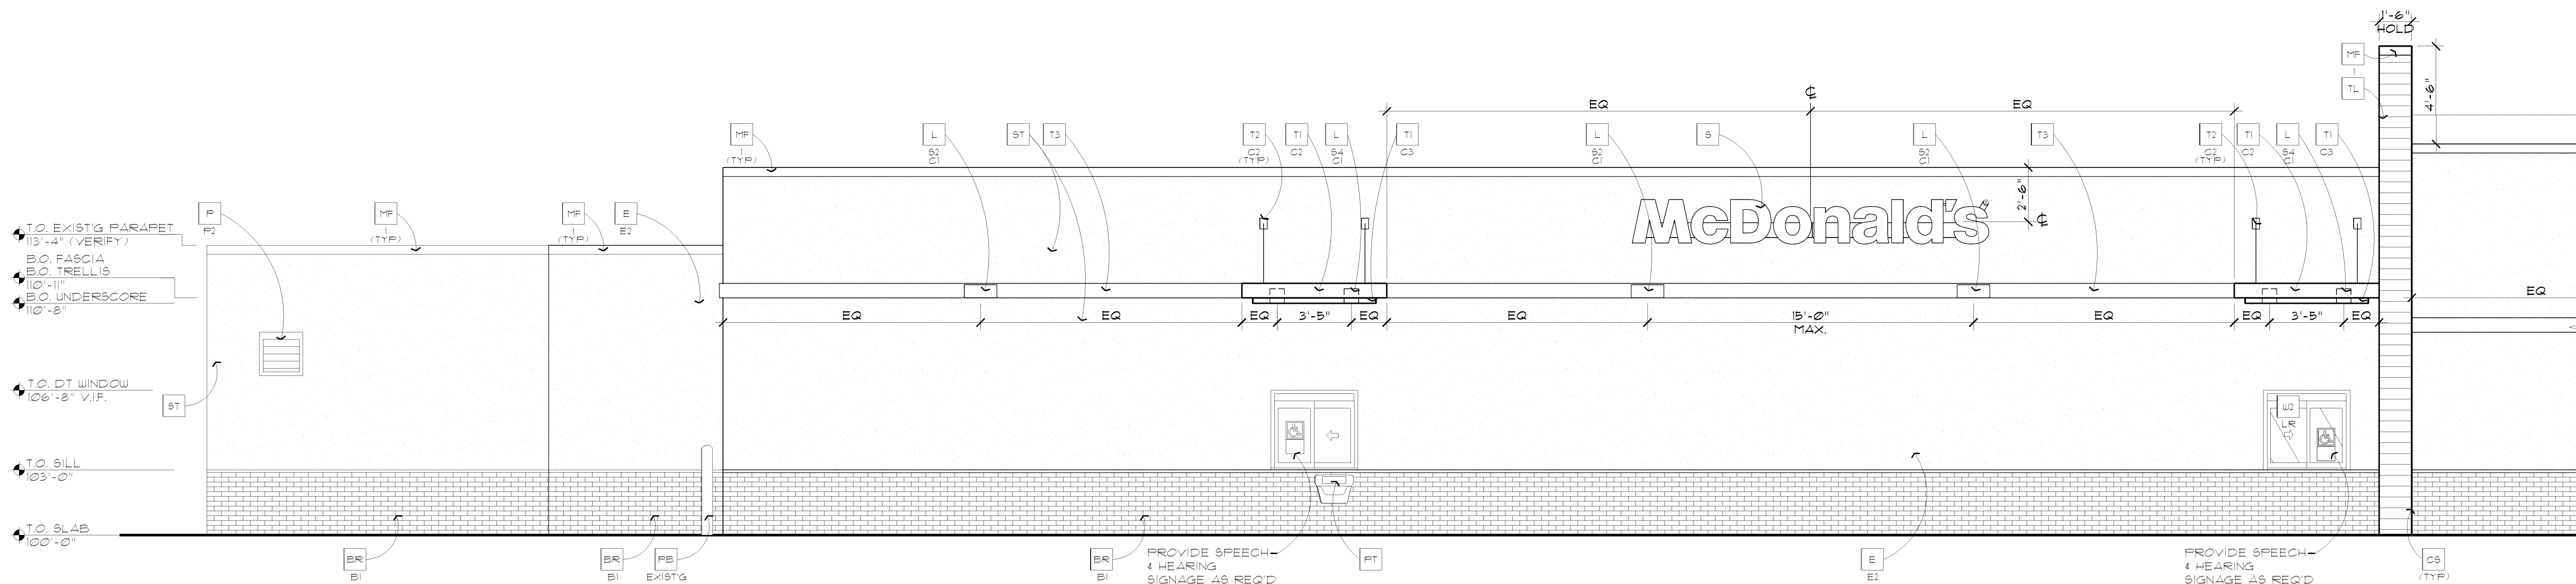

3 PARTIAL DRIVE-THRU SIDE ELEVATION
1/4" = 1'-0"

KEY NOTES:

BM BRAKE METAL - 240 ALUM COIL STOCK METAL WRAP, MATCH WINDOW COLOR

BR THIN FACE BRICK
BI = "RED BLEND VELOUR" BY ENDICOTT OR EQUAL

C1 ALUMINUM CANOPY SYSTEM (COLOR: WHITE)

C2 ALUMINUM CANOPY TIE-BACK SYSTEM (COLOR: WHITE)

C3 OUTSIDE CORNER STRIPS
COLOR: DARK ANTHRACITE
RONDEC ROOOTS DA
BY: SCHLUTER SYSTEMS L.P.
CONTACT: EARL MAIGUS, (510) 324-3410

C4 ALUMINUM CANOPY TIE-BACK SYSTEM (COLOR: WHITE)

C5 OUTSIDE CORNER STRIPS
COLOR: DARK ANTHRACITE
RONDEC ROOOTS DA
BY: SCHLUTER SYSTEMS L.P.
CONTACT: EARL MAIGUS, (510) 324-3410

C6 ALUMINUM CANOPY TIE-BACK SYSTEM (COLOR: WHITE)

C7 OUTSIDE CORNER STRIPS
COLOR: DARK ANTHRACITE
RONDEC ROOOTS DA
BY: SCHLUTER SYSTEMS L.P.
CONTACT: EARL MAIGUS, (510) 324-3410

C8 ALUMINUM CANOPY TIE-BACK SYSTEM (COLOR: WHITE)

D DOOR - PAINTED TO MATCH SURROUNDING MATERIAL 'ST'

G GUTTER/OVERFLOW TO BE PAINTED TO MATCH SURROUNDING MATERIAL 'ST'

L LIGHT FIXTURE - SEE ELECTRICAL

LI TYPE:
91 = NOT USED
92 = DOWN ONLY WALL SCONCE FIXTURE
93 = NOT USED
94 = RECESSED DOWN FIXTURE
COLOR:
C1 = SILVER
C2 = WHITE

LE ACCENT LIGHTING - SEE ELECTRICAL

LI LED LIGHT:
L1 = DOWN ONLY FIXTURE
L2 = NOT USED
L3 = INTEGRAL CANOPY FIXTURE
L4 = FLOOD LIGHT

LI TYPE:
91 = NOT USED
92 = DOWN ONLY WALL SCONCE FIXTURE
93 = NOT USED
94 = RECESSED DOWN FIXTURE
COLOR:
C1 = SILVER
C2 = WHITE

LE ACCENT LIGHTING - SEE ELECTRICAL

LI LED LIGHT:
L1 = DOWN ONLY FIXTURE
L2 = NOT USED
L3 = INTEGRAL CANOPY FIXTURE
L4 = FLOOD LIGHT

LI TYPE:
91 = NOT USED
92 = DOWN ONLY WALL SCONCE FIXTURE
93 = NOT USED
94 = RECESSED DOWN FIXTURE
COLOR:
C1 = SILVER
C2 = WHITE

MF METAL FASCIA - COLOR TO MATCH CORRUGATED METAL PANEL, REFER TO SECTIONS FOR ADD'L INFO

MF TYPE:
1 = PRE-FAB ANCHOR-TITE FASCIA
2 = PRE-FAB CUSTOM BRANDING FASCIA
3 = METAL COPING

MF TILE MOVEMENT JOINT - (MOVEMENT JOINTS MUST BE MAINTAINED OVER TIME W/ SEALANT)

MF DILEX BUBBLES
BY: SCHLUTER SYSTEMS L.P.
CONTACT: EARL MAIGUS, (510) 324-3410

MF METAL LETTERING - BY OTHERS

MF PAINT COLOR:
P1 = NOT USED
P2 = TO MATCH 'ST'

MF PIPE BOLLARD - PAINTED YELLOW

MF METAL FASCIA - COLOR TO MATCH CORRUGATED METAL PANEL, REFER TO SECTIONS FOR ADD'L INFO

MF TYPE:
1 = PRE-FAB ANCHOR-TITE FASCIA
2 = PRE-FAB CUSTOM BRANDING FASCIA
3 = METAL COPING

MF TILE MOVEMENT JOINT - (MOVEMENT JOINTS MUST BE MAINTAINED OVER TIME W/ SEALANT)

PT (RMHC) COIN COLLECTOR UNIT CMU DT1000 STD. CALL 1-888-743-7435 TO ORDER

S McDONALD'S SIGNAGE BY OTHERS - UNDER SEPARATE PERMIT. SEE SIGNAGE SUPPORT NOTE ON THIS SHEET.

ST STUCCO (TO MATCH SURROUNDING BUILDINGS) PAREX INC. COLOR 12429 1 SHADE DARKER THAN 10401 TEXTURE: 325 SAND COURSE

TI ALUMINUM TRELLIS

TI COLOR:
C1 = CITYSCAPE
C2 = CHARCOAL
C3 = GOLD

T2 TRELLIS TIE-BACK

T2 COLOR:
C1 = CITYSCAPE
C2 = CHARCOAL

T3 2x8 ALUMINUM WALL FASCIA (COLOR: CITYSCAPE)

T4 2x8 ALUMINUM WALL FASCIA (COLOR: CITYSCAPE)

T5 2x8 ALUMINUM WALL FASCIA (COLOR: CITYSCAPE)

TL TILE BY EUROQUEST, E-WOOD COLLECTION COLOR: R3 BLACK SIZE: 6" x 36" PATTERN: 1/4 RUNNING BOND GROUT: MAPEI - 09 GRAY CONTACT: JAN DETER (714) 931-7500

TL EXTERIOR WINDOW ASSEMBLY W/ TEMPERED GLASS - SEE ASSEMBLY NOTES 3/A22

W2 DRIVE-THRU WINDOW BY READY ACCESS 600 SERIES, 36" SERVICE HEIGHT WITH TRANSOM - CONFIRM OPTIONS WITH MCD AREA CONSTRUCTION MANAGER

W2 SLIDE DIRECTION: RL = RIGHT TO LEFT LR = LEFT TO RIGHT

W2 SIGNAGE SUPPORT NOTE: UNIBODY FASCIA SIGN WALL SUPPORTS TO BE VERIFIED WITH McDONALD'S ACM AND COORDINATED WITH SIGN MANUFACTURER.

W2 SLIDE DIRECTION: RL = RIGHT TO LEFT LR = LEFT TO RIGHT