


# OVERALL

PL202500160  
PL2025-160

FD emergency vehicle access to be maintained throughout the property including gate access and clear width to accommodate the mini pumper. Gate access control devices to be approved by the Fire Prevention Division.



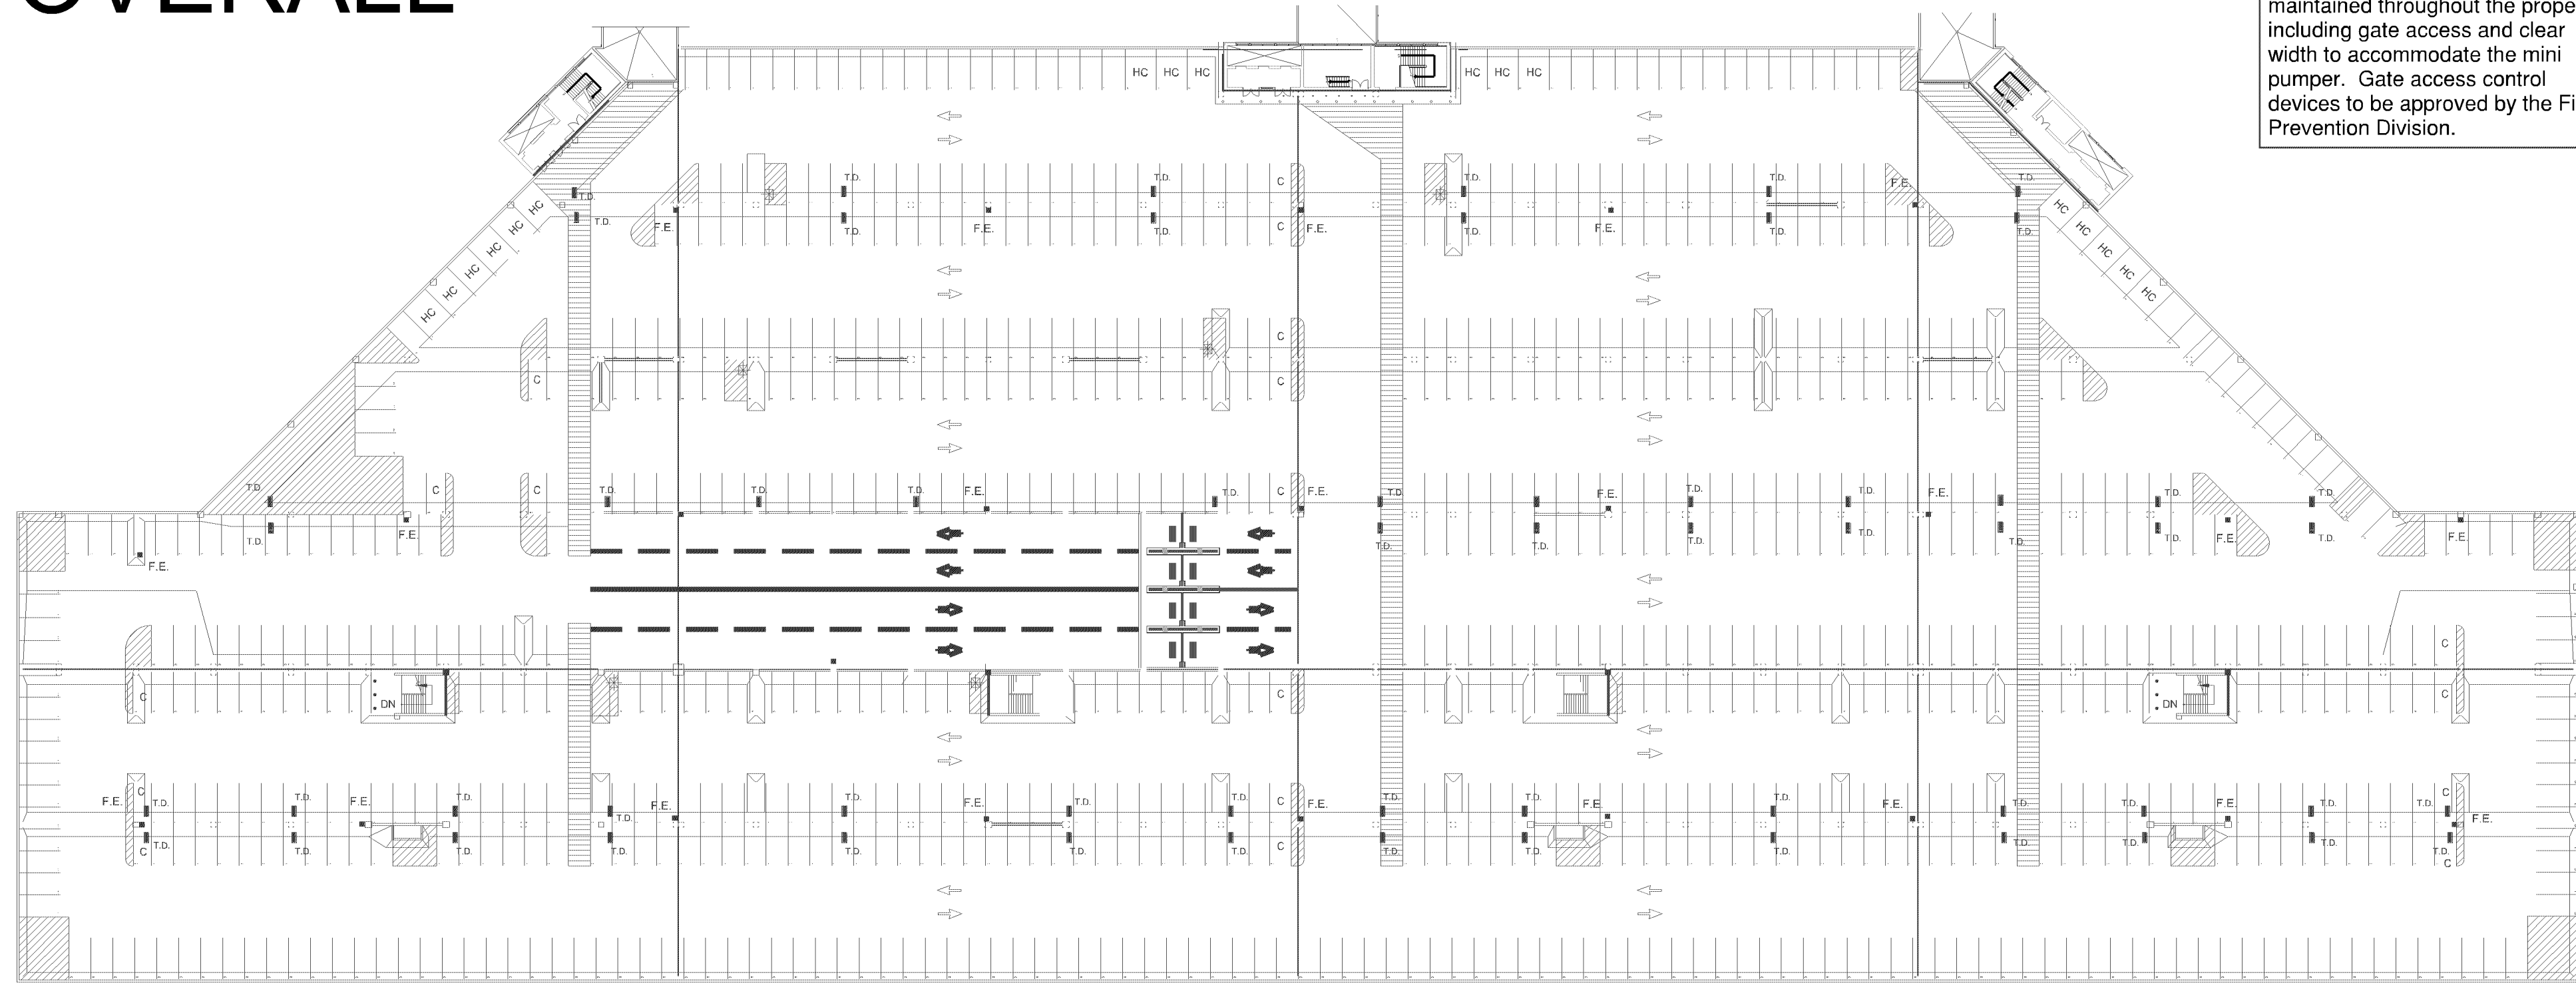




  
PROJECT  
MALL OF AMERICA®  
2131 Lindau Lane - Suite 500  
Bloomington, MN 55425


The information in this document is confidential and a proprietary trade secret of the Landlord and may not be copied, distributed, published or disclosed without prior written permission. Landlord retains the right to design, change, alter or modify (without prior written notice) the size and configuration of any or all of the Center or any of its buildings, premises, driveway, walk, corridor, aisle, shared space or common areas without the tenant's consent. This document does not constitute any contract or obligation by the Landlord. Landlord makes no representation or warranties regarding the Center, any premises contained therein or the accuracy of the information contained in this document. Circles, readable area is indicated pursuant to ANSI/BOMA 2005-2010 Retail Building Standard. It is the responsibility of Tenant or Tenant's contractor to field verify existing site conditions and dimensions.

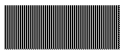

# ZOOMED IN

Ensure Bloomington Fire Prevention and the Police Departments have reviewed and approved of the proposed access designs.


-  LOOPS
-  GATE OPERATORS
-  BOLLARDS
-  CONCRETE ISLANDS
-  STRIPING

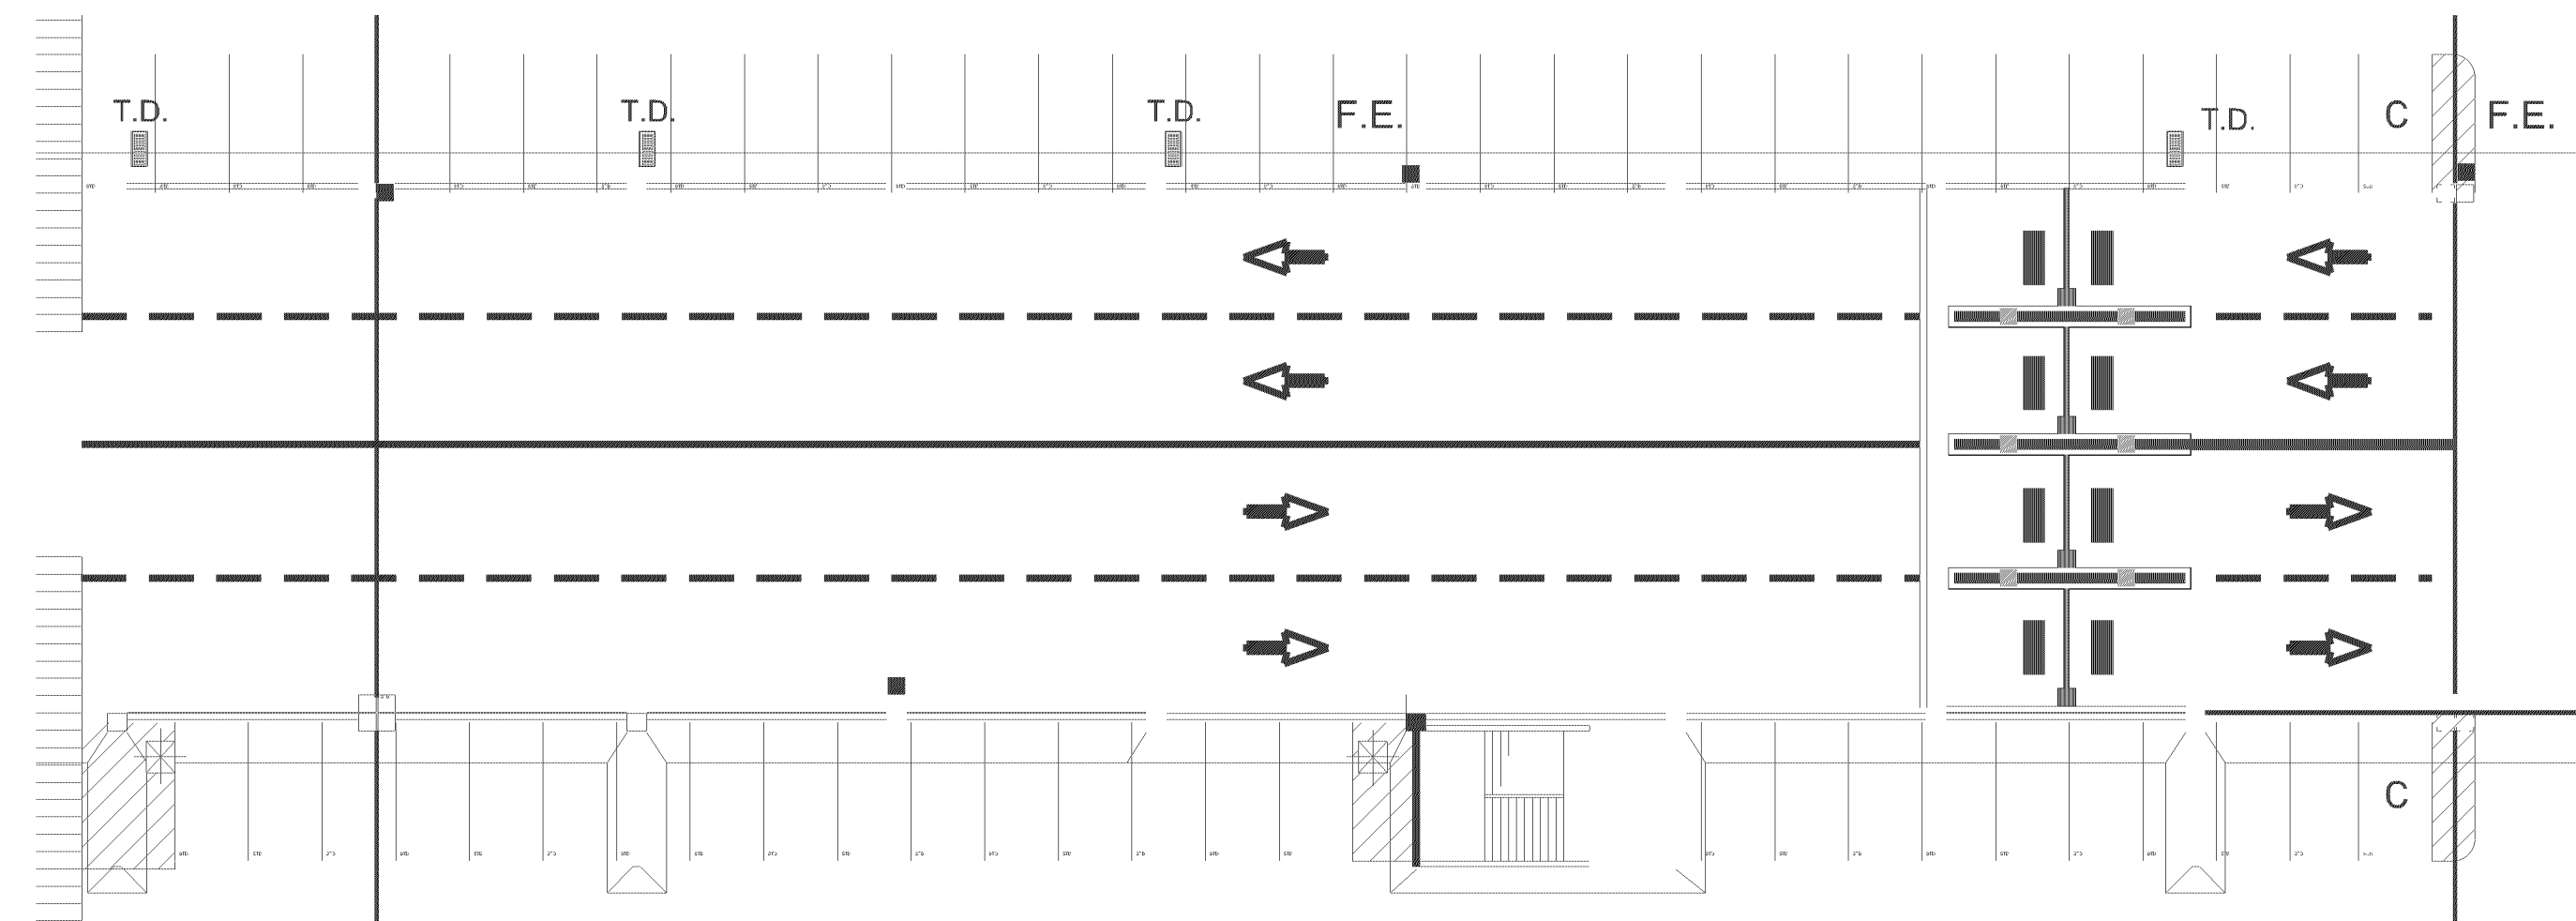

PARK & FLY - PARKING RAMP P7 GATE


A Building permit is required for monument signs.

A Building permit is required for any wall signs that are over 50 s.f. or weigh more than 50 lbs.

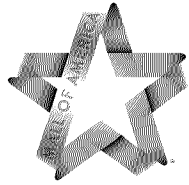



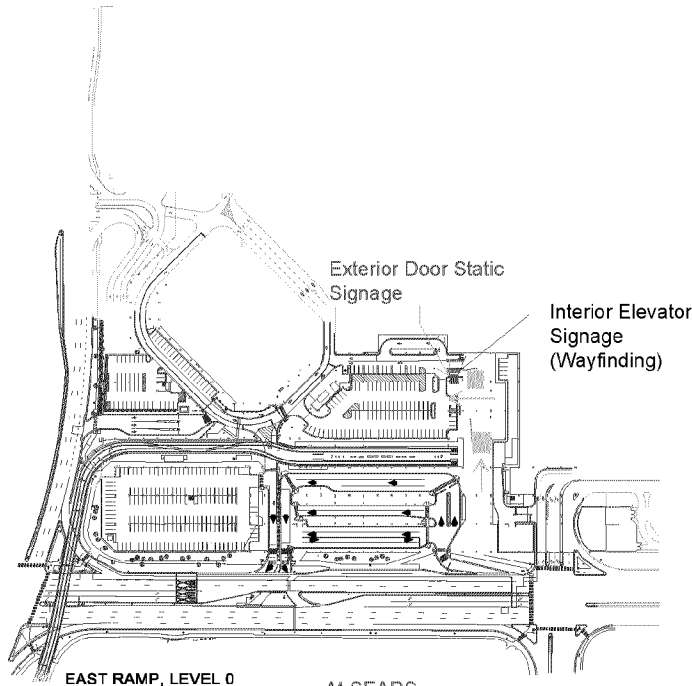


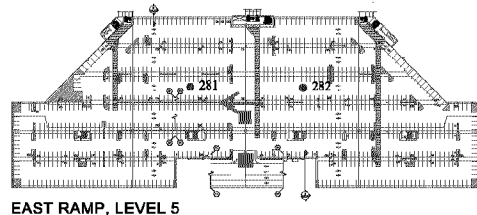
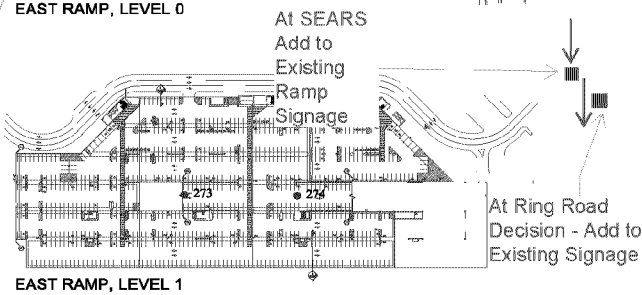
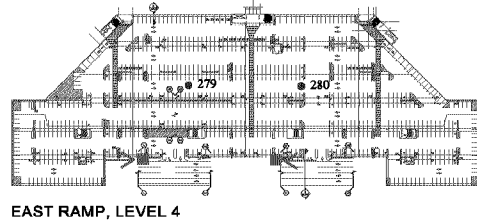
PL202500160

2121 LINDAU LANE - SUITE 500  
 BLOOMINGTON, MN 55425  
 PL2025-160






Key:

-  Park Assist Sign Modification
-  Hi-Vis Directional Static Signage
-  Wall Mounted Static Signage
-  Column Directional Signage to Elevator
-  Interior Elevator Graphics




PA Signage Alteration

PA Monument Sign w/ Additional Directional Signage

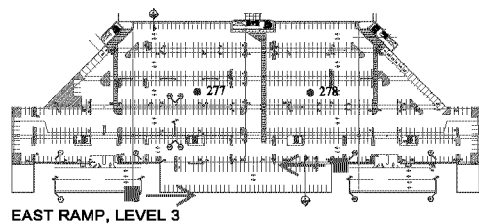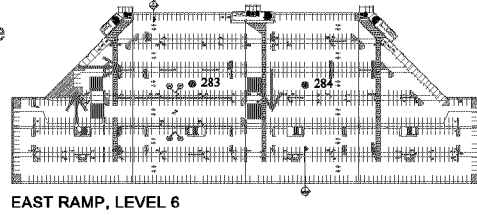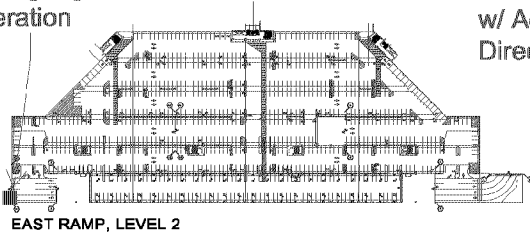

Park & Fly Signage

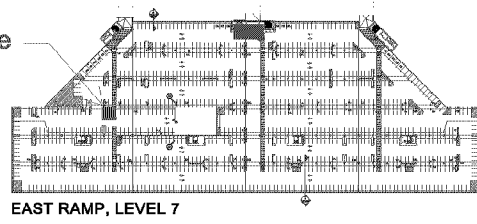

Notes:  
 1.) Park Assist Signage Modifications: Level 7 / Park & Fly

Please provide more detail on any proposed freestanding or wall signage.

The information in this document is confidential and a proprietary trade secret of the Landlord and may not be copied, distributed, published or disclosed without prior written permission. Landlord retains the right to design, change, alter or modify (without prior written notice) the size and configuration of any or all of the Center or any of the buildings, premises, hallways, malls, corridors, kiosks, tenant spaces or common areas contained therein, including, but not limited to, the identity, size, configuration, location or arrangement of any of the foregoing. This document does not constitute any contract or obligation by the Landlord. Landlord makes no representations or warranties regarding the Center, any premises contained therein, or the accuracy of the information contained in this document. Gross Leasable Area is calculated pursuant to ANSI/BOMA Z65.5-2010 Retail Building Standard. It is the responsibility of Tenant or Tenant's contractor to field verify existing site conditions and dimensions.

DBA Name: PARK & FLY  
 Unit No. N/A

0-P7 East Ramp Signage Plan


Date: 09/16/2025  
 Scale: NOT TO SCALE



The information in this document is confidential and a proprietary trade secret of the Landlord and may not be copied, distributed, published or disclosed without prior written permission. Landlord retains the right to design, change, alter or modify (without prior written notice) the size and configuration of any or all of the Center or any of the buildings, premises, interiors, malls, corridors, kiosks, leased spaces or common areas contained therein, including, but not limited to, the identity, size, configuration, location or arrangement of any of the foregoing. This document does not constitute any contract or obligation by the Landlord. Landlord makes no representation or warranties regarding the Center, any premises contained therein, or the accuracy of the information contained in this document. (See Leaseable Area in Schedule pursuant to ANS/BOMA 2015-2016 Retail Building Standard. It is the responsibility of Tenant or Tenant's contractor to field verify existing site conditions and dimensions.



NOT TO SCALE

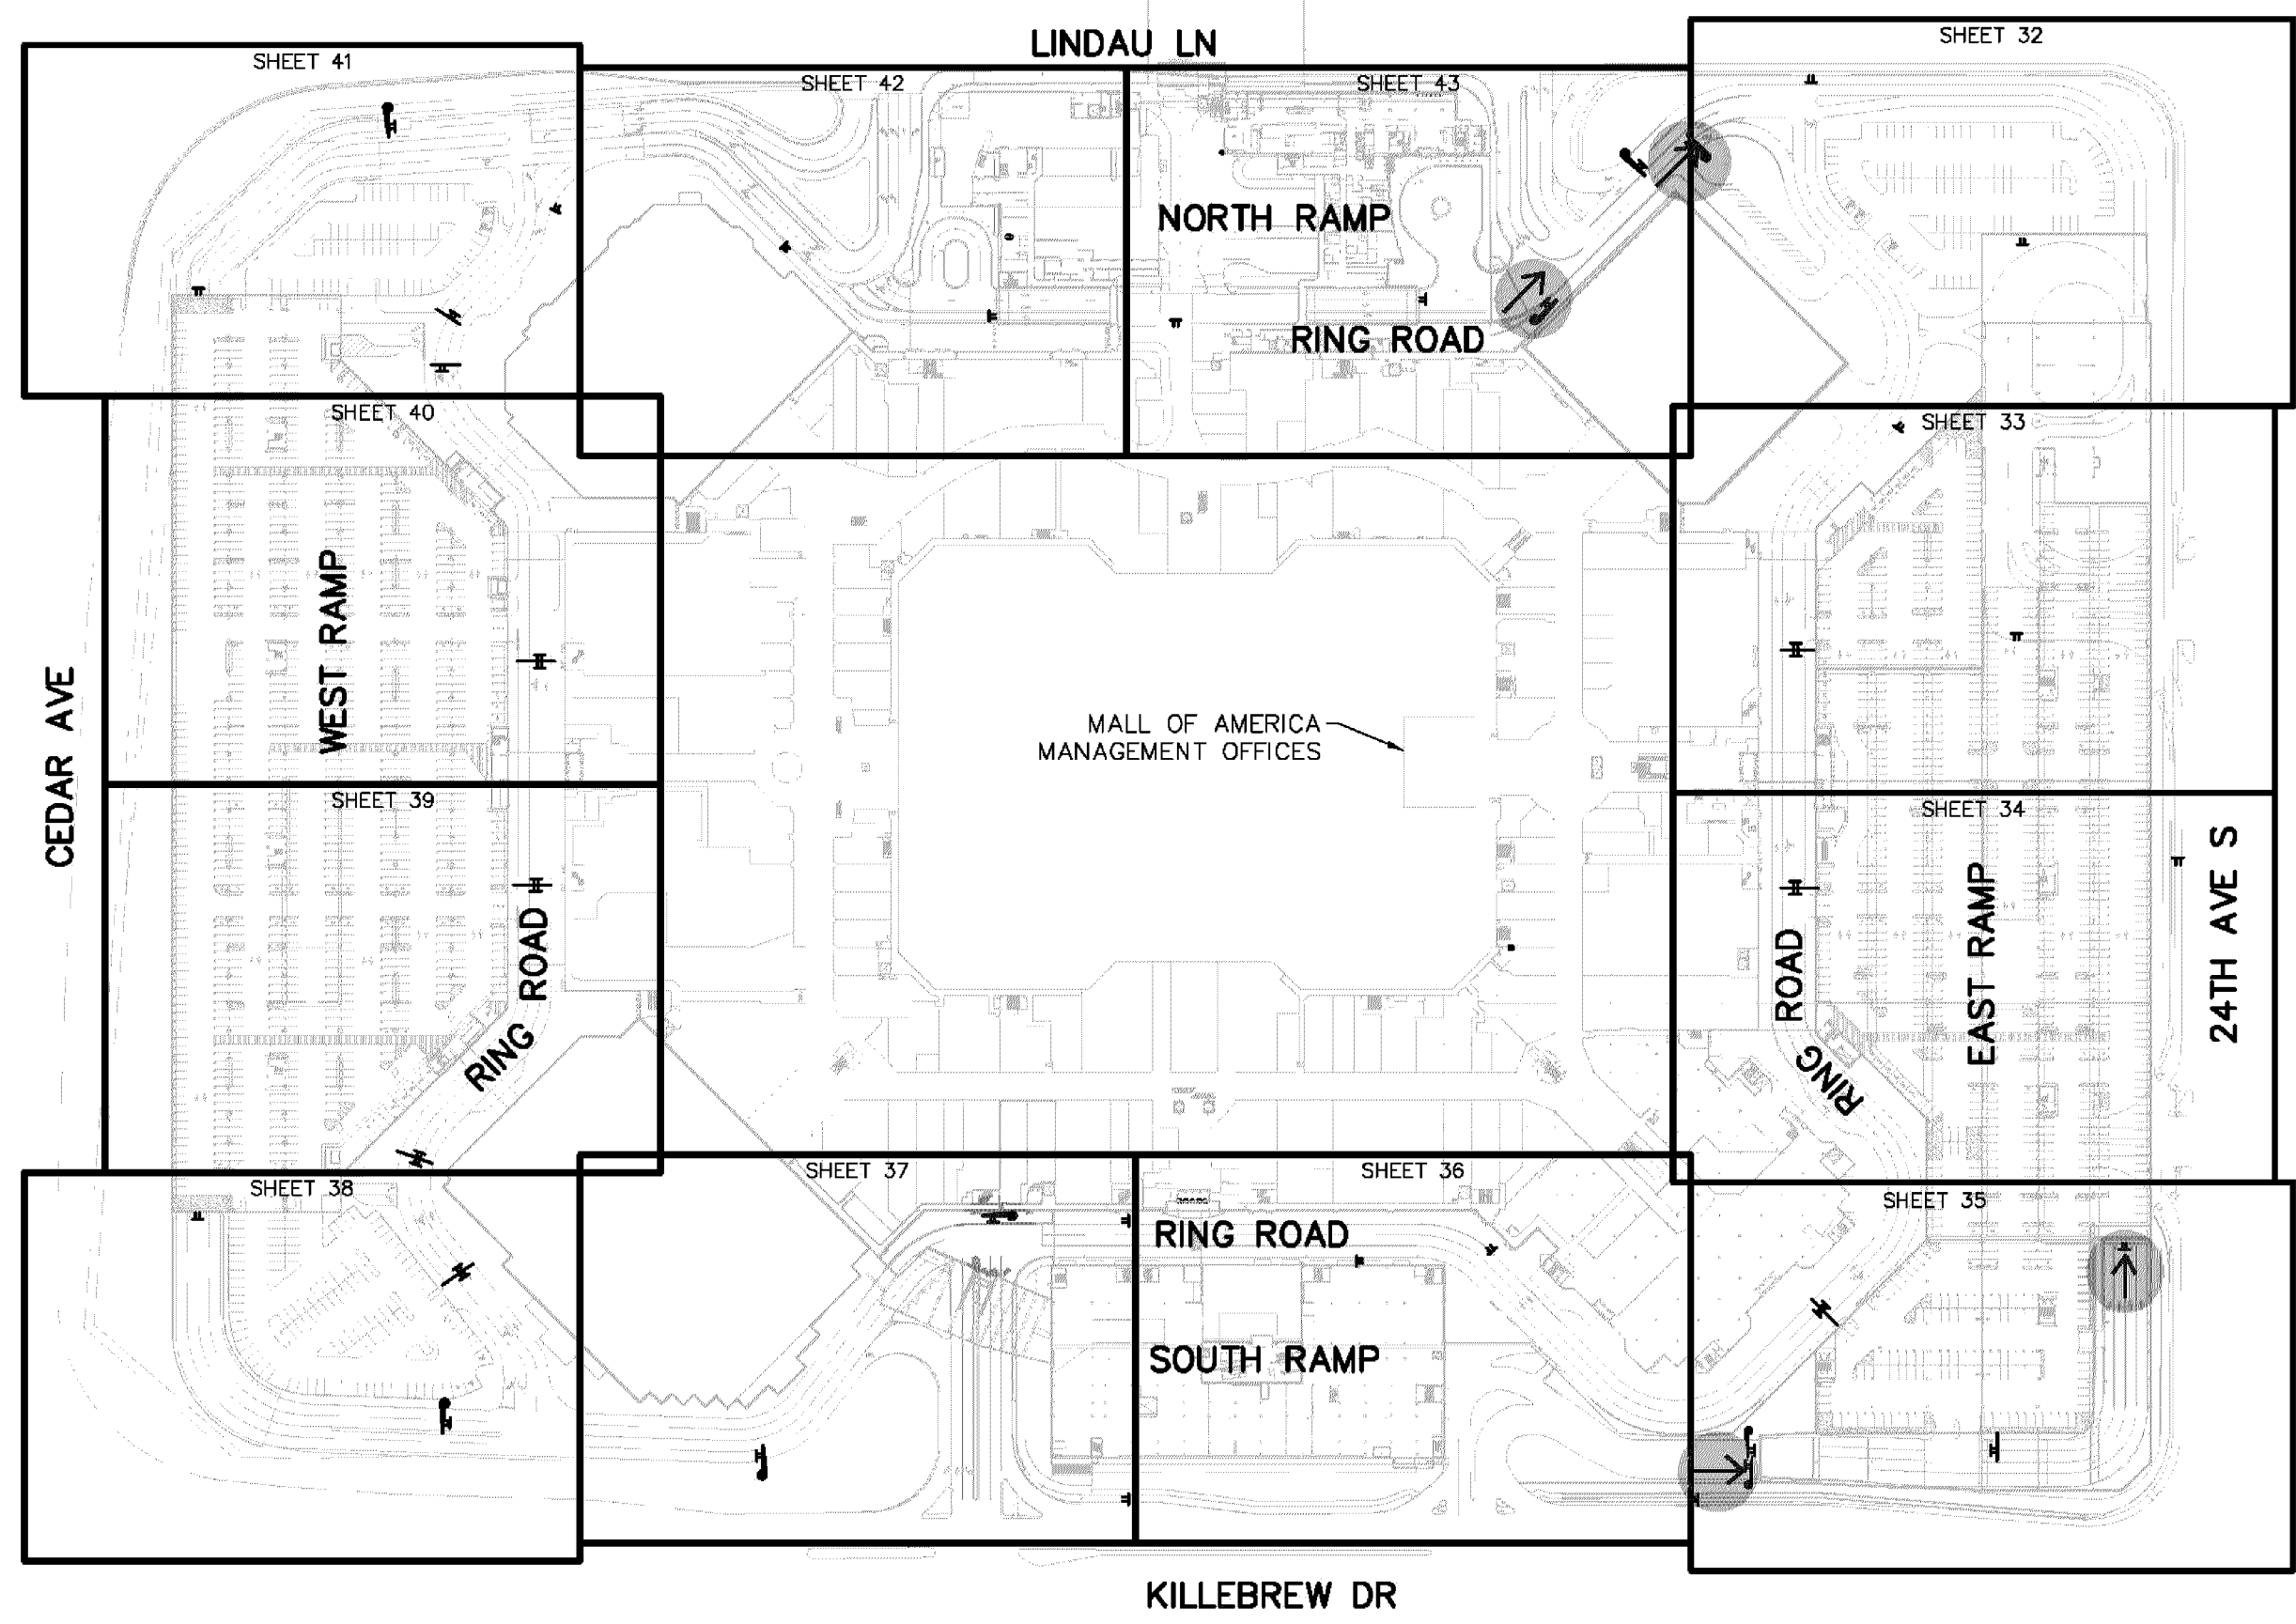


EAST PARKING RAMP  
SHEETS: 44-50  
WEST PARKING RAMP  
SHEETS: 51-57  
NORTH RAMP  
SHEETS: 42-43  
SOUTH RAMP  
SHEETS: 36-37

Drawing name: X:\2024\140095\03SIGN\Plan\Sheets\140095-genby.dwg --- Printed: Mar 02, 2016 --- 2:05pm

DATE	REVISIONS	Design File:	Designed By:		<b>GENERAL LAYOUT</b> Mall of America - Park & Fly
		Dwg Name:	Drawn By:		
		Date:	Checked By:		

These DMS signs are on public ROW and controlled by the City. Advertising is not allowed on DMS signs per MnMUTCD.

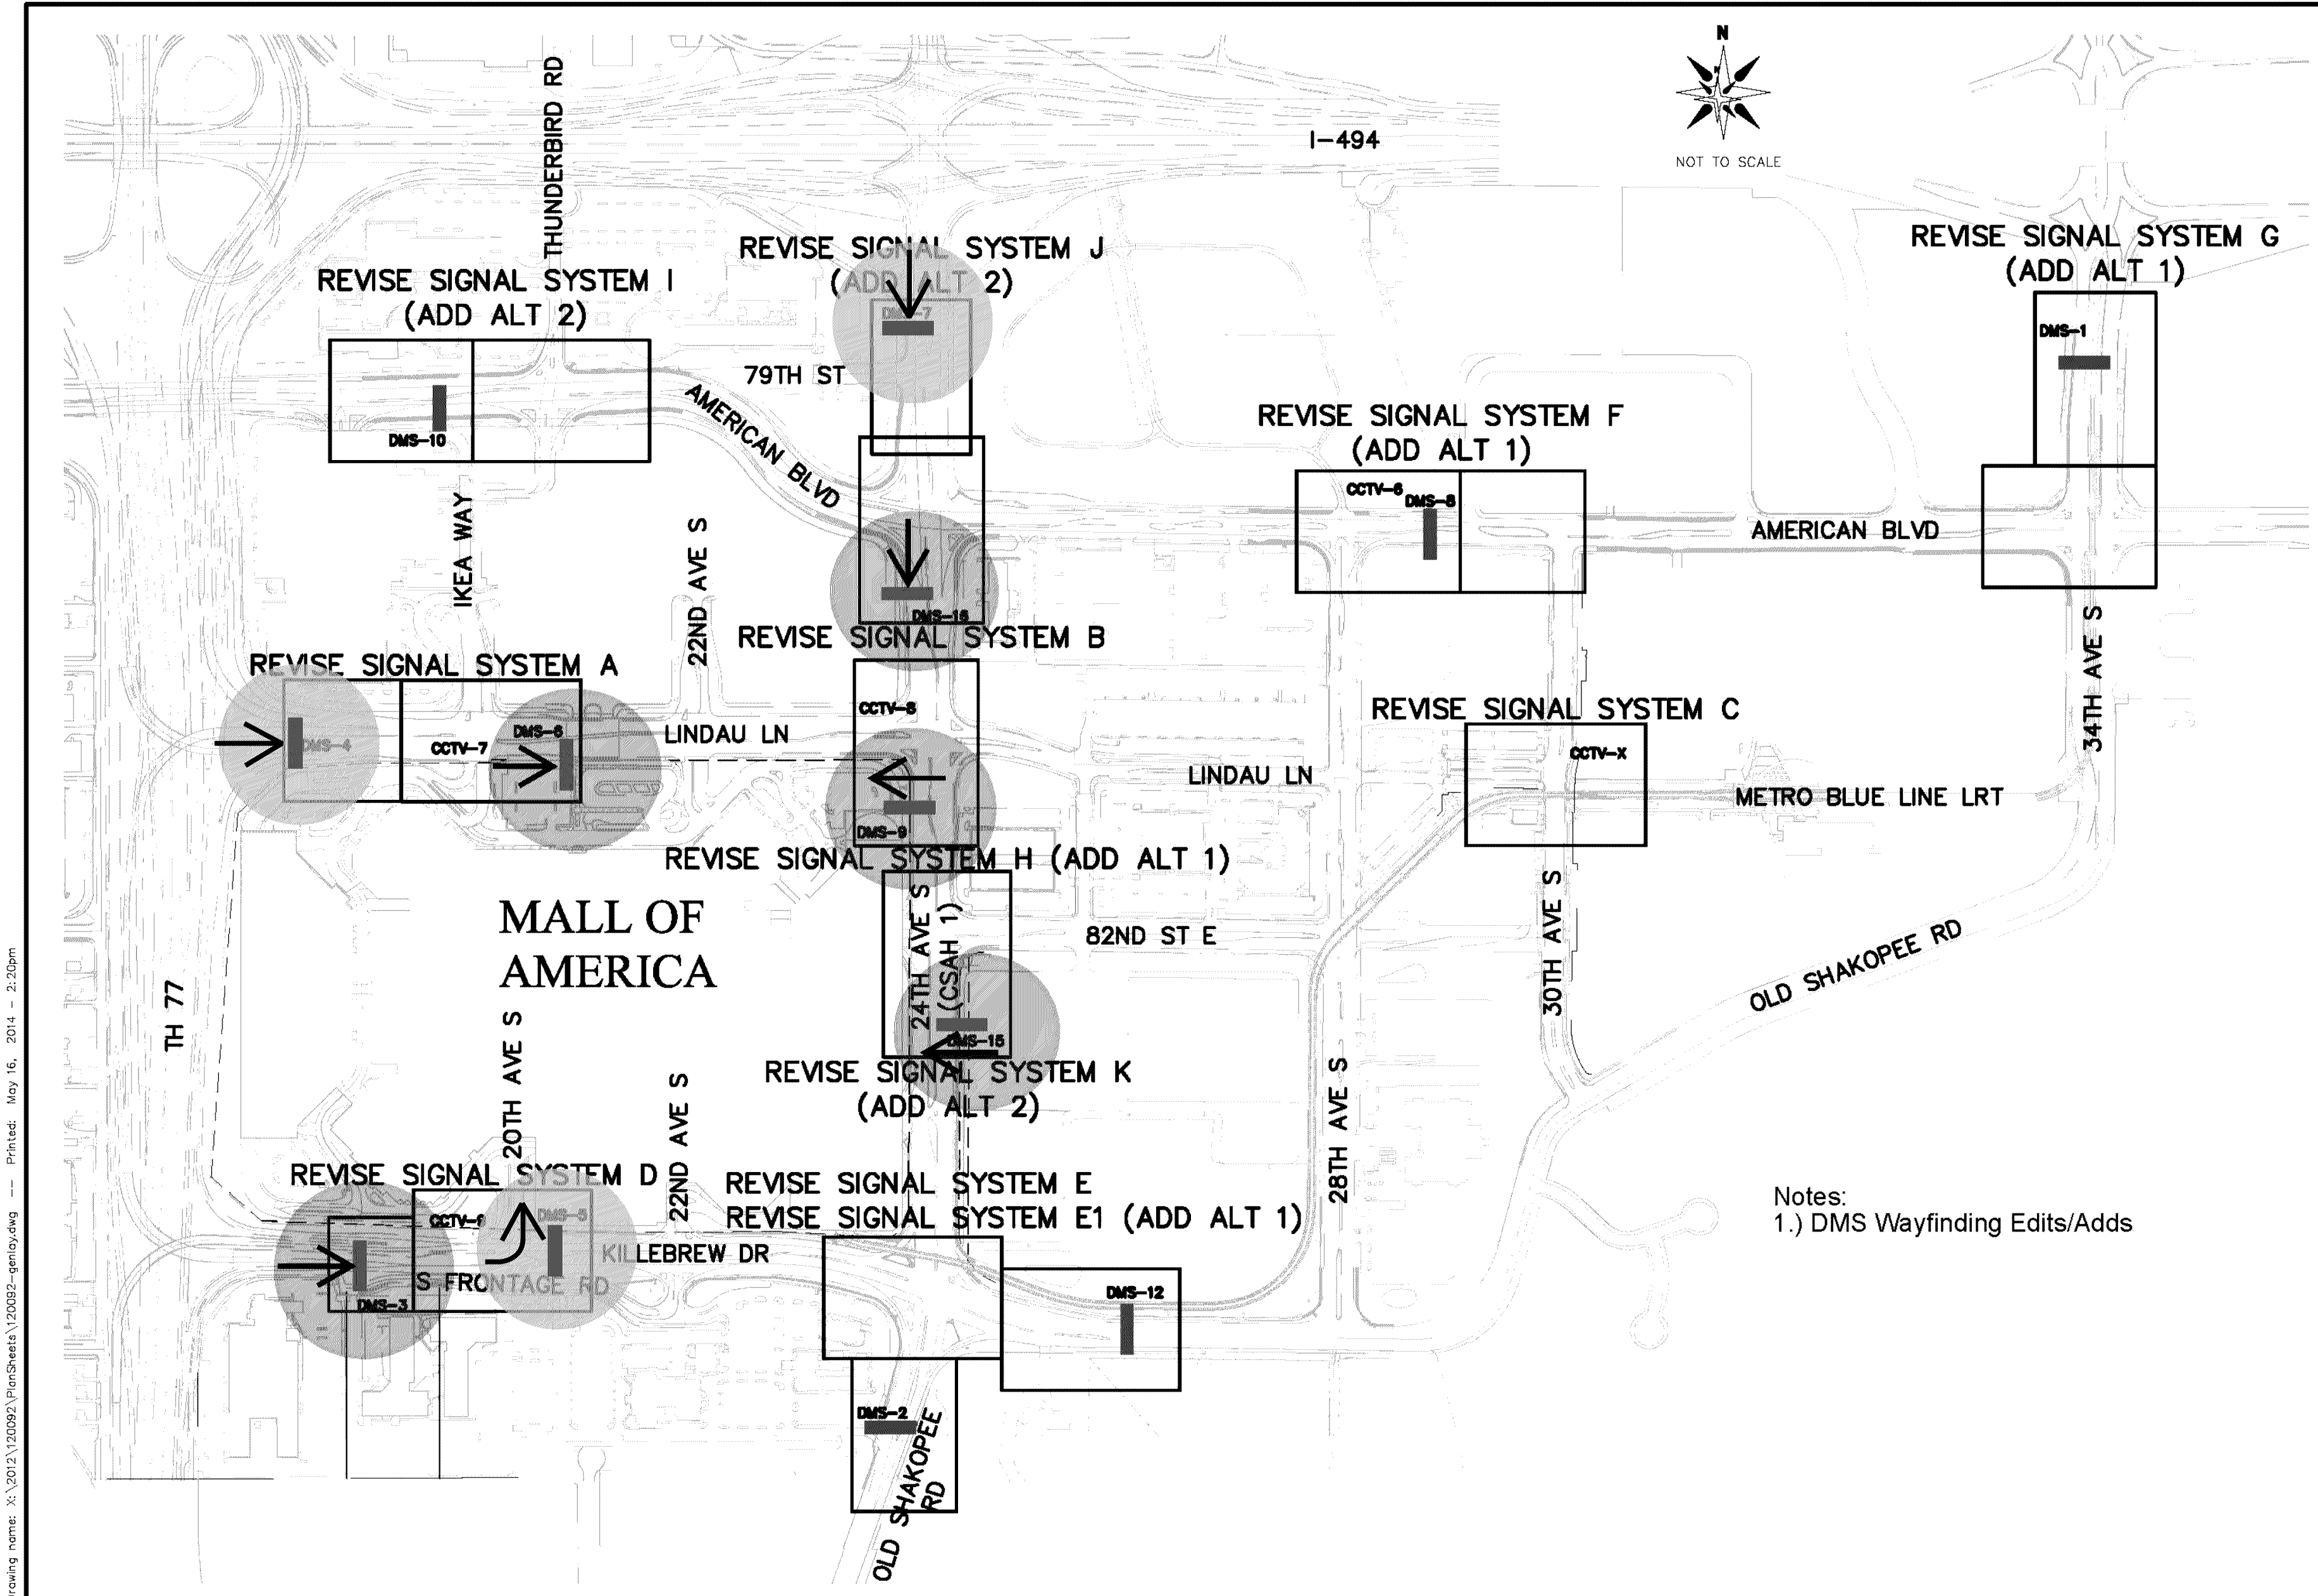

GENERAL LAYOUT

Mall of America Park & Fly

REVISIONS	
DATE	DESCRIPTION

Notes:  
1.) DMS Wayfinding Edits/Addds

Drawing name: X:\2012\120092\PlanSheets\20092-genlay.dwg -- Printed: May 16, 2014 - 2:20pm