


AS BUILT

BY: DEAN VAN HOEVER
DATE: 2/1/11

EXTERNAL CHIMNEY SEALS
F&I'd ON SAN. MH's SHOWN
(UNLESS OTHERWISE NOTED)

CASE FILE #PL201900046

METRO DRIVE
FROM AMERICAN BLVD TO
STA 13+25

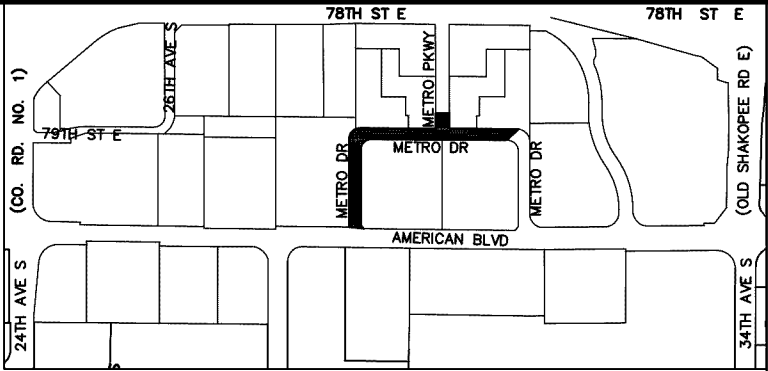



STREET MILL AND OVERLAY

METRO DRIVE:
FROM AMERICAN BLVD TO STA 13+25
METRO PARKWAY:
FROM METRO BLVD TO STA 21+00

CITY OF BLOOMINGTON
MINNESOTA
ENGINEERING DIVISION
PUBLIC WORKS DEPARTMENT
2010-102 PMP STREET MAINTENANCE PROJECT

REVISIONS		DATE	DESCRIPTION	BY

I HEREBY CERTIFY THAT THIS PLAN WAS PREPARED BY ME OR UNDER MY DIRECT SUPERVISION AND THAT I AM A DULY LICENSED PROFESSIONAL ENGINEER UNDER THE LAWS OF THE STATE OF MINNESOTA.		25847	2/23/10	DATE
JULIE M. LONG	LIC. #			
DRAWN:	KBO			
CHECKED:	JML			
APPROVED:	JML			
SHEET:		74	OF	94

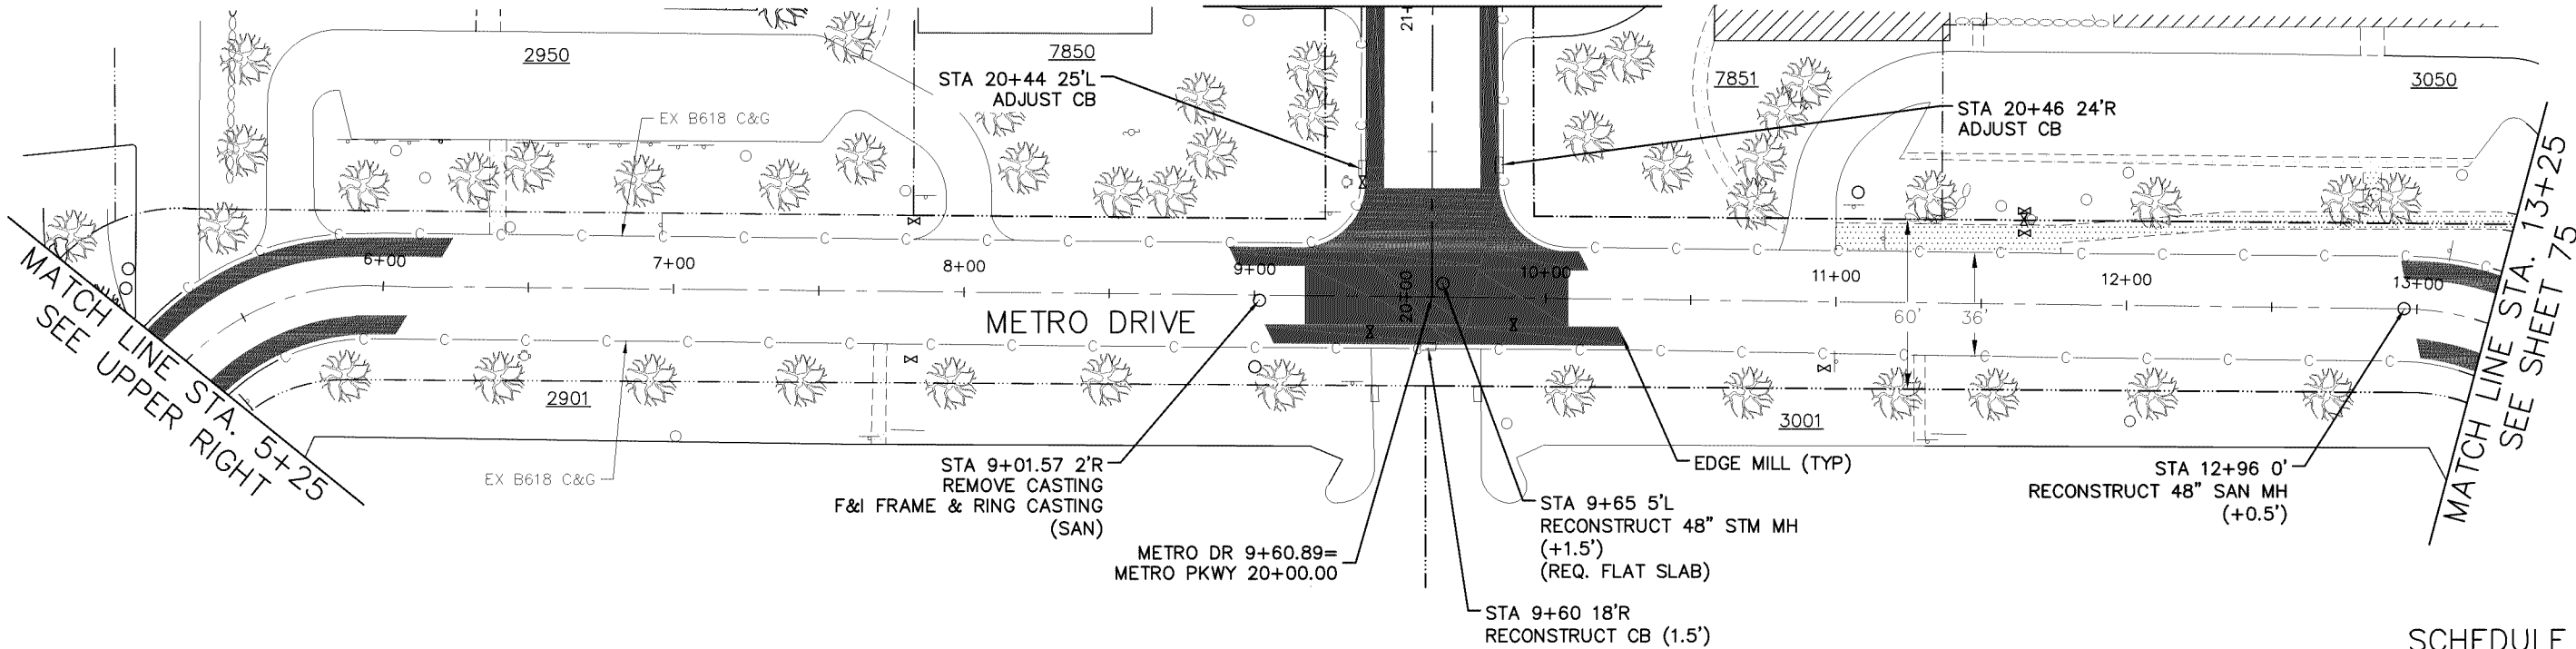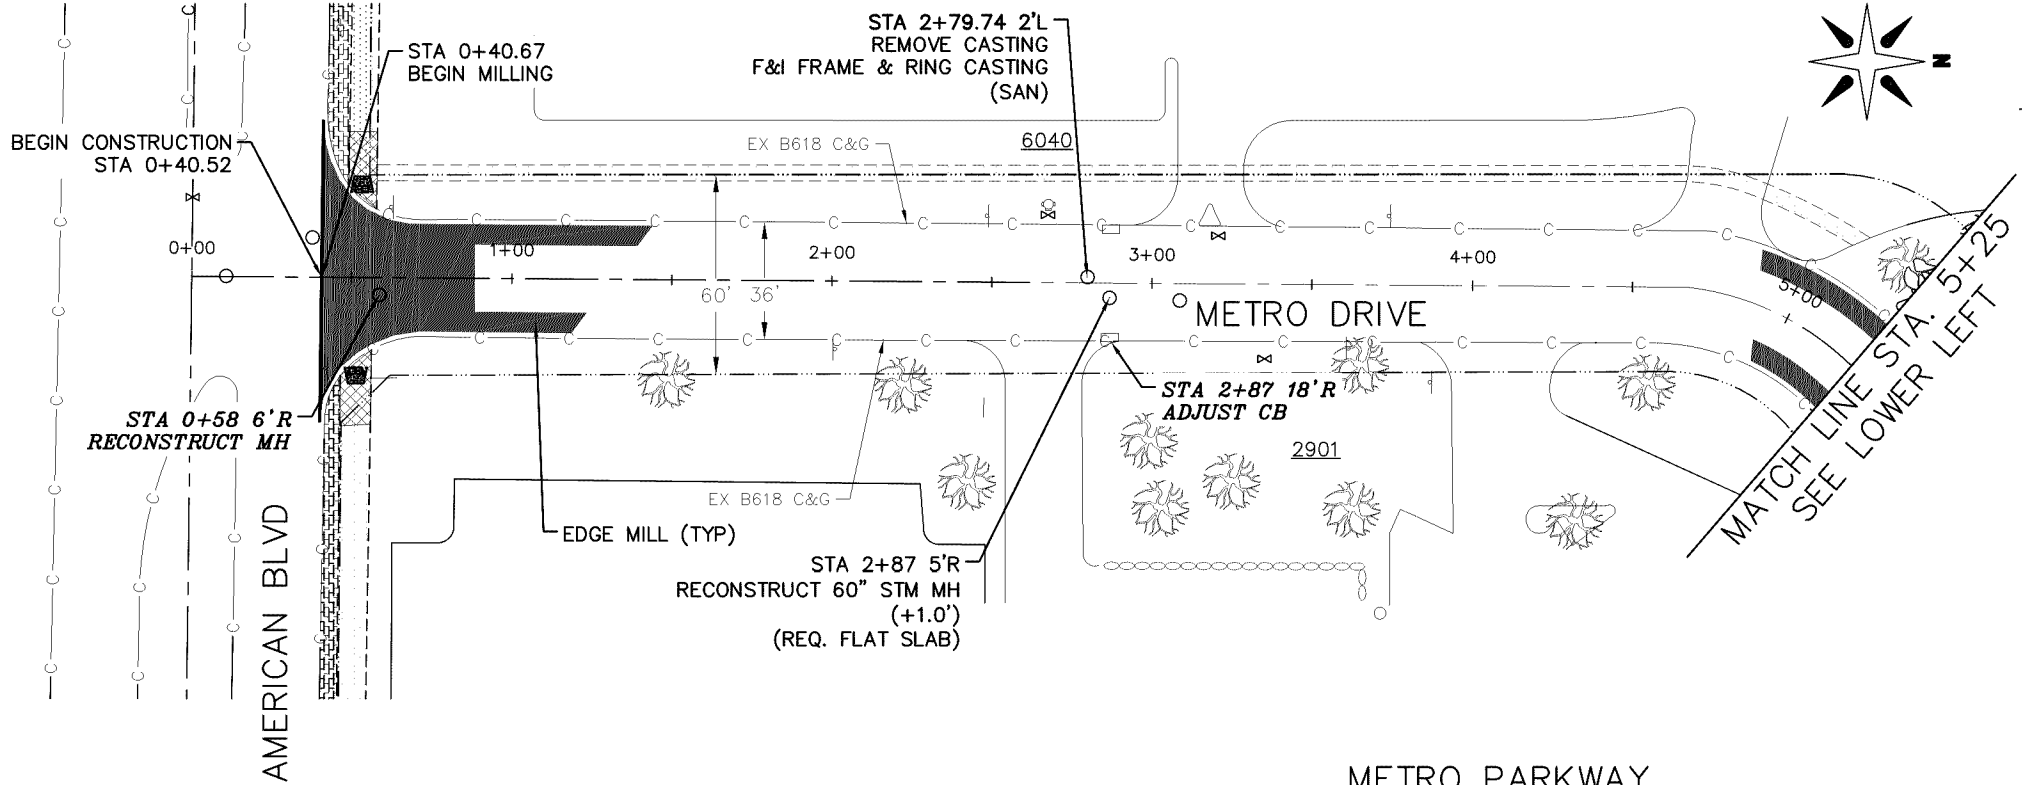

SCHEDULE 2
NON-PARTICIPATING