






CASE #PL2020-79

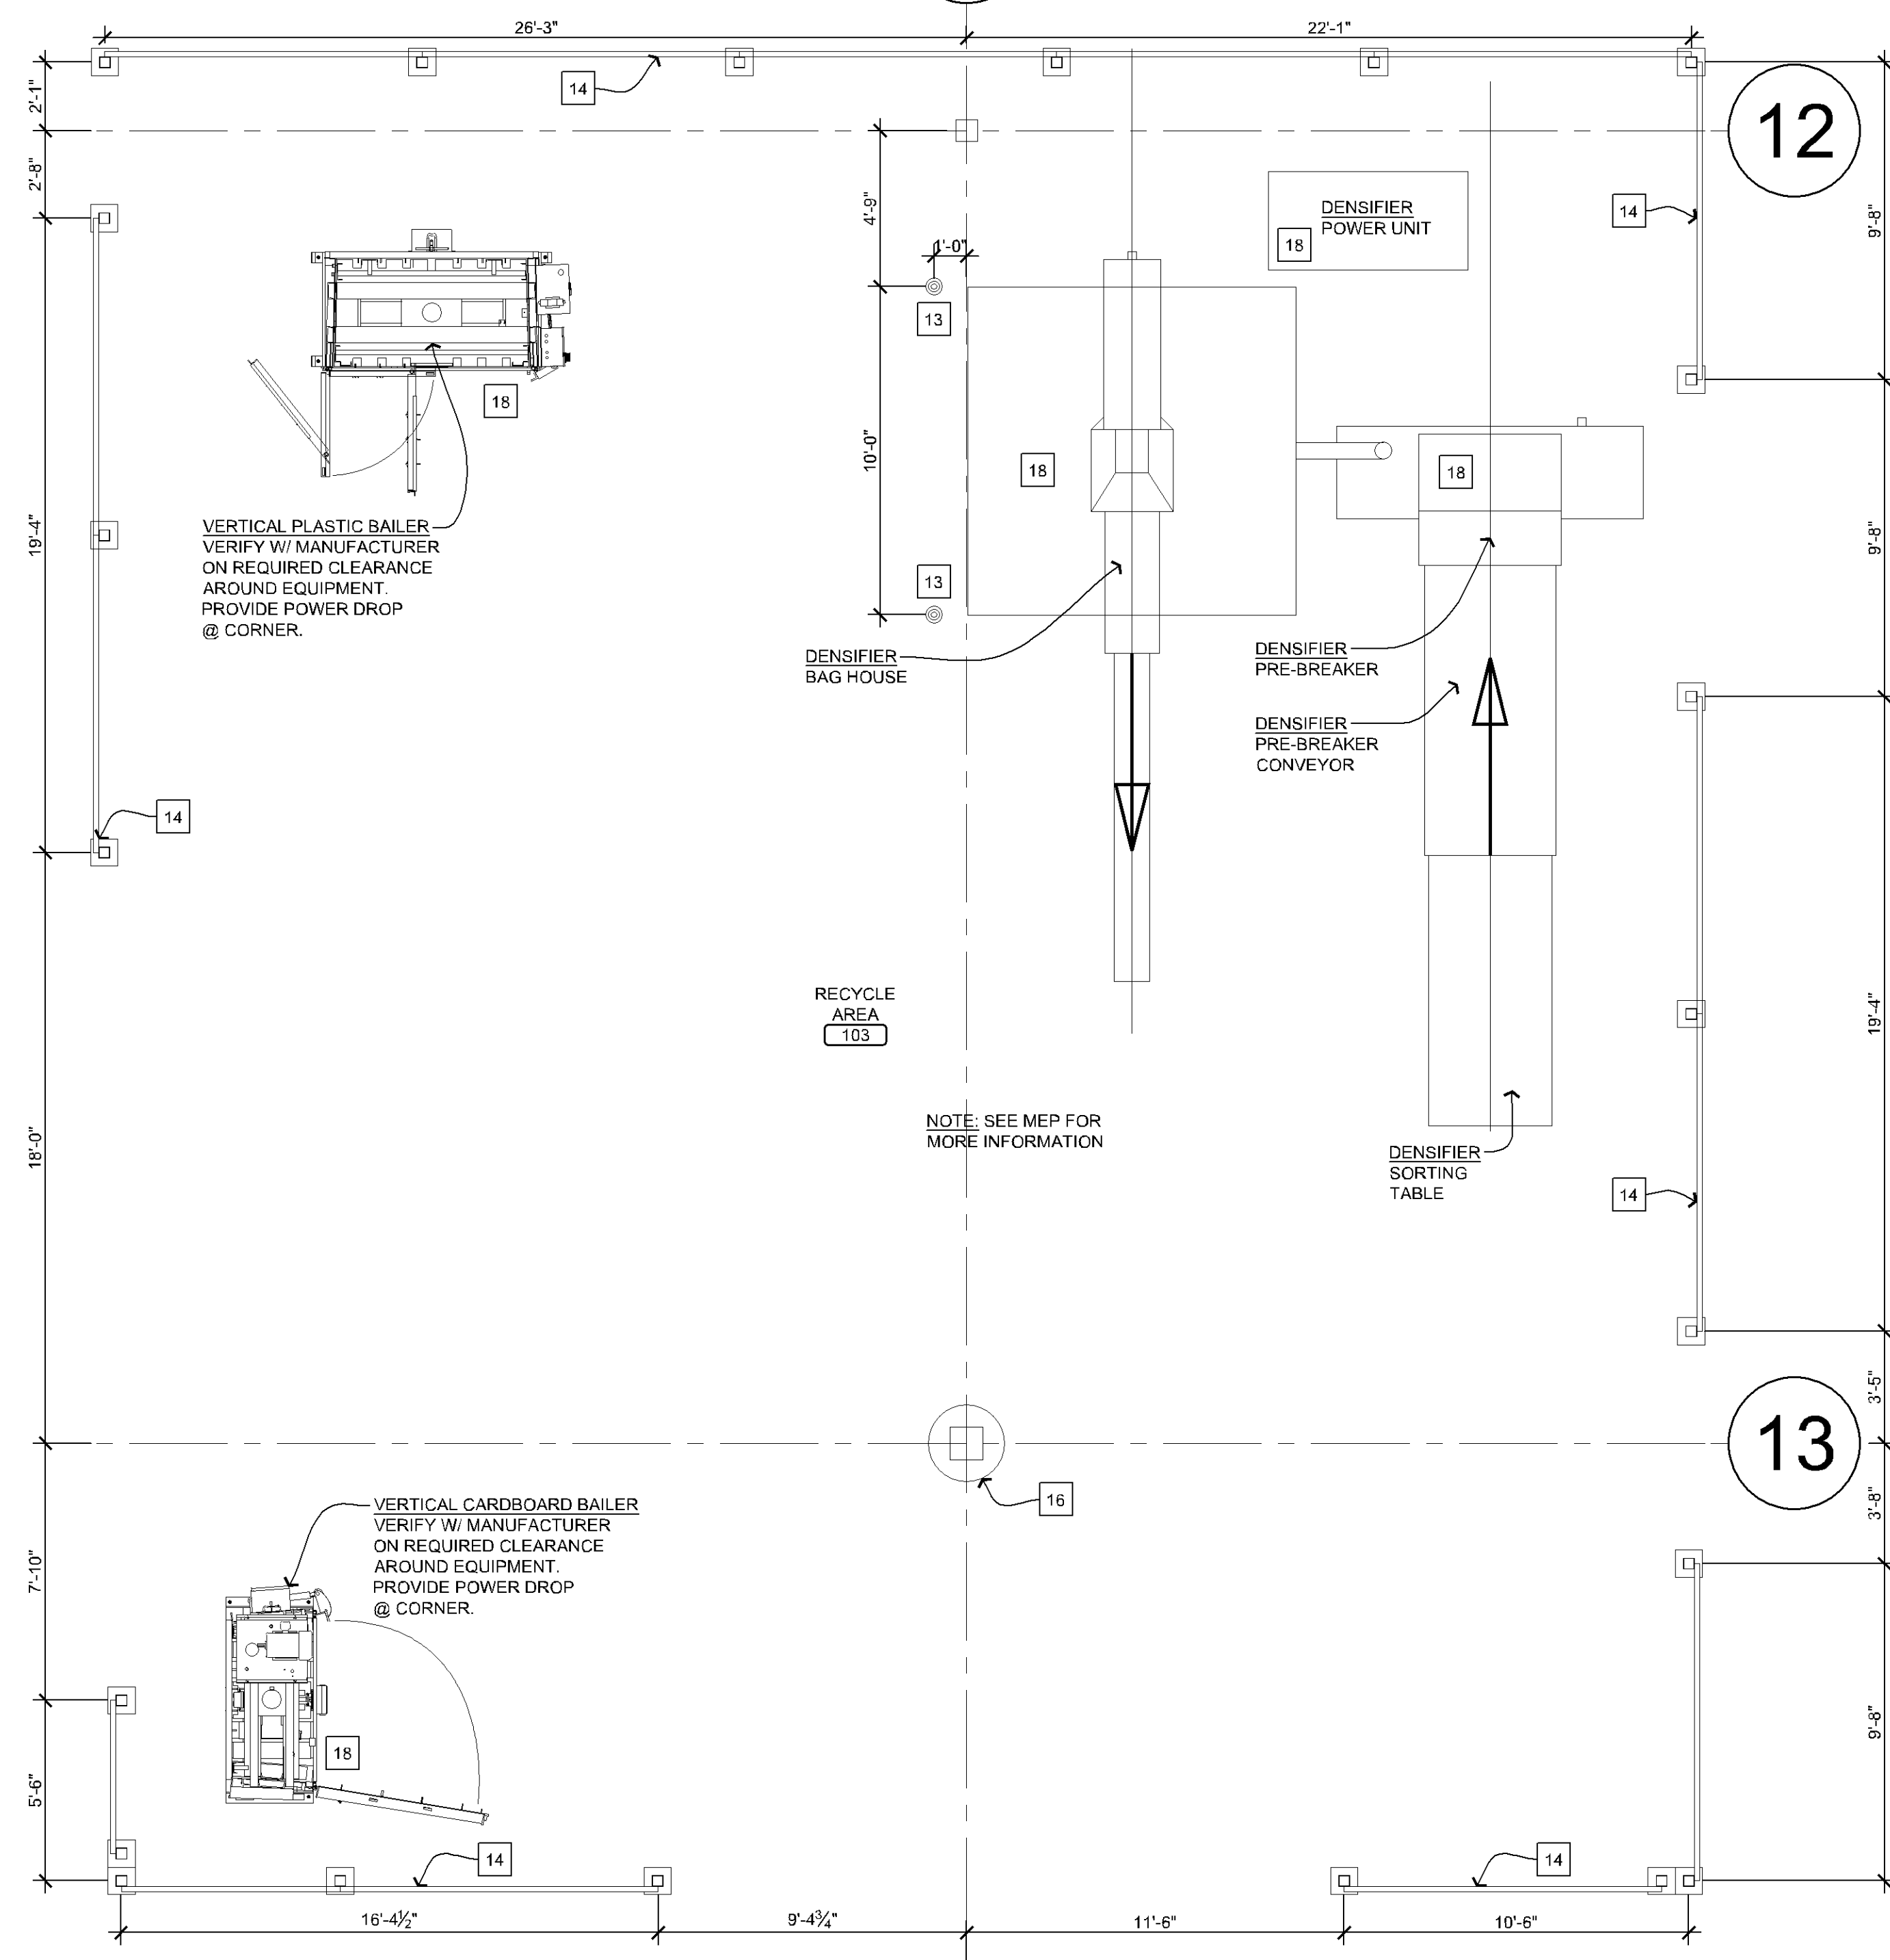


1 ENLARGED NEW FLOOR PLAN
SCALE: 1/4" = 1'-0"

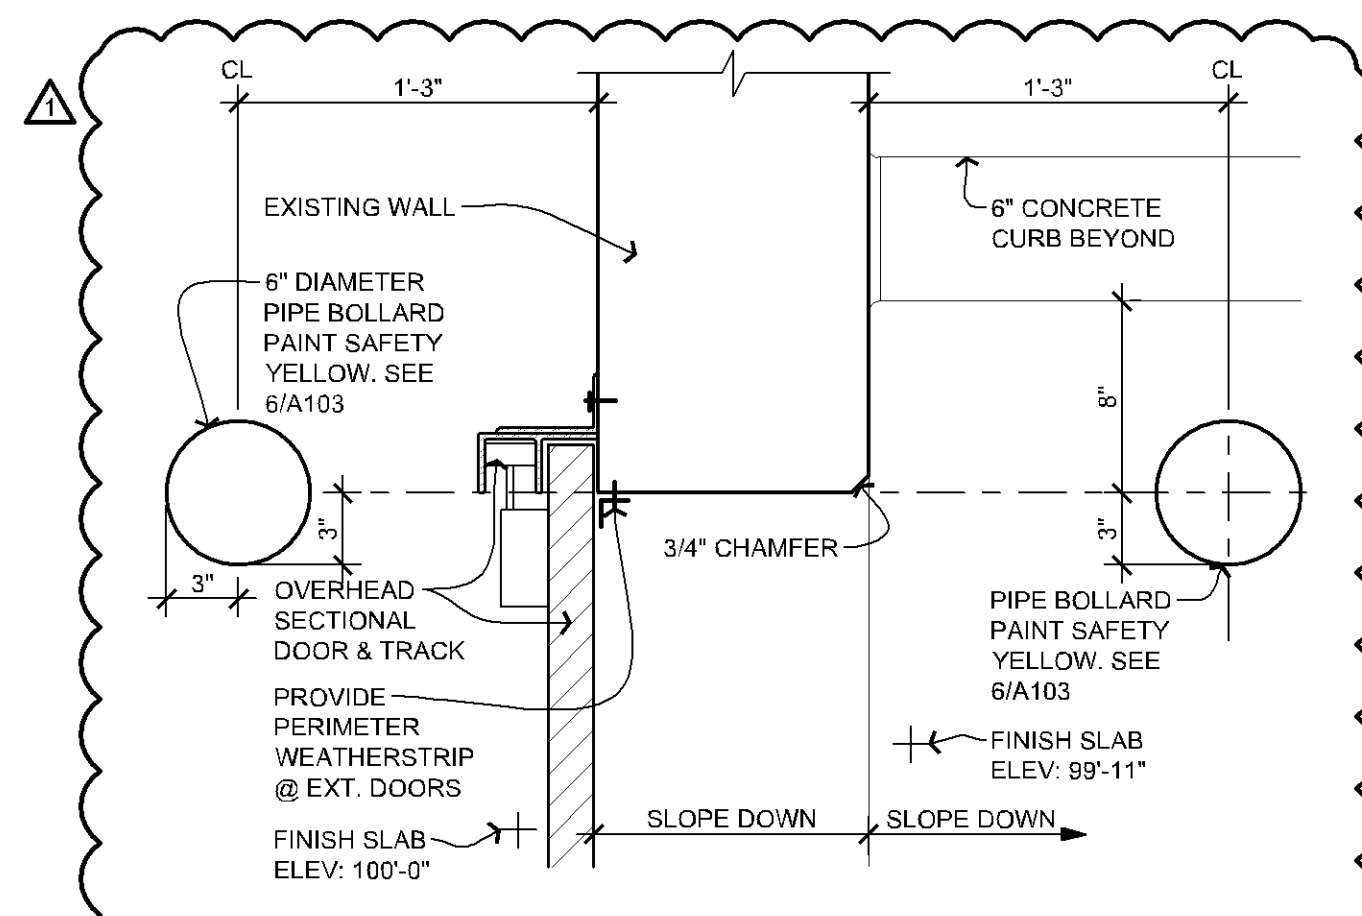


4 ENLARGED RECYCLING AREA
SCALE: 1/4" = 1'-0"

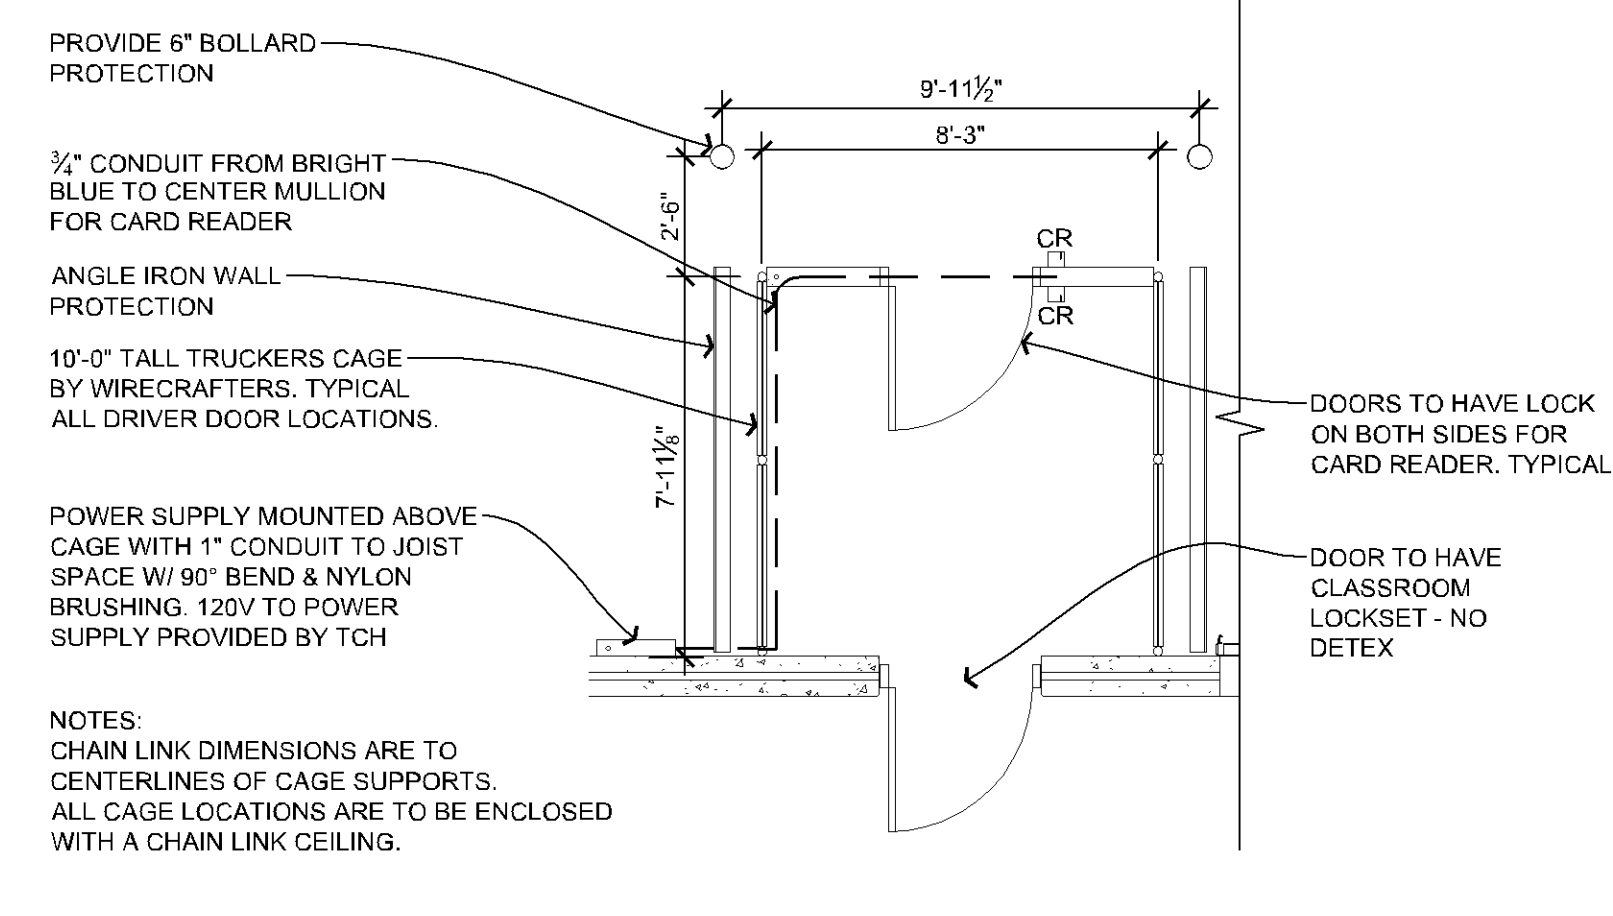


5 TRUCKER'S CAGE DOORS
SCALE: 1/4" = 1'-0"

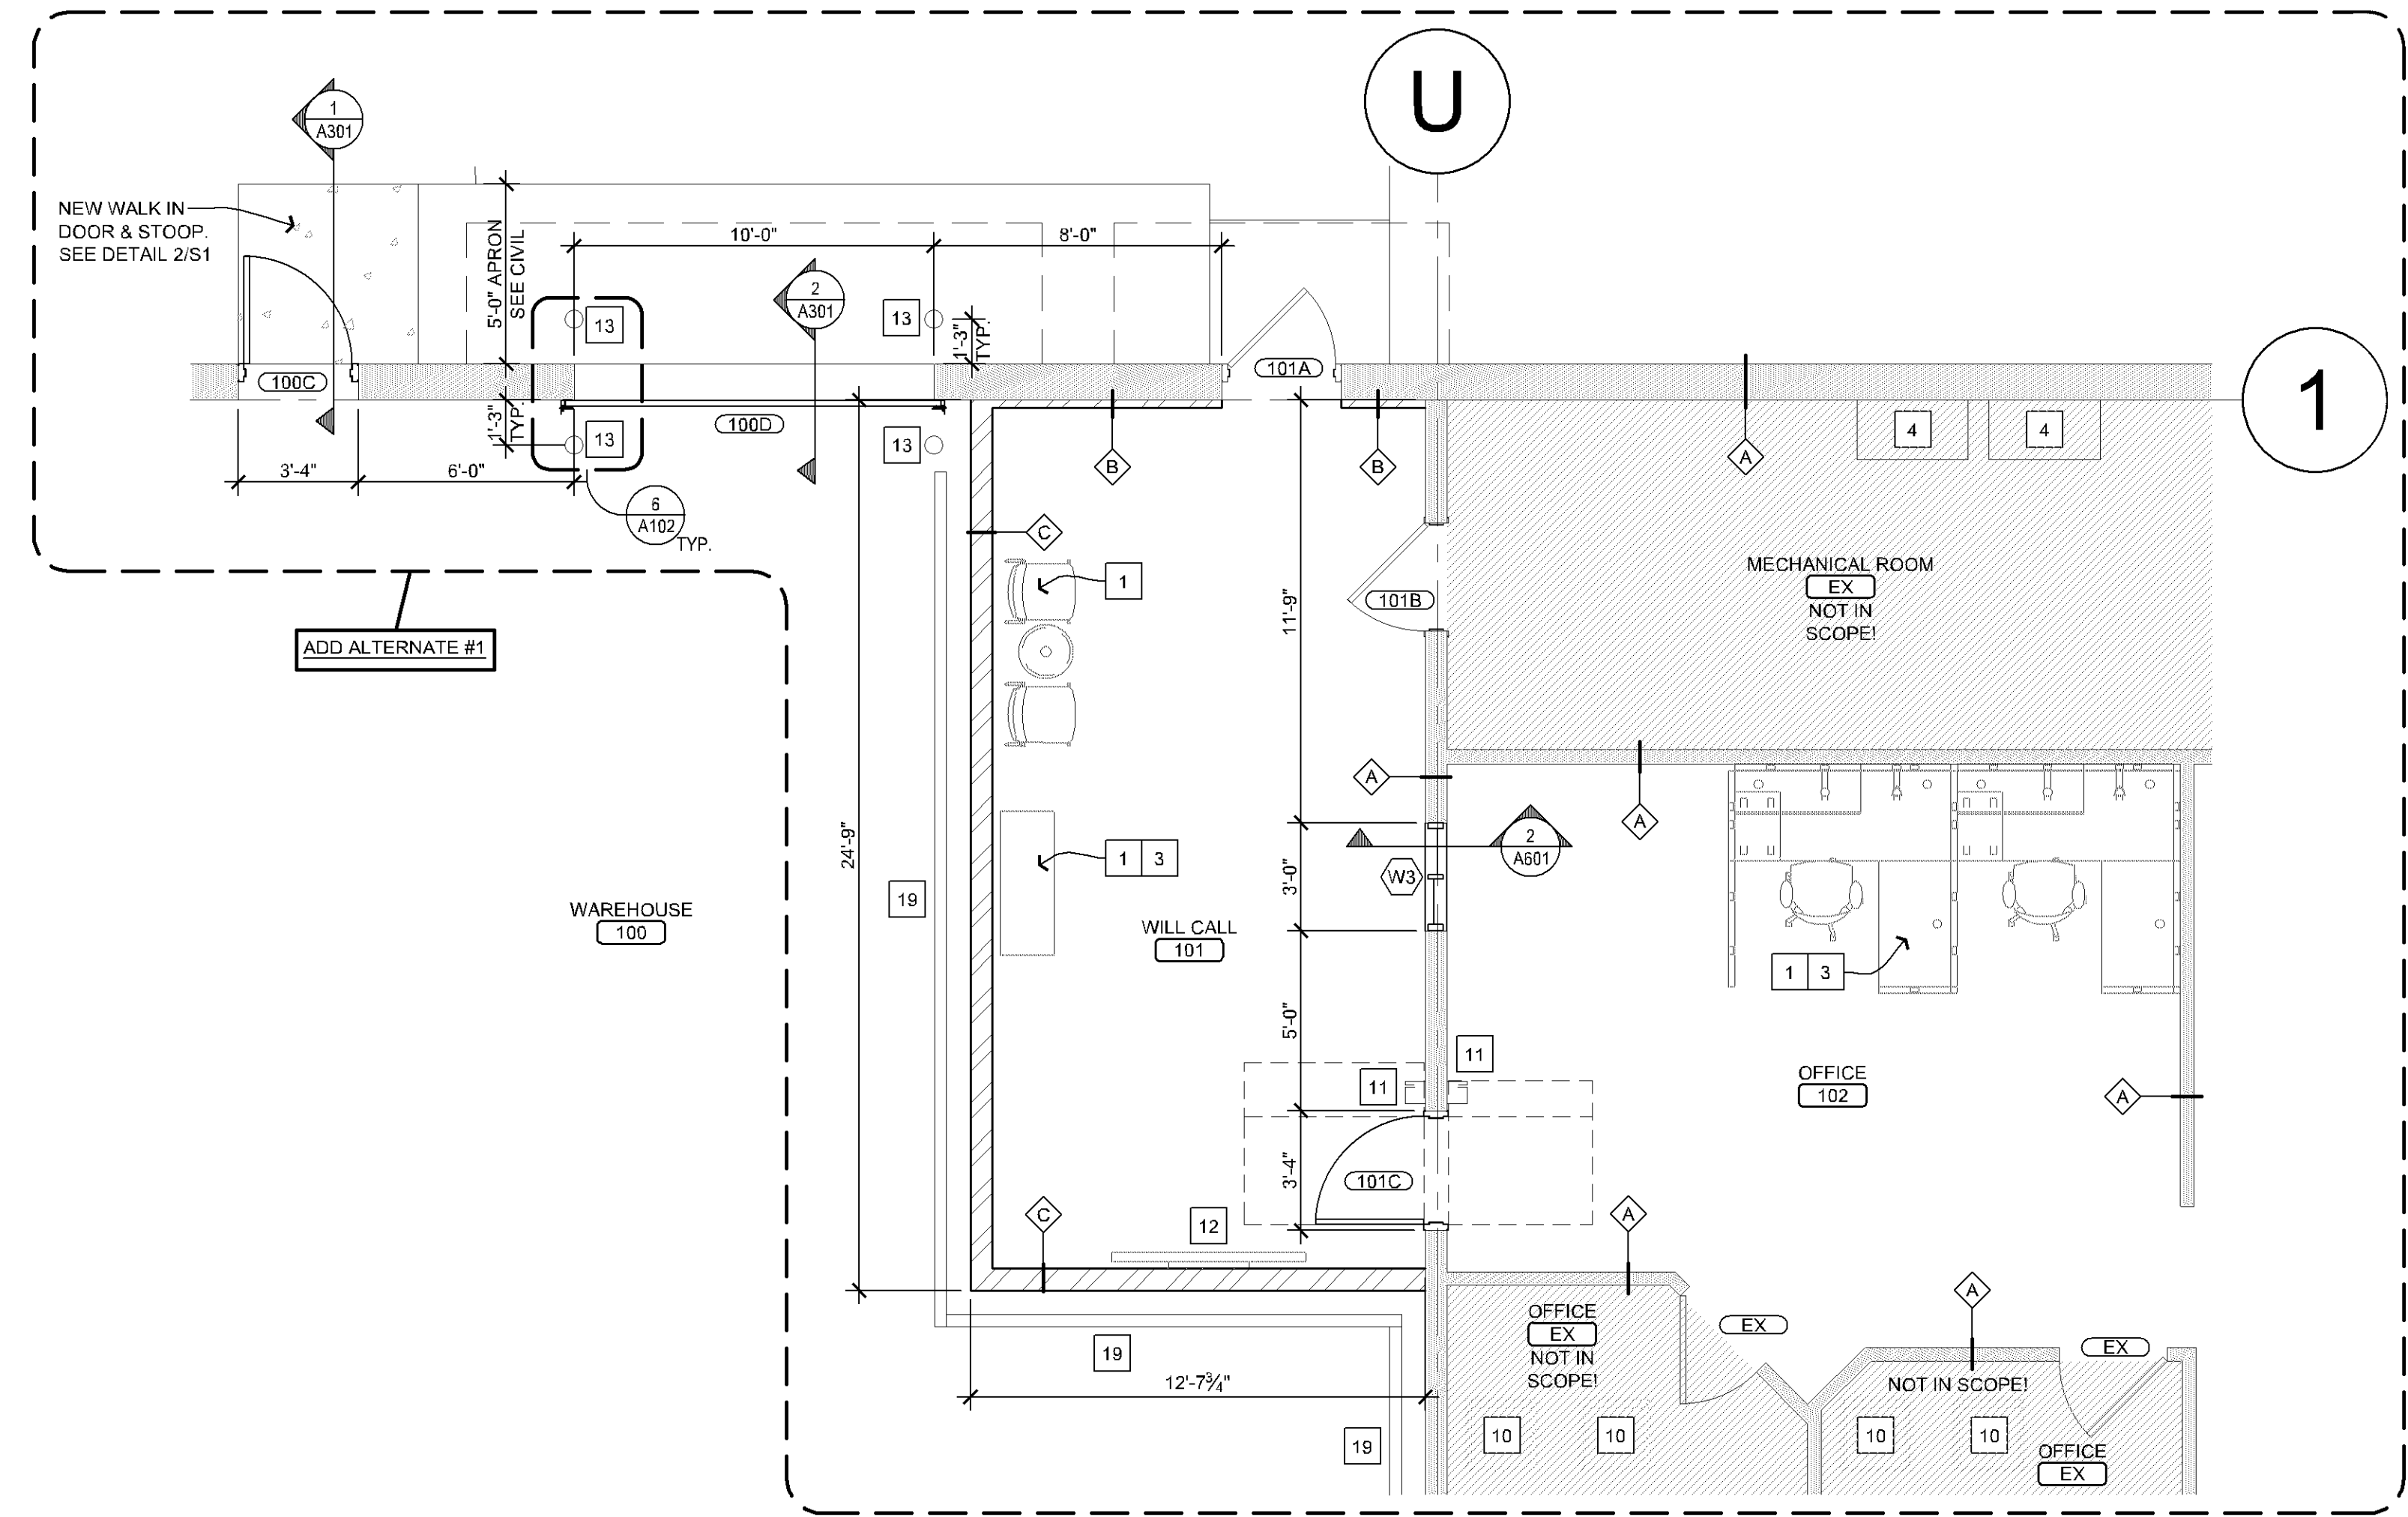

2 ENLARGED NEW FLOOR PLAN
SCALE: 1/4" = 1'-0"

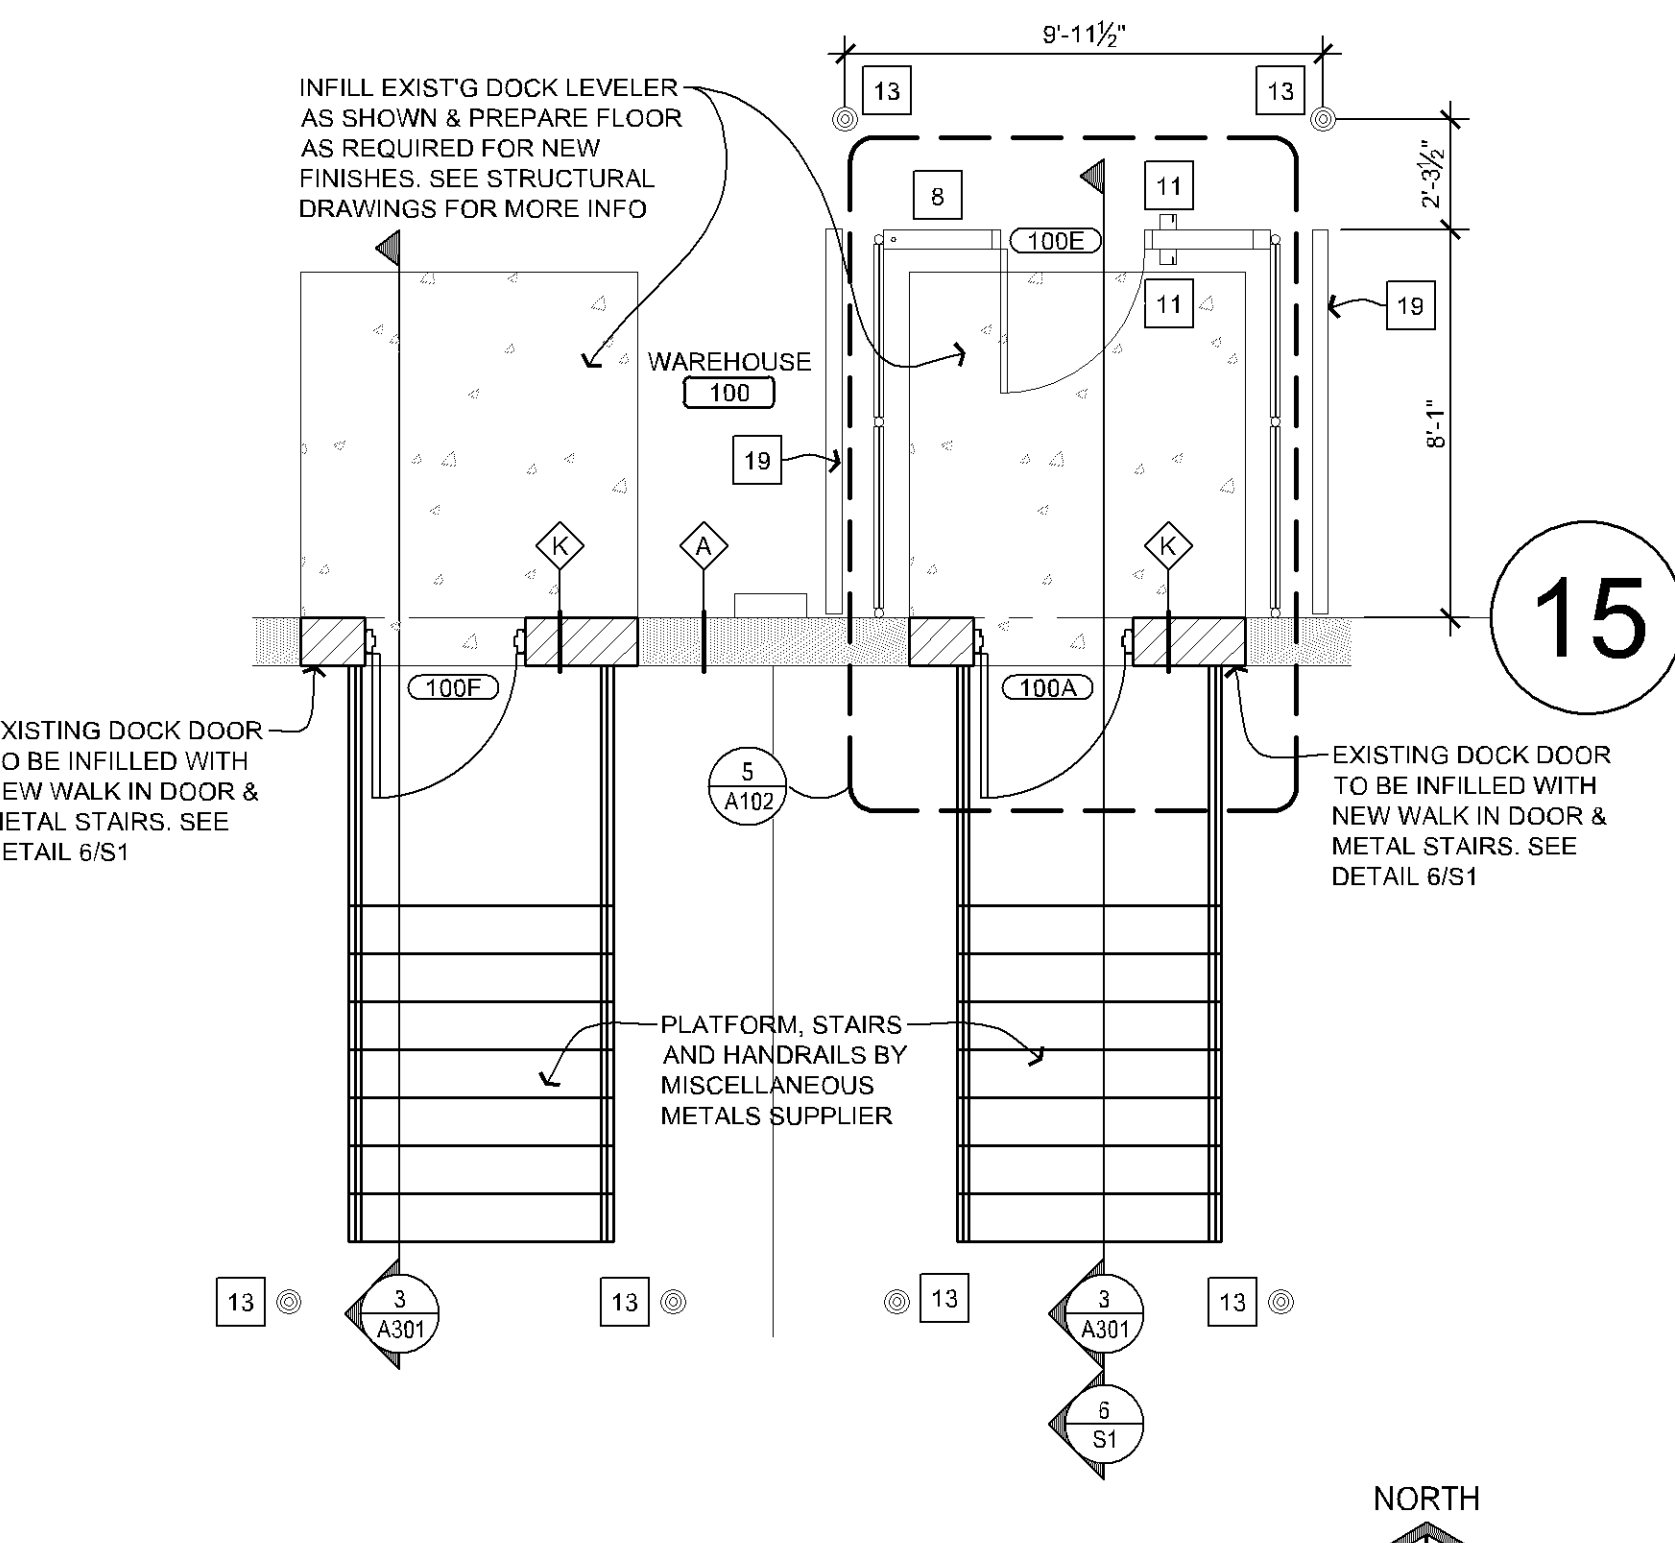

3 ENLARGED NEW FLOOR PLAN
SCALE: 1/4" = 1'-0"







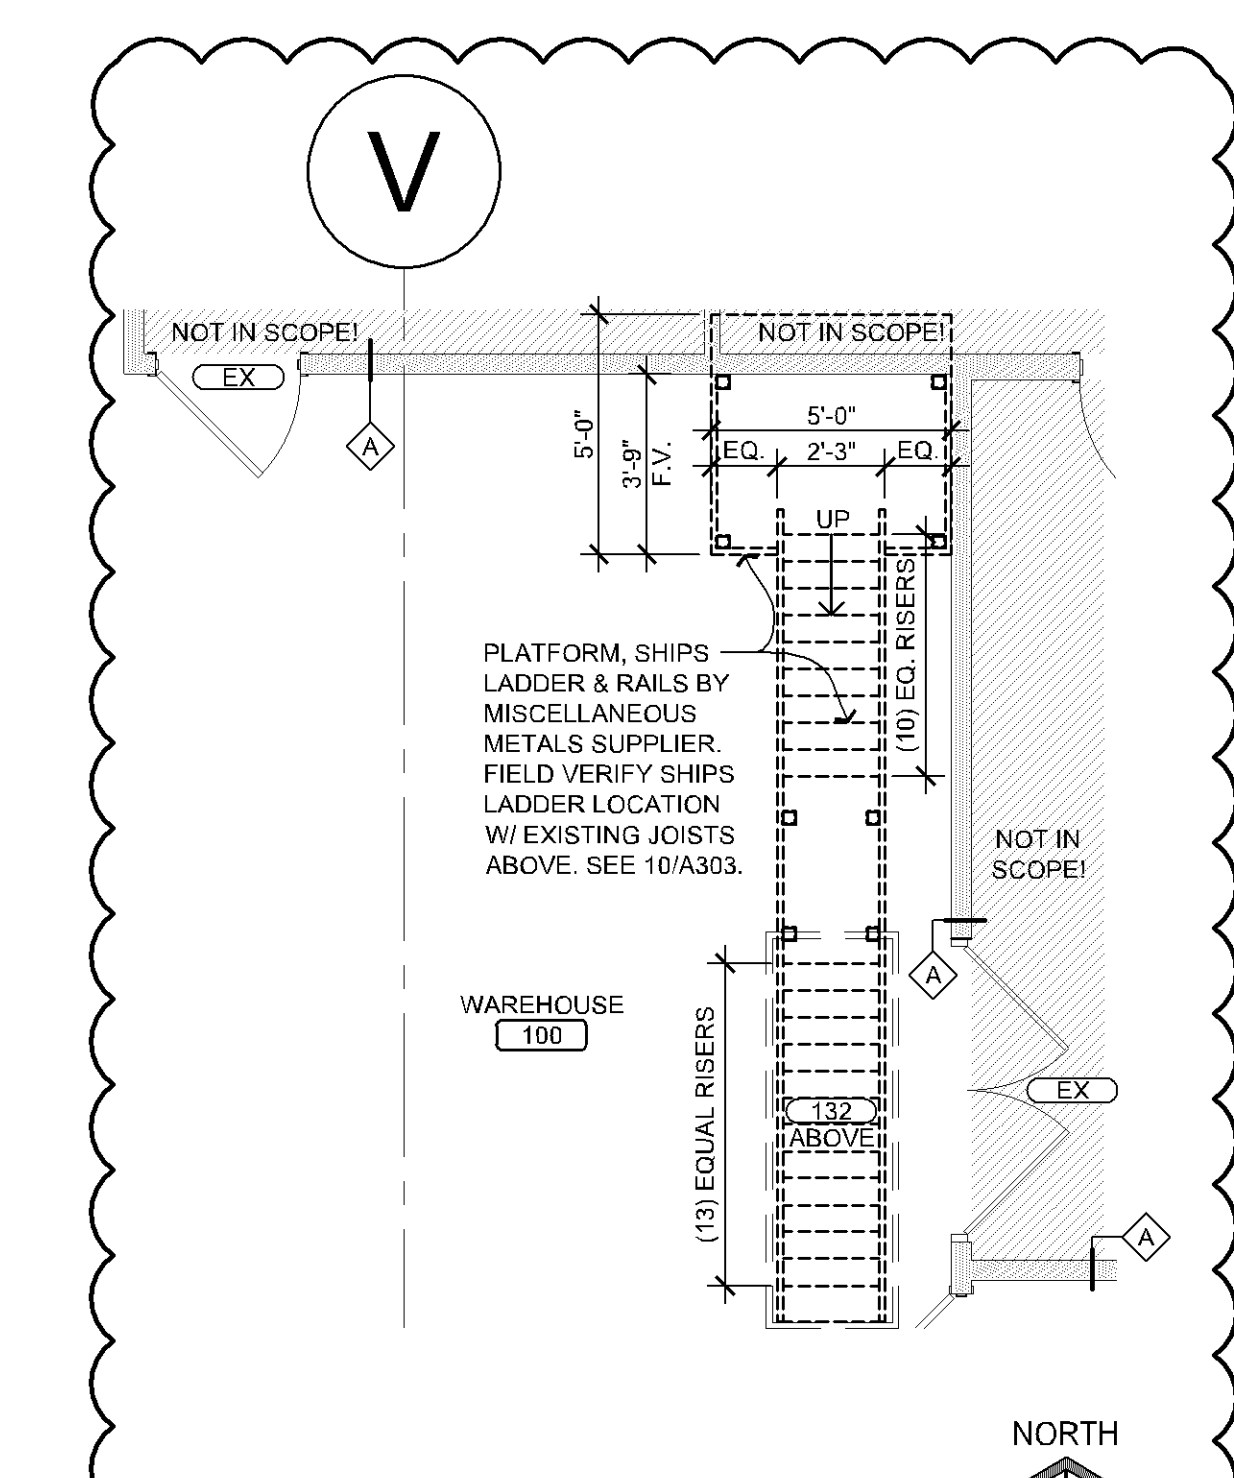



4 ENLARGED NEW FLOOR PLAN
SCALE: 1/4" = 1'-0"

WALL LEGEND	
	EXISTING WALL
	EXISTING CONDITIONS BY OTHERS TO REMAIN
	NEW FULL HEIGHT METAL STUD WALL
	NEW CMU WALL

- GENERAL NOTES**
- DO NOT SCALE THIS DRAWING IF THERE ARE ANY DISCREPANCIES CONTACT THE ARCHITECT PRIOR TO COMMENCING WORK.
 - G.C. TO VERIFY ALL DIMENSIONS AND NOTIFY ARCHITECT OF ANY DISCREPANCIES PRIOR TO CONSTRUCTION.
 - IF EXISTING EXTERIOR THRESHOLD EXCEEDS ADA MAXIMUM HEIGHT OF 1/2" REMOVE AND REPLACE WITH ACCESSIBLE THRESHOLD. RAISED THRESHOLDS AND FLOOR LEVEL CHANGES AT ACCESSIBLE DOORWAYS TO BE BEVELED WITH A SLOPE NO GREATER THAN 1:12 LOCATION WITH TENANT.
 - G.C. TO PROVIDE ALL WALL BLOCKING AND BACKING. VERIFY LOCATION WITH TENANT.
 - G.C. TO PROVIDE AND INSTALL NON COMBUSTIBLE WOOD BACKING WHEN REQUIRED BY CODE.
 - PAINTING OF ALL WALL SURFACES TO BE COMPLETED PRIOR TO THE INSTALLATION OF ANY WALL TRIM OR PANELING.
 - REMOVAL OF EXCESS GROUT WILL BE DONE WITH WATER. THE USE OF SULFURIC OR MURIATIC ACID IS PROHIBITED. IF THESE ACIDS ARE USED, THE INSTALLER WILL BE REQUIRED TO REMOVE THE ACID AND RESTORE THE GROUT AT THEIR EXPENSE (IF APPLICABLE).
 - G.C. SHALL DOCUMENT AS-BUILT INSTALLATION CONDITIONS & PROVIDE OWNER WITH AS-BUILT DRAWINGS AT PROJECT COMPLETION.
 - ALL GYPSUM BOARD TO BE PREPARED TO LEVEL 4 FINISH STANDARDS PER GYPSUM ASSOCIATION STANDARDS.
 - ALL FIXTURES/FURNITURE IS TENANT SUPPLIED AND INSTALLED. UNO
 - USE CEMENT BOARD AT ALL WALL TILE LOCATIONS.
 - ALL TILE TO BE INSTALLED PER TILE COUNCIL OF AMERICA STANDARDS.
 - FLOOR SLAB IS TO BE PINNED AND TRENCHING COMPACTED PRIOR TO POURING BACK AFTER UNDERGROUND PLUMBING.

  - KEY NOTES**
- NEW FURNITURE
 - NEW COUNTER/MILLWORK
 - NEW EQUIPMENT
 - EXISTING ELECTRICAL EQUIPMENT TO REMAIN
 - EXISTING GUARDRAIL TO REMAIN
 - EXISTING EQUIPMENT TO REMAIN
 - SOFT BARRIER/CURTAIN
 - NEW TRUCKERS CAGE BY WIRECRAFTERS. SEE 5A102.
 - NEW CLOSET SHELF
 - EXISTING GUARDRAIL TO REMAIN
 - NEW CARD READER
 - NEW TV W/ WOOD BLOCKING.
 - COORDINATE W/ ELECTRICAL
 - NEW 8" PIPE BOLLARD, PAINT SAFETY YELLOW. SEE 6A103.
 - NEW GUARDRAIL OR REPURPOSE EXISTING GUARDRAIL
 - NEW DRINKING FOUNTAIN W/ BOTTLE FILLER
 - NEW 4" HIGH CONCRETE COLUMN PROTECTION
 - NEW HOLLMAN CCI LAMINATE LOCKERS, (4) UNITS W/ KEYPAD ACCESS
 - EXISTING EQUIPMENT RELOCATED
 - NEW ANGLE IRON WALL PROTECTION. SEE 4A/103.
 - NEW CONCRETE SLAB INFILL. SEE PLUMBING DRAWINGS & DETAIL S154 FOR MORE INFORMATION.
 - PATCH & REPAIR EXISTING SLAB INFILL AS REQUIRED FOR NEW FINISHES.
 - COORDINATE EXACT LOCATIONS WITH BEST BUY CONSTRUCTION MANAGER.
 - BRAKE METAL AT COLUMN TO MATCH ADJACENT WINDOW RAIL FINISH. VERIFY FINISH TO MATCH GR. BLACK ANDODDED
 - APS RESOURCE POLY COLUMN PROTECTOR
 - STEEL BENT PLATE COLUMN PROTECTION BY MISCELLANEOUS METALS SUPPLIER. COORDINATE SIZING DETAILS W/ BEST BUY CONST. MANAGER.
 - WALLS TO HAVE THE TOP & BOTTOM TRACKS. PENETRATIONS SEALED W/ ACACUSTICAL SEALANT. JUNCTION BOXES SHOULD BE STAGGERED & SEALED.
 - HIGHLIGHTED WALLS SHOULD HAVE ACACUSTICAL SEALANT AT BOTTOM
 - TRACK AND RAIL EXTENSION. SEE 6A/103 BY SENTRY OR EQUAL. VERIFY FINAL LOCATIONS MAINTAIN 75" MAXIMUM SPACING.
 - 3"x3"x3/8" STEEL ANGLE ANCHORED TO FLOOR 12" O.C. PAINT BLACK. SEE DETAIL 7A103.

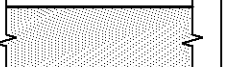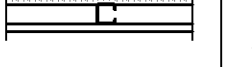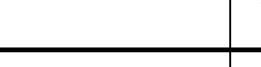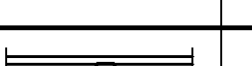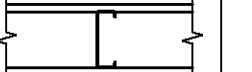WALL TYPES					
		EXISTING WALL - PATCH AND REPAIR AS REQUIRED AND PREP FOR NEW FINISHES.			3-5/8" METAL STUDS @ 16" O.C. TO 12'-0" AFF. PROVIDE SOUND BATT INSULATION. BOTH SIDES: 5/8" GYP. BD. FROM FLOOR TO 12'-0" AFF. COMM ROOM SIDE: F.R.T. PLYWOOD, WALLS SEALED ONLY
		EXISTING EXT. WALL W/ 1-5/8" METAL STUDS @ 16" O.C. OFFICE SIDE: RIGID INSUL. 4 MIL. POLY VAPOR BARRIER, 5/8" GYP. BD. FROM FLOOR TO 6" ABOVE FINISH CEILING.			3-5/8" METAL STUDS @ 16" O.C. TO 12'-0" AFF. PROVIDE SOUND BATT INSULATION. OFFICE SIDE: 5/8" GYP. BD. FROM FLOOR TO 12'-0" AFF. RESTROOM SIDE: 5/8" EXT. DENSGLASS BD. FROM FLOOR TO 6'-2" AFF & 5/8" GYP. BD. FROM 6'-2" AFF TO 6" ABOVE FINISH CEILING
		6" 14 GA. METAL STUDS @ 12" O.C. OFFICE SIDE: 5/8" GYP. BD. FROM FLOOR TO 6" ABOVE FINISH CEILING. WAREHOUSE SIDE: 5/8" GYP. BD. FROM FLOOR TO DECK.			6" 14 GA. METAL STUDS @ 12" O.C. PROVIDE SOUND BATT INSULATION. BOTH SIDES: 5/8" GYP. BD. FROM FLOOR TO DECK. RESTROOM SIDE: 5/8" EXT. DENSGLASS BD. FROM FLOOR TO 6'-2" AFF & 5/8" GYP. BD. FROM 6'-2" AFF TO DECK.
		3-5/8" METAL STUDS @ 16" O.C. TO 12'-0" AFF. BOTH SIDES: 5/8" GYP. BD. FROM FLOOR TO 12'-0" AFF. COMM ROOM SIDE: F.R.T. PLYWOOD, WALLS SEALED ONLY			3-5/8" METAL STUDS @ 16" O.C. TO 12'-0" AFF. PROVIDE SOUND BATT INSULATION. BOTH SIDES: 5/8" EXT. DENSGLASS BD. FROM FLOOR TO 6'-2" AFF & 5/8" GYP. BD. FROM 6'-2" AFF TO 6" ABOVE FINISH CEILING
		6" 14 GA. METAL STUDS @ 12" O.C. BOTH SIDES: 5/8" GYP. BD. FROM FLOOR TO DECK.			6" 14 GA. METAL STUDS @ 12" O.C. PROVIDE SOUND BATT INSULATION. BOTH SIDES: 5/8" GYP. BD. FROM FLOOR TO DECK.
		12" CMU - CORE FILLED W/ INSUL. FROM FLOOR TO TOP OF OPENING.			12" CMU - CORE FILLED W/ INSUL. FROM FLOOR TO TOP OF OPENING.
		6" 14 GA. METAL STUDS @ 12" O.C. BOTH SIDES: 5/8" GYP. BD. FROM FLOOR TO DECK.			6" 14 GA. METAL STUDS @ 12" O.C. PROVIDE SOUND BATT INSULATION. BOTH SIDES: 5/8" GYP. BD. FROM FLOOR TO DECK.
		6" 14 GA. METAL STUDS @ 12" O.C. BOTH SIDES: 5/8" GYP. BD. FROM FLOOR TO DECK.			6" 14 GA. METAL STUDS @ 12" O.C. PROVIDE SOUND BATT INSULATION. BOTH SIDES: 5/8" GYP. BD. FROM FLOOR TO DECK.
		6" 14 GA. METAL STUDS @ 12" O.C. BOTH SIDES: 5/8" GYP. BD. FROM FLOOR TO DECK.			6" 14 GA. METAL STUDS @ 12" O.C. PROVIDE SOUND BATT INSULATION. BOTH SIDES: 5/

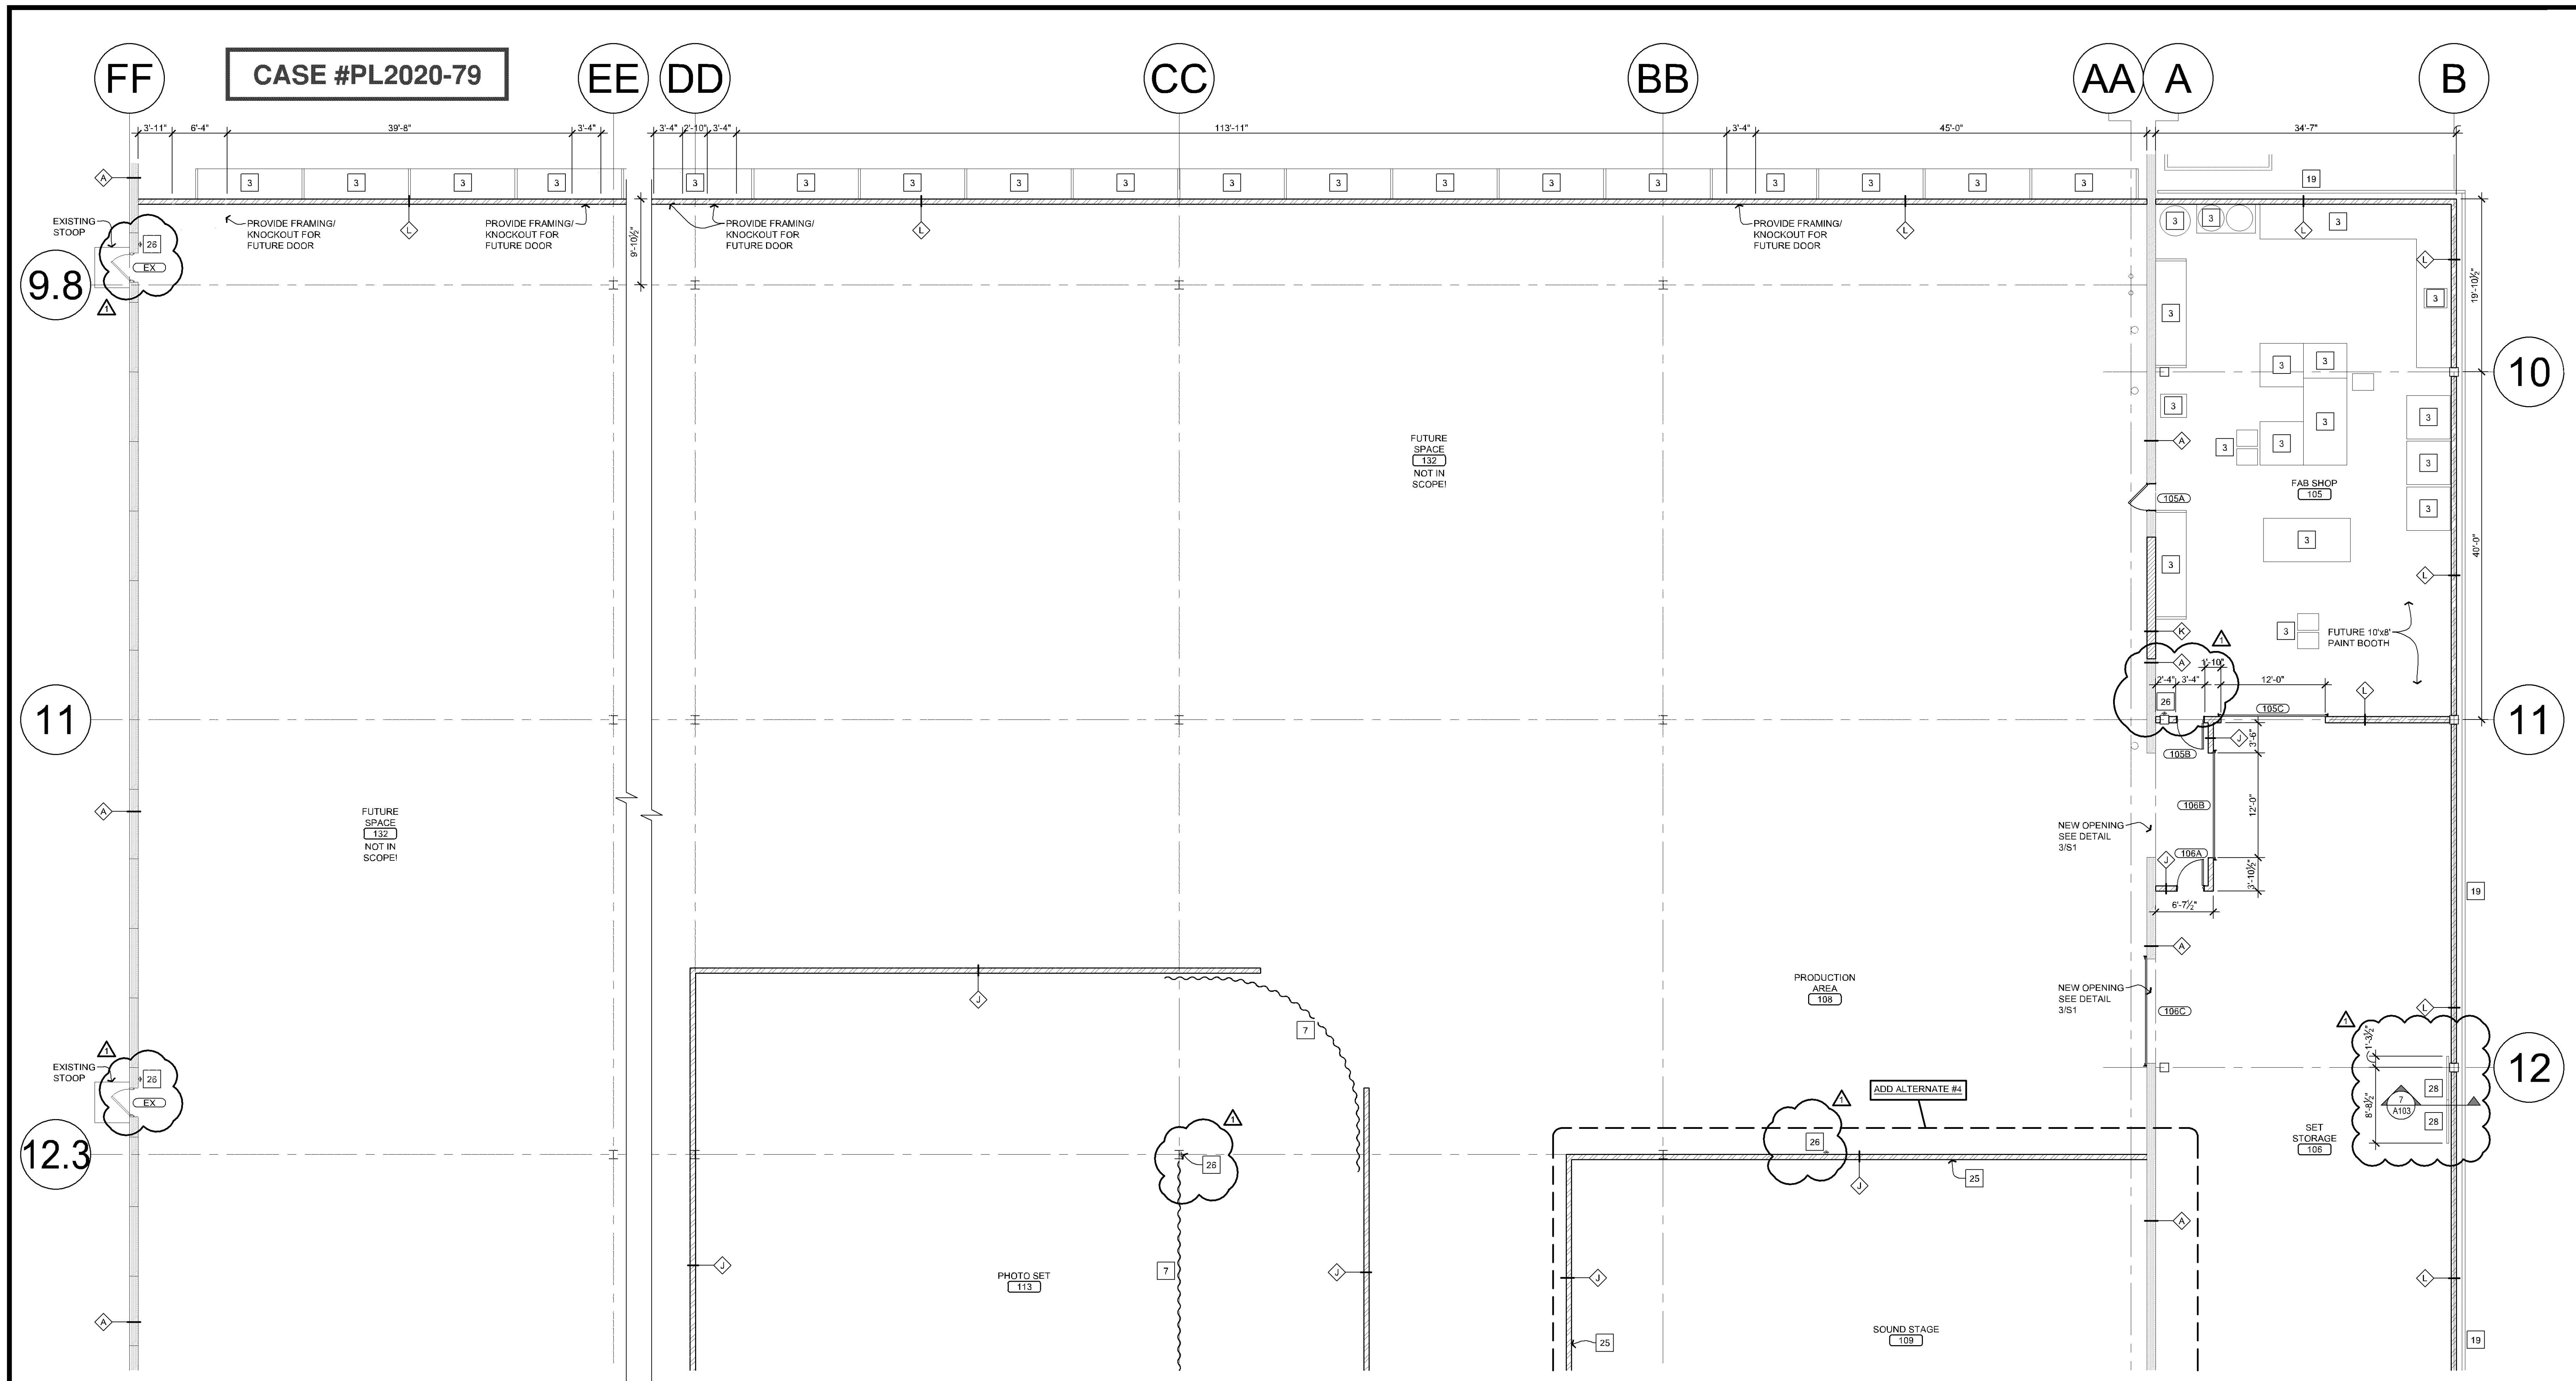

1 ENLARGED NEW FLOOR PLAN
SCALE: 1/8" = 1'-0"

APPROVED
Zoning Review Only
08/06/2020 NMJ

GENERAL NOTES

- DO NOT SCALE THIS DRAWING IF THERE ARE ANY DISCREPANCIES CONTACT THE ARCHITECT PRIOR TO COMMENCING WORK.
- G.C. TO VERIFY ALL DIMENSIONS AND NOTIFY ARCHITECT OF ANY DISCREPANCIES PRIOR TO CONSTRUCTION.
- IF EXISTING EXTERIOR THRESHOLD EXCEEDS ADA MAXIMUM HEIGHT OF 1/2" REMOVE AND REPLACE WITH ACCESSIBLE THRESHOLD. RAISED THRESHOLDS AND FLOOR LEVEL CHANGES AT ACCESSIBLE DOORWAYS TO BE BEVELED WITH A SLOPE NO GREATER THAN 1:12.
- G.C. TO PROVIDE ALL WALL BLOCKING AND BACKING. VERIFY LOCATION WITH TENANT.
- G.C. TO PROVIDE AND INSTALL NON COMBUSTIBLE WOOD BACKING WHEN REQUIRED BY CODE.
- PAINTING OF ALL WALL SURFACES TO BE COMPLETED PRIOR TO THE INSTALLATION OF ANY WALL TRIM OR PANELING.
- REMOVAL OF EXCESS GROUT WILL BE DONE WITH WATER. THE USE OF SULFURIC OR MURIATIC ACID IS PROHIBITED. IF THESE ACIDS ARE USED, THE INSTALLER WILL BE REQUIRED TO REMOVE THE ACID AND RESTORE THE GROUT AT THEIR EXPENSE (IF APPLICABLE).
- G.C. SHALL DOCUMENT AS-BUILT INSTALLATION/CONDITIONS & PROVIDE OWNER WITH AS-BUILT DRAWINGS AT PROJECT COMPLETION.
- ALL GYPSUM BOARD TO BE PREPARED TO LEVEL 4 FINISH STANDARDS PER GYPSUM ASSOCIATION STANDARDS.
- ALL FIXTURES/FURNITURE IS TENANT SUPPLIED AND INSTALLED. UNO
- USE CEMENT BOARD AT ALL WALL TILE LOCATIONS.
- ALL TILE TO BE INSTALLED PER TILE COUNCIL OF AMERICA STANDARDS.
- FLOOR SLAB IS TO BE PINNED AND TRENCHING COMPACTED PRIOR TO POURING BACK AFTER UNDERGROUND PLUMBING.

WALL LEGEND

- EXISTING WALL/ EXISTING CONDITIONS BY OTHERS TO REMAIN
- NEW FULL HEIGHT METAL STUD WALL
- NEW CMU WALL

KEY NOTES

- NEW FURNITURE
- NEW COUNTERMILLWORK
- NEW EQUIPMENT
- EXISTING ELECTRICAL EQUIPMENT TO REMAIN
- EXISTING GUARDRAIL TO REMAIN
- EXISTING EQUIPMENT TO REMAIN
- SOFT BARRIER/CURTAIN
- NEW TRUCKERS CAGE BY WIRECRAFTERS. SEE S/A102.
- NEW CLOSET SHELF
- EXISTING FURNITURE TO REMAIN
- NEW CARD READER
- NEW TV W/ WOOD BLOCKING. COORDINATE W/ ELECTRICAL
- NEW 6" PIPE BOLLARD, PAINT AS KEY YELLOW. SEE S/A103.
- NEW GUARDRAIL OR REPURPOSE EXISTING GUARDRAIL
- NEW DRINKING FOUNTAIN W/ BOTTLE FILLER
- NEW 4" HIGH CONCRETE COLUMN PROTECTION WALL. SEE DETAIL S/A103.
- NEW HOLLMAN CCI LAMINATE LOCKERS, (4) UNITS W/ KEYPAD ACCESS
- EXISTING EQUIPMENT RELOCATED
- NEW ANGLE IRON WALL PROTECTION. SEE 4/A103.
- NEW CONCRETE SLAB INFILL. SEE PLUMBING DRAWINGS & DETAIL S/A104 FOR MORE INFORMATION.
- PATCH & REPAIR EXISTING SLAB INFILL AS REQUIRED FOR NEW FINISHES.
- COORDINATE EXACT LOCATIONS WITH BEST BUY CONSTRUCTION MANAGER.
- BRAKE METAL AT COLUMN TO MATCH ADJACENT WINDOW RAIL FINISH. VERIFY FINISH TO MATCH GR. BLACK ANODIZED
- APS RESOURCE POLY COLUMN PROTECTOR
- STEEL BENT PLATE COLUMN PROTECTION BY MISCELLANEOUS METALS SUPPLIER. COORDINATE SIZING DETAILS W/ BEST BUY CONST. MANAGER.
- WALLS TO HAVE THE TOP & BOTTOM TRACKS. PENETRATIONS SEALED W/ ACoustICAL SEALANT. JUNCTION BOXES SHOULD BE STAGGERED & SEALED.
- HIGHLIGHTED WALLS SHOULD HAVE ACOUSTICAL SEALANT AT BOTTOM TRACK AND WINDOW GLASS SEALS.
- NEW FIRE EXTINGUISHER (A106) BY SENTRY OR EQUAL. VERIFY FIRM LOCATIONS MAINTAIN 75" MAXIMUM SPACING.
- 3"x3"x8" STEEL ANGLE ANCHORED TO FLOOR 12" O.C. PAINT BLACK. SEE DETAIL 7A103.


WALL TYPES

	EXISTING WALL - PATCH AND REPAIR AS REQUIRED AND PREP FOR NEW FINISHES		EXISTING EXT. WALL W/ 1-5/8" METAL STUDS @ 16" O.C.		3-5/8" METAL STUDS @ 16" O.C. TO 12'-0" AFF. PROVIDE SOUND BATT INSULATION. BOTH SIDES; 5/8" GYP. BD. FROM FLOOR TO 12'-0" AFF.		6" 14 GA. METAL STUDS @ 12" O.C. OFFICE SIDE; 5/8" GYP. BD. FROM FLOOR TO DECK. WAREHOUSE SIDE; 5/8" GYP. BD. FROM FLOOR TO 12'-0" AFF.		EXISTING EXT. WALL W/ 3-5/8" METAL STUDS @ 16" O.C. OFFICE SIDE; 4 MIL. POLY VAPOR BARRIER, 5/8" GYP. BD. FROM FLOOR TO 6" ABOVE FINISH CEILING. EDIT ROOM SIDE; 5/8" GYP. BD. TO 12'-0" AFF. PROVIDE SOUND BATT INSULATION.
	6" 14 GA. METAL STUDS @ 12" O.C. OFFICE SIDE; 5/8" GYP. BD. FROM FLOOR TO 6" ABOVE FINISH CEILING. WAREHOUSE SIDE; 5/8" GYP. BD. FROM FLOOR TO DECK.		3-5/8" METAL STUDS @ 16" O.C. TO 12'-0" AFF. PROVIDE SOUND BATT INSULATION. OFFICE SIDE; 5/8" GYP. BD. FROM FLOOR TO 12'-0" AFF. RESTROOM SIDE; 5/8" EXT. DENSGLASS BD. FROM FLOOR TO 6'-2" AFF & 5/8" GYP. BD. FROM 6'-2" AFF TO 6" ABOVE FINISH CEILING.		6" 14 GA. METAL STUDS @ 12" O.C. RESTROOM SIDE; 5/8" EXT. DENSGLASS BD. FROM FLOOR TO 6'-2" AFF & 5/8" GYP. BD. FROM 6'-2" AFF TO DECK.		12" CMU - CORE FILLED W/ INSUL. FROM FLOOR TO TOP OF OPENING.		6" 14 GA. METAL STUDS @ 12" O.C. BOTH SIDES; 5/8" GYP. BD. FROM FLOOR TO DECK.
	3-5/8" METAL STUDS @ 16" O.C. TO 12'-0" AFF. BOTH SIDES; 5/8" GYP. BD. FROM FLOOR TO 12'-0" AFF.		6" 14 GA. METAL STUDS @ 12" O.C. BOTH SIDES; 5/8" GYP. BD. FROM FLOOR TO DECK.		12" CMU - CORE FILLED W/ INSUL. FROM FLOOR TO TOP OF OPENING.		6" 14 GA. METAL STUDS @ 12" O.C. BOTH SIDES; 5/8" GYP. BD. FROM FLOOR TO DECK.		EXISTING EXT. WALL W/ 3-5/8" METAL STUDS @ 16" O.C. OFFICE SIDE; 4 MIL. POLY VAPOR BARRIER, 5/8" GYP. BD. FROM FLOOR TO 6" ABOVE FINISH CEILING. EDIT ROOM SIDE; 5/8" GYP. BD. TO 12'-0" AFF. PROVIDE SOUND BATT INSULATION.

NOTE: G.C. TO PROVIDE ROUGH LUMBER, PLYWOOD BLOCKING, ETC. THAT IS PRESSURE TREATED FIRE RETARDANT WOOD BEARING U.L. LABELING WHERE REQUIRED.

CASE #PL2020-79

APPROVED
Zoning Review Only
08/06/2020 NMJ

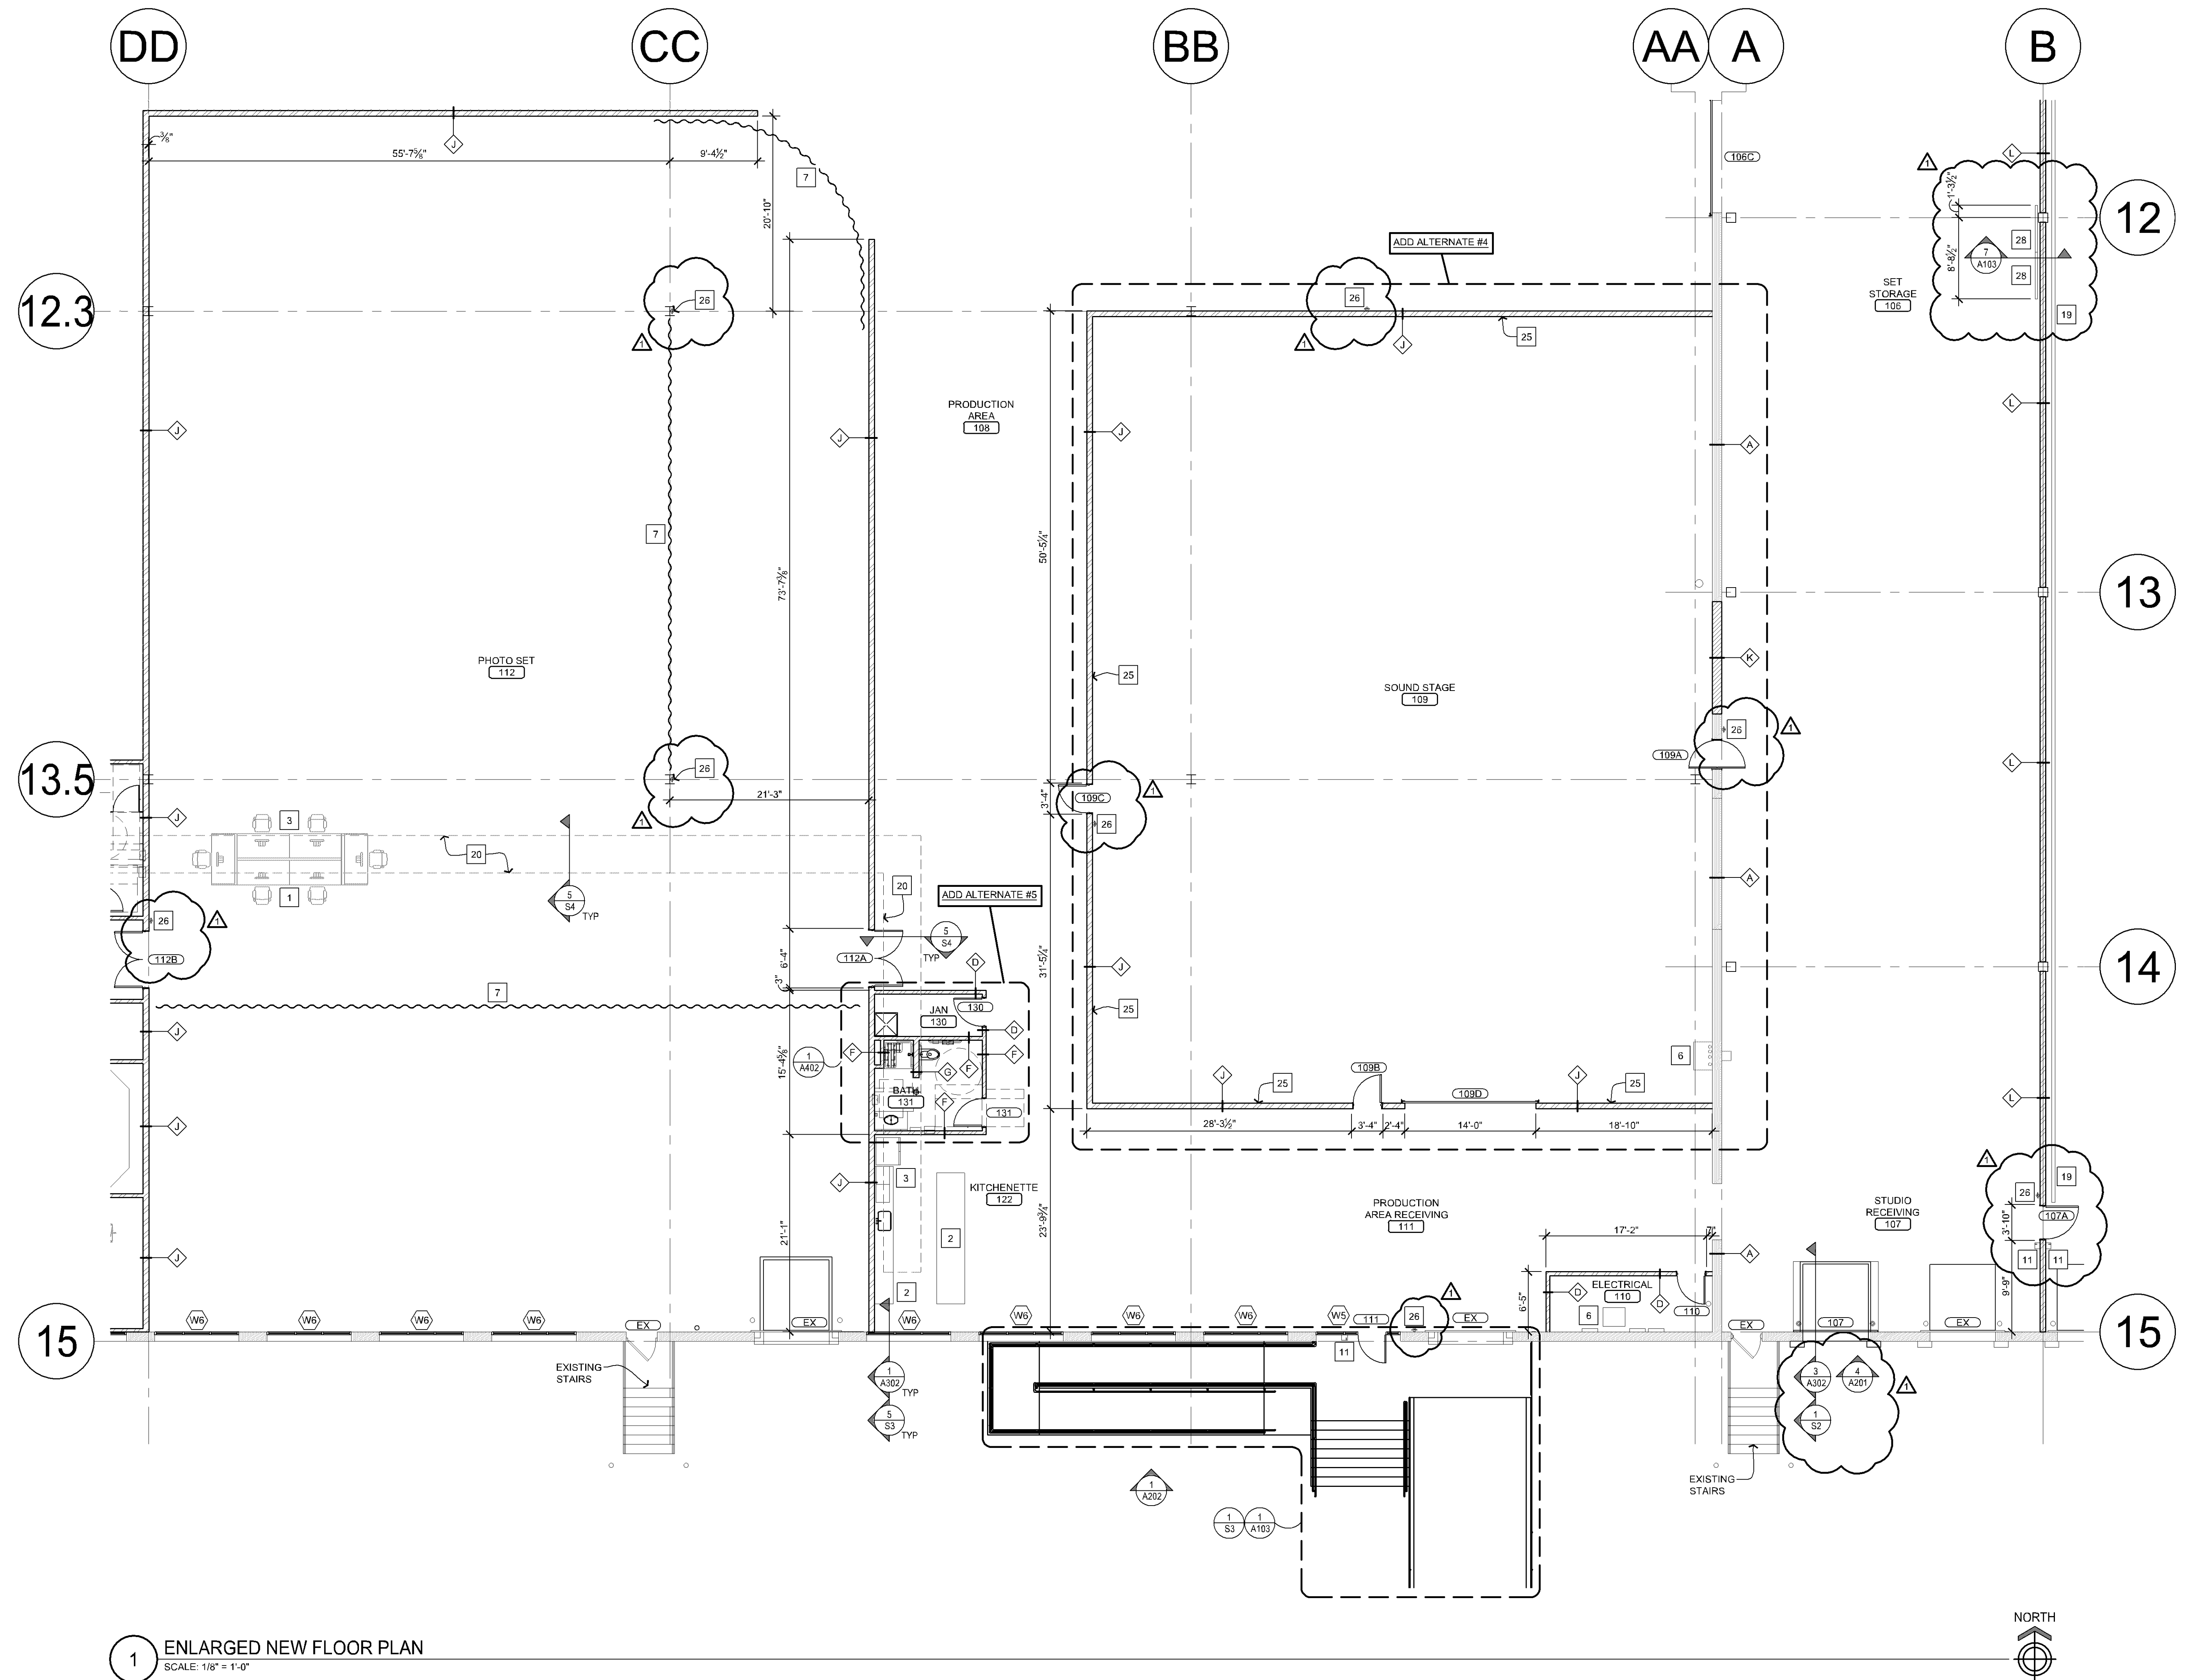

1 ENLARGED NEW FLOOR PLAN
SCALE: 1/8" = 1'-0"

GENERAL NOTES

- DO NOT SCALE THIS DRAWING IF THERE ARE ANY DISCREPANCIES CONTACT THE ARCHITECT PRIOR TO COMMENCING WORK.
- G.C. TO VERIFY ALL DIMENSIONS AND NOTIFY ARCHITECT OF ANY DISCREPANCIES PRIOR TO CONSTRUCTION.
- IF EXISTING EXTERIOR THRESHOLD EXCEEDS ADA MAXIMUM HEIGHT OF 1/2" REMOVE AND REPLACE WITH ACCESSIBLE THRESHOLD. RAISED THRESHOLDS AND FLOOR LEVEL CHANGES AT ACCESSIBLE DOORWAYS TO BE BEVELED WITH A SLOPE NO GREATER THAN 1:12.
- G.C. TO PROVIDE ALL WALL BLOCKING AND BACKING. VERIFY LOCATION WITH TENANT.
- G.C. TO PROVIDE AND INSTALL NON COMBUSTIBLE WOOD BACKING WHEN REQUIRED BY CODE.
- PAINTING OF ALL WALL SURFACES TO BE COMPLETED PRIOR TO THE INSTALLATION OF ANY WALL TRIM OR PANELING.
- REMOVAL OF EXCESS GROUT WILL BE DONE WITH WATER. THE USE OF SULFURIC OR MURIATIC ACID IS PROHIBITED. IF THESE ACIDS ARE USED, THE INSTALLER WILL BE REQUIRED TO REMOVE THE ACID AND RESTORE THE GROUT AT THEIR EXPENSE (IF APPLICABLE).
- G.C. SHALL DOCUMENT AS-BUILT INSTALLATION CONDITIONS & PROVIDE OWNER WITH AS-BUILT DRAWINGS AT PROJECT COMPLETION.
- ALL GYPSUM BOARD TO BE PREPARED TO LEVEL 4 FINISH STANDARDS PER GYPSUM ASSOCIATION STANDARDS.
- ALL FIXTURES/FURNITURE IS TENANT SUPPLIED AND INSTALLED. UNO
- USE CEMENT BOARD AT ALL WALL TILE LOCATIONS.
- ALL TILE TO BE INSTALLED PER TILE COUNCIL OF AMERICA STANDARDS.
- FLOOR SLAB IS TO BE PINNED AND TRENCHING COMPACTED PRIOR TO POURING BACK AFTER UNDERGROUND PLUMBING.

WALL LEGEND

- EXISTING WALL/
- EXISTING CONDITIONS BY OTHERS TO REMAIN
- NEW FULL HEIGHT METAL STUD WALL
- NEW CMU WALL

KEY NOTES

- NEW FURNITURE
- NEW COUNTERMILLWORK
- NEW EQUIPMENT
- EXISTING ELECTRICAL EQUIPMENT TO REMAIN
- EXISTING GUARDRAIL TO REMAIN
- EXISTING EQUIPMENT TO REMAIN
- SOFT BARRIER/CURTAIN
- NEW TRUCKERS CAGE BY WIRECRAFTERS. SEE S/A102.
- NEW CLOSET SHELF
- EXISTING FURNITURE TO REMAIN
- NEW CARD READER
- NEW TV W/ WOOD BLOCKING. COORDINATE W/ ELECTRICAL
- NEW 6" PIPE BOLLARD, PAINT AS EXIST. YELLOW. SEE S/A103.
- NEW GUARDRAIL OR REPURPOSE EXISTING GUARDRAIL
- NEW DRINKING FOUNTAIN W/ BOTTLE FILLER
- NEW 4" HIGH CONCRETE COLUMN PROTECTION. W/ SLAB EDGE. SEE S/A103.
- NEW HOLLMAN CCL LAMINATE LOCKERS, (4) UNITS W/ KEYPAD ACCESS
- EXISTING EQUIPMENT RELOCATED
- NEW ANGLE IRON WALL PROTECTION. SEE 4/A103.
- NEW CONCRETE SLAB INFILL. SEE PLUMBING DRAWINGS & DETAIL S/S4 FOR MORE INFORMATION. PATCH & REPAIR EXISTING SLAB INFILL AS REQUIRED FOR NEW FINISHES. COORDINATE EXACT LOCATIONS WITH BEST BUY CONSTRUCTION MANAGER.
- BRAKE METAL AT COLUMN TO MATCH ADJACENT WINDOW RAIL FINISH. VERIFY FINISH TO MATCH GR. BLACK ANODIZED
- APS RESOURCE POLY COLUMN PROTECTOR
- STEEL BENT PLATE COLUMN PROTECTION BY MISCELLANEOUS METALS SUPPLIER. COORDINATE SIZING DETAILS W/ BEST BUY CONST. MANAGER. WALLS TO HAVE THE TOP & BOTTOM TRACKS. PENETRATIONS SEALED W/ ACUSTICAL SEALANT. JUNCTION BOXES SHOULD BE STAGGERED & SEALED. HIGHLIGHTED WALLS SHOULD HAVE ACUSTICAL SEALANT AT BOTTOM TRACK AND JUNCTION BOXES.
- NEW FIRE EXTINGUISHERS: 10B-G BY SENTRY OR EQUAL. VERIFY FINAL LOCATIONS MAINTAIN 75' MAXIMUM SPACING.
- 3"x3"x3/8" STEEL ANGLE ANCHORED TO FLOOR 12" O.C. PAINT BLACK. SEE DETAIL 7A103.

WALL TYPES

	EXISTING WALL - PATCH AND REPAIR AS REQUIRED AND PREP FOR NEW FINISHES		3-5/8" METAL STUDS @ 16" O.C. TO 12'-0" AFF. PROVIDE SOUND BATT INSULATION.		6" 14 GA. METAL STUDS @ 12" O.C. OFFICE SIDE: 5/8" GYP. BD. FROM FLOOR TO DECK. WAREHOUSE SIDE: 5/8" GYP. BD. FROM FLOOR TO 12'-0" AFF.		EXISTING EXT. WALL W/ 5/8" METAL STUDS @ 16" O.C.
	OFFICE SIDE: RIGID INSUL. 4 MIL. POLY VAPOR BARRIER, 5/8" GYP. BD. FROM FLOOR TO 6" ABOVE FINISH CEILING.		BOTH SIDES: 5/8" GYP. BD. FROM FLOOR TO 12'-0" AFF.		6" 14 GA. METAL STUDS @ 12" O.C. PROVIDE SOUND BATT INSULATION.		OFFICE SIDE: 4 MIL. POLY VAPOR BARRIER, 5/8" GYP. BD. FROM FLOOR TO 6" ABOVE FINISH CEILING.
	6" 14 GA. METAL STUDS @ 12" O.C. OFFICE SIDE: 5/8" GYP. BD. FROM FLOOR TO 6" ABOVE FINISH CEILING. WAREHOUSE SIDE: 5/8" GYP. BD. FROM FLOOR TO DECK.		OFFICE SIDE: 5/8" GYP. BD. FROM FLOOR TO 12'-0" AFF.		BOTH SIDES: 5/8" GYP. BD. FROM FLOOR TO DECK.		EDIT ROOM SIDE: 5/8" GYP. BD. TO 12'-0" AFF. PROVIDE SOUND BATT INSULATION.
	3-5/8" METAL STUDS @ 16" O.C. TO 12'-0" AFF.		RESTROOM SIDE: 5/8" EXT. DENSGLASS BD. FROM FLOOR TO 6'-2" AFF & 5/8" GYP. BD. FROM 6'-2" AFF TO 6" ABOVE FINISH CEILING		12" CMU - CORE FILLED W/ INSUL. FROM FLOOR TO TOP OF OPENING.		3-5/8" METAL STUDS @ 16" O.C. TO 12'-0" AFF. PROVIDE SOUND BATT INSULATION.
	BOTH SIDES: 5/8" GYP. BD. FROM FLOOR TO 12'-0" AFF.		3-5/8" METAL STUDS @ STAGGERED 16" O.C. TO 12'-0" AFF. PROVIDE SOUND BATT INSULATION.		6" 14 GA. METAL STUDS @ 12" O.C. BOTH SIDES: 5/8" GYP. BD. FROM FLOOR TO DECK.		OFFICE SIDE: 5/8" GYP. BD. FROM FLOOR TO 12'-0" AFF.
	3-5/8" METAL STUDS @ 16" O.C. TO 12'-0" AFF.		BOTH SIDES: 5/8" EXT. DENSGLASS BD. FROM FLOOR TO 6'-2" AFF & 5/8" GYP. BD. FROM 6'-2" AFF TO 6" ABOVE FINISH CEILING		NOTE: G.C. TO PROVIDE ROUGH LUMBER, PLYWOOD BLOCKING, ETC. THAT IS PRESSURE TREATED FIRE RETARDANT WOOD BEARING U.L. LABELING WHERE REQUIRED.		RESTROOM SIDE: 5/8" EXT. DENSGLASS BD. FROM FLOOR TO 4'-7" AFF & 5/8" GYP. BD. FROM 4'-7" AFF TO 6" ABOVE FINISH CEILING

STARGATE - BLOOMINGTON
TENANT REMODELING IN EXISTING TENANT SPACE
6203 8TH WEST 11TH STREET
BLOOMINGTON, MN 55438
ENLARGED FLOOR PLANS

BEST BUY

DATE ISSUED
PERMIT SET 05/22/20
ADDENDUM 1 06/01/20
DRAWN BY JPH/ND
CHECKED BY JH
JOB NO. 19246

A105

reprise Architecture, Inc.
12400 Portland Avenue South
Suite 100, Portland Corporate Center
Office: (952) 232-4442
Fax: (952) 232-4443
DESIGN
I hereby certify that this plan, specification or schedule of work was prepared by me or under my direct supervision and that I am a duly registered architect in the State of Minnesota.
Signature: [Signature]
Date: 06/01/20
Registration Number: 18650


CASE #PL2020-79

13.5

FF

EE

DD

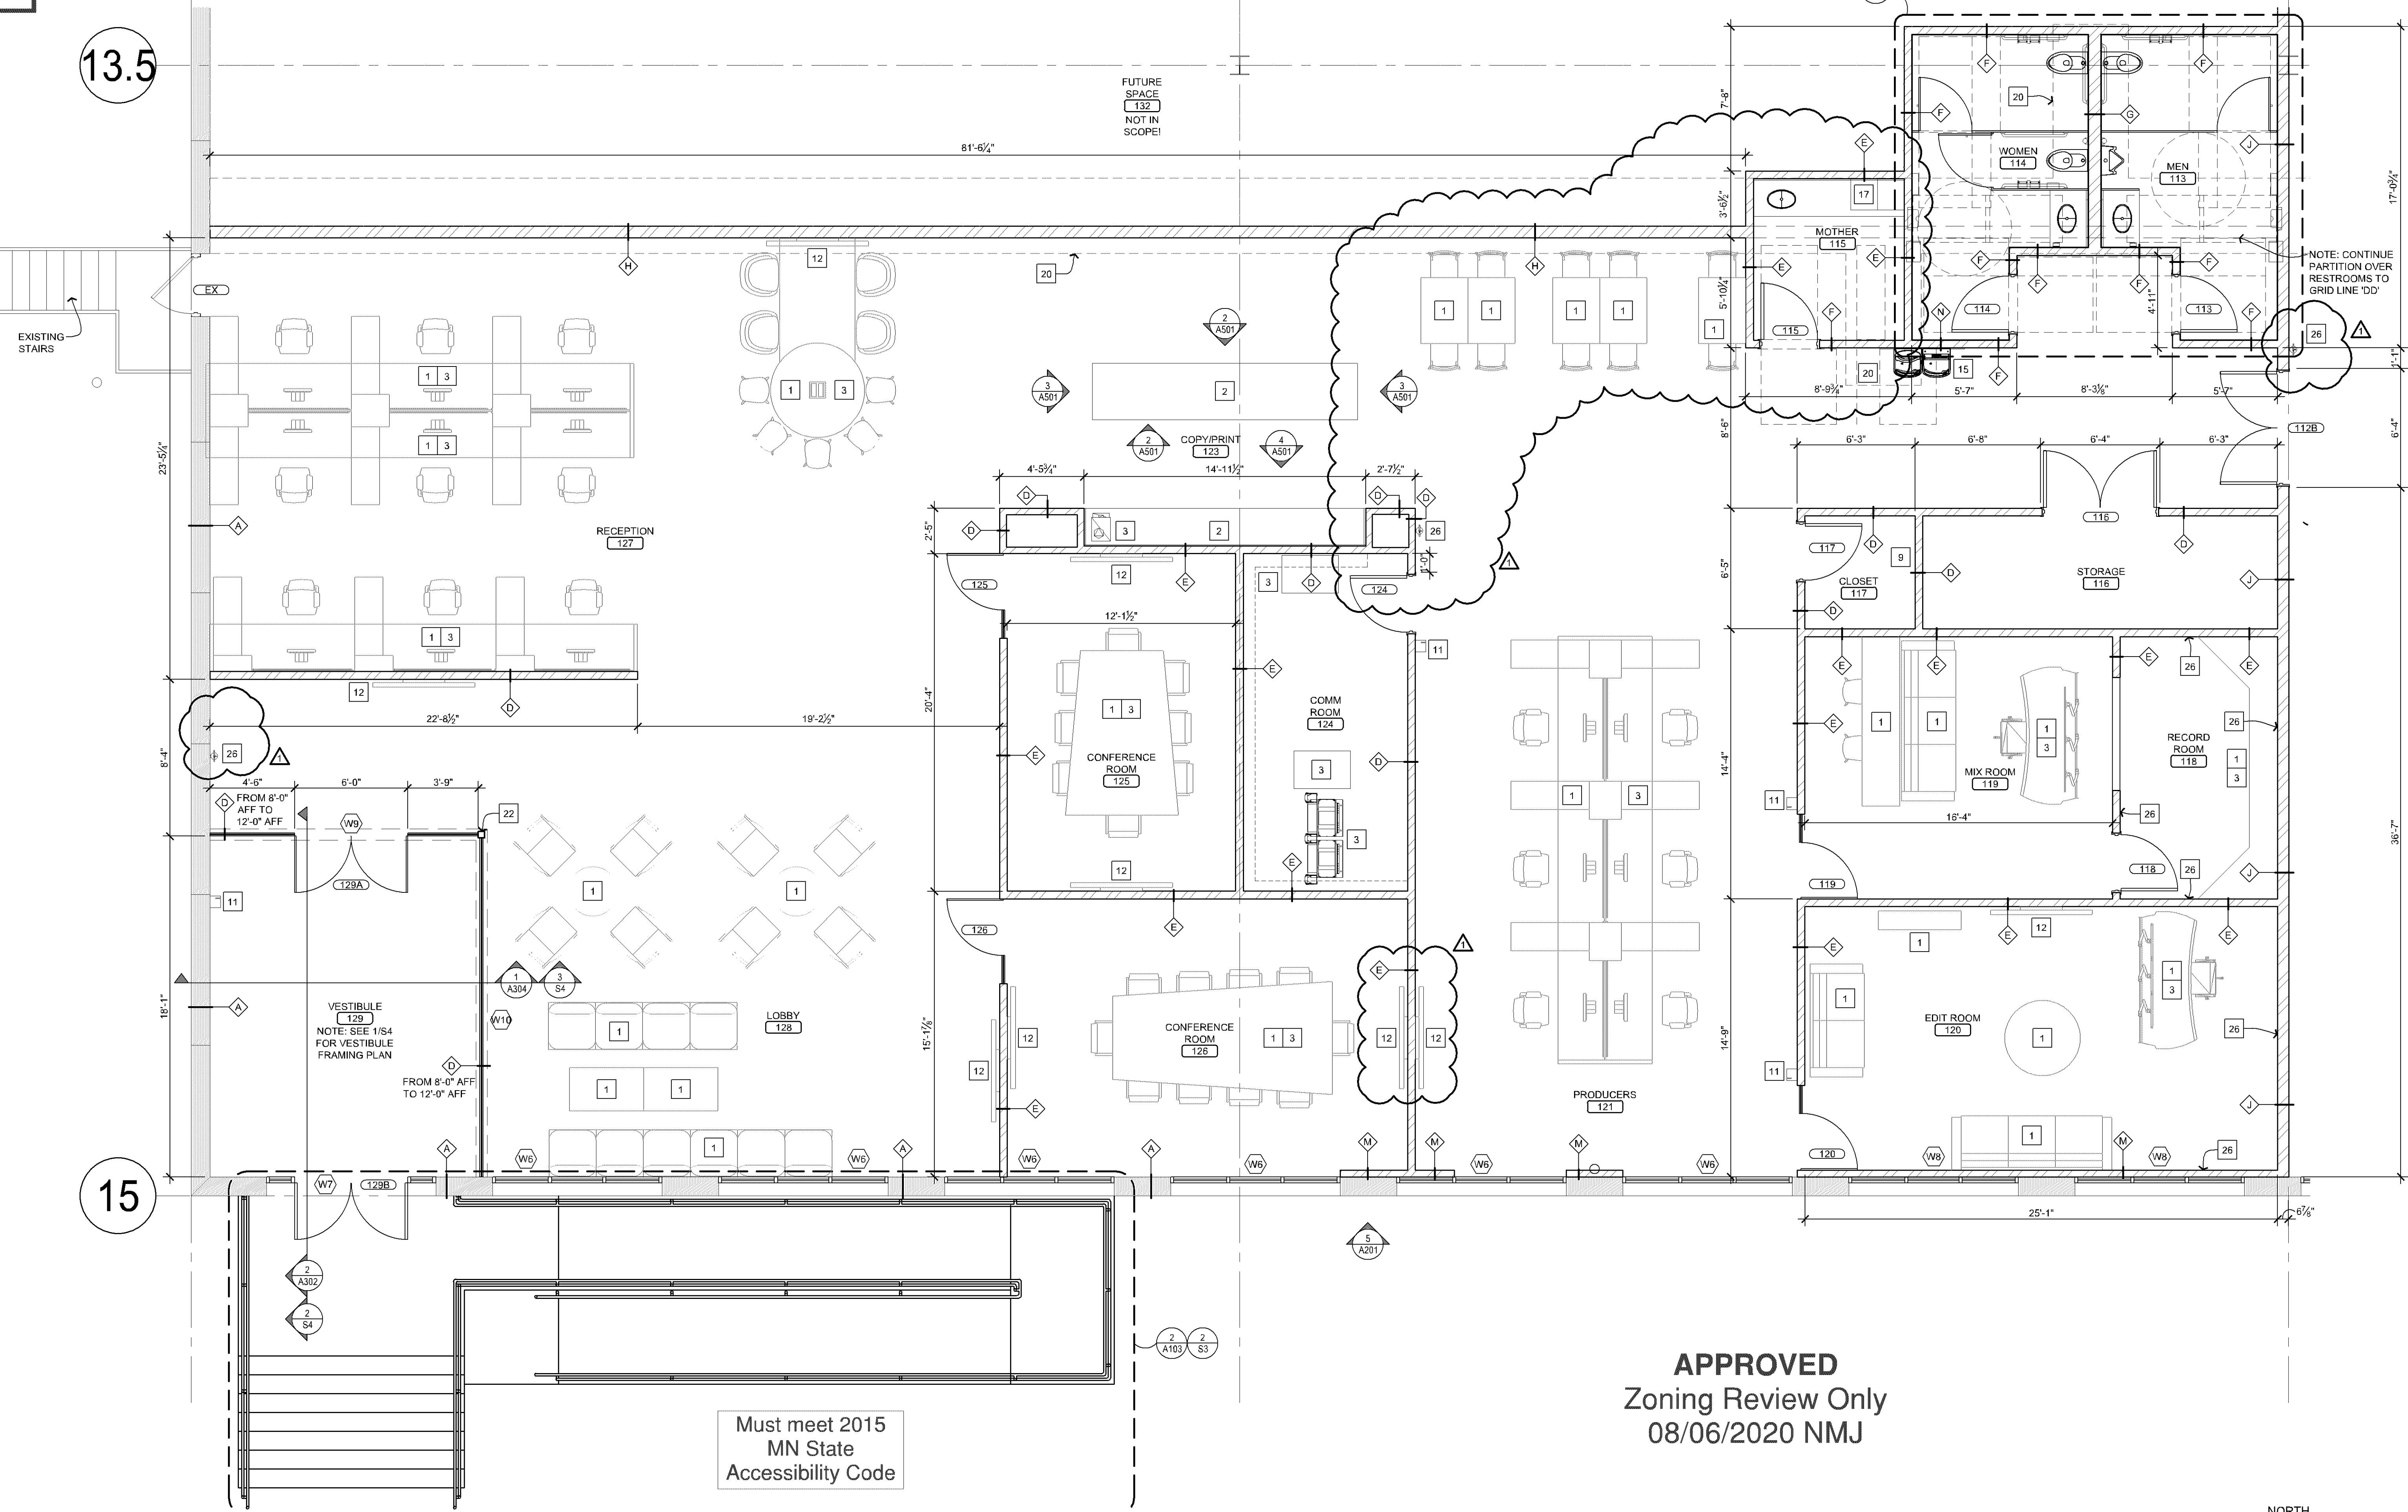

APPROVED
Zoning Review Only
08/06/2020 NMJ



1 ENLARGED NEW FLOOR PLAN
SCALE: 1/4" = 1'-0"

GENERAL NOTES	
1.	DO NOT SCALE THIS DRAWING IF THERE ARE ANY DISCREPANCIES CONTACT THE ARCHITECT PRIOR TO COMMENCING WORK.
2.	G.C. TO VERIFY ALL DIMENSIONS AND NOTIFY ARCHITECT OF ANY DISCREPANCIES PRIOR TO CONSTRUCTION.
3.	IF EXISTING EXTERIOR THRESHOLD EXCEEDS ADA MAXIMUM HEIGHT OF 1/2" REMOVE AND REPLACE WITH ACCESSIBLE THRESHOLD. RAISED THRESHOLDS AND FLOOR LEVEL CHANGES AT ACCESSIBLE DOORWAYS TO BE BEVELED WITH A SLOPE NO GREATER THAN 1:12
4.	G.C. TO PROVIDE ALL WALL BLOCKING AND BACKING. VERIFY LOCATION WITH TENANT.
5.	G.C. TO PROVIDE AND INSTALL NON COMBUSTIBLE WOOD BACKING WHEN REQUIRED BY CODE.
6.	PAINTING OF ALL WALL SURFACES TO BE COMPLETED PRIOR TO THE INSTALLATION OF ANY WALL TRIM OR PANELING.
7.	REMOVAL OF EXCESS GROUT WILL BE DONE WITH WATER. THE USE OF SULFURIC OR MURIATIC ACID IS PROHIBITED. IF THESE ACIDS ARE USED, THE INSTALLER WILL BE REQUIRED TO REMOVE THE ACID AND RESTORE THE GROUT AT THEIR EXPENSE (IF APPLICABLE).
8.	G.C. SHALL DOCUMENT AS-BUILT INSTALLATION/CONDITIONS & PROVIDE OWNER WITH AS-BUILT DRAWINGS AT PROJECT COMPLETION. ALL GYPSUM BOARD TO BE PREPARED TO LEVEL 4 FINISH STANDARDS PER GYPSUM ASSOCIATION STANDARDS.
9.	ALL FIXTURES/FURNITURE IS TENANT SUPPLIED AND INSTALLED. UNO
10.	USE CEMENT BOARD AT ALL WALL TILE LOCATIONS.
11.	ALL TILE TO BE INSTALLED PER TILE COUNCIL OF AMERICA STANDARDS.
12.	FLOOR SLAB IS TO BE PINNED AND TRENCHING COMPACTED PRIOR TO POURING BACK AFTER UNDERGROUND PLUMBING.

WALL LEGEND	
	EXISTING WALL/
	EXISTING CONDITIONS BY OTHERS TO REMAIN
	NEW FULL HEIGHT METAL STUD WALL
	NEW CMU WALL

KEY NOTES	
1	NEW FURNITURE
2	NEW COUNTER/MILLWORK
3	NEW EQUIPMENT
4	EXISTING ELECTRICAL EQUIPMENT TO REMAIN
5	EXISTING GUARDRAIL TO REMAIN
6	EXISTING EQUIPMENT TO REMAIN
7	SOFT BARRIER/CURTAIN
8	NEW TRUCKERS CAGE BY WIRECRAFTERS. SEE S/A102.
9	NEW CLOSET SHELF
10	EXISTING FURNITURE TO REMAIN
11	NEW CARD READER
12	NEW TV W/ WOOD BLOCKING
13	COORDINATE W/ ELECTRICAL
14	NEW 6" PIPE BOLLARD, PAINT BLACK, YELLOW SEE S/A103
15	NEW DRINKING FOUNTAIN W/ BOTTLE FILLER
16	NEW 4" HIGH CONCRETE COLUMN PROTECTION
17	NEW HOLLAND C/O LAMINATE LOCKERS, (4) UNITS W/ KEYPAD ACCESS
18	EXISTING EQUIPMENT RELOCATED
19	NEW ANGLE IRON WALL PROTECTION. SEE 4/A103.
20	NEW CONCRETE SLAB INFILL. SEE PLUMBING DRAWINGS & DETAIL S14 FOR MORE INFORMATION.
21	PATCH & REPAIR EXISTING SLAB INFILL AS REQUIRED FOR NEW FINISHES.
22	COORDINATE EXACT LOCATIONS WITH BEST BUY CONSTRUCTION MANAGER.
23	BRAKE METAL AT COLUMNS TO MATCH ADJACENT WINDOW RAIL FINISH. VERIFY FINISH TO MATCH GRN BLACK ANODIZED
24	APS RESOURCE POLY COLUMN PROTECTOR
25	STEEL BENT PLATE COLUMN PROTECTION BY MISCELLANEOUS METALS SUPPLIER. COORDINATE SIZING DETAILS W/ BEST BUY CONST. MANAGER.
26	WALLS TO HAVE THE TOP & BOTTOM TRACKS PENETRATIONS SEALED W/ ACUSTICAL SEALANT. JUNCTION BOXES SHOULD BE STAGGERED & SEALED.
27	HIGHLIGHTED WALLS SHOULD HAVE ACUSTICAL SEALANT AT BOTTOM TRACK AND JUNCTION BOXES.
28	NEW FIRE EXTINGUISHER, (16) G BY SENTRY OR EQUAL. VERIFY FINAL LOCATIONS MAINTAIN 75" MAXIMUM SPACING. 3"X3"X8" STEEL ANGLE ANCHORED TO FLOOR 12" O.C. PAINT BLACK. SEE DETAIL 7A103.

WALL TYPES	
	EXISTING WALL - PATCH AND REPAIR AS REQUIRED AND PREP FOR NEW FINISHES
	EXISTING EXT. WALL W/ 5/8" METAL STUDS @ 16" O.C.
	OFFICE SIDE, RIGID INSUL. 4 MIL. POLY VAPOR BARRIER, 5/8" GYP. BD. FROM FLOOR TO 6' ABOVE FINISH CEILING.
	6" 14 GA. METAL STUDS @ 12" O.C.
	OFFICE SIDE, 5/8" GYP. BD. FROM FLOOR TO 12'-0" AFF.
	WAREHOUSE SIDE, 5/8" GYP. BD. FROM FLOOR TO 12'-0" AFF.
	6" 14 GA. METAL STUDS @ 12" O.C. PROVIDE SOUND BATT INSULATION.
	BOTH SIDES, 5/8" GYP. BD. FROM FLOOR TO 12'-0" AFF.
	3-5/8" METAL STUDS @ 16" O.C. TO 12'-0" AFF. PROVIDE SOUND BATT INSULATION.
	OFFICE SIDE, 5/8" GYP. BD. FROM FLOOR TO 12'-0" AFF.
	REST ROOM SIDE, 5/8" EXT. DENSGLASS BD. FROM FLOOR TO 6'-2" AFF & 5/8" GYP. BD. FROM 6'-2" AFF TO 6' ABOVE FINISH CEILING
	3-5/8" METAL STUDS @ 16" O.C. TO 12'-0" AFF.
	BOTH SIDES, 5/8" GYP. BD. FROM FLOOR TO 12'-0" AFF.
	3-5/8" METAL STUDS @ 16" O.C. TO 12'-0" AFF. PROVIDE SOUND BATT INSULATION.
	BOTH SIDES, 5/8" EXT. DENSGLASS BD. FROM FLOOR TO 6'-2" AFF & 5/8" GYP. BD. FROM 6'-2" AFF TO 6' ABOVE FINISH CEILING
	12" CMU - CORE FILLED W/ INSUL. FROM FLOOR TO TOP OF OPENING.
	6" 14 GA. METAL STUDS @ 12" O.C. PROVIDE SOUND BATT INSULATION.
	BOTH SIDES, 5/8" GYP. BD. FROM FLOOR TO 12'-0" AFF.
	EXISTING WALL W/ 3-5/8" METAL STUDS @ 16" O.C.
	OFFICE SIDE, 4 MIL. POLY VAPOR BARRIER, 5/8" GYP. BD. FROM FLOOR TO 6' ABOVE FINISH CEILING.
	EDIT ROOM SIDE, 5/8" GYP. BD. TO 12'-0" AFF. PROVIDE SOUND BATT INSULATION.
	3-5/8" METAL STUDS @ 16" O.C. TO 12'-0" AFF.
	REST ROOM SIDE, 5/8" EXT. DENSGLASS BD. FROM FLOOR TO 4'-7" AFF & 5/8" GYP. BD. FROM 4'-7" AFF TO 6' ABOVE FINISH CEILING
NOTE: G.C. TO PROVIDE ROUGH LUMBER, PLYWOOD BLOCKING, ETC. THAT IS PRESSURE TREATED FIRE RETARDANT WOOD BEARING U.L. LABELING WHERE REQUIRED.	

reprise
Architecture, Inc.
12400 Portland Avenue South
Suite 100, Portland Corporate Center
Office: (952) 222-4432
Fax: (952) 224-4431


DESIGN
I hereby certify that this plan, specification or schedule was prepared by me or under my direct supervision and that I am a duly registered architect under the laws of the State of Minnesota.
Signature: [Signature]
Date: 8/6/2020
Registration Number: 18650

STARGATE - BLOOMINGTON
TENANT REMODELING IN EXISTING TENANT SPACE
6203 8TH WEST 11TH STREET
BLOOMINGTON, MN 55436
ENLARGED FLOOR PLANS


BEST
BUY

DATE ISSUED
PERMIT SET 05/22/20
ADDENDUM 1 06/01/20
DRAWN BY JPH/ND
CHECKED BY JH
JOB NO. 19246

A106

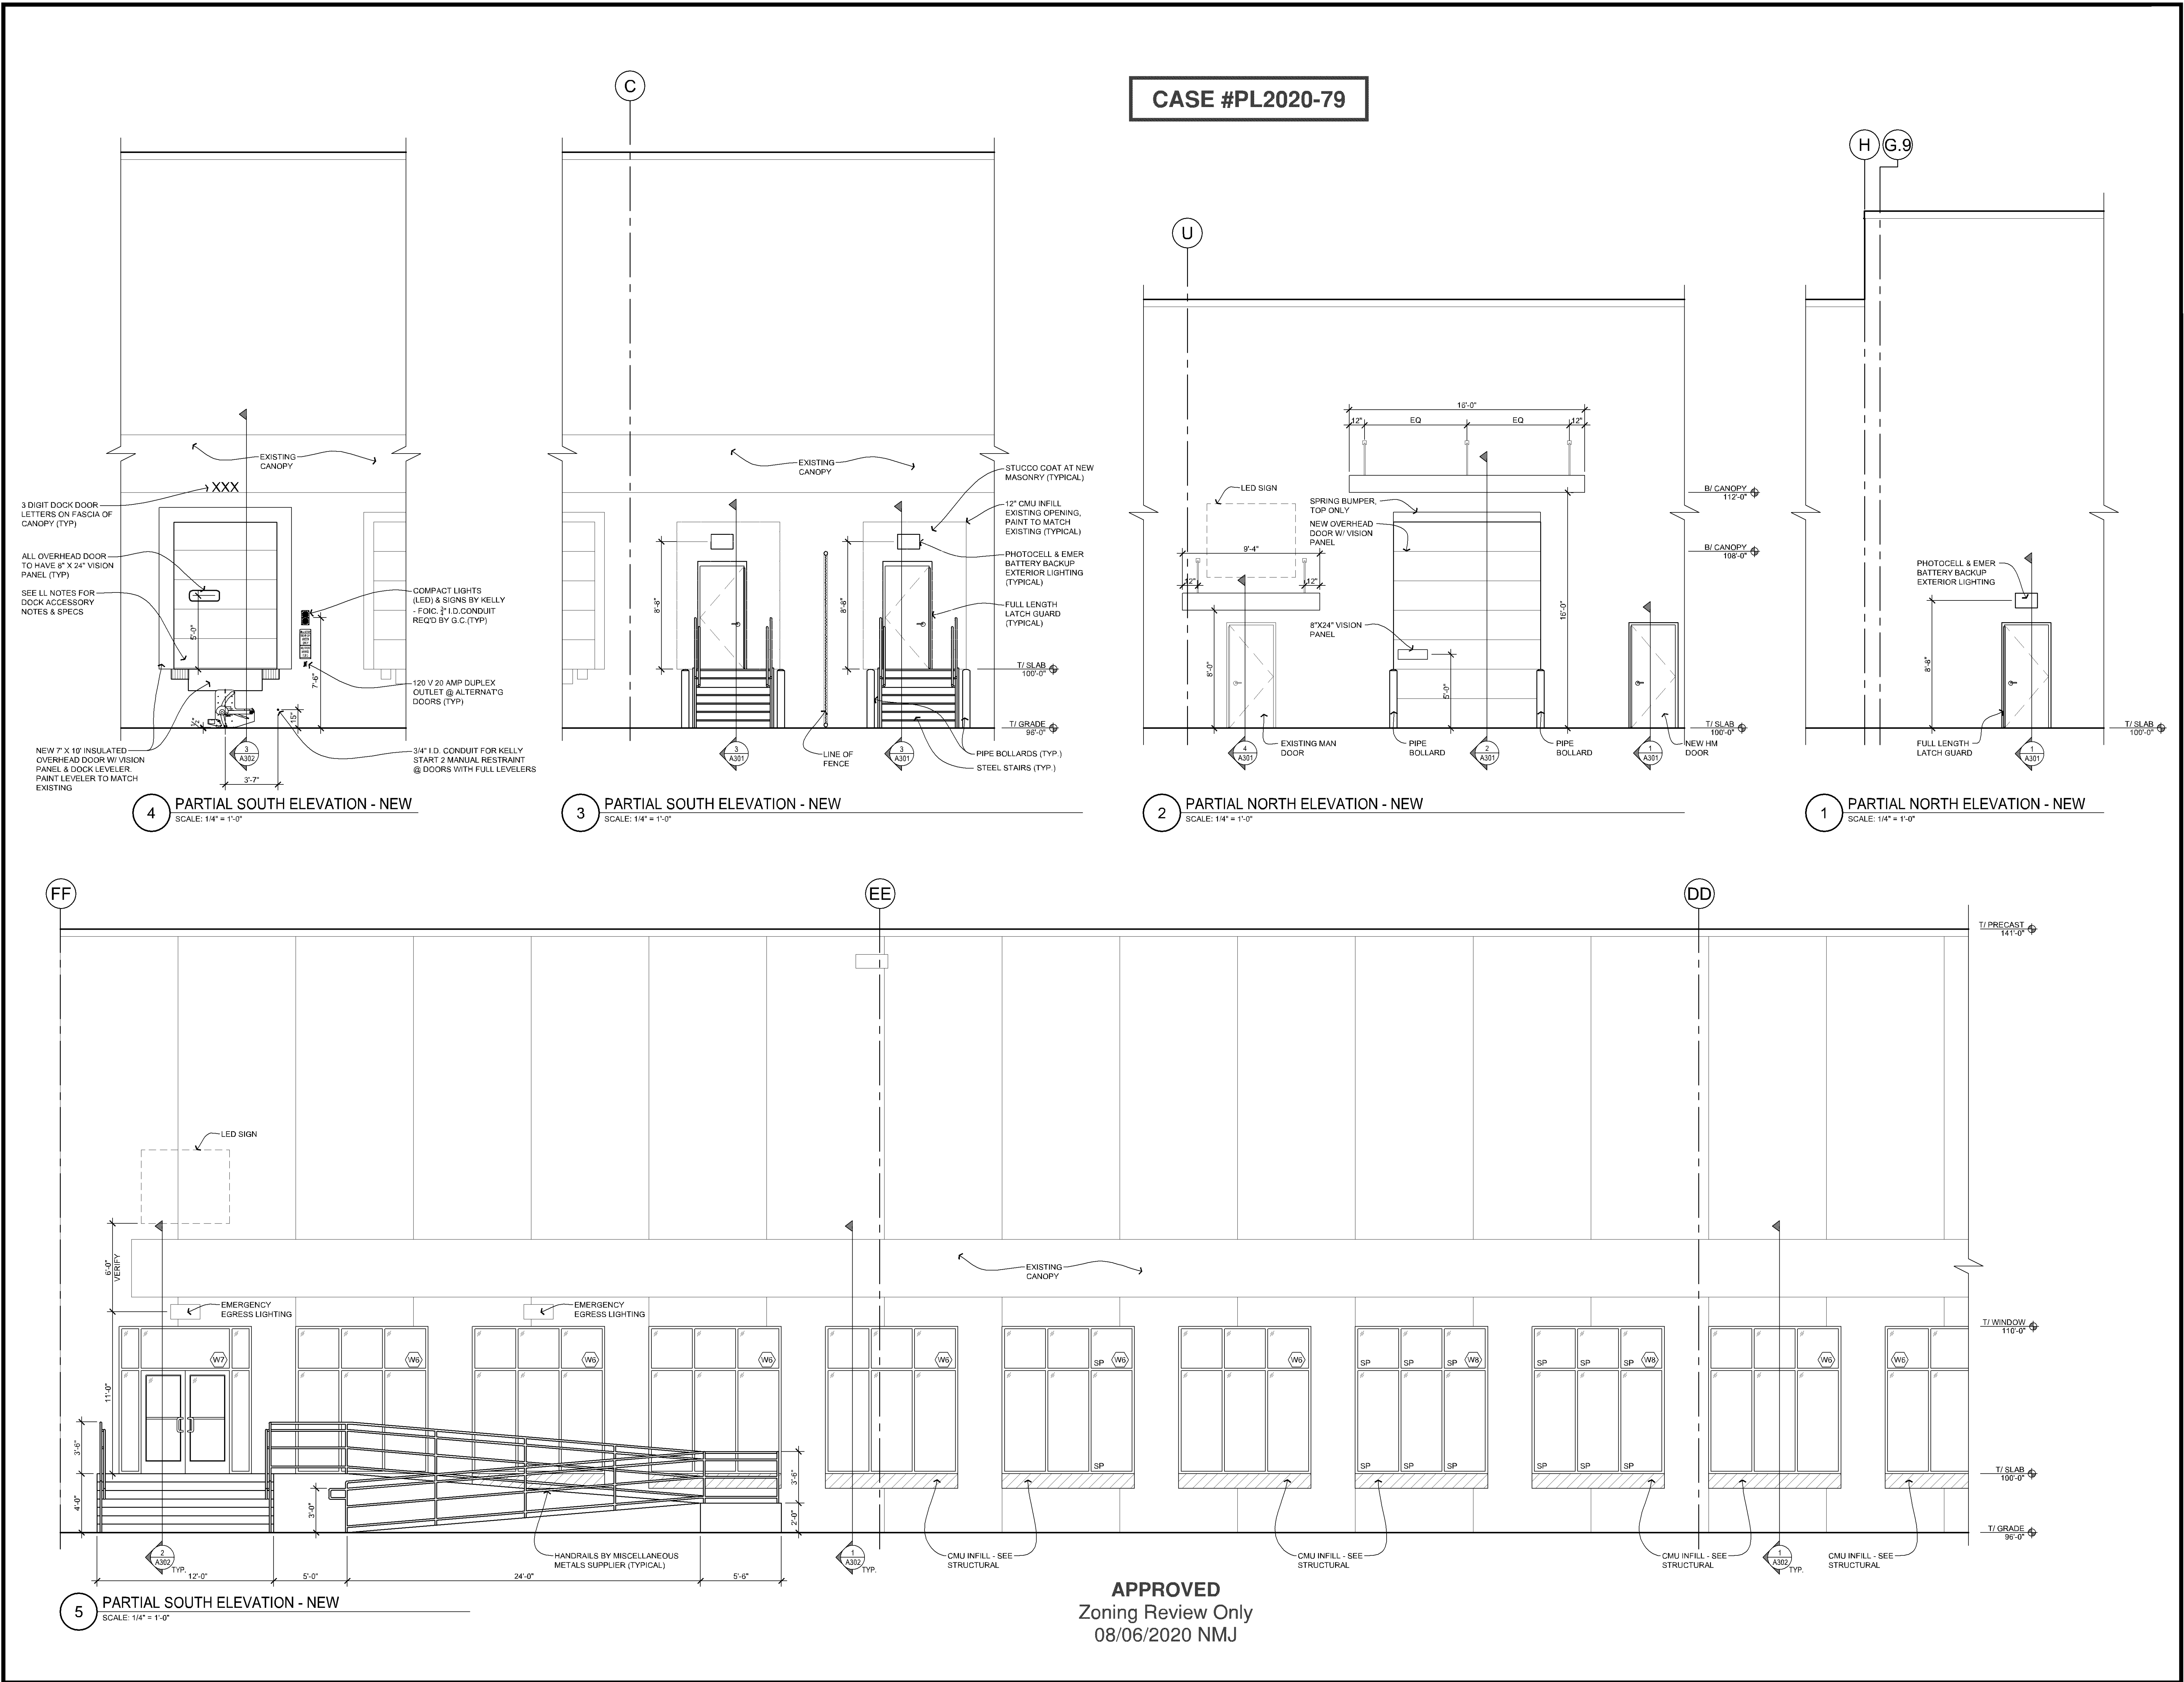

CASE #PL2020-79

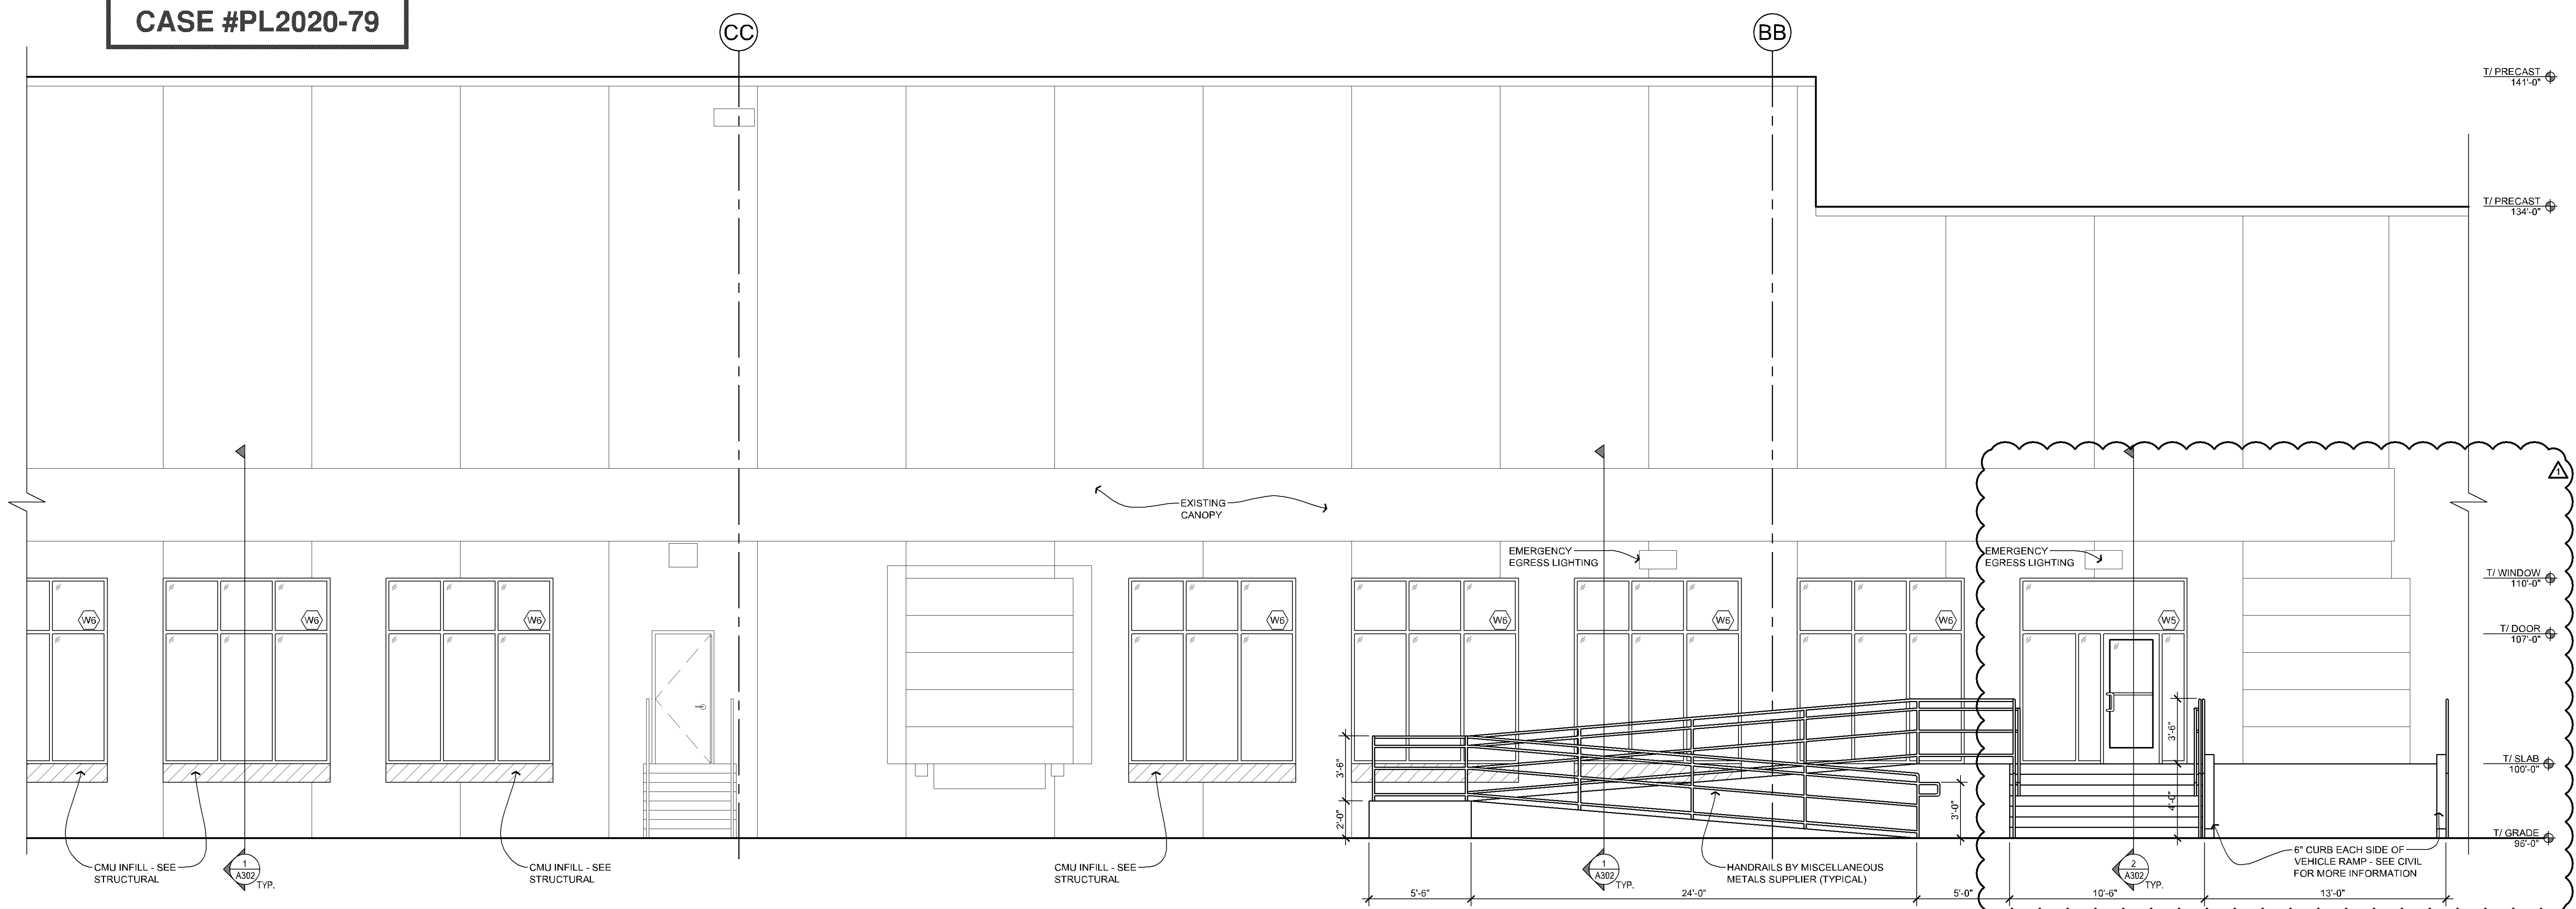

1 PARTIAL SOUTH ELEVATION - NEW
SCALE: 1/4" = 1'-0"

APPROVED
Zoning Review Only
08/06/2020 NMJ

Must meet 2015
MN State
Accessibility Code

**BEST
BUY**

STARGATE - BLOOMINGTON
TENANT REMODELING IN EXISTING TENANT SPACE
6203 8TH WEST 11TH STREET
BLOOMINGTON, MN 55438
PARTIAL EXTERIOR ELEVATIONS

DATE ISSUED
PERMIT SET 05/22/20
ADDENDUM 1 06/01/20
DRAWN BY JPH/ND
CHECKED BY JH
JOB NO. 19246

A202

I hereby certify that this plan, specification or
supervision and that I am a duly registered
architect under the laws of the
State of Minnesota.
Signature: *Robert L. Johnson*
06/01/20
10650
Registration Number

reprise
DESIGN
Architecture, Inc.
12405 Portland Avenue South
Suite 100, Portland Corporate Center
Office: (952) 232-4432
Fax: (952) 232-4432