

Drawing name: X:\2019\190123\plan sheets\Final Plan Development\190123cover.dwg May 06, 2020 — 1:21pm

AMERICAN SQUARE APARTMENTS

AMERICAN BOULEVARD E AND 34TH AVE SOUTH

BLOOMINGTON, MINNESOTA

FINAL DEVELOPMENT PLAN

PL202000083

ALLIANT
ENGINEERING

733 Marquette Avenue
Suite 700
Minneapolis, MN 55402
612.758.3080
www.alliant-inc.com

DEVELOPER

KAEDING MANAGEMENT /
RON CLARK CONSTRUCTION

ARCHITECT

MOMENTUM DESIGN GROUP
PRIOR WORKS BUILDING
755 PRIOR AVENUE NORTH
SUITE #301A
ST. PAUL, MINNESOTA 55104
OFFICE: 952.583.9788
WWW.MDGARCHITECTS.COM

SURVEYOR

HARRY JOHNSON
HARRY S. JOHNSON CO., INC.
LAND SURVEYORS
9063 LYNDALE AVENUE SOUTH
BLOOMINGTON, MN 55437
PH: 952-88-4-5341
www.hsjsurveyors.com

CONSULTANT


ALLIANT ENGINEERING, INC.
733 MARQUETTE AVE STE, 700
MINNEAPOLIS, MN 55415
PH: 612-758-3080 / FX: 612-758-3099
www.alliant-inc.com

CIVIL ENGINEER

DAVE NASH
LICENSE NO. 40922
EM: dnash@alliant-inc.com

LANDSCAPE ARCHITECT

MARK KRONBECK, PLA, ASLA
LICENSE NO. 26222
EM: mkronbeck@alliant-inc.com

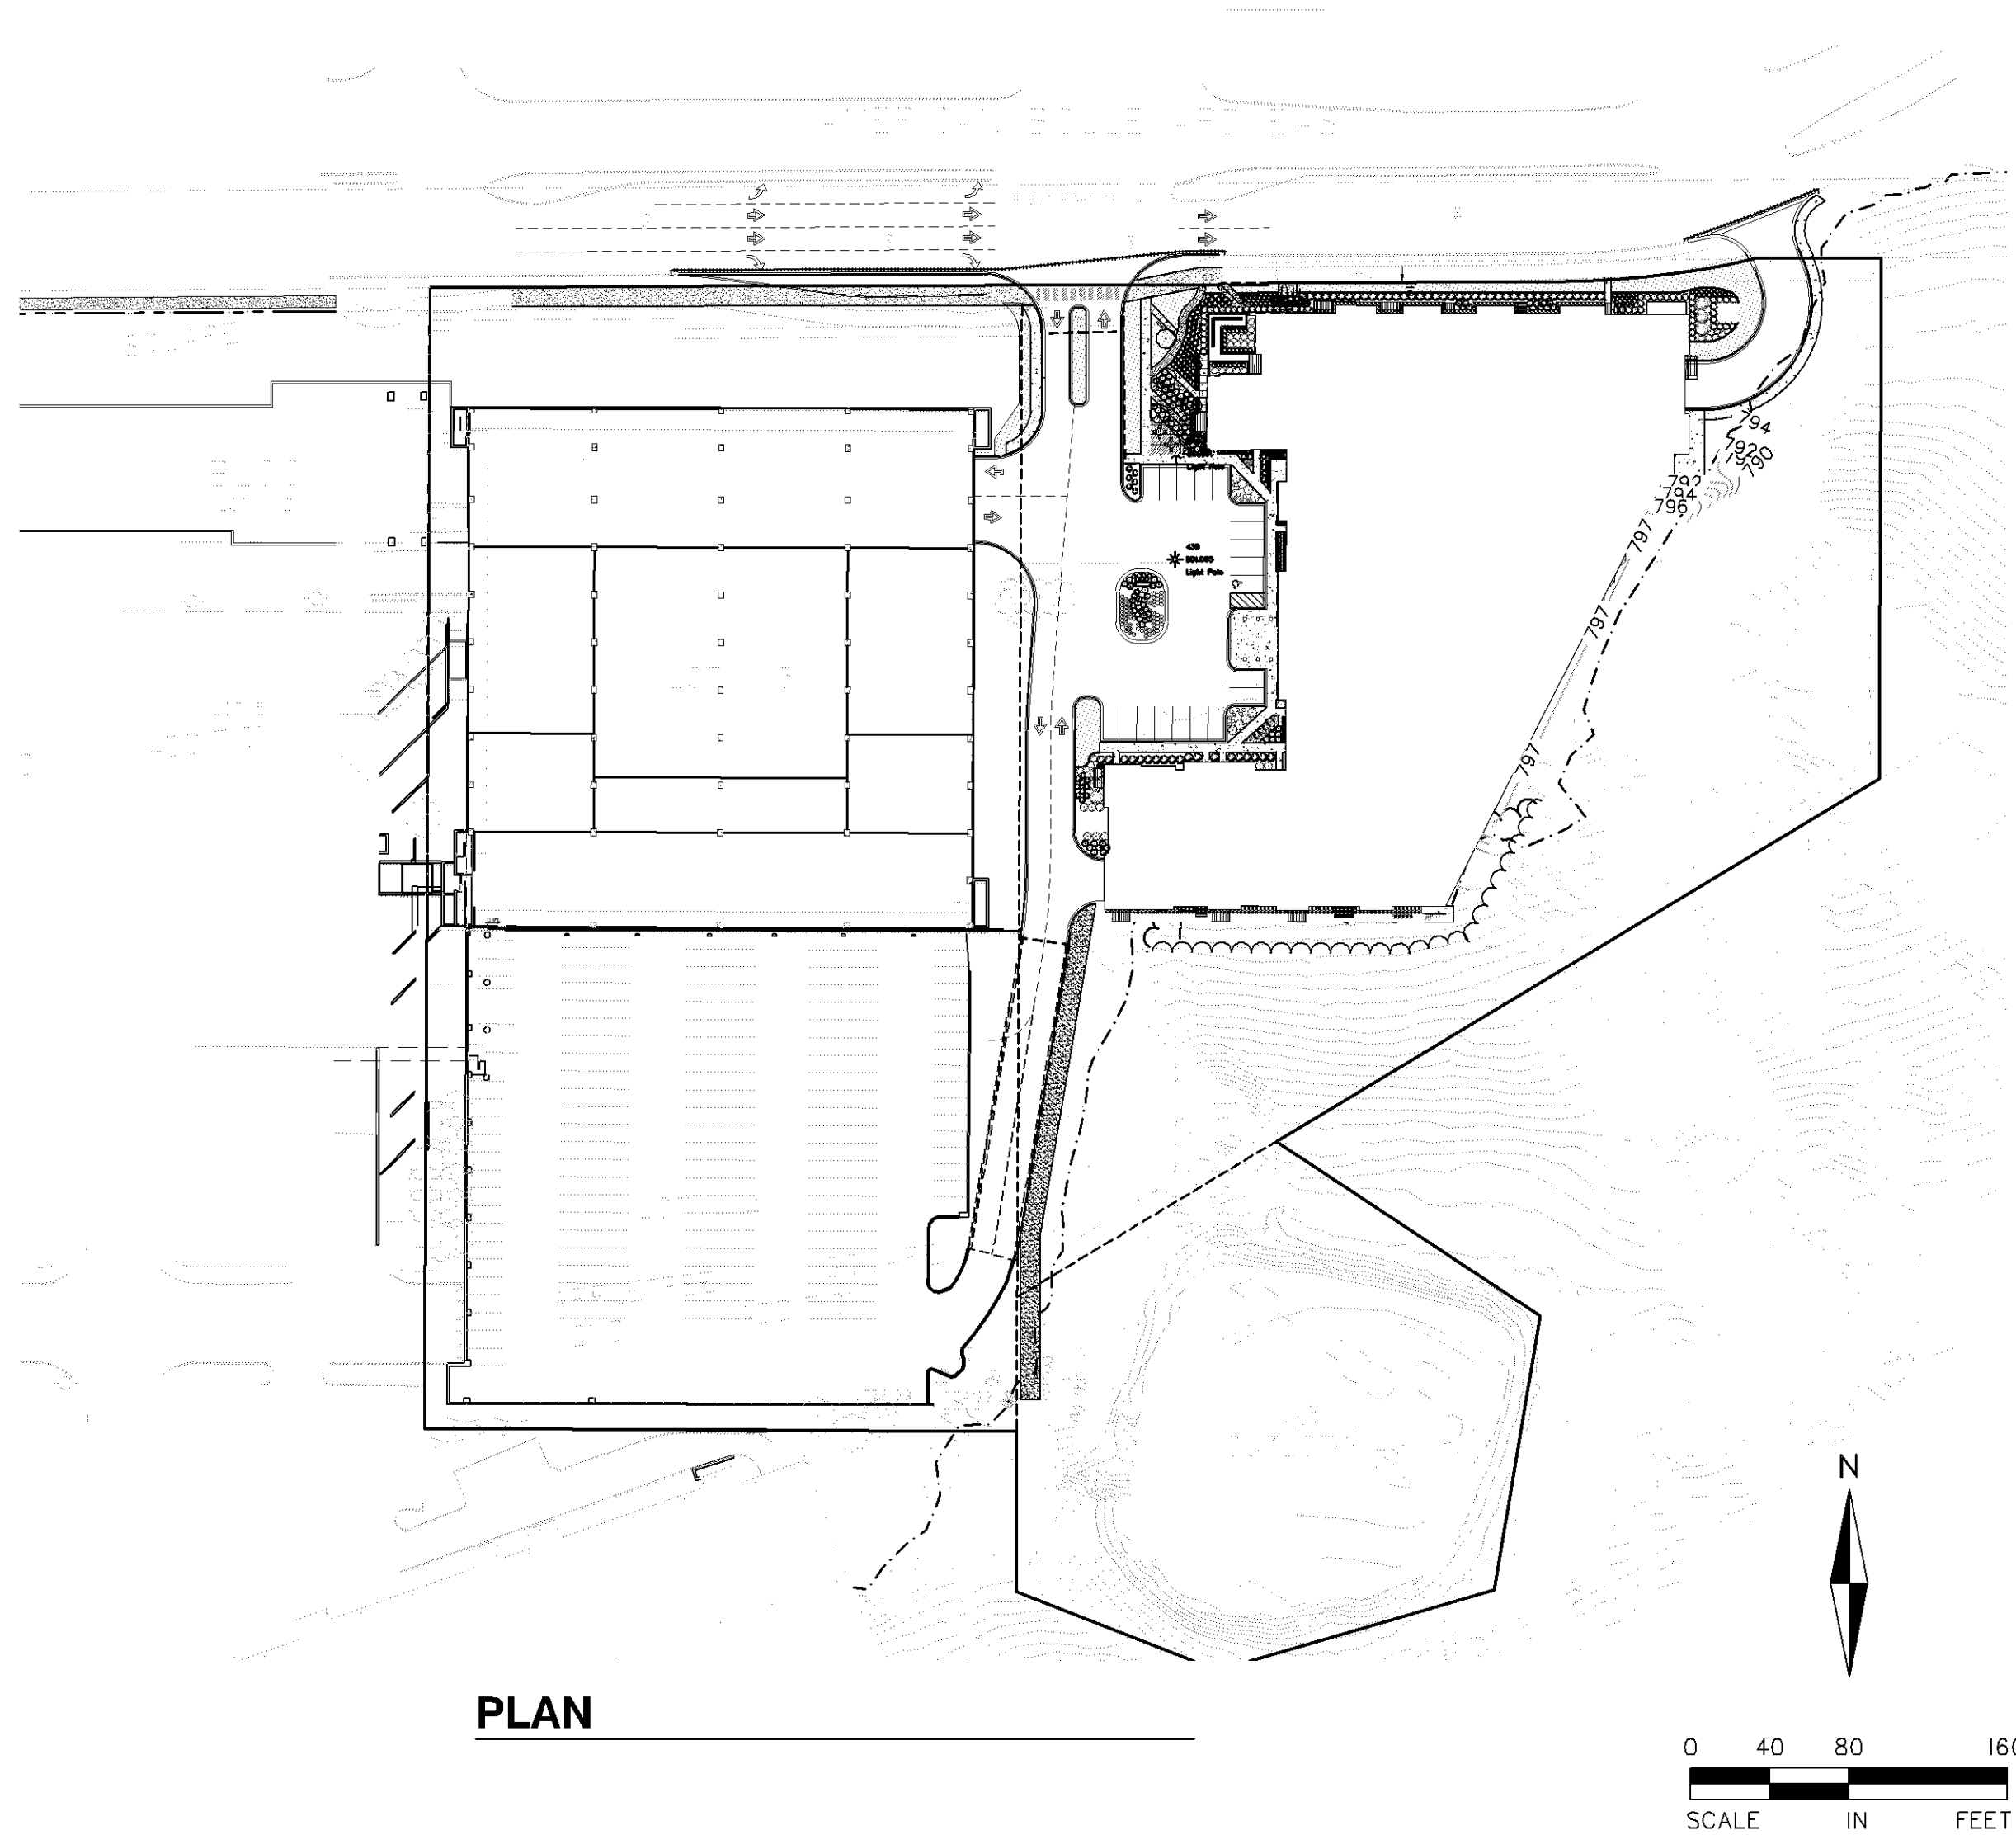

SITE VICINITY MAP

SHEET INDEX

Sheet Number	Sheet Title
C-1.0	COVER PAGE
C-2.0	EXISTING CONDITIONS
C-2.1	TREE INVENTORY
C-3.0	DEMOLITION PLAN
C-4.0	SITE PLAN
C-5.0	GRADING AND EROSION CONTROL PLAN
C-5.1	EROSION CONTROL, SWPPP, AND BLUFF PROTECTION NOTES
C-6.0	UTILITY PLAN
C-7.0	DETAILS
C-7.1	DETAILS
C-7.2	DETAILS
C-7.3	DETAILS
L-1.0	LANDSCAPE PLAN
L-2.0	LANDSCAPE DETAILS

AMERICAN SQUARE APARTMENTS
BLOOMINGTON, MN
AMERICAN BOULEVARD E. AND 34TH AVE SOUTH
3601 AMERICAN BOULEVARD EAST
FINAL DEVELOPMENT PLAN
COVER PAGE

I hereby certify that this plan, specification, or report was prepared by me or under my direct supervision and that I am a duly Licensed PROFESSIONAL ENGINEER under the laws of the State of MINNESOTA

DAVID NASH, PE
12-30-19
Date License No.

QUALITY ASSURANCE/CONTROL

BY	DATE
DATE	ISSUE
01-29-20	CITY SUBMITTAL
03-27-20	PROGRESS PLOT
05-06-20	REVISED CITY SUBMITTAL

PROJECT TEAM DATA
DESIGNED: DMS/DJN
DRAWN: KDB/DMS
PROJECT NO: 190123

C-1.0

PL202000083

HARRY S. JOHNSON CO., INC.
LAND SURVEYORS
9063 Lyndale Avenue South
Bloomington, MN. 55437
Tele. 952-884-5341 Fax 952-884-5344
www.hsjsurveyors.com

ALLIANT
ENGINEERING
733 Marquette Avenue
Suite 700
Minneapolis, MN 55402
612.758.3080
www.alliant-inc.com

LEGAL DESCRIPTION:

PARCEL 1:
Outlot A, Lot 1, Block 1, except that part thereof embraced within the North 294.5 feet of the Southeast Quarter of the Northwest Quarter of Section 6, Township 27, Range 23, all in Hennepin County, Minnesota, TORRENS PROPERTY: Certificate of Title No. 1207183.
PARCEL 2:
That part of Lot 1, Block 1, Appletree Square 4th Addition embraced within the North 294.5 feet of the Southeast Quarter of the Northwest Quarter of Section 6, Township 27, Range 23, Hennepin County, Minnesota, except that part of said Lot 1 which lies Northwesterly of a line run parallel with and distant 30 feet Southerly of Line 1 described below:
Line 1: From a point on the North line of Section 6, Township 27 North, Range 23 West, distant 1085.23 feet East of the Northwest corner thereof, run Southerly at an angle of 89 degrees 56 minutes 48 seconds from said North section line (measured from East to South) for 332.91 feet; thence South to the right at an angle of 5 degrees 55 minutes 59 seconds for 835.2 feet; thence defect to the left at an angle of 5 degrees 18 minutes 00 seconds for 282.59 feet to the point of beginning.
thence defect to the left at an angle of 90 degrees 36 minutes 39 seconds for 1038.00 feet; thence defect to the left on a tangential curve having a radius of 381.97 feet, a delta angle of 88 degrees 18 minutes 18 seconds for 595.37 feet and three terminating, RESCUE PROPERTY.

PARCEL 3:
Rights of the Lessee under the unrecorded Appletree Motel Parking Ramp Lease dated December 14, 1978, as amended by Lease Amendment dated April 8, 1979, and set out in Memorandum of Lease recorded August 27, 1997, as Document No. 283183 (Torrens) and recorded August 28, 1997, as Document No. 677124 (Abstract) and Memorandum of Lease recorded August 5, 1997, as Document No. 678709 (Abstract), affecting Lot 1, Block 1, Appletree Square 2nd Addition. Together with a non-exclusive perpetual easement for utilities and access dated September 6, 1978, and recorded as Document No. 453483 (Abstract) and Document No. 1354759 (Torrens) and as amended by Amendment of Declaration dated January 25, 1980, recorded as Document No. 4558767 (Abstract) and Document No. 1573598 (Torrens) and further amended by Second Amendment to Declaration of Easements dated April 30, 1984 and recorded as Document No. 4886760 (Abstract) and Document No. 1573598 (Torrens). Together with a non-exclusive easement for use as vehicular and pedestrian passage ways as set forth in Document No. 4038889 (Abstract), ABSTRACT AND TORRENS PROPERTY: Part of Certificate of Title No. 1375982.

NOTES CORRESPONDING TO EASEMENTS:

10. Easements for drainage and utility purposes as shown on the recorded plat of Appletree Square 4th Addition, recorded as Document No. 4488247 (Abstract) and as Document No. 1339007 (Torrens), (Affects Parcels 1 and 2). (AS SHOWN ON SURVEY)
11. Easements for drainage and utility purposes as shown on the recorded plat of Appletree Square 2nd Addition, recorded as Document No. 4029332 (Abstract) and as Document No. 1076392 (Torrens), (Affects Parcels 3 and 4). (AS SHOWN ON SURVEY)
12. Easement for pedestrian access in favor of the City of Bloomington dated July 31, 1973, recorded March 20, 1974, as Document No. 1101611 (Torrens), (Affects Parcel 1) (AS SHOWN ON SURVEY)
13. Terms and conditions of and easements created in Declaration of Easements dated September 6, 1978, recorded August 24, 1979, as Document No. 453483 (Abstract) and recorded October 30, 1979, as Document No. 1354759 (Torrens). Amended by Amendment to Declaration of Easements dated January 25, 1980, recorded April 28, 1980, as Document No. 4558767 (Abstract) and recorded April 18, 1984, as Document No. 1573429 (Torrens). Amended by Second Amendment to Declaration of Easements dated April 30, 1984, recorded May 2, 1984, as Document No. 4886760 (Abstract) and recorded May 3, 1984, as Document No. 1573598 (Torrens), (Affects Parcels 1, 2, 3 and 4) (AS SHOWN ON SURVEY)
14. Easement for drainage, ponding and floodage purposes in favor of the City of Bloomington dated October 15, 1985, recorded October 22, 1985, as Document No. 5044843 (Abstract) and as Document No. 1680038 (Torrens), (Affects Outlot A of Parcel 1) (AS SHOWN ON SURVEY)
15. Easement for utility purposes in favor of the City of Bloomington dated June 27, 1983, recorded July 1, 1983, as Document No. 4806019 (Abstract), (Affects Parcel 2) (AS SHOWN ON SURVEY)
16. Easement for sidewalk and bikeway purposes in favor of the City of Bloomington dated July 31, 1973, recorded August 2, 1979, as Document No. 4498335 (Abstract), (Affects Parcel 2) (AS SHOWN ON SURVEY)
17. Terms and conditions of and easements contained in Special Area Easement in favor of the City of Bloomington dated June 6, 1972, recorded July 13, 1972, as Document No. 3958057 (Abstract), (Affects Parcels 1 and 2) (AS SHOWN ON SURVEY)
18. Easement for drainage and utility purposes as shown on the recorded plat of Declaration of Easements dated January 6, 1981, recorded January 21, 1981, as Document No. 4491756 (Abstract), (Affects Parcel 3) (AS SHOWN ON SURVEY)
19. Non-exclusive easement for use as vehicular and pedestrian passage ways and utility services as set forth in the Lease dated August 27, 1973, recorded August 28, 1973, as Document No. 4038889 (Abstract), (Affects Parcels 3 and 4) (AS SHOWN ON SURVEY)
20. Easement for drainage, ponding and floodage purposes in favor of the City of Bloomington dated March 6, 1986, recorded April 24, 1986, as Document No. 6565014 (Abstract), (Affects Lot 2 of Parcel 3) (AS SHOWN ON SURVEY)
21. Easement for sidewalk and bikeway purposes in favor of the City of Bloomington dated March 6, 1986, recorded April 24, 1986, as Document No. 6565014 (Abstract), (Affects Lot 1 of Parcel 1) (AS SHOWN ON SURVEY)
22. Terms and conditions of and easements created in Reciprocal Easement Agreement dated May 15, 1984, recorded May 22, 1984, as Document No. 6187453 (Abstract) and recorded August 30, 1983, as Document No. 2415979 (Torrens), (Affects Parcel 4) (A BLANKET EASEMENT OVER PARCEL 4)
23. Easement for sidewalk and bikeway purposes in favor of the City of Bloomington dated December 11, 1995, recorded December 29, 1995, as Document No. 656086 (Abstract), (Affects Parcel 4) (AS SHOWN ON SURVEY)
24. Skyway and Walkway Easement contained in Warranty Deed dated November 5, 1979, recorded November 9, 1979, as Document No. 4532060 (Abstract), (Affects Parcels 3 and 4) (AS SHOWN ON SURVEY)

GENERAL NOTES:

- The bearing system used is assumed.
- The location of the underground utilities shown herein, if any, are approximate only. PRESUMED TO MEET 2102 CONTACT CODED STATE ONE C-AT (R12) 454-0002 PRIOR TO ANY EXCAVATION.
- Subject property is identified as being in "Zone X, Other Areas" on Flood Insurance Rate Map No. 270500176P, effective date November 4, 2016.
- Site Area = 386,500 square feet = 8.942 acres.
- There are 191 surface striped parking stalls on said property, 2 are designated as handicap. Parking Ramp Total = 185 parking stalls of which there are 24 Handicap parking (per 2014 survey by HSJ).
- This survey was made on the ground.
- No current title work was furnished for the preparation of this survey. In preparing this survey I have relied upon the supporting documents and the Commitment for Title Insurance issued First American Title Insurance Company Commitment Number MCS-708623-MLLS dated December 3, 2014. Legal description, recorded or unrecorded easements and encumbrances are subject to revision upon receipt of current title work.
- Elevation datum is based on NAVD 88 data. HSJ Benchmark #1 is located Top Nut Hydrant (AS SHOWN ON SURVEY) Elevation = 805.99
- LiDAR contour information was used to fill in the steep, overgrown and heavily wooded areas of the site. Note: These areas have contours only and no spot elevations.
- ENCLOSURE AND CREDITS: LiDAR data shown and provided is subject to the disclaimers provided in the data documentation from MnTPO. MnTPO is a collaborative effort between MnIT Services & Minnesota Department of Natural Resources and MnIT Services & MnDNR.

LEGEND

- | | |
|-----------------------|--------------------------------|
| Property Corner | Catchbasin |
| Concrete | Catchbasin |
| Concrete Curb | Deciduous Tree (Dia. in In.) |
| Underground Electric | Coniferous Tree (Dia. in In.) |
| Underground Telephone | Light Pole |
| Water | Sanitary Manhole |
| Gas | Storm Manhole |
| Sanitary Sewer | Existing Contour |
| Storm Sewer | Existing Spot Elevation Gutter |
| Electric Box | Existing Spot Elevation |
| Electric Manhole | |
| Hydrant | |
| Unknown Manhole | |
| Gate Valve | |

0 25 50 100
SCALE IN FEET

AMERICAN SQUARE APARTMENTS
BLOOMINGTON, MN
AMERICAN BOULEVARD E. AND 34TH AVE SOUTH
3601 AMERICAN BOULEVARD EAST
FINAL DEVELOPMENT PLAN
EXISTING CONDITIONS

QUALITY ASSURANCE/CONTROL

BY	DATE
DATE	ISSUE

PROJECT TEAM DATA

DESIGNED:
DRAWN:
PROJECT NO: 219-0123

C-2.0

Drawing name: X:\2019\190123\plan sheets\Final Plan Development\190123tree.dwg May 06, 2020 — 1:21pm

TREE INVENTORY

Tag Number	DBH	Common Name	Remove	Located in the Bluff	Notes
302	26	Basswood	X		2x trunk 15, 11
303	15	Basswood	X		
304	19	Basswood	X		
305	5	Hackberry		Yes	
306	6	Hackberry		Yes	
307	6	Hackberry		Yes	
308	7	Hackberry		Yes	
309	10	Hackberry		Yes	
310	16	Hackberry		Yes	
311	7	Hackberry		Yes	
312	15	Hackberry		Yes	
313	4	Hackberry		Yes	
314	9	Hackberry		Yes	
349	14	Hackberry		Yes	
350	12	Hackberry		Yes	
353	11	Hackberry		Yes	
354	8	Locust		Yes	
356	37	Locust		Yes	
357	6	Locust		Yes	
358	4	Hackberry		Yes	
359	27	Locust		Yes	
360	9	Hackberry		Yes	
361	5	Locust		Yes	
362	4	Hackberry		Yes	
363	6	Hackberry		Yes	
364	6	Hackberry		Yes	
365	6	Hackberry		Yes	
366	4	Oak		Yes	
367	15	Locust		Yes	
368	41	Oak		Yes	2x trunk 18, 23
369	4	Elm		Yes	
370	6	Elm		Yes	
371	10	Elm		Yes	
372	4	Oak		Yes	
373	14	Elm		Yes	
374	6	Elm		Yes	
375	10	Oak		Yes	
376	4	Elm		Yes	
377	9	Hackberry		Yes	
378	7	Hackberry		Yes	
379	12	Oak		Yes	
380	15	Elm		Yes	
381	30	Elm		Yes	2x trunk 18, 12
382	20	Russian Olive		Yes	
383	20	Russian Olive		Yes	2x trunk 10, 10
384	6	Hackberry		Yes	
385	4	Hackberry		Yes	
386	20	Hackberry		Yes	2x trunk 15, 5
387	7	Hackberry		Yes	
388	11	Elm		Yes	
389	8	Elm		Yes	
390	10	Elm		Yes	
391	25	Russian Olive		Yes	3x trunk 7, 10, 8
392	4	Hackberry		Yes	
393	7	Locust	X	Yes	
394	4	Locust	X		
395	4	Hackberry		Yes	
396	5	Hackberry		Yes	
397	6	Elm		Yes	
398	7	Elm		Yes	
399	4	Hackberry		Yes	
400	4	Hackberry		Yes	
402	6	Hackberry		Yes	
764	8	Elm		Yes	
765	8	Elm		Yes	
766	9	Elm		Yes	
767	9	Elm		Yes	2x trunk 5, 4
768	5	Elm		Yes	
769	8	Elm		Yes	
770	6	Elm		Yes	
771	5	Elm		Yes	
772	9	Elm		Yes	
773	4	Elm		Yes	
774	4	Elm		Yes	
775	19	Elm		Yes	
776	6	Hackberry		Yes	
777	7	Elm		Yes	
778	19	Elm		Yes	
779	4	Elm		Yes	
780	17	Elm		Yes	
781	6	Elm		Yes	
782	6	Elm		Yes	
783	5	Elm		Yes	
784	5	Hackberry	X	Yes	
785	5	Elm		Yes	
786	6	Elm	X	Yes	
787	10	Elm	X	Yes	
788	10	Elm	X	Yes	
789	7	Elm	X		
790	6	Elm	X	Yes	

Tag Number	DBH	Common Name	Remove	Located in the Bluff	Notes
791	6	Elm		Yes	
792	6	Elm	X	Yes	
793	5	Hackberry		Yes	
794	9	Elm		Yes	
795	6	Elm		Yes	
796	7	Elm		Yes	
797	12	Cottonwood		Yes	
798	9	Elm		Yes	
799	6	Elm		Yes	
901	5	Elm		Yes	
1396	15	Box Elder		Yes	
1498	5	Elm		Yes	
1499	5	Elm		Yes	
2193	15	Cottonwood		Yes	
2194	10	Elm		Yes	
2195	7	Elm		Yes	
2196	12	Cottonwood		Yes	
2199	16	Cottonwood		Yes	
2200	10	Elm	X	Yes	
2301	3	Colorado Green Spruce			11' tall
2303	3	Colorado Green Spruce			11' tall
2304	3	Colorado Green Spruce			11' tall
2305	12	Crab Apple			
2306	12	Crab Apple			
2307	12	Crab Apple			
2308	12	Crab Apple			
2309	12	Crab Apple			
2310	12	Crab Apple			
2311	12	Crab Apple			
2312	12	Crab Apple			
2313	12	Crab Apple			
2314	12	Crab Apple			
2315	12	Crab Apple			
2316	12	Crab Apple			
2318	19	Elm		Yes	
2319	26	Box Elder			2x trunk 16, 10
2320	38	Cottonwood	X		
2321	16	Cottonwood	X		
2322	45	Cottonwood			3x trunk 18, 15, 12
2323	64	Cottonwood		Yes	4x trunk 16, 16, 16, 16
2324	19	Cottonwood	X		
2325	12	Ash			
2326	14	Ash			
2327	14	Cottonwood	X		
2328	14	Cottonwood	X		
2329	15	Cottonwood	X		
2330	18	Cottonwood	X		
2331	12	Cottonwood	X		
2332	17	Cottonwood		Yes	
2334	38	Cottonwood		Yes	
2335	19	Cottonwood		Yes	
2336	23	Cottonwood		Yes	
2337	18	Cottonwood		Yes	
2338	17	Ash		Yes	
2339	18	Maple		Yes	
2340	96	Cottonwood		Yes	3x trunk 39, 29, 28
2341	14	Hackberry		Yes	
2342	19	Maple		Yes	
2343	16	Hackberry		Yes	
2344	23	Cottonwood		Yes	
2345	23	Cottonwood		Yes	
2399	16	Cottonwood		Yes	
2400	40	Cottonwood		Yes	
2572	4	Elm		Yes	
2573	32	Cottonwood		Yes	
2574	7	Elm		Yes	
2698	10	Elm		Yes	

PL202000083



ALLIANT
ENGINEERING

733 Marquette Avenue
Suite 700
Minneapolis, MN 55402
612.758.3080
www.alliant-inc.com

AMERICAN SQUARE APARTMENTS
BLOOMINGTON, MN
AMERICAN BOULEVARD E. AND 34TH AVE SOUTH
3601 AMERICAN BOULEVARD EAST

FINAL DEVELOPMENT PLAN

TREE INVENTORY

I hereby certify that this plan, specification, or report was prepared by me or under my direct supervision and that I am a duly Licensed PROFESSIONAL ENGINEER under the laws of the State of MINNESOTA

DAVID NASH, PE

12-30-19
Date
License No.

QUALITY ASSURANCE/CONTROL

BY	DATE
DATE	ISSUE
01-29-20	CITY SUBMITTAL
03-27-20	PROGRESS PLOT
05-06-20	REVISED CITY SUBMITTAL

PROJECT TEAM DATA

DESIGNED: DMS/DJN

DRAWN: KDB/DMS

PROJECT NO: 190123

C-2.1



ALLIANT
ENGINEERING

733 Marquette Avenue
Suite 700
Minneapolis, MN 55402
612.758.3080
www.alliant-inc.com

AMERICAN SQUARE APARTMENTS
BLOOMINGTON, MN
AMERICAN BOULEVARD E. AND 34TH AVE SOUTH
3601 AMERICAN BOULEVARD EAST
FINAL DEVELOPMENT PLAN
DEMOLITION PLAN

I hereby certify that this plan, specification, or report was prepared by me or under my direct supervision and that I am a duly Licensed PROFESSIONAL ENGINEER under the laws of the State of MINNESOTA

DAVID NASH, PE
12-30-19
Date License No.

QUALITY ASSURANCE/CONTROL

BY	DATE
DATE	ISSUE
01-29-20	CITY SUBMITTAL
03-27-20	PROGRESS PLOT
05-06-20	REVISED CITY SUBMITTAL

PROJECT TEAM DATA
DESIGNED: DMS/DJN
DRAWN: KDB/DMS
PROJECT NO: 190123



C-3.0

DEMOLITION NOTES:

1. ALL WORK SHALL BE PERFORMED IN ACCORDANCE WITH THESE PLANS AND SPECIFICATIONS AND THE REQUIREMENTS AND STANDARDS OF THE LOCAL GOVERNING AUTHORITY. THE GEOTECHNICAL AND EVALUATION REPORTS AND RECOMMENDATIONS SET FORTH THEREIN ARE A PART OF THE REQUIRED CONSTRUCTION DOCUMENTS AND IN CASE OF CONFLICT SHALL TAKE PRECEDENCE UNLESS SPECIFICALLY NOTED OTHERWISE ON THE PLANS. THE CONTRACTOR SHALL NOTIFY THE CONSTRUCTION MANAGER OF ANY DISCREPANCY BETWEEN GEOTECHNICAL AND EVALUATION REPORTS & PLANS, ETC.
2. NOTIFY GOPHER ONE 48 HOURS PRIOR TO ANY SITE DEMOLITION. CONTRACTOR SHALL VERIFY THE LOCATION OF ALL EXISTING UTILITIES, CONTACT GOPHER STATE ONE CALL (1-800-252-1166) FOR UTILITY LOCATION PRIOR TO DEMOLITION AND CONSTRUCTION.
3. PRIOR TO STARTING CONSTRUCTION, THE CONTRACTOR SHALL BE RESPONSIBLE TO MAKE SURE THAT ALL REQUIRED PERMITS AND APPROVALS HAVE BEEN OBTAINED, NO CONSTRUCTION OR FABRICATION SHALL BEGIN UNTIL THE CONTRACTOR HAS RECEIVED AND THOROUGHLY REVIEWED ALL PLANS AND OTHER DOCUMENTS APPROVED BY ALL OF THE PERMITTING AUTHORITIES. DEMOLITION CONTRACTOR SHALL ALSO FILE FOR ALL NECESSARY PERMITS FOR DEMOLITION WITH THE CITY OF BLOOMINGTON.
4. CONTRACTOR TO COORDINATE THE REMOVAL OF THE EXISTING UTILITIES WITH THE RESPECTIVE UTILITY COMPANIES.
5. DEMOLITION CONTRACTOR SHALL PROVIDE AIR QUALITY CONTROL MEASURES AT THE REQUEST OF COUNTY/CITY HEALTH INSPECTOR/INSPECTIONS OFFICER. DEMOLITION CONTRACTOR SHALL TAKE ALL NECESSARY MEASURES TO KEEP DUST LEVELS TO A MINIMUM.
6. CONTRACTOR SHALL FURNISH ALL NECESSARY FENCING BARRICADES AND SIGNING NEEDED TO PROTECT PEDESTRIANS AND VEHICULAR TRAFFIC FROM HAZARDS RESULTING FROM DIRECTLY OR INDIRECTLY FROM CONSTRUCTION.
7. ALL ITEMS CALLED FOR REMOVAL SHALL BE DISPOSED OF OFF-SITE IN A LOCATION APPROVED BY THE STATE.
8. CONTRACTOR IS RESPONSIBLE FOR DEMOLITION & REMOVAL OF ALL EXISTING STRUCTURES WHICH INTERFERE WITH NEW WORK AS SHOWN IN PROPOSED CONSTRUCTION DRAWINGS.
9. CONTRACTOR SHALL PROTECT ADJOINING PROPERTIES & STRUCTURES FROM HAZARDS ASSOCIATED WITH HIS CONSTRUCTION ACTIVITIES & SHALL BE RESPONSIBLE FOR ALL DAMAGES TO PROPERTIES & STRUCTURES THAT OCCUR AS A RESULT OF THESE ACTIVITIES.
10. CONTRACTOR SHALL NOT IMPEDE EXISTING TRAFFIC CIRCULATION TO ADJACENT BUSINESSES.
11. PROVIDE TEMPORARY TRAFFIC CONTROL IN COMPLIANCE WITH THE MOST CURRENT EDITION OF THE MINNESOTA TEMPORARY TRAFFIC CONTROL ZONE LAYOUTS FIELD MANUAL.
12. DEMOLITION CONTRACTOR SHALL FAMILIARIZE THEMSELVES WITH THE ENVIRONMENTAL REPORTS INCLUDING THE PHASE I REPORT AND FOLLOW REPORT RECOMMENDATIONS.

LEGEND

---	PROPERTY LINE
- - - - -	EASEMENTS
X	REMOVE TREE
+++++	REMOVE CURB AND GUTTER
~~~~~	REMOVE EXISTING UTILITY
~~~~~	CLEARING LIMITS
- - - - -	SAWCUT
	REMOVE BITUMINOUS PAVEMENT/PATH

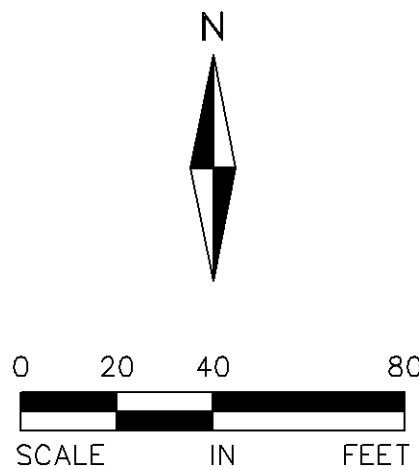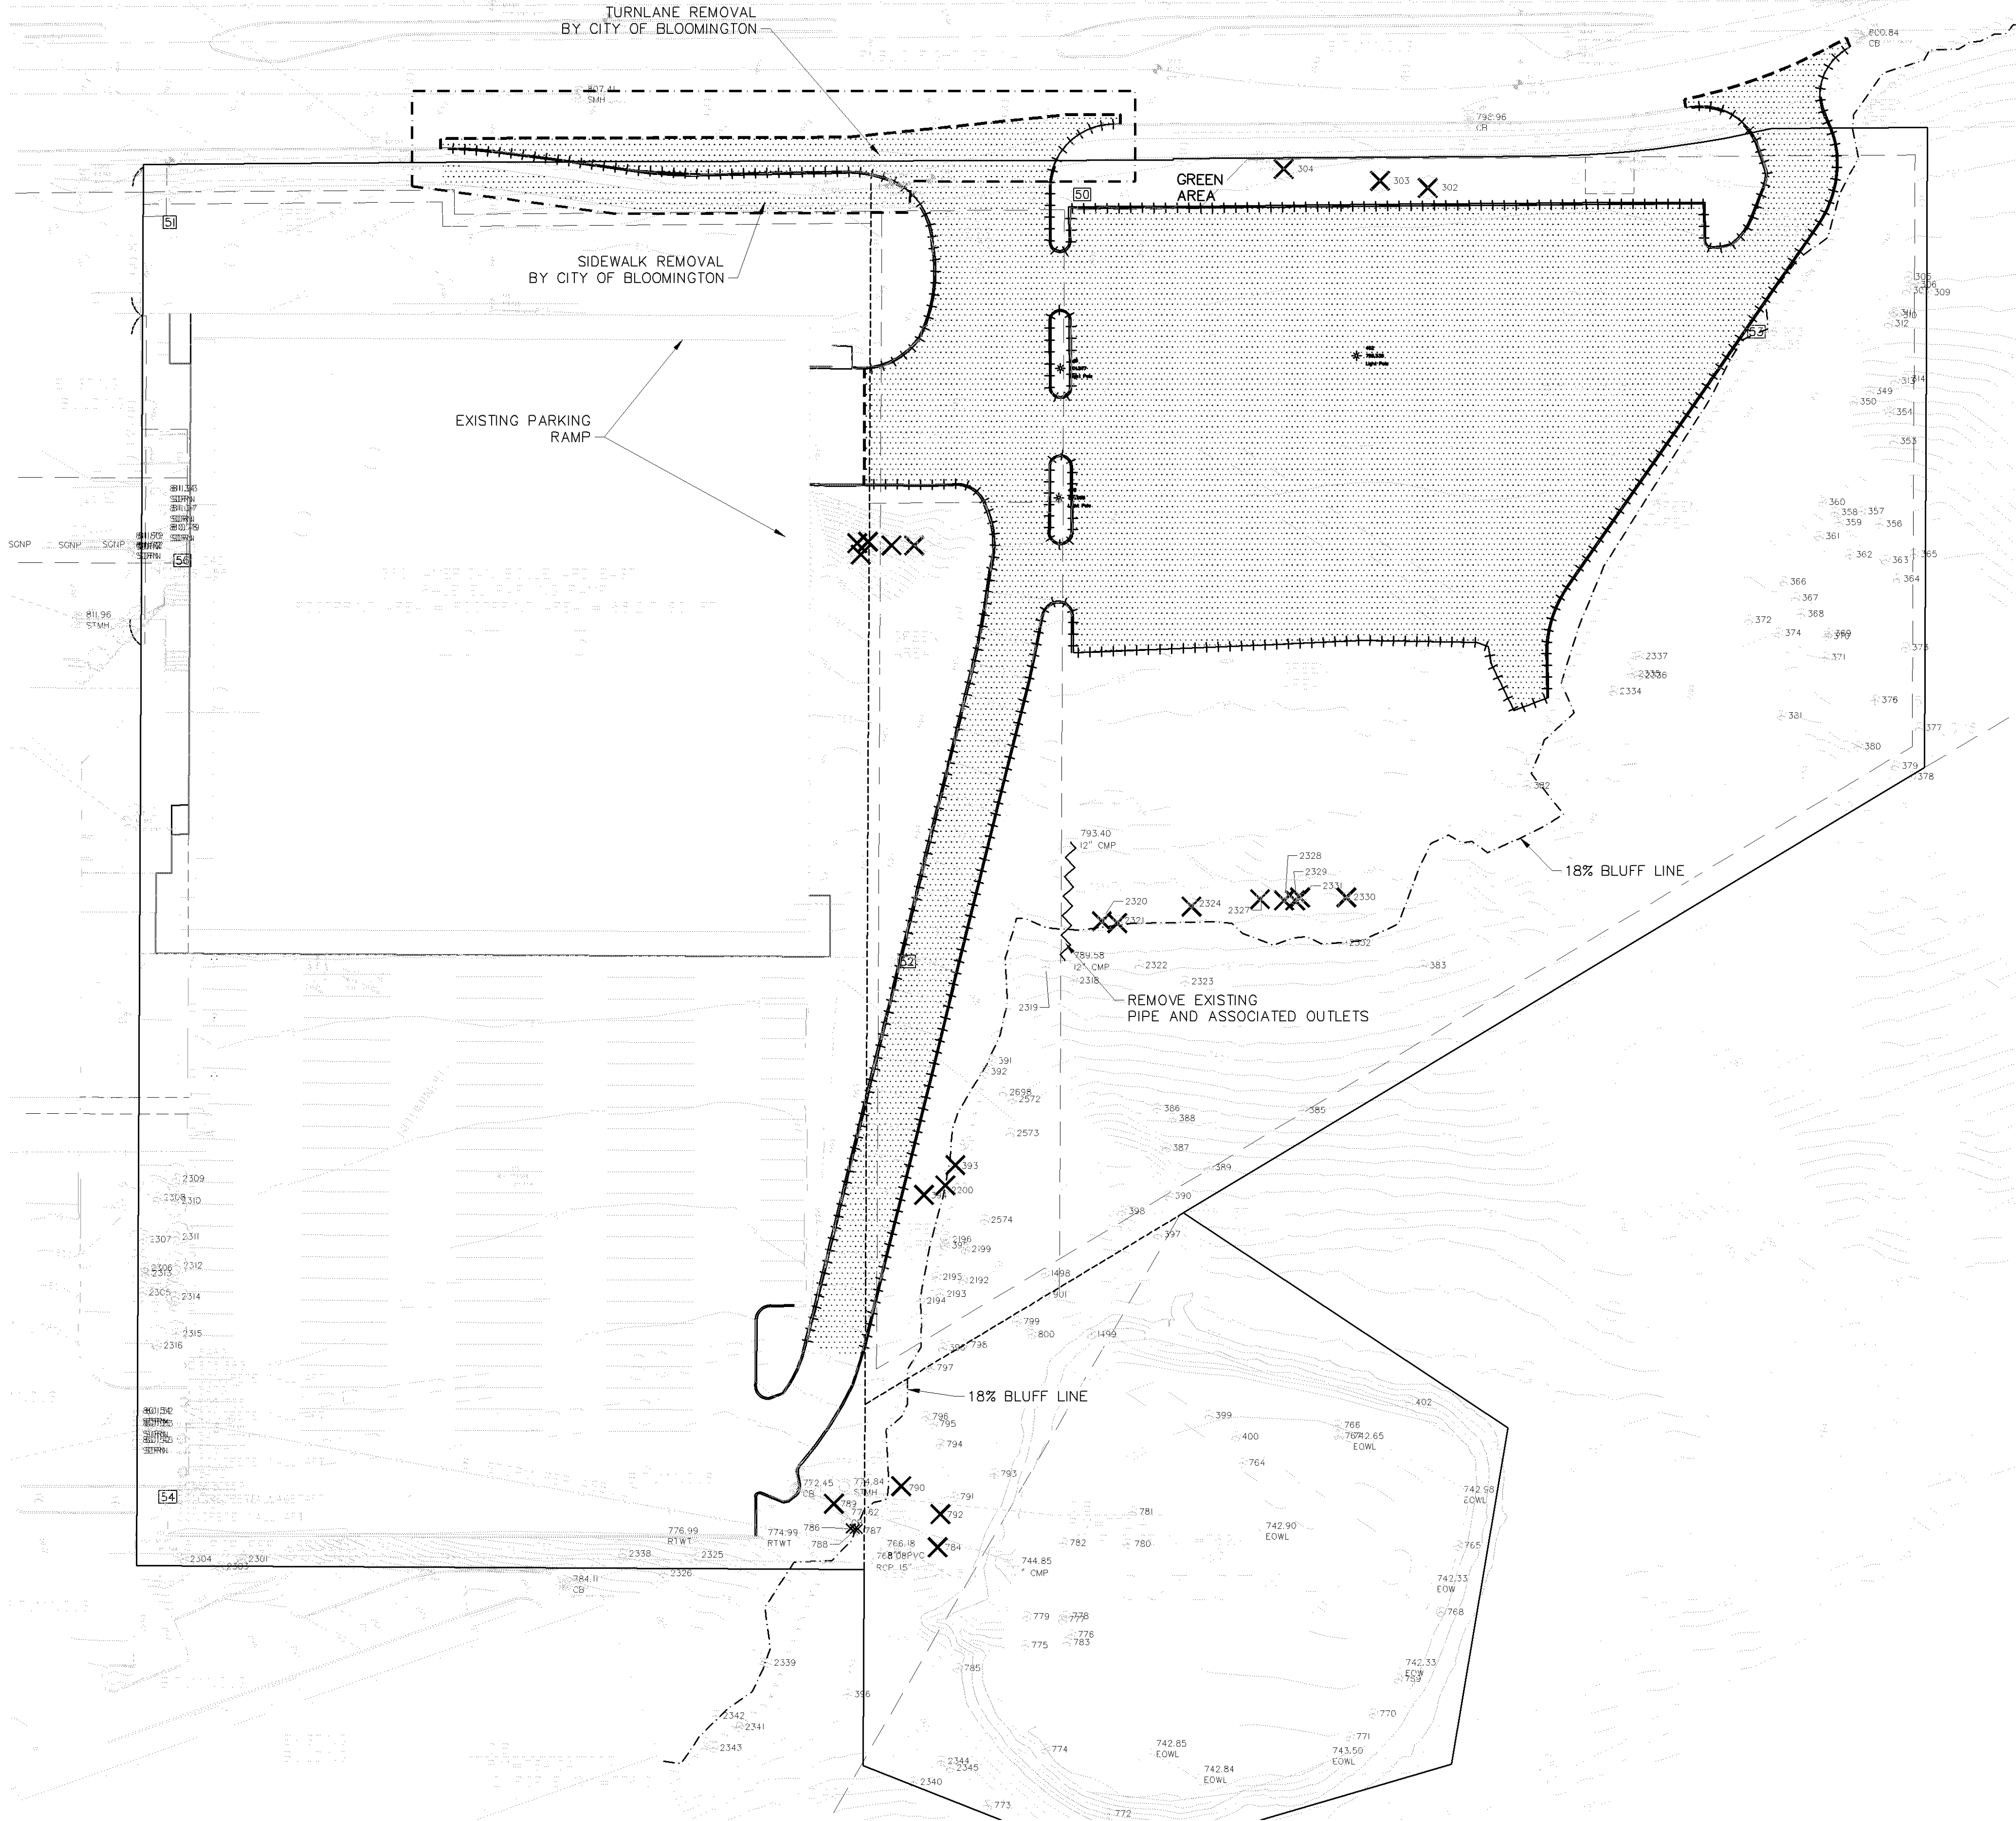

Drawing name: X:\2019\190123\plan sheets\Final Plan Development\190123site.dwg May 06, 2020 — 1:22pm

PL202000083



ALLIANT
ENGINEERING

733 Marquette Avenue
Suite 700
Minneapolis, MN 55402
612.758.3080
www.alliant-inc.com

AMERICAN SQUARE APARTMENTS
BLOOMINGTON, MN
AMERICAN BOULEVARD E. AND 34TH AVE SOUTH
3601 AMERICAN BOULEVARD EAST
FINAL DEVELOPMENT PLAN
SITE PLAN

I hereby certify that this plan, specification, or report was prepared by me or under my direct supervision and that I am a duly Licensed PROFESSIONAL ENGINEER under the laws of the State of MINNESOTA

DAVID NASH, PE
12-30-19
Date License No.

QUALITY ASSURANCE/CONTROL

BY	DATE
DATE	ISSUE
01-29-20	CITY SUBMITTAL
03-27-20	PROGRESS PLOT
05-06-20	REVISED CITY SUBMITTAL

PROJECT TEAM DATA
DESIGNED: DMS/DJN
DRAWN: KDB/DMS
PROJECT NO: 190123

C-4.0

NOTES

- DIMENSIONS ARE TO TOP FACE OF CURB, EDGE OF SIDEWALK OR EXTERIOR OF BUILDING UNLESS OTHERWISE NOTED. REFER TO ARCHITECTURAL DRAWINGS FOR BUILDING DIMENSIONS AND SPECIFICATION FOR LOCATION OF EXITS, RAMPS, CONCRETE APRONS AND STOOPS.
- ALL CONCRETE CURB AND GUTTER ADJACENT TO CONCRETE WALK TO BE SEPARATED BY A 1/2 INCH EXPANSION JOINT.
- ALL STRIPING SHALL BE 4 INCH WHITE PAVEMENT STRIPING, PER GOVERNING AGENCY STANDARDS.
- ALL WORK WITHIN THE R.O.W. SHALL COMPLY WITH THE CITY OF BLOOMINGTON ENGINEERING DESIGN STANDARDS.
- ALL CURB AND GUTTER TO BE CONCRETE B612 CURB UNLESS NOTED OTHERWISE, PER CITY STANDARDS.
- CONTINUOUS CONCRETE CURB & GUTTER WHICH CHANGES TYPE SHALL HAVE A FIVE FOOT TRANSITION.
- BITUMINOUS PAVEMENT SECTION DESIGN TO BE IN ACCORDANCE WITH LOCAL CONSTRUCTION STANDARDS. REFER TO GEOTECHNICAL REPORT AND DETAIL SHEET.
- CONTRACTOR SHALL FIELD VERIFY THE LOCATIONS AND ELEVATIONS OF EXISTING UTILITIES AND TOPOGRAPHIC FEATURES, SUCH AS EXISTING GUTTER GRADES AT THE PROPOSED DRIVEWAYS, PRIOR TO THE START OF SITE GRADING. THE CONTRACTOR SHALL IMMEDIATELY NOTIFY THE ENGINEER OF ANY DISCREPANCIES OF VARIATIONS FROM THE PLANS.
- ACCESSIBLE ROUTE SHALL BE PROVIDED FROM ACCESSIBLE STALLS TO BUILDING ENTRANCE. (SEE MN ACCESSIBILITY CODE). POLE MOUNT APPROVED SIGNS, ONE VAN ACCESSIBLE, CENTER ON STALL, LOCATION PER GENERAL CONTRACTOR. PAINT INTERNATIONAL SYMBOL OF ACCESSIBILITY WHITE ON BLUE BACKGROUND. G.C. TO ENSURE SLOPE OF PAVEMENT AT ACCESSIBLE PARKING STALLS & ACCESS AISLE DOES NOT EXCEED 2% IN ALL DIRECTIONS.
- REFER TO PHOTOMETRIC PLAN FOR LIGHT LOCATIONS, FOOTCANDLE PRINT OUT AND SPECIFICATIONS. FOUNDATION BY CONTRACTOR. CONTRACTOR TO FIELD VERIFY LOCATION OF PROPOSED LIGHT POLE WITH OWNER & G.C. AND THAT THERE ARE NO CONFLICTS WITH EXISTING & PROPOSED UTILITIES.
- CONTRACTOR SHALL BE RESPONSIBLE TO PROVIDE AND INSTALL TRENCHING AND PVC SLEEVING UNDER ANY PAVEMENT AS REQUIRED FOR IRRIGATION, LIGHTING, SIGNS ETC. AS NEEDED PRIOR TO PAVING.

GENERAL NOTES:

- PRIOR TO STARTING CONSTRUCTION, THE CONTRACTOR SHALL BE RESPONSIBLE TO MAKE SURE THAT ALL REQUIRED PERMITS AND APPROVALS HAVE BEEN OBTAINED. NO CONSTRUCTION OR FABRICATION SHALL BEGIN UNTIL THE CONTRACTOR HAS RECEIVED AND THOROUGHLY REVIEWED ALL PLANS AND OTHER DOCUMENTS APPROVED BY ALL OF THE PERMITTING AUTHORITIES.
- ALL WORK SHALL BE PERFORMED IN ACCORDANCE WITH THESE PLANS AND SPECIFICATIONS AND THE REQUIREMENTS AND STANDARDS OF THE LOCAL GOVERNING AUTHORITY.
- CONTRACTOR IS RESPONSIBLE FOR DEMOLITION AND REMOVAL OF ALL EXISTING STRUCTURES WHICH INTERFERE WITH NEW WORK AS SHOWN.
- ALL DIMENSIONS, GRADES, EXISTING AND PROPOSED INFORMATION SHOWN ON THE PLANS SHALL BE FIELD VERIFIED BY THE CONTRACTOR PRIOR TO CONSTRUCTION. CONTRACTOR SHALL NOTIFY THE CONSTRUCTION MANAGER IF ANY DISCREPANCIES EXIST PRIOR TO PROCEEDING WITH CONSTRUCTION FOR NECESSARY PLAN OR GRADE CHANGES. NO EXTRA COMPENSATION SHALL BE PAID TO THE CONTRACTOR FOR WORK HAVING TO BE REDONE DUE TO INFORMATION SHOWN INCORRECTLY ON THESE PLANS IF SUCH NOTIFICATION HAS NOT BEEN GIVEN.
- CONTRACTOR SHALL PROTECT ADJOINING PROPERTIES AND STRUCTURES FROM HAZARDS ASSOCIATED WITH HIS CONSTRUCTION ACTIVITIES & SHALL BE RESPONSIBLE FOR ALL DAMAGES TO PROPERTIES AND STRUCTURES THAT OCCUR AS A RESULT OF THESE ACTIVITIES.
- CONTRACTOR SHALL NOT IMPEDE EXISTING TRAFFIC CIRCULATION TO ADJACENT PROPERTIES.
- CONTRACTOR SHALL PERFORM SWEEPING ON PRIVATE PARKING AREAS AND PUBLIC STREETS AT LEAST ONCE A WEEK, IF NEEDED, AND IN ADVANCE OF ALL RAIN EVENTS.
- CONTRACTOR SHALL BE HELD FULLY RESPONSIBLE TO PREVENT AND ELIMINATE ANY DUST NUISANCE OCCASIONED BY AND DURING CONSTRUCTION, UNTIL THE PROJECT HAS BEEN COMPLETED.
- CONTRACTOR SHALL PROVIDE TEMPORARY STREET SIGNS, LIGHTING, AND ADDRESSES DURING CONSTRUCTION PERIOD.
- ALL PUBLIC SIDEWALKS SHALL NOT BE OBSTRUCTED DURING CONSTRUCTION UNLESS APPROVED BY CITY ENGINEER.
- STORAGE OF MATERIALS OR EQUIPMENT SHALL NOT BE ALLOWED ON PUBLIC STREETS OR WITHIN PUBLIC RIGHT OF WAY.
- CONTRACTOR TO PROVIDE TEMPORARY TRAFFIC CONTROL IN COMPLIANCE WITH MnDOT "TEMPORARY TRAFFIC CONTROL ZONE LAYOUT-FIELD MANUAL, LATEST EDITION, FOR ANY CONSTRUCTION IN PUBLIC ROW.



Know what's below.
Call before you dig.
Dial 811


LEGEND

- EXISTING CURB & GUTTER
- B612 CURB & GUTTER (EXCEPT IN ROW)
- HEAVY DUTY BITUMINOUS PAVING
- 8' BITUMINOUS TRAIL
- CONCRETE SIDEWALK
- CONSTRUCTION LIMITS
- PROPERTY LINE
- BUILDING SETBACK
- 18% SLOPE/BLUFF LINE
- RETAINING WALL (BY OTHERS)
- RETAINING WALL

PARKING NOTES:

- SEE ARCHITECTURAL PLANS FOR PARKING REQUIREMENTS

FOR REVIEW ONLY
PRELIMINARY
NOT FOR CONSTRUCTION

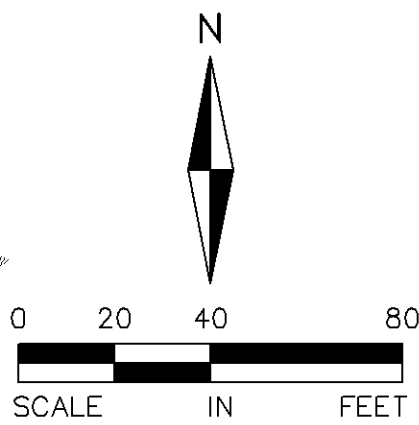

Drawing name: X:\2019\190123\plan sheets\Final Plan Development\190123grad.dwg May 06, 2020 — 1:22pm

PL202000083



ALLIANT
ENGINEERING

733 Marquette Avenue
Suite 700
Minneapolis, MN 55402
612.758.3080
www.alliant-inc.com

AMERICAN SQUARE APARTMENTS
BLOOMINGTON, MN

AMERICAN BOULEVARD E. AND 34TH AVE SOUTH

3601 AMERICAN BOULEVARD EAST

FINAL DEVELOPMENT PLAN

GRADING AND EROSION CONTROL PLAN

GRADING NOTES

1. ALL FINISHED GRADES SHALL SLOPE AWAY FROM PROPOSED BUILDINGS.
2. THE CONTRACTOR SHALL KEEP THE ADJACENT ROADWAYS FREE OF DEBRIS AND PREVENT THE OFF-SITE TRACKING OF SOIL IN ACCORDANCE WITH THE REQUIREMENTS OF COUNTY, CITY AND WATERSHED.
3. NOTIFY GOPHER STATE ONE CALL, AT (800)252-1166, 48 HOURS PRIOR TO START OF CONSTRUCTION.
4. ALL IMPROVEMENTS TO CONFORM WITH CITY CONSTRUCTION STANDARDS SPECIFICATION, LATEST EDITION.
5. ROCK CONSTRUCTION ENTRANCES SHALL BE PROVIDED AT ALL CONSTRUCTION ACCESS POINTS.
6. REFER TO GEOTECHNICAL REPORT AND PROJECT MANUAL, FOR SOIL CORRECTION REQUIREMENTS AND FREQUENT TESTING REQUIREMENTS.
7. STRIP TOPSOIL PRIOR TO ANY CONSTRUCTION. REUSE STOCKPILE ON SITE. STOCKPILE PERIMETERS MUST BE PROTECTED WITH SILT FENCE.
8. PRIOR TO STARTING CONSTRUCTION, THE CONTRACTOR SHALL BE RESPONSIBLE TO MAKE SURE THAT ALL REQUIRED PERMITS AND APPROVALS HAVE BEEN OBTAINED. NO CONSTRUCTION OR FABRICATION SHALL BEGIN UNTIL THE CONTRACTOR HAS RECEIVED AND THOROUGHLY REVIEWED ALL PLANS AND OTHER DOCUMENTS APPROVED BY ALL OF THE PERMITTING AUTHORITIES.
9. IMMEDIATELY FOLLOWING GRADING OF (3:1 OR GREATER) SIDE SLOPES AND DRAINAGE SWALES, WOOD FIBER BLANKET OR OTHER APPROVED SOIL STABILIZING METHOD (APPROVED BY ENGINEER) SHALL BE APPLIED OVER APPROVED SEED MIXTURE AND A MINIMUM OF 4" TOPSOIL.
10. THE GENERAL CONTRACTOR MUST DISCUSS DEWATERING PLANS WITH ALL SUBCONTRACTORS TO VERIFY NPDES REQUIREMENTS. IF DEWATERING IS REQUIRED DURING CONSTRUCTION, CONTRACTOR SHOULD CONSULT WITH EROSION CONTROL INSPECTOR AND ENGINEER TO DETERMINE APPROPRIATE METHOD.
11. REFER TO STORMWATER POLLUTION PREVENTION PLAN (SWPPP) FOR ALL EROSION AND SEDIMENT CONTROL DEVICE LOCATION, DESCRIPTIONS, NOTES AND DETAILS INCLUDING CONCRETE WASHOUT STATION INSTRUCTIONS.
12. BUILDING PERMITS ARE REQUIRED FOR ALL RETAINING WALLS 4 FEET IN HEIGHT OR GREATER AND THE WALLS SHALL BE DESIGNED BY A STRUCTURAL ENGINEER WITH DESIGN REVIEWED AND APPROVED BY THE CITY PRIOR TO INSTALLATION.
13. A 4 FOOT SAFETY RAILING IS REQUIRED ATOP ALL WALLS 30" IN HEIGHT OR GREATER.

LEGEND:

- EXISTING CONTOUR
- PROPOSED CONTOUR
- PROPOSED SPOT ELEVATION
- TOP OF WALL ELEVATION
- BOTTOM OF WALL ELEVATION
- DIRECTION OF DRAINAGE
- EMERGENCY OVERFLOW ROUTING
- RETAINING WALL
- PROPOSED LUMINARIES
- EXISTING CATCH BASINS
- EXISTING STORM SEWER
- PROPOSED CATCH BASINS
- PROPOSED STORM SEWER
- PROPOSED LIMITS OF CONSTRUCTION
- PROPOSED EASEMENT
- PROPERTY LINE
- DRAINAGE DIVIDE
- HEAVY DUTY SILT FENCE
- INLET PROTECTION
- ROCK CONSTRUCTION EXIT
- EROSION CONTROL BLANKET

I hereby certify that this plan, specification, or report was prepared by me or under my direct supervision and that I am a duly Licensed PROFESSIONAL ENGINEER under the laws of the State of MINNESOTA

DAVID NASH, PE

12-30-19

Date

License No.

QUALITY ASSURANCE/CONTROL

BY	DATE
DATE	ISSUE
01-29-20	CITY SUBMITTAL
03-27-20	PROGRESS PLOT
05-06-20	REVISED CITY SUBMITTAL

PROJECT TEAM DATA

DESIGNED:	DMS/DJN
DRAWN:	KDB/DMS
PROJECT NO:	190123

C-5.0

FOR REVIEW ONLY
PRELIMINARY
NOT FOR CONSTRUCTION



0 20 40 80
SCALE IN FEET



ALLIANT
ENGINEERING

733 Marquette Avenue
Suite 700
Minneapolis, MN 55402
612.758.3080
www.alliant-inc.com

AMERICAN SQUARE APARTMENTS
BLOOMINGTON, MN
AMERICAN BOULEVARD E. AND 34TH AVE SOUTH
3601 AMERICAN BOULEVARD EAST
FINAL DEVELOPMENT PLAN
EROSION CONTROL, SWPPP, AND BLUFF PROTECTION NOTES

ACTIVE SWPPP LEGEND

CONSTRUCTION SEQUENCE	APR	MAY	JUN	JUL	AUG	SEP	OCT	NOV	DEC	JAN	FEB	MAR	APR
MULCH BERM													
FIBER ROLLS / MULCH SOCKS													
SILT FENCE													
TEMPORARY MULCH COVER													
TEMPORARY HYDROMULCH													
EROSION CONTROL BLANKET													
ROCK DRIVEWAY / ROCK PADS													
INLET PROTECTION DEVICES													
PAVEMENT (DRIVEWAY/ROADS)													
SOD													
STOCKPILES													

NOTE: CONTRACTOR, GENERAL CONTRACTOR OR SWPPP INSPECTOR TO COMPLETE TABLE AS GRADING PROGRESSES

SEDIMENT BARRIERS 1. SILT FENCE (MnDOT 3886) 2. CURB LOG 3. ROCK WEEPER 4. SEDIMENT LOGS	TEMPORARY SEED MIX 1. MN STATE SEED MIX 21-112 (WINTER WHEAT COVER CROP) 2. MN STATE SEED MIX 22-111 (OATS COVER CROP)	STABILIZATION BMP'S 1. EROSION CONTROL BLANKET MnDOT CATEGORY 5	GRADING ACTIVITY 1. CONCRETE WASHOUT IS DONE TRUCK BY TRUCK WITH A MOBILE WASHOUT SYSTEM PROVIDED AND COMPLETED BY THE CONCRETE CONTRACTOR.
INLET PROTECTION DEVICES 1. WINCO (MnDOT TYPE A & C) 2. INFRASAFE STORM DRAIN/CULVERT	PERMANENT SEED MIX/STABILIZATION 1. MN STATE SEED MIX 23-151 (RESIDENTIAL TURF) 2. SOD	PERTINENT PERMITS: 1. CITY OF BLOOMINGTON GRADING PERMIT 2. NPDES	
ANTI-TRACKING CONTROL 1. CRUSHED CLEAR ROCK (LAND DEVELOPMENT)			

IMPAIRED WATER

SPECIAL REQUIREMENT:

THE MINNESOTA RIVER IS CLASSIFIED AS AN IMPAIRED WATER. THE FOLLOWING REQUIREMENTS APPLY FOR THIS PROJECT:

PERMITTEES MUST IMMEDIATELY INITIATE STABILIZATION OF EXPOSED SOIL AREAS, AS DESCRIBED IN ITEM 8.4. AND COMPLETE THE STABILIZATION WITHIN SEVEN (7) CALENDAR DAYS AFTER CONSTRUCTION ACTIVITY IN THAT PORTION OF THE SITE TEMPORARILY OR PERMANENTLY CEASES.

PERMITTEES MUST PROVIDE A TEMPORARY SEDIMENT BASIN AS DESCRIBED IN SECTION 14 FOR COMMON DRAINAGE LOCATIONS THAT SERVE AN AREA WITH FIVE (5) OR MORE ACRES DISTURBED AT ONE TIME.

ALSO, A MANDATORY STORMWATER POLLUTION PREVENTION PLAN (SWPPP) REVIEW IS REQUIRED BY THE MPCA IF THE PROJECT WILL DISTURB OVER 50 ACRES AND HAS A DISCHARGE POINT ON THE PROJECT WITHIN 1 MILE (ACRUAL RADIUS MEASUREMENT) OF AND FLOWS TO THE IMPAIRED WATERWAY. SWPPP REVIEW SHALL BE COMPLETED BY THE CONTRACTOR AND SUBMITTED TO THE MPCA AT LEAST 10-DAYS BEFORE THE CONSTRUCTION START DATE. SWPPP REVIEW SHALL BE ATTACHED TO THE SWPPP AND USED FOR THE ONLINE APPLICATION.

POLLUTION PREVENTION MANAGEMENT MEASURES

THE CONTRACTOR SHALL IMPLEMENT THE FOLLOWING POLLUTION PREVENTION MANAGEMENT MEASURES ON THE SITE:

1. STORAGE, HANDLING, AND DISPOSAL OF CONSTRUCTION PRODUCTS, MATERIALS, AND WASTES: THE CONTRACTOR SHALL COMPLY WITH THE FOLLOWING TO MINIMIZE THE EXPOSURE TO STORMWATER OF ANY OF THE PRODUCTS, MATERIALS, OR WASTES. PRODUCTS OR WASTES WHICH ARE EITHER NOT A SOURCE OF CONTAMINATION TO STORMWATER OR ARE DESIGNED TO BE EXPOSED TO STORMWATER ARE NOT HELD TO THIS REQUIREMENT:

a. BUILDING PRODUCTS THAT HAVE THE POTENTIAL TO LEACH POLLUTANTS MUST BE UNDER COVER (E.G., PLASTIC SHEETING OR TEMPORARY ROOFS) TO PREVENT THE DISCHARGE OF POLLUTANTS OR PROTECTED BY A SIMILARLY EFFECTIVE MEANS DESIGNED TO MINIMIZE CONTACT WITH STORMWATER.

b. PESTICIDES, HERBICIDES, INSECTICIDES, FERTILIZERS, TREATMENT CHEMICALS, AND LANDSCAPE MATERIALS MUST BE UNDER COVER (E.G., PLASTIC SHEETING OR TEMPORARY ROOFS) TO PREVENT THE DISCHARGE OF POLLUTANTS OR PROTECTED BY SIMILARLY EFFECTIVE MEANS DESIGNED TO MINIMIZE CONTACT WITH STORMWATER.

c. HAZARDOUS MATERIALS, TOXIC WASTE, INCLUDING OIL, DIESEL FUEL, GASOLINE, HYDRAULIC FLUIDS, ANT SOLVENTS, PETROLEUM-BASED PRODUCTS, WOOD PRESERVATIVES, ADDITIVES, CURING COMPOUNDS, AND ACIDS) MUST BE PROPERLY STORED IN SEALED CONTAINERS TO PREVENT SPILLS, LEAKS OR OTHER DISCHARGE. RESTRICTED ACCESS STORAGE AREAS MUST BE PROVIDED TO PREVENT VANDALISM, STORAGE AND DISPOSAL OF HAZARDOUS WASTE. PREVENT OR HAZARDOUS MATERIALS MUST BE IN COMPLIANCE WITH MINN. R. CH. 7045 INCLUDING SECONDARY CONTAINMENT AS APPLICABLE.

d. SOLID WASTE MUST BE STORED, COLLECTED AND DISPOSED OF PROPERLY IN COMPLIANCE WITH MINN. R. CH. 7035.

e. PORTABLE TOILETS MUST BE POSITIONED SO THAT THEY ARE SECURE AND WILL NOT BE TIPPED OR KNOCKED OVER. SANITARY WASTE MUST BE DISPOSED OF PROPERLY IN ACCORDANCE WITH MINN. R. CH. 7041.

2. FUELING AND MAINTENANCE OF EQUIPMENT OR VEHICLES: SPILL PREVENTION AND RESPONSE: THE CONTRACTOR SHALL TAKE REASONABLE STEPS TO PREVENT THE DISCHARGE OF SPILLED OR LEAKED CHEMICALS, INCLUDING FUEL, FROM ANY AREA WHERE CHEMICALS OR FUEL WILL BE LOADED OR UNLOADED INCLUDING, BUT NOT LIMITED TO, FUELING OPERATIONS. IF IT IS INFEASIBLE, THE CONTRACTOR MUST CONDUCT FUELING IN A CONTAINED AREA UNLESS THE CONTRACTOR MUST ENSURE ADEQUATE SUPPLIES ARE AVAILABLE AT ALL TIMES TO CLEAN UP DISCHARGED MATERIALS AND THAT AN APPROPRIATE DISPOSAL METHOD IS AVAILABLE FOR RECOVERED SPILLED MATERIALS. THE CONTRACTOR MUST REPORT AND CLEAN UP SPILLS IMMEDIATELY AS REQUIRED BY MINN. STAT. § 118.061, USING DRY CLEAN UP MEASURES WHERE POSSIBLE.

3. VEHICLE AND EQUIPMENT WASHING: IF THE CONTRACTOR WASH THE EXTERIOR OF VEHICLES OR EQUIPMENT ON THE PROJECT SITE, WASHING MUST BE LIMITED TO A DEFINED AREA OF THE SITE. RUNOFF FROM THE WASHING AREA MUST BE CONTAINED IN A SEDIMENT BASIN OR OTHER SIMILARLY EFFECTIVE CONTROLS AND THE WASHING ACTIVITY MUST BE PROPERLY DISPOSED OF. THE CONTRACTOR MUST PROPERLY USE AND STORE SOAPS, DETERGENTS, OR SOLVENTS. NO ENGINE DEGRADING IS ALLOWED ON SITE.

4. CONCRETE AND OTHER WASHOUTS WASTE: THE CONTRACTOR MUST PROVIDE EFFECTIVE CONTAINMENT FOR ALL LIQUID AND SOLID WASTES GENERATED BY WASHOUT OPERATIONS (CONCRETE, STUCCO, PAINT, FORM RELEASE OILS, CURING COMPOUNDS AND OTHER CONSTRUCTION MATERIALS) RELATED TO THE CONSTRUCTION ACTIVITY. THE LIQUID AND SOLID WASHOUT WASTES MUST NOT CONTACT THE GROUND, AND THE CONTAINMENT MUST BE DESIGNED SO THAT IT DOES NOT RESULT IN RUNOFF FROM THE WASHOUT OPERATIONS OR AREAS. LIQUID AND SOLID WASTES MUST BE DISPOSED OF PROPERLY AND IN COMPLIANCE WITH MPCA RULES. A SIGN MUST BE INSTALLED ADJACENT TO EACH WASHOUT FACILITY THAT REQUIRES SITE PERSONNEL TO UTILIZE THE PROPER FACILITIES FOR DISPOSAL OF CONCRETE AND OTHER WASHOUT WASTES.

FINAL STABILIZATION

THE CONTRACTOR MUST ENSURE FINAL STABILIZATION OF THE SITE. FINAL STABILIZATION IS NOT COMPLETE UNTIL ALL REQUIREMENTS OF ITEMS 13.2-13.7 BELOW:

13.2 PERMITTEES MUST COMPLETE ALL CONSTRUCTION ACTIVITY AND MUST INSTALL PERMANENT COVER OVER ALL AREAS PRIOR TO SUBMITTING THE NOT. VEGETATIVE COVER MUST CONSIST OF A UNIFORM PERENNIAL VEGETATION WITH A DENSITY OF 70 PERCENT OF ITS EXPECTED FINAL GROWTH. VEGETATION IS NOT REQUIRED WHERE THE FUNCTION OF A SPECIFIC AREA DICTATES NO VEGETATION, SUCH AS IMPERVIOUS SURFACES OR THE BASE OF A SAND FILTRATION.


13.3 PERMITTEES MUST CLEAN THE PERMANENT STORMWATER TREATMENT SYSTEM OF ANY ACCUMULATED SEDIMENT AND MUST ENSURE THE SYSTEM MEETS ALL APPLICABLE REQUIREMENTS IN SECTION 15 THROUGH 19 AND IS OPERATING AS DESIGNED.

13.4 PERMITTEES MUST REMOVE ALL SEDIMENT FROM CONVEYANCE SYSTEMS PRIOR TO SUBMITTING THE NOTICE OF TERMINATION (NOT).

13.5 PERMITTEES MUST REMOVE ALL TEMPORARY SYNTHETIC EROSION PREVENTION AND SEDIMENT CONTROL BMPs PRIOR TO SUBMITTING THE NOT. PERMITTEES MAY LEAVE BMPs DESIGNED TO DECOMPOSE ON-SITE IN PLACE.

13.6 FOR RESIDENTIAL CONSTRUCTION ONLY, PERMIT COVER TERMINATES ON INDIVIDUAL LOTS IF THE STRUCTURES ARE FINISHED AND TEMPORARY EROSION PREVENTION AND DOWNGRADE PERMETER CONTROL IS COMPLETE. THE RESIDENCE SELLS TO THE HOMEOWNER, AND THE PERMITTEE DISTRIBUTES THE MPCA'S HOMEOWNER FACT SHEET TO THE HOMEOWNER.

13.7 FOR CONSTRUCTION PROJECTS ON AGRICULTURAL LAND (E.G., PIPELINES ACROSS CROPLAND), PERMITTEES MUST RETURN THE DISTURBED LAND TO ITS PRECONSTRUCTION AGRICULTURAL USE PRIOR TO SUBMITTING THE NOT.

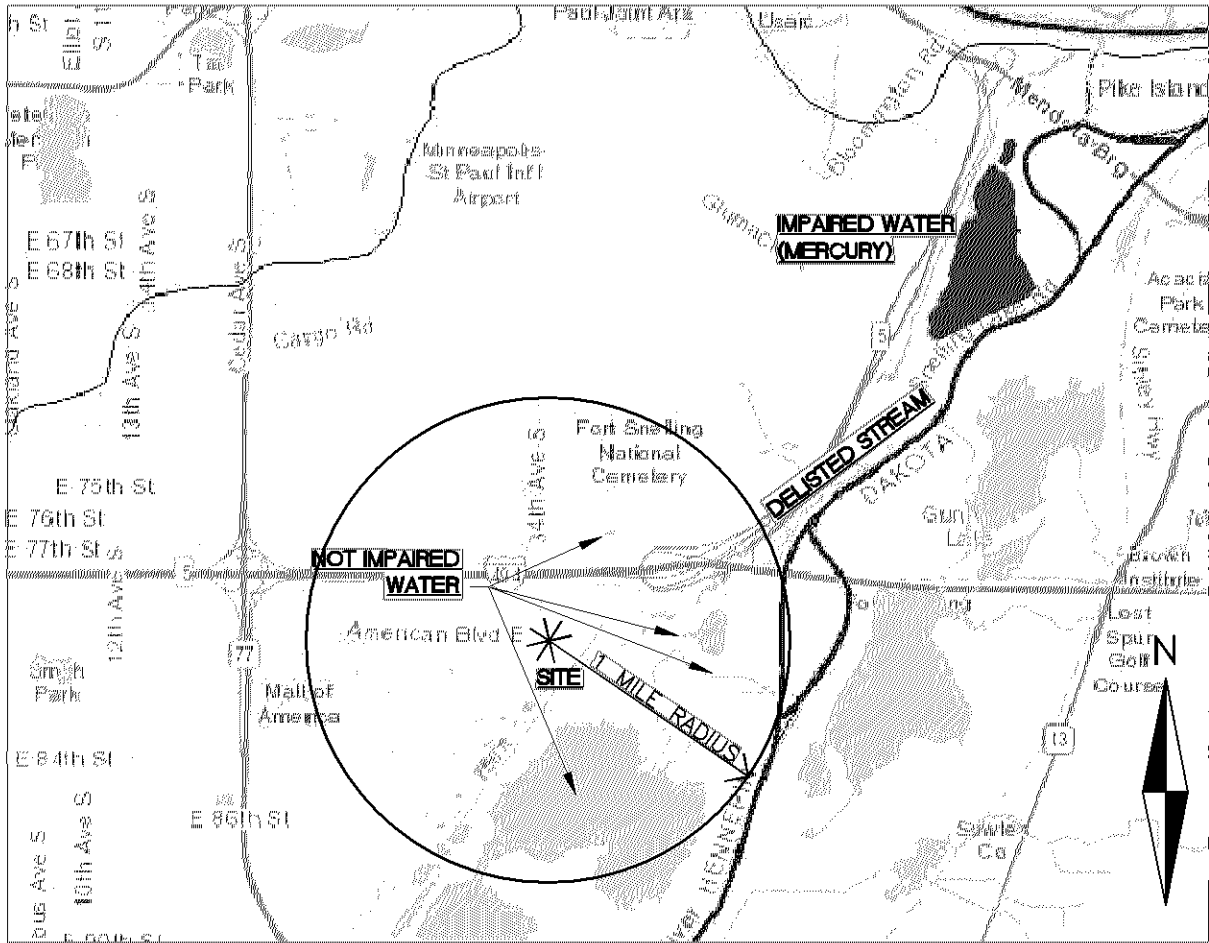

USGS TOPOGRAPHIC MAP



WEB SOIL SURVEY MAP

Map Unit Symbol	Map Unit Name	Acres in AGI	Percent of AGI
DSD	Diesel-Two Inlets complex, 12 to 18 percent slopes	0.9	10.3%
GP	Pis, gravel-Louisianams complex	1.3	15.4%
L2ZF	Hawok heavy sand, 20 to 40 percent slopes	3.6	44.1%
U4A	Urban land-Louisianams (cut and fill land) complex, 0 to 2 percent slopes	2.6	30.2%
Totals for Area of Interest		6.7	100.0%

WEB SOIL SURVEY LEGEND

EROSION CONTROL GENERAL NOTES:

1. NO LAND DISTURBING ACTIVITY SHALL OCCUR UNTIL A GRADING PERMIT HAS BEEN ISSUED FROM THE CITY OF BLOOMINGTON.
2. BEST MANAGEMENT PRACTICES (BMP'S) REFER TO EROSION AND SEDIMENT CONTROL PRACTICES DEFINED BY THE MPCA PROTECTING WATER QUALITY IN URBAN AREAS AND THE MINNESOTA CONSTRUCTION SITE EROSION AND SEDIMENT CONTROL PLANNING HANDBOOK.
3. ALL BMP'S SELECTED SHALL BE APPROPRIATE FOR THE TIME OF YEAR, SITE CONDITIONS, AND ESTIMATED DURATION OF USE.
4. ALL WORK AND MATERIALS SHALL BE CONSTRUCTED ACCORDING TO THE APPROVED PLANS, ANY DEVIATION FROM THE APPROVED PLANS SHALL REQUIRE WRITTEN APPROVAL FROM THE ENGINEER OF RECORD.
5. A COPY OF THESE PLANS MUST BE ON THE JOB SITE WHENEVER CONSTRUCTION IS IN PROGRESS.
6. THE BOUNDARIES OF THE LAND DISTURBANCE LIMITS SHOWN ON THE PLANS SHALL BE CLEARLY FLAGGED IN THE FIELD PRIOR TO CONSTRUCTION. NO DISTURBANCE ALLOWED BEYOND THE DISTURBED LIMITS.
7. WHEREVER POSSIBLE, PRESERVE THE EXISTING TREES, GRASS, AND OTHER VEGETATIVE COVER TO HELP FILTER RUNOFF.
8. ESTABLISH A PERMANENT VEGETATIVE COVER ON ALL EXPOSED SOILS WHERE LAND IS COMING OUT OF AGRICULTURAL PRODUCTION. PLANT AS SOON AS POSSIBLE TO ESTABLISH DENSE GRASS FILTER PRIOR TO CONSTRUCTION AND TO MINIMIZE WEED GROWTH.
9. ALL TREES NOT LISTED FOR REMOVAL SHALL BE PROTECTED. DO NOT OPERATE EQUIPMENT WITHIN THE DRIPLINE, ROOT ZONES OR WITHIN TREE PROTECTION FENCE AREAS.
10. ALL EROSION AND SEDIMENT CONTROL FACILITIES (BMP'S) SHALL BE INSTALLED AND IN OPERATION PRIOR TO LAND DISTURBANCE ACTIVITIES AND THEY SHALL BE SATISFACTORILY MAINTAINED UNTIL CONSTRUCTION IS COMPLETED AND THE POTENTIAL FOR EROSION HAS PASSED.
11. SILT FENCE IS REQUIRED AT DOWN GRADIENT PERIMETER OF DISTURBED AREAS AND STOCKPILES. PROTECT ADJACENT WATERBODIES AND ADJACENT PROPERTIES FROM SEDIMENTATION AND STORM WATER RUNOFF.
12. THE BMP'S SHOWN ON THE PLANS ARE THE MINIMUM REQUIREMENTS FOR THE ANTICIPATED SITE CONDITIONS. AS CONSTRUCTION PROGRESSES AND UNEXPECTED OR SEASONAL CONDITIONS DICTATE, THE PERMITTEE/CONTRACTOR SHALL ANTICIPATE THAT MORE BMP'S WILL BE NECESSARY TO ENSURE EROSION AND SEDIMENT CONTROL ON THE SITE DURING THE COURSE OF CONSTRUCTION. IT IS THE RESPONSIBILITY OF THE PERMITTEE/CONTRACTOR TO ADDRESS ANY NEW CONDITIONS THAT MAY BE CREATED BY CONSTRUCTION ACTIVITIES AND/OR CLIMATIC EVENTS AND TO PROVIDE ADDITIONAL BMP'S OVER AND ABOVE THE MINIMUM REQUIREMENTS SHOWN ON THE PLANS, AS MAY BE NEEDED TO PROVIDE EFFECTIVE PROTECTION OF WATER AND SOIL RESOURCES.
13. THE BMP'S SHALL BE INSPECTED DAILY BY THE PERMITTEE/CONTRACTOR AND MAINTAINED AS NECESSARY TO ENSURE THEIR CONTINUED FUNCTIONING. SILT FENCES SHALL BE CLEANED OR REPLACED AT SEDIMENT BUILDUP OF 1/3 OF THE FENCE HEIGHT.
14. LAND DISTURBING ACTIVITIES SHALL OCCUR IN INCREMENTS OF WORKABLE SIZE SUCH THAT ADEQUATE BMP CONTROL CAN BE PROVIDED THROUGHOUT ALL PHASES OF CONSTRUCTION. THE SMALLEST PRACTICAL AREA SHALL BE EXPOSED OR OTHERWISE DISTURBED AT ANY ONE TIME.
15. OPERATE TRACK EQUIPMENT (DOZER) UP AND DOWN EXPOSED SOIL SLOPES ON FINAL PASS, LEAVING TRACK GROOVES PERPENDICULAR TO THE SLOPE. DO NOT BACK-BLADE. LEAVE A SURFACE ROUGH TO MINIMIZE EROSION.
16. ALL AREAS DISTURBED BY CONSTRUCTION SHALL BE STABILIZED FROM EROSION WITHIN 7 DAYS OF SUBSTANTIAL COMPLETION OF GRADING IN THAT AREA. TEMPORARY SEED AND MULCH SHALL COVER ALL EXPOSED SOILS IF GRADING COMPLETION IS DELAYED LONGER THAN 7 DAYS. PERMANENT SEED AND MULCH OR SOD IS REQUIRED WITHIN 3 DAYS OF COMPLETION OF FINAL GRADING.
17. GENERAL TEMPORARY SEED SHALL BE MN STATE SEED MIX 22-112 @ 40 LBS. PER ACRE OR APPROVED EQUAL. PERMANENT SEED SHALL BE MN STATE SEED MIX 25-151 @ 120 LBS. PER ACRE OR APPROVED EQUAL. (PLANTING DATES PER MNOOT SEED MIX MANUAL) MULCH SHALL BE MNOOT TYPE 1 (CLEAN CUT STRAW) @ 2 TONS PER ACRE AND DISK ANCHORED IN PLACE OR APPROVED EQUAL. FERTILIZER SHALL BE 10-10-10 NPK PER ACRE (UNLESS P RESTRICTIONS APPLY) AND INCORPORATED INTO THE SEED BED.
18. ALL TEMPORARY EROSION AND SEDIMENT CONTROL MEASURES SHALL BE PROPERLY DISPOSED OF WITHIN THIRTY (30) DAYS AFTER FINAL SITE STABILIZATION IS ACHIEVED OR AFTER THE TEMPORARY MEASURES ARE NO LONGER NEEDED.
19. ALL CONSTRUCTION SITE WASTE SUCH AS DISCARDED BUILDING MATERIALS, CONCRETE TRUCK WASHOUT, CHEMICALS, LITTER, AND SANITARY WASTE MUST BE PROPERLY MANAGED AND COMPLY WITH THE MPCA AND THE CITY OF BLOOMINGTON RULES AND REQUIREMENTS.

DEWATERING:

1. IF UTILITY INSTALLATION WORK ENCOUNTERS GROUNDWATER, THE CONTRACTOR SHALL PROVIDE A PLAN TO THE CITY AND PROJECT ENGINEER FOR REVIEW. THE PLAN MUST BE SUBMITTED TO THE CITY FOR APPROVAL AT LEAST 10 DAYS PRIOR TO DISCHARGING INTO RECEIVING WATERS. THE PLAN AT MINIMUM SHALL INCLUDING A DEWATERING SYSTEM, WATER ROUTING, STORAGE, AND DISCHARGE LOCATION. THE DEWATERING PLAN MUST ENSURE THAT DISCHARGE WATER IS FREE OF SEDIMENT AND TURBID WATER IN ACCORDANCE WITH STATE AND LOCAL PERMIT REQUIREMENTS.
2. IF ANY TEMPORARY DEWATERING IS REQUIRED, THE CONTRACTOR SHALL DISPOSE OF STORMWATER OR GROUND WATER BY USE OF PUMPS AND HOSES TO ACCEPTABLE DISCHARGE POINTS APPROVED BY THE CITY AND PROJECT ENGINEER.
3. ANY ACCUMULATED SEDIMENT ALONG EXISTING CURB AND GUTTER THAT HAS COLLECTED AS A RESULT OF DISCHARGING DEWATERING HOSES SHALL BE IMMEDIATELY REMOVED AND PROPERLY DISPOSED OF AFTER EACH DISCHARGING EVENT.

FILTRATION BMP NOTES:

1. INSTALLATION OF INFILTRATION/FILTRATION PRACTICES SHALL BE DONE DURING PERIODS OF DRY WEATHER AND COMPLETED BEFORE A RAINFALL EVENT. PLACEMENT OF ENGINEERED SOILS SHALL BE ON DRY NATIVE SOIL ONLY.
2. EXCAVATION OF INFILTRATION AREAS SHALL BE COMPLETED USING A BACKHOE WITH A TIGHTENED BUCKET.
3. THE BOTTOM EXCAVATION SURFACE OF INFILTRATION AREAS SHALL BE LEVEL WITHOUT DIPS OR SWALES.
4. DURING CONSTRUCTION, STORM WATER MUST BE ROUTED AROUND INFILTRATION AREAS UNTIL ALL CONSTRUCTION ACTIVITY HAS CEASED AND TRIBUTARY SURFACES ARE CLEANED OF SEDIMENT.
5. ENGINEERED SOIL SHALL REMAIN UNCONTAMINATED (NOT MIXED WITH OTHER SOIL) BEFORE AND DURING INSTALLATION.

EROSION CONTROL SCHEDULE:

1. PRIOR TO ANY CONSTRUCTION OR DEMOLITION, SILT FENCE AND FILTERS SHALL BE INSTALLED AS SHOWN IN INTERIOR RUNOFF.
2. CONTRACTOR SHALL INSTALL EROSION CONTROL DEVICES AS INDICATED ON THIS EROSION CONTROL PLAN AND ANY ADDITIONAL REQUIRED BASED ON MEANS, METHODS AND SEQUENCES OF CONSTRUCTION.
3. ALL EROSION CONTROL INSTALLATIONS SHALL REMAIN IN PLACE AND BE MAINTAINED IN GOOD CONDITION BY THE CONTRACTOR UNTIL THE SITE HAS BEEN RE-VEGETATED. CONTRACTOR MAY REMOVE NECESSARY SILT FENCES/FILTERS TO CONSTRUCT ROADS/WAYS, WHILE MAINTAINING ADEQUATE EROSION CONTROL IN ADJACENT AREA.
4. SUFFICIENT TOPSOIL SHALL BE STOCKPILED TO ALLOW FOR THE REPLACEMENT OF 6" OF TOPSOIL FOR DISTURBED AREAS TO BE RE-VEGETATED.
5. SOIL COMPACTION SHALL BE MINIMIZED IN PROPOSED PERVIOUS AREAS ON SITE AND AVOID ALTOGETHER IN PROPOSED INFILTRATION BASINS. SOIL SURFACES OF PROPOSED PERVIOUS AREAS COMPACTED DURING CONSTRUCTION SHALL BE DECOMPACTED THROUGH SOIL AMENDMENT OR DEEP RIPPING TO AN 18" DEPTH.
6. THE CONTRACTOR SHALL SCHEDULE SITE GRADING, UTILITY INSTALLATION AND PAVEMENT CONSTRUCTION SO THAT THE GENERAL SITE CAN BE MULCHED AND RE-SEEDED SOON AFTER DISTURBANCE. AREAS THAT WILL NOT BE SUBJECT TO CONSTRUCTION TRAFFIC SHALL BE SEEDED (MN STATE SEED MIX 22-112 @ 40 LBS/AC AND MULCHED OR SODDED WITHIN SEVEN (7) DAYS OF BEING DISTURBED.

SEDIMENT CONTROL PRACTICES

1. THE CONTRACTOR MUST EMPLOY SEDIMENT CONTROL PRACTICES AS NECESSARY TO MINIMIZE SEDIMENT FROM ENTERING SURFACE WATERS, INCLUDING CURB AND GUTTER SYSTEMS AND STORM SEWER INLETS.
 - a. TEMPORARY OR PERMANENT DRAINAGE DITCHES AND SEDIMENT BASINS THAT ARE DESIGNED AS PART OF A SEDIMENT CONTAINMENT SYSTEM (E.G., DITCHES WITH ROCK-CHECK DAMS) REQUIRE SEDIMENT CONTROL PRACTICES ONLY AS APPROPRIATE FOR SITE CONDITIONS.
 - b. THE DOWN GRADIENT SEDIMENT CONTROLS ARE OVERLOADED (BASED ON FREQUENT FAILURE OR EXCESSIVE MAINTENANCE REQUIREMENT), THE CONTRACTOR MUST INSTALL ADDITIONAL UPGRADED SEDIMENT CONTROL PRACTICES OR REDUNDANT BMP'S TO ELIMINATE THE OVERLOADING, AND THE SWPPP MUST BE AMENDED TO IDENTIFY THESE ADDITIONAL PRACTICES AS REQUIRED IN PART II.B 1.3.
2. SEDIMENT CONTROL PRACTICES MUST BE ESTABLISHED ON ALL DOWN GRADIENT PERIMETERS AND BE LOCATED UPGRADEMENT OF ANY BUFFER ZONES. THE PERIMETER SEDIMENT CONTROL PRACTICES MUST BE IN PLACE BEFORE ANY UPGRADEMENT LAND DISTURBING ACTIVITIES BEGIN. THESE PRACTICES SHALL REMAIN IN PLACE UNTIL FINAL STABILIZATION HAS BEEN ESTABLISHED IN ACCORDANCE WITH PART I.V.G. A FLOATING SILT CURTAIN PLACED IN THE WATER IS NOT A SEDIMENT CONTROL BMP TO SATISFY PERIMETER CONTROL REQUIREMENTS IN THIS PART. EXCEPT WHEN WORKING ON A SHORELINE AND BELOW THE WATERLINE. IN THOSE CASES, A FLOATING SILT CURTAIN CAN BE USED AS A PERIMETER CONTROL PRACTICE IF THE FLOATING SILT CURTAIN IS INSTALLED AS CLOSE TO SHORE AS POSSIBLE. IMMEDIATELY AFTER THE SHORT TERM CONSTRUCTION ACTIVITY (E.G. INSTALLATION OF RIP RAP ALONG THE SHORELINE) IN THAT AREA IS COMPLETE, AN UPLAND PERIMETER CONTROL PRACTICE MUST BE INSTALLED IF EXPOSED SOILS STILL DRAIN TO THE SURFACE WATER.
3. THE CONTRACTOR SHALL REINSTATE ALL SEDIMENT CONTROL PRACTICES THAT HAVE BEEN ADJUSTED OR REMOVED TO ACCOMMODATE SHORT-TERM ACTIVITIES SUCH AS CLEARING OR GRUBBING, OR PASSAGE OF VEHICLES. IMMEDIATELY AFTER THE SHORT-TERM ACTIVITY HAS BEEN COMPLETED, THE CONTRACTOR SHALL COMPLETE ANY SHORT-TERM ACTIVITY THAT REQUIRES REMOVAL OF SEDIMENT CONTROL PRACTICES AS QUICKLY AS POSSIBLE. THE CONTRACTOR MUST REINSTATE SEDIMENT CONTROL PRACTICES BEFORE THE NEXT PRECIPITATION EVENT EVEN IF THE SHORT-TERM ACTIVITY IS NOT COMPLETE.

4. ALL STORM DRAIN INLETS MUST BE PROTECTED BY APPROPRIATE BMPs DURING CONSTRUCTION UNTIL ALL SOURCES WITH POTENTIAL FOR DISCHARGING TO THE STREET HAVE BEEN STABILIZED. INLET PROTECTION MAY BE REMOVED FOR A PARTICULAR INLET IF A SPECIFIC SAFETY CONCERN (STREET FLOODING/FREEZING) HAS BEEN IDENTIFIED BY THE CONTRACTOR OR THE JURISDICTIONAL AUTHORITY (E.G., CITY/COUNTY/TOWNSHIP/AND/OR ENGINEER). THE CONTRACTOR MUST DOCUMENT THE NEED FOR REMOVAL IN THE SWPPP.
5. TEMPORARY SILT STOCKPILES MUST HAVE SILT FENCE OR OTHER EFFECTIVE SEDIMENT CONTROLS, AND CANNOT BE PLACED IN ANY NATURAL BUFFERS OR SURFACE WATERS, INCLUDING STORMWATER DITCHES, CATCH BASINS, AND GUTTER SYSTEMS, OR CONDUITS AND DITCHES UNLESS THERE IS A BYPASS IN PLACE FOR THE STORMWATER.
6. WHERE VEHICLE TRAFFIC LEAVES ANY PART OF THE SITE (OR ONTO PAVED ROADS WITHIN THE SITE):
 - a. THE CONTRACTOR MUST INSTALL A VEHICLE TRACKING BMP TO MINIMIZE THE TRACK OUT OF SEDIMENT FROM THE CONSTRUCTION SITE. EXAMPLES OF VEHICLE TRACKING BMP'S INCLUDE, BUT ARE NOT LIMITED TO: ROCK PADS, MUD MATS, SLASH MULCH, CONCRETE OR STEEL WASH RACKS, OR EQUIVALENT SYSTEMS.
 - b. THE CONTRACTOR MUST USE STREET SWEEPING IF SUCH VEHICLE TRACKING BMP'S ARE NOT ADEQUATE TO PREVENT SEDIMENT FROM BEING TRACKED ONTO THE STREET (SEE PART I.V.E.5.D.).

7. THE CONTRACTOR MUST INSTALL TEMPORARY SEDIMENTATION BASINS AS REQUIRED IN PART II.C. OF THIS PERMIT.
8. THE CONTRACTOR MUST MINIMIZE SOIL COMPACTION AND, UNLESS INFEASIBLE, PRESERVE TOPSOIL. MINIMIZING SOIL COMPACTION IS NOT RECOMMENDED WHERE THE FUNCTION OF A SPECIFIC AREA OF THE SITE DICTATES THAT IT BE COMPACTED.
9. THE CONTRACTOR MUST PRESERVE A 50 FOOT NATURAL BUFFER OR (IF A BUFFER IS INFEASIBLE ON THE SITE) PROVIDE REDUNDANT SEDIMENT CONTROLS WHEN A SURFACE WATER IS LOCATED WITHIN 50 FEET OF THE PROJECT'S EARTH DISTURBANCES AND STORMWATER FLOWS TO THE SURFACE WATER. NATURAL BUFFERS ARE NOT REQUIRED ADJACENT TO ROAD DITCHES, JUDICIAL DITCHES, COUNTRY DITCHES, STORMWATER CONVEYANCE CHANNELS, STORM DRAIN INLETS, AND SEDIMENT BASINS. THE CONTRACTOR IS/ARE NOT REQUIRED TO ENHANCE THE QUALITY OF THE VEGETATION THAT ALREADY EXISTS IN THE BUFFER OR PROVIDE VEGETATION IF NONE EXISTS. HOWEVER, CONTRACTOR CAN IMPROVE THE NATURAL BUFFER WITH VEGETATION.
10. IF THE CONTRACTOR INTEND TO USE POLYMERS, FLOCCULANTS, OR OTHER SEDIMENTATION TREATMENT CHEMICALS ON THE PROJECT SITE, THE CONTRACTOR MUST COMPLY WITH THE FOLLOWING MINIMUM REQUIREMENTS:
 - a. THE CONTRACTOR MUST USE CONVENTIONAL EROSION AND SEDIMENT CONTROLS PRIOR TO CHEMICAL ADDITION TO ENSURE EFFECTIVE TREATMENT. CHEMICALS MAY ONLY BE APPLIED AFTER TREATED STORMWATER IS DIRECTED TO A SEDIMENT CONTROL SYSTEM WHICH ALLOWS FOR FILTRATION OR SETTLEMENT OF THE FLOC PRIOR TO DISCHARGE.
 - b. CHEMICALS MUST BE SELECTED THAT ARE APPROPRIATELY SUITED TO THE TYPES OF SOILS LIKELY TO BE EXPOSED DURING CONSTRUCTION, AND TO THE EXPECTED TURBIDITY, PH, AND FLOW RATE OF STORMWATER FLOWING INTO THE CHEMICAL TREATMENT SYSTEM OR AREA.
 - c. CHEMICALS MUST BE USED IN ACCORDANCE WITH ACCEPTED ENGINEERING PRACTICES, AND WITH DOSING SPECIFICATIONS AND SEDIMENT REMOVAL DESIGN SPECIFICATIONS PROVIDED BY THE MANUFACTURER OR PROVIDER/SUPPLIER OF THE APPLICABLE CHEMICALS.


WINTER STABILIZATION:

- GRADING CONTRACTOR REQUIREMENTS IN THE CASE WHERE THE ONSET OF WINTER DOES NOT ALLOW FOR COMPLETION OF MASS GRADING AND FINAL SOIL STABILIZATION FOR THE FALL:
 1. MASS GRADING ACTIVITIES SHALL BE PLANNED AND PHASED IN A MANNER TO AVOID ANY UNNECESSARY SOIL DISTURBANCE PRIOR TO WINTER SHUT DOWN.
 2. ALL FINAL GRADED AREAS SHALL BE STABILIZED PERMANENTLY BY GRADING CONTRACTOR WITH SEEDING, MULCHING, BLANKET, ETC. IN ACCORDANCE WITH PLANS PRIOR TO CONTRACTOR LEAVING THE SITE AT WINTER SHUT DOWN.
 3. THE GRADING CONTRACTOR IS RESPONSIBLE TO ENSURE THAT ALL TEMPORARY OR INCOMPLETE GRADING AREAS INCLUDING ALL STOCKPILES ARE STABILIZED WITH TEMPORARY SEEDING (MN STATE SEED MIX 22-112 @ 40/AC, MULCH (MNOOT TYPE 1) BEFORE LEAVING THE SITE AT WINTER SHUT DOWN.
 4. ALL SIGNIFICANT DRAINAGE SWALES (TEMPORARY OR PERMANENT) SHALL BE STABILIZED WITH MNOOT CATEGORY 3 EROSION CONTROL BLANKET BY GRADING CONTRACTOR PRIOR TO LEAVING THE SITE AT WINTER SHUT DOWN.

Drawing name: X:\2019\190123\plan sheets\Final Plan Development\190123util.dwg May 06, 2020 1:22pm

LEGEND:

	PROPOSED STORM SEWER		PROPOSED HYDRANT
	PROPOSED SANITARY GRAVITY SEWER		PROPOSED LIMITS OF CONSTRUCTION
	PROPOSED SANITARY FORCEMAIN		PROPOSED EASEMENT
	PROPOSED WATERMAIN		EXISTING STORM SEWER
	PROPOSED STORM CATCH BASIN /MANHOLE		EXISTING SANITARY SEWER
	PROPOSED SANITARY MANHOLE		EXISTING WATERMAIN
	PROPOSED BUTTERFLY/GATE VALVE		EXISTING SANITARY MANHOLE
	PROPOSED SUBGRADE DRAIN TILE		EXISTING STORM MANHOLE/CATCH BASIN
			EXISTING EASEMENTS

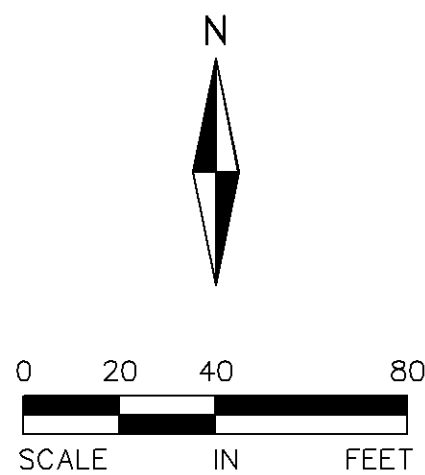

EXISTING 12" WATERMAIN

The existing water line feeding the hydrant is actually an 8" service to the property with an 8" valve and a 8x6 tee for the hydrant. If the 8" service isn't big enough for the water loop just replace the valve and Tee (with a 90 bend), add an 8 x 6 reducer and install a new hydrant in the location out of the new turn lane. Don't change the 12" x 8" tee, or extensive shutdowns and testing old pipe will be required. A new larger tap for the service loop (located just east of this point) would be less disruptive.

Show Tapping valve here second valve not needed.

SAWCUT, REMOVE AND REPLACE WITH MATCHING BITUMINOUS SECTION

CONNECT TO EXISTING STRUCTURE
RIM=798.99
CORE CUT 15" INV S=794.05
EX 12" INV W=793.8
EX 18" INV N=793.8
EX 24" INV E=793.3

48 LF - 15" RCP @ 0.4%

EXISTING HYDRANT

FIELD VERIFY EXISTING 8" STUB LOCATION AND INVERT

Make sure sewer is 10' from hydrant.

RELOCATE EXISTING HYDRANT (3FT B.O.C.)

ADS YARD DRAIN
RIM=803.0
6" PVC INV=798.0

CB 112 (4FT BUILD)

SAN MH 5

8" SAN STUB

C-900 PVC SANITARY FORCEMAIN

CB 109 (4FT BUILD)

CONSTRUCT CBMH 300 ON EXISTING 18" RAMP OUTLET PIPE
RIM=778.40
(FIELD VERIFY) 18" INV=771.54

STUB WATERMAIN FOR FUTURE LOOPING

SAN MH 3
SAN MH 2

ABANDON IN PLACE EXISTING 18" RAMP OUTLET DRAIN

FIELD VERIFY 8" OUTLET MAINTAINED, CONNECT TO CBMH 102 IF NECESSARY

10" SAN SERVICE 2

SAN MH 1

RD 3

CBMH 103

CBMH 102 WITH 4' SUMP

CBMH 101

RESTORE SLOPE WITH EROSION CONTROL FABRIC

FES 100 W/ RIPRAP

CONNECT TO EXISTING 12" MAIN WITH 10" WET TAP, REPLACE HYDRANT, LEAD, AND TEE

412 LF 10" PVC WM

CBMH 111

8" SAN SERVICE 1

10" COMBINED FIRE AND DOMESTIC WATER SERVICE

TEE AND GV, TYP.

HYDRANT AND G.V., TYP.

CBMH 110

FIRE DEPT. CONNECTION

10" SAN SERVICE 1

RD 2

CBMH 107

TRENCH DRAIN

CBMH 106

CBMH 105

LIFT STATION, TO BE DESIGNED BY OTHERS

CBMH 104

FFE = 804.0'

Water main to be DIP

8" SAN SERVICE 1

10" COMBINED FIRE AND DOMESTIC WATER SERVICE

TRENCH DRAIN, BY OTHERS (REFER TO PLUMBING PLANS)

Water main to be DIP

San Services shall be SDR 26 or Sch 40

Use 3 phase power for LS Work with Power Co.

PROVIDE DETAILS SHOWING HOW IS THIS ROUTED TO THE STORM SEWER.

PROVIDE SUMP MANHOLES AT ROOF DRAIN CONNECTIONS AS PER STORMWATER REPORT.

PROVIDE SAFI BAFFLE FOR PRETREATMENT AT INFILTRATION BASIN.

There are at least 8 water pipe crossings please show all to avoid conflicts.



Know what's below. Call before you dig. Dial 811

SANITARY SEWER SCHEDULE:

FROM MH	TO	PIPE O.D. [IN]	PIPE SLOPE [FT/FT]	PIPE LENGTH [FT]	INVERT FROM	INVERT TO	RIM ELEV	STRUCTURE SIZE [IN]	MANHOLE BUILD [FT]	PIPE TYPE
SAN MH6	EX SAN MH	8	0.004	25.7	801.30	801.20	805.75	48	4.45	SDR-35 PVC
8" SAN SERV 1	SAN MH5	8	0.028	103.3	796.00	793.08	N/A	N/A	N/A	SDR-35 PVC
8" SAN STUB	SAN MH6	8	0.028	9.2	793.35	793.09	N/A	N/A	N/A	SDR-35 PVC
SAN MH5	SAN MH4	10	0.057	166.9	792.98	783.42	801.98	48	9.00	SDR-35 PVC
10" SAN SERV 1	SAN MH4	10	0.019	28.1	783.50	782.96	N/A	N/A	N/A	SDR-35 PVC
SAN MH4	SAN MH3	10	0.055	69.8	782.86	779.04	794.37	48	11.51	SDR-35 PVC
SAN MH3	SAN MH2	10	0.055	21.2	778.94	777.78	792.38	48	13.44	SDR-35 PVC
10" SAN SERV 2	SAN MH1	8	0.004	6.3	773.45	773.42	N/A	N/A	N/A	SDR-35 PVC
SAN MH1	SAN MH2	8	0.004	128.7	773.32	772.81	779.27	48	5.95	SDR-35 PVC
SAN MH2	LIFT STATION	10	0.055	5.8	772.71	772.39	792.94	48	20.23	SDR-35 PVC

STORM SEWER SCHEDULE:

MH/CB FROM	TO	P. DIA. [IN]	P. SLOPE S [%]	P. TYPE	PIPE LENGTH [FT]	FROM INVERT	TO INVERT	RIM ELEV	STR. TYPE	CAST TYPE	BUILD (FT)
RD 1	EX MH	15	0.004	RCP	48.1	794.2	794.0				
CB 112	CBMH 111	12	0.040	HDPE	45.0	797.7	795.9	801.7	2x3	R-3067-V	4.0
CBMH 111	CBMH 110	12	0.040	HDPE	137.6	795.9	790.4	802.3	48	R-3067-V	6.4
CBMH 110	CBMH 108	12	0.040	HDPE	16.6	790.4	789.7	799.6	48	R-3067-V	9.2
CB 109	CBMH 108	12	0.040	HDPE	35.2	794.2	792.8	798.2	2x3	R-3067-V	4.0
CBMH 108	CBMH 107	12	0.020	HDPE	49.5	792.8	791.8	798.9	48	R-3067-V	6.1
RD 2	CBMH 107	12	0.018	HDPE	10.2	787.0	786.8				
CBMH 107	CBMH 106	12	0.030	HDPE	34.3	786.8	785.8	791.9	48	R-3067-V	5.0
CBMH 300	CBMH 106	18	0.010	HDPE	32.0	771.5	771.2	778.4	48	R-4342	6.9
CBMH 106	CBMH 105	18	0.015	HDPE	33.0	771.2	770.7	791.3	48	R-3067-V	20.1
CBMH 105	CBMH 104	18	0.020	HDPE	42.2	770.7	769.9	789.1	48	R-3067-V	18.4
CBMH 104	CBMH 103	18	0.060	HDPE	131.9	769.9	762.0	789.0	48	R-1642	23.2
RD 3	CBMH 103	12	0.049	HDPE	8.1	785.0	784.6				
CBMH 103	CBMH 102	18	0.080	HDPE	56.3	762.0	757.5	776.6	48	R-1642	14.6
CBMH 102	CBMH 101	18	0.085	HDPE	19.8	757.5	755.8	771.2	48	R-1642	17.8
CBMH 101	FES 100	27	0.022	HDPE	39.9	745.8	744.9	760.1	48	R-1642	18.3

PIPE CROSSING SCHEDULE:

CROSSING	PIPE ABOVE	PIPE BELOW	ELEV. ABOVE	ELEV. BELOW	DISTANCE BETWEEN
A	STORM	SANITARY	795.26	793.84	1.41'

NOTES

- EXISTING UTILITIES, SERVICE LOCATIONS AND ELEVATIONS SHALL BE VERIFIED IN FIELD PRIOR TO CONSTRUCTION.
- MAINTAIN A MIN. 18" VERTICAL SEPARATION AT ALL PIPE CROSSINGS. LOWER WATERMAIN AS NECESSARY W/ BENDS AND FITTINGS. WATER AND SANITARY SEWER LINES TO MAINTAIN 10' HORIZONTAL SEPARATION.
- CONTRACTOR IS RESPONSIBLE FOR ALL PERMITS PRIOR TO THE START OF CONSTRUCTION.
- PROVIDE POLYSTYRENE INSULATION FOR ALL STORM SEWER AND WATERMAIN CROSSINGS WHERE VERTICAL OR HORIZONTAL SEPARATION IS LESS THAN 3'.
- ALL UTILITY WORK WITHIN THE R.O.W. SHALL COMPLY WITH CITY OF BLOOMINGTON ENGINEERING GUIDELINES.
- NOTIFY GOPHER STATE ONE CALL 48 HOURS IN ADVANCE OF ANY UTILITY WORK.
- PROVIDE TEMPORARY TRAFFIC CONTROL IN COMPLIANCE WITH MNDOT "TEMPORARY TRAFFIC CONTROL ZONE LAYOUTS-FIELD MANUAL" LATEST REVISION, FOR ANY CONSTRUCTION WITHIN PUBLIC R.O.W.
- ALL STORM SEWER CASTINGS SHALL BE NEENAH OR APPROVED EQUAL.
- ALL SANITARY SEWER MANHOLES SHALL BE 48" DIAMETER AND HAVE NEENAH CASTING UNLESS OTHERWISE NOTED ON THE PLAN.
- WATERMAIN, SERVICES, AND VALVES SHALL BE INSTALLED WITH MINIMUM 8.0' OF COVER.
- ALL 8" WATERMAIN SHALL BE P-9 C900. ALL PVC C900 WATERMAIN SHALL BE INSTALLED WITH TRACER WIRE (COPPERHEAD INDUSTRIES OR APPROVED EQUAL).
- ALL SANITARY SERVICES SHALL BE PVC SDR 35 OF THE SIZE NOTED ON THE PLAN. ALL SANITARY FORCEMAIN TO BE C-900 PVC. SIZE TO BE DETERMINED BY OTHERS.
- CONTRACTOR TO VERIFY ALL BUILDING CONNECTION POINTS WITH ARCHITECTURAL PLANS.
- ALL STORM SEWER (EXCEPT TO FLARED END SECTIONS) SHALL BE ADS N-12 UNLESS OTHERWISE SPECIFIED ON THE PLAN. STORM SEWER TO FLARED END SECTIONS SHALL BE RCP.
- ALL ROOF DRAINS (RD) SHALL HAVE AN AT GRADE DOWNSPOUT OVERFLOW.
- ALL ROOF WATER SHALL BE ROUTED TO THE SOUTH FILTRATION BASIN PER THE APPROVED STORMWATER MANAGEMENT PLAN.
- MAINTAIN AND VERIFY 10' HORIZONTAL SEPARATION IS PROVIDED BETWEEN ALL WATERMAIN AND CATCHBASIN/MANHOLES.
- CONTRACTOR TO COORDINATE ALL REQUIRED WATER MAIN SHUT-OFF WITH CITY OF BLOOMINGTON AND CONTACT PROPERTY OWNERS.
- CONTRACTOR TO ORDER AND PAY CITY FOR ALL WET TAPS ON SITE.



ALLIANT
ENGINEERING

733 Marquette Avenue
Suite 700
Minneapolis, MN 55402
612.758.3080
www.alliant-inc.com

AMERICAN SQUARE APARTMENTS

BLOOMINGTON, MN
AMERICAN BOULEVARD E. AND 34TH AVE SOUTH

FINAL DEVELOPMENT PLAN

UTILITY PLAN

I hereby certify that this plan, specification, or report was prepared by me or under my direct supervision and that I am a duly Licensed PROFESSIONAL ENGINEER under the laws of the State of MINNESOTA

DAVID NASH, PE

12-30-19 Date 21836 License No.

QUALITY ASSURANCE/CONTROL

BY	DATE
DATE	ISSUE
01-29-20	CITY SUBMITTAL
03-27-20	PROGRESS PLOT
05-06-20	REVISED CITY SUBMITTAL

PROJECT TEAM DATA

DESIGNED: DMS/DJN
DRAWN: KDB/DMS
PROJECT NO: 190123

C-6.0



ALLIANT
ENGINEERING

733 Marquette Avenue
Suite 700
Minneapolis, MN 55402
612.758.3080
www.alliant-inc.com

AMERICAN SQUARE APARTMENTS
BLOOMINGTON, MN
3601 AMERICAN BOULEVARD EAST
FINAL DEVELOPMENT PLAN
DETAILS

I hereby certify that this plan, specification, or report was prepared by me or under my direct supervision and that I am a duly Licensed PROFESSIONAL ENGINEER under the laws of the State of MINNESOTA

DAVID NASH, PE


12-30-19
Date License No.

QUALITY ASSURANCE/CONTROL


BY	DATE
DATE	ISSUE
01-29-20	CITY SUBMITTAL
03-27-20	PROGRESS PLOT
05-06-20	REVISED CITY SUBMITTAL

PROJECT TEAM DATA
DESIGNED: DMS/DJN
DRAWN: KDB/DMS
PROJECT NO: 190123

C-7.1

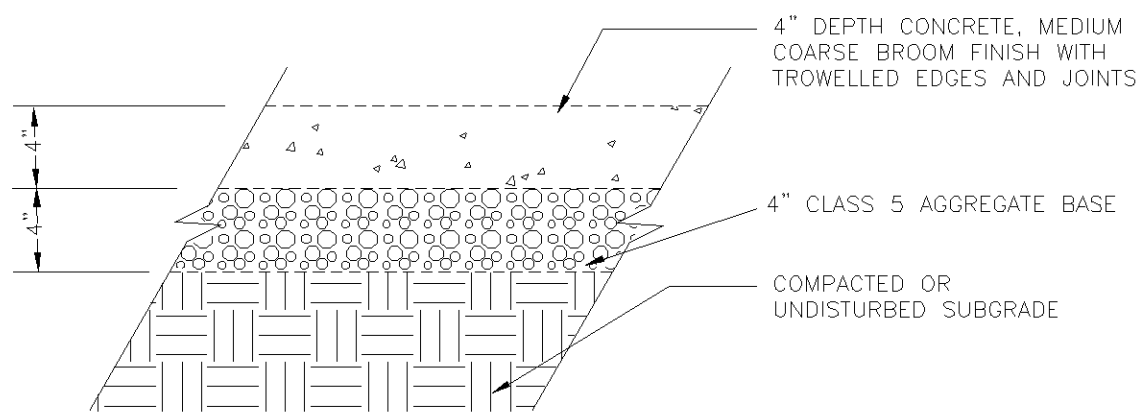


4 CONCRETE SIDEWALK
NOT TO SCALE

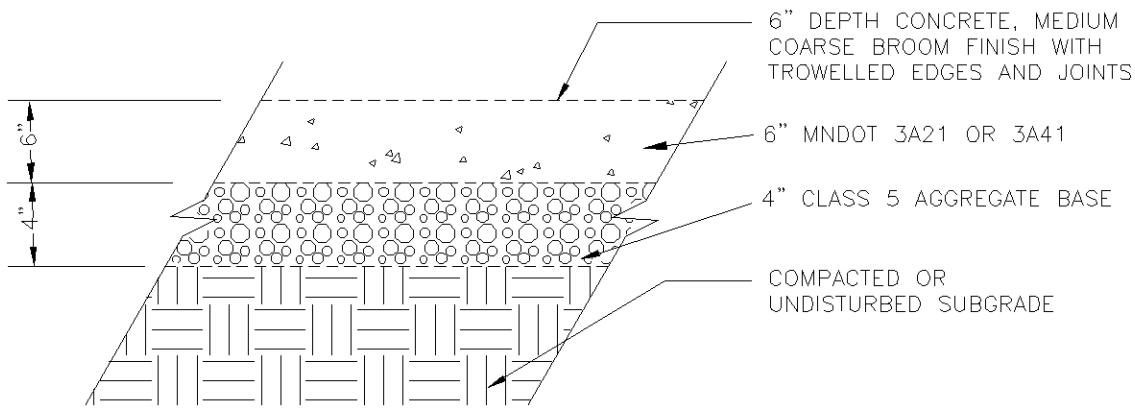


*GEOTECH TO VERIFY FINAL DESIGN

5 CONCRETE PAVEMENT
NOT TO SCALE

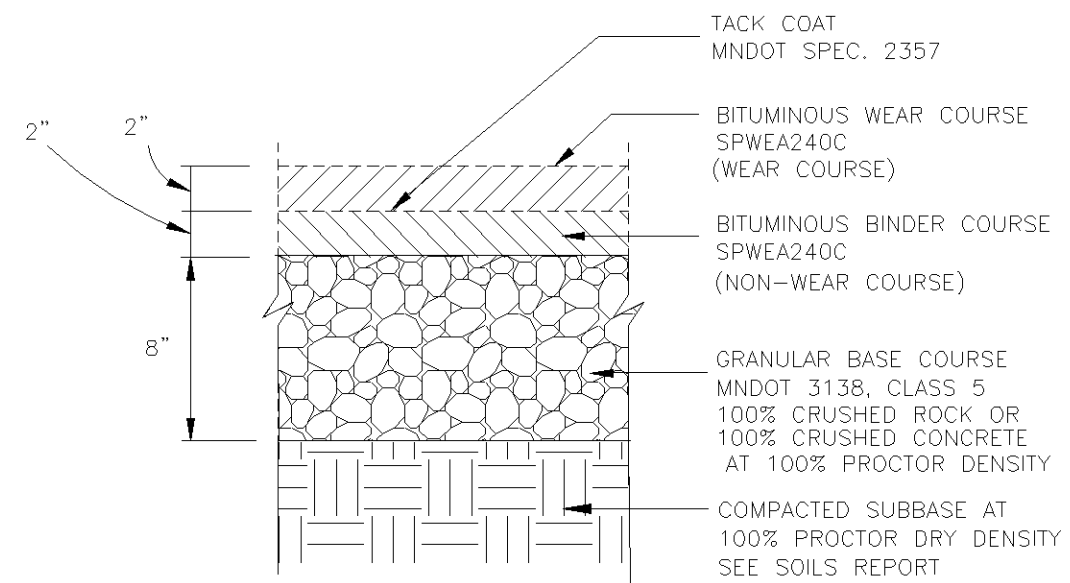


*GEOTECH TO VERIFY FINAL DESIGN

6 LIGHT-DUTY BITUMINOUS PAVEMENT
SOILS REPORT SUPERSEDES ABOVE SPEC NOT TO SCALE

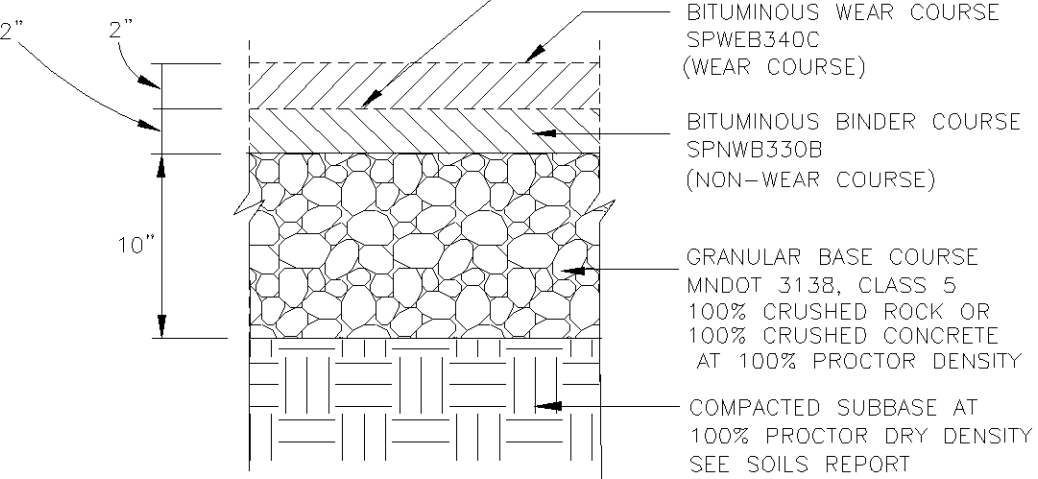


*GEOTECH TO VERIFY FINAL DESIGN


7 HEAVY-DUTY BITUMINOUS PAVEMENT
SOILS REPORT SUPERSEDES ABOVE SPEC NOT TO SCALE

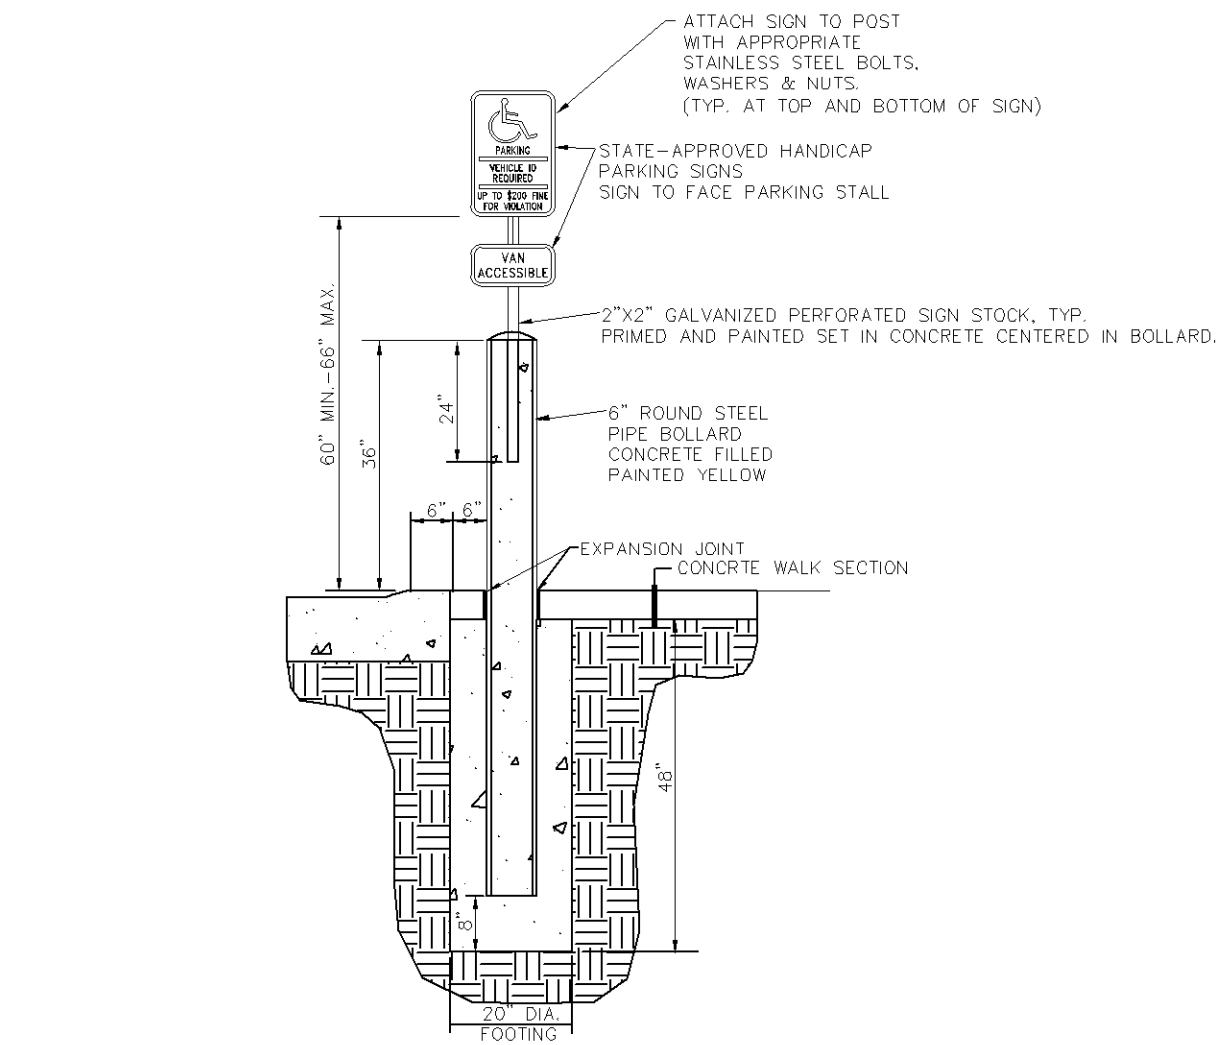


1 ROUND BOLLARD WITH ACCESSIBLE SIGNAGE
NOT TO SCALE

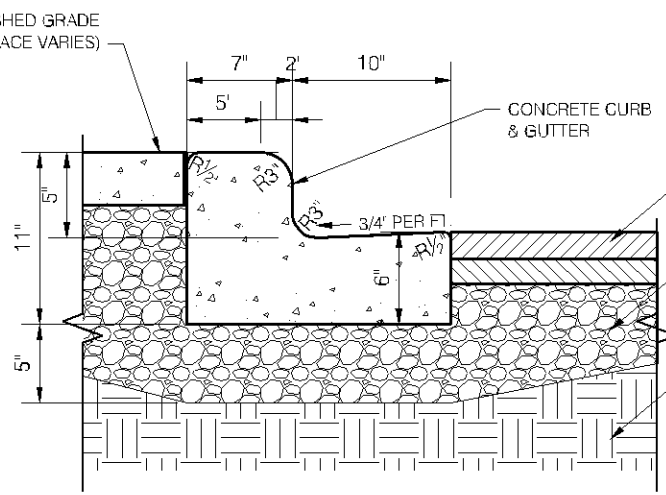


2 B612 CURB AND GUTTER
NOT TO SCALE

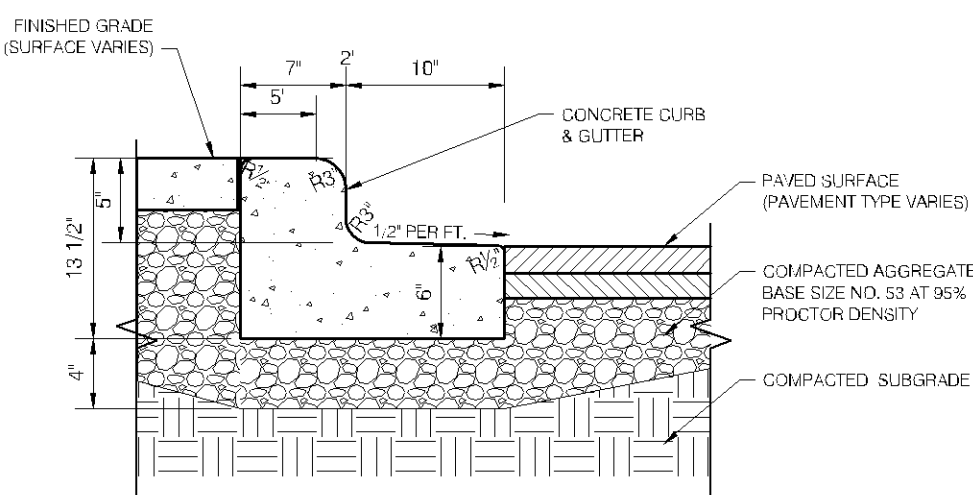


3 B612 CURB AND GUTTER - OUTFALL
NOT TO SCALE

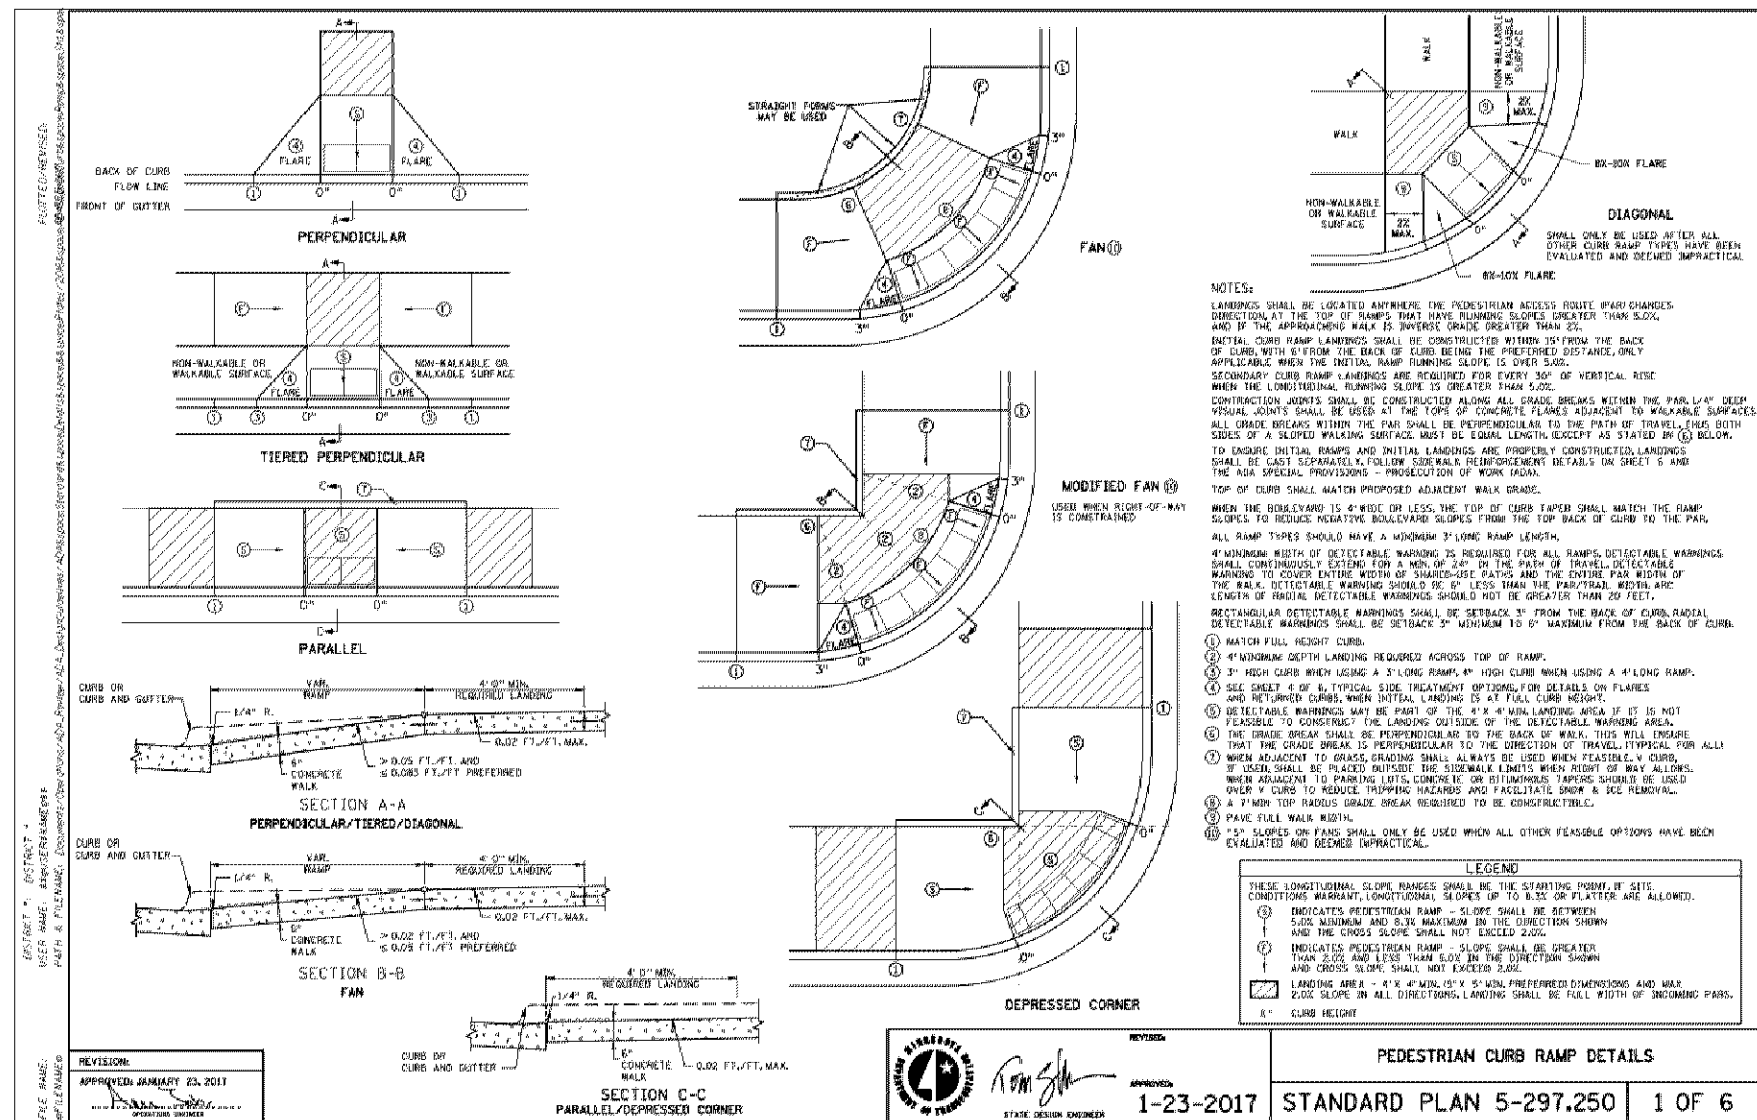


PEDESTRIAN CURB RAMP DETAILS
1-23-2017 STANDARD PLAN 5-297.250 1 OF 6

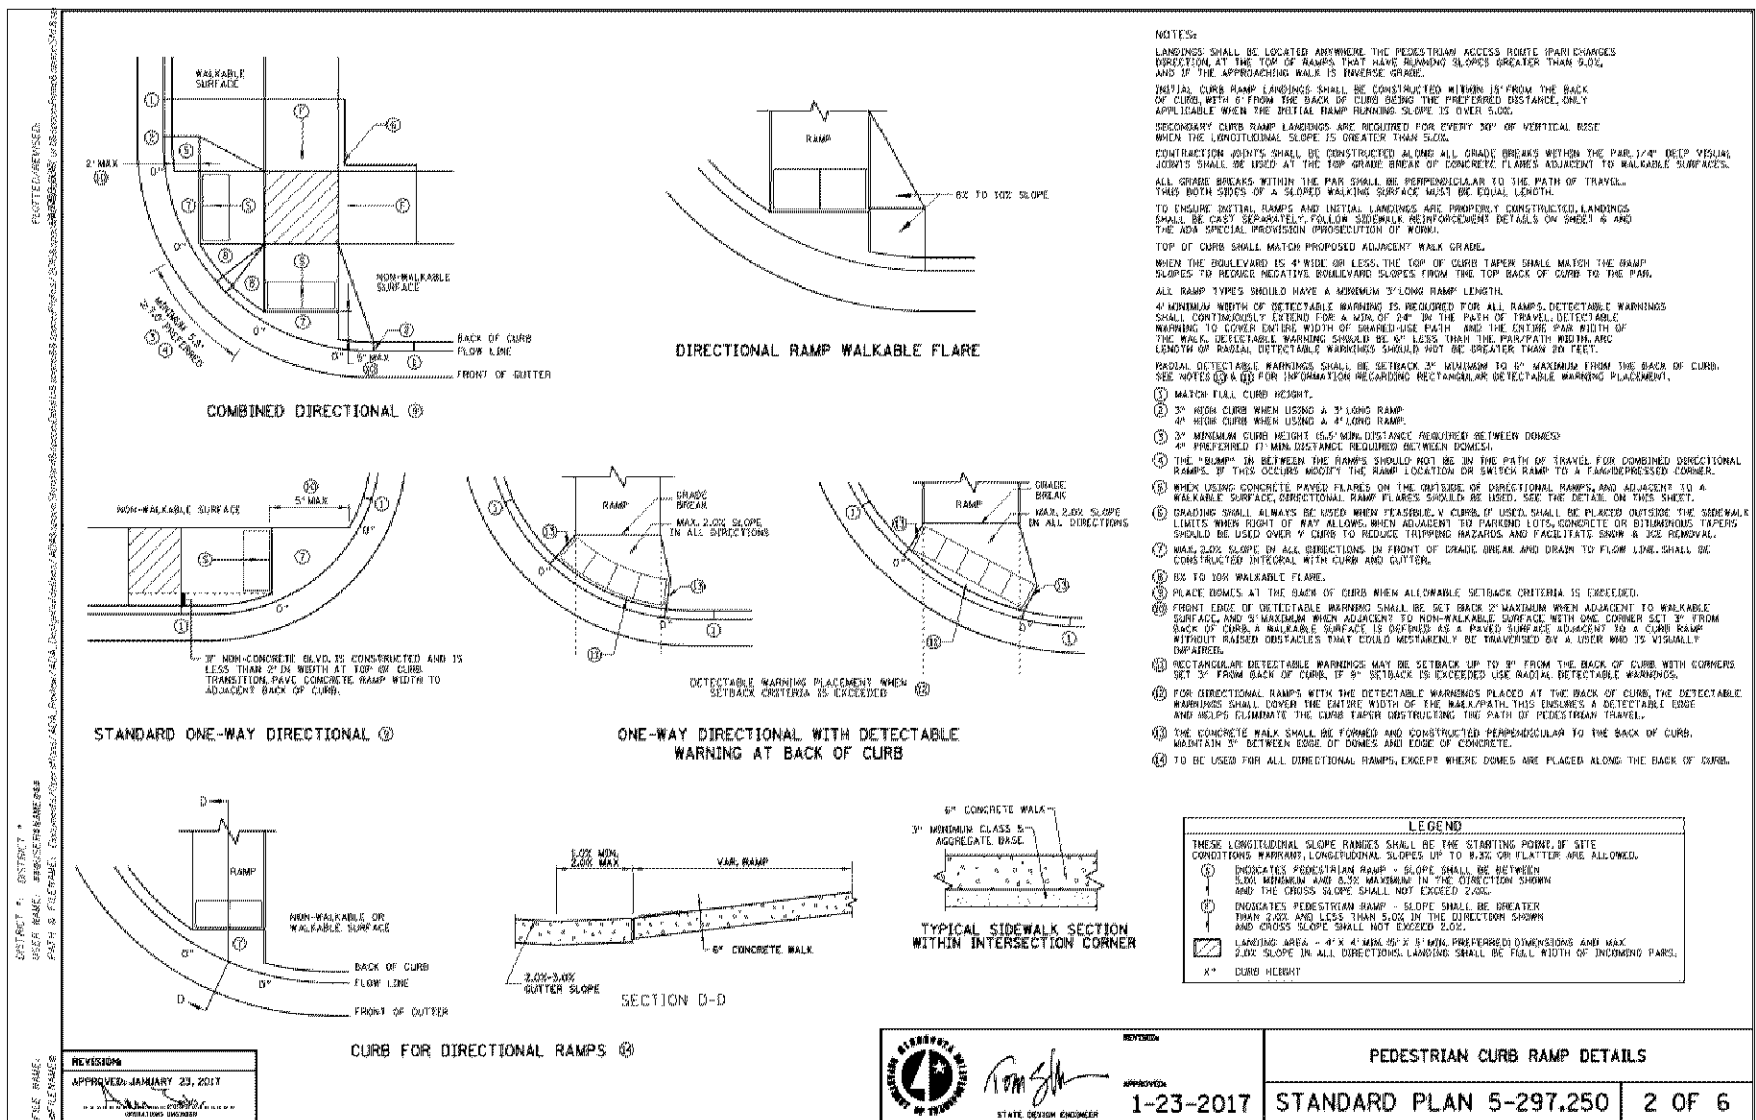

PEDESTRIAN CURB RAMP DETAILS
1-23-2017 STANDARD PLAN 5-297.250 2 OF 6

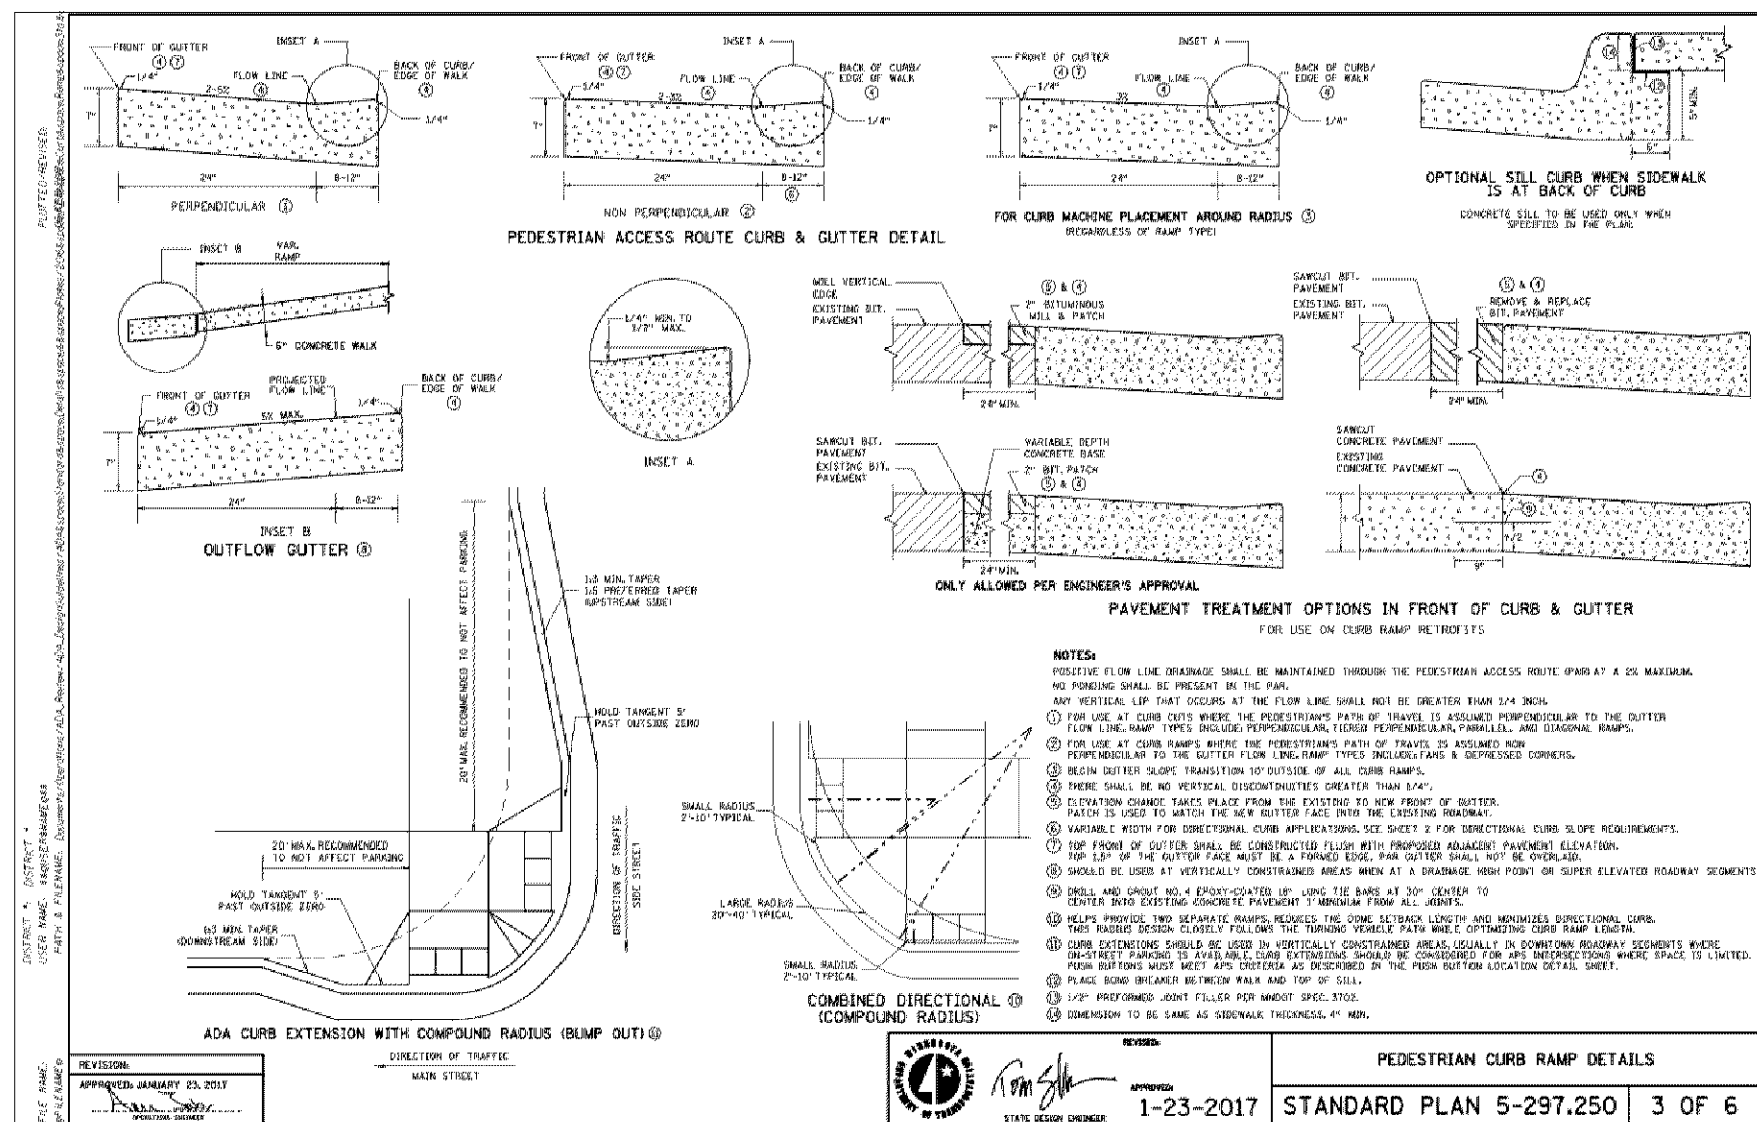

PEDESTRIAN CURB RAMP DETAILS
1-23-2017 STANDARD PLAN 5-297.250 3 OF 6

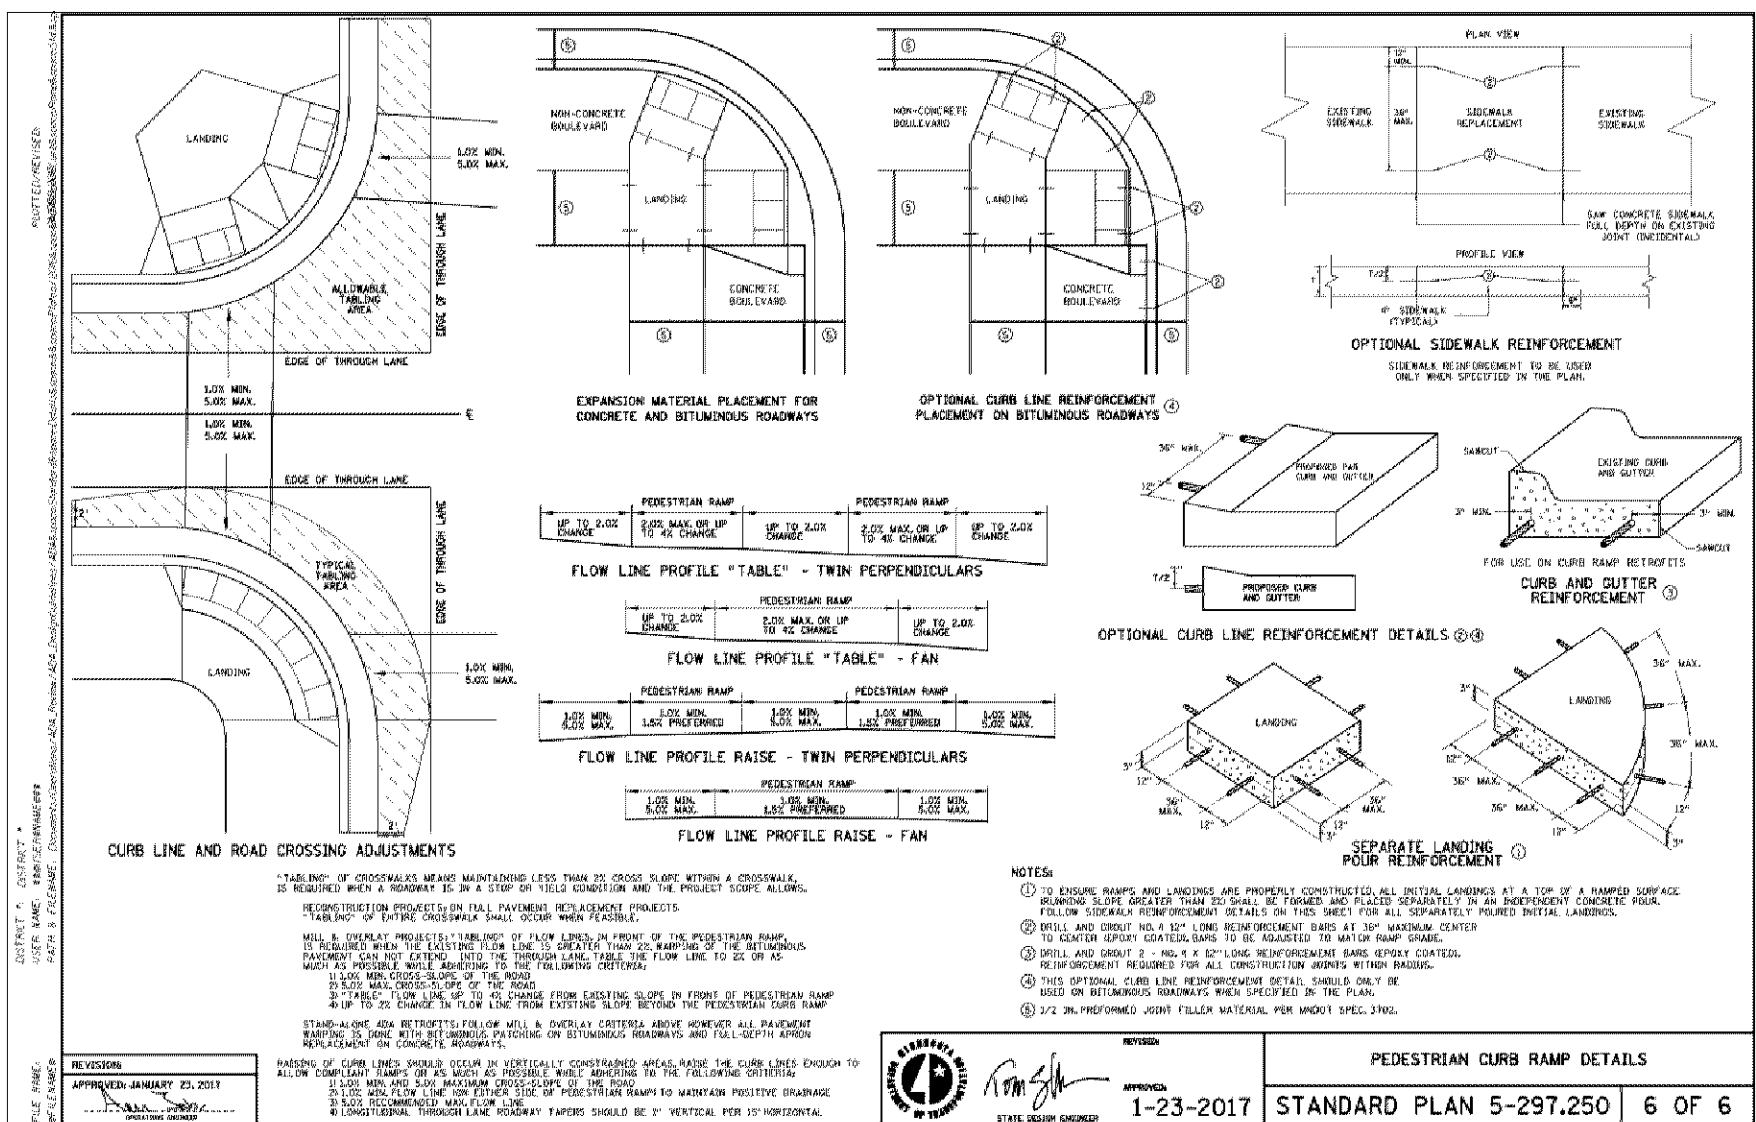

PEDESTRIAN CURB RAMP DETAILS
1-23-2017 STANDARD PLAN 5-297.250 6 OF 6

8 PEDESTRIAN CURB RAMP
NOT TO SCALE

Drawing name: X:\2019\190123\plan sheets\Final Plan Development\190123details.dwg May 06, 2020 — 1:22pm

PL202000083



ALLIANT
ENGINEERING

733 Marquette Avenue
Suite 700
Minneapolis, MN 55402
612.758.3080
www.alliant-inc.com

AMERICAN SQUARE APARTMENTS
BLOOMINGTON, MN
AMERICAN BOULEVARD E. AND 34TH AVE SOUTH
3601 AMERICAN BOULEVARD EAST
FINAL DEVELOPMENT PLAN
DETAILS

I hereby certify that this plan, specification, or report was prepared by me or under my direct supervision and that I am a duly Licensed PROFESSIONAL ENGINEER under the laws of the State of MINNESOTA


DAVID NASH, PE
12-30-19
Date License No.

QUALITY ASSURANCE/CONTROL

BY	DATE
DATE	ISSUE
01-29-20	CITY SUBMITTAL
03-27-20	PROGRESS PLOT
05-06-20	REVISED CITY SUBMITTAL


PROJECT TEAM DATA
DESIGNED: DMS/DJN
DRAWN: KDB/DMS
PROJECT NO: 190123

C-7.2

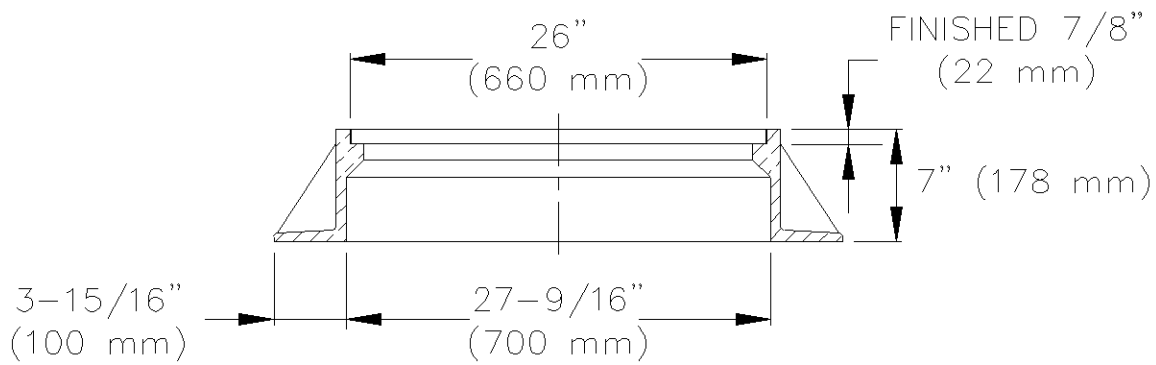


MN/DOT S.P. 4101D CASTING NO. 700-7

4 503 - RING CASTING FOR MANHOLE
NOT TO SCALE 503 - MH Frame.dwg 5/2015

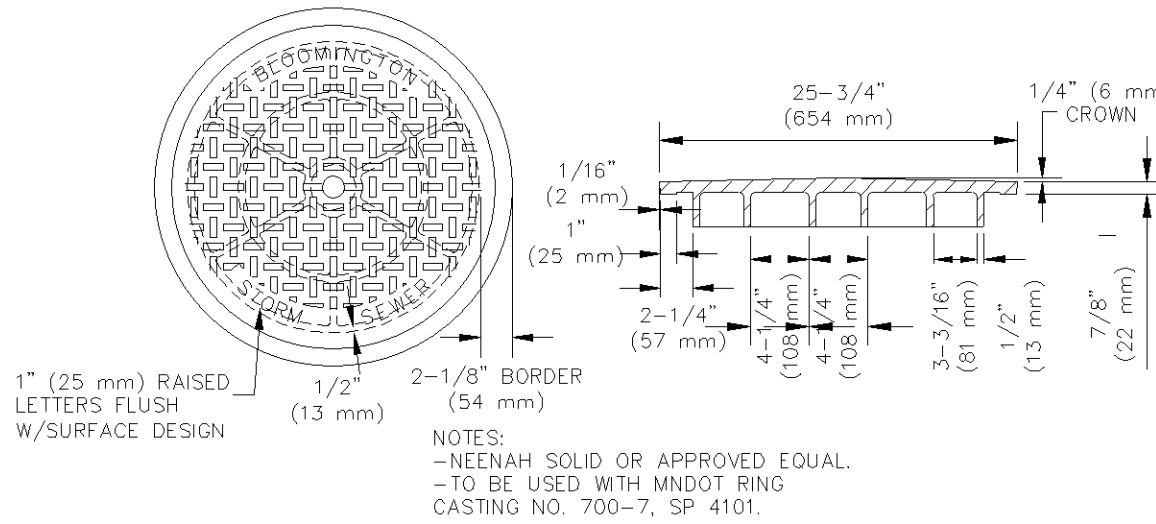


NOTES:
- NEENAH SOLID OR APPROVED EQUAL.
- TO BE USED WITH MNDOT RING CASTING NO. 700-7, SP 4101.

5 500 - STANDARD STORM SEWER MANHOLE COVER
NOT TO SCALE 500 - Storm Cov (Solid).dwg 5/2015

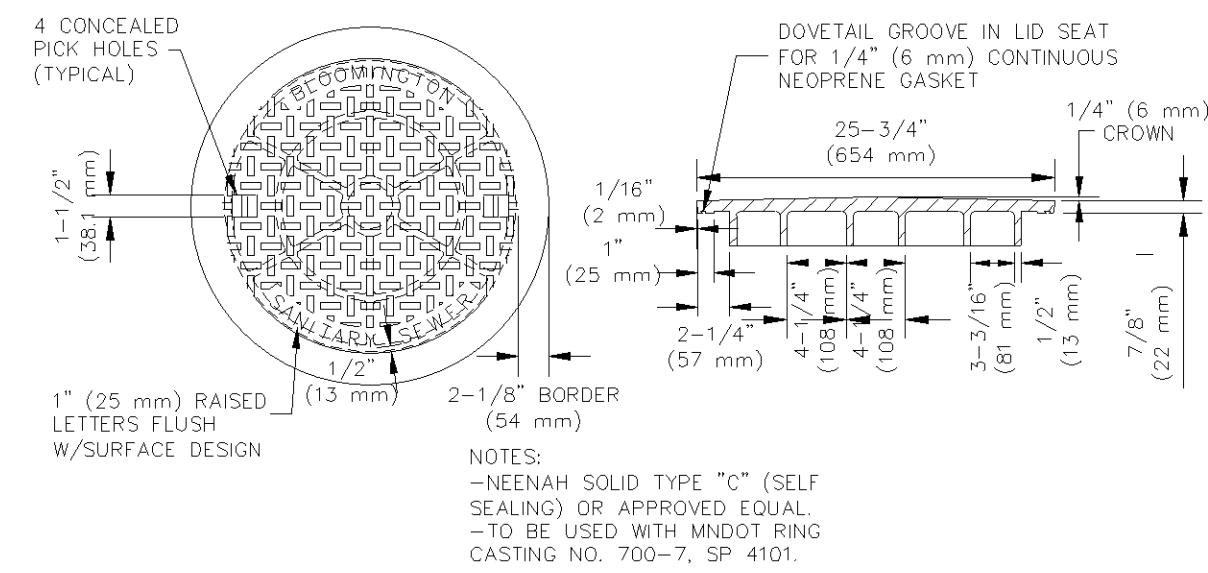


NOTES:
- NEENAH SOLID TYPE "C" (SELF SEALING) OR APPROVED EQUAL.
- TO BE USED WITH MNDOT RING CASTING NO. 700-7, SP 4101.

8 501 - STANDARD SANITARY MANHOLE COVER
NOT TO SCALE 501 - Sanitary Cov.dwg 5/2015

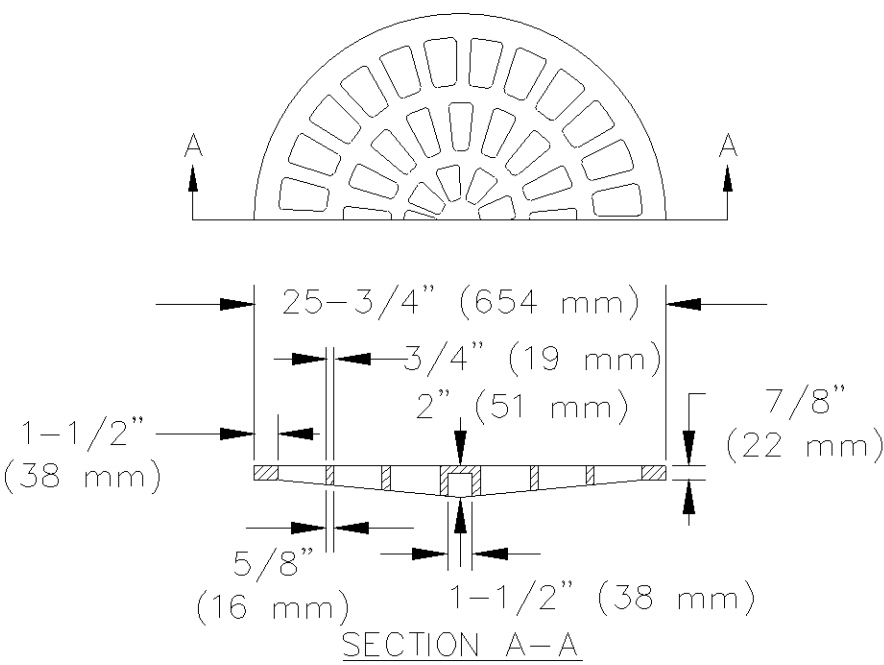

NOTES:
- USE NEENAH R-2296 TYPE C GRATE OR APPROVED EQUAL.
- TO BE USED WITH MNDOT RING CASTING NO. 700-7, SP 4101.


9 502 - RADIAL GRATE STORM MANHOLE COVER
NOT TO SCALE 502 - Radial Grate.dwg 4/2009

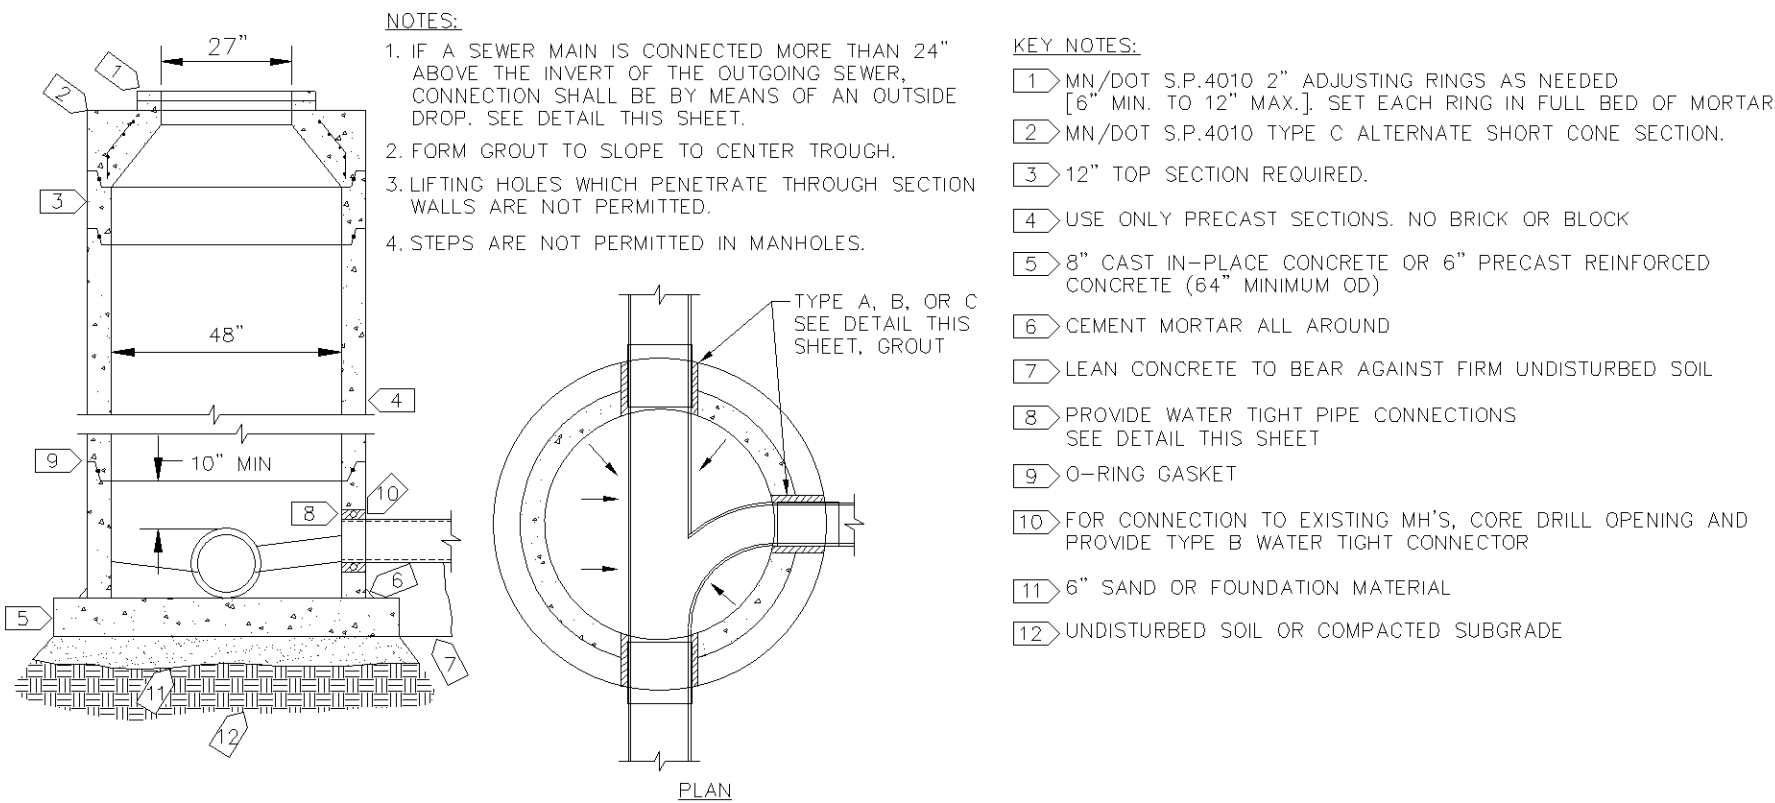



NOTES:
1. IF A SEWER MAIN IS CONNECTED MORE THAN 24" ABOVE THE INVERT OF THE OUTGOING SEWER, CONNECTION SHALL BE BY MEANS OF AN OUTSIDE DROP. SEE DETAIL THIS SHEET.
2. FORM GROUT TO SLOPE TO CENTER TROUGH.
3. LIFTING HOLES WHICH PENETRATE THROUGH SECTION WALLS ARE NOT PERMITTED.
4. STEPS ARE NOT PERMITTED IN MANHOLES.

KEY NOTES:
1. MN/DOT S.P.4010 2" ADJUSTING RINGS AS NEEDED [6" MIN. TO 12" MAX.]. SET EACH RING IN FULL BED OF MORTAR.
2. MN/DOT S.P.4010 TYPE C ALTERNATE SHORT CONE SECTION.
3. 12" TOP SECTION REQUIRED.
4. USE ONLY PRECAST SECTIONS. NO BRICK OR BLOCK.
5. 8" CAST IN-PLACE CONCRETE OR 6" PRECAST REINFORCED CONCRETE (64" MINIMUM OD).
6. CEMENT MORTAR ALL AROUND.
7. LEAN CONCRETE TO BEAR AGAINST FIRM UNDISTURBED SOIL.
8. PROVIDE WATER TIGHT PIPE CONNECTIONS SEE DETAIL THIS SHEET.
9. O-RING GASKET.
10. FOR CONNECTION TO EXISTING MH'S, CORE DRILL OPENING AND PROVIDE TYPE B WATER TIGHT CONNECTOR.
11. 6" SAND OR FOUNDATION MATERIAL.
12. UNDISTURBED SOIL OR COMPACTED SUBGRADE.


1 400 - STANDARD SANITARY SEWER MANHOLE
NOT TO SCALE 400 - Std San MH.dwg 6/2015

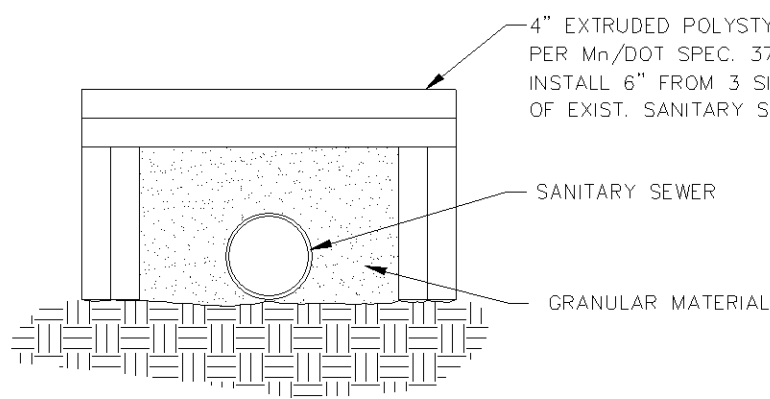

2 411 - SANITARY SEWER INSULATION DETAIL
NOT TO SCALE 411 - Std San MH.dwg 6/2015

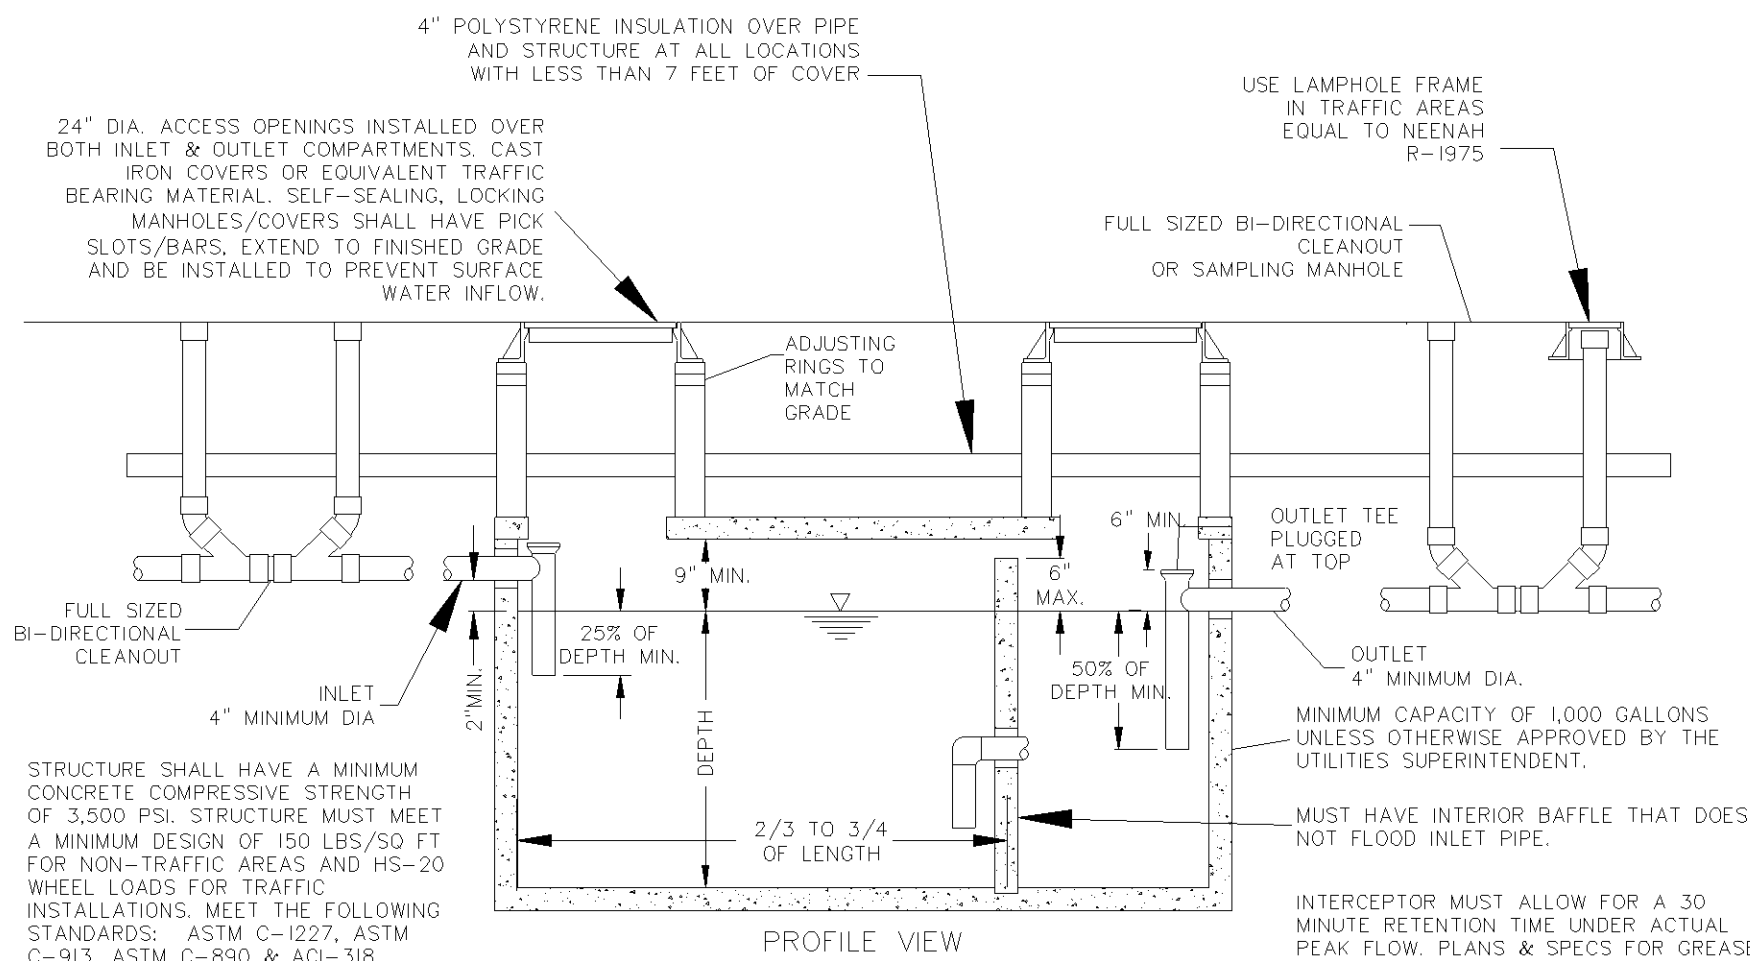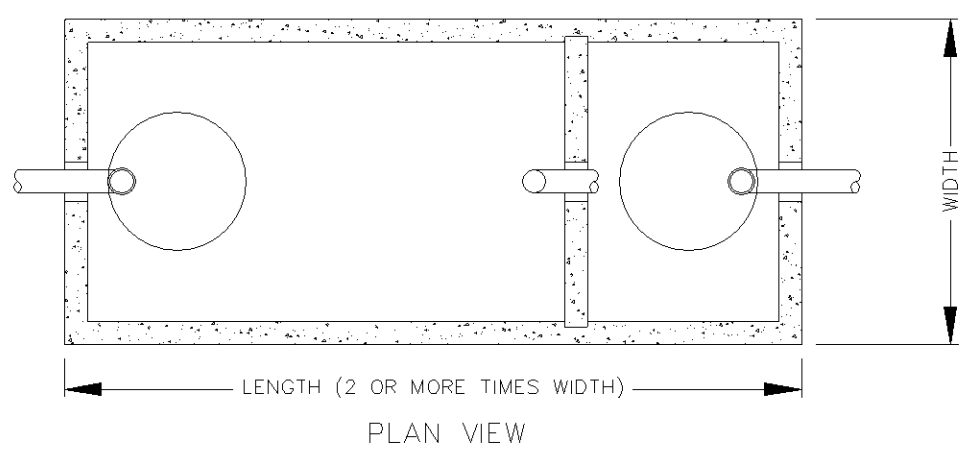


6 412 - GREASE INTERCEPTOR EXAMPLE
NOT TO SCALE - FOR INFORMATIONAL PURPOSES ONLY 412 - Typical Grease Interceptor.dwg 12/2019

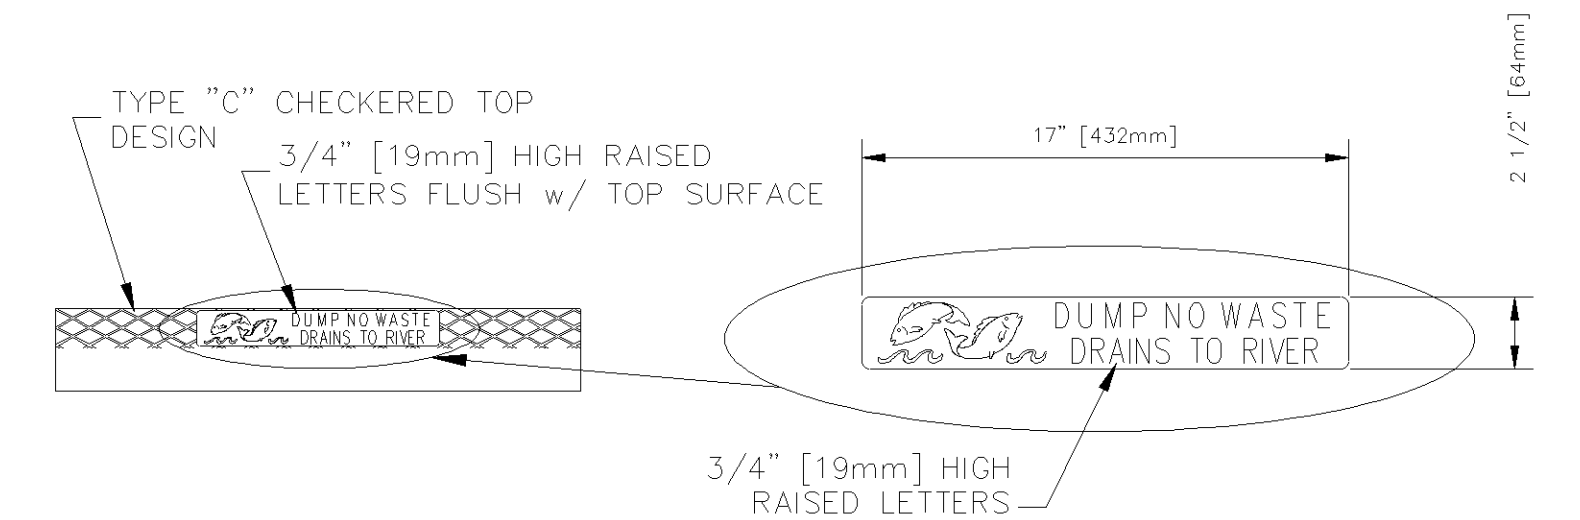

USE NEENAH R-3067 WITH TYPE L GRATE OR APPROVED EQUAL

3 504 - RECTANGULAR CATCH BASIN CASTING ASSEMBLY
NOT TO SCALE 504 - Rect. CB.dwg 5/2015

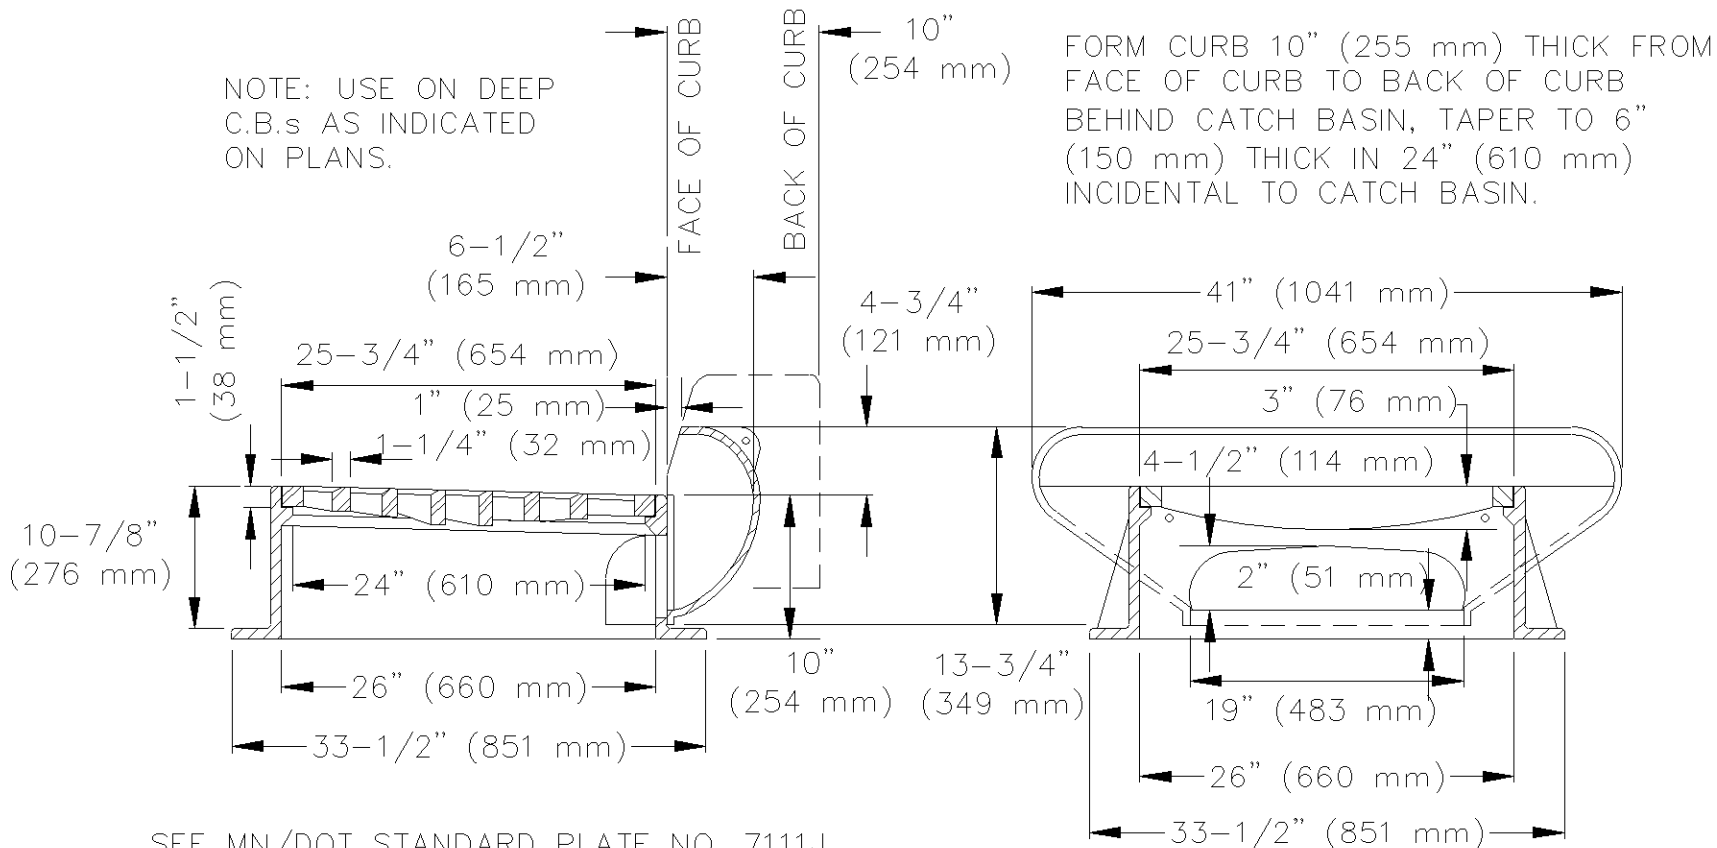


SEE MN/DOT STANDARD PLATE NO. 7111J FOR CURB REINFORCING REQUIREMENTS.

FRAME: MN/DOT STD PLATE 4126F CASTING 801
GRATE: MN/DOT STD PLATE 4149C CASTING 810
CURB BOX WITH 41" OPENING: AS SHOWN ABOVE
(USE NEENAH R-3250-1 OR APPROVED EQUAL)


7 505 - ROUND CATCH BASIN CASTING ASSEMBLY
NOT TO SCALE 505 - Round CB.dwg 5/2015

Drawing name: X:\2019\190123\plan sheets\Final Plan Development\190123details.dwg May 06, 2020 — 1:23pm

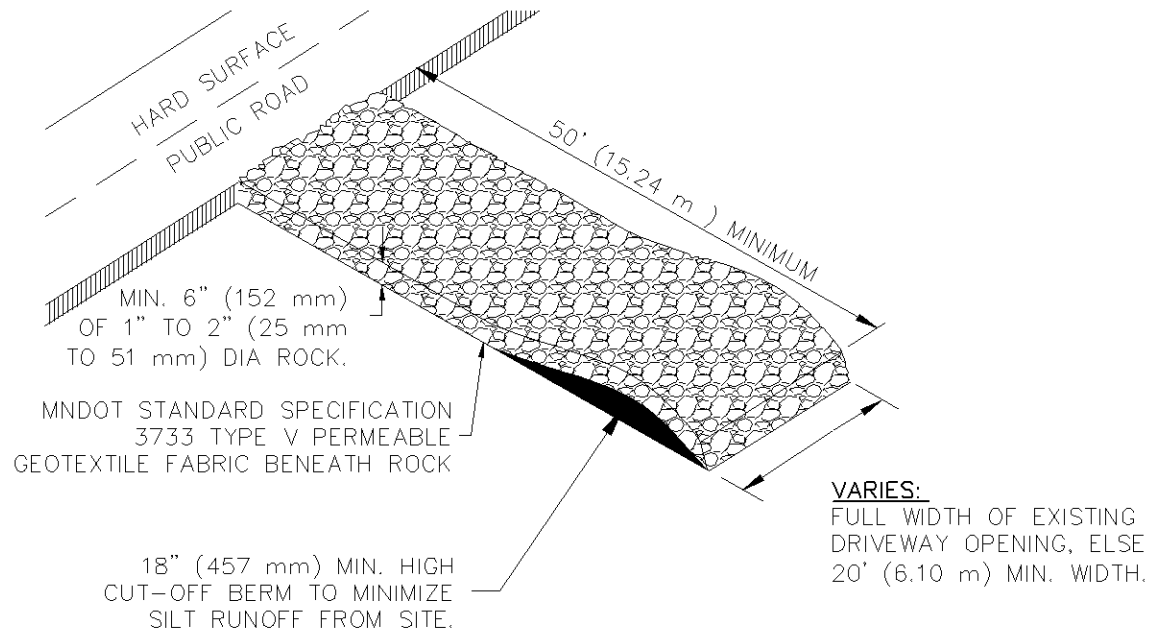


600 — ROCK CONSTRUCTION ENTRANCE AT ACCESS ROADS
600 - Rock Const. Ent.dwg 5/2015

1 600 - ROCK CONSTRUCTION ENTRANCE AT ACCESS ROADS
NOT TO SCALE 600 - Rock Const. Ent.dwg 5/2015

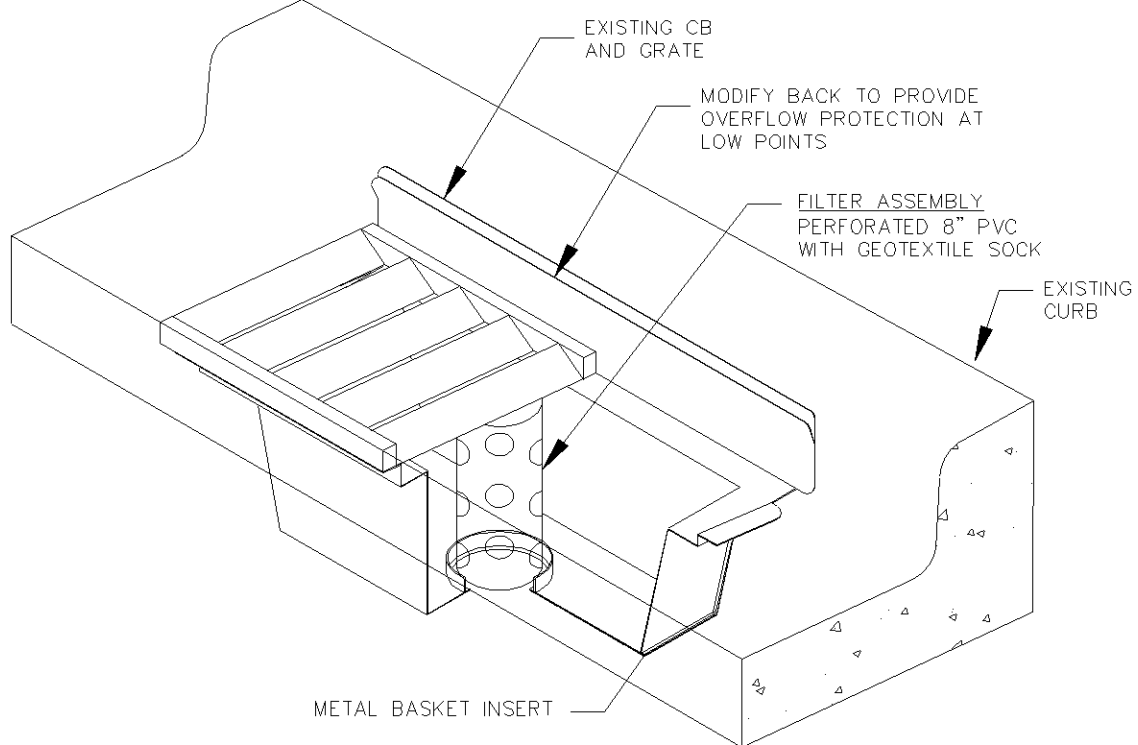


601 — INLET PROTECTION, METAL BASKET TYPE
601 - Wimco (CB).dwg 5/2015

2 601 - INLET PROTECTION, METAL BASKET TYPE
NOT TO SCALE 601 - Wimco (CB).dwg 5/2015

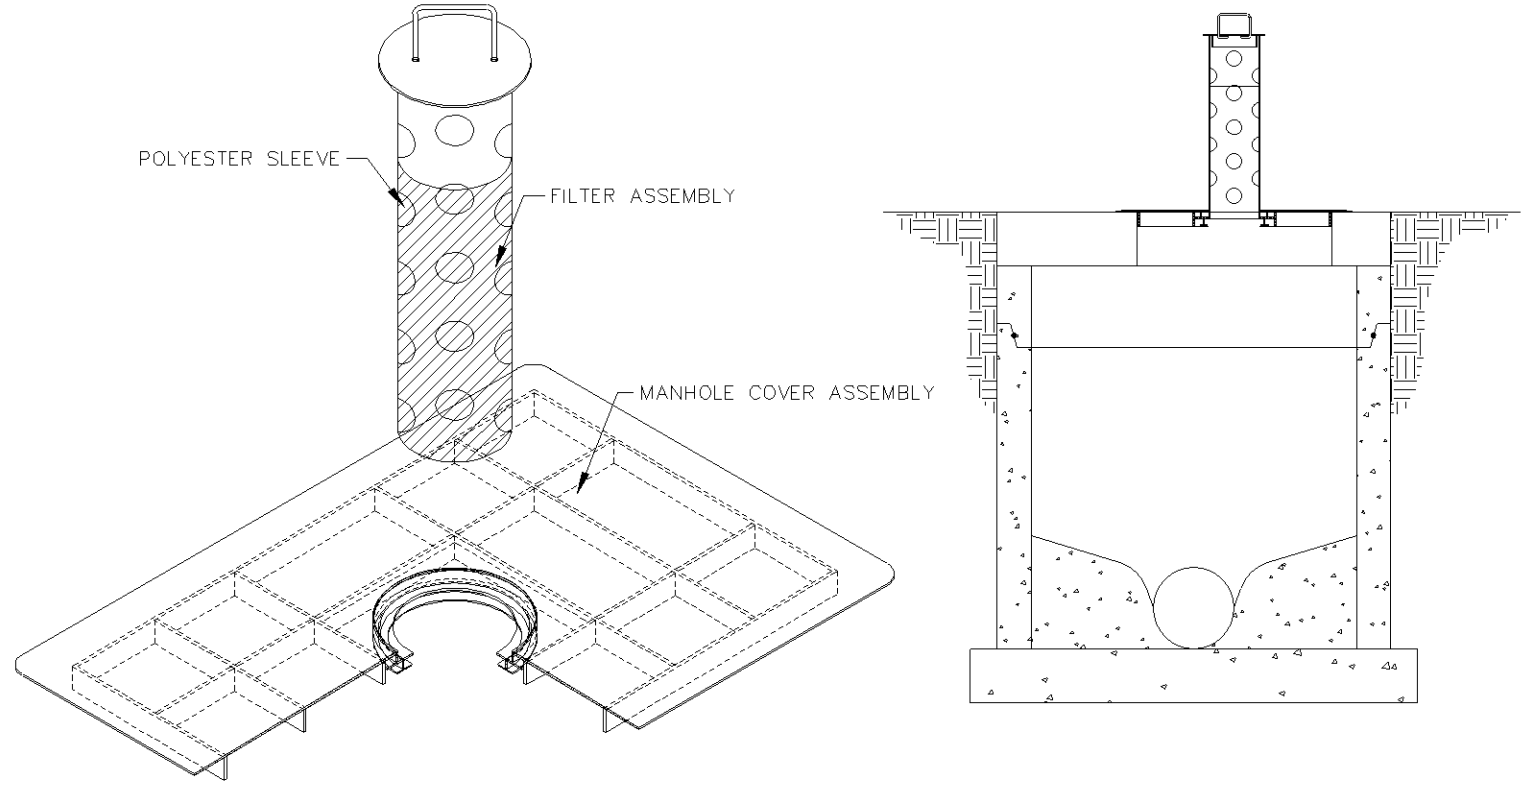


602 — INLET PROTECTION, MANHOLE COVER ASSEMBLY
602 - Wimco (MH).dwg 5/2015

3 602 - INLET PROTECTION, MANHOLE COVER ASSEMBLY
NOT TO SCALE 6012 - Wimco (MH).dwg 5/2015

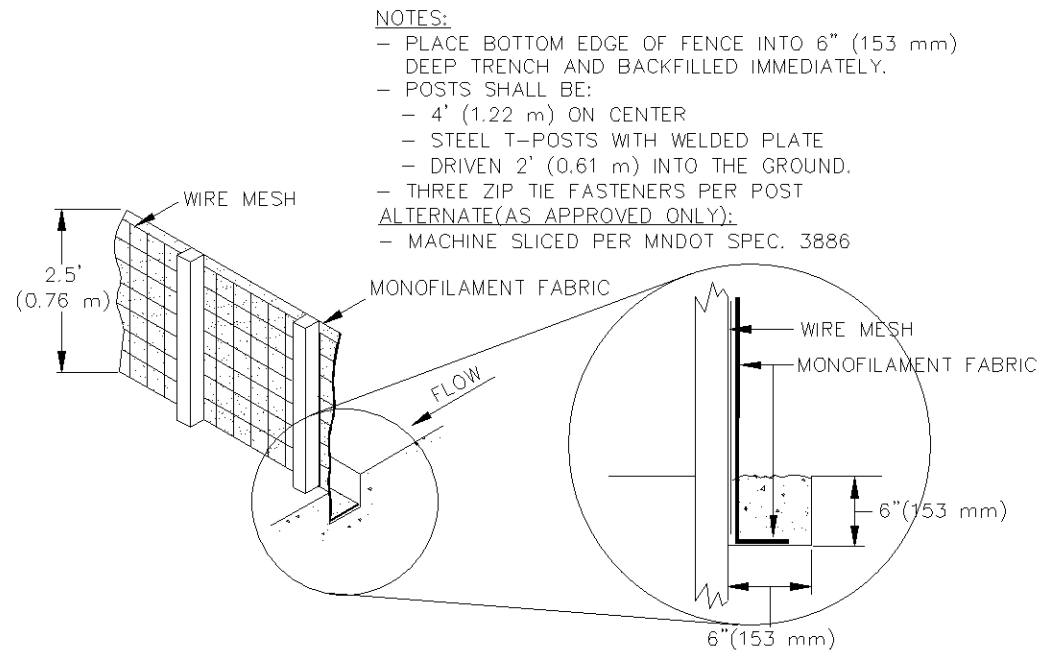

607 — SILT FENCE, TYPE HEAVY DUTY
607 - Silt Fenc (HEAVY DUTY).dwg 5/2015

4 607 - SILT FENCE, TYPE HEAVY DUTY
NOT TO SCALE 607 - Silt Fenc (HEAVY DUTY).dwg 5/2015

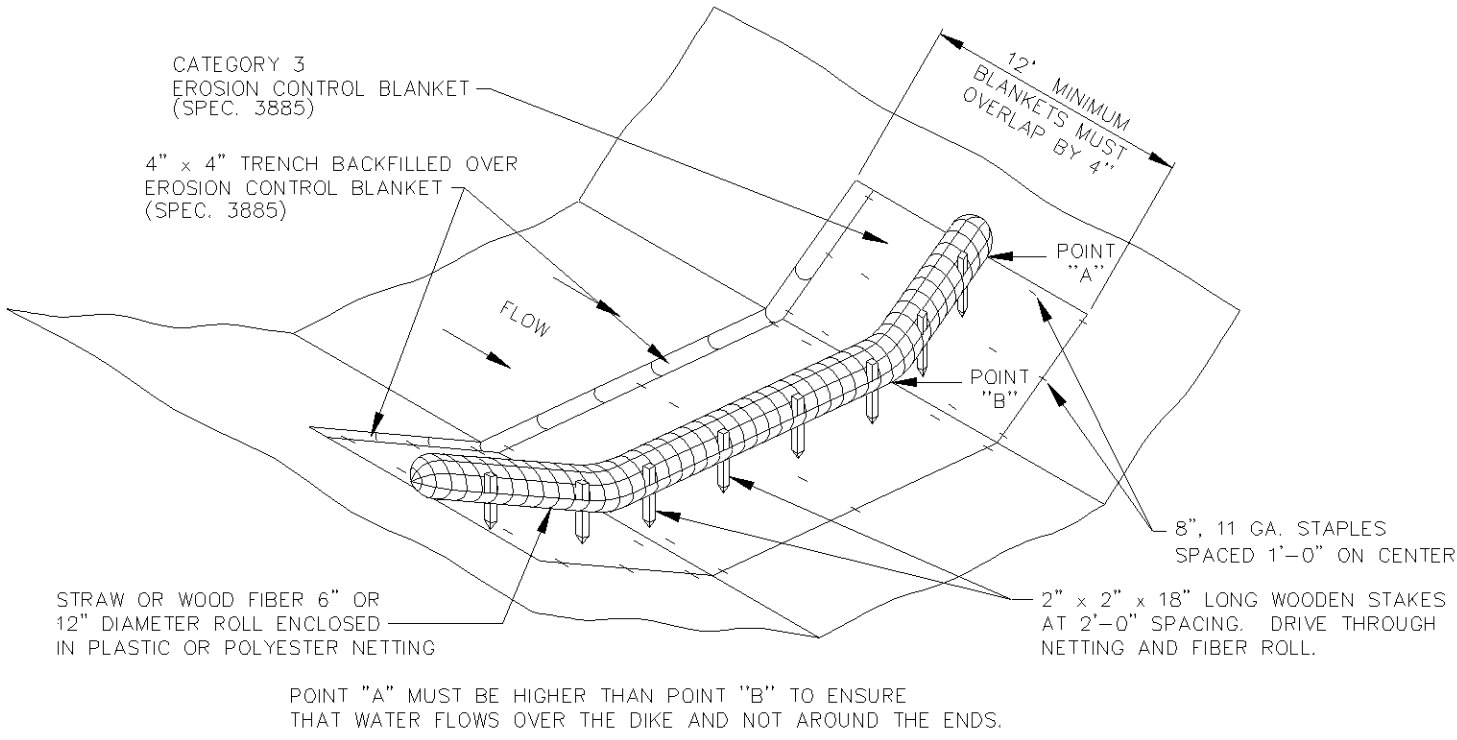

610 — BIOROLL BLANKET SYSTEM (TYPE 3 SPEC. 3889)
610 - Bioroll.dwg 5/2015

5 610 - BIOROLL BLANKET SYSTEM (TYPE 3 SPEC. 3889)
NOT TO SCALE 610 - Bioroll.dwg 5/2015

I hereby certify that this plan, specification, or report was prepared by me or under my direct supervision and that I am a duly Licensed PROFESSIONAL ENGINEER under the laws of the State of MINNESOTA

DAVID NASH, PE	
12-30-19	
Date	License No.

QUALITY ASSURANCE/CONTROL

BY	DATE
DATE	ISSUE
01-29-20	CITY SUBMITTAL
03-27-20	PROGRESS PLOT
05-06-20	REVISED CITY SUBMITTAL

PROJECT TEAM DATA	
DESIGNED:	DMS/DJN
DRAWN:	KDB/DMS
PROJECT NO:	190123

AMERICAN SQUARE APARTMENTS
BLOOMINGTON, MN

LANDSCAPE PLAN

I hereby certify that this plan,
specification, or report was
prepared by me or under my
direct supervision and that I
am a duly Licensed
PROFESSIONAL ENGINEER under
the laws of the State of
MINNESOTA

DAVID NASH, PE

12-30-19

License No.

QUALITY ASSURANCE/CONTROL

BY _____ DATE _____

DATE	ISSUE
------	-------

01-29-20	CITY SUBMITTAL
----------	----------------

03-27-20	PROGRESS PLOT
----------	---------------

05-06-20	REVISED CITY SUBMITTAL
----------	------------------------

PROJECT TEAM DATA

DESIGNED: DMS/DJN

DRAWN: KDB/DMS


PROJECT NO: 190123

L-1.0



FOR REVIEW ONLY
PRELIMINARY
NOT FOR CONSTRUCTION

Drawing name: X:\2019\190123\plan sheets\Final Plan Development\190123land.dwg, May 06, 2020 — 1:24pm

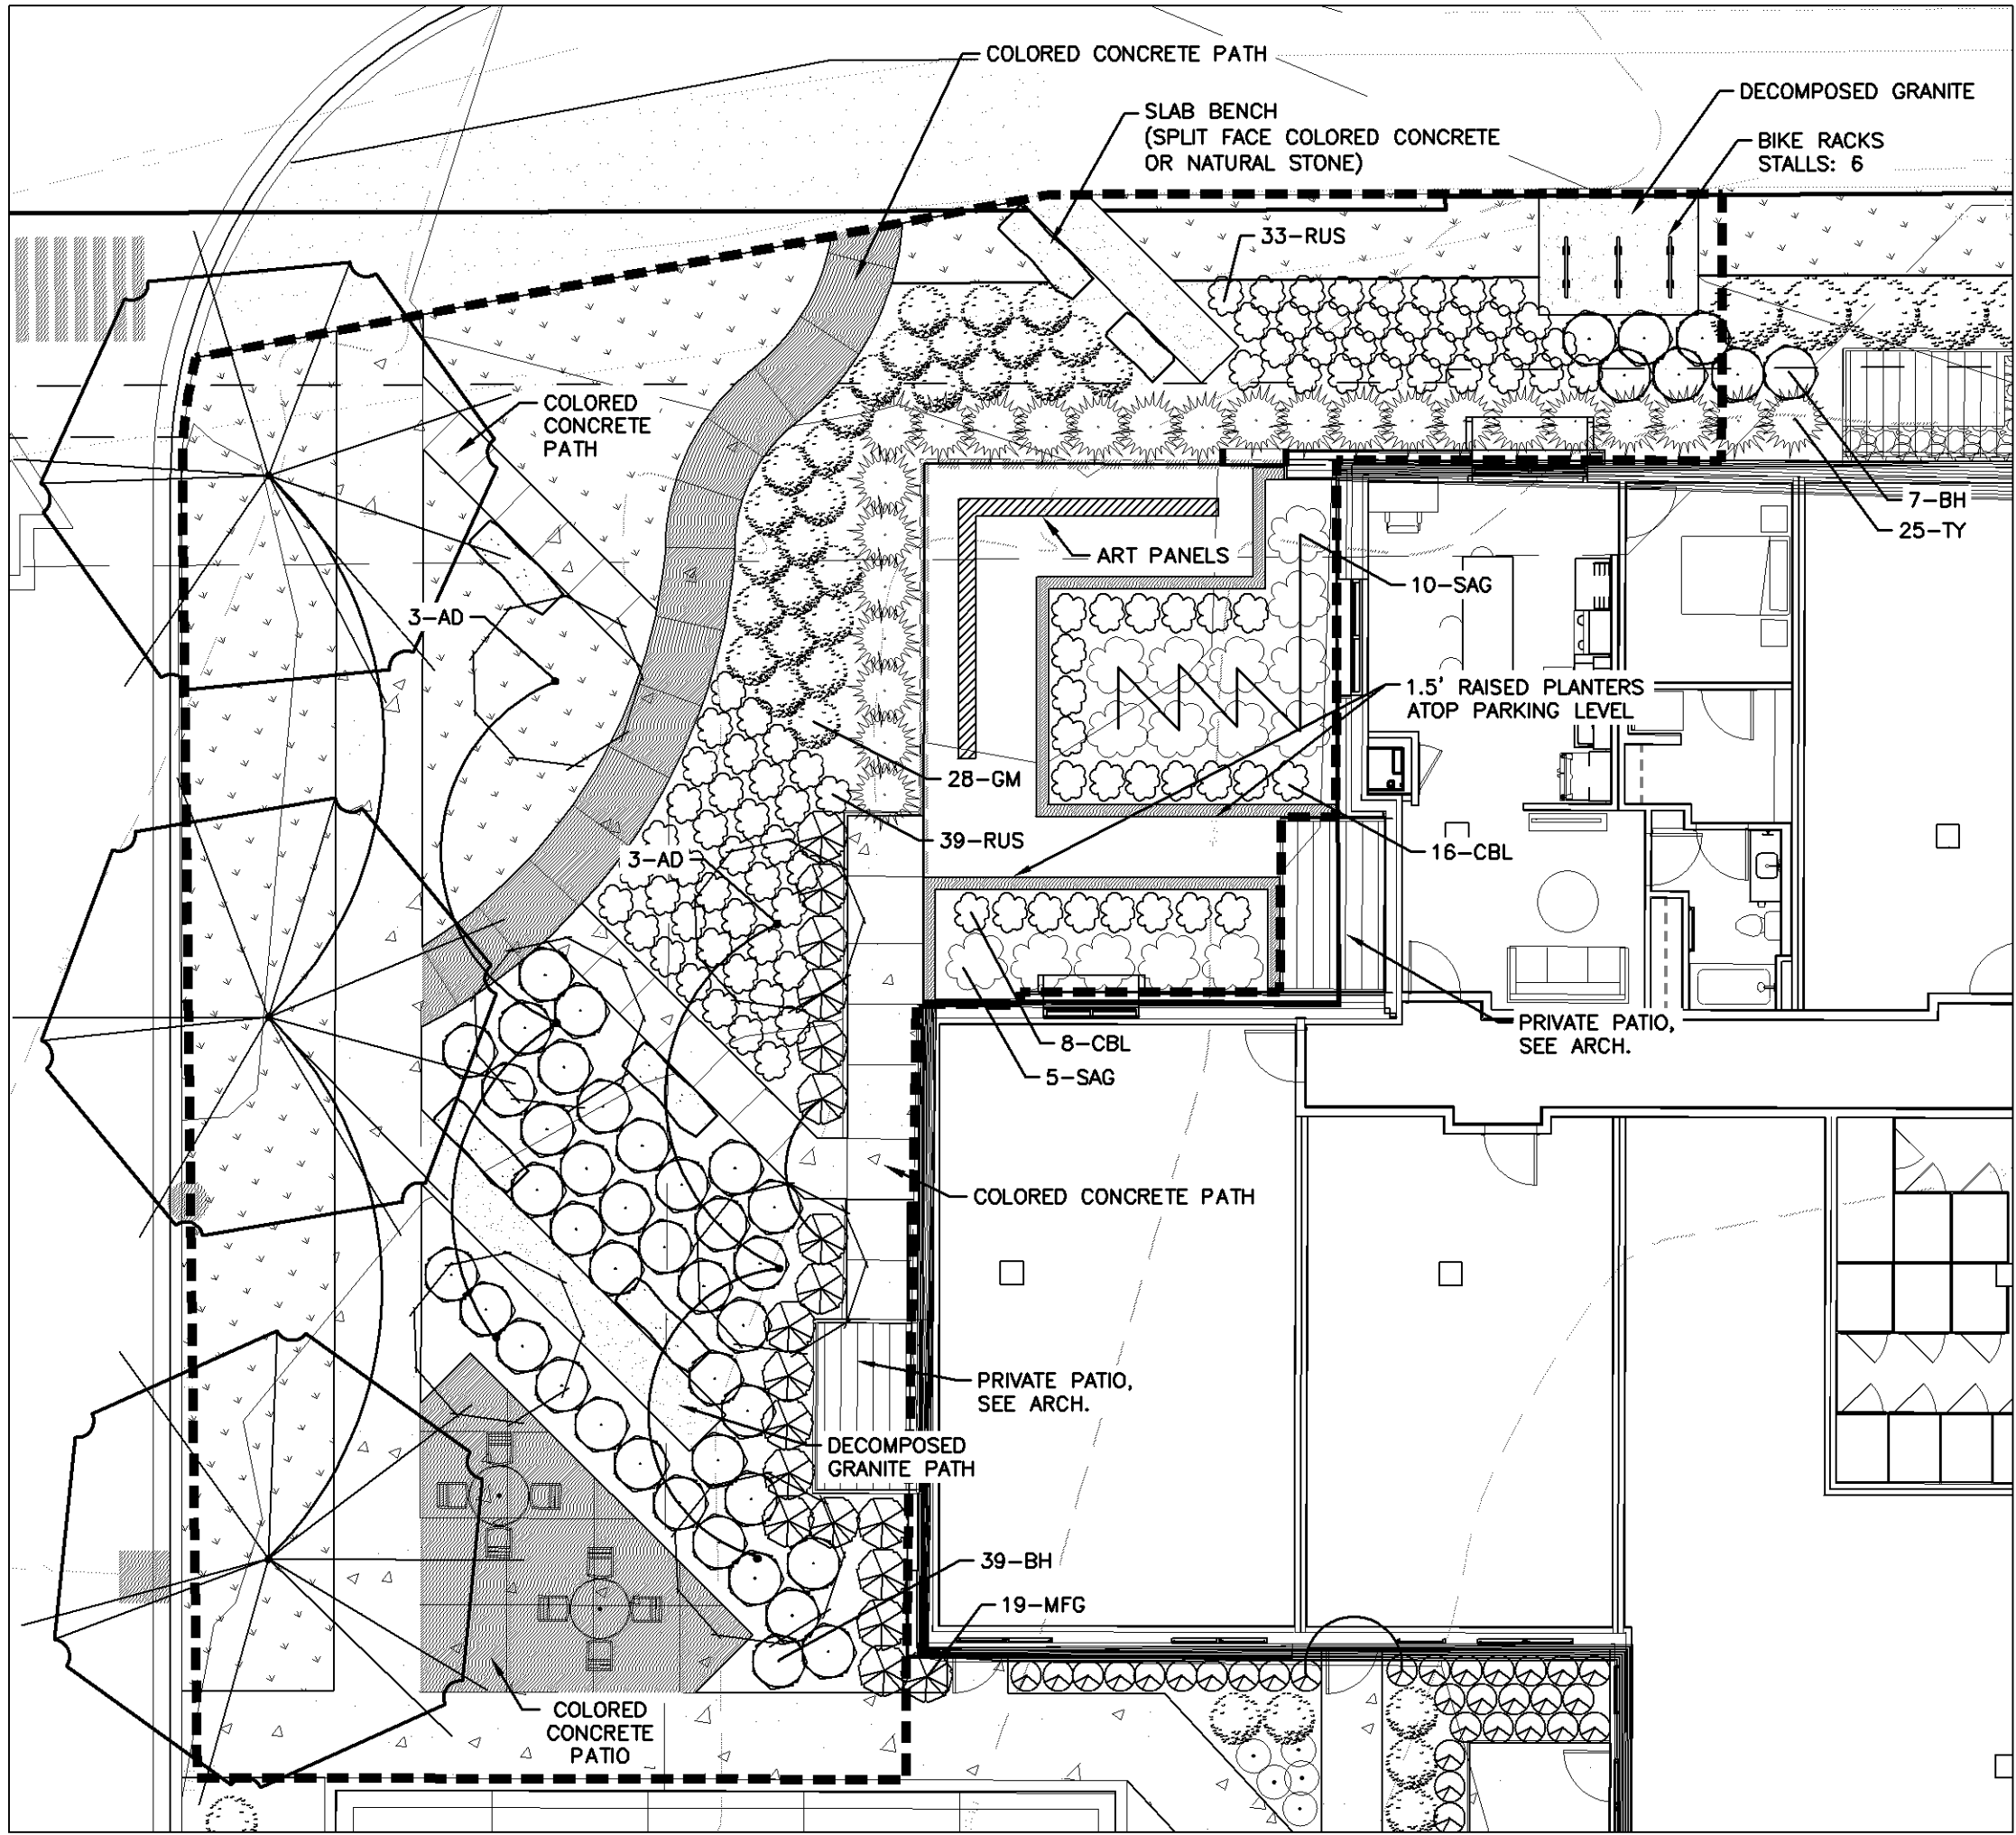


PUBLIC PARK/PLAZA REQUIREMENTS

TOTAL PLAZA AREA	
REQUIRED:	5,000 SF
PROVIDED:	5,000 SF
ABUTTING PUBLIC WAY	
REQUIRED (350 LF X 25%):	87.5 LF
PROVIDED (25%):	88 LF
LANDSCAPE/WATER FEATURE	
REQUIRED (30%):	1,500 SF
PROVIDED (60%):	3,019 SF
SEATING REQUIREMENT	
REQUIRED (5,000/200 SF):	25 SEATS
PROVIDED (5,000/200 SF):	25 SEATS

Is there a public park agreement?

LANDSCAPE NOTES:


- CALL GOPHER STATE ONE CALL AT 651-454-0002 FOR LOCATING ALL UNDERGROUND UTILITIES AND TO AVOID DAMAGE TO UTILITIES DURING THE COURSE OF THE WORK.
- INSTALL 4" MIN. TOP SOIL TO ALL SOD AND SHRUB AREAS. FINE GRADE ALL SOD AREAS. INSTALL 12" PLANTING (TOP) SOIL TO ALL ANNUAL/PERENNIAL AREAS.
- STAKE OR MARK ALL PLANT MATERIAL LOCATIONS PRIOR TO INSTALLATION. HAVE OWNERS REPRESENTATIVE APPROVE ALL STAKING PRIOR TO INSTALLATION.
- ALL SHRUB AREAS UNLESS SPECIFIED AS OTHER ON THE PLAN, TO BE BED MULCHED WITH 4" DEPTH OF HARDWOOD MULCH, DARK BROWN COLOR, OVER FILTER FABRIC, POLY-EDGER TO BE VALLEY VIEW BLACK DIAMOND OR APPROVED.
- ALL MULCH AND ROCK (BOULDERS, COBBLESTONE, ETC) TO BE APPROVED BY OWNER AND/OR LANDSCAPE ARCHITECT PRIOR TO INSTALLATION.
- INSTALL 4-6" DEPTH SHREDDED HARDWOOD MULCH AROUND ROOT SAUCER OF ALL TREES ISOLATED FROM PLANT BEDS. DO NOT PLACE LANDSCAPE FABRIC OR MULCH ONTO TREE TRUNK.
- PLANTING SOIL SHALL BE 1:1:1 CONSISTING OF 33% SELECT LOAMY TOPSOIL, 33% PEAT MOSS, 33% PIT RUN SAND.
- COMPLETELY GUARANTEE ALL WORK FOR A PERIOD OF ONE YEAR BEGINNING AT THE DATE OF ACCEPTANCE. MAKE ALL REPLACEMENTS PROMPTLY (AS PER DIRECTION OF OWNER).
- ALL MATERIAL SHALL COMPLY WITH THE LATEST EDITION OF THE AMERICAN STANDARD FOR NURSERY STOCK, AMERICAN ASSOCIATION OF NURSERYMEN.
- ALL TREE TRUNKS SHALL BE WRAPPED WITH BROWN CREPE TREE WRAP. APPLY WRAP IN NOVEMBER AND REMOVE IN APRIL.
- MAINTAIN ALL PLANT MATERIALS, INCLUDING WATERING, UNTIL THE TIME OF ACCEPTANCE.
- COORDINATE LANDSCAPE INSTALLATION WITH GENERAL CONTRACTOR.
- STAKING AND GUYING OF TREES OPTIONAL: MAINTAIN PLUMBNESS OF TREES FOR DURATION OF WARRANTY PERIOD.
- SWEEP AND WASH ALL PAVED SURFACES AND REMOVE ALL DEBRIS RESULTING FROM LANDSCAPE OPERATIONS DAILY.
- SUPPLY DESIGN AND INSTALLATION FOR NEW IRRIGATION SYSTEM WITH 100% COVERAGE OF SOD AND PLANTING AREAS INCLUDING PLANTINGS ON THE POOL DECK (SEE SHEET L-2.0). USE RAINBIRD OR APPROVED EQUAL. COORDINATE INSTALLATION WITH G.C. SOD AND SHRUB AREAS TO BE ON SEPARATE ZONES. PROVIDE RAIN SENSOR.

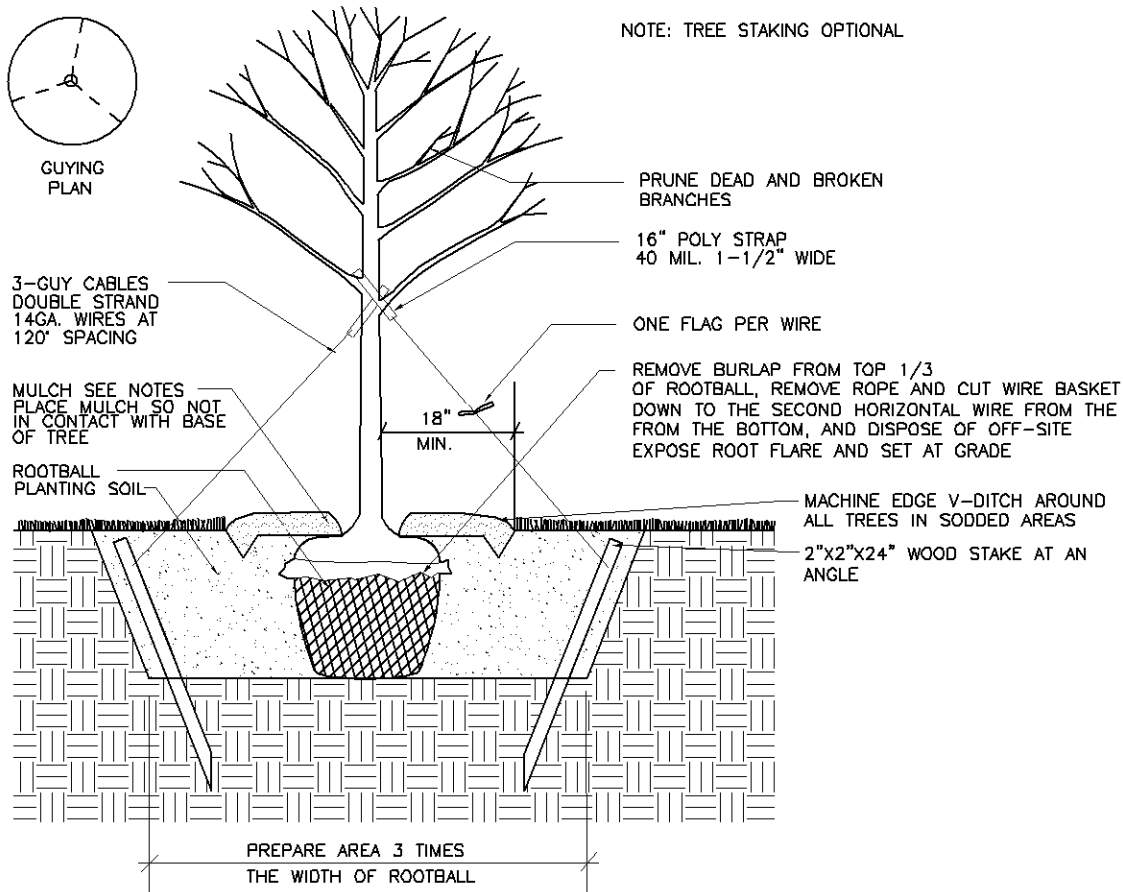

NOTE:
CONTRACTOR IS RESPONSIBLE TO MAINTAIN TREES IN A PLUMB POSITION THROUGHOUT THE MAINTENANCE PERIOD


1 TREE PLANTING

NOT TO SCALE

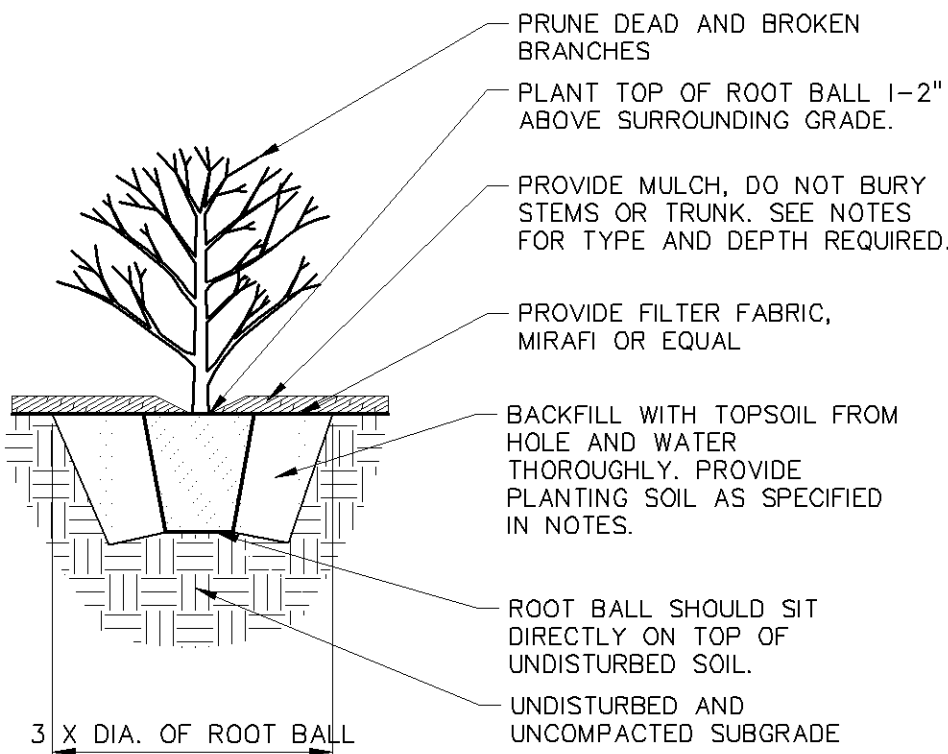


2 SHRUB PLANTING

NOT TO SCALE

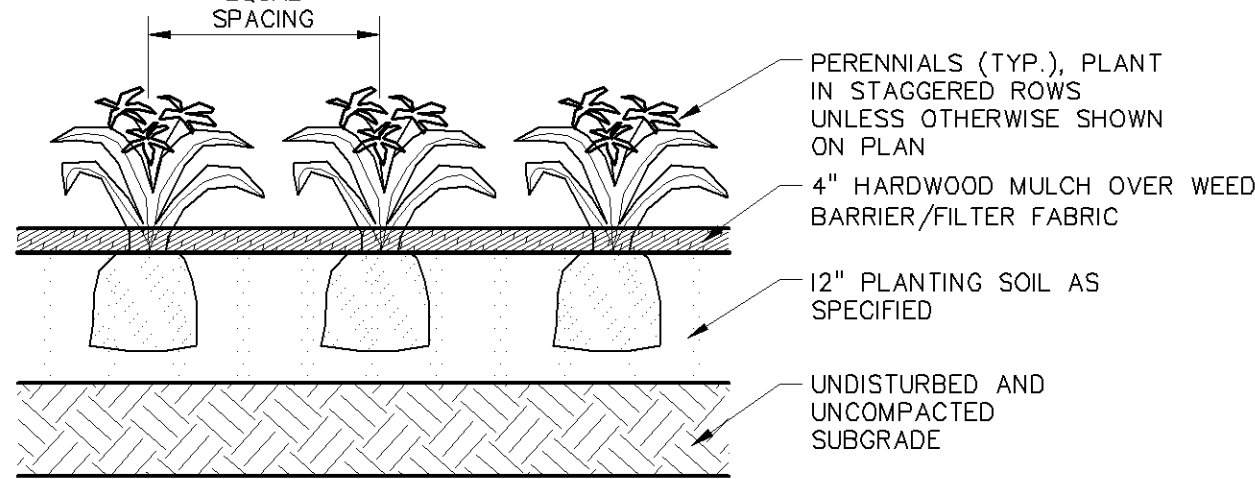


3 PERENNIAL PLANTINGS

NOT TO SCALE

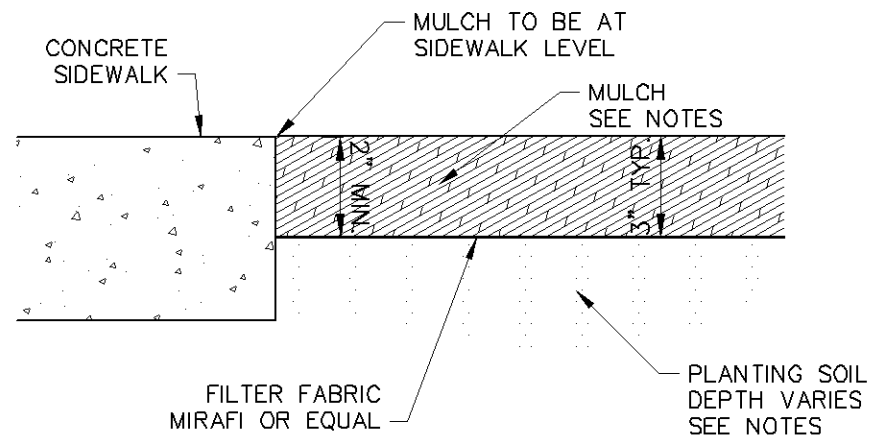

4 MULCH AT SIDEWALK DETAIL

NOT TO SCALE

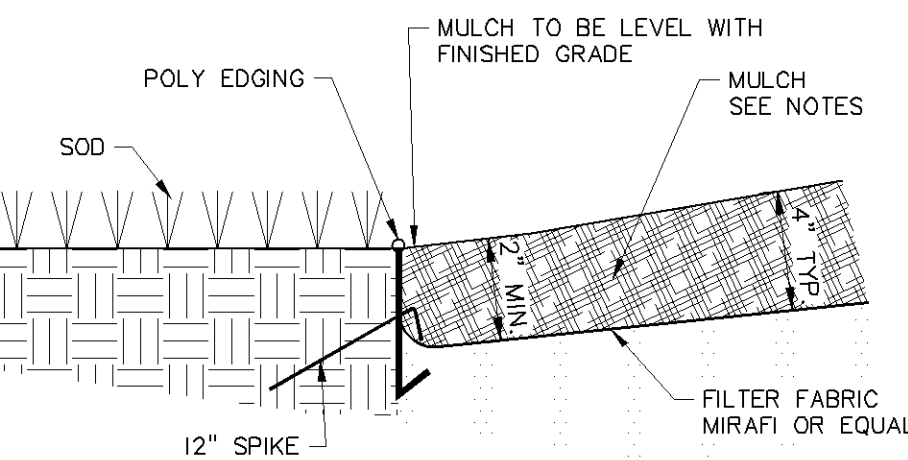

5 MULCH AT SOD DETAIL

NOT TO SCALE

LANDSCAPE SCHEDULE

QUANTITY	KEY	COMMON NAME	SCIENTIFIC NAME	SIZE / ROOT TYPE	NOTES
OVERSTORY TREES					
8	NH	Northern Acclaim Honey Locust	Gleditsia Tricanthos var. Inermis 'Harve'	2.5' cal. B&B	Straight Trunk, No V-Crotch
9	NH	New Horizon Elm	Ulmus carpinifolia 'New Horizon'	2.5' cal. B&B	Straight Trunk, No V-Crotch
7	SM	Autumn Spire Maple	Acer rubrum 'Autumn Spire'	2.5' cal. B&B	Straight Trunk, No V-Crotch
5	PB	Paper Birch	Betula papyrifera	10' ht. B&B	Clump Form
4	RB	River Birch	Betula nigra	12' ht. B&B	Clump Form
EVERGREEN TREES					
5	BS	Black Hills Spruce	Picea densata 'Black Hills'	10' ht. B&B	Clump Form
ORNAMENTAL TREES					
6	AD	Adirondack Flowering Crab	Malus 'Adirondack'	1.5' cal. B&B	Straight Trunk, No V-Crotch
SHRUBS					
78	BH	Dwarf Bush Honeysuckle	Diervilla lonicera	18" ht. cont.	Min. 5 canes at ht. spec.
51	GM	Goldmound Spirea	Spiraea 'Goldmound'	18" ht. cont.	Min. 5 canes at ht. spec.
9	HA	Holmstrup Arborvitae	Thuja occidentalis 'Holmstrup'	6' ht. B&B	Full Form
58	LH	Lime Light Hydrangea	Hydrangea paniculata 'Lime Light'	18" ht. cont.	Min. 5 canes at ht. spec.
6	RD	Red Twig Dogwood	Cornus Alba	36" ht. cont.	Min. 5 canes at ht. spec.
8	SJ	Scandia Juniper	Juniperus sabinia 'Skandia'	18" ht. cont.	Min. 5 canes at ht. spec.
58	TY	Taunton Yew	Taxus x media 'Taunton'	24" ht. cont.	Full Form
PERENNIALS & ORNAMENTAL GRASSES					
65	CBL	Chamagne Coral Bells	Heuchera 'Chamagne'	1gal. cont.	
8	GRZ	Miscanthus Graziella	Miscanthus sinensis 'Graziella'	3gal. cont.	
55	LBS	Little Bluestem	Schizachyrium scoparium	1gal. cont.	
32	MFG	Miscanthus Flame	Miscanthus sinensis 'Purpurascens'	3gal. cont.	
72	RUS	Little Spire Russian Sage	Perovskia atriplicifolia 'Little Spire'	1gal. cont.	
25	SAG	Sagae Hosta	Hosta 'Sagae'	1gal. cont.	
10	SSD	Stella Supreme Daylily	Hemerocallis 'Stella Supreme'	1gal. cont.	
84	WLC	Walker's Low Catmint	Nepeta x faassenii 'Walker's Low'	1gal. cont.	

LANDSCAPE REQUIREMENTS

DEVELOPABLE AREA:

TOTAL DEVELOPABLE AREA:	108,963 SF
APPLE TREE 4TH ADD.	
- LOT 1 BLK 1	
- OUTLOT A	

LANDSCAPE CALCULATIONS:

TREES REQUIRED: (1/2,500 SF DEVELOPABLE)	44 TREES
TREES PROVIDED:	44 TREES
SHRUBS REQUIRED: (1/1,000 SF DEVELOPABLE)	109 SHRUBS
SHRUBS PROVIDED:	268 SHRUBS

NOTE: TREES NOT REQUIRED IN PARKING LOTS WITH 50 OR FEWER SPACES.

SEED PLANTING NOTES:

WOODLAND SEED MIX: MN STATE SEED MIX #36-711 WOODLAND EDGE CENTRAL SEEDING RATE TO BE 35.5 LBS/ACRE (PURE LIVE SEED)

APPLY SEED PER THE FOLLOWING: MULCH SEEDED AREAS WITH MNDOT TYPE 3 (MOA CERTIFIED WEED FREE) MULCH AT A RATE OF 1 TON PER ACRE WITHIN 48 HOURS OF SEEDING. MULCH SHOULD THEN BE DISC ANCHORED TO KEEP IT FROM BLOWING AWAY.

SEEDING SHALL BE APPLIED FROM APRIL 15 - JUNE 30 OR NOVEMBER 1 - FREEZE UP. IF HYDROSEEDING UTILIZE APPROXIMATELY 500 GALLONS OF WATER PER ACRE. REFER TO MN/DOT SPEC 3884 FOR PROPER INSTALLATION OF HYDRO-SEED. ALL NATIVE SEEDS USED ON THIS PROJECT SHALL BE CERTIFIED TO BE OF MINNESOTA ORIGIN BY THE MINNESOTA CROP IMPROVEMENT ASSOCIATION (MCA). SITE TO BE PREPARED BY LOOSENING TOPSOIL TO A MINIMUM DEPTH OF 3 INCHES. THE SITE TO BE HARROWED OR RAKED FOLLOWING SEEDING, AND THEN PACKED USING A CULTI-PACKER OR EQUIVALENT. SEE MNDOT SEEDING MANUAL FOR REFERENCE.

MAINTAIN SEEDED AREAS BY WATERING, REMULCHING AND REPLANTING AS NECESSARY TO ESTABLISH A UNIFORMLY DENSE STAND OF THE SPECIFIED GRASSES UNTIL ACCEPTED. ANY AREAS FAILING TO ESTABLISH A STAND SHALL BE RESEDED, REFERTILIZED AND REMULCHED WHENEVER 70% VEGETATIVE COVER IS NOT ACHIEVED. RESEEDING SHALL CONFORM IN ALL RESPECTS TO THESE SPECIFICATIONS. THE CONTRACTOR SHALL REPAIR ANY DAMAGE TO THE WORK AREAS RESULTING FROM EROSION AND/OR EQUIPMENT. THE CONTRACTOR SHALL REPAIR DAMAGE, INCLUDING REGRADING, RESEEDING, ETC. AS NECESSARY, BEFORE SIGNIFICANT DAMAGE OCCURS.

REFER TO MINNESOTA STATE SEED MIX MANUAL.

SOIL PREPARATION:

- PRIOR TO THE INSTALLATION OF THE LANDSCAPE AND IRRIGATION SYSTEM, CONTRACTOR TO PREPARE SOIL TO ENSURE A PROPER ENVIRONMENT FOR PLANT ROOT DEVELOPMENT.
- CONTRACTOR TO DE-COMPACT SOILS IN PLANTING AREAS BY ROTO-TILLING, DISKING OR RIPPING TO DEPTH OF 6-8" MINIMUM AND PREFERABLE A DEPTH OF 12-18". DE-COMPACTING OF SMALL PLANTER AREAS, SUCH AS THOSE IN PARKING LOT AREAS, MAY REQUIRE THE REMOVAL OF THE COMPACTED SOIL TO A DEPTH OF 18" OR MORE AND THEN RE-INSTALLED LOOSELY WITH REQUIRED AMENDMENTS. ALWAYS REMOVE DEBRIS OVER 2" IN SIZE FROM THE SOIL.
- WHEN PERFORMING SOIL DE-COMPACTION, MULTIPLE PASSES ACROSS THE AREA WILL BE REQUIRED AND, WHEN POSSIBLE, SHOULD BE AT VARYING ANGLES TO ENSURE ADEQUATE COVERAGE. WHEN USING DISC OR RIPPING EQUIPMENT, IT IS REQUIRED THAT THE FINAL PASSES OVER THE AREA BE MADE WITH A ROTO-TILLER TO BREAK UP ANY LARGE CLUMPS TO MAKE FINAL GRADING EASIER.
- AFTER INITIAL SOIL DE-COMPACTION PROCEDURES ARE PERFORMED, SOIL AMENDMENTS SHOULD BE ADDED. THE ADDITION OF SOIL AMENDMENTS IS DETERMINED FROM SOIL TESTS CONDUCTED PRIOR TO WORK COMMENCING. SOIL AMENDMENT MAY INCLUDE INORGANIC MATERIAL SUCH AS SAND, SILT OR CLAY, WHICH HELP IMPROVE SOIL TEXTURE. ORGANIC MATERIAL SUCH AS COMPOST, MANURE, AND PEAT MOSS MAY ALSO BE USED AND HELP IMPROVE SOIL STRUCTURE. OTHER AMENDMENTS SUCH AS FERTILIZER IMPROVE NUTRIENT CONTENT AND SULFUR ADJUSTS THE SOIL PH LEVEL. SULFUR SHALL BE INCORPORATED AT THE RATE OF ONE POUND OF SULFUR PER 100 SQUARE FEET.
- ALL AMENDMENTS SHOULD BE MIXED THOROUGHLY WITH EXISTING SOIL AND AN ADDITIONAL SOIL TEST WILL BE TAKEN TO ENSURE PROPER SOIL CONDITIONS PRIOR TO PLANTING.



ALLIANT
ENGINEERING

733 Marquette Avenue
Suite 700
Minneapolis, MN 55402
612.758.3080
www.alliant-inc.com

AMERICAN SQUARE APARTMENTS
BLOOMINGTON, MN

LANDSCAPE DETAILS

I hereby certify that this plan, specification, or report was prepared by me or under my direct supervision and that I am a duly Licensed PROFESSIONAL ENGINEER under the laws of the State of MINNESOTA

DAVID NASH, PE
12-30-19
Date License No.

QUALITY ASSURANCE/CONTROL

BY	DATE
DATE	ISSUE
01-29-20	CITY SUBMITTAL
03-27-20	PROGRESS PLOT
05-06-20	REVISED CITY SUBMITTAL

PROJECT TEAM DATA
DESIGNED: DWS/DJN
DRAWN: KDB/DMS
PROJECT NO: 190123

L-2.0