


Must meet 2020 MN State Building Code

Must meet 2020 MN Accessibility Code.

Provide a detailed code analysis with the plans.

SAC review by MET council will be required.

Building plans must be signed by a MN licensed architect.

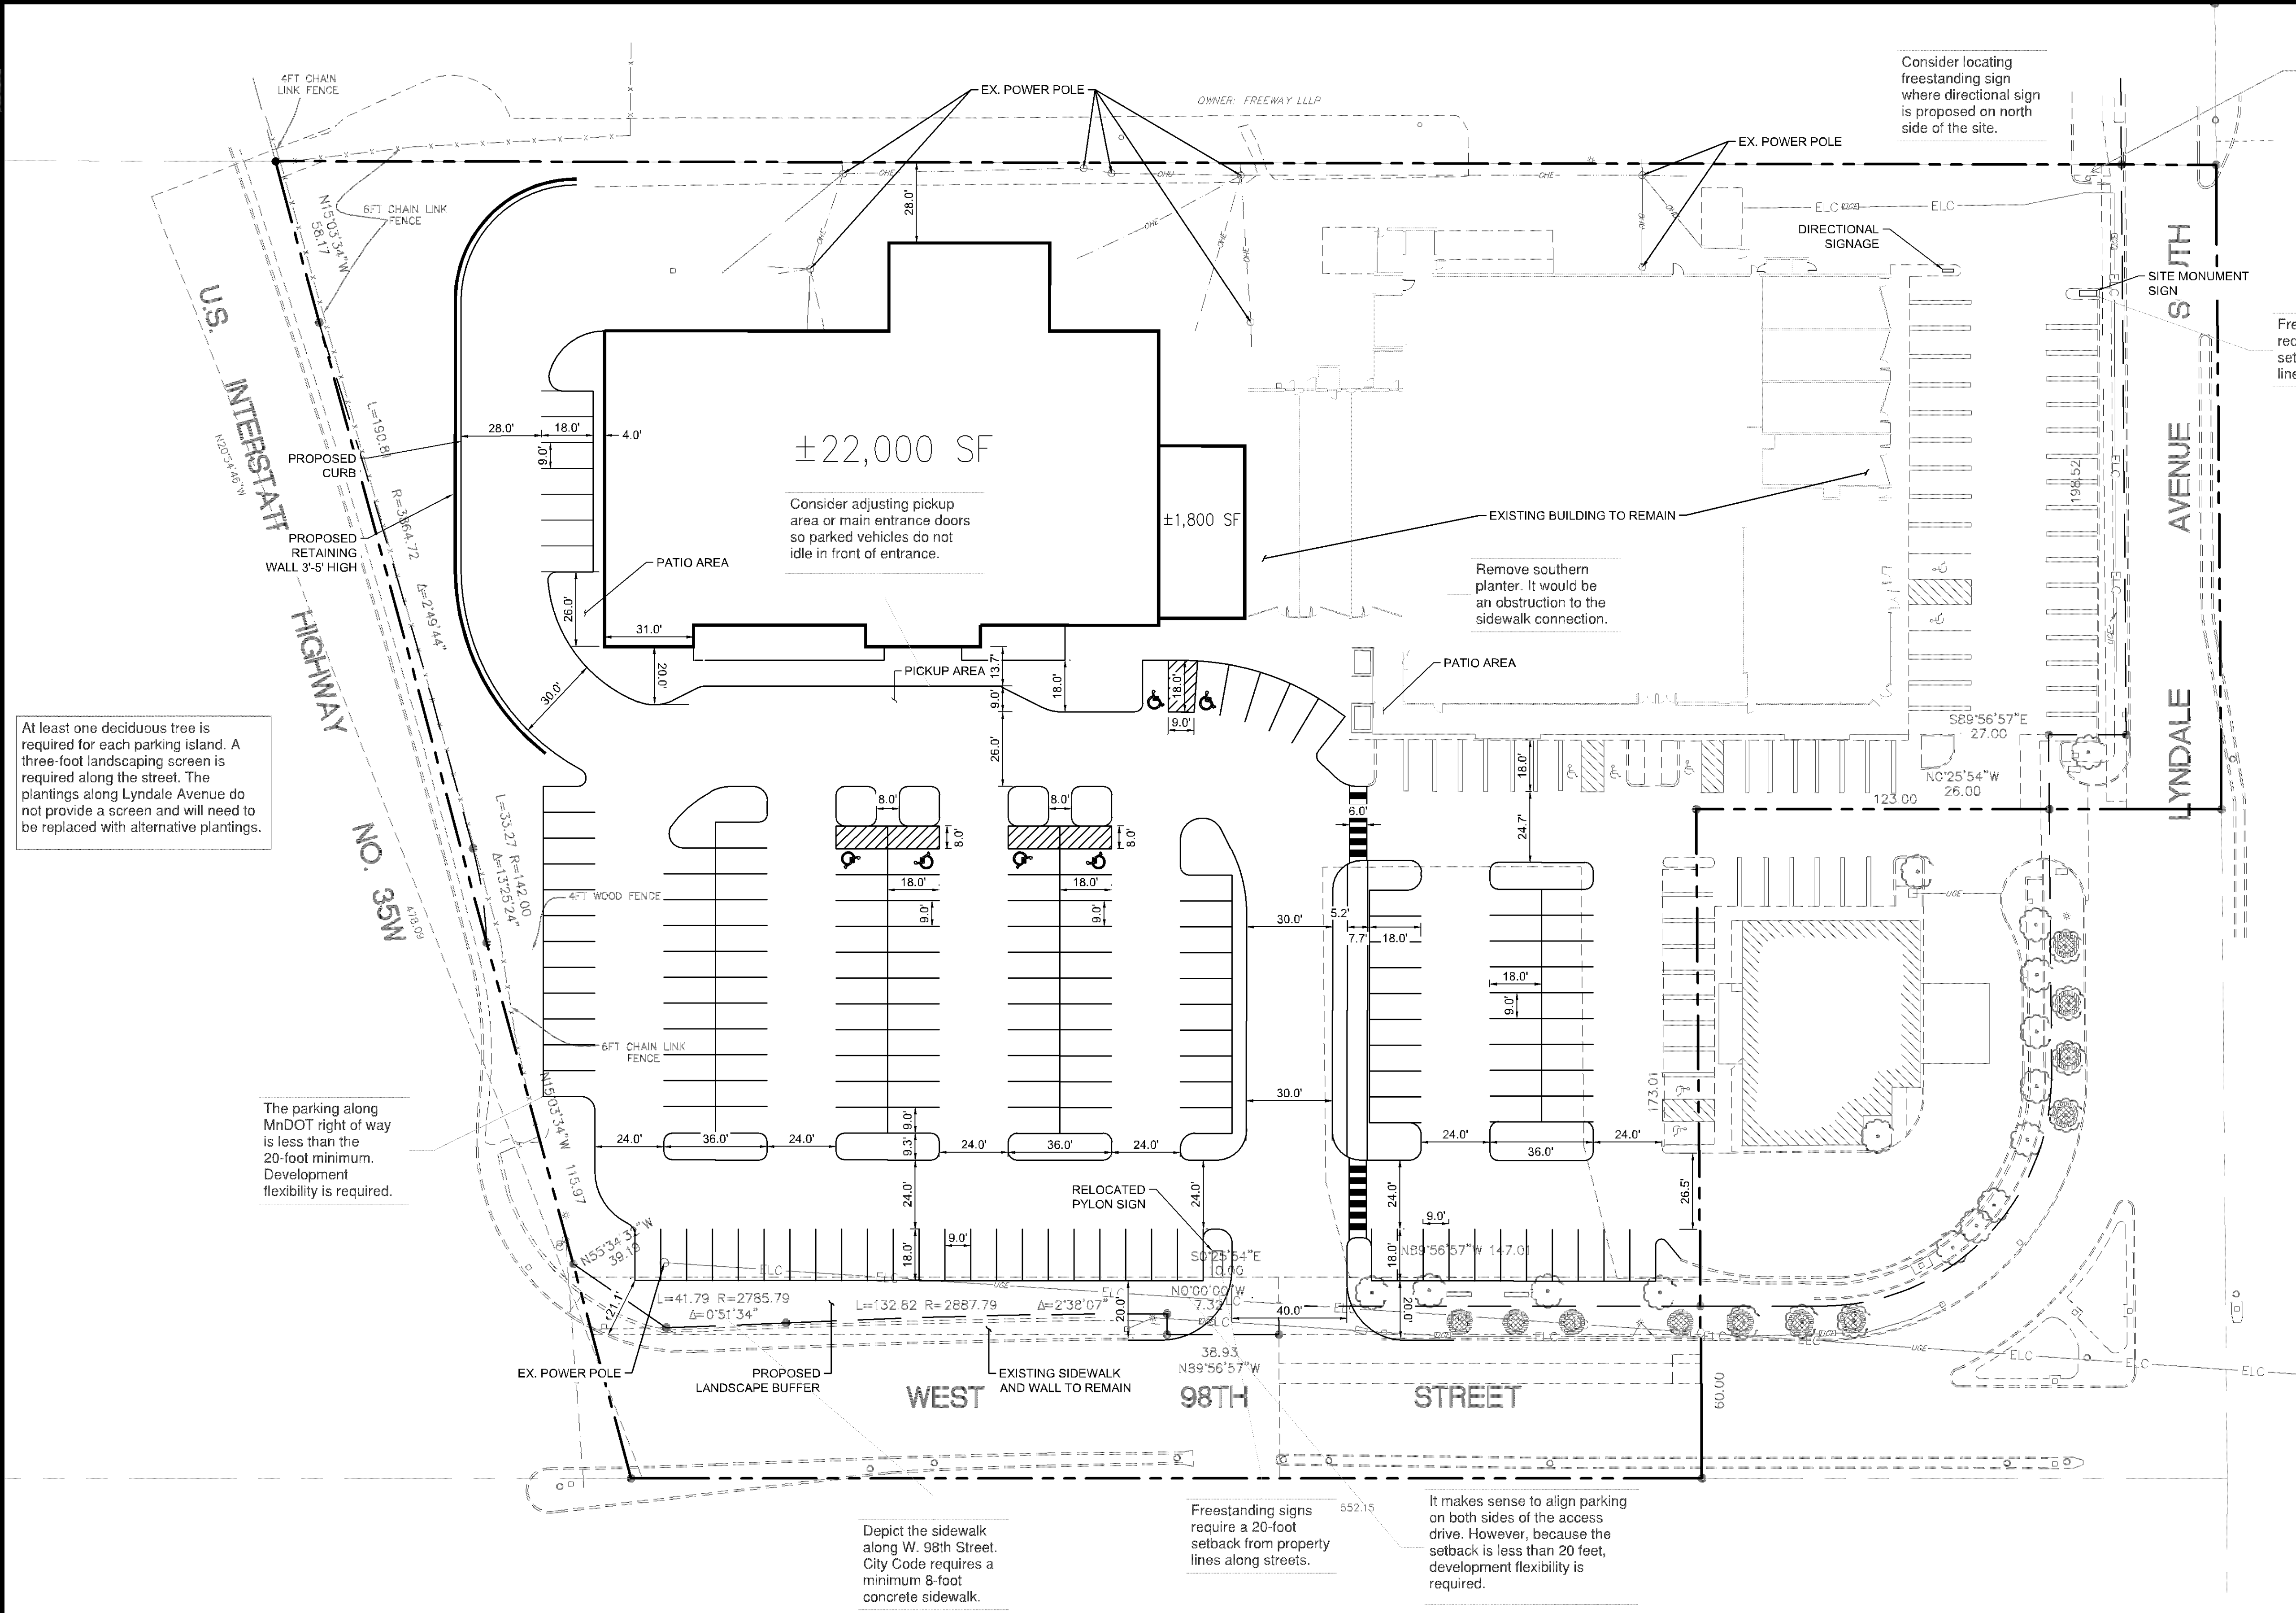

Existing Clover Center Sign must be relocated/removed.

Freestanding signs require a 20-foot setback from property lines along streets.

BUILDING SUMMARY	
EXISTING	PROPOSED
±58,810 SF	±54,800 SF

PARKING SUMMARY		
	EXISTING	PROPOSED
WESTERN LOT	131 STALLS	124 STALLS
EASTERN LOT	117 STALLS	106 STALLS
TOTAL PARKING	248 STALLS	230 STALLS

The overall parking requirement with the proposed redevelopment would decrease. Please provide the uses for tenant spaces, including the number of seats for restaurants. Staff will prepare a parking analysis to determine the level of deviation from City Code. Depending on the level of deviation, a parking study may be necessary prior to the City accepting a development application

A traffic study will be necessary prior to the City accepting a development application

CLOVER SHOPPING
CENTER REDEVELOPMENT

PREPARED FOR
KRAUS
ANDERSON

BLOOMINGTON MINNESOTA

Kimley»Horn

767 EUSTIS STREET, SUITE 100, ST. PAUL, MN 55114
PHONE: 651-645-4197
WWW.KIMLEY-HORN.COM

KHA PROJECT
XXXXXXXXXX


DATE
06/16/2021

SCALE AS SHOWN

DESIGNED BY LEC


DRAWN BY LEC

CHECKED BY WDM

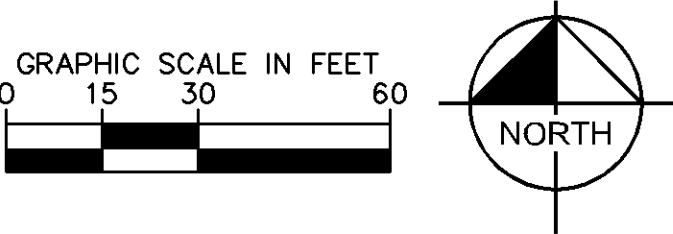

CLOVER SHOPPING
CENTER EXHIBIT

EX 1

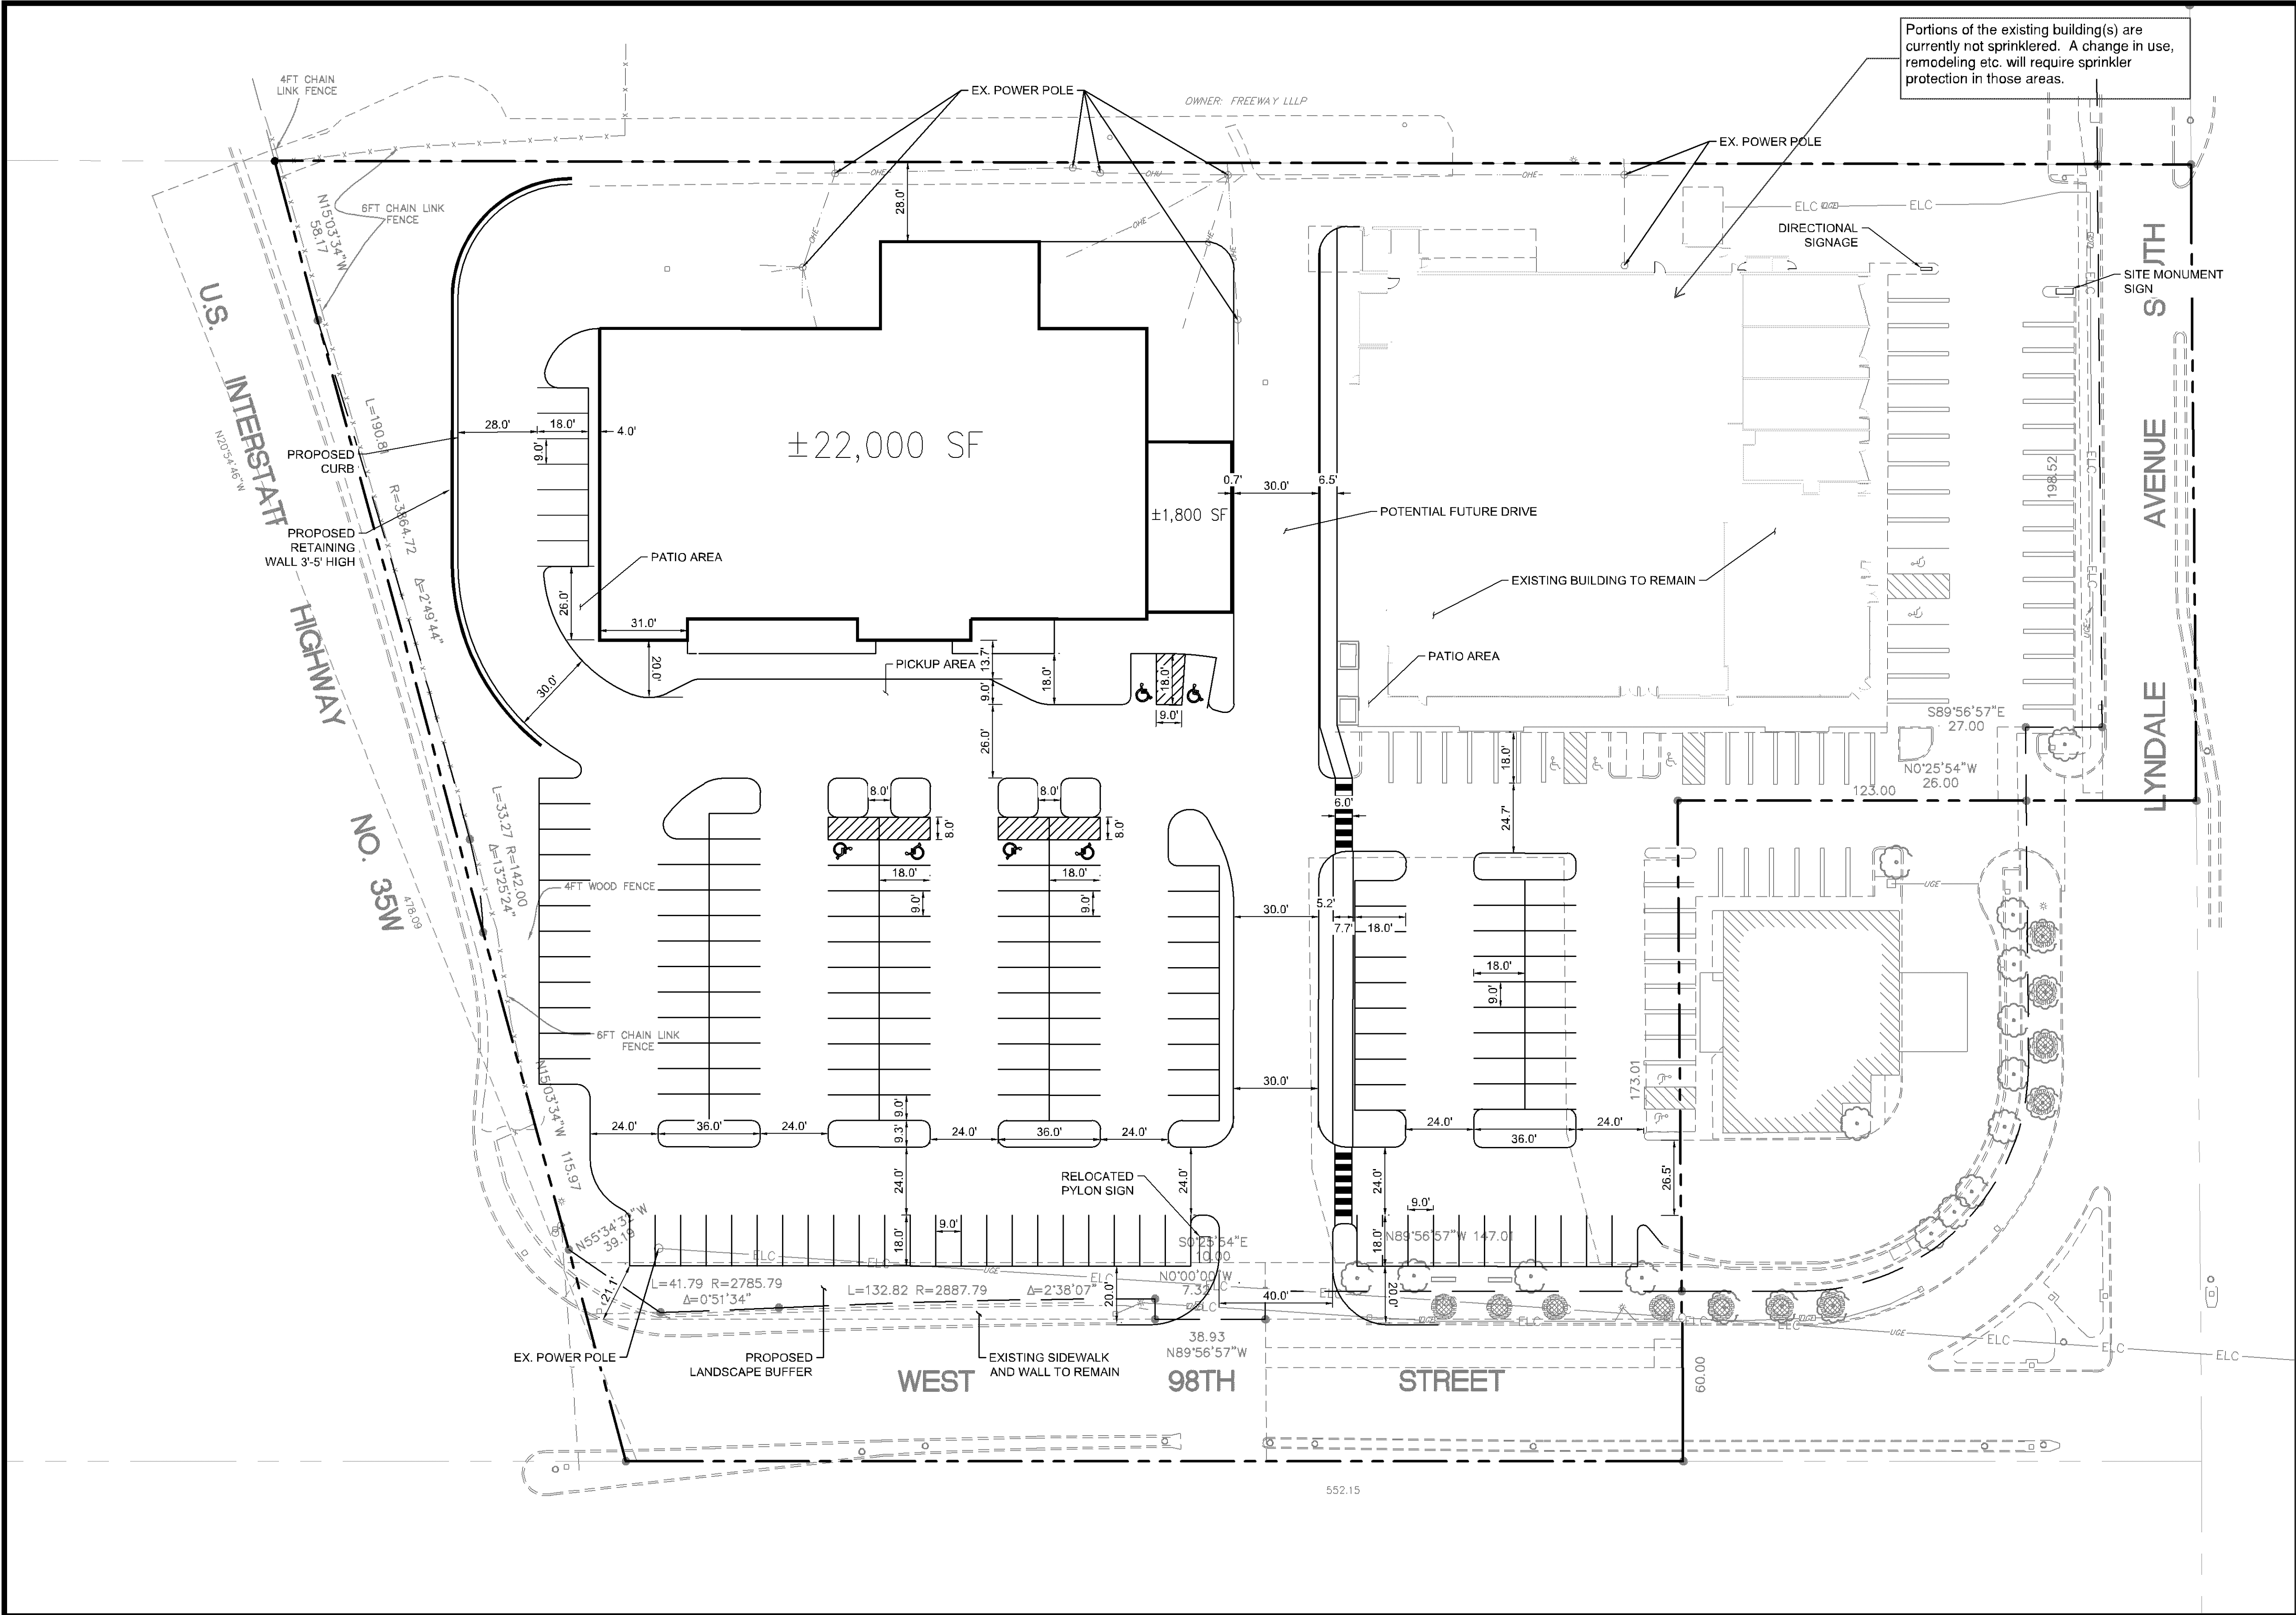

Provide adequate turning radius for BFD Ladder 3.

Additional hydrants will be required to provide coverage within 150' of all exterior walls.

BUILDING SUMMARY	
EXISTING	PROPOSED
±58,810 SF	±50,330 SF


PARKING SUMMARY		
	EXISTING	PROPOSED
WESTERN LOT	131 STALLS	120 STALLS
EASTERN LOT	117 STALLS	106 STALLS
TOTAL PARKING	248 STALLS	226 STALLS

"EX 2" could be identified as a Phase II for the Clover Center preliminary development plan. Also envision what a Phase III and any additional phases would entail.

CLOVER SHOPPING
CENTER REDEVELOPMENT
PREPARED FOR
KRAUS
ANDERSON
BLOOMINGTON MINNESOTA

Kimley»Horn
767 EUSTIS STREET, SUITE 100, ST. PAUL, MN 55114
PHONE: 651-645-4197
WWW.KIMLEY-HORN.COM

KHA PROJECT
XXXXXXXXXX
DATE
06/16/2021
SCALE AS SHOWN
DESIGNED BY LEC
DRAWN BY LEC
CHECKED BY WDM

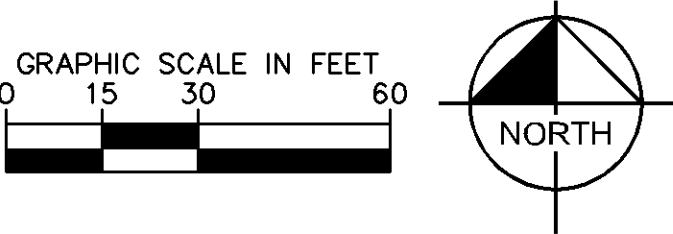

CLOVER SHOPPING
CENTER EXHIBIT - DRIVE
EXTENSION

EX 2



The City has very specific standards pertaining to exterior building materials. Brick, glass, and stucco are permitted primary building materials. There are limitations on "secondary" materials such as EIFS and fiber cement panels. Metal panels may be permitted as "primary" material, subject to finish warranty and gauge requirements.



