


This document, together with the concepts and designs presented herein, as an instrument of service, is intended only for the specific purpose and client for which it was prepared. Reuse of and improper reliance on this document without written authorization and adaptation by Kimley-Horn and Associates, Inc. shall be without liability to Kimley-Horn and Associates, Inc.

CASE #PL2021-251

KEYNOTE LEGEND

- (A) REMOVE EXISTING BUILDING, FOOTINGS, FOUNDATIONS & ASSOCIATED SERVICES
- (B) REMOVE BITUMINOUS SURFACE
- (C) REMOVE CONCRETE SURFACE
- (D) REMOVE EXISTING TREE
- (E) REMOVE EXISTING UTILITY
- (F) REMOVE EXISTING LIGHT POLE
- (G) REMOVE EXISTING STRUCTURE
- (H) PROTECT EXISTING STRUCTURE
- (I) REMOVE EXISTING MONUMENT SIGN
- (J) PROTECT EXISTING UTILITY
- (K) PROTECT EXISTING CURB & GUTTER
- (L) PROTECT EXISTING HYDRANT
- (M) REMOVE EXISTING CONCRETE CURB & GUTTER
- (N) PROTECT EXISTING TREE WITH TREE PROTECTION FENCING
- WHERE POSSIBLE, REMOVE 4" WATER SERVICE ON-SITE. REMAINDER OF 4" WATER SERVICE TO BE ABANDONED WITH SAND. REMOVE CONNECTION TO WATERMAIN IN VIKING DRIVE PER CITY OF BLOOMINGTON SPECIFICATIONS
- (O) UTILITY DISCONNECTION, MATCH EXISTING PAVEMENT SECTION IN 78TH STREET WEST AND VIKING DRIVE

Consider verifying plans of this MnDOT outfall with future I-494 project. Consider collaboration, if applicable

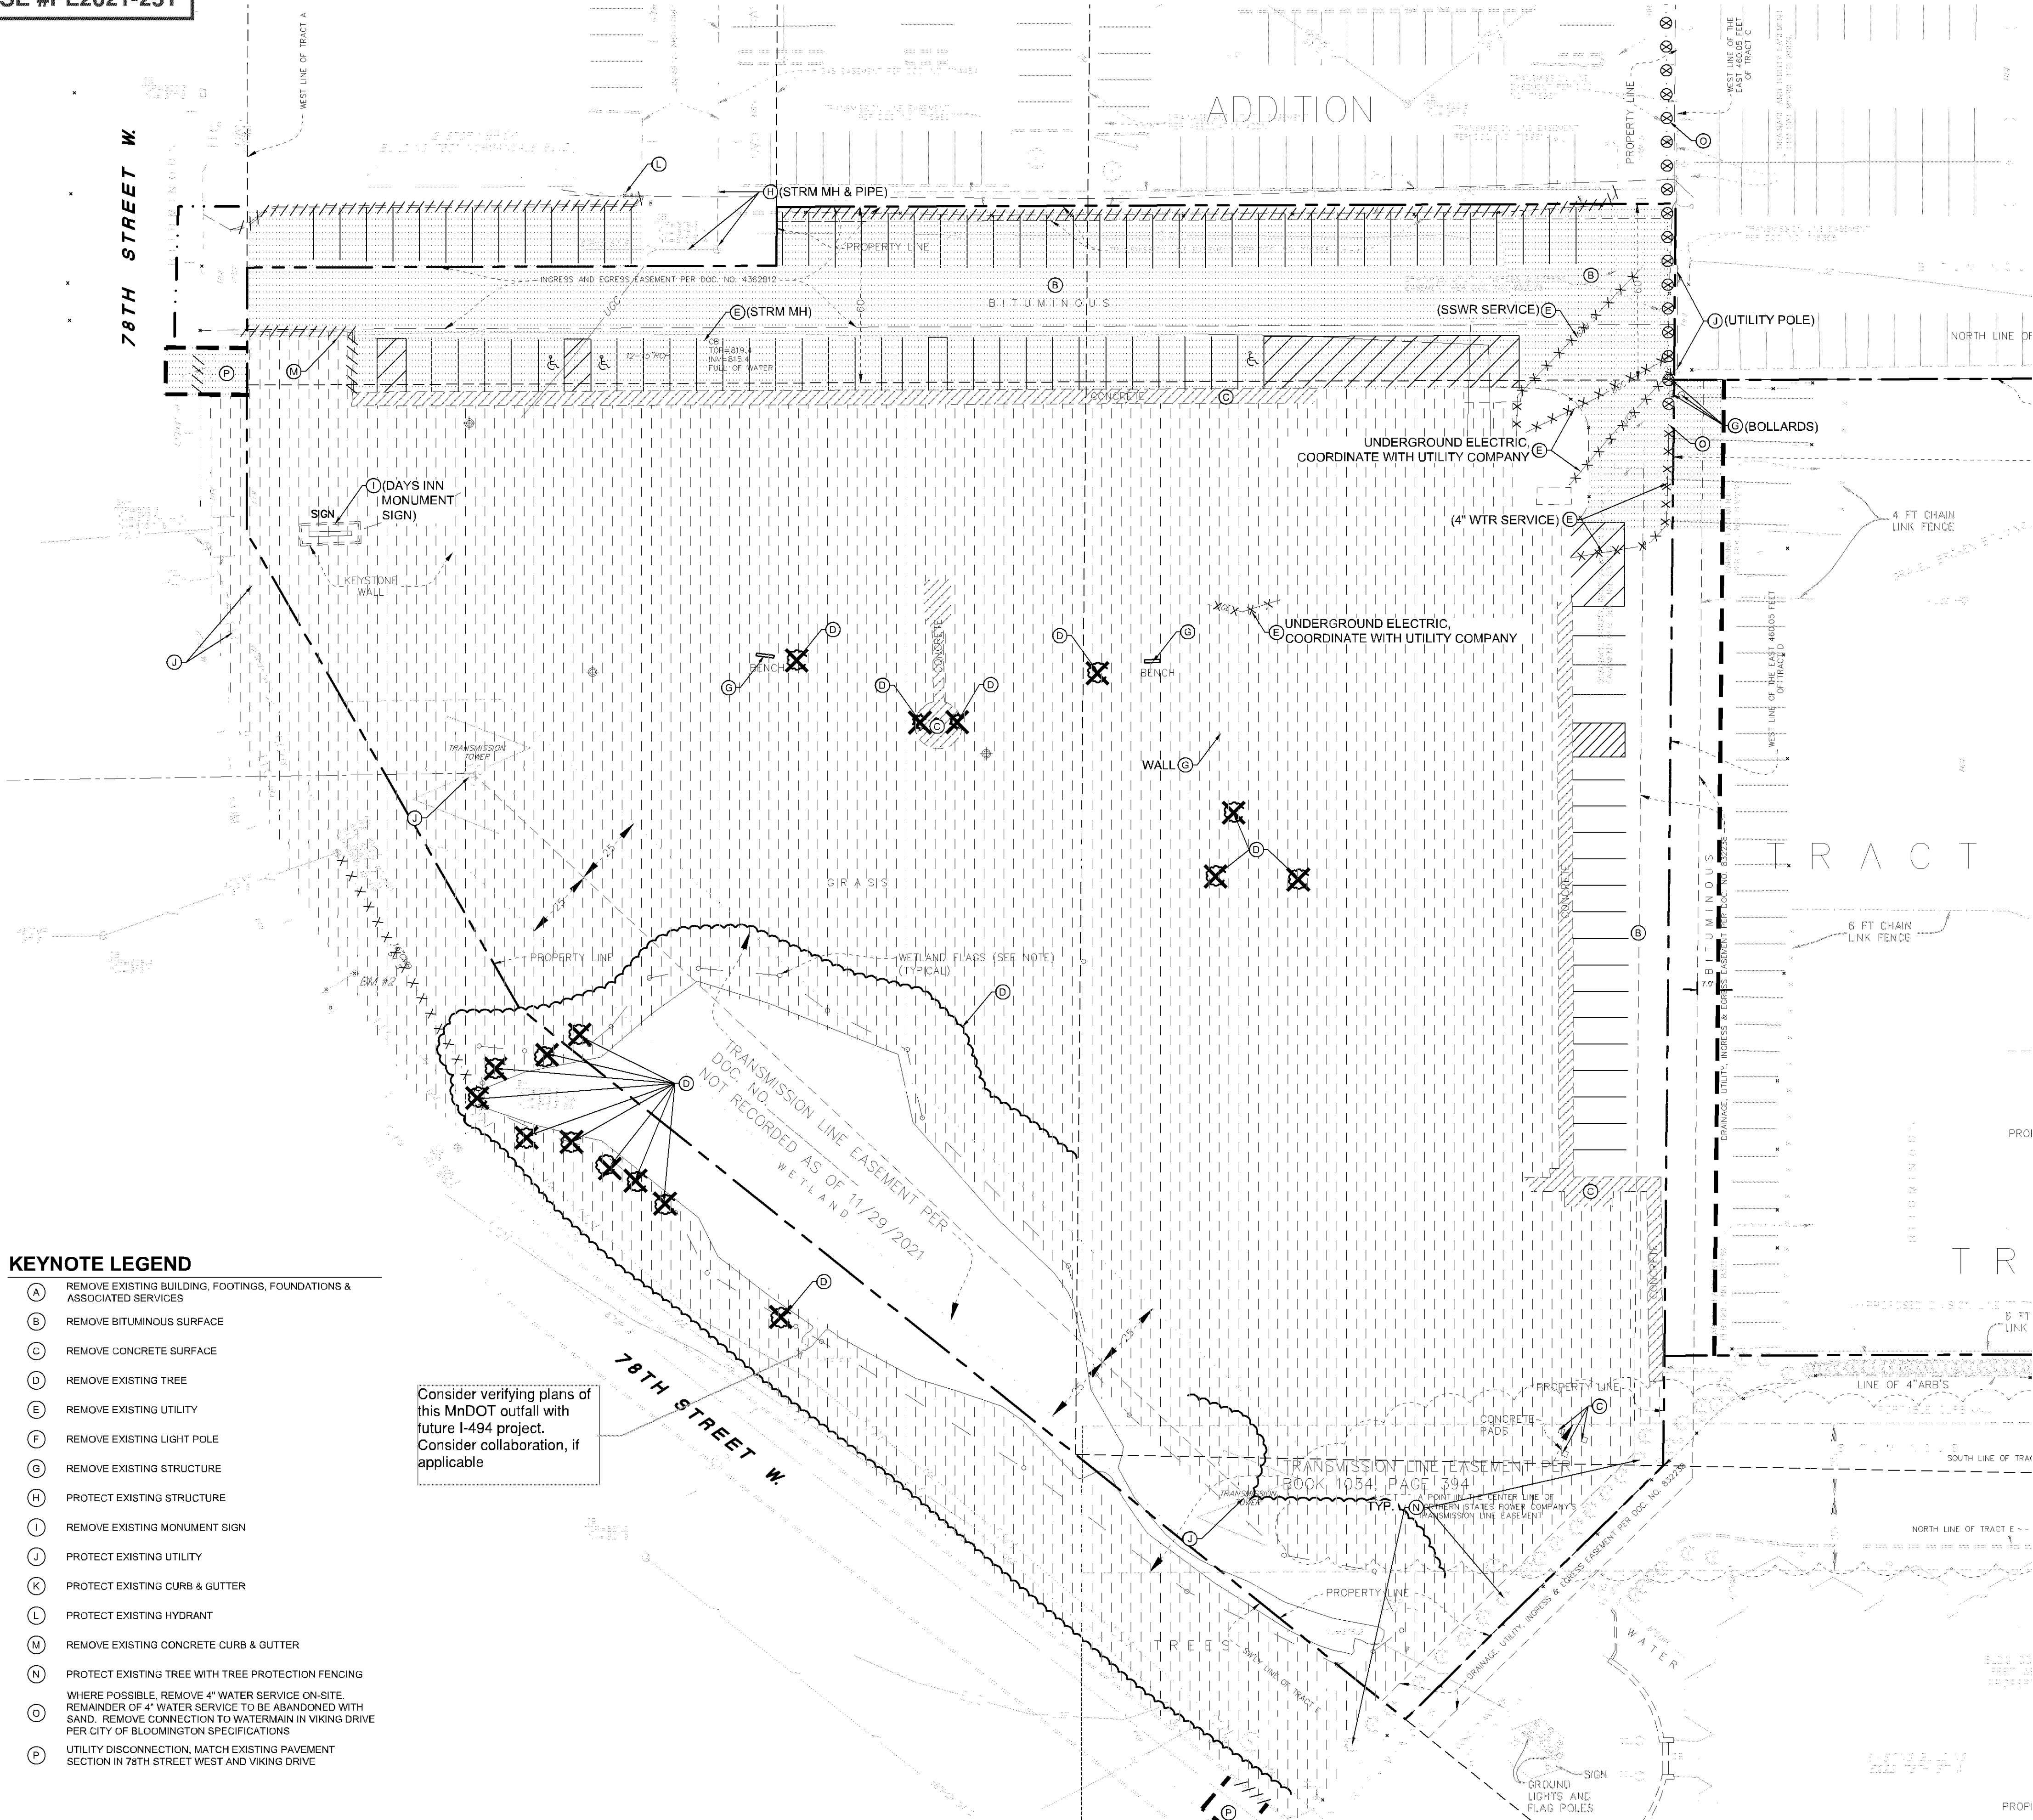


DEMOLITION PLAN NOTES

1. THE CONTRACTOR IS RESPONSIBLE FOR THE DEMOLITION, REMOVAL, AND DISPOSAL (IN A LOCATION APPROVED BY ALL GOVERNING AUTHORITIES) ALL STRUCTURES, PADS, WALLS, FLUMES, FOUNDATIONS, PARKING, DRIVES, DRAINAGE STRUCTURES, UTILITIES, ETC. SUCH THAT THE IMPROVEMENTS ON THE PLANS CAN BE CONSTRUCTED. ALL FACILITIES TO BE REMOVED SHALL BE UNDERCUT TO SUITABLE MATERIAL AND BROUGHT TO GRADE WITH SUITABLE COMPACTED FILL MATERIAL PER THE PROJECT DOCUMENTS.
2. THE CONTRACTOR IS RESPONSIBLE FOR REMOVING ALL DEBRIS FROM THE SITE AND DISPOSING THE DEBRIS IN A LAWFUL MANNER. THE CONTRACTOR IS RESPONSIBLE FOR OBTAINING ALL PERMITS REQUIRED FOR DEMOLITION AND DISPOSAL. THE CONTRACTOR SHALL PROVIDE COPIES OF THE PERMIT AND RECEIPTS OF DISPOSAL OF MATERIALS TO THE OWNER AND OWNERS REPRESENTATIVE.
3. THE CONTRACTOR SHALL MAINTAIN ALL UTILITY SERVICES TO ADJACENT PROPERTIES AT ALL TIMES. UTILITY SERVICES SHALL NOT BE INTERRUPTED WITHOUT APPROVAL FROM THE CONSTRUCTION MANAGER AND COORDINATION WITH THE ADJACENT PROPERTIES AND/OR THE CITY.
4. THE CONTRACTOR SHALL COORDINATE WITH RESPECTIVE UTILITY COMPANIES PRIOR TO THE REMOVAL AND/OR RELOCATION OF UTILITIES. THE CONTRACTOR SHALL COORDINATE WITH THE UTILITY COMPANY CONCERNING PORTIONS OF WORK WHICH MAY BE PERFORMED BY THE UTILITY COMPANY'S FORCES AND ANY FEES WHICH ARE TO BE PAID TO THE UTILITY COMPANY FOR THEIR SERVICES. THE CONTRACTOR IS RESPONSIBLE FOR PAYING ALL FEES AND CHARGES.
5. THE LOCATIONS OF ALL EXISTING UTILITIES SHOWN ON THE PLAN HAVE BEEN DETERMINED FROM THE BEST INFORMATION AVAILABLE AND ARE GIVEN FOR THE CONVENIENCE OF THE CONTRACTOR. THE ENGINEER ASSUMES NO RESPONSIBILITY FOR THEIR ACCURACY. PRIOR TO THE START OF ANY DEMOLITION ACTIVITY, THE CONTRACTOR SHALL NOTIFY THE UTILITY COMPANIES FOR LOCATIONS OF EXISTING UTILITIES WITHIN ALL AREAS OF PROPOSED WORK.
6. ALL EXISTING SEWERS, PIPING AND UTILITIES SHOWN ARE NOT TO BE INTERPRETED AS THE EXACT LOCATION, OR AS ANY OBSTACLES THAT MAY OCCUR ON THE SITE. VERIFY EXISTING CONDITIONS AND PROCEED WITH CAUTION AROUND ANY ANTICIPATED FEATURES. GIVE NOTICE TO ALL UTILITY COMPANIES REGARDING DESTRUCTION AND REMOVAL OF ALL SERVICE LINES AND CAP ALL LINES BEFORE PRECEDING WITH THE WORK.
7. ELECTRICAL, TELEPHONE, CABLE, WATER, FIBER OPTIC, AND/OR GAS LINES NEEDING TO BE REMOVED OR RELOCATED SHALL BE COVERED AFFECTED UTILITY COMPANY. ADEQUATE TIME SHALL BE PROVIDED FOR RELOCATION AND CLOSE COORDINATION WITH THE UTILITY COMPANY IS NECESSARY TO PROVIDE A SMOOTH TRANSITION IN UTILITY SERVICE. CONTRACTOR SHALL PAY CLOSE ATTENTION TO EXISTING UTILITIES WITHIN ANY ROAD RIGHT-OF-WAY DURING CONSTRUCTION.
8. CONTRACTOR MUST PROTECT THE PUBLIC AT ALL TIMES WITH FENCING, BARRICADES, ENCLOSURES, ETC. (AND OTHER APPROPRIATE BEST MANAGEMENT PRACTICES) AS APPROVED BY THE CONSTRUCTION MANAGER. MAINTENANCE OF TRAFFIC CONTROL SHALL BE COORDINATED IN ACCORDANCE WITH BLOOMINGTON, HENNEPIN COUNTY AND MNDOT.
9. CONTRACTOR SHALL MAINTAIN ACCESS TO ALL ADJACENT PROPERTIES DURING CONSTRUCTION, AND SHALL NOTIFY ALL PROPERTIES IF ACCESS WILL BE INTERRUPTED OR ALTERED AT ANY TIME DURING CONSTRUCTION.
10. PRIOR TO DEMOLITION OCCURRING, ALL EROSION CONTROL DEVICES ARE TO BE INSTALLED.
11. CONTRACTOR MAY LIMIT SAW-CUT AND PAVEMENT REMOVAL TO ONLY THOSE AREAS WHERE IT IS REQUIRED AS SHOWN ON THESE CONSTRUCTION PLANS BUT IF ANY DAMAGE IS INCURRED ON ANY OF THE SURROUNDING PAVEMENT, ETC. THE CONTRACTOR SHALL BE RESPONSIBLE FOR ITS REMOVAL AND REPAIR.
12. THE CONTRACTOR SHALL COORDINATE WATER MAIN WORK WITH THE FIRE DEPT. AND THE CITY WATER DEPARTMENT TO PLAN PROPOSED IMPROVEMENTS AND TO ENSURE ADEQUATE FIRE PROTECTION IS CONSTANTLY AVAILABLE TO THE SITE THROUGHOUT THIS SPECIFIC WORK AND THROUGH ALL PHASES OF CONSTRUCTION. CONTRACTOR WILL BE RESPONSIBLE FOR ARRANGING/PROVIDING ANY REQUIRED WATER MAIN SHUT OFFS WITH THE CITY OF BLOOMINGTON DURING CONSTRUCTION. ANY COSTS ASSOCIATED WITH WATER MAIN SHUT OFFS WILL BE THE RESPONSIBILITY OF THE CONTRACTOR AND NO EXTRA COMPENSATION WILL BE PROVIDED.
13. REFER TO SURVEY FOR ALL EXISTING INVERT AND RIM ELEVATIONS.
14. ALL UTILITIES SHOWN ARE EXISTING UTILITIES.
15. IN THE EVENT A WELL IS FOUND, THE CONTRACTOR SHALL CONTACT THE ENGINEER AND OWNER IMMEDIATELY. ALL WELLS SHALL BE SEALED BY A LICENSED WELL CONTRACTOR IN ACCORDANCE WITH ALL STATE OF MN REQUIREMENTS.
16. IN THE EVENT THAT UNKNOWN CONTAINERS OR TANKS ARE ENCOUNTERED, THE CONTRACTOR SHALL CONTACT THE OWNER AND/OR OWNERS REPRESENTATIVE IMMEDIATELY. ALL CONTAINERS SHALL BE DISPOSED OF AT A PERMITTED LANDFILL PER THE PROJECT DOCUMENTS.
17. CONTRACTOR SHALL NOTIFY THE ENGINEER IF ANY EXISTING DRAINLITE IS ENCOUNTERED ON SITE. NO ACTIVE DRAINLITE SHALL BE REMOVED WITHOUT APPROVAL FROM THE ENGINEER.
18. ALL CONSTRUCTION AND POST-CONSTRUCTION PARKING AND STORAGE OF EQUIPMENT AND MATERIALS MUST BE LOCATED ON-SITE. USE OF PUBLIC STREETS FOR PRIVATE CONSTRUCTION PARKING, LOADING/UNLOADING, AND STORAGE WILL NOT BE ALLOWED.
19. ALL UNUSED WATER SERVICES MUST BE PROPERLY ABANDONED AT THE MAIN. ALL UNUSED SANITARY SEWER SERVICES MUST BE PROPERLY ABANDONED AT THE PROPERTY LINE.

LEGEND

- | | |
|--|---|
| | PROPERTY LINE |
| | REMOVE BITUMINOUS SURFACE |
| | REMOVE CONCRETE SURFACE |
| | REMOVE BUILDING |
| | CLEARING & GRUBBING |
| | FULL DEPTH SAWCUT |
| | REMOVE TREE |
| | REMOVE CONCRETE CURB & GUTTER |
| | REMOVE UTILITY LINES |
| | FILL & ABANDON UTILITY LINES |
| | LIMITS OF CONSTRUCTION, OFFSET 3' FOR CLARITY |
| | EXISTING OVERHEAD POWER LINE |
| | EXISTING CHAINLINK FENCE |
| | EXISTING RETAINING WALL |
| | EXISTING SANITARY SEWER |
| | EXISTING STORM SEWER |
| | EXISTING WATERMAIN |
| | EXISTING GAS MAIN |
| | EXISTING UNDERGROUND TELEPHONE |
| | EXISTING CONTOUR |
| | EXISTING CURB & GUTTER |
| | EXISTING SIGN |
| | EXISTING FLARED END SECTION |
| | EXISTING STORM MANHOLE |
| | EXISTING STORM CATCHBASIN |
| | EXISTING GAS METER |
| | EXISTING POST INDICATOR VALVE |
| | EXISTING WELL |
| | EXISTING GATE VALVE |
| | EXISTING HYDRANT |
| | EXISTING METAL COVER |
| | EXISTING ELECTRICAL METER |
| | EXISTING AIR CONDITIONER |
| | EXISTING TELEPHONE MANHOLE |
| | EXISTING CABLE BOX |
| | EXISTING GUY WIRE |
| | EXISTING POWER POLE |
| | EXISTING LIGHT POLE |
| | EXISTING TREE |
| | EXISTING TREE LINE |

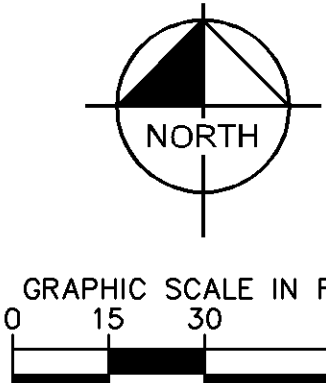


PRELIMINARY - NOT FOR CONSTRUCTION

BLOOMINGTON WEST REDEVELOPMENT	PREPARED FOR UNITED PROPERTIES	BLOOMINGTON MN	SHEET NUMBER C200	KHA PROJECT 160576002	DATE 12/01/2021	SCALE AS SHOWN	DESIGNED BY EIS	DRAWN BY EIS	CHECKED BY TJL	DATE 12/01/2021	EIS	BY	
EXISTING CONDITIONS AND REMOVALS PLAN				DEVELOPMENT APPLICATION				REVISIONS					
Kimley»Horn				2021 KIMLEY-HORN AND ASSOCIATES, INC. 767 EUSTIS STREET, SUITE 100, ST. PAUL, MN 55114 PHONE: 651-445-4187 WWW.KIMLEY-HORN.COM									

KEYNOTE LEGEND




A	REMOVE EXISTING BUILDING, FOOTINGS, FOUNDATIONS & ASSOCIATED SERVICES
B	REMOVE BITUMINOUS SURFACE
C	REMOVE CONCRETE SURFACE
D	REMOVE EXISTING TREE
E	REMOVE EXISTING UTILITY
F	REMOVE EXISTING LIGHT POLE
G	REMOVE EXISTING STRUCTURE
H	PROTECT EXISTING STRUCTURE
I	REMOVE EXISTING MONUMENT SIGN
J	PROTECT EXISTING UTILITY
K	PROTECT EXISTING CURB & GUTTER
L	PROTECT EXISTING HYDRANT
M	REMOVE EXISTING CONCRETE CURB & GUTTER
N	PROTECT EXISTING TREE WITH TREE PROTECTION FENCING
O	WHERE POSSIBLE, REMOVE 4" WATER SERVICE ON-SITE. REMAINDER OF 4" WATER SERVICE TO BE ABANDONED WITH SAND. REMOVE CONNECTION TO WATERMAIN IN VIKING DRIVE PER CITY OF BLOOMINGTON SPECIFICATIONS
P	UTILITY DISCONNECTION, MATCH EXISTING PAVEMENT SECTION IN 78TH STREET WEST AND VIKING DRIVE

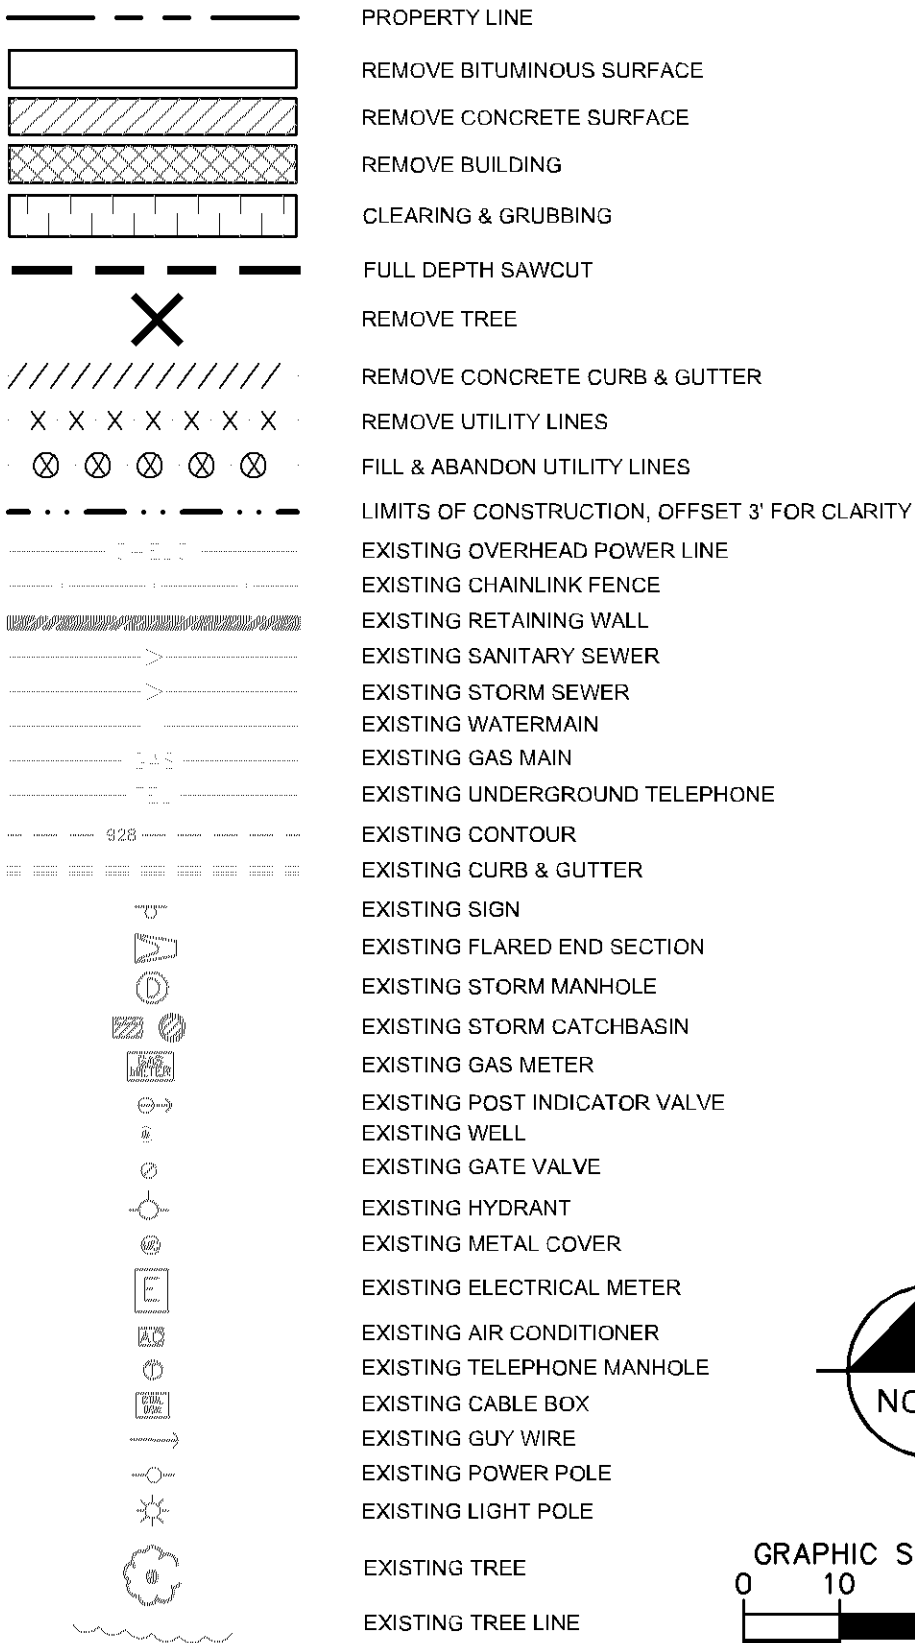

1. THE CONTRACTOR IS RESPONSIBLE FOR THE DEMOLITION, REMOVAL, AND DISPOSAL, (IN A LOCATION APPROVED BY ALL GOVERNING AUTHORITIES) ALL STRUCTURES, PADS, WALLS, FUMES, FOUNDATIONS, PARKING, DRIVERS, DRAINAGE STRUCTURES, UTILITIES, ETC. SUCH THAT THE IMPROVEMENTS ON THE PLANS CAN BE CONSTRUCTED. ALL FACILITIES TO BE REMOVED SHALL BE UNDERCUT TO SUITABLE MATERIAL AND BROUGHT TO GRADE WITH SUITABLE COMPACTED FILL MATERIAL PER THE PROJECT DOCUMENTS.
2. THE CONTRACTOR IS RESPONSIBLE FOR REMOVING ALL DEBRIS FROM THE SITE AND DISPOSING THE DEBRIS IN A LAWFUL MANNER. THE CONTRACTOR IS RESPONSIBLE FOR OBTAINING ALL PERMITS REQUIRED FOR DEMOLITION AND DISPOSAL. CONTRACTOR SHALL PROVIDE COPIES OF THE PERMIT AND RECEIPTS OF DISPOSAL OF MATERIALS TO THE OWNER AND OWNERS REPRESENTATIVE.
3. THE CONTRACTOR SHALL MAINTAIN ALL UTILITY SERVICES TO ADJACENT PROPERTIES AT ALL TIMES. UTILITY SERVICES SHALL NOT BE INTERRUPTED WITHOUT APPROVAL FROM THE CONSTRUCTION MANAGER AND COORDINATION WITH THE ADJACENT PROPERTIES AND/OR THE CITY.
4. THE CONTRACTOR SHALL COORDINATE WITH RESPECTIVE UTILITY COMPANIES PRIOR TO THE REMOVAL AND/OR RELOCATION OF UTILITIES. THE CONTRACTOR SHALL COORDINATE WITH THE UTILITY COMPANY CONCERNING PORTIONS OF WORK WHICH MAY BE PERFORMED BY THE UTILITY COMPANY'S FORCES AND ANY FEES WHICH ARE TO BE PAID TO THE UTILITY COMPANY FOR THEIR SERVICES. THE CONTRACTOR IS RESPONSIBLE FOR PAYING ALL FEES AND CHARGES.
5. THE LOCATIONS OF ALL EXISTING UTILITIES SHOWN ON THE PLAN HAVE BEEN DETERMINED FROM THE BEST INFORMATION AVAILABLE AND ARE GIVEN FOR THE CONVENIENCE OF THE CONTRACTOR. THE ENGINEER ASSUMES NO RESPONSIBILITY FOR THEIR ACCURACY. PRIOR TO THE START OF ANY DEMOLITION ACTIVITY, THE CONTRACTOR SHALL NOTIFY THE UTILITY COMPANIES FOR LOCATIONS OF EXISTING UTILITIES WITHIN ALL AREAS OF PROPOSED WORK.
6. ALL EXISTING DRIVERS, PIPING AND UTILITIES SHOWN ARE NOT TO BE INTERPRETED AS THE EXACT LOCATION OF UTILITIES THAT MAY OCCUR ON THE SITE. VERIFY EXISTING CONDITIONS AND PROCEED WITH CAUTION AROUND ANY ANTICIPATED FEATURES. GIVE NOTICE TO ALL UTILITY COMPANIES REGARDING DESTRUCTION AND REMOVAL OF ALL SERVICE LINES AND CAP ALL LINES BEFORE PRECEDING WITH THE WORK.
7. ELECTRICAL, TELEPHONE, CABLE, WATER, FIBER OPTIC, AND/OR GAS LINES NEEDING TO BE REMOVED OR RELOCATED SHALL BE COORDINATED WITH THE AFFECTED UTILITY COMPANY. ADEQUATE TIME SHALL BE PROVIDED FOR RELOCATION AND CLOSE COORDINATION WITH THE UTILITY COMPANY IS NECESSARY TO PROVIDE A SMOOTH TRANSITION IN UTILITY SERVICE. CONTRACTOR SHALL PAY CLOSE ATTENTION TO EXISTING UTILITIES WITHIN ANY ROAD RIGHT-OF-WAY DURING CONSTRUCTION.
8. CONTRACTOR MUST PROTECT THE PUBLIC AT ALL TIMES WITH FENCING, BARRICADES, ENCLOSURES, ETC. (AND OTHER APPROPRIATE BEST MANAGEMENT PRACTICES) AS APPROVED BY THE CONSTRUCTION MANAGER. MAINTENANCE OF TRAFFIC CONTROL SHALL BE COORDINATED IN ACCORDANCE WITH BLOOMINGTON, HENRIETTA COUNTY, AND MDOT.
9. CONTRACTOR SHALL MAINTAIN ACCESS TO ALL ADJACENT PROPERTIES DURING CONSTRUCTION, AND SHALL NOTIFY ALL PROPERTIES IF ACCESS WILL BE INTERRUPTED OR ALTERED AT ANY TIME DURING CONSTRUCTION.
10. PRIOR TO DEMOLITION OCCURRING, ALL EROSION CONTROL DEVICES ARE TO BE INSTALLED.
11. CONTRACTOR MAY LIMIT SAW-CUT AND PAVEMENT REMOVAL TO ONLY THOSE AREAS WHERE IT IS REQUIRED AS SHOWN ON THESE CONSTRUCTION PLANS BUT IF ANY DAMAGE IS INCURRED ON ANY OF THE SURROUNDING PAVEMENT, ETC. THE CONTRACTOR SHALL BE RESPONSIBLE FOR ITS REMOVAL AND REPAIR.
12. THE CONTRACTOR SHALL COORDINATE WATER MAIN WORK WITH THE FIRE DEPT. AND THE CITY WATER DEPARTMENT TO PLAN PROPOSED IMPROVEMENTS AND TO ENSURE ADEQUATE FIRE PROTECTION IS CONSTANTLY AVAILABLE TO THE SITE THROUGHOUT THIS SPECIFIC WORK AND THROUGH ALL PHASES OF CONSTRUCTION. CONTRACTOR WILL BE RESPONSIBLE FOR ARRANGING/PROVIDING ANY REQUIRED WATER MAIN SHUT OFFS WITH THE CITY OF BLOOMINGTON DURING CONSTRUCTION. ANY COSTS ASSOCIATED WITH WATER MAIN SHUT OFFS WILL BE THE RESPONSIBILITY OF THE CONTRACTOR AND NO EXTRA COMPENSATION WILL BE PROVIDED.
13. REFER TO SURVEY FOR ALL EXISTING INVERT AND RIM ELEVATIONS.
14. ALL UTILITIES SHOWN ARE EXISTING UTILITIES.
15. IN THE EVENT A WELL IS FOUND, THE CONTRACTOR SHALL CONTACT THE ENGINEER AND OWNER IMMEDIATELY. ALL WELLS SHALL BE SEALED BY A LICENSED WELL CONTRACTOR IN ACCORDANCE WITH ALL STATE OF MN REQUIREMENTS.
16. IN THE EVENT THAT UNKNOWN CONTAINERS OR TANKS ARE ENCOUNTERED, THE CONTRACTOR SHALL CONTACT THE OWNER AND/OR OWNERS REPRESENTATIVE IMMEDIATELY. ALL CONTAINERS SHALL BE DISPOSED OF AT A PERMITTED LANDFILL PER THE PROJECT DOCUMENTS.
17. CONTRACTOR SHALL NOTIFY THE ENGINEER IF ANY EXISTING DRAINILE IS ENCOUNTERED ON SITE. NO ACTIVE DRAINILE SHALL BE REMOVED WITHOUT APPROVAL FROM THE ENGINEER.
18. ALL CONSTRUCTION AND POST-CONSTRUCTION PARKING AND STORAGE OF EQUIPMENT AND MATERIALS MUST BE LOCATED ON-SITE. USE OF PUBLIC STREETS FOR PRIVATE CONSTRUCTION PARKING, LOADING/UNLOADING, AND STORAGE WILL NOT BE ALLOWED.
19. ALL UNUSED WATER SERVICES MUST BE PROPERLY ABANDONED AT THE MAIN. ALL UNUSED SANITARY SEWER SERVICES MUST BE PROPERLY ABANDONED AT THE PROPERTY LINE.

SHEET NUMBER C201		BLOOMINGTON WEST REDEVELOPMENT		PREPARED FOR UNITED PROPERTIES		BLOOMINGTON		EXISTING CONDITIONS AND REMOVALS PLAN		KHA PROJECT 160576022 DATE 12/01/2021 SCALE AS SHOWN DESIGNED BY EIS DRAWN BY EIS CHECKED BY TJJ I HEREBY CERTIFY THAT THIS PLAN, SPECIFICATION OR REPORT WAS PREPARED BY ME OR UNDER MY CLOSE PERSONAL SUPERVISION AND THAT I AM A DULY LICENSED PROFESSIONAL ENGINEER UNDER THE LAWS OF THE STATE OF MINNESOTA. DATE: 10/08/2021 U.C. NO. 21433 MN		Kimley»»Horn 2021 KIMLEY-HORN AND ASSOCIATES, INC. 767 EUSTIS STREET, SUITE 100, ST. PAUL, MN 55114 PHONE: 651-485-4187 WWW.KIMLEY-HORN.COM		DEVELOPMENT APPLICATION REVISIONS No. No.		DATE 12/01/2021 BY	
-----------------------------	--	---	--	---	--	--------------------	--	--	--	---	--	--	--	---	--	---	--

This document, together with the concepts and designs presented herein, as an instrument of service, is intended only for the specific purpose and client for which it was prepared. Reuse of and improper reliance on this document without written authorization and adaptation by Kimley-Horn and Associates, Inc. shall be without liability to Kimley-Horn and Associates, Inc.

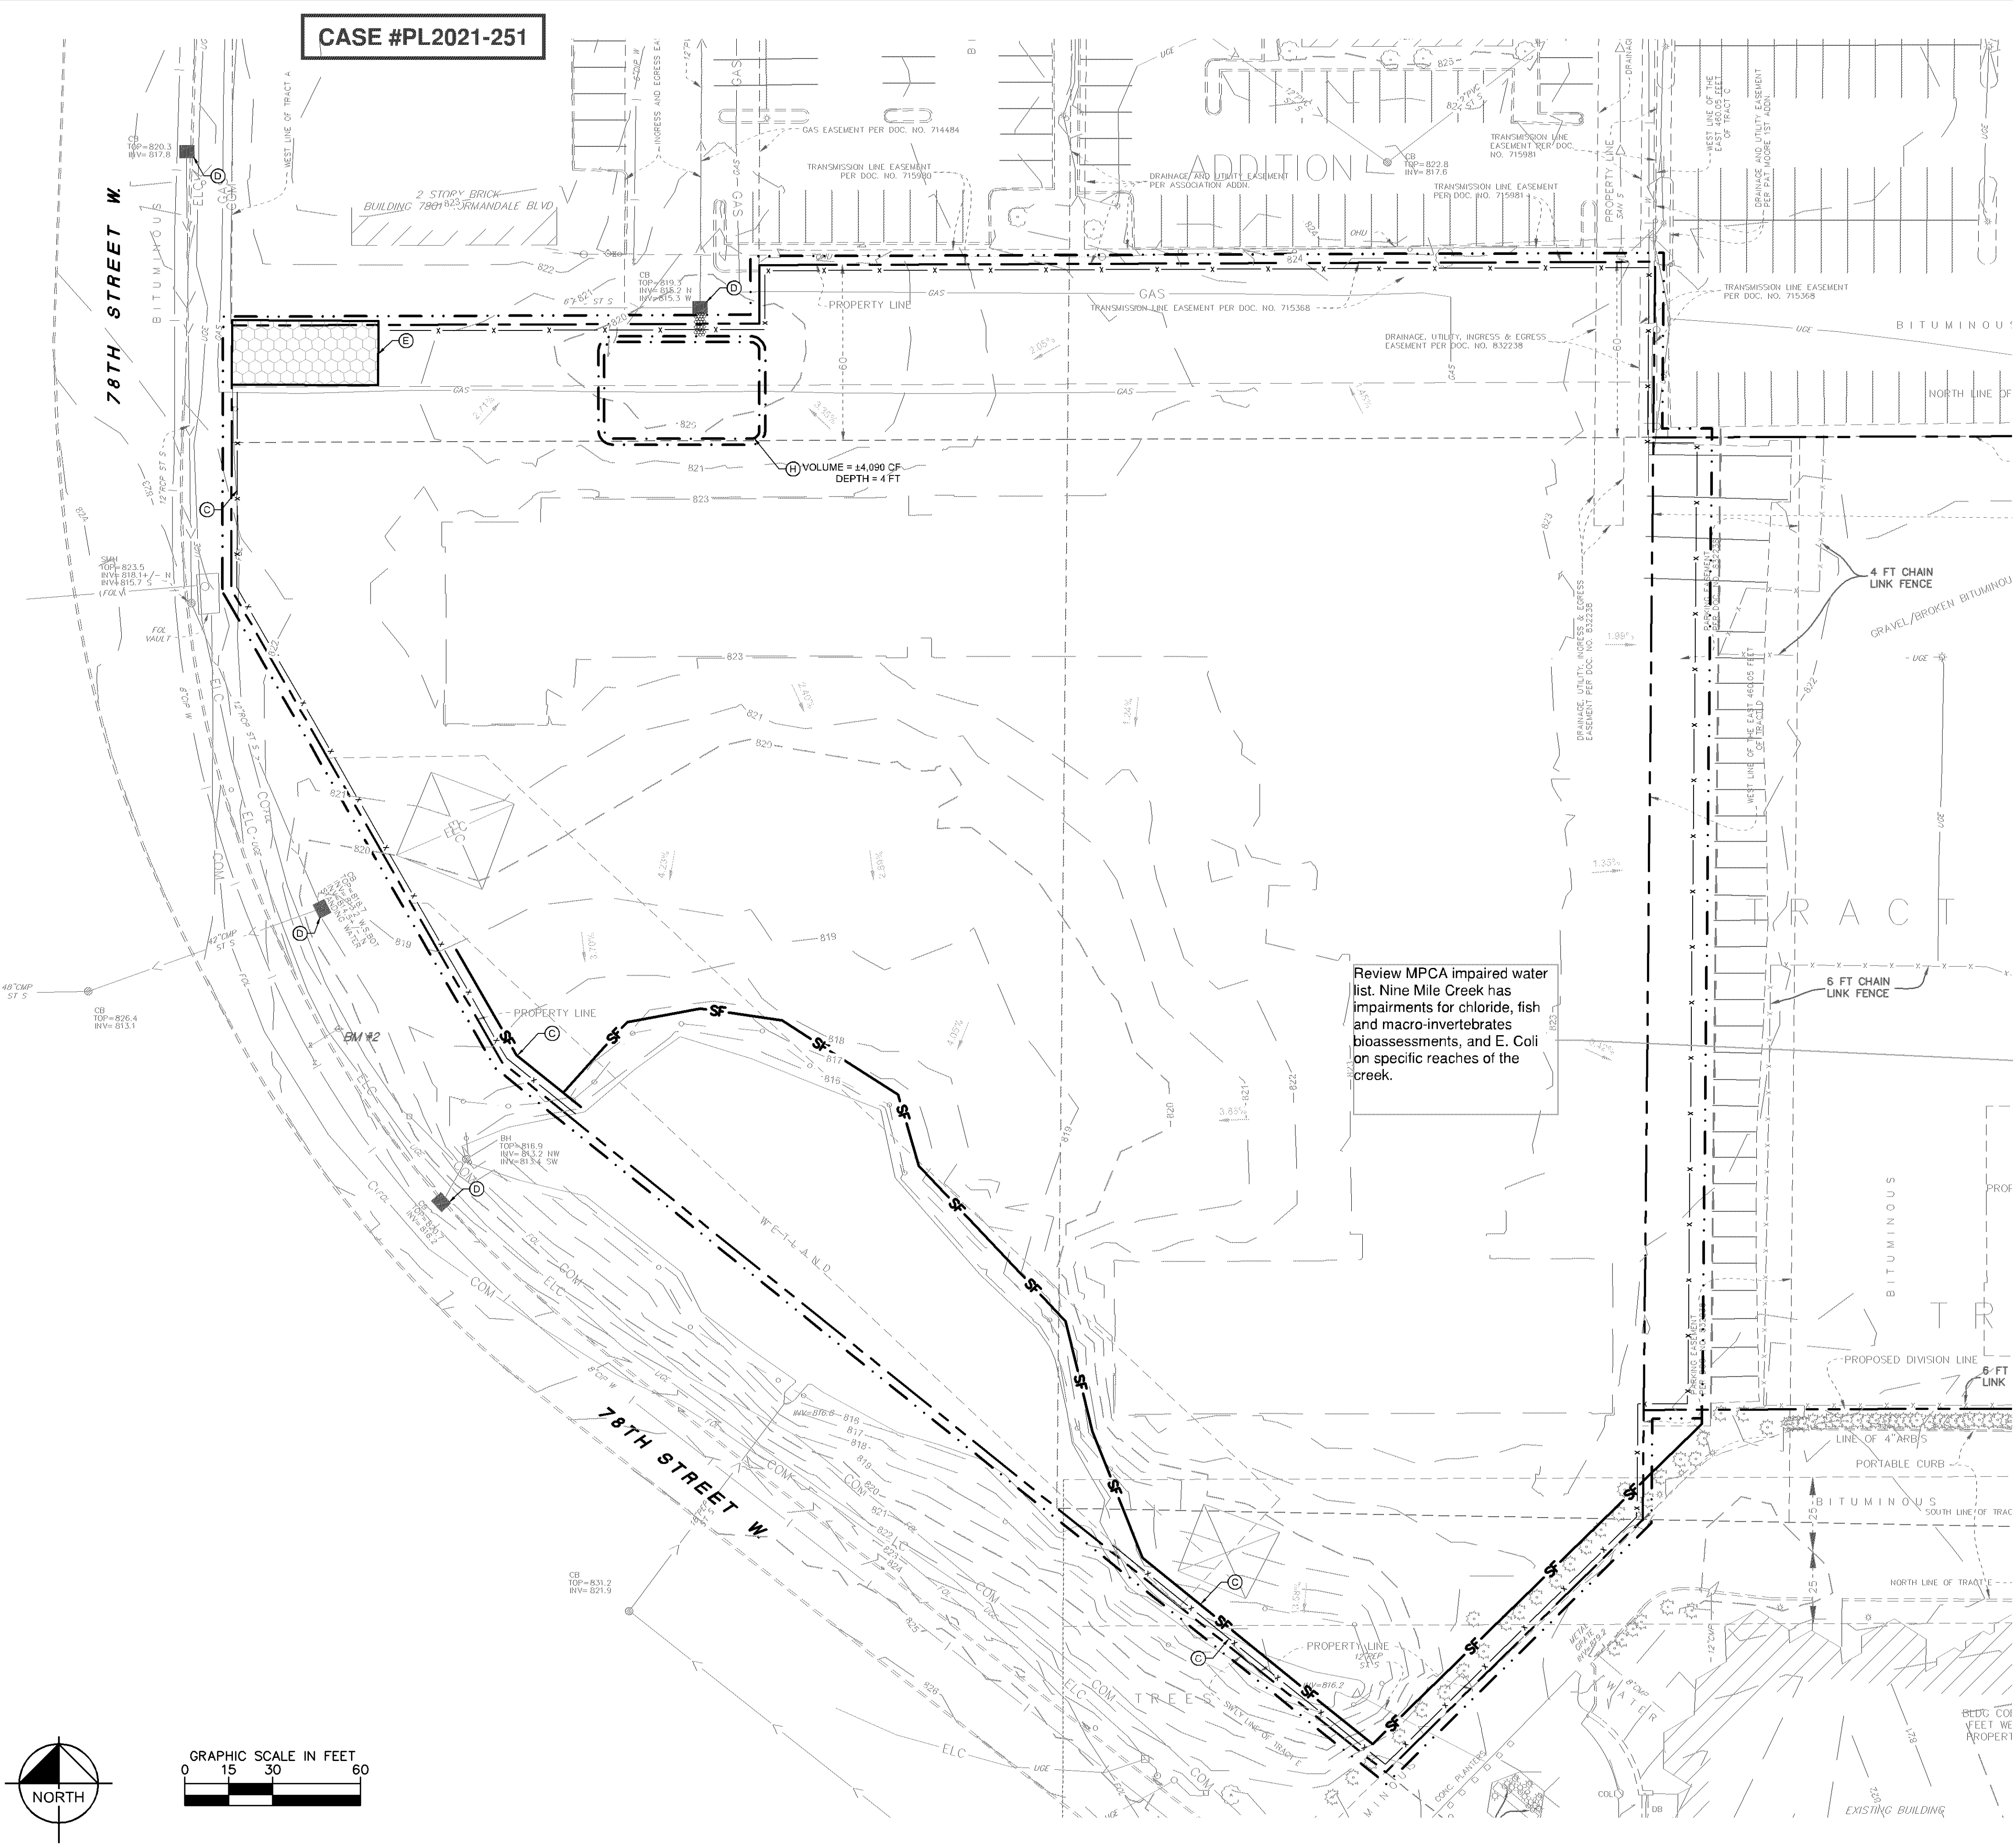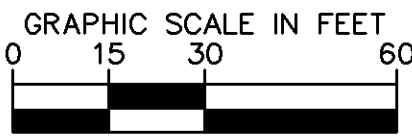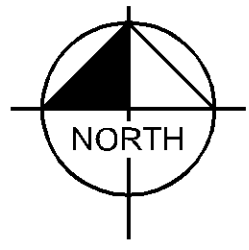

Review MPCA impaired water list. Nine Mile Creek has impairments for chloride, fish and macro-invertebrates bioassessments, and E. Coli on specific reaches of the creek.

LEGEND

- ROCK ENTRANCE
- EROSION CONTROL BLANKET
- INLET PROTECTION
- SILT FENCE
- LIMITS OF DISTURBANCE
- SAFETY FENCE
- BIOROLL

EROSION CONTROL PLAN NOTES

- ALL PERIMETER SILT FENCE AND ROCK CONSTRUCTION ENTRANCES SHALL BE INSTALLED PRIOR TO CONSTRUCTION.
- THE CONTRACTOR SHALL CONSTRUCT DRAINAGE BASINS PRIOR TO SITE GRADING.
- THE CONTRACTOR SHALL INSTALL CATCH BASIN EROSION CONTROL MEASURES.
- WITHIN 1 WEEK (7 DAYS) OF SITE GRADING, ALL DISTURBED AREAS SHALL BE STABILIZED WITH SEED, SOD, OR ROCK BASE. REFER TO LANDSCAPE PLANS FOR MATERIALS.
- ALL EROSION CONTROL MEASURES SHALL BE INSTALLED AND MAINTAINED IN ACCORDANCE WITH CITY, STATE, AND WATERSHED DISTRICT PERMITS.
- THE CONTRACTOR SHALL MAINTAIN ALL EROSION CONTROL MEASURES, INCLUDING THE REMOVAL OF SILT IN FRONT OF SILT FENCES DURING THE DURATION OF THE CONSTRUCTION.
- ANY EXCESS SEDIMENT IN PROPOSED BASINS SHALL BE REMOVED BY THE CONTRACTOR.
- REMOVAL ALL EROSION CONTROL MEASURES AFTER VEGETATION IS ESTABLISHED.
- THE CONTRACTOR SHALL REMOVE ALL SOILS AND SEDIMENT TRACKED ONTO EXISTING STREETS AND PAVED AREAS AND SHALL SWEEP ADJACENT STREETS AS NECESSARY IN ACCORDANCE WITH CITY REQUIREMENTS.
- IF BLOWING DUST BECOMES A NUISANCE, THE CONTRACTOR SHALL APPLY WATER FROM A TANK TRUCK TO ALL CONSTRUCTION AREAS.

SEQUENCE OF CONSTRUCTION:

UPON IMPLEMENTATION AND INSTALLATION OF THE FOLLOWING AREAS: TRAILER, PARKING, LAYDOWN, PORTA POTTY, WHEEL WASH, CONCRETE WASHOUT, FUEL AND MATERIAL STORAGE CONTAINERS, SOLID WASTE CONTAINERS, ETC., IMMEDIATELY DENOTE THEM ON THE SITE MAPS AND NOTE ANY CHANGES IN LOCATION AS THEY OCCUR THROUGHOUT THE CONSTRUCTION PROCESS.

BMP AND EROSION CONTROL INSTALLATION SEQUENCE SHALL BE AS FOLLOWS:

- INSTALL INLET PROTECTION AT EXISTING STORMWATER CULVERTS.
- CONSTRUCT STABILIZED CONSTRUCTION ENTRANCE (1), CONCRETE WASHOUT PIT (1) AND INSTALL SILT FENCE.
- PREPARE TEMPORARY PARKING AND STORAGE AREA.
- CONSTRUCT AND STABILIZE DIVERSIONS AND TEMPORARY SEDIMENT TRAPS.
- PERFORM CLEARING AND GRUBBING OF THE SITE. PERFORM MASS GRADING.
- ROUGH GRADE TO ESTABLISH PROPOSED DRAINAGE PATTERNS.
- START CONSTRUCTION OF THE BUILDING PAD AND STRUCTURES.
- TEMPORARILY SEED WITH PURE LIVE SEED, THROUGHOUT CONSTRUCTION.

SWPPP UPDATES AND AMENDMENTS

THE GC MUST UPDATE THE SWPPP, INCLUDING THE JOBSITE BINDER AND SITE MAPS, TO REFLECT THE PROGRESS OF CONSTRUCTION ACTIVITIES AND GENERAL CHANGES TO THE PROJECT SITE. UPDATES SHALL BE MADE DAILY TO TRACK PROGRESS WHEN ANY OF THE FOLLOWING ACTIVITIES OCCUR: BMP INSTALLATION, MODIFICATION OR REMOVAL, CONSTRUCTION ACTIVITIES (E.G., PAVING, STORM SEWER INSTALLATION, FOOTING INSTALLATION, ETC.), CLEARING, GRUBBING OR GRADING, OR TEMPORARY OR PERMANENT STABILIZATION.

SITE DISCHARGE
RUNOFF WILL DISCHARGE INTO NINEMILE CREEK LOCATED APPROXIMATELY 0.05 MILES TO THE WEST. THIS CREEK WAS DELISTED IN 2010 AND IS NO LONGER CLASSIFIED AS AN IMPAIRED STREAM.

SOIL TYPES
THE SITE BORING LOGS CONSIST GENERALLY OF 2 TO 10 FEET OF FILL FOLLOWED BY SWAMP DEPOSITS AND GLACIAL DEPOSITS. NATIVE SOILS LARGELY CONSIST OF POORLY CONSOLIDATED AND WITH SILT (SP-SM), SILTY SANDS (SM), AND CLAYEY SANDS (SC).

AREA SUMMARY

TOTAL PROPERTY AREA	4.02 AC
EXISTING IMPERVIOUS AREA	1.88 AC
EXISTING PERVIOUS AREA	2.16 AC
PROPOSED IMPERVIOUS AREA	2.55 AC
PROPOSED PERVIOUS AREA	1.47 AC

KEYNOTE LEGEND

- (A) LIMITS OF DISTURBANCE
- (B) SILT FENCE - OFFSET FROM LIMITS OF DISTURBANCE FOR CLARITY
- (C) SAFETY FENCE - OFFSET FROM LIMITS OF DISTURBANCE FOR CLARITY
- (D) INLET PROTECTION
- (E) ROCK CONSTRUCTION ENTRANCE/EXIT
- (F) TEMPORARY CHECK DAM
- (G) TEMPORARY DIVERSION DITCH
- (H) SEDIMENT TRAP WITH RIP-RAP TO INLET STRUCTURE

PRELIMINARY - NOT FOR CONSTRUCTION

BLOOMINGTON WEST
REDEVELOPMENT
PREPARED FOR
UNITED
PROPERTIES
BLOOMINGTON

EROSION AND
SEDIMENT
CONTROL PLAN -
PHASE 1




KHA PROJECT	160576022	DATE	12/01/2021	SCALE	AS SHOWN	DESIGNED BY	EIS	DRAWN BY	EIS	CHECKED BY	TJL
UNLESS NOTED OTHERWISE, ALL DESIGN AND CONSTRUCTION SHALL BE IN ACCORDANCE WITH THE LATEST EDITIONS OF THE MNCSS, MNDOT, AND MPCA. THE DESIGNER SHALL BE RESPONSIBLE FOR OBTAINING ALL NECESSARY PERMITS AND APPROVALS. THE CONTRACTOR SHALL BE RESPONSIBLE FOR OBTAINING ALL NECESSARY PERMITS AND APPROVALS. THE CONTRACTOR SHALL BE RESPONSIBLE FOR OBTAINING ALL NECESSARY PERMITS AND APPROVALS.											

Kimley»Horn

2021 KIMLEY-HORN AND ASSOCIATES, INC.
767 EUSTIS STREET, SUITE 100, ST. PAUL, MN 55114
PHONE: 651-945-4187
WWW.KIMLEY-HORN.COM

DEVELOPMENT APPLICATION	12/01/2021	EIS	BY
REVISIONS	No.	DATE	

SHEET NUMBER
C300

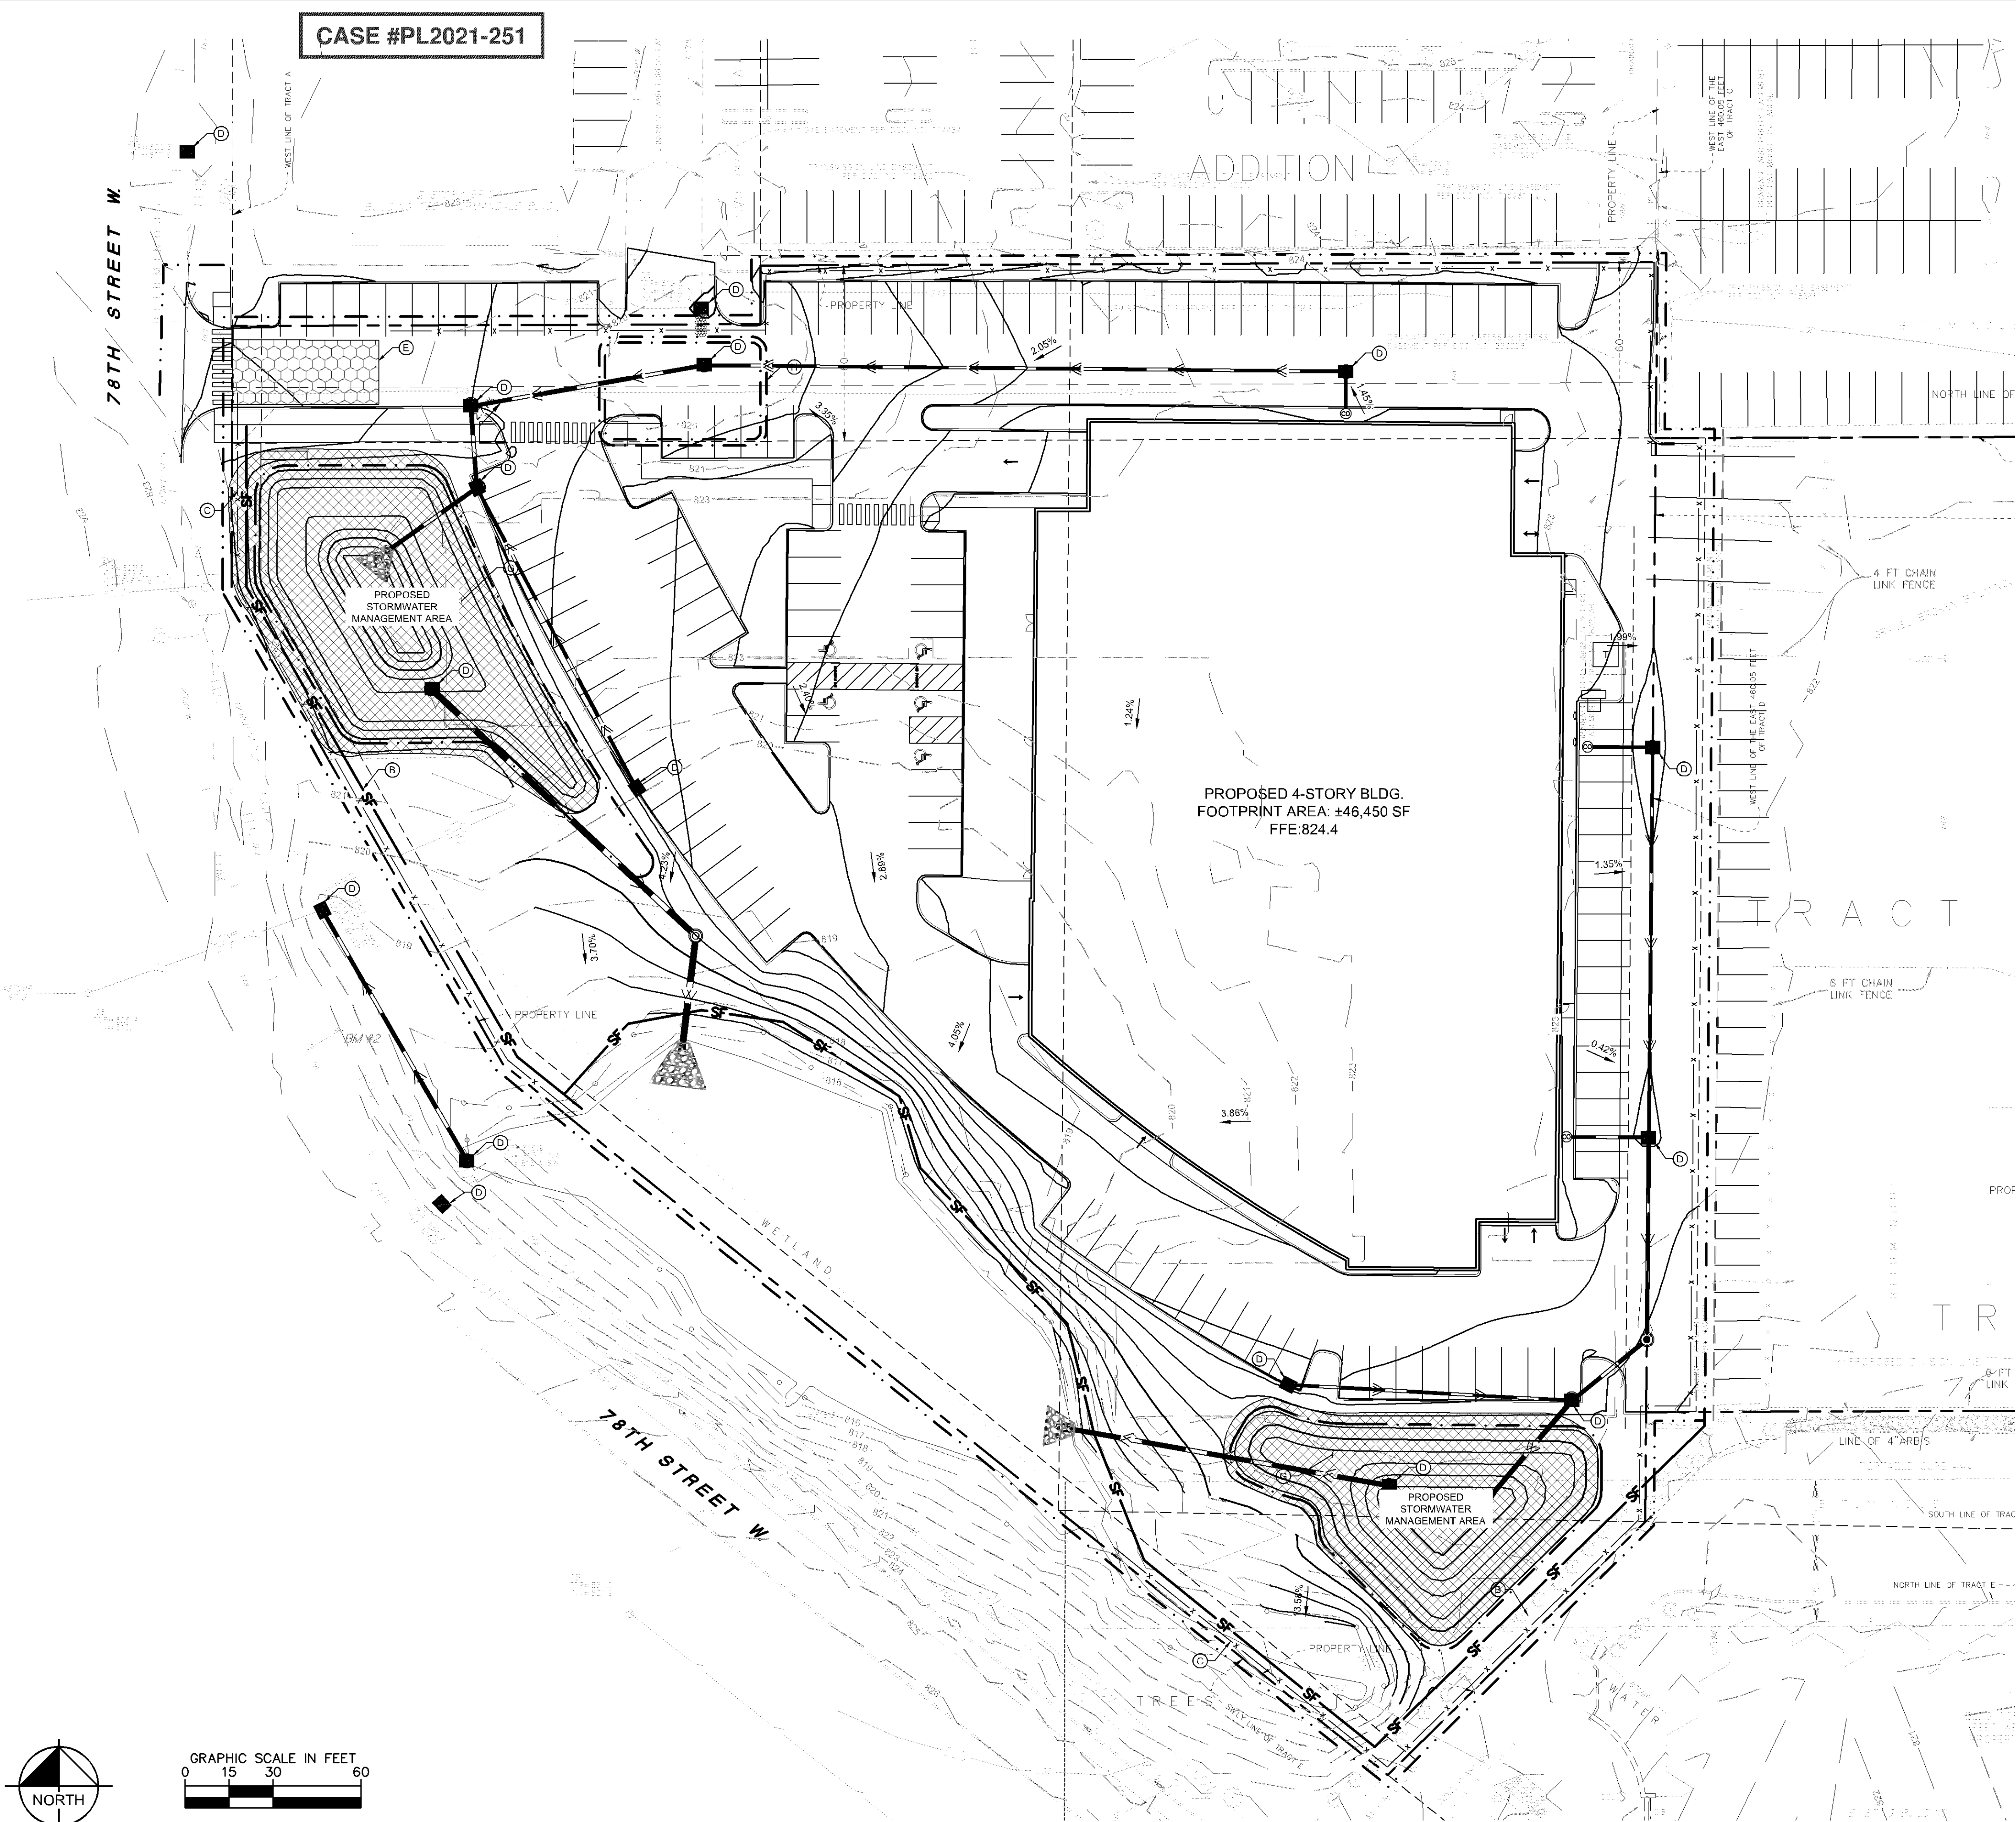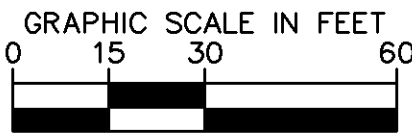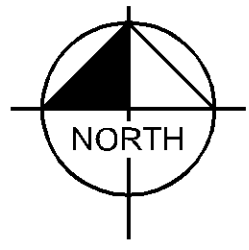

LEGEND

- ROCK ENTRANCE
- EROSION CONTROL BLANKET
- INLET PROTECTION
- SILT FENCE
- LIMITS OF DISTURBANCE
- SAFETY FENCE
- BIOROLL

EROSION CONTROL PLAN NOTES

- ALL PERIMETER SILT FENCE AND ROCK CONSTRUCTION ENTRANCES SHALL BE INSTALLED PRIOR TO CONSTRUCTION.
- THE CONTRACTOR SHALL CONSTRUCT DRAINAGE BASINS PRIOR TO SITE GRADING.
- THE CONTRACTOR SHALL INSTALL CATCH BASIN EROSION CONTROL MEASURES.
- WITHIN ONE WEEK (7 DAYS) OF SITE GRADING, ALL DISTURBED AREAS SHALL BE STABILIZED WITH SEED, SOD, OR ROCK BASE. REFER TO LANDSCAPE PLANS FOR MATERIALS.
- ALL EROSION CONTROL MEASURES SHALL BE INSTALLED AND MAINTAINED IN ACCORDANCE WITH CITY, STATE, AND WATERSHED DISTRICT PERMITS.
- THE CONTRACTOR SHALL MAINTAIN ALL EROSION CONTROL MEASURES, INCLUDING THE REMOVAL OF SILT IN FRONT OF SILT FENCES DURING THE DURATION OF THE CONSTRUCTION.
- ANY EXCESS SEDIMENT IN PROPOSED BASINS SHALL BE REMOVED BY THE CONTRACTOR.
- REMOVAL ALL EROSION CONTROL MEASURES AFTER VEGETATION IS ESTABLISHED.
- THE CONTRACTOR SHALL REMOVE ALL SOILS AND SEDIMENT TRACKED ONTO EXISTING STREETS AND PAVED AREAS AND SHALL SWEEP ADJACENT STREETS AS NECESSARY IN ACCORDANCE WITH CITY REQUIREMENTS.
- IF BLOWING DUST BECOMES A NUISANCE, THE CONTRACTOR SHALL APPLY WATER FROM A TANK TRUCK TO ALL CONSTRUCTION AREAS.

SEQUENCE OF CONSTRUCTION:

UPON IMPLEMENTATION AND INSTALLATION OF THE FOLLOWING AREAS: TRAILER, PARKING, LAYDOWN, PORTA POTT, WHEEL WASH, CONCRETE WASHOUT, FUEL AND MATERIAL STORAGE CONTAINERS, SOLID WASTE CONTAINERS, ETC., IMMEDIATELY DENOTE THEM ON THE SITE MAPS AND NOTE ANY CHANGES IN LOCATION AS THEY OCCUR THROUGHOUT THE CONSTRUCTION PROCESS.

BMP AND EROSION CONTROL INSTALLATION SEQUENCE SHALL BE AS FOLLOWS:

- INSTALL INLET PROTECTION AT EXISTING STORMWATER CULVERTS.
- CONSTRUCT STABILIZED CONSTRUCTION ENTRANCE (1), CONCRETE WASHOUT PIT (1) AND INSTALL SILT FENCE.
- PREPARE TEMPORARY PARKING AND STORAGE AREA.
- CONSTRUCT AND STABILIZE DIVERSIONS AND TEMPORARY SEDIMENT TRAPS.
- PERFORM CLEARING AND GRUBBING OF THE SITE. PERFORM MASS GRADING, ROUGH GRADE TO ESTABLISH PROPOSED DRAINAGE PATTERNS.
- START CONSTRUCTION OF THE BUILDING PAD AND STRUCTURES.
- TEMPORARILY SEED WITH PURE LIVE SEED, THROUGHOUT CONSTRUCTION, DISTURBED AREAS THAT WILL BE INACTIVE FOR 7 DAYS OR MORE OR AS REQUIRED BY NPDES AND/OR CITY OF BLOOMINGTON GRADING PERMIT.

SWPPP UPDATES AND AMENDMENTS

THE GC MUST UPDATE THE SWPPP, INCLUDING THE JOBSITE BINDER AND SITE MAPS, TO REFLECT THE PROGRESS OF CONSTRUCTION ACTIVITIES AND GENERAL CHANGES TO THE PROJECT SITE. UPDATES SHALL BE MADE DAILY TO TRACK PROGRESS WHEN ANY OF THE FOLLOWING ACTIVITIES OCCUR: BMP INSTALLATION, MODIFICATION OR REMOVAL, CONSTRUCTION ACTIVITIES (E.G., PAVING, STORM SEWER INSTALLATION, FOOTING INSTALLATION, ETC.), CLEARING, GRUBBING OR GRADING, OR TEMPORARY OR PERMANENT STABILIZATION.

SITE DISCHARGE
RUNOFF WILL DISCHARGE INTO NINEMILE CREEK LOCATED APPROXIMATELY 0.05 MILES TO THE WEST. THIS CREEK WAS DELISTED IN 2010 AND IS NO LONGER CLASSIFIED AS AN IMPAIRED STREAM.

SOIL TYPES
THE SITE BORING LOGS CONSIST GENERALLY OF 2 TO 10 FEET OF FILL FOLLOWED BY SWAMP DEPOSITS AND GLACIAL DEPOSITS. NATIVE SOILS LARGELY CONSIST OF POORLY GRADED SAND WITH SILT (SP-SM), SILTY SANDS (SM), AND CLAYEY SANDS (SC).

AREA SUMMARY

TOTAL PROPERTY AREA	4.02 AC
EXISTING IMPERVIOUS AREA	1.86 AC
EXISTING PERVIOUS AREA	2.16 AC
PROPOSED IMPERVIOUS AREA	2.55 AC
PROPOSED PERVIOUS AREA	1.47 AC

KEYNOTE LEGEND

- (A) LIMITS OF DISTURBANCE
- (B) SILT FENCE - OFFSET FROM LIMITS OF DISTURBANCE FOR CLARITY
- (C) SAFETY FENCE - OFFSET FROM LIMITS OF DISTURBANCE FOR CLARITY
- (D) INLET PROTECTION
- (E) ROCK CONSTRUCTION ENTRANCE/EXIT
- (F) TEMPORARY CHECK DAM
- (G) TEMPORARY DIVERSION DITCH
- (H) SEDIMENT TRAP WITH RIP-RAP TO INLET STRUCTURE

PRELIMINARY - NOT FOR CONSTRUCTION

BLOOMINGTON WEST
REDEVELOPMENT

PREPARED FOR
UNITED
PROPERTIES

BLOOMINGTON MN

EROSION AND
SEDIMENT
CONTROL PLAN -
PHASE 2

DESIGNED BY: KIMLEY-HORN
SPECIFICATION OR REPORT WAS PREPARED BY
ME OR UNDER MY DIRECT SUPERVISION AND
I AM A DULY LICENSED PROFESSIONAL
ENGINEER UNDER THE LAWS OF THE STATE OF
MINNESOTA.

DATE: 10/06/2021
LIC. NO. 21433
TOM LINCOLN, P.E.
MN

KHA PROJECT
160576022
DATE
12/01/2021
SCALE
AS SHOWN
DESIGNED BY
EIS
DRAWN BY
EIS
CHECKED BY
TJL

BLOOMINGTON WEST
REDEVELOPMENT

PREPARED FOR
UNITED
PROPERTIES

BLOOMINGTON MN

EROSION AND
SEDIMENT
CONTROL PLAN -
PHASE 2

DESIGNED BY: KIMLEY-HORN
SPECIFICATION OR REPORT WAS PREPARED BY
ME OR UNDER MY DIRECT SUPERVISION AND
I AM A DULY LICENSED PROFESSIONAL
ENGINEER UNDER THE LAWS OF THE STATE OF
MINNESOTA.

DATE: 10/06/2021
LIC. NO. 21433
TOM LINCOLN, P.E.
MN


KHA PROJECT
160576022
DATE
12/01/2021
SCALE
AS SHOWN
DESIGNED BY
EIS
DRAWN BY
EIS
CHECKED BY
TJL

Kimley»Horn

2021 KIMLEY-HORN AND ASSOCIATES, INC.
767 EUSTIS STREET, SUITE 100, ST. PAUL, MN 55114
PHONE: 651-945-4187
WWW.KIMLEY-HORN.COM


No.	REVISIONS	DATE	BY
1	DEVELOPMENT APPLICATION	12/01/2021	EIS

CASE #PL2021-251

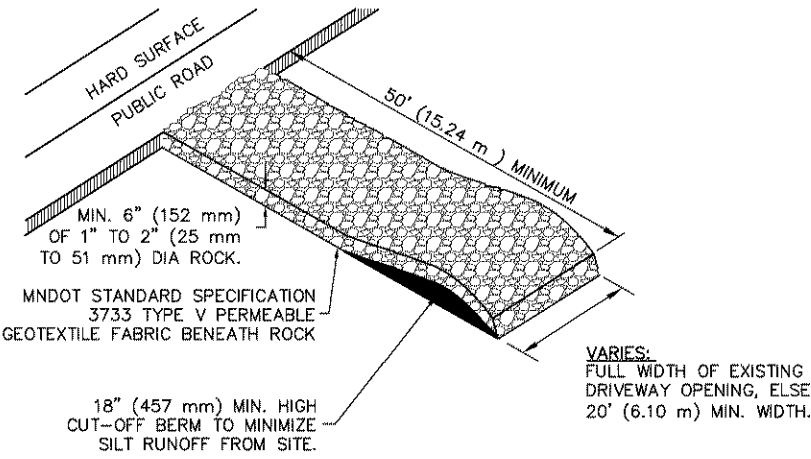


600 - ROCK CONSTRUCTION ENTRANCE AT ACCESS ROADS
600 - Rock Const. Ent.dwg 5/2015

CITY OF BLOOMINGTON ENGINEERING DIVISION PUBLIC WORKS DEPARTMENT	
1700 W. METER ST. BLOOMINGTON, MN 55401 PHONE: 612-254-2970	PLATE NAME 600 - Rock Const. Ent
LAST REVISED: 6/15/2015	
LAST REVISED BY: KBO	

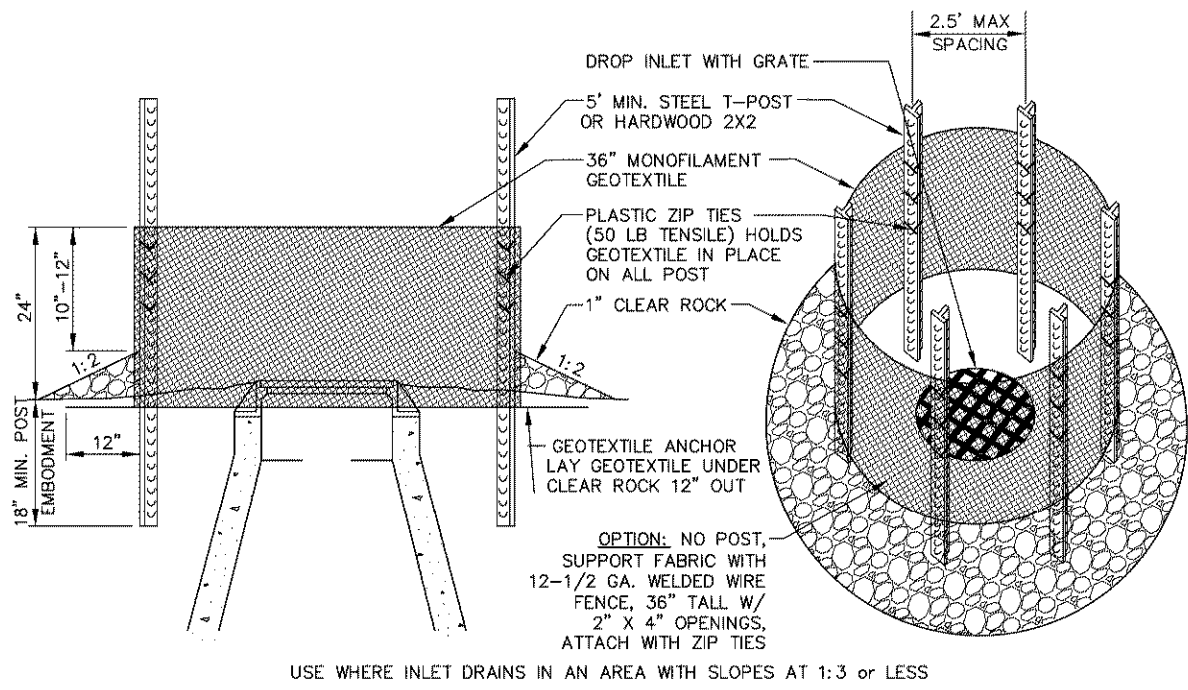


603 - INLET PROTECTION
SILT FENCE RING AND ROCK FILTER BERM
603 - Inlet Protection (Ring).dwg 5/2015

CITY OF BLOOMINGTON ENGINEERING DIVISION PUBLIC WORKS DEPARTMENT	
1700 W. METER ST. BLOOMINGTON, MN 55401 PHONE: 612-254-2970	PLATE NAME 603 - Inlet Protection (Ring)
LAST REVISED: 6/15/2015	
LAST REVISED BY: KBO	

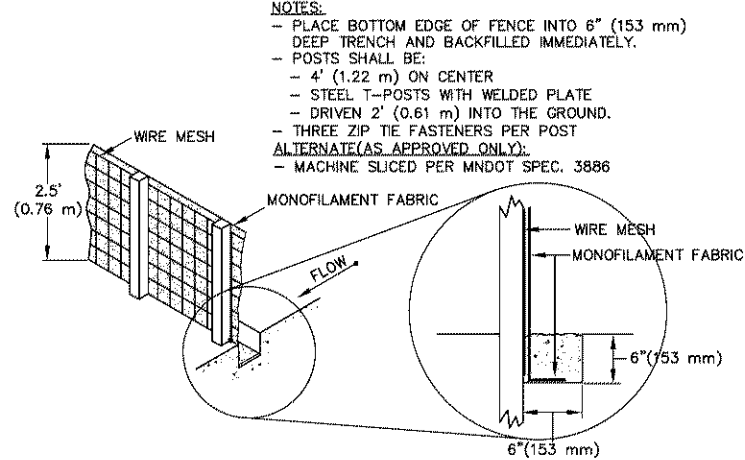


607 - SILT FENCE, TYPE HEAVY DUTY
607 - Silt Fen (HEAVY DUTY).dwg 5/2015

CITY OF BLOOMINGTON ENGINEERING DIVISION PUBLIC WORKS DEPARTMENT	
1700 W. METER ST. BLOOMINGTON, MN 55401 PHONE: 612-254-2970	PLATE NAME 607 - Silt Fen (HEAVY DUTY)
LAST REVISED: 6/15/2015	
LAST REVISED BY: KBO	

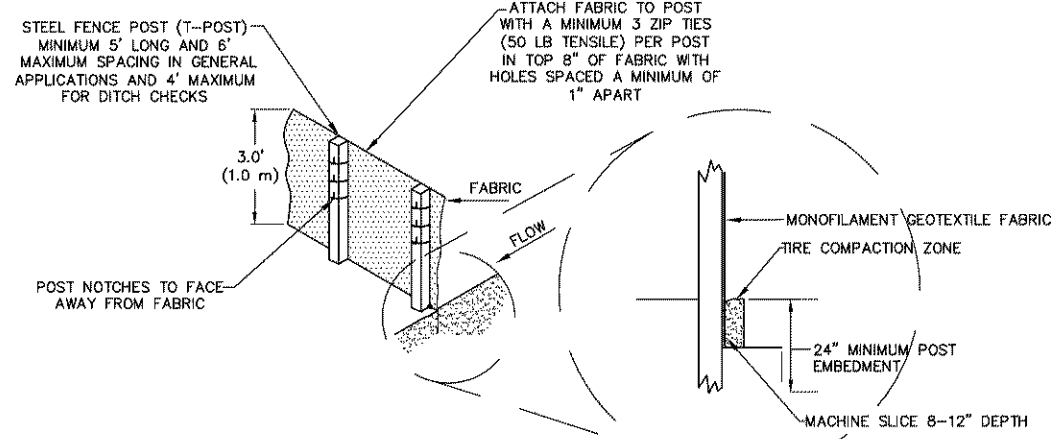

608 - SILT FENCE - MACHINE SLICED
608 - Silt Fen (MACHINE SLICED).dwg 5/2015

CITY OF BLOOMINGTON ENGINEERING DIVISION PUBLIC WORKS DEPARTMENT	
1700 W. METER ST. BLOOMINGTON, MN 55401 PHONE: 612-254-2970	PLATE NAME 608 - Silt Fen (MACHINE SLICED)
LAST REVISED: 6/15/2015	
LAST REVISED BY: KBO	

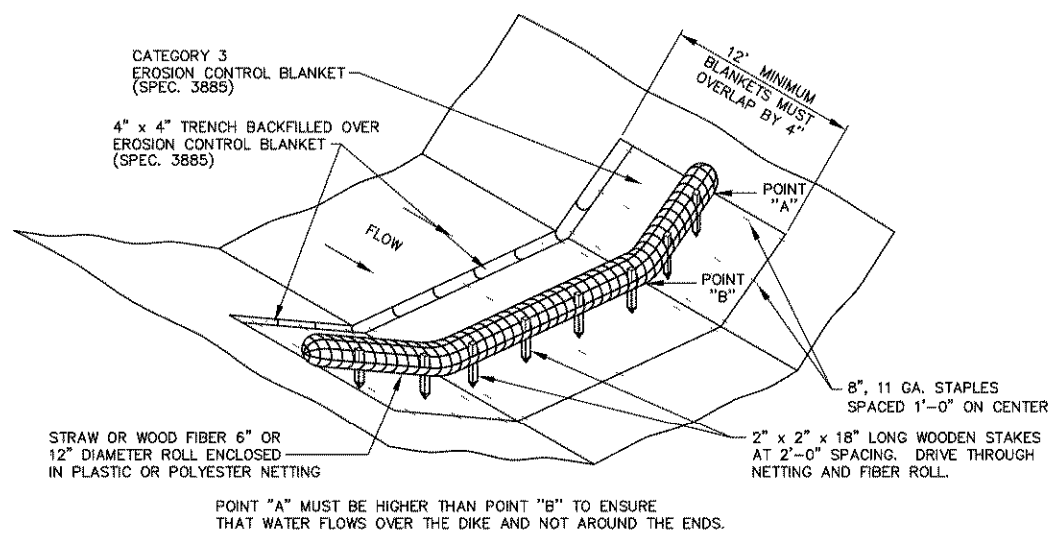


610 - BIOROLL BLANKET SYSTEM (TYPE 3 SPEC. 3889)
610 - Bioroll.dwg 5/2015

CITY OF BLOOMINGTON ENGINEERING DIVISION PUBLIC WORKS DEPARTMENT	
1700 W. METER ST. BLOOMINGTON, MN 55401 PHONE: 612-254-2970	PLATE NAME 610 - Bioroll
LAST REVISED: 6/15/2015	
LAST REVISED BY: KBO	

SC-5

Rock Sock (RS)

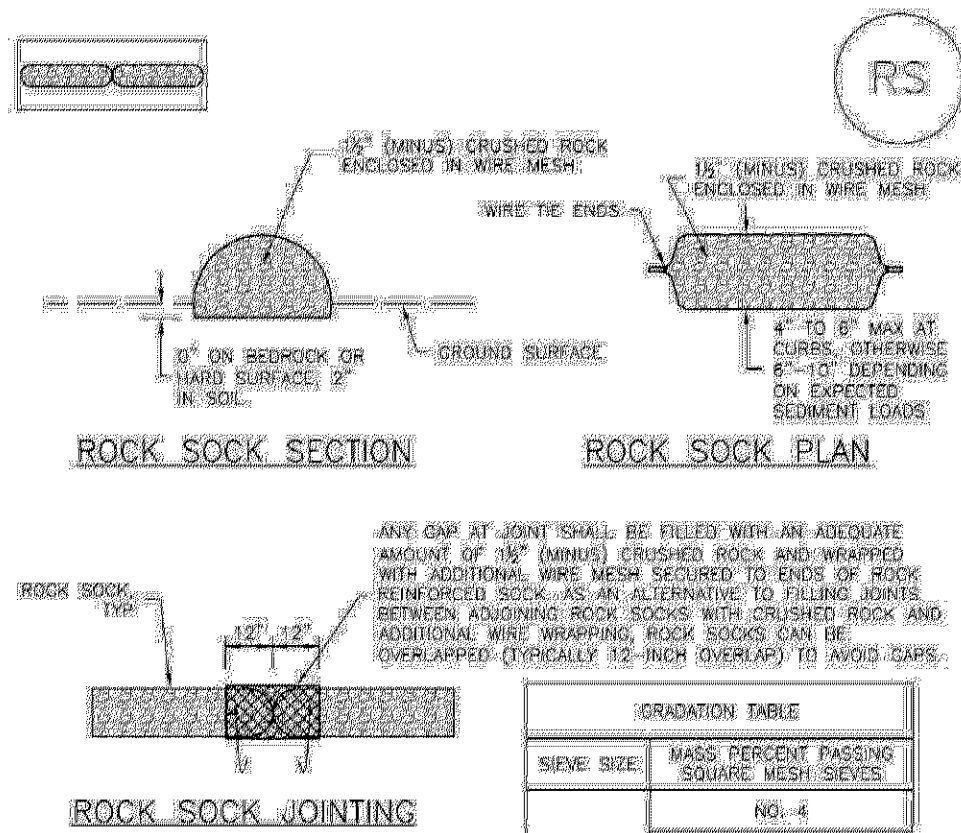

ROCK SOCK INSTALLATION NOTES

1. SEE PLAN VIEW FOR:
- LOCATION(S) OF ROCK SOCKS
2. CRUSHED ROCK SHALL BE 3/4\"/>
3. WIRE MESH SHALL BE FABRICATED OF 16 GAGE POLYESTER MESH, OR EQUIVALENT, WITH A MAXIMUM OPENING OF 2\"/>
4. WIRE MESH SHALL BE SECURED USING "SHOT RINGS" OR WIRE RINGS AT 6\"/>
5. SOME MUNICIPALITIES MAY ALLOW THE USE OF FILTER FABRIC AS AN ALTERNATIVE TO WIRE MESH FOR THE ROCK ENCLOSURE.

RS-1. ROCK SOCK PERIMETER CONTROL

RS-2 Urban Drainage and Flood Control District
Urban Storm Drainage Criteria Manual Volume 3 November 2010

Rock Sock (RS)

SC-5

ROCK SOCK MAINTENANCE NOTES

1. INSPECT BMPs EACH WORKDAY AND MAINTAIN THEM IN EFFECTIVE OPERATING CONDITION. MAINTENANCE OF BMPs SHOULD BE PROACTIVE, NOT REACTIVE. INSPECT BMPs AS SOON AS POSSIBLE (AND ALWAYS WITHIN 24 HOURS) FOLLOWING A STORM THAT CAUSES SURFACE EROSION, AND PERFORM NECESSARY MAINTENANCE.
2. FREQUENT OBSERVATIONS AND MAINTENANCE ARE NECESSARY TO MAINTAIN BMPs IN EFFECTIVE OPERATING CONDITION. INSPECTIONS AND CORRECTIVE MEASURES SHOULD BE DOCUMENTED THOROUGHLY.
3. WHERE BMPs HAVE FAILED, REPAIR OR REPLACEMENT SHOULD BE INITIATED UPON DISCOVERY OF THE FAILURE.
4. ROCK SOCKS SHALL BE REPLACED IF THEY BECOME HEAVILY SOILED, OR DAMAGED BEYOND REPAIR.
5. SEDIMENT ACCUMULATED UPSTREAM OF ROCK SOCKS SHALL BE REMOVED AS NEEDED TO MAINTAIN FUNCTIONALITY OF THE BMP. TYPICALLY WHEN DEPTH OF ACCUMULATED SEDIMENT IS APPROXIMATELY 1/3 OF THE HEIGHT OF THE ROCK SOCK.
6. ROCK SOCKS ARE TO REMAIN IN PLACE UNTIL THE UPSTREAM DISTURBED AREA IS STABILIZED AND APPROVED BY THE LOCAL JURISDICTION.
7. WHEN ROCK SOCKS ARE REMOVED, ALL DISTURBED AREAS SHALL BE COVERED WITH TOPSOIL, SEEDS, AND MULCH, OR OTHERWISE STABILIZED AS APPROVED BY LOCAL JURISDICTION.

DETAIL ADAPTED FROM TOWN OF FARMER, COUNCIL AND CITY OF ALPHEA, COLORADO, NOT AVAILABLE IN AUTHOR'S

NOTE: MANY JURISDICTIONS HAVE BMP DETAILS THAT VARY FROM USFOCD STANDARD DETAILS. CONSULT WITH LOCAL JURISDICTIONS AS TO WHICH DETAIL SHOULD BE USED WHEN DIFFERENCES ARE NOTED.

NOTE: THE DETAILS INCLUDED WITH THIS FACT SHEET SHOW COMMONLY USED CONVENTIONAL METHODS OF ROCK SOCK INSTALLATION IN THE DENVER METROPOLITAN AREA. THERE ARE MANY OTHER SIMILAR PROPRIETARY PRODUCTS ON THE MARKET. USFOCD NEITHER ENDORSES NOR DISCOURAGES USE OF PROPRIETARY PROTECTION PRODUCTS. HOWEVER, IF THE EVENT PROPRIETARY METHODS ARE USED, THE APPROPRIATE DETAIL FROM THE MANUFACTURER MUST BE INCLUDED IN THE SWMP AND THE BMP MUST BE INSTALLED AND MAINTAINED AS SHOWN IN THE MANUFACTURER'S DETAILS.

November 2010 Urban Drainage and Flood Control District
Urban Storm Drainage Criteria Manual Volume 3 RS-3

PRELIMINARY - NOT FOR CONSTRUCTION

BLOOMINGTON WEST
REDEVELOPMENT
PREPARED FOR
UNITED
PROPERTIES
BLOOMINGTON MN

EROSION AND
SEDIMENT
CONTROL
DETAILS

KHA PROJECT
160576022
DATE
12/01/2021
SCALE
AS SHOWN
DESIGNED BY
EIS
DRAWN BY
EIS
CHECKED BY
TJL

DESIGNED BY
EIS
DRAWN BY
EIS
CHECKED BY
TJL
DATE
10/06/2021
LIC NO.
21433
TOM LINCOLN, P.E.
MN
LIC

THIS DOCUMENT WAS PREPARED BY
KIMLEY-HORN AND ASSOCIATES, INC.
A PROFESSIONAL ENGINEERING FIRM
REGISTERED IN THE STATE OF
MINNESOTA

Kimley»Horn
2021 KIMLEY-HORN AND ASSOCIATES, INC.
767 EUSTIS STREET, SUITE 100, ST. PAUL, MN 55114
PHONE: 651-445-4167
WWW.KIMLEY-HORN.COM



REVISIONS
No. DATE BY
1 12/01/2021 EIS
2 DEVELOPMENT APPLICATION
3 REVISIONS

SHEET NUMBER
C302


k:\TWC_LDEV\United_Properties\BLOOMINGTON TESLA3 Design\CAD\PlanSheets\C3-EROS DETAILS.dwg December 01, 2021 - 12:56pm

This document, together with the concepts and designs presented herein, as an instrument of service, is intended only for the specific purpose and client for which it was prepared. Reuse of and improper reliance on this document without written authorization and adaptation by Kimley-Horn and Associates, Inc. shall be without liability to Kimley-Horn and Associates, Inc.



CASE #PL2021-251

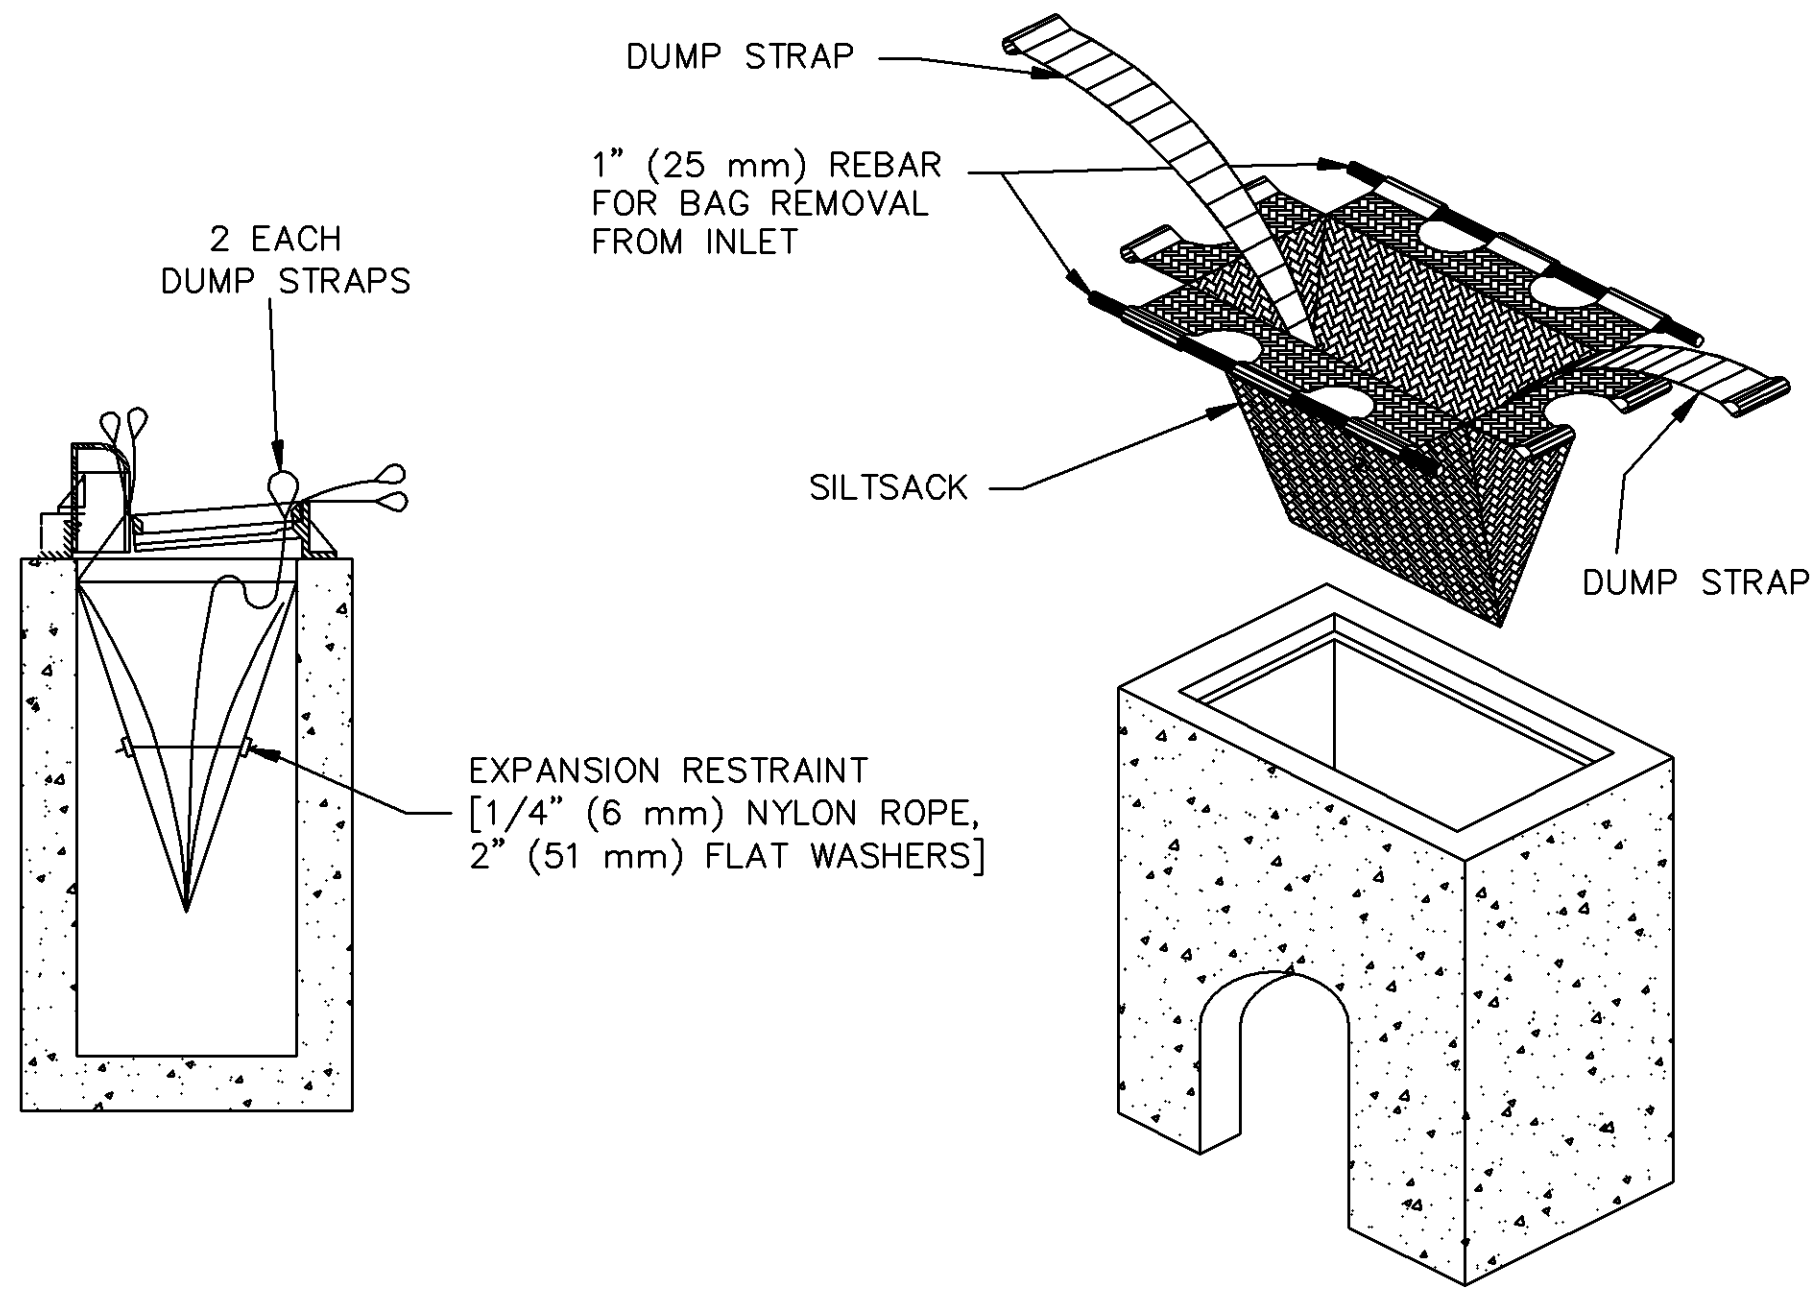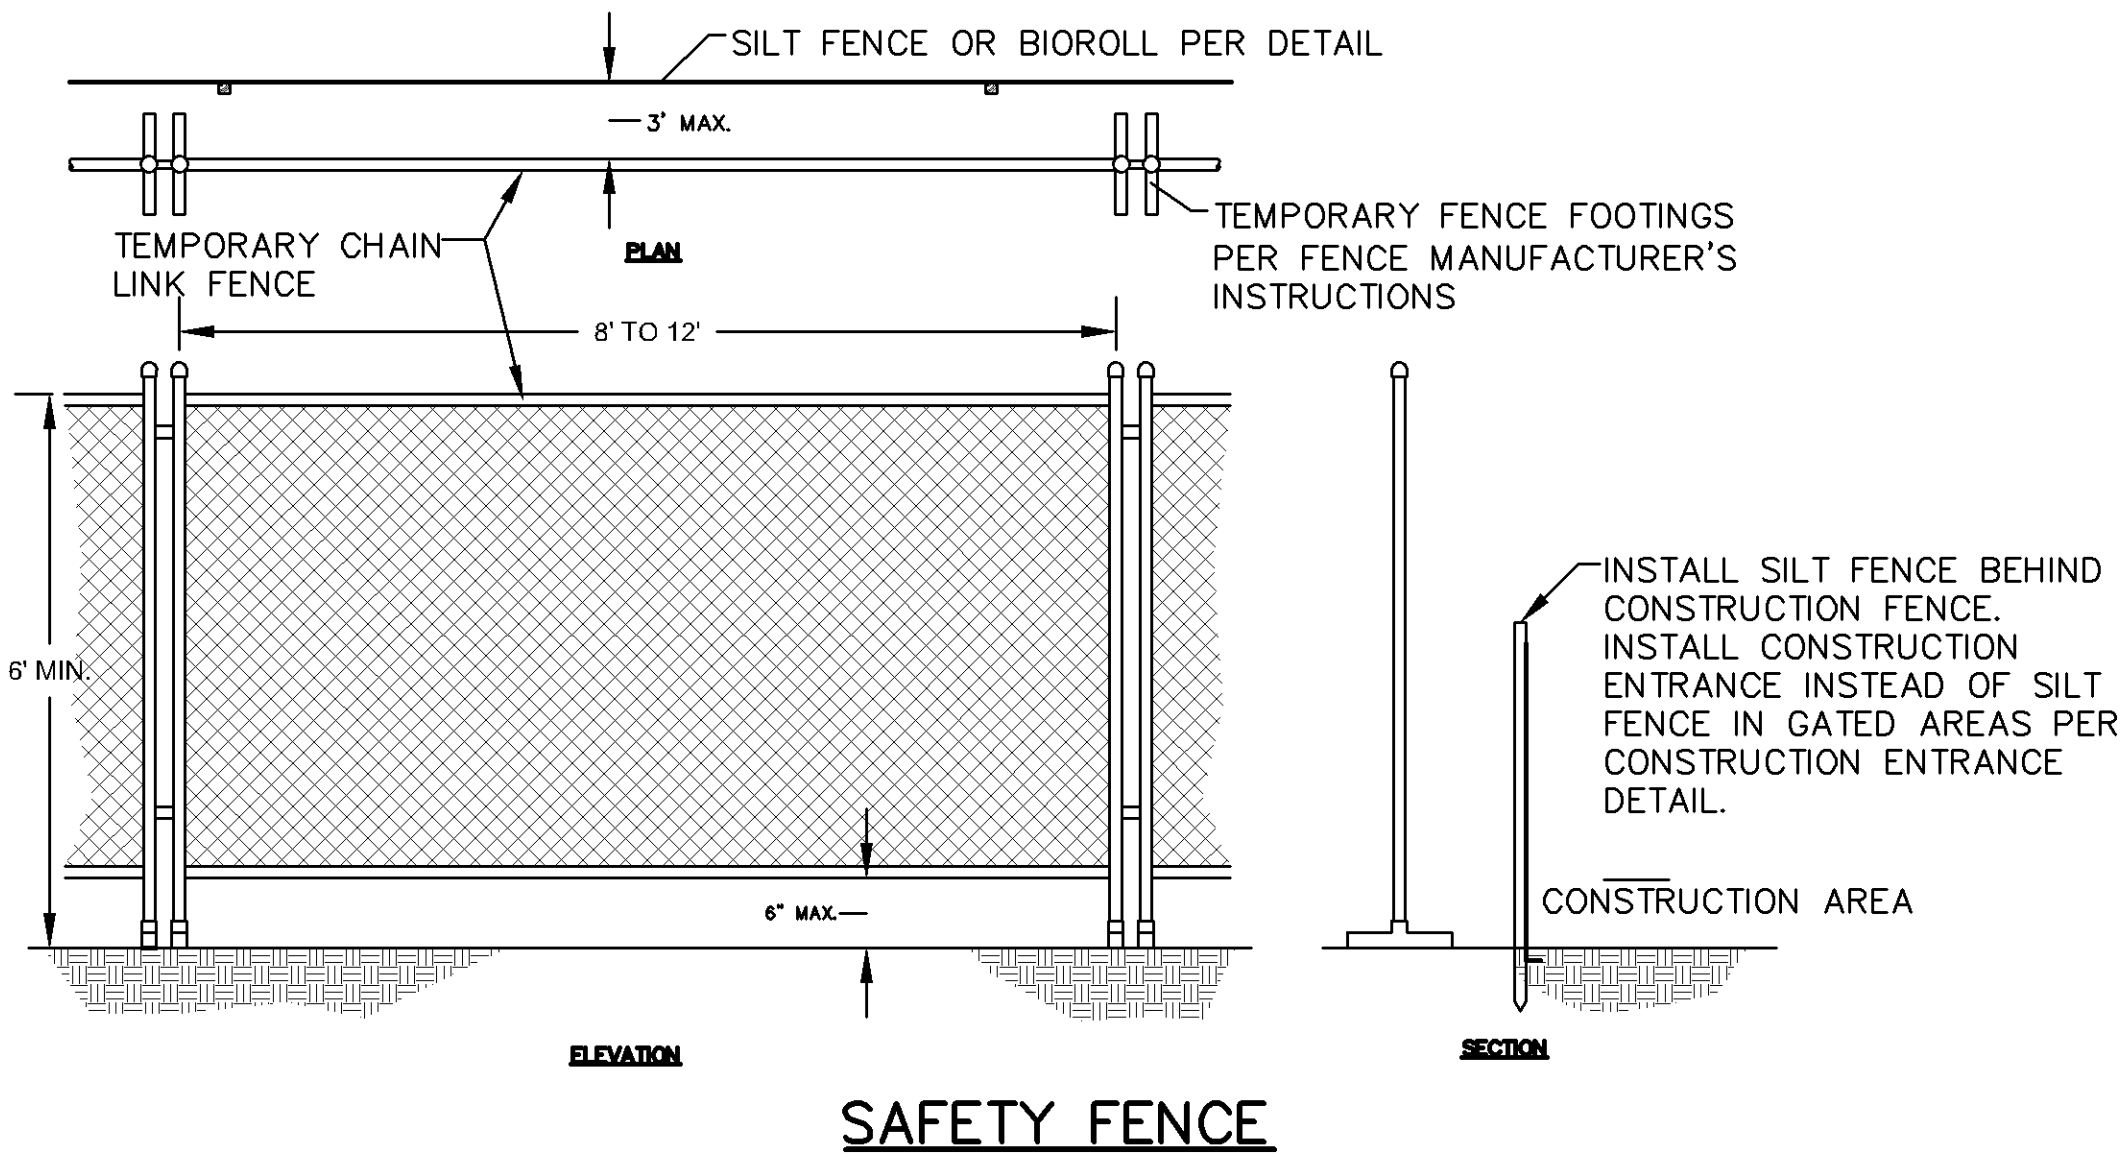

INLET PROTECTION, SEDIMENT FILTER SACK

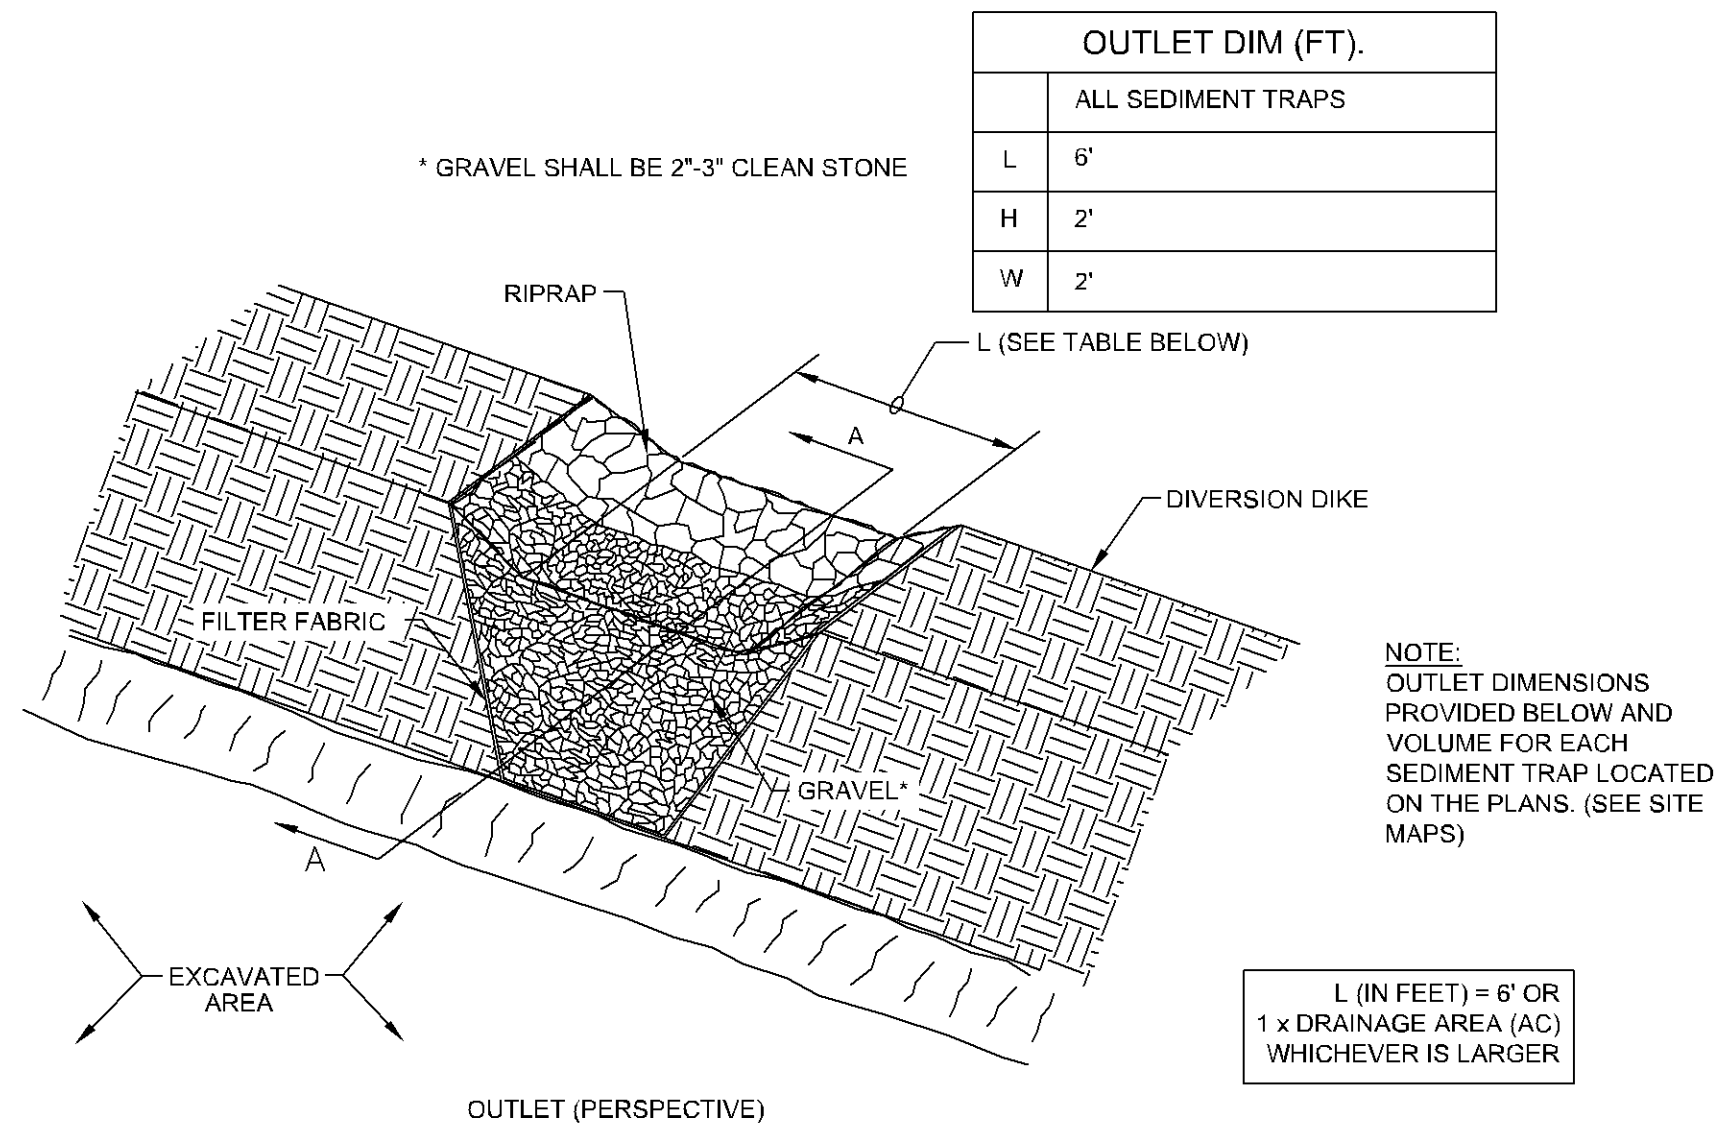

TEMPORARY SEDIMENT TRAP

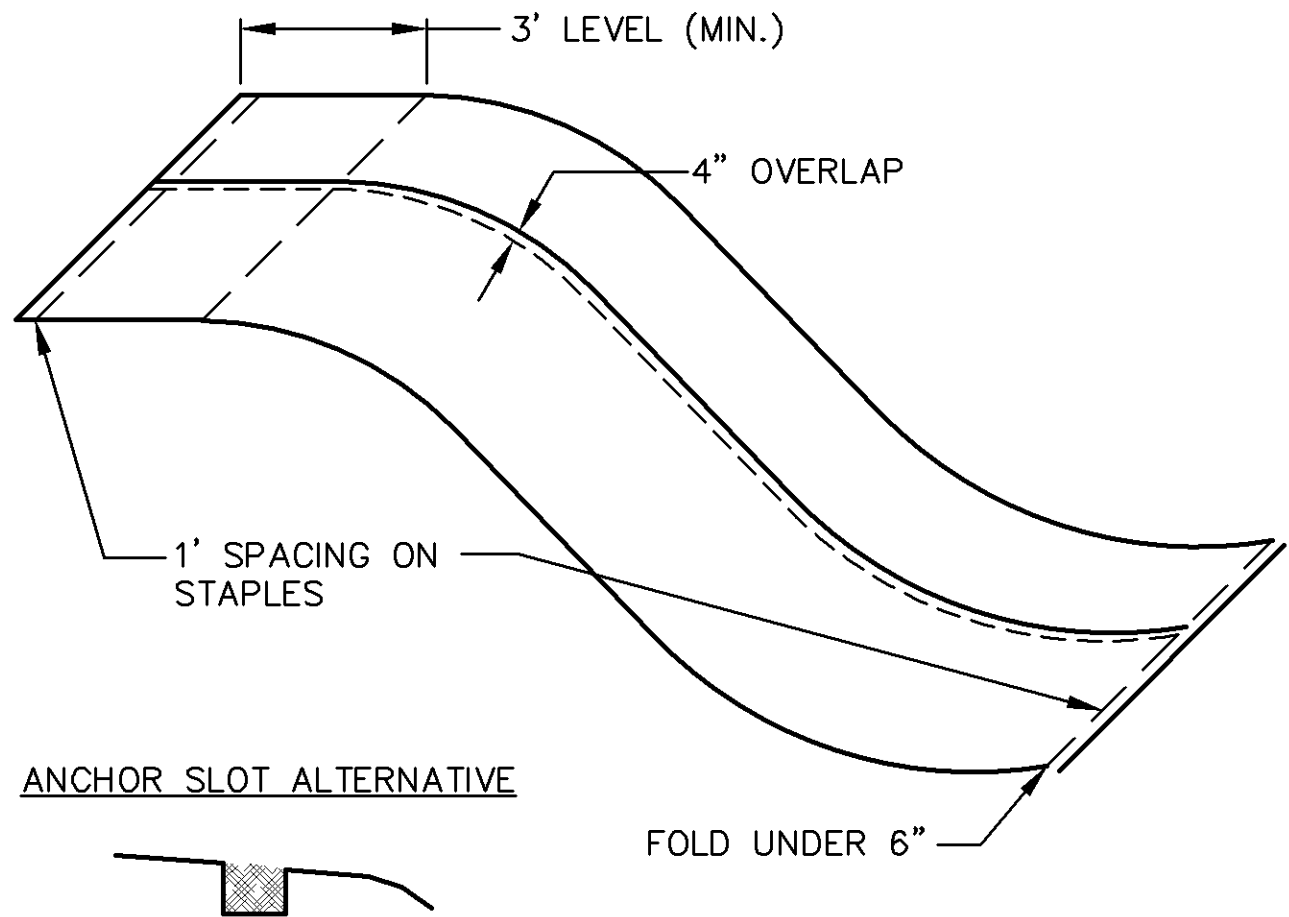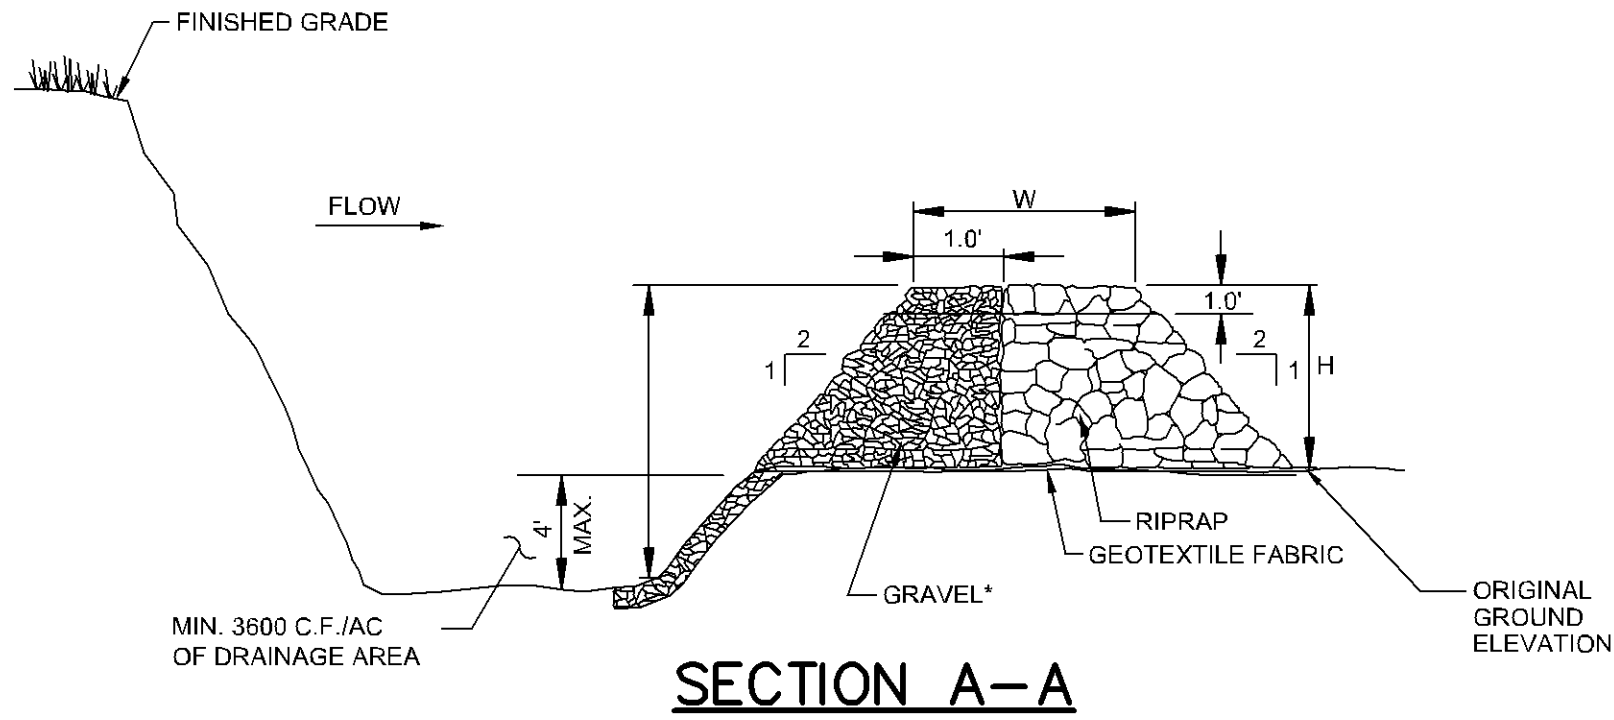

EROSION CONTROL BLANKET

PRELIMINARY - NOT FOR CONSTRUCTION

BLOOMINGTON WEST REDEVELOPMENT PREPARED FOR UNITED PROPERTIES BLOOMINGTON MN

EROSION AND SEDIMENT CONTROL DETAILS

KHA PROJECT 160576022 DATE 12/01/2021 SCALE AS SHOWN DESIGNED BY EIS DRAWN BY EIS CHECKED BY T.J.L.

DESIGNED BY EIS DATE 10/06/2021 LIC. NO. 21433

TOM LINCOLN, P.E. MN

2021 KIMLEY-HORN AND ASSOCIATES, INC. 767 EUSTIS STREET, SUITE 100, ST. PAUL, MN 55114 PHONE: 651-445-4187 WWW.KIMLEY-HORN.COM

Kimley»Horn

DEVELOPMENT APPLICATION REVISIONS

12/01/2021 EIS

DATE BY

This document, together with the concepts and designs presented herein, as an instrument of service, is intended only for the specific purpose and client for which it was prepared. Reuse of and improper reliance on this document without written authorization and adaptation by Kimley-Horn and Associates, Inc. shall be without liability to Kimley-Horn and Associates, Inc.

Sidewalks along collector roads must be eight feet in width (Sec. 21.301.04(d)(1)(A)(iii)).

Do not mark a crosswalk through the driveway

Vacation of this ingress easement requires further discussion. What is happening with the shared parking in the northwest corner of the site?

Ped ramps placed as shown don't appear to line up with future sidewalk to the south. Is there a reason for their position as shown? Does it line up with future sidewalk to the north?

Only rain gardens are allowed within required front landscape yard areas (20 feet from the front boundary). More significant stormwater facilities are not allowed within the front landscape yard.

KEYNOTE LEGEND

- (A) MATCH EXISTING EDGE OF PAVEMENT/ CURB & GUTTER
- (B) B612 CURB & GUTTER (TYP.)
- (C) B618 CURB & GUTTER (TYP.)
- (D) TRANSITION CURB
- (E) FLUSH CURB
- (F) COMMERCIAL DRIVEWAY APRON
- (G) LANDSCAPE AREA - SEE LANDSCAPE PLANS
- (H) ACCESSIBLE CURB RAMP
- (I) ACCESSIBLE PARKING SIGN
- (J) ACCESSIBLE PARKING
- (K) AREA STRIPED WITH 4" SYSL @ 45° 2' O.C.
- (L) PROPOSED TRANSFORMER PAD
- (M) VEHICULAR RAMP
- (N) UTILITY EXCAVATION PATCH, MATCH EXISTING PAVEMENT SECTION PER CITY STANDARD SPECIFICATIONS
- (O) 4" MOUNTABLE CURB
- (P) HEAVY DUTY CONCRETE PAVEMENT

CASE #PL2021-251

LEGEND

- PROPERTY LINE
- EXISTING EASEMENT
- WETLAND BOUNDARY
- PROPOSED CURB AND GUTTER
- PROPOSED LIGHT DUTY ASPHALT
- PROPOSED HEAVY DUTY ASPHALT
- PROPOSED CONCRETE SIDEWALK
- PROPOSED CONCRETE PAVEMENT

PROPERTY SUMMARY

BLOOMINGTON WEST REDEVELOPMENT

ZONING SUMMARY



FREEWAY COMMERCIAL DISTRICT (C-3)

BUILDING DATA SUMMARY

FOOTPRINT AREA	±46,450SF
PARKING	
PROPOSED SURFACE PARKING	118 SPACES
CITY PARKING REQUIREMENT	75 SPACES
SURFACE ADA STALLS REQ'D / PROVIDED	5 STALLS / 5 STALLS
TOTAL PROPERTY AREA	4.02 AC

SITE PLAN NOTES

- ALL WORK AND MATERIALS SHALL COMPLY WITH ALL CITY/COUNTY REGULATIONS AND CODES AND O.S.H.A. STANDARDS.
- CONTRACTOR SHALL REFER TO THE ARCHITECTURAL PLANS FOR EXACT LOCATIONS AND DIMENSIONS OF VESTIBULES, SLOPE PAVING, SIDEWALKS, EXIT PORCHES, TRUCK DOCKS, PRECISE BUILDING DIMENSIONS AND EXACT BUILDING UTILITY ENTRANCE LOCATIONS.
- ALL INNER CURBED RADII ARE TO BE 3' AND OUTER CURBED RADII ARE TO BE 10' UNLESS OTHERWISE NOTED. STRIPED RADII ARE TO BE 5'.
- ALL DIMENSIONS AND RADII ARE TO THE FACE OF CURB UNLESS OTHERWISE NOTED.
- EXISTING STRUCTURES WITHIN CONSTRUCTION LIMITS ARE TO BE ABANDONED, REMOVED OR RELOCATED AS NECESSARY. ALL COST SHALL BE INCLUDED IN BASE BID.
- CONTRACTOR SHALL BE RESPONSIBLE FOR ALL RELOCATIONS, (UNLESS OTHERWISE NOTED ON PLANS) INCLUDING BUT NOT LIMITED TO, ALL UTILITIES, STORM DRAINAGE, SIGNS, TRAFFIC SIGNALS & POLES, ETC. AS REQUIRED. ALL WORK SHALL BE IN ACCORDANCE WITH GOVERNING AUTHORITIES REQUIREMENTS AND PROJECT SITE WORK SPECIFICATIONS AND SHALL BE APPROVED BY SUCH. ALL COST SHALL BE INCLUDED IN BASE BID.
- SITE BOUNDARY, TOPOGRAPHY, UTILITY AND ROAD INFORMATION TAKEN FROM A SURVEY BY SUNDE LAND SURVEYING, DATED 12/18/2017.
KIMLEY-HORN ASSUMES NO LIABILITY FOR ANY ERRORS, INACCURACIES, OR OMISSIONS CONTAINED THEREIN.
- TOTAL LAND AREA IS 4.02 ACRES.
- PYLON / MONUMENT SIGNS SHALL BE CONSTRUCTED BY OTHERS. SIGNS ARE SHOWN FOR GRAPHICAL & INFORMATIONAL PURPOSES ONLY. CONTRACTOR TO VERIFY SIZE, LOCATION AND ANY REQUIRED PERMITS NECESSARY FOR THE CONSTRUCTION OF THE PYLON / MONUMENT SIGN.
- CONTRACTOR SHALL REFERENCE ARCH / MEP PLANS FOR SITE LIGHTING AND ELECTRICAL PLAN.
- NO PROPOSED LANDSCAPING SUCH AS TREES OR SHRUBS, ABOVE AND UNDERGROUND STRUCTURES, OR OTHER OBSTRUCTIONS SHALL BE LOCATED WITHIN EXISTING OR PROPOSED UTILITY EASEMENTS AND RIGHTS OF WAY UNLESS SPECIFICALLY NOTED ON PLANS OTHERWISE.
- REFERENCE ARCHITECTURAL PLANS FOR DUMPSTER ENCLOSURE DETAILS.
- REFER TO FINAL PLAT OR ALTA SURVEY FOR EXACT LOT AND PROPERTY BOUNDARY DIMENSIONS.
- ALL AREAS ARE ROUNDED TO THE NEAREST SQUARE FOOT.
- ALL DIMENSIONS ARE ROUNDED TO THE NEAREST TENTH FOOT.
- ALL PARKING STALLS TO BE 9' IN WIDTH AND 18' IN LENGTH UNLESS OTHERWISE INDICATED.
- THERE ARE WETLANDS EXISTING ON SITE.
- CONTRACTOR SHALL OBTAIN A PUBLIC WORKS PERMIT FOR OBSTRUCTION AND CONCRETE WORK WITHIN THE RIGHT-OF-WAY. PERMIT IS REQUIRED PRIOR TO REMOVALS OR INSTALLATION. CONTACT SEAN JENKINS.
- ALL CONSTRUCTION AND POST-CONSTRUCTION PARKING AND STORAGE OF EQUIPMENT AND MATERIALS MUST BE ON-SITE. USE OF PUBLIC STREETS FOR PRIVATE CONSTRUCTION PARKING, LOADING/UNLOADING, AND STORAGE WILL NOT BE ALLOWED.

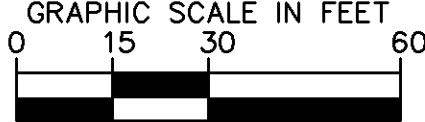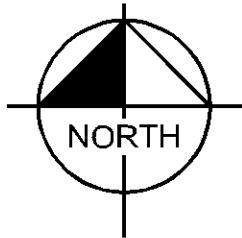

PRELIMINARY - NOT FOR CONSTRUCTION

BLOOMINGTON WEST
REDEVELOPMENT

PREPARED FOR

UNITED
PROPERTIES

BLOOMINGTON

SHEET NUMBER

C400

SITE PLAN

KHA PROJECT

160576022

DATE

12/01/2021

SCALE

AS SHOWN

DESIGNED BY

EIS

DRAWN BY

EIS

CHECKED BY

TJL

LICENSE CERTIFY THAT THIS PLAN

SPECIFICATION OR REPORT WAS PREPARED BY

ME OR UNDER MY DIRECT SUPERVISION AND

THAT I AM A DULY LICENSED PROFESSIONAL

ENGINEER UNDER THE LAWS OF THE STATE OF

MINNESOTA.

TOWNLINCOLN, P.E.

DATE

10/06/2021

LIC. NO.

21433

Kimley»Horn

© 2021 KIMLEY-HORN AND ASSOCIATES, INC.

767 EUSTIS STREET, SUITE 100, ST. PAUL, MN 55114

PHONE: 651-446-4197

WWW.KIMLEY-HORN.COM


No.

REVISIONS

DATE

BY

This document, together with the concepts and designs presented herein, as an instrument of service, is intended only for the specific purpose and client for which it was prepared. Reuse of and improper reliance on this document without written authorization and adaptation by Kimley-Horn and Associates, Inc. shall be without liability to Kimley-Horn and Associates, Inc.

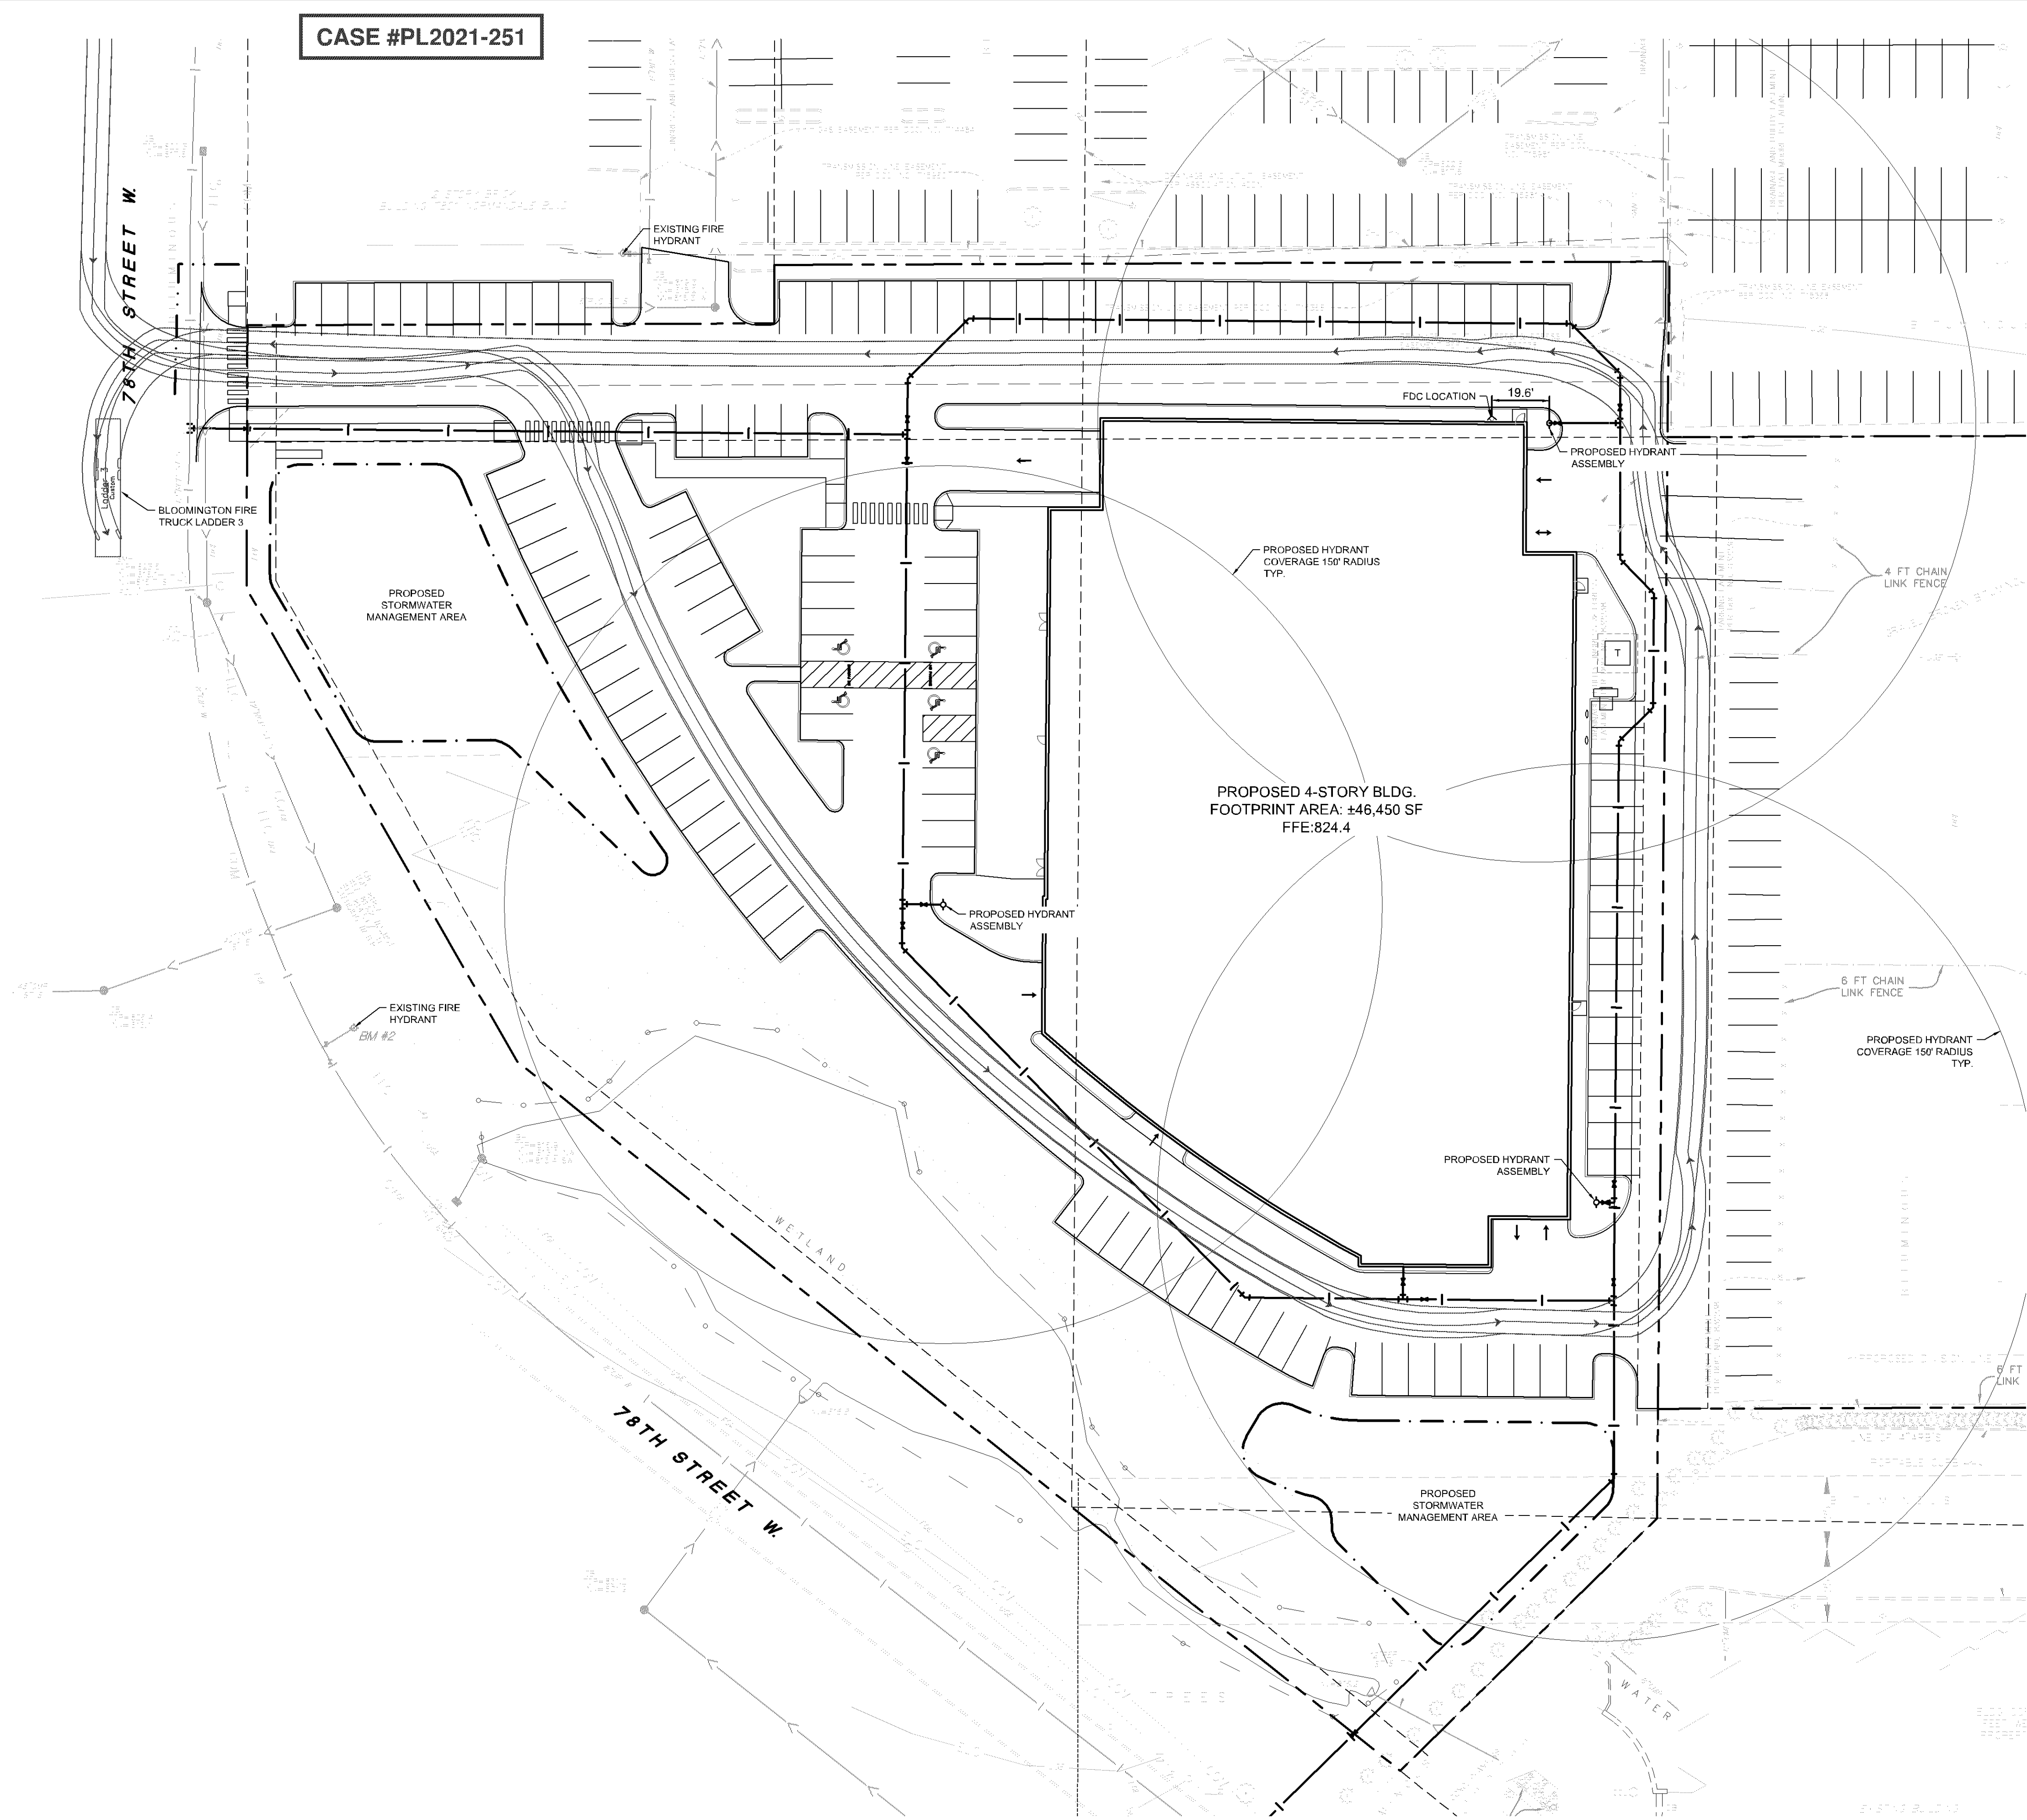

LEGEND


EXISTING PROPOSED

FIRE HYDRANT

FIRE HYDRANT

WATERMAIN

WATERMAIN

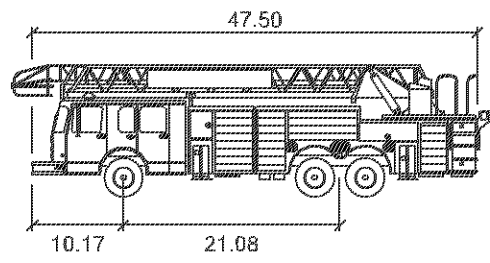

Bloomington Fire Ladder 3

feet


Width : 8.33

Track : 8.33

Lock to Lock Time : 6.0

Steering Angle : 40.0

THE VEHICLE MANEUVERINGS IDENTIFIED ON THIS PLAN WERE PREPARED USING AUTOTURN SOFTWARE AND DOES NOT NECESSARILY REPRESENT ACTUAL CONDITIONS NOR DOES IT ACCOUNT FOR EXTERNAL FACTORS. THIS ANALYSIS SHOULD NOT BE USED AS THE SOLE BASIS FOR THE CLIENT'S DECISION MAKING

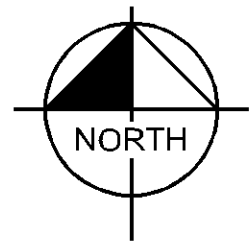

GRAPHIC SCALE IN FEET

0 15 30 60

PRELIMINARY - NOT FOR CONSTRUCTION

**BLOOMINGTON WEST
REDEVELOPMENT**
PREPARED FOR
**UNITED
PROPERTIES**
BLOOMINGTON MN

**FIRE ACCESS
PLAN**

I hereby certify that this plan was prepared by me or under my direct supervision and that I am a duly licensed professional engineer under the laws of the state of Minnesota.

DESIGNED BY: AS SHOWN
DRAWN BY: EIS
CHECKED BY: T.J.L.
DATE: 10/06/2021
LIC. NO.: 21433
TOM LINCOLN, P.E.
MN

KHA PROJECT: 160576022
DATE: 12/01/2021
SCALE: AS SHOWN
DESIGNED BY: EIS
DRAWN BY: EIS
CHECKED BY: T.J.L.

Kimley»Horn

2021 KIMLEY-HORN AND ASSOCIATES, INC.
767 EUSTIS STREET, SUITE 100, ST. PAUL, MN 55114
PHONE: 651-445-4187
WWW.KIMLEY-HORN.COM

No.	REVISIONS	DATE	BY
1	DEVELOPMENT APPLICATION	12/01/2021	EIS

78TH STREET W.

Max. 2% cross grade at crosswalk location

BMP #2: RETENTION BASIN -
TOP OF BASIN: 820.50
BOTTOM OF BASIN: 812.90
100-YR HWL: 819.51
WQV: 9,422 CF
TOTAL VOLUME: ±25,530 CF

CONNECT TO EXISTING STRM
& ADJUST CASTING ELEVATION
RE:820.00
IE:813.20 SE


EXISTING WETLAND
NWL: 816.90
100-YR HWL: 820.31

PROPOSED 4-STORY BLDG.
FOOTPRINT AREA: ±46,450 SF
FFE:824.4

BMP #1: RETENTION BASIN
TOP OF BASIN: 821.30
BOTTOM OF BASIN: 814.30
100-YR HWL: 820.31
WQV: 7,936 CF
TOTAL VOLUME: $\pm 18,100$ CF

	PROPERTY LINE
	EXISTING CONTOUR
	PROPOSED CONTOUR
	PROPOSED STORM MANHOLE (SOLID CASTING)
	PROPOSED STORM MANHOLE (ROUND INLET CASTING)
	PROPOSED STORM MANHOLE/ CATCH BASIN (CURB INLET CASTING)
	PROPOSED STORM SEWER GLENOUT
	PROPOSED FLARED END SECTION
	PROPOSED RIPRAP
	PROPOSED STORM SEWER
	PROPOSED STORM SEWER
	PROPOSED SPOT ELEVATION
	PROPOSED HIGH POINT ELEVATION
	PROPOSED LOW POINT ELEVATION
	PROPOSED GUTTER ELEVATION
	PROPOSED TOP OF CURB ELEVATION
	PROPOSED FLUSH PAVEMENT ELEVATION
	MATCH EXISTING ELEVATION
	PROPOSED EMERGENCY OVERFLOW
	PROPOSED DRAINAGE DIRECTION
	PROPOSED ADA SLOPE

1. ALL WORK SHALL BE PERFORMED IN ACCORDANCE WITH THE CITY OF BLOOMINGTON, SPECIFICATIONS AND BUILDING PERMIT REQUIREMENTS.
2. CONTRACTOR TO CALL GOPHER STATE CALL ONE @ <1-800-252-1166> AT LEAST TWO WORKING DAYS PRIOR TO EXCAVATION/CONSTRUCTION FOR UTILITY LOCATIONS.
3. STORM SEWER PIPE SHALL BE AS FOLLOWS:
 - RCP PER ASTM C-76
 - HDPE 6" - 10" PER AASHTO M-252
 - HDPE: 12" OR GREATER PER ASTM F-2306
 - PVC SCH. 40 PER ASTM D-1785STORM SEWER FITTINGS SHALL BE AS FOLLOWS:
 - RCP PER ASTM C-76, JOINTS PER ASTM C-361, C-990, AND C-443
 - HDPE PER ASTM 3212
 - PVC PER ASTM D-3034, JOINTS PER ASTM D-3212
4. CONTRACTOR TO FIELD VERIFY THE LOCATIONS AND ELEVATIONS OR EXISTING UTILITIES AND TO CORROBORATE FINDINGS PRIOR TO THE START OF SITE GRADING. THE CONTRACTOR SHALL IMMEDIATELY NOTIFY THE PROJECT ENGINEER OF ANY DISCREPANCIES OR VARIATIONS.
5. SUBGRADE EXCAVATION SHALL BE BACKFILLED IMMEDIATELY AFTER EXCAVATION TO HELP OFFSET ANY STABILITY PROBLEMS DUE TO WATER SEEPAGE OR STEEP SLOPES. WHEN PLACING NEW SURFACE MATERIAL ADJACENT TO EXISTING PAVEMENT, THE EXCAVATION SHALL BE BACKFILLED PROMPTLY TO AVOID UNDERMINING OF EXISTING PAVEMENT.
6. CONTRACTOR SHALL BE RESPONSIBLE FOR ALL HORIZONTAL AND VERTICAL CONTROL.
7. CONTRACTOR SHALL EXCAVATE DRAINAGE TRENCHES TO FOLLOW PROPOSED STORM SEWER ALIGNMENTS.
8. GRADES SHOWN ARE FINISHED GRADES. CONTRACTOR SHALL ROUGH GRADE TO SUBGRADE ELEVATION AND LEAVE STREET READY FOR SUBBASE.
9. ALL EXCESS MATERIAL, BITUMINOUS SURFACING, CONCRETE ITEMS, ANY ABANDONED UTILITY ITEMS, AND OTHER UNSTABLE MATERIALS SHALL BECOME THE PROPERTY OF THE CONTRACTOR AND SHALL BE DISPOSED OF OFF THE CONSTRUCTION SITE.
10. REFER TO THE UTILITY PLAN FOR SANITARY SEWER MAIN, WATER MAIN SERVICE LAYOUT AND ELEVATIONS AND CASTING / STRUCTURE NOTATION.
11. CONTRACTOR SHALL BE RESPONSIBLE FOR CONSTRUCTION OF PAVEMENTS AND CURB AND GUTTER WITH SMOOTH UNIFORM SLOPES TO PROVIDE POSITIVE DRAINAGE.
12. INSTALL A MINIMUM OF 4" CLASS 5 AGGREGATE BASE UNDER CURB AND GUTTER AND CONCRETE SIDEWALKS.
13. UPON COMPLETION OF EXCAVATION AND FILLING, CONTRACTOR SHALL RESTORE ALL STREETS AND DISTURBED AREAS ON SITE. ALL DISTURBED AREAS SHALL BE RE-VEGETATED WITH A MINIMUM OF 4" OF TOPSOIL.
14. ALL SPOT ELEVATIONS/CONTOURS ARE TO GUTTER / FLOW LINE UNLESS OTHERWISE NOTED.
15. GRADING FOR ALL SIDEWALKS AND ACCESSIBLE ROUTES INCLUDING CROSSING DRIVEWAYS SHALL CONFORM TO CURRENT ADA STATENATIONAL STANDARDS. IN NO CASE SHALL ACCESSIBLE RAMP SLOPES EXCEED 1 VERTICAL TO 12 HORIZONTAL. IN NO CASE SHALL SIDEWALK CROSS SLOPES EXCEED 2% . IN NO CASE SHALL LONGITUDINAL SIDEWALK SLOPES EXCEED 5% . IN NO CASE SHALL ACCESSIBLE PARKING STALLS OR AISLES EXCEED 2% (1 1/2 % TARGET) IN ALL DIRECTIONS. SIDEWALK ACCESS TO EXTERNAL BUILDING DOORS AND GATES SHALL BE ADA COMPLIANT. CONTRACTOR SHALL NOTIFY ENGINEER IMMEDIATELY IF ADA CRITERIA CANNOT BE MET IN ANY LOCATION PRIOR TO PAVING. NO CONTRACTOR CHANGE ORDERS WILL BE ACCEPTED FOR A.D.A COMPLIANCE ISSUES.
16. MAINTAIN A MINIMUM OF 0.5% GUTTER SLOPE TOWARDS LOW POINTS.
17. CONTRACTOR TO PROVIDE 3" INSULATION BY 5" WIDE CENTERED ON STORM PIPE IF LESS THAN 4" OF COVER IN PAVEMENT AREAS AND LESS THAN 3" OF COVER IN LANDSCAPE AREAS.
18. ALL STORM SEWER CONNECTIONS SHALL BE GASKETED AND WATER TIGHT INCLUDING MANHOLE CONNECTIONS.
19. ALL STORM SEWER PIPE SHALL BE AIR TESTED IN ACCORDANCE WITH THE CURRENT PLUMBING CODE.
20. MAINTAIN A MINIMUM OF 1.25% SLOPE IN BITUMINOUS PAVEMENT AREAS, 0.5% SLOPE IN CONCRETE PAVEMENT AREAS.
21. CONTRACTOR SHALL REVIEW PAVEMENT GRADIENT AND CONSTRUCT "INFALL CURB" WHERE PAVEMENT DRAINS TOWARD GUTTER, AND "OUTFALL" CURB WHERE PAVEMENT DRAINS AWAY FROM GUTTER.
22. HDPE PIPE CONNECTIONS INTO ALL CONCRETE STRUCTURES MUST BE MADE WITH WATER TIGHT MATERIALS UTILIZING A-LOK OR WATERSTOP GASKET OR BOOT, CAST-IN-PLACE RUBBER BOOT, OR APPROVED EQUIV. WHERE THE ALIGNMENT DIFFERS THE USE OF THE ABOVE APPROVED WATER TIGHT METHODS, CONSEAL 2311 WATER-OF-SEALANT OR APPROVED EQUIV. WILL ONLY BE ALLOWED AS APPROVED BY THE ENGINEER.

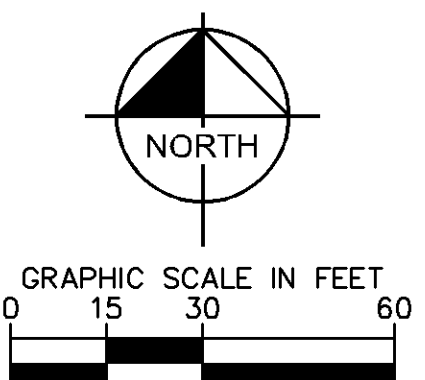


REDEVELOPMENT
PREPARED FOR
**UNITED
PROPERTIES**
BLOOMINGTON
MN

© 2021 KIMLEY-HORN AND ASSOCIATES, INC.
1767 EUSTIS STREET, SUITE 100, ST. PAUL, MN 55114
PHONE: 651-645-4197
WWW.KIMLEY-HORN.COM

DATE:	10/06/2021	MN	21433
		LIC NO	

[illegible]

This document, together with the concepts and designs presented herein, as an instrument of service, is intended only for the specific purpose and client for which it was prepared. Reuse of and improper reliance on this document without written authorization and adaptation by Kimley-Horn and Associates, Inc. shall be without liability to Kimley-Horn and Associates, Inc.

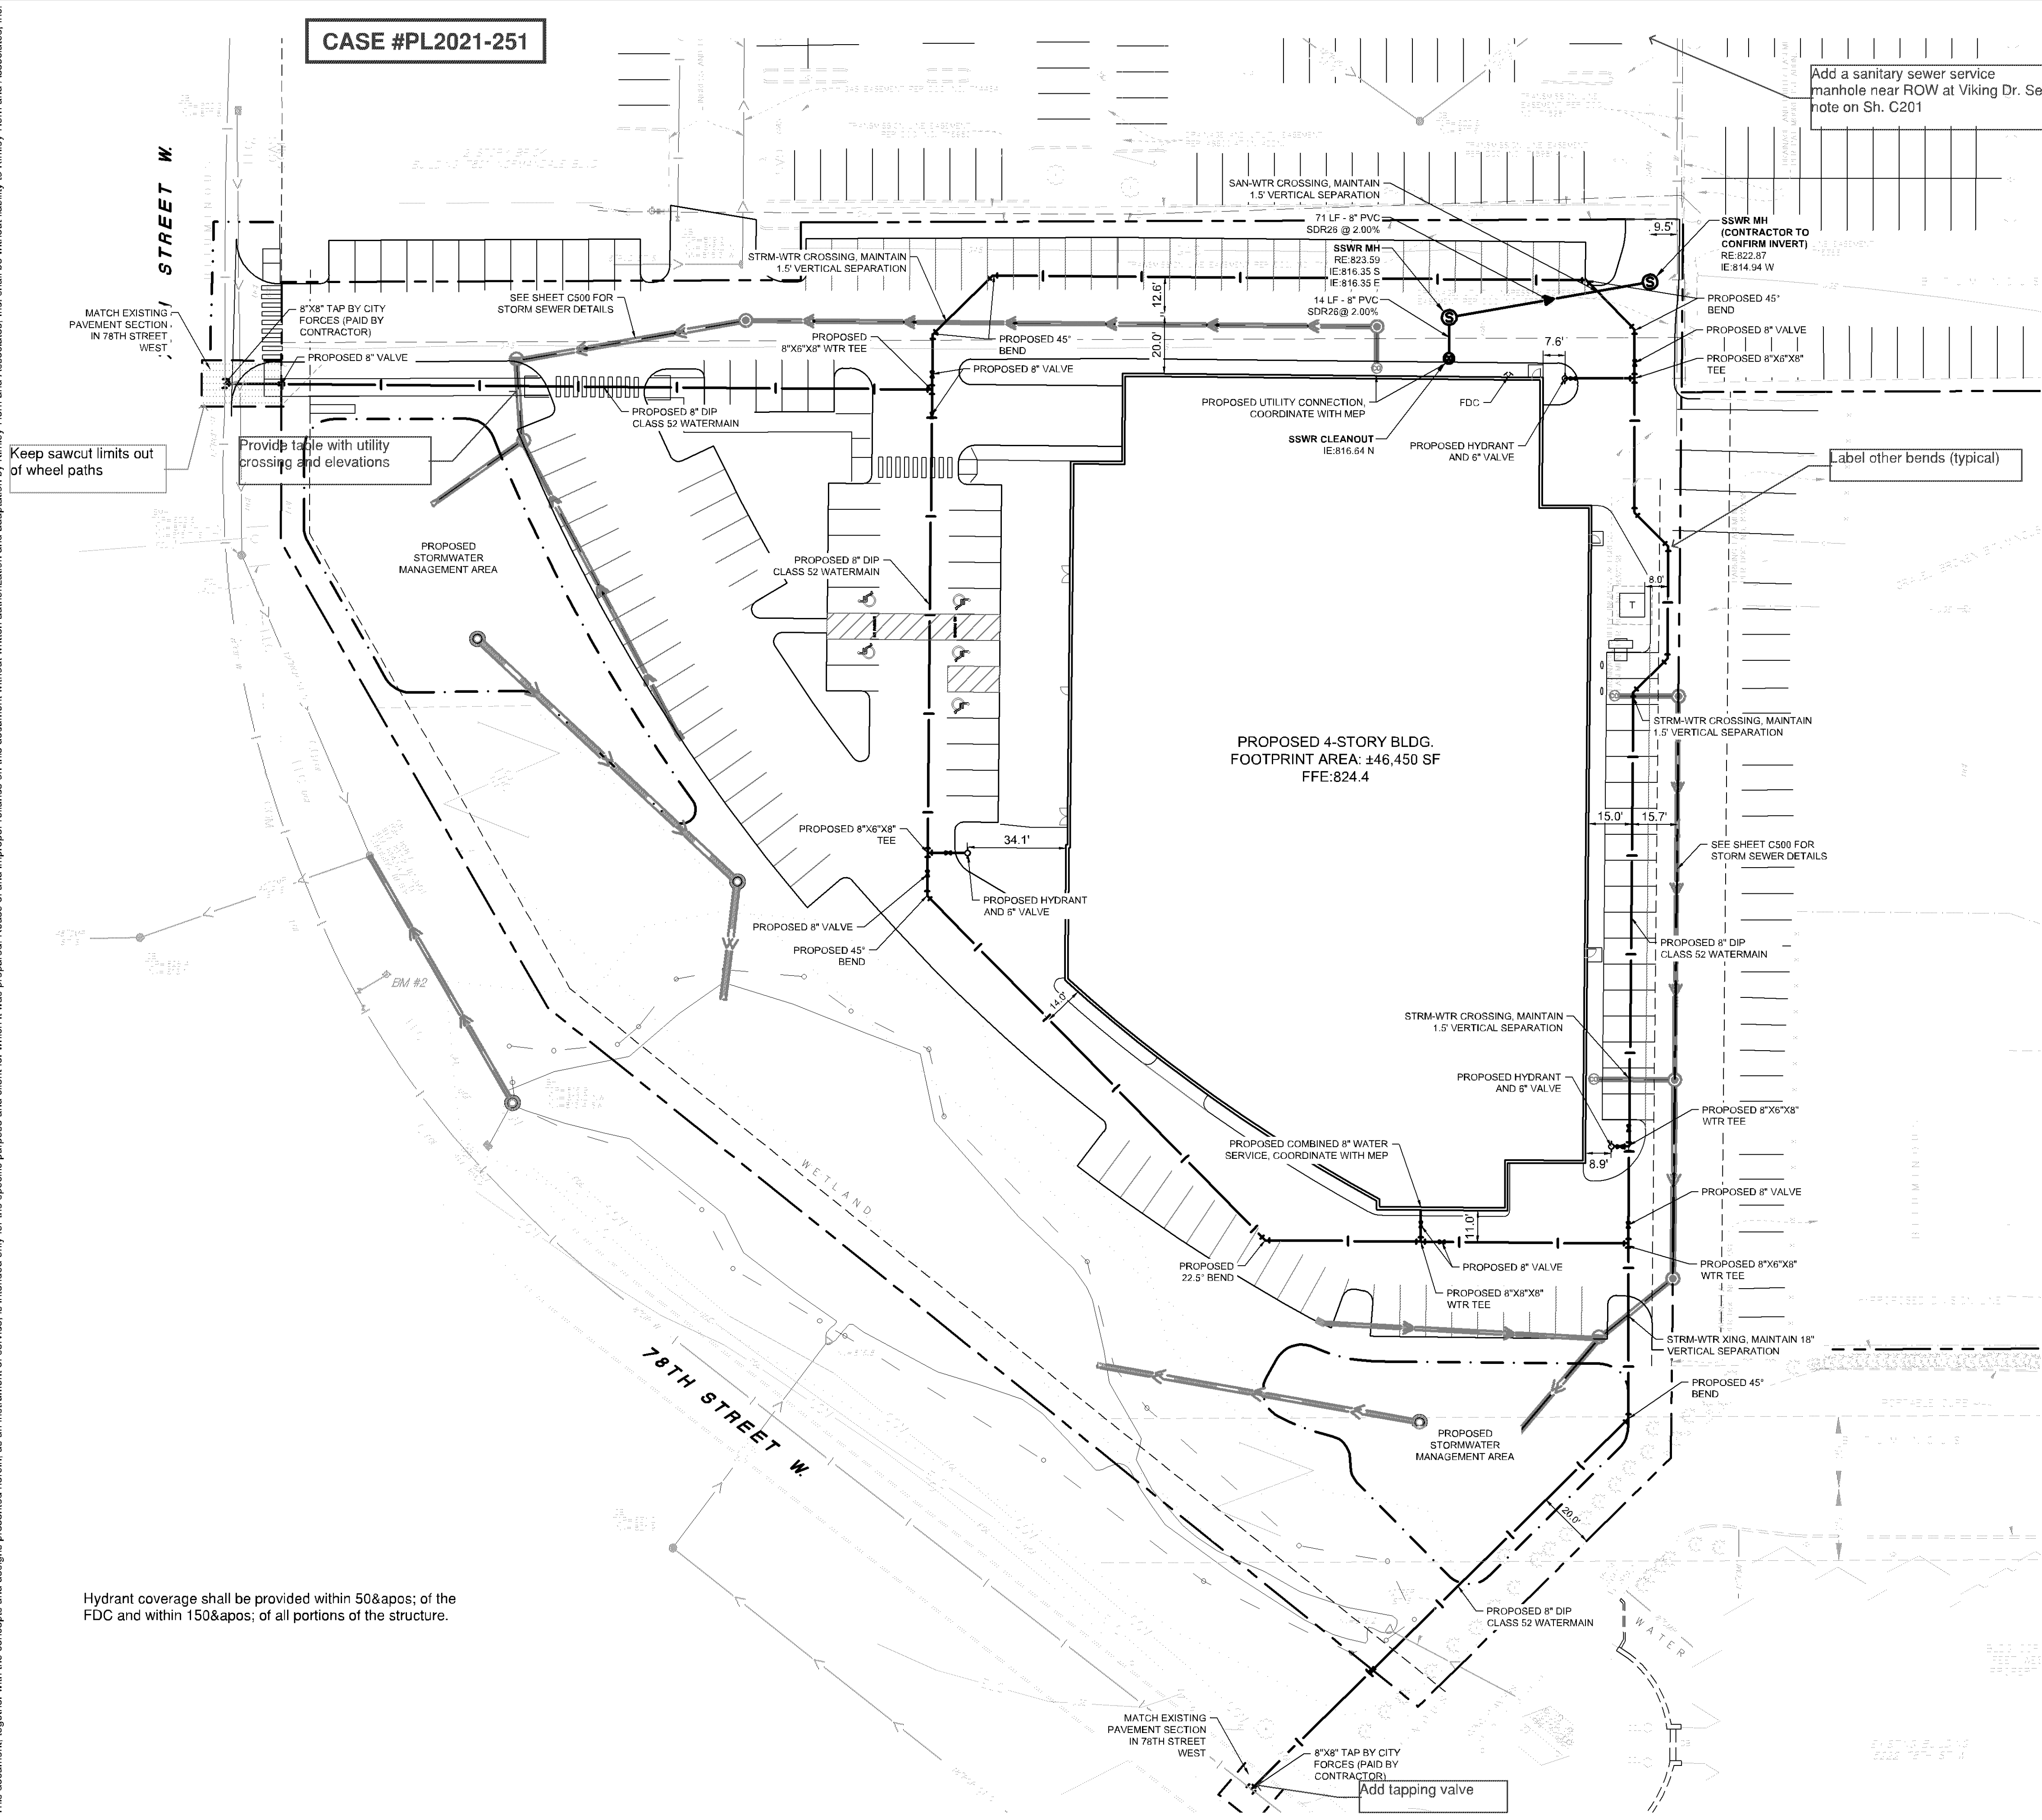

Hydrant coverage shall be provided within 50' of the FDC and within 150' of all portions of the structure.

LEGEND

EXISTING

PROPOSED

GATE VALVE

HYDRANT

REDUCER

TEE

SANITARY SEWER MANHOLE

SANITARY CLEANOUT

WATERMAIN

SANITARY SEWER

STORM SEWER

UNDERGROUND ELECTRIC

TELEPHONE

GAS MAIN

UTILITY PLAN NOTES

1. ALL FILL MATERIAL IS TO BE IN PLACE, AND COMPACTED BEFORE INSTALLATION OF PROPOSED UTILITIES.

2. SANITARY SEWER PIPE SHALL BE AS FOLLOWS:
10" PVC SDR26, SCHEDULE 40, OR EQUIVALENT PER ASTM D 3034
8" PVC SDR26, SCHEDULE 40, OR EQUIVALENT PER ASTM D 3034
6" PVC SCHEDULE 40
DUCTILE IRON PIPE PER AWWA C150

3. WATER LINES SHALL BE AS FOLLOWS:
8" AND LARGER DUCTILE IRON PIPE PER AWWA C150
12" AND SMALLER USE CLASS 52 DIP

A MINIMUM OF 8MIL POLYWRAP IS REQUIRED ON ALL DIP. DIP TO BE ZINC COATED.

4. MINIMUM TRENCH WIDTH SHALL BE 2 FEET.

5. ALL WATER JOINTS ARE TO BE MECHANICAL JOINTS WITH RESTRAINTS SUCH AS THRUST BLOCKING, WITH STAINLESS STEEL OR COBALT BLUE BOLTS, OR AS INDICATED IN THE CITY SPECIFICATIONS AND PROJECT DOCUMENTS.

6. ALL UTILITIES SHOULD BE KEPT TEN (10') APART (PARALLEL) OR WHEN CROSSING 18" VERTICAL CLEARANCE (OUTSIDE EDGE OF PIPE TO OUTSIDE EDGE OF PIPE OR STRUCTURE).

7. CONTRACTOR SHALL MAINTAIN A MINIMUM OF 7'-5" COVER ON ALL WATERLINES.

8. IN THE EVENT OF A VERTICAL CONFLICT BETWEEN WATER LINES, SANITARY LINES, STORM LINES AND GAS LINES, OR ANY OBSTRUCTION (EXISTING AND PROPOSED), THE SANITARY LINE SHALL BE SCH. 40 OR C900 WITH MECHANICAL JOINTS AT LEAST 10 FEET ON EITHER SIDE OF THE CENTER LINE OF THE CROSSING. THE WATER LINE SHALL HAVE MECHANICAL JOINTS WITH APPROPRIATE FASTENERS AS REQUIRED TO PROVIDE A MINIMUM OF 18" VERTICAL SEPARATION. MEETING REQUIREMENTS OF ANSI A21.10 OR ANSI 21.11 (AWWA C-151) (CLASS 50).

9. LINES UNDERGROUND SHALL BE INSTALLED, INSPECTED AND APPROVED BEFORE BACKFILLING.

10. TOPS OF MANHOLES SHALL BE RAISED AS NECESSARY TO BE FLUSH WITH PROPOSED PAVEMENT ELEVATIONS, AND TO BE ONE FOOT ABOVE FINISHED GROUND ELEVATIONS, IN GREEN AREAS, WITH WATERTIGHT LIDS.

11. ALL CONCRETE FOR ENCASEMENTS SHALL HAVE A MINIMUM 28 DAY COMPRESSION STRENGTH AT 3000 P.S.I.

12. EXISTING UTILITIES SHALL BE VERIFIED IN FIELD PRIOR TO INSTALLATION OF ANY NEW LINES.

13. REFER TO INTERIOR PLUMBING DRAWINGS FOR TIE-IN OF ALL UTILITIES.

14. CONTRACTOR IS RESPONSIBLE FOR COMPLYING TO THE SPECIFICATIONS OF THE CITY OF BLOOMINGTON AND/OR STATE OF MN WITH REGARDS TO MATERIALS AND INSTALLATION OF THE WATER AND SEWER LINES.

15. THE CONTRACTOR IS SPECIFICALLY CAUTIONED THAT THE LOCATION AND/OR ELEVATION OF EXISTING UTILITIES AS SHOWN ON THESE PLANS IS BASED ON RECORDS OF THE VARIOUS UTILITY COMPANIES, AND WHERE POSSIBLE, MEASUREMENTS TAKEN IN THE FIELD. THE INFORMATION IS NOT TO BE RELIED ON AS BEING EXACT OR COMPLETE. THE CONTRACTOR MUST CALL THE APPROPRIATE UTILITY COMPANIES AT LEAST 72 HOURS BEFORE ANY EXCAVATION TO REQUEST EXACT FIELD LOCATION OF UTILITIES. IT SHALL BE THE RESPONSIBILITY OF THE CONTRACTOR TO RELOCATE ALL EXISTING UTILITIES WHICH CONFLICT WITH THE PROPOSED IMPROVEMENTS SHOWN ON THE PLANS.

16. CONTRACTOR IS RESPONSIBLE FOR ALL NECESSARY INSPECTIONS AND/OR CERTIFICATIONS REQUIRED BY CODES AND/OR UTILITY SERVICE COMPANIES.

17. CONTRACTOR SHALL COORDINATE WITH ALL UTILITY COMPANIES FOR INSTALLATION REQUIREMENTS AND SPECIFICATIONS.

18. CONTRACTOR SHALL REFERENCE ARCH / MEP PLANS FOR SITE LIGHTING AND ELECTRICAL PLAN.

19. BACKFLOW DEVICES (DDCV AND PRZ ASSEMBLIES) AND METERS ARE LOCATED IN THE INTERIOR OF THE BUILDING. REF. ARCH / MEP PLANS.

20. ALL ONSITE WATERMAINS AND SANITARY SEWERS SHALL BE PRIVATELY OWNED AND MAINTAINED.

21. ALL WATERMAIN STUBOUTS SHALL BE MECHANICALLY RESTRAINED WITH REACTION BLOCKING.

22. HDPE CONNECTIONS INTO ALL CONCRETE STRUCTURES MUST BE MADE WITH WATER TIGHT MATERIALS UTILIZING AN A-LOK OR WATERSTOP GASKET OR BOOT, CAST-IN-PLACE RUBBER BOOT, OR APPROVED EQUAL. WHERE THE ALIGNMENT PRECLUDES THE USE OF THE ABOVE APPROVED WATER TIGHT METHODS, CONSEAL 231 WATERSTOP SEALANT, OR APPROVED EQUAL WILL ONLY BE ALLOWED AS APPROVED BY THE ENGINEER.

23. TAP OF LIVE WATER MAINS ARE DONE BY CITY FORCES AND PAID FOR AND COORDINATED WITH THE CONTRACTOR.

24. UTILITY AND MECHANICAL CONTRACTORS MUST COORDINATE THE INSTALLATION OF ALL WATER AND SEWER SERVICE PIPES INTO THE BUILDING TO ACCOMMODATE CITY INSPECTIONS AND TESTING.

25. ALL COMPONENTS OF THE WATER SYSTEM, UP TO THE WATER METER OR FIRE SERVICE EQUIPMENT MUST UTILIZE PROTECTIVE INTERNAL COATINGS MEETING CURRENT ANSI/AWWA STANDARDS FOR CEMENT MORTAR LINING OR SPECIAL COATINGS. THE USE OF UNLINED OR UNCOATED PIPE IS NOT ALLOWED.

26. ALL UNUSED WATER SERVICE MUST PROPERLY ABANDONED AT THE MAIN. ALL UNUSED SANITARY SEWER SERVICES MUST PROPERLY ABANDONED AT THE PROPERTY LINE.

27. UTILITY PERMITS ARE REQUIRED FOR CONNECTIONS TO THE PUBLICS STORM, SANITARY, AND WATER SYSTEM. CONTACT CITY OF BLOOMINGTON UTILITIES DIVISION (952-563-8777) FOR PERMIT INFORMATION.

28. RESTORE UTILITY TRENCHES PER STANDARDS LISTED IN ARTICLE 5, CH. 17 OF THE BLOOMINGTON CITY CODE (SEE UTILITY DETAILS).

29. INTERIOR CHIMNEY SEALS SHALL BE INSTALLED ON ALL SANITARY MANHOLES.

30. PROVIDE A MINIMUM OF 8-FEET AND A MAXIMUM OF 10-FEET OF COVER OVER ALL WATER LINES, VALVES, SERVICES, ETC.

31. COMBINATION FIRE AND DOMESTIC SERVICES MUST TERMINATE WITH A THREAD ON FLANGE OR AN MJ TO FLANGE ADAPTER.

32. CONTRACTOR SHALL OBTAIN A PUBLIC WORKS PERMIT FOR UNDERGROUND WORK WITHIN THE RIGHT-OF-WAY. PERMIT IS REQUIRED PRIOR TO REMOVALS OR INSTALLATION. CONTACT UTILITIES (952-563-4598) FOR PERMIT INFORMATION.

PRELIMINARY - NOT FOR CONSTRUCTION

BLOOMINGTON WEST REDEVELOPMENT

PREPARED FOR
UNITED PROPERTIES

BLOOMINGTON

KHA PROJECT
160576022

DATE
12/01/2021

SCALE
AS SHOWN

DESIGNED BY
EIS

DRAWN BY
EIS

CHECKED BY
TJL

LIBRARY CERTIFY THAT THIS PLAN SPECIFICATION OR REPORT WAS PREPARED BY ME OR UNDER MY DIRECT SUPERVISION AND THAT I AM A DULY LICENSED PROFESSIONAL ENGINEER UNDER THE LAWS OF THE STATE OF MINNESOTA.

TOM LINCOLN, P.E.

DATE: 10/06/2021

MIN. LIC. NO. 21433

Kimley»Horn

2021 KIMLEY-HORN AND ASSOCIATES, INC.
767 EUSTIS STREET, SUITE 100, ST. PAUL, MN 55114
PHONE: 651-946-4197
WWW.KIMLEY-HORN.COM

12/01/2021

REVISIONS


DATE

BY


SHEET NUMBER
C600

This document, together with the concepts and designs presented herein, as an instrument of service, is intended only for the specific purpose and client for which it was prepared. Reuse of and improper reliance on this document without written authorization and adaptation by Kimley-Horn and Associates, Inc. shall be without liability to Kimley-Horn and Associates, Inc.


CASE #PL2021-251

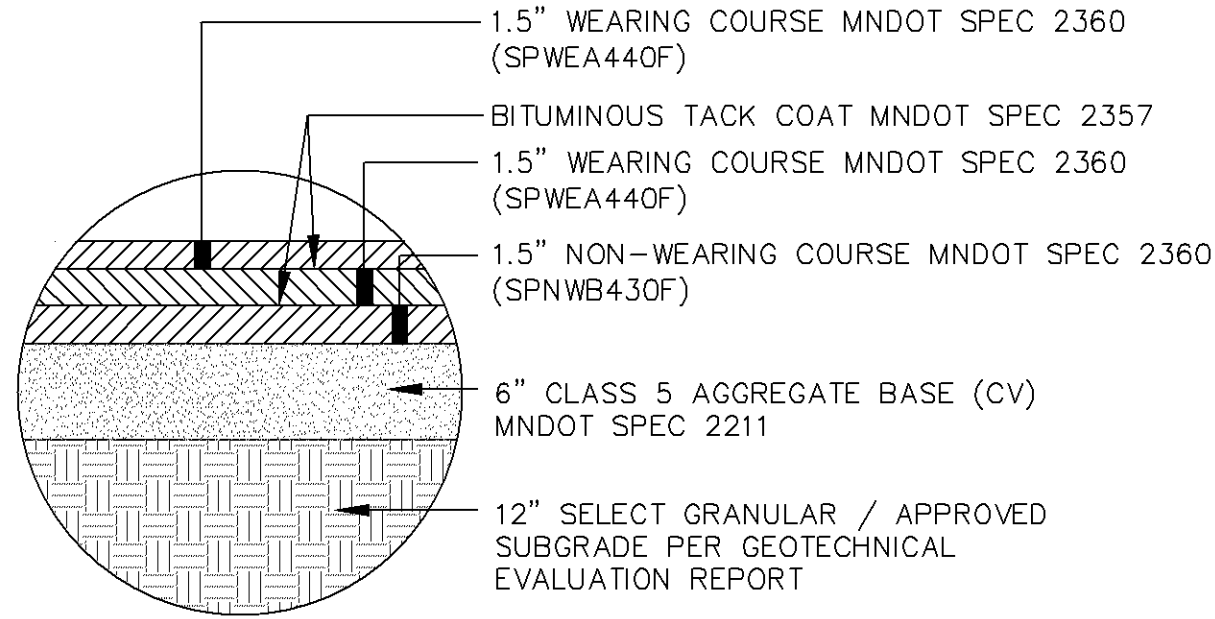


HEAVY DUTY BITUMINOUS PAVEMENT

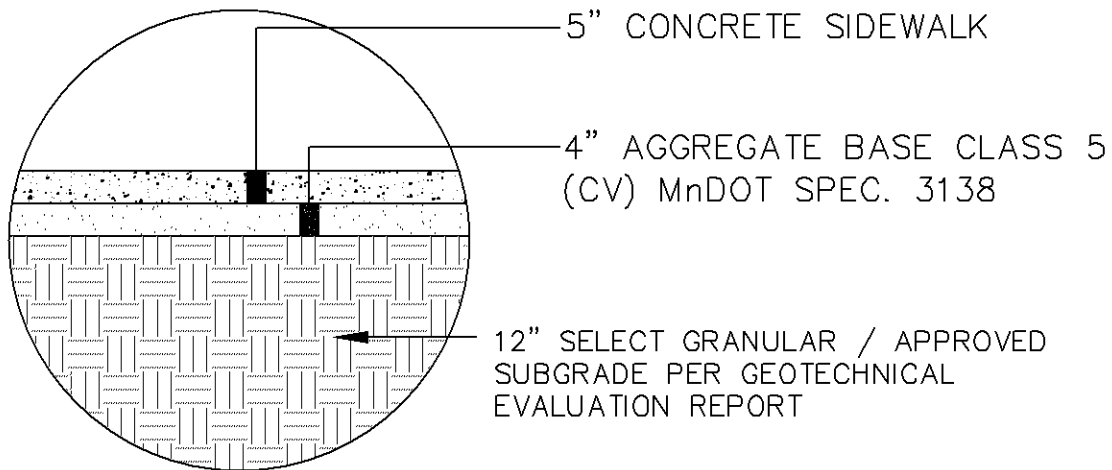


CONCRETE SIDEWALK

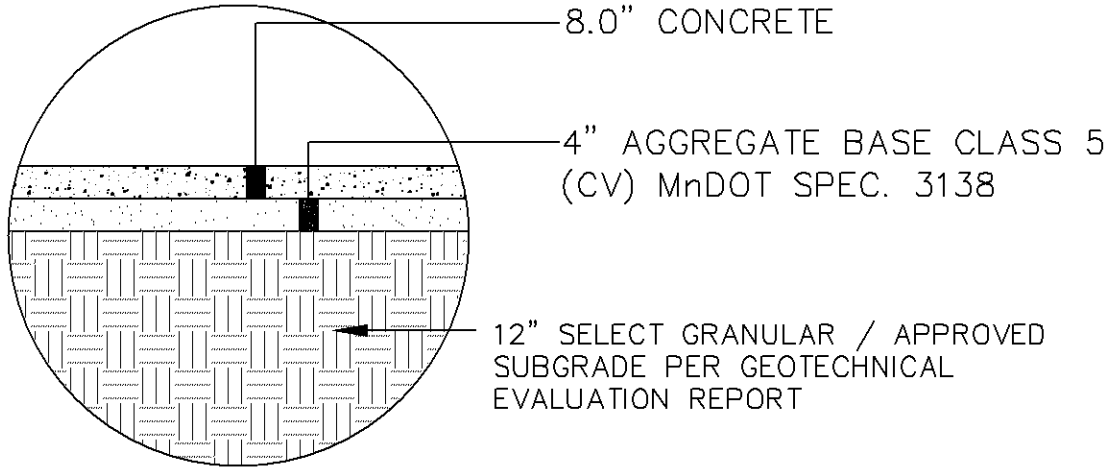


HEAVY DUTY CONCRETE PAVEMENT

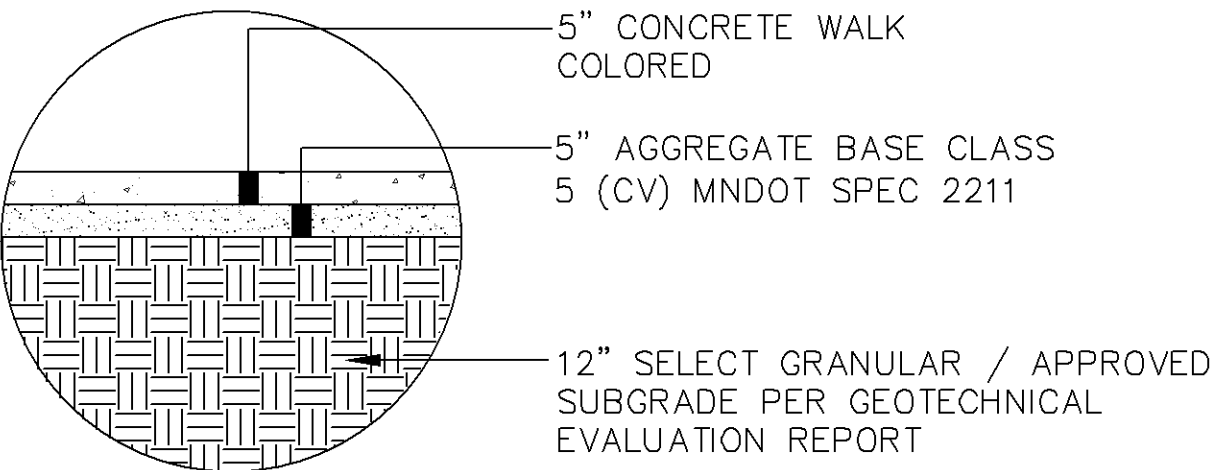


CONCRETE PAVEMENT-PUBLIC

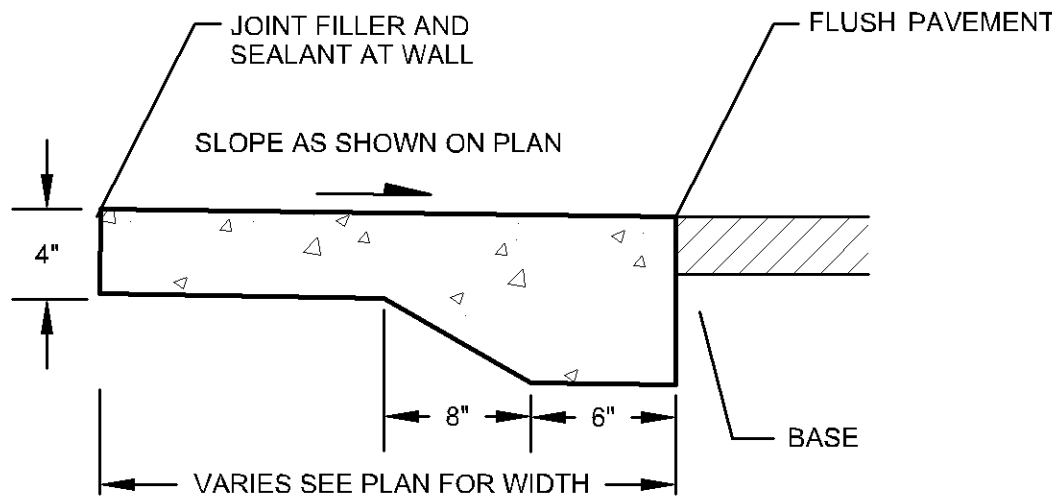


FLUSH CONCRETE CURB (OUTFALL)

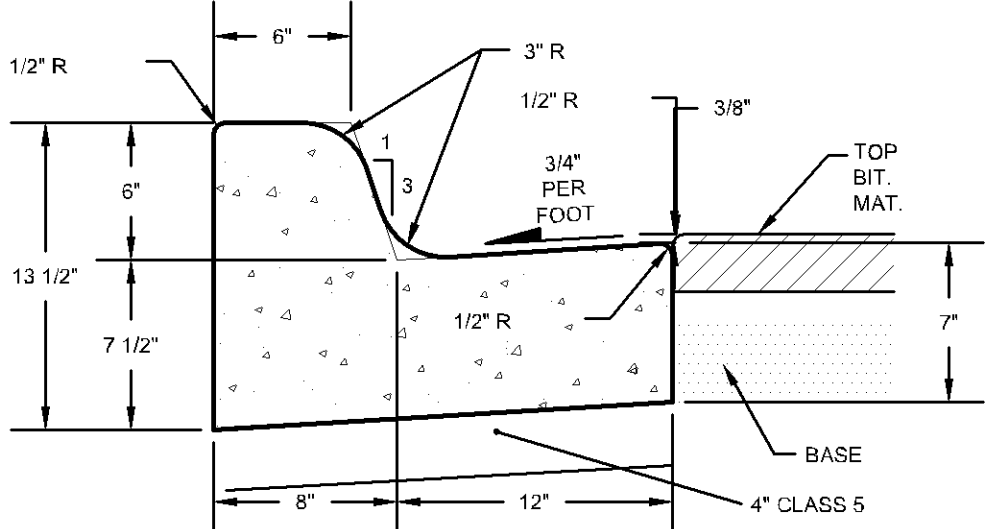


B612 CURB & GUTTER

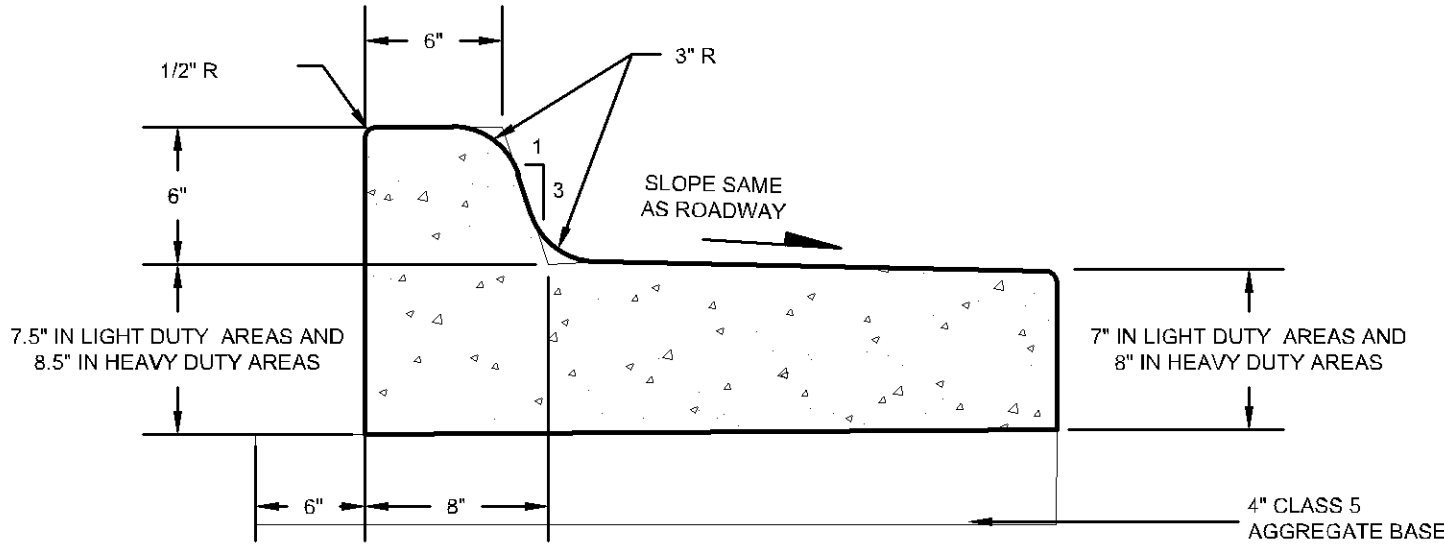


B612 CURB & GUTTER (OUTFALL)

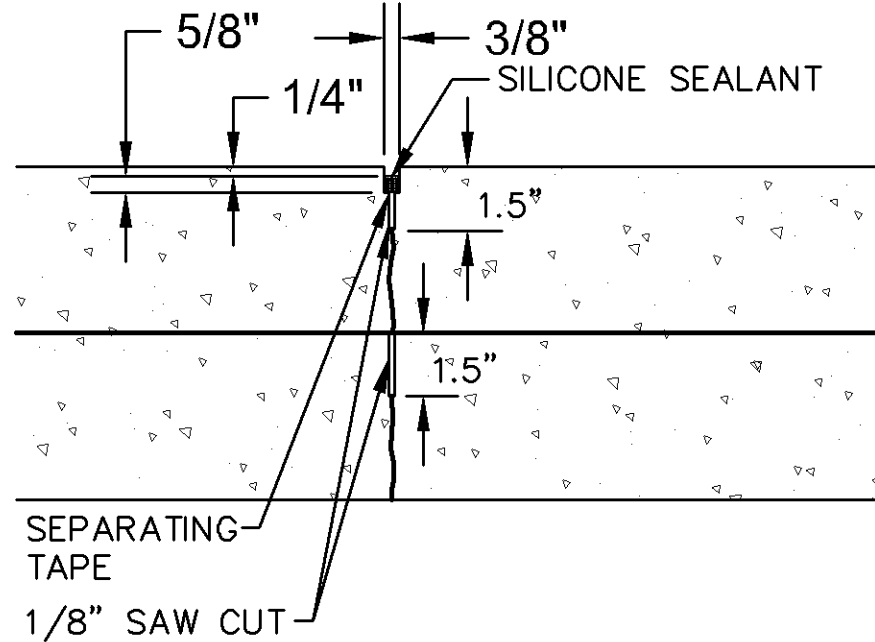


CONTRACTION JOINT DETAIL

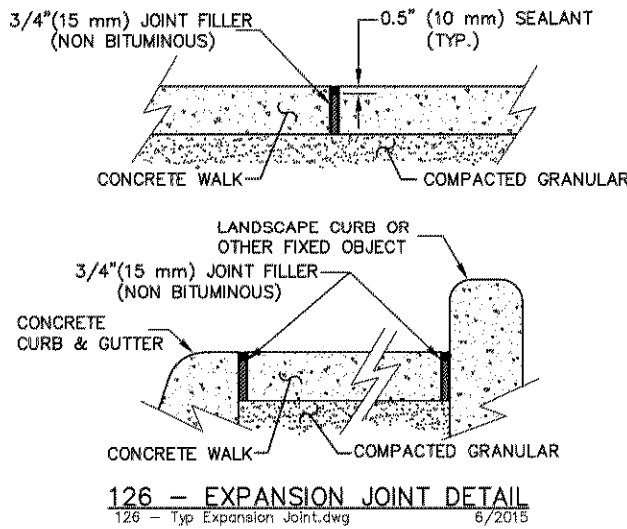

126 - Expansion Joint Detail

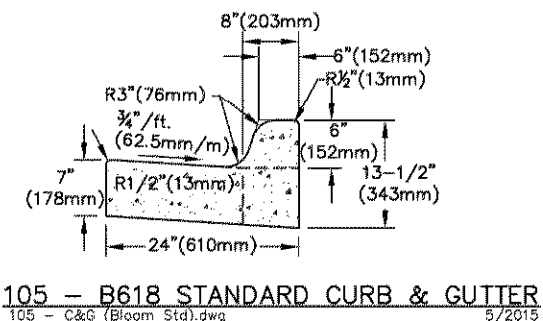

105 - B618 Standard Curb & Gutter

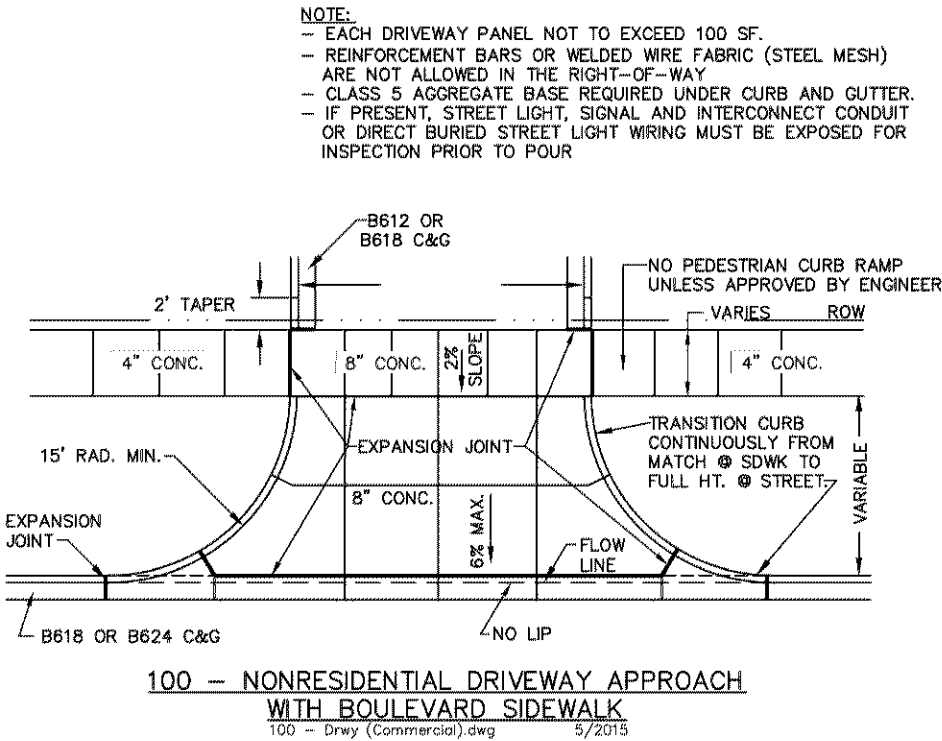

100 - Nonresidential Driveway Approach with Boulevard Sidewalk

126 - Typ Expansion Joint

ENGINEERING DIVISION
PUBLIC WORKS DEPARTMENT

105 - C&G (Bloom Std)

ENGINEERING DIVISION
PUBLIC WORKS DEPARTMENT

100 - Drwy (Commercial)

ENGINEERING DIVISION
PUBLIC WORKS DEPARTMENT

PRELIMINARY - NOT FOR CONSTRUCTION

BLOOMINGTON WEST
REDEVELOPMENT
PREPARED FOR
UNITED
PROPERTIES
BLOOMINGTON MN



CONSTRUCTION
DETAILS

KHA PROJECT
160576022
DATE
12/01/2021
SCALE
AS SHOWN
DESIGNED BY
EIS
DRAWN BY
EIS
CHECKED BY
TJL

FOR REFERENCE ONLY
TOM LINCOLN, P.E.
DATE
10/06/2021
LIC. NO.
21433

Kimley»Horn
2021 KIMLEY-HORN AND ASSOCIATES, INC.
767 EUSTIS STREET, SUITE 100, ST. PAUL, MN 55114
PHONE: 651-445-4187
WWW.KIMLEY-HORN.COM

DEVELOPMENT APPLICATION	REVISIONS	DATE	BY
No.			


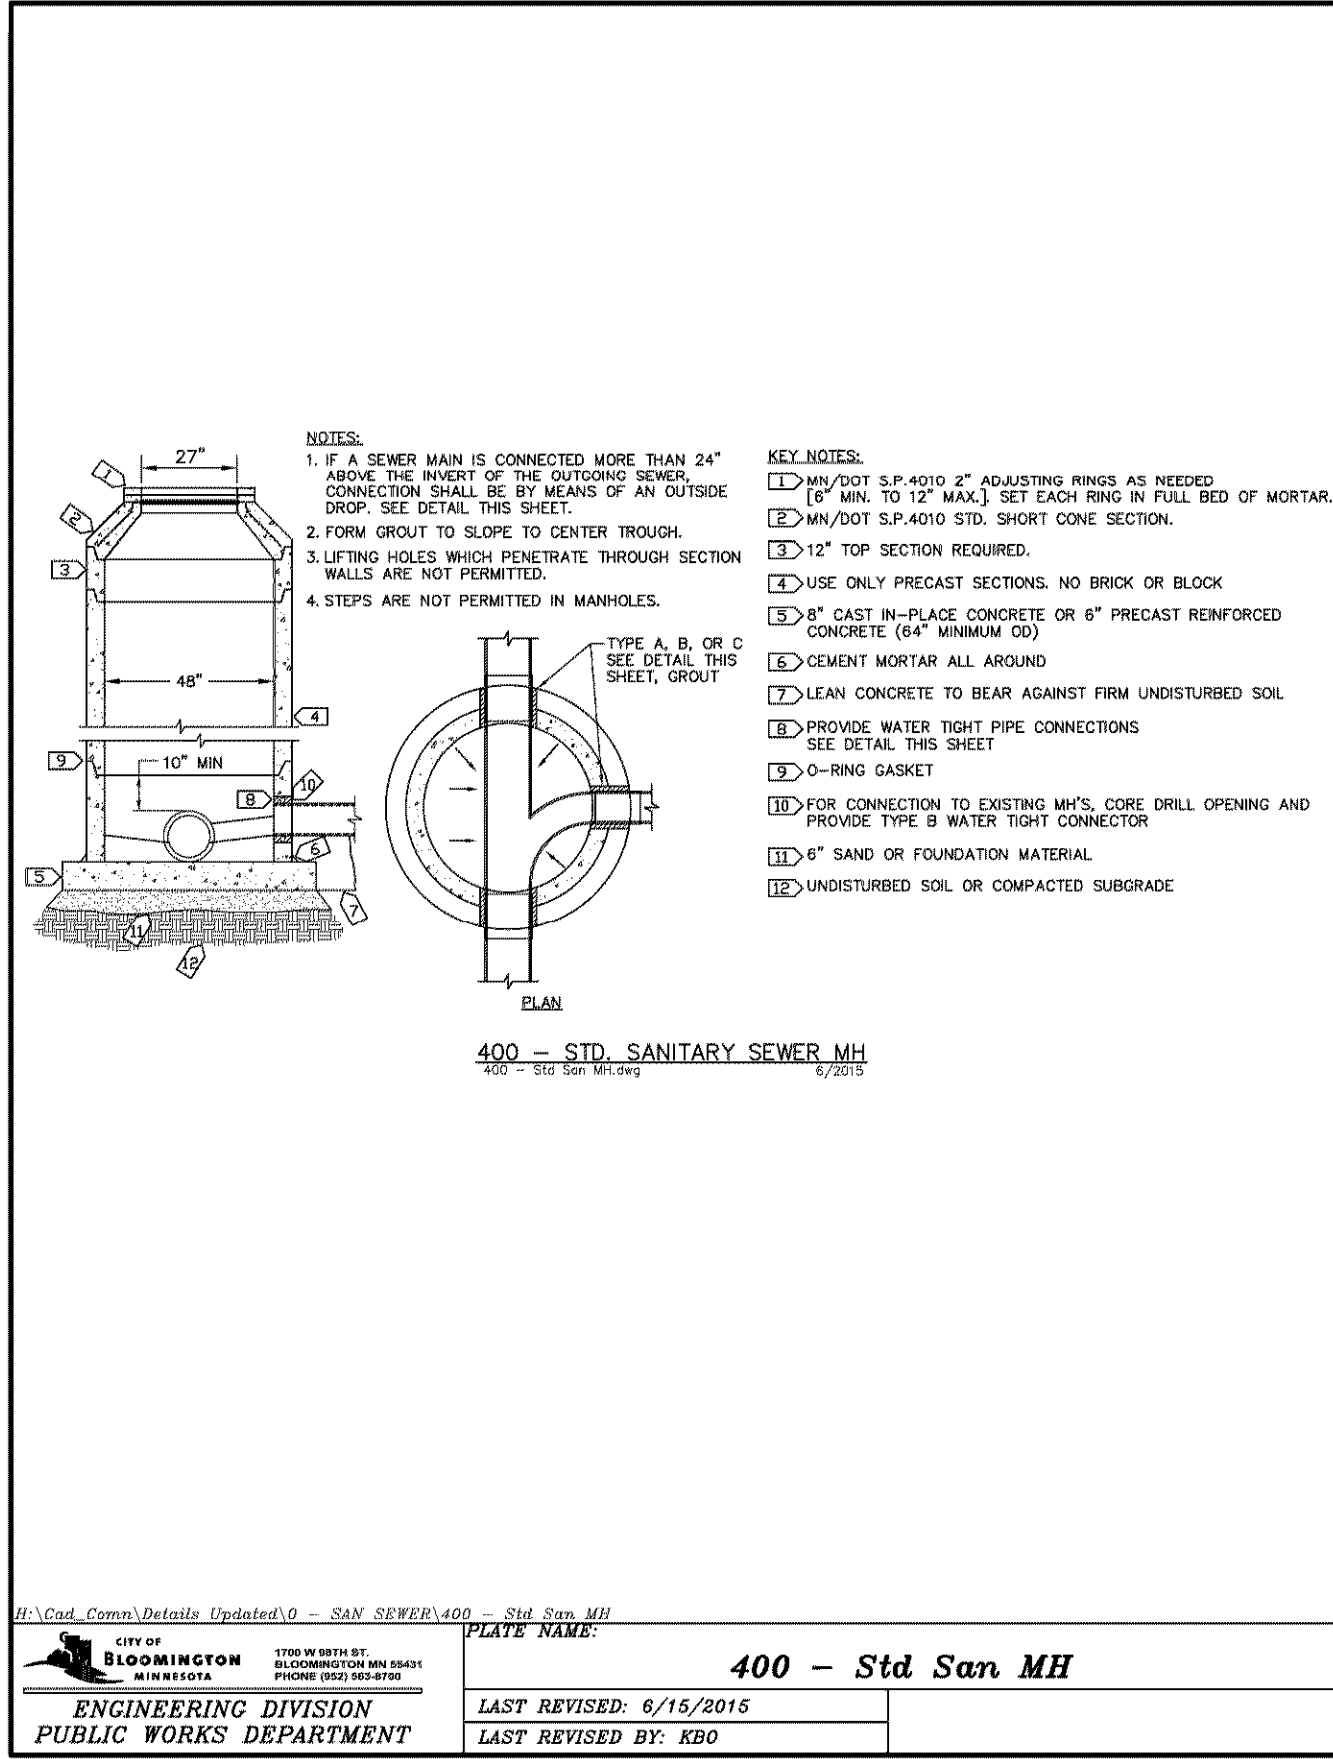
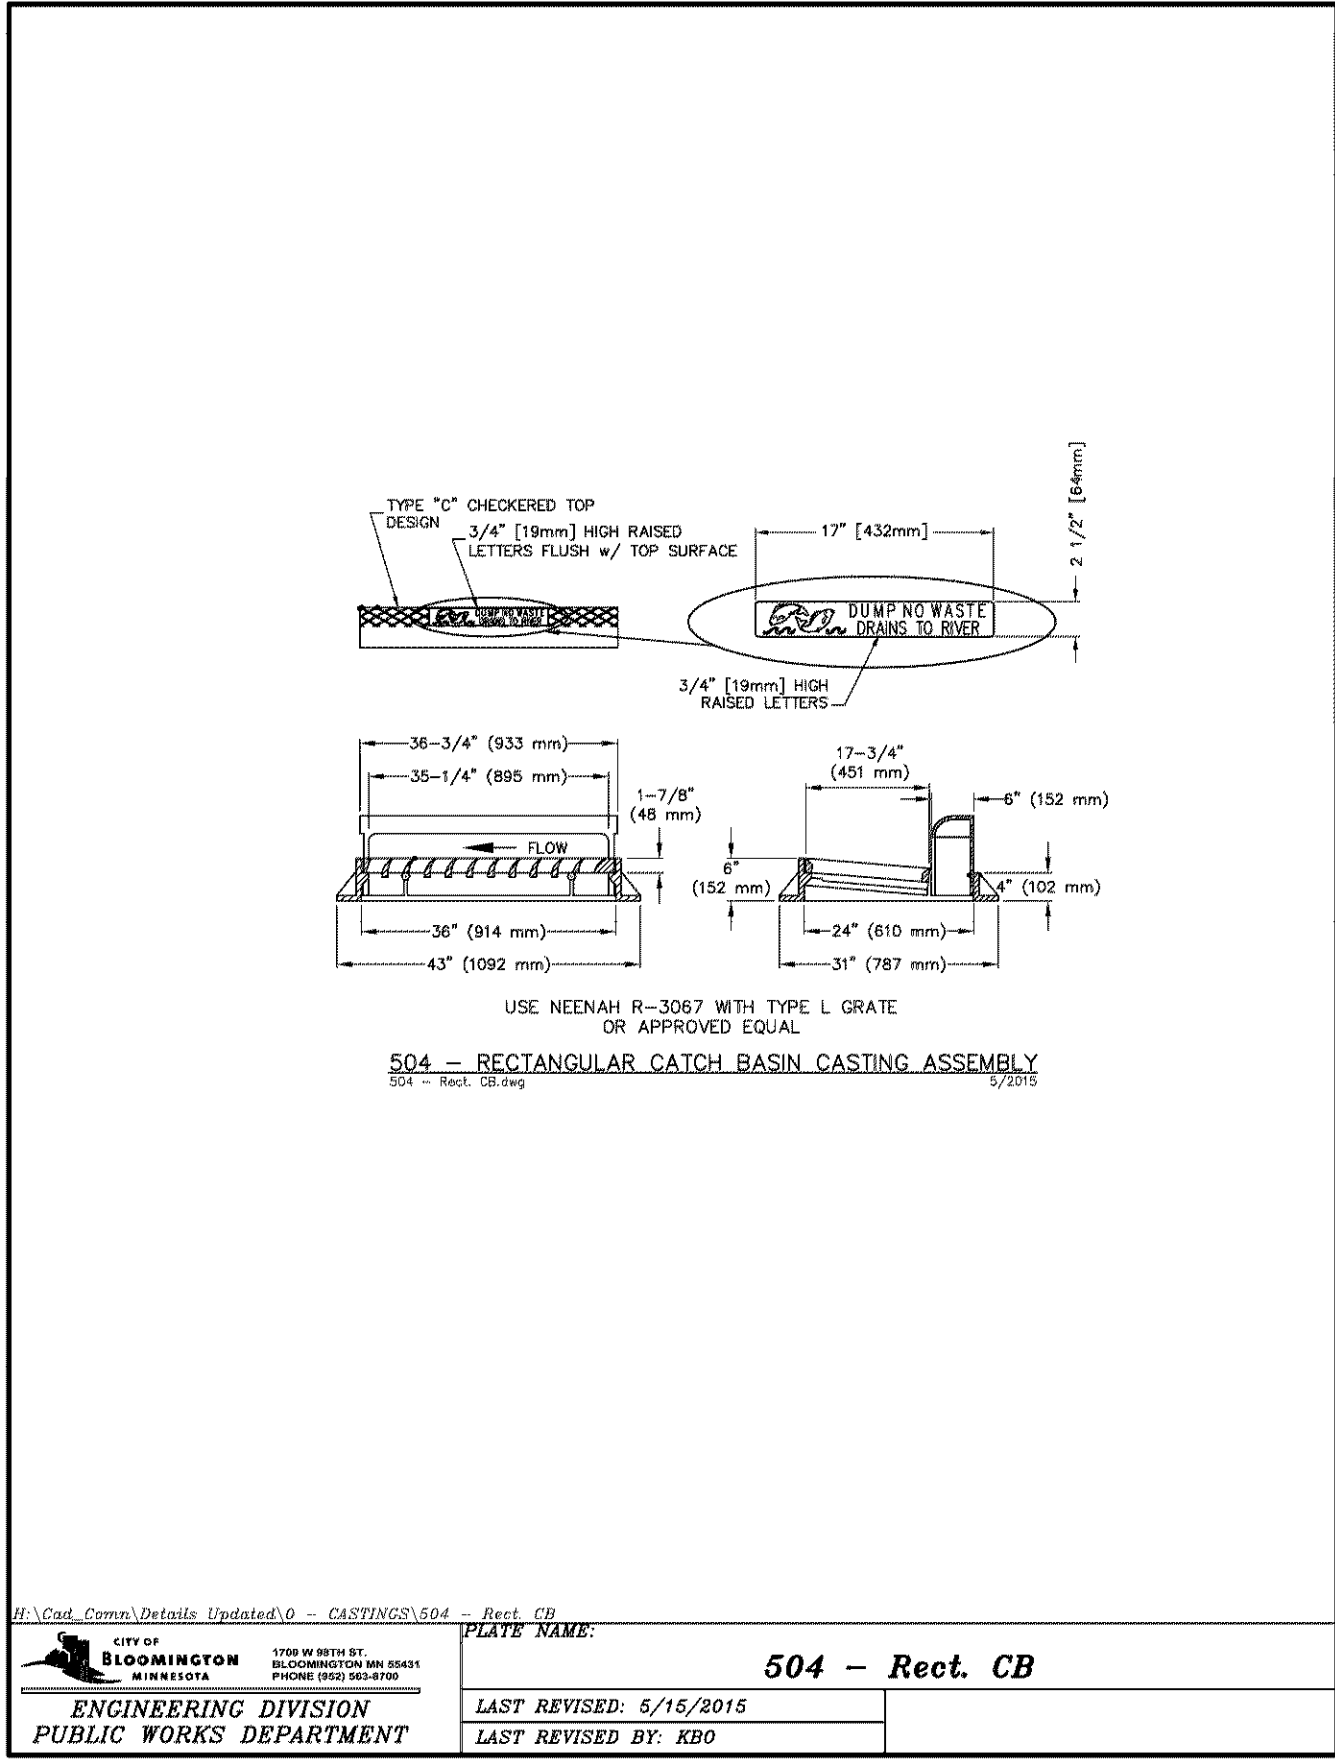


GENERAL NOTES:


1. THE MAXIMUM SLOPE OF THE SIDE FLARE FOR TYPE B RAMPS SHALL BE 1:10; HOWEVER, IF THE WIDTH OF THE LANDING AREA BETWEEN THE TOP OF THE RAMP AND AN OBSTRUCTION IS LESS THAN 1.2m (4'-0") THEN THE MAXIMUM SLOPE SHALL BE 1:12.
2. ALL SLOPE RATIOS ARE EXPRESSED AS UNITS OF VERTICAL DISPLACEMENT TO UNITS OF HORIZONTAL DISPLACEMENT (V:H).
3. ALL DIMENSIONS ARE IN INCHES UNLESS OTHERWISE SHOWN.
4. RAMP DETAILS TO BE COORDINATED PER VILLAGE REQUIREMENTS.
5. DETECTABLE WARNINGS SHALL CONSIST OF TRUNCATED DOMES WHICH CONTRAST VISUALLY WITH ADJOINING SURFACES, EITHER LIGHT-ON-DARK OR DARK-ON-LIGHT.
6. CONTRACTOR TO SELECT ADA DETECTABLE WARNING PERMEABLE PAVERS OR CONCRETE WITH ADA DETECTABLE WARNING DOMES FOR RAMPS.

LEGEND


- SIDEWALK
- RAMP
- DETECTABLE WARNINGS
- NON WALKING AREA
- FACE OF BUILDING

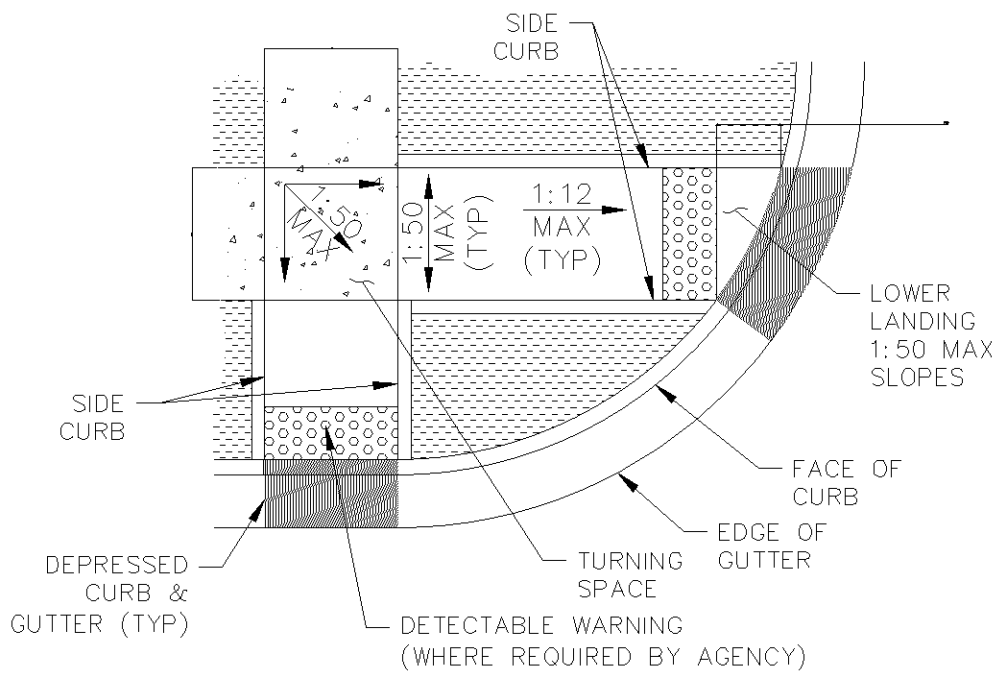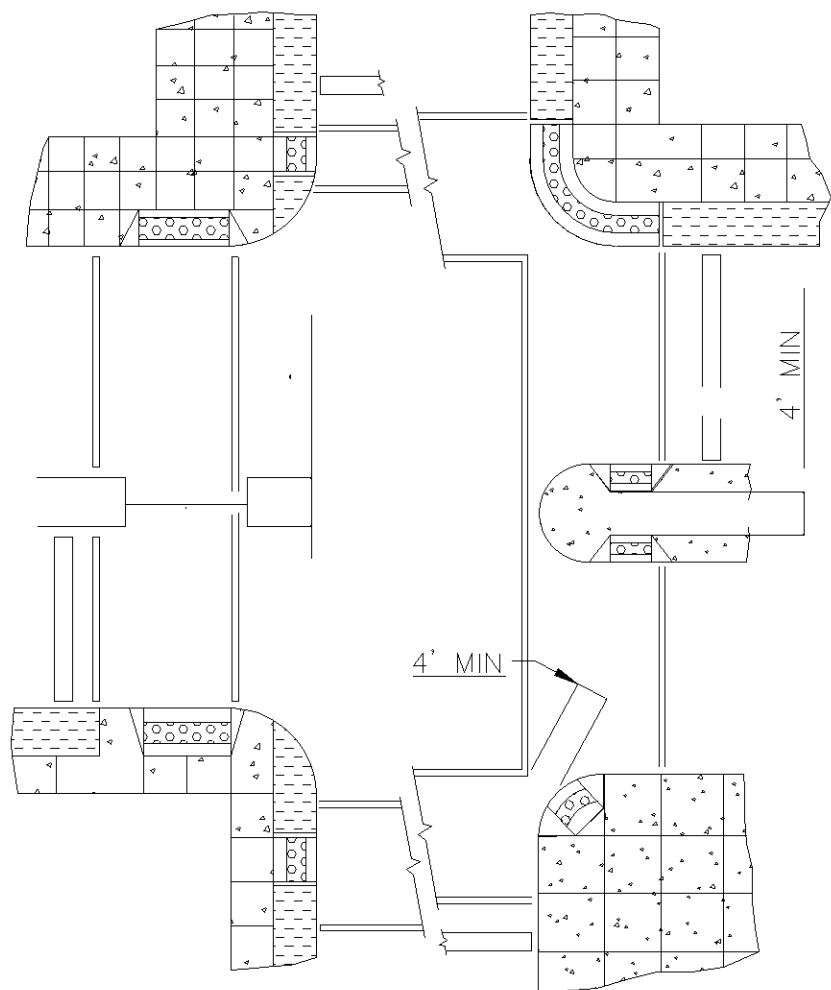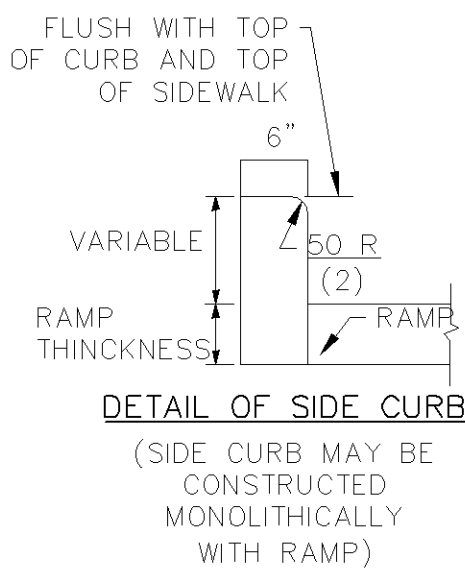


RAMPS IN LANDSCAPED AREA (SETBACK < 5')

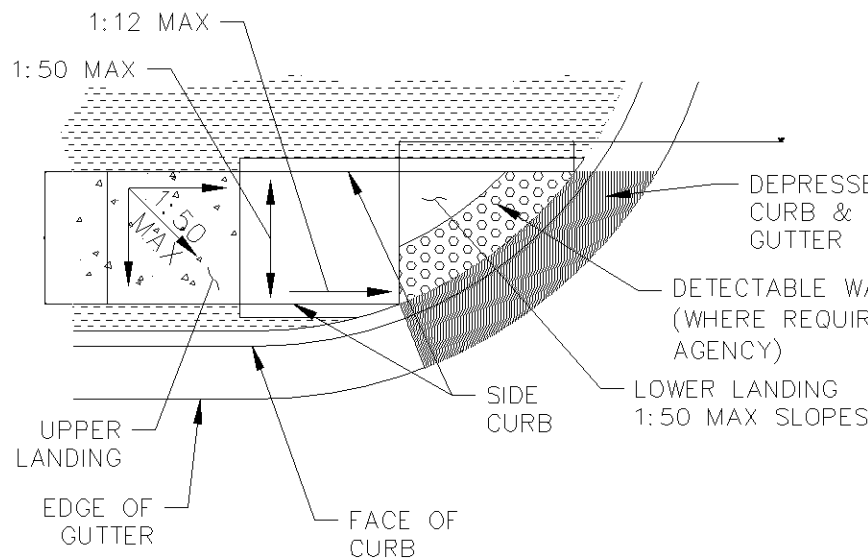


RAMPS IN LANDSCAPED AREA (SETBACK > 5')

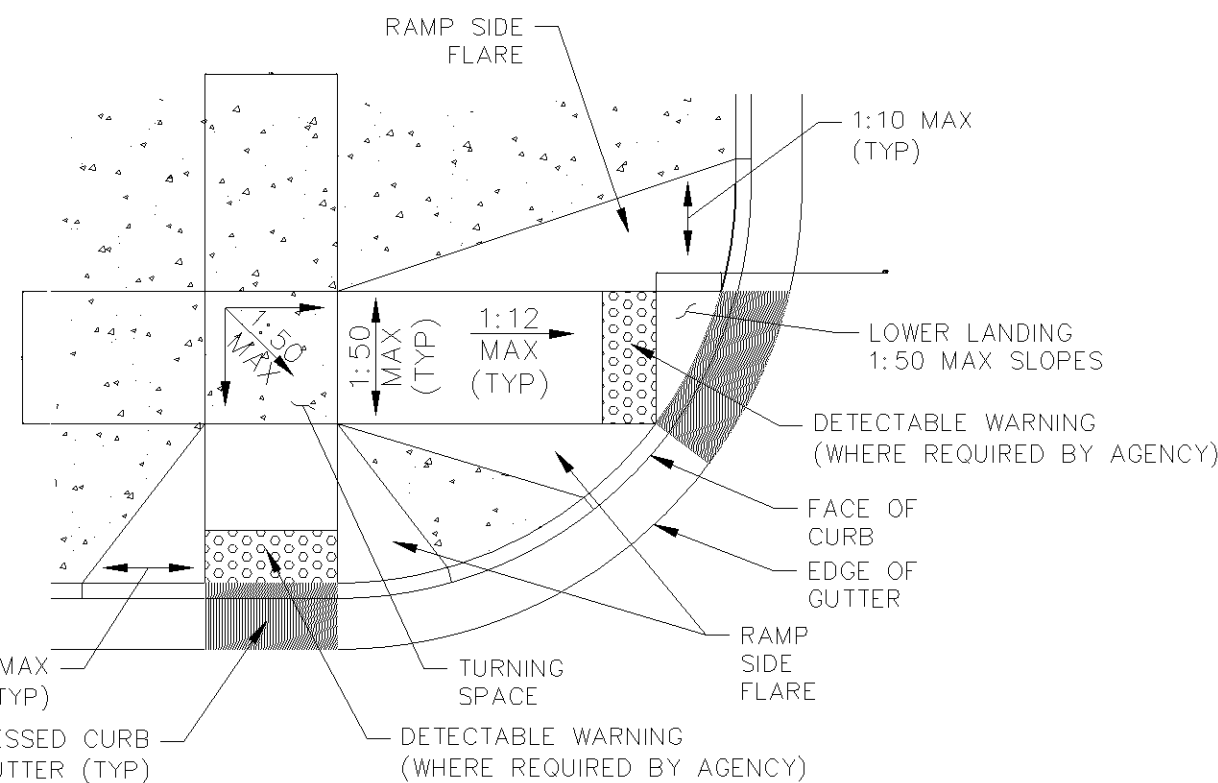


RAMPS IN PAVED AREA (SETBACK < 5')

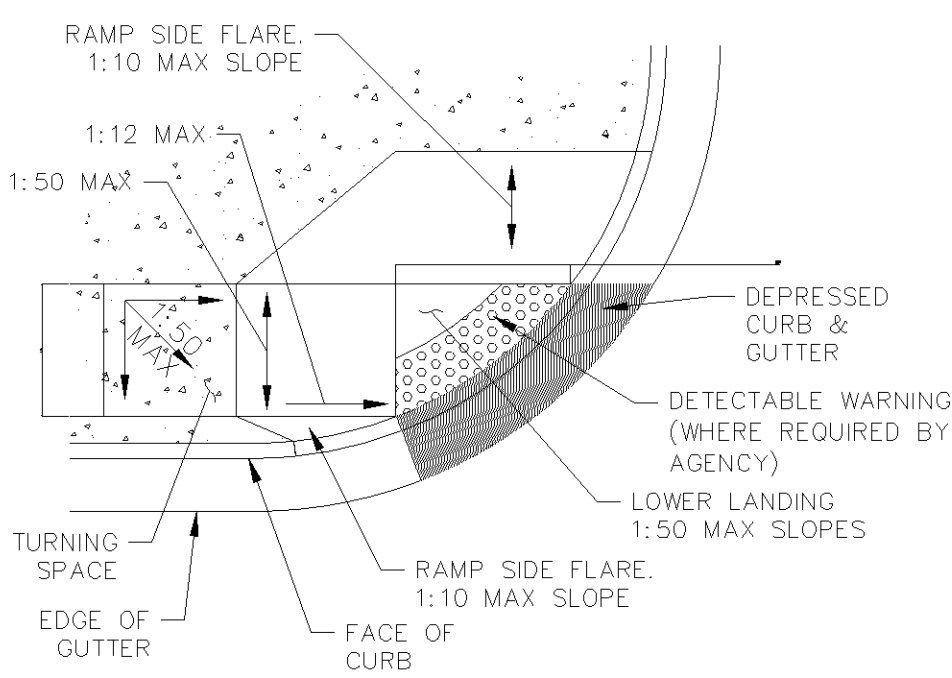


RAMPS IN PAVED AREA (SETBACK > 5')

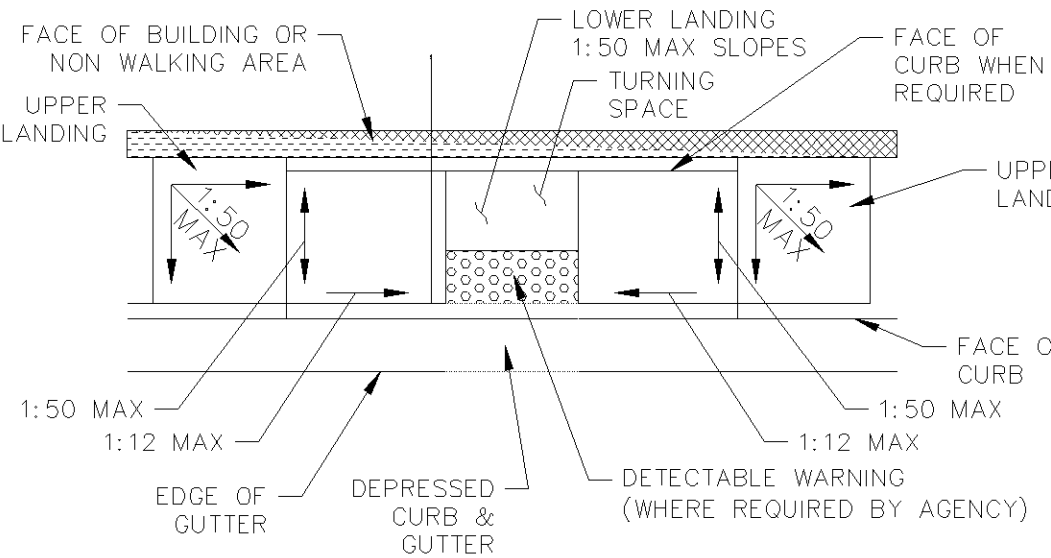


PARALLEL MID-BLOCK CURB RAMP

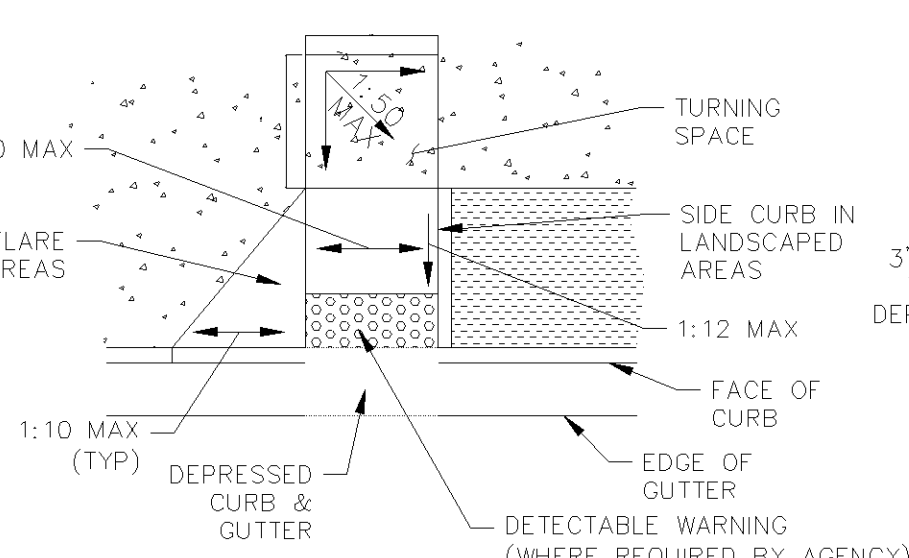

PERPENDICULAR MID-BLOCK CURB RAMP

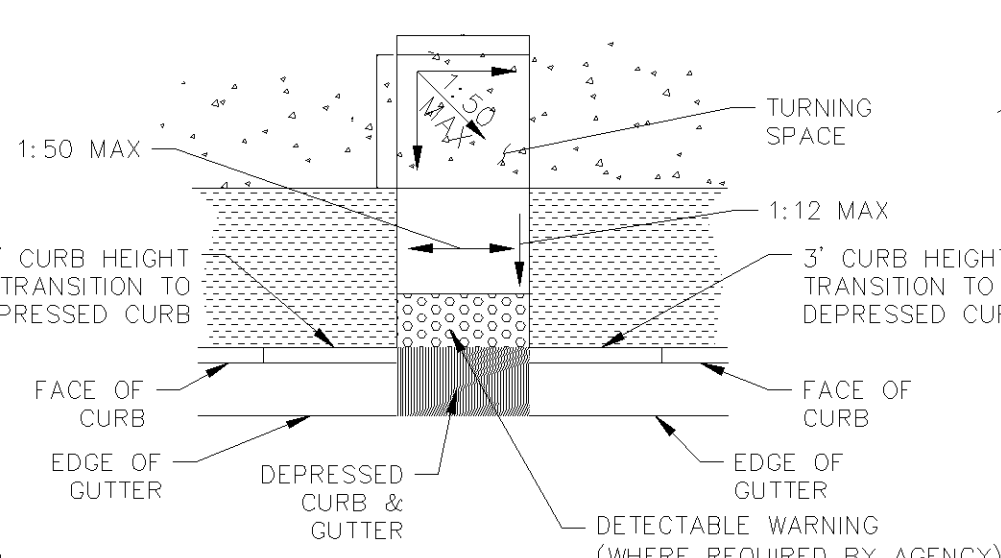

PERPENDICULAR MID-BLOCK CURB RAMP (OPTION 2)

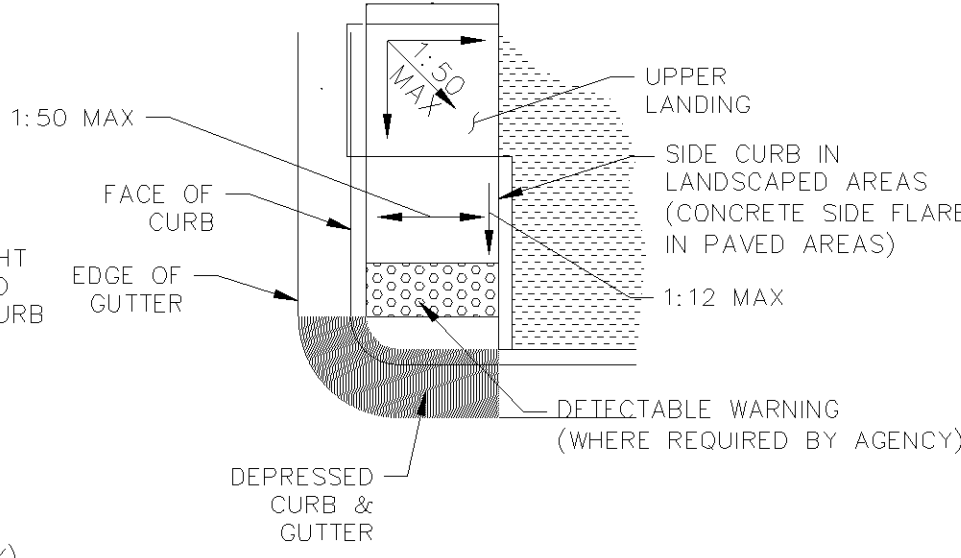

RAMPS ADJACENT TO PAVEMENT

SIDEWALK AND SIDEWALK RAMPS

N.T.S.

PRELIMINARY - NOT FOR CONSTRUCTION

BLOOMINGTON WEST
REDEVELOPMENT
PREPARED FOR
UNITED
PROPERTIES
BLOOMINGTON MN

CONSTRUCTION
DETAILS

KHA PROJECT
1605760022
DATE
12/01/2021
SCALE
AS SHOWN
DESIGNED BY
EIS
DRAWN BY
EIS
CHECKED BY
TJL

FOR REFERENCE ONLY


TOMLINSON, P.E.
DATE
XX-XX-XXXX
LIC. NO.
XXXXXX

DEVELOPMENT APPLICATION	REVISIONS	DATE	BY
12/01/2021	EIS		



Kimley»Horn

2021 KIMLEY-HORN AND ASSOCIATES, INC.
767 EUSTIS STREET, SUITE 100, ST. PAUL, MN 55114
PHONE: 651-445-4187
WWW.KIMLEY-HORN.COM



CASE #PL2021-251

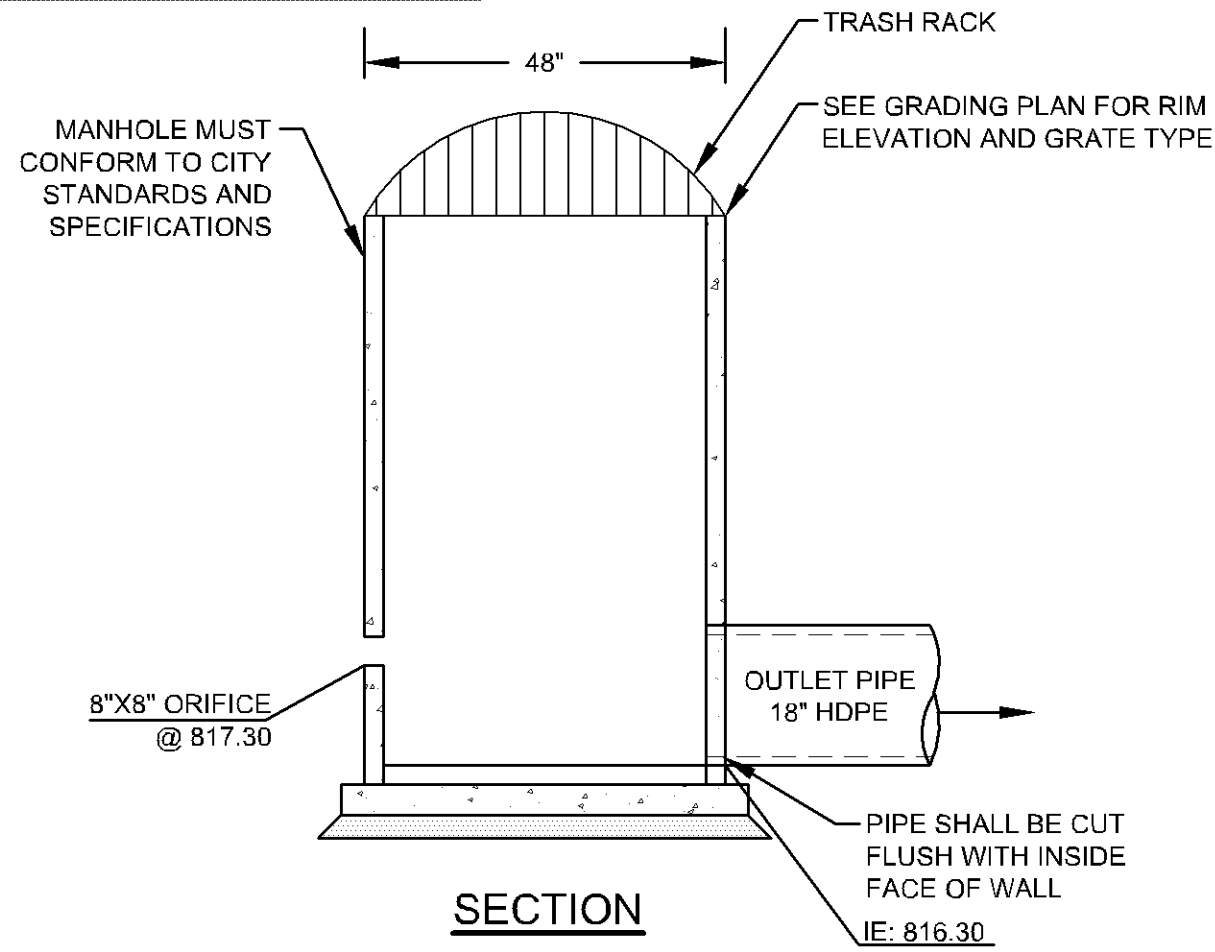



OUTLET CONTROL STRUCTURE
OCS #1
N.T.S.

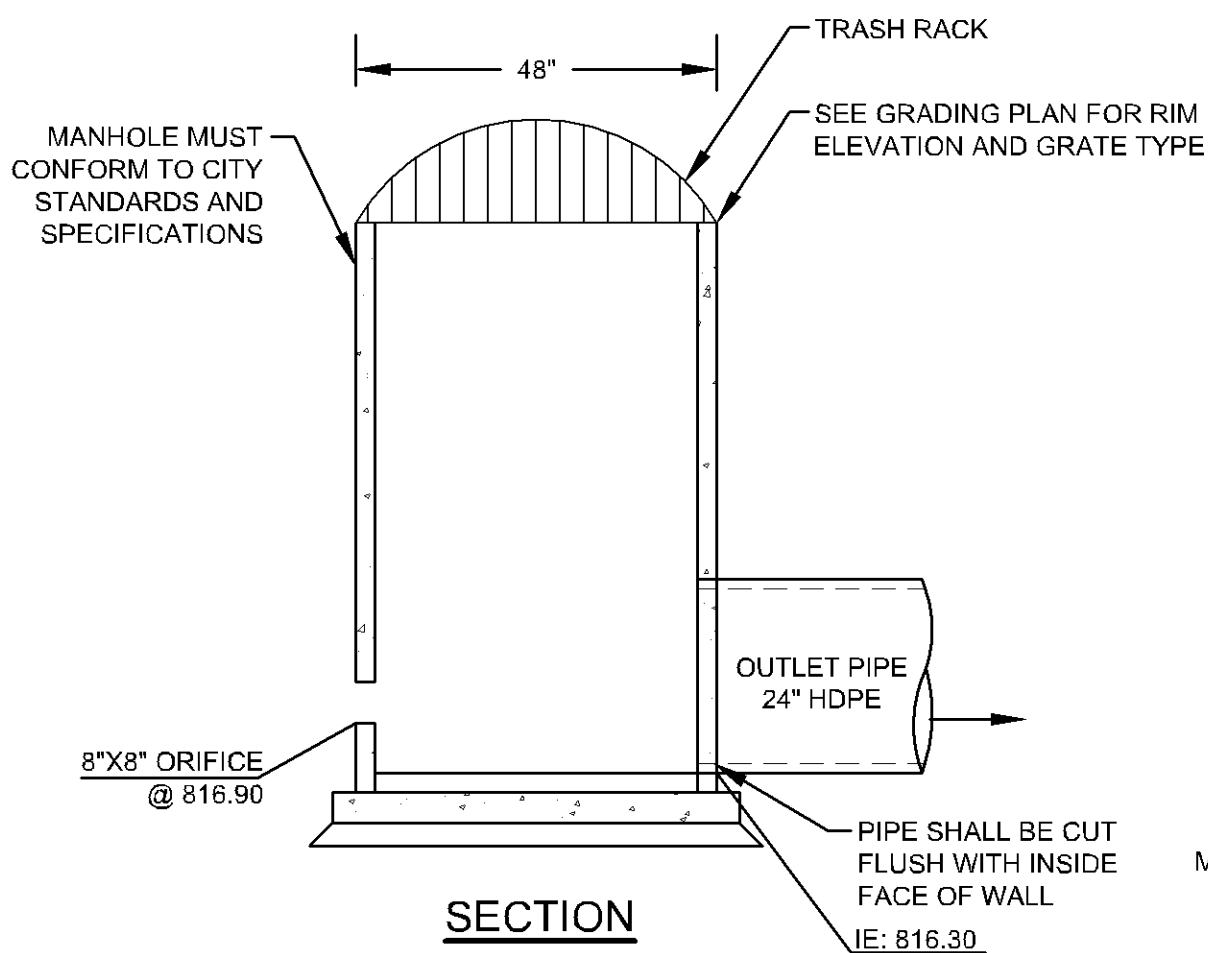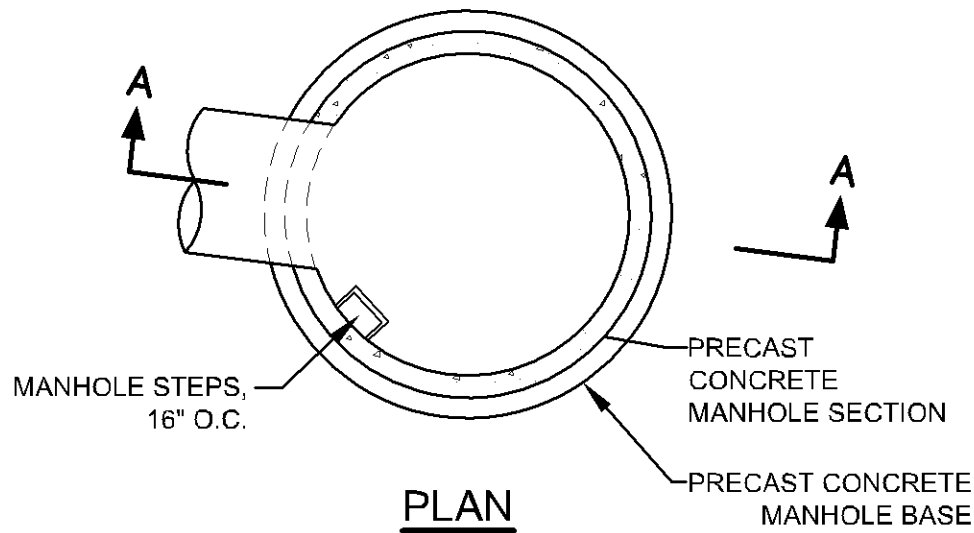


OUTLET CONTROL STRUCTURE
OCS #2
N.T.S.

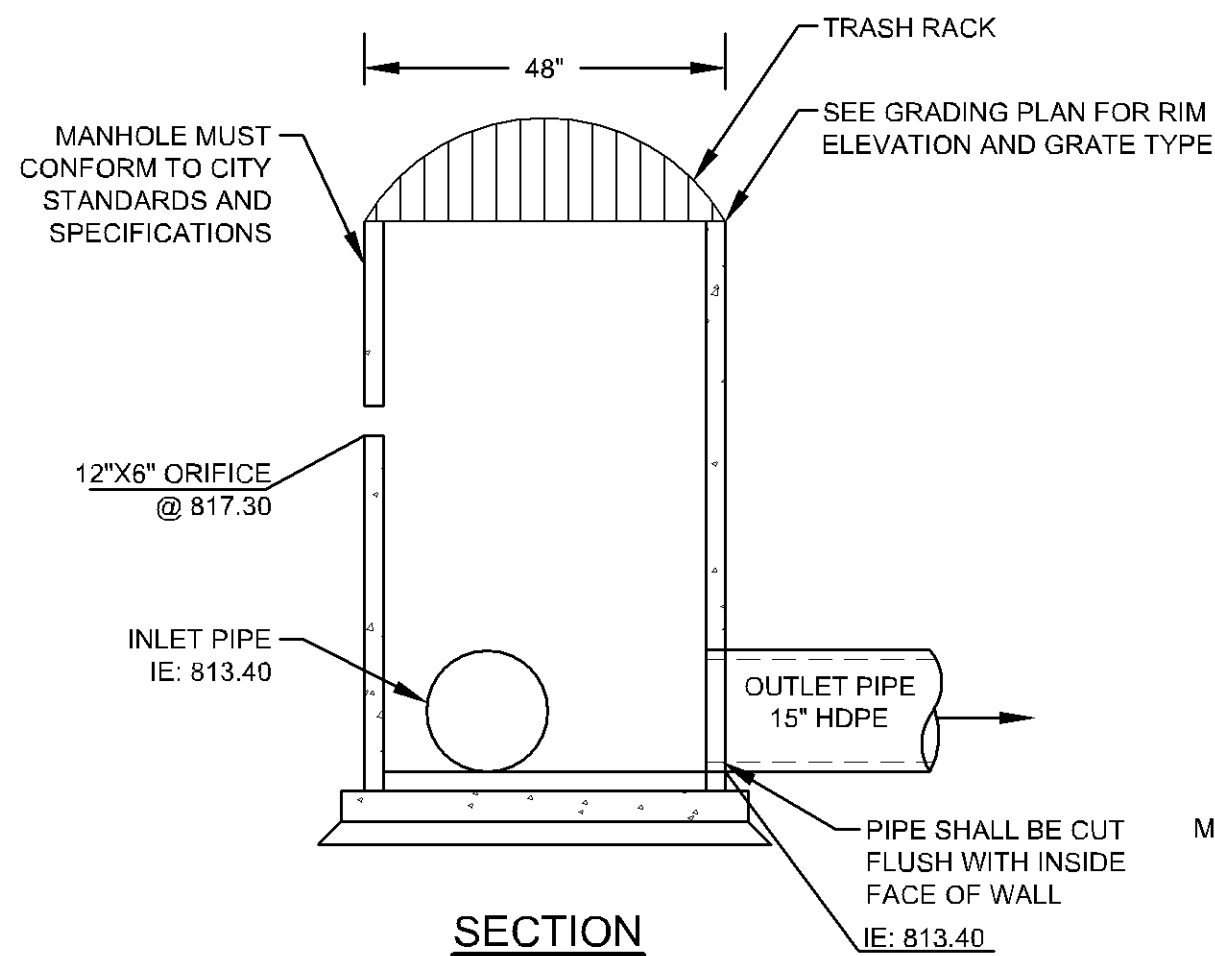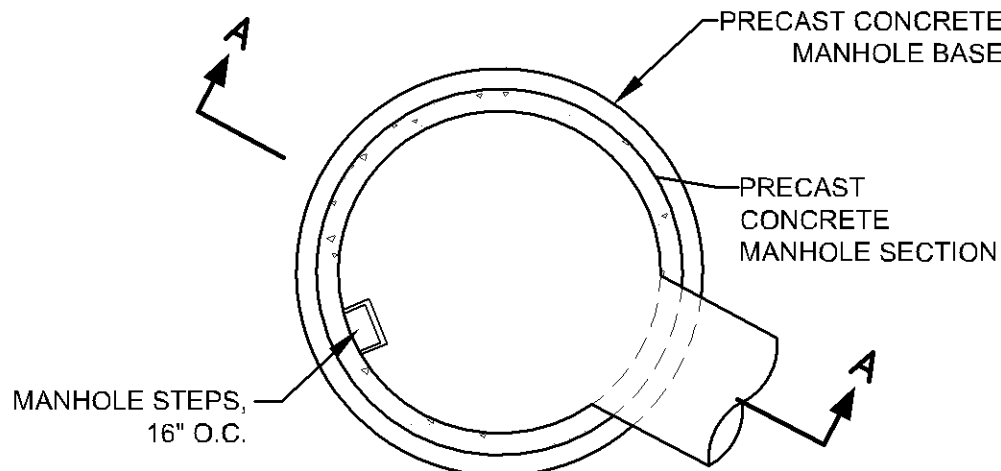

OUTLET CONTROL STRUCTURE
OCS #3
N.T.S.

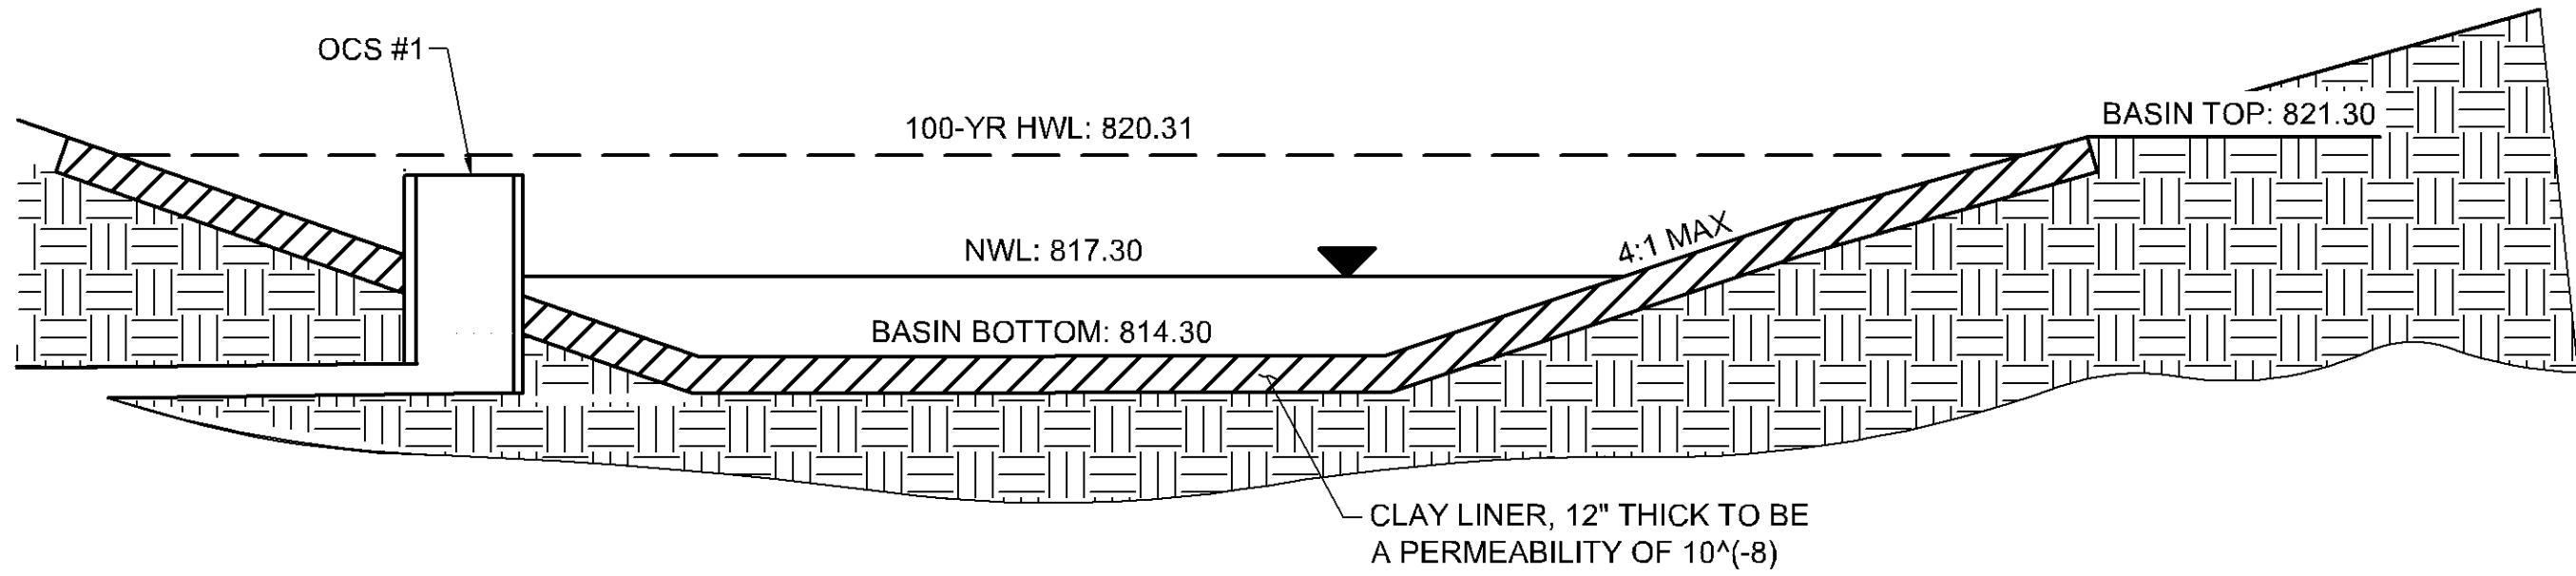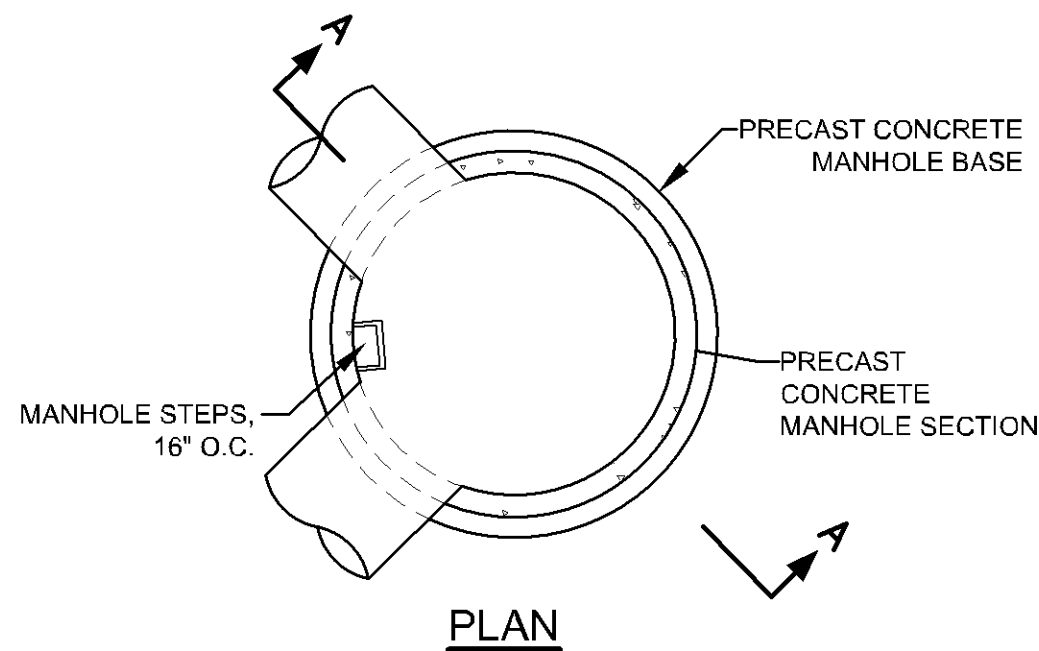

BMP #1 RETENTION BASIN
TYPICAL SECTION
N.T.S.

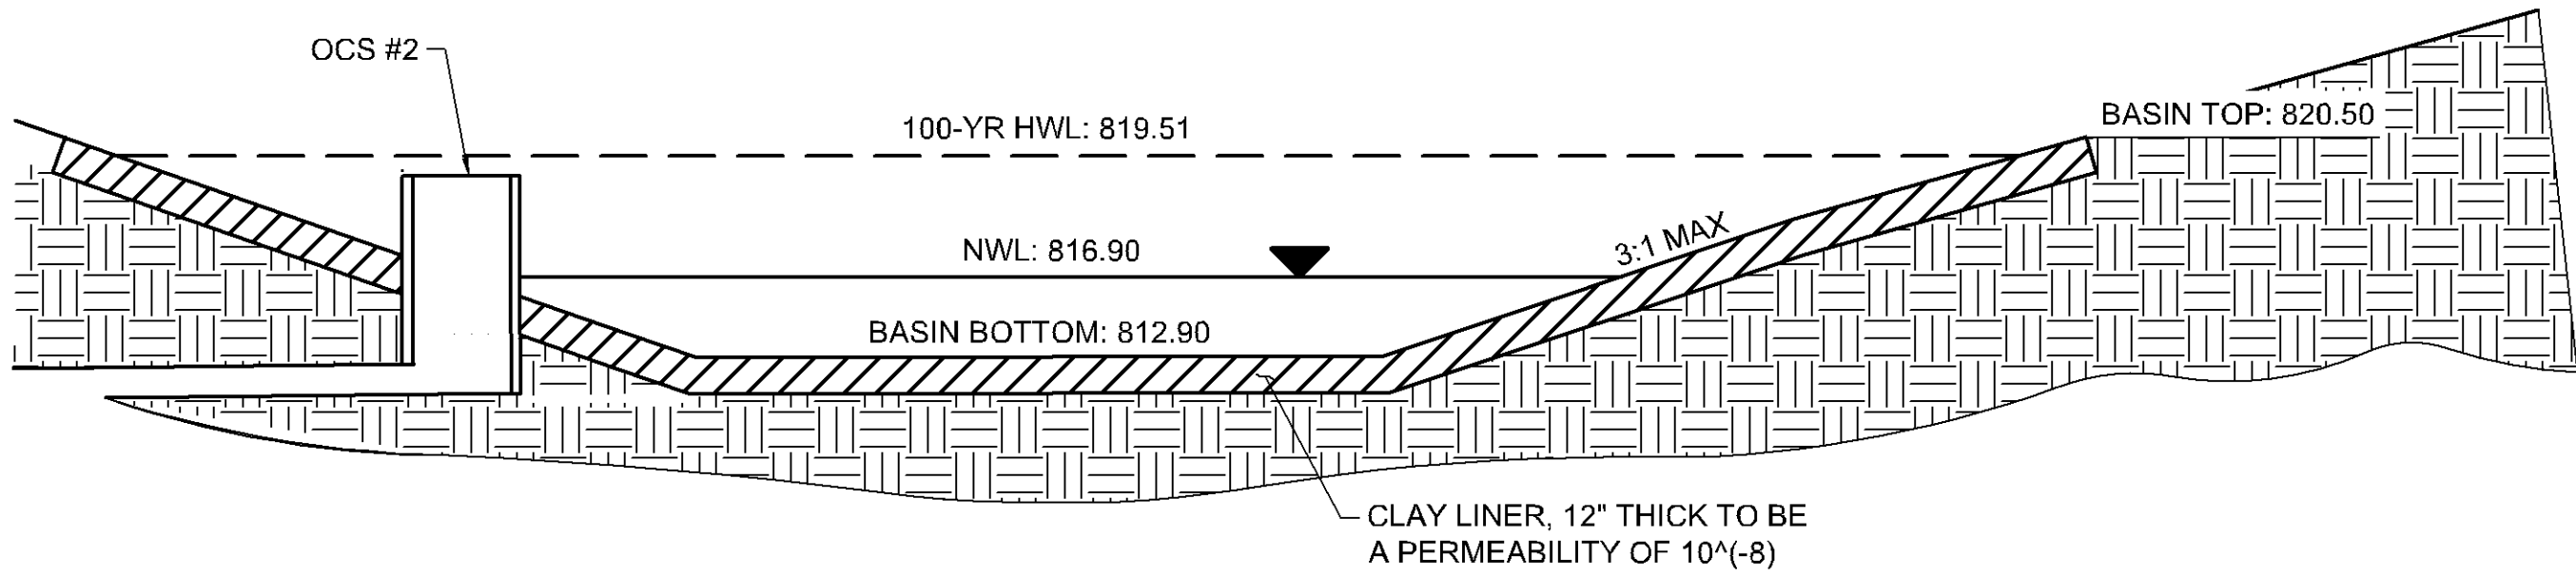

BMP #2 RETENTION BASIN
TYPICAL SECTION
N.T.S.

PRELIMINARY - NOT FOR CONSTRUCTION

BLOOMINGTON WEST
REDEVELOPMENT
PREPARED FOR
UNITED
PROPERTIES
BLOOMINGTON MN

SHEET NUMBER
C704

CONSTRUCTION
DETAILS

KHA PROJECT	160576022
DATE	12/01/2021
SCALE	AS SHOWN
DESIGNED BY	EIS
DRAWN BY	EIS
CHECKED BY	TJL

DESIGNED BY	EIS
DRAWN BY	EIS
CHECKED BY	TJL

I HEREBY CERTIFY THAT THIS PLAN, SPECIFICATION OR REPORT WAS PREPARED BY ME OR UNDER MY DIRECT SUPERVISION AND THAT I AM A DULY LICENSED PROFESSIONAL ENGINEER UNDER THE LAWS OF THE STATE OF MINNESOTA.

TOM LINCOLN, P.E.
MN LIC. NO. XXXX
DATE: XXX-XX-XXXX

Kimley»Horn
2021 KIMLEY-HORN AND ASSOCIATES, INC.
767 EUSTIS STREET, SUITE 100, ST. PAUL, MN 55114
PHONE: 651-945-4187
WWW.KIMLEY-HORN.COM

REVISIONS	DATE	BY
1	12/01/2021	EIS