


SR - 700 American Boulevard
SCHEMATIC DESIGN | LAND USE APPLICATION

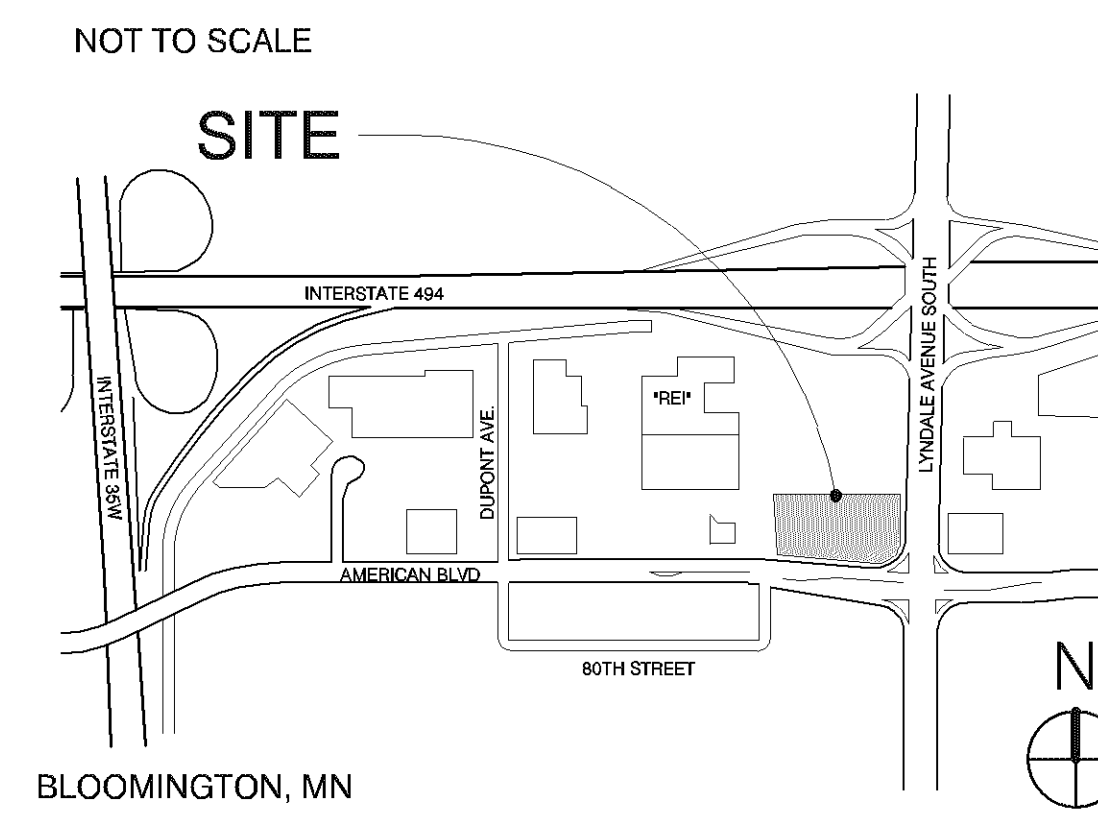

VICINITY MAP



BUILDING GROSS AREA SUMMARY

	GROSS AREA
LEVEL 5	27,086 SF
LEVEL 4	27,086 SF
LEVEL 3	27,086 SF
LEVEL 2	27,086 SF
LEVEL 1 - RESIDENTIAL	25,135 SF
LEVEL 1 - RETAIL	1,600 SF
SUBTOTAL	42,856 SF
GRAND TOTAL	177,913 SF

PARKING STALLS

STALL TYPE	SUBLEVEL ENCLOSED	SURFACE	TOTAL PARKING
ACCESSIBLE PARKING STALL	4	4	8
COMPACT PARKING STALL	25	5	30
STANDARD PARKING STALL	89	38	127
GRAND TOTAL	118	47	165

GENERAL NOTES

- DO NOT SCALE DRAWINGS.
- SUBCONTRACTORS SHALL VISIT THE JOB SITE AND SHALL REVIEW THE CONTRACT DOCUMENTS TO FAMILIARIZE THEMSELVES WITH THE REQUIREMENTS AND INTENT OF THE SCOPE OF THE WORK PRIOR COMMENCEMENT OF WORK. DISCREPANCIES SHALL BE REPORTED TO GENERAL CONTRACTOR FOR CLARIFICATION.
- PROJECT CODE NARRATIVE**
700 AMERICAN BOULEVARD IS PROPOSED TO BE A 5-STORY MIXED USE PROJECT THAT INCLUDES AFFORDABLE SENIOR LIVING APARTMENT PROJECT (1128 UNIT, 55+ INDEPENDENT LIVING, GROUP R2 OCCUPANCY w/ AMENITIES) AND A 1,500sq FT RETAIL TENANT (GROUP M). THE BUILDING WILL CONSIST OF A TYPE I SUBLEVEL PARKING GARAGE AND (3) STORIES OF TYPE II WOOD-FRAMED CONSTRUCTION ABOVE. CONCRETE CONSTRUCTION ABOVE LEVEL 1 AT THE RETAIL AND AMENITY SPACES IS TO BE CONSIDERED TYPE II AND IS NOT REQUIRED FOR SEPARATIONS. HEIGHT INCREASES OR AREA INCREASES.


UNIT COUNT

UNIT TYPE	Nr. SF	LEVEL 1	LEVEL 2	LEVEL 3	LEVEL 4	LEVEL 5	TOTALS
1BR UNIT	37,103 SF	9	12	13	12	12	58
1BR UNIT - TYPE A	2,562 SF	2	1	0	1	0	4
1BR-D UNIT	2,911 SF	0	1	1	1	1	4
2BR UNIT	46,339 SF	7	10	10	11	12	50
2BR UNIT - TYPE A	2,786 SF	1	1	1	0	0	3
2BR-D UNIT	4,652 SF	0	1	1	1	1	4
3BR UNIT	5,394 SF	1	1	1	1	1	5
GRAND TOTAL	102,258 SF	20	27	27	27	27	128

LAND USE | SCHEMATIC DESIGN SHEET INDEX

- 9001 - TITLE SHEET
- SURVEY**
- C100.0 - SELECTIVE SITE DEMOLITION AND EROSION CONTROL PLAN
 - C200.0 - GRADING, DRAINAGE, AND EROSION CONTROL PLAN
 - C300.0 - UTILITY PLAN
 - C400.0 - PAVING AND GEOMETRIC PLAN
 - C500.0 - CIVIL DETAILS
 - C500.1 - CIVIL DETAILS
 - C500.2 - CIVIL DETAILS
 - C800.0 - STORM WATER POLLUTION PREVENTION PLAN
- L010 - LANDSCAPE SCHEDULES & NOTES**
- L110 - HARDSCAPE PLAN
 - L140 - LANDSCAPE PLAN
 - L500 - LANDSCAPE DETAILS
- AL101 - ARCHITECTURAL LANDSCAPE PLAN**
- A101.0 - SUBLEVEL PLAN - OVERALL
 - A101.0 - LEVEL 1 PLAN - OVERALL
 - A102.0 - LEVEL 2, 3, 4 & 5 PLAN - OVERALL
- A301 - BUILDING ELEVATIONS**
- A302 - BUILDING ELEVATIONS
- A356 - BUILDING PERSPECTIVE VIEWS**

SYMBOL INDEX

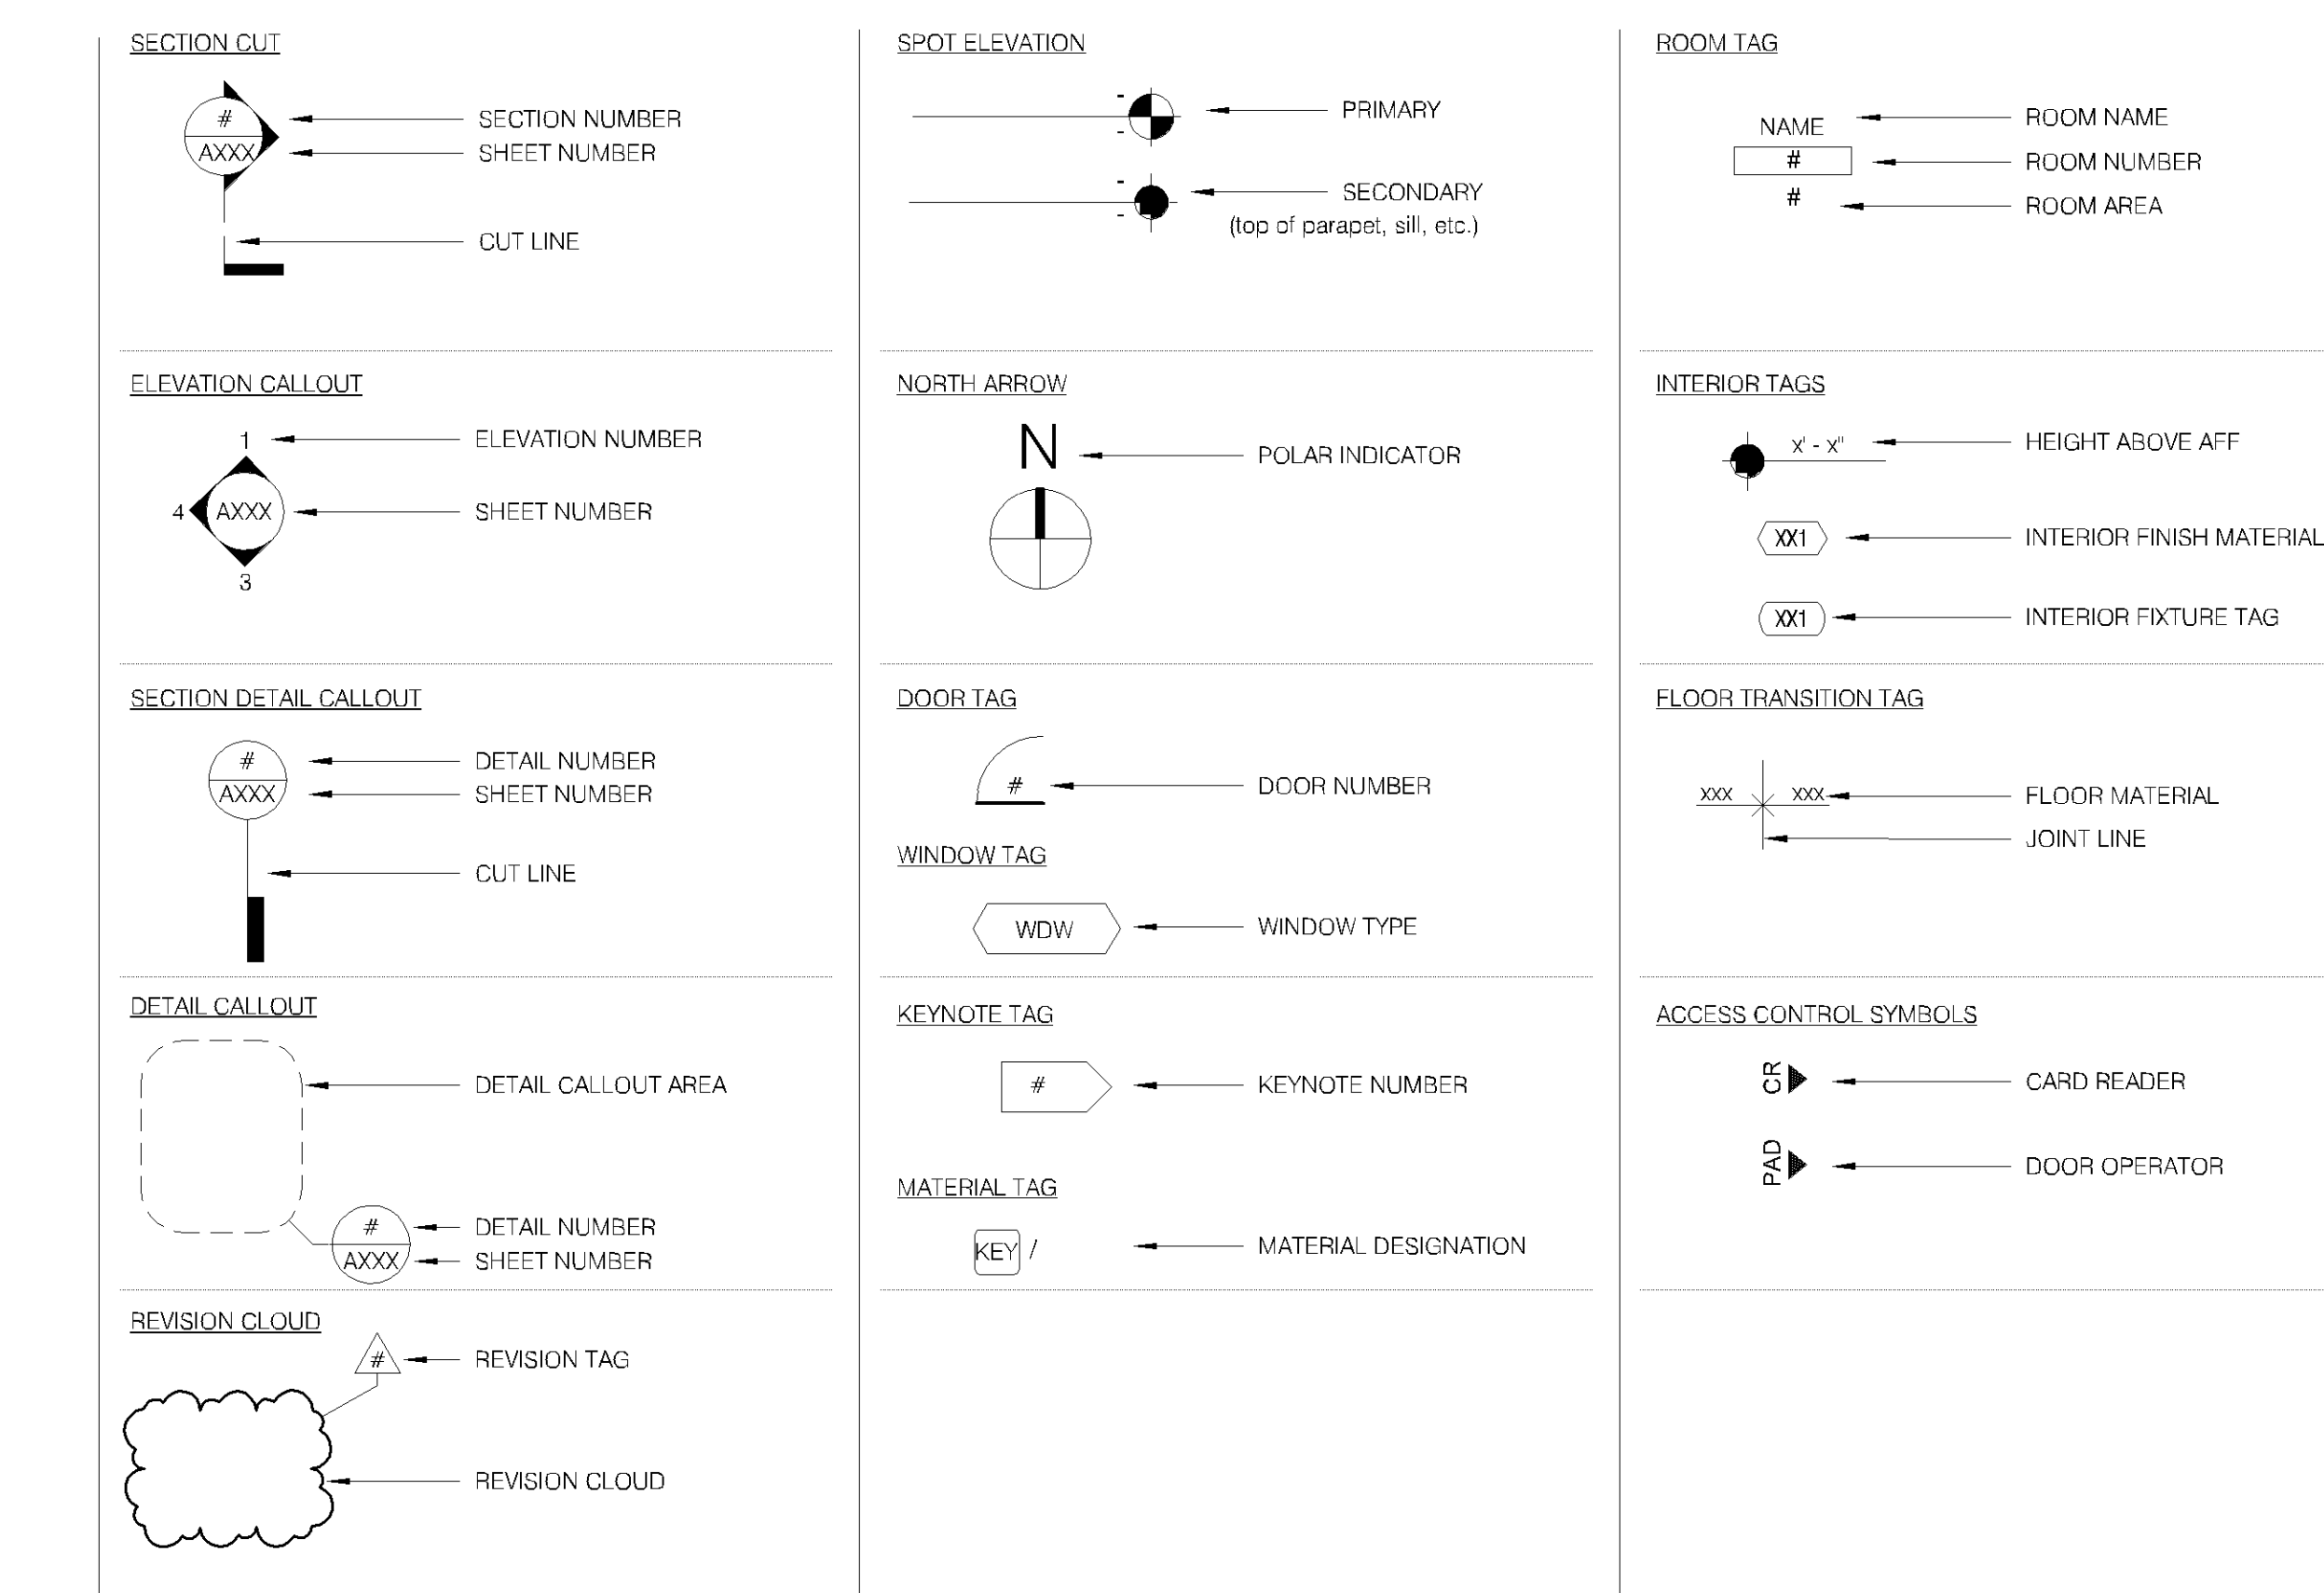

CONTACTS

DEVELOPER/CLIENT	ARCHITECT	CIVIL ENGINEER	LANDSCAPE ARCHITECT	STRUCTURAL ENGINEER
NAME: SHAFER RICHARDSON CONTACT: ACACIA GALLE KATIE ANTHONY ADDRESS: 900 NORTH 3RD ST MINNEAPOLIS, MN 55401 PHONE No: 612-359-0845 EMAIL: AGALLE@SR-RE.COM KANTHONY@SR-RE.COM	NAME: URBANWORKS ARCHITECTURE CONTACT: DEVON LUNDY SIDNEY ANGELL ADDRESS: 901 NORTH 3RD ST, STE #145 MINNEAPOLIS, MN 55401 PHONE No: 612-455-3189 EMAIL: DLUNDY@URBANWORKS.COM SANGELL@URBANWORKS.COM	NAME: BKBM ENGINEERS CONTACT: KEITH MATTE SAM DOLLERSCHIELL ADDRESS: 6120 EARLE BROWN DR, STE 700 MINNEAPOLIS, MN 55430 PHONE No: 763-843-0446 EMAIL: KMATTE@BKBM.COM SDOLLERSCHIELL@BKBM.COM	NAME: DAMON FARBBER CONTACT: JESSE SYMNYKOWICZ BLAKE SLATTE ADDRESS: 310 S. 4TH AVE., STE 2050 MINNEAPOLIS, MN 55415 PHONE No: 612-332-7222 EMAIL: JSYMNKYWICZ@DAMONFARBBER.COM BSLATTE@DAMONFARBBER.COM	NAME: BKBM ENGINEERS CONTACT: JOHN TIMM MARIE DESHARNAIS ADDRESS: 6120 EARLE BROWN DR, STE 700 MINNEAPOLIS, MN 55430 PHONE No: 763-843-0430 EMAIL: JTIMM@BKBM.COM MDESCHARNAIS@BKBM.COM

SR - 700 American
700 W AMERICAN BLVD / BLOOMINGTON, MN

URBANWORKS

© URBANWORKS ARCHITECTURE LLC 2023
901 NORTH THIRD STREET, SUITE 145, MINNEAPOLIS, MN 55401

CONSULTANT

PRELIMINARY
NOT FOR CONSTRUCTION


SCHEMATIC DESIGN
10.11.2023

REVISIONS

DATE: 10/11/2023
PROJECT #: 23-0001
PHASE: SCHEMATIC DESIGN
DRAWN BY: DP/SL
CHECKED BY:

TITLE SHEET

G001

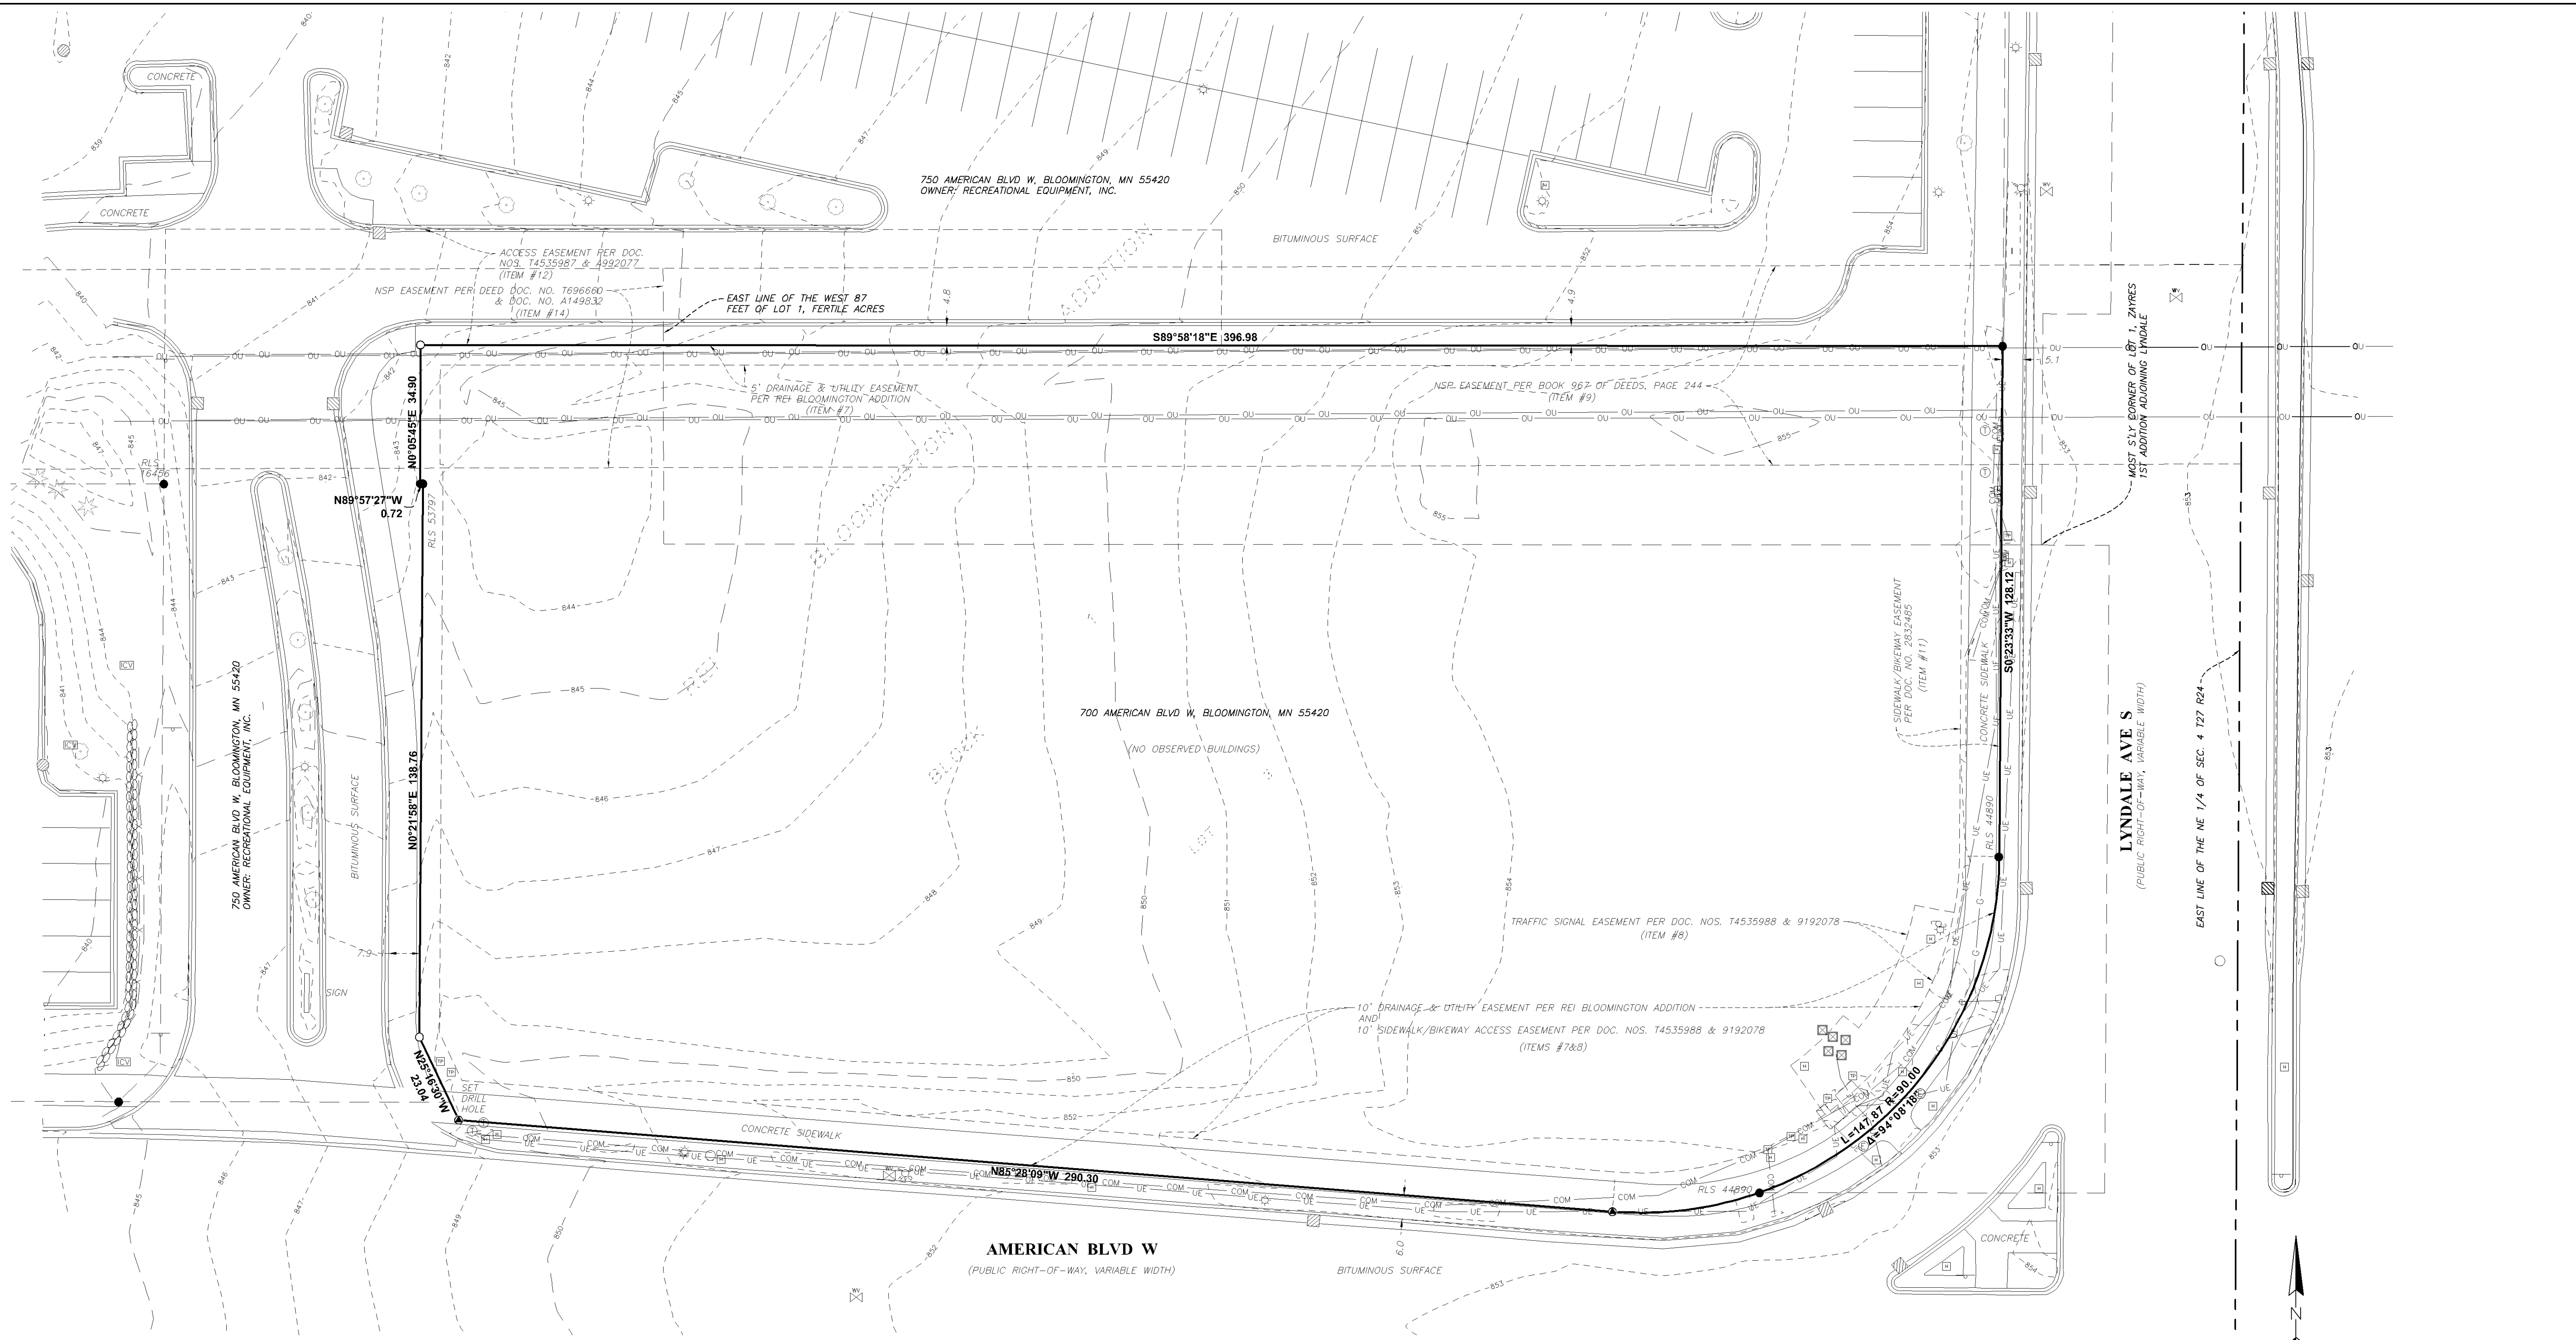


LEGEND

○ SET 1/2" x 14" IRON PIPE WITH PLASTIC CAP 54850	⊠ ELECTRIC METER	— x — x — FENCE LINE
● FOUND "PK" NAIL	⊞ ELECTRIC TRANSFORMER	— >>> — STORM SEWER
● FOUND MONUMENT	⊕ TRAFFIC SIGN	— >>> — SANITARY SEWER
⊙ SANITARY SEWER MANHOLE	⊙ BOLLARD/POST	— — — WATERMAIN
⊙ STORM SEWER MANHOLE	⊕ UTILITY POLE	— G — G — UNDERGROUND GAS LINE
⊙ STORM SEWER INLET	⊕ ANCHOR CABLE	— COM — COM — UNDERGROUND COMMUNICATION LINE
⊙ STORM SEWER INLET	⊕ LIGHT POLE	— OU — OU — OVERHEAD UTILITY LINE
⊙ HYDRANT	⊕ HANDICAP PARKING SPACE	— UE — UE — TREE LINE
⊙ AUTO SPRINKLER	⊕ STOP LIGHT	— UE — UE — UNDERGROUND ELECTRIC
⊙ GAS METER	⊕ HAND HOLE	▭ BUILDING
⊙ COMMUNICATIONS PEDESTAL	⊕ IRRIGATION CONTROL VALVE	
⊙ ELECTRIC MANHOLE	⊕ DECIDUOUS TREE	
⊙ TELEPHONE MANHOLE	⊕ CONIFEROUS TREE	
⊙ DECORATIVE LIGHT		
⊙ WATER VALVE		


GENERAL NOTES

- Bearings shown hereon are based on the Hennepin County Coordinate System relative to the NAD83(11) control adjustment.
- Elevations and contours shown hereon were established with GPS and are relative to the NAVD88 vertical datum.

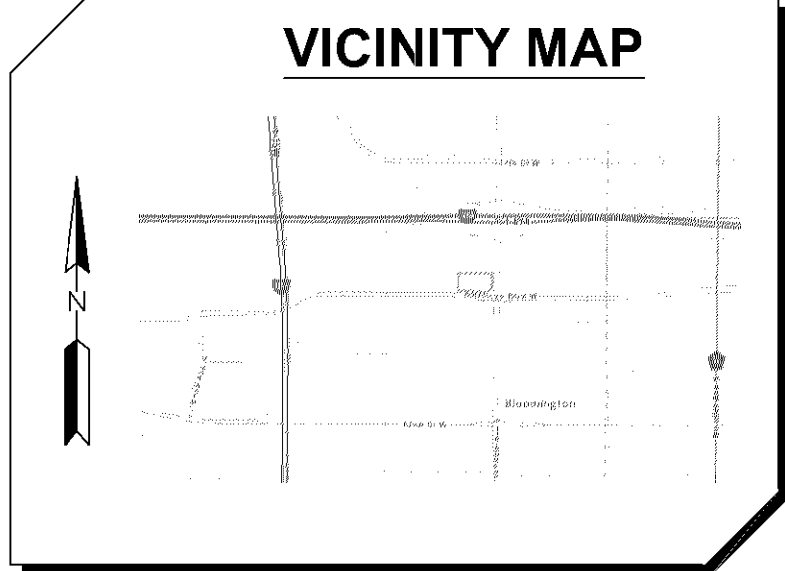


PL202300178

	CLIENT NAME	PROJECT TITLE			
	SCHAFER RICHARDSON, INC.	ALTA/NSPS LAND TITLE SURVEY			
		DWN BY	CHK'D	APP'D	DWG DATE
	KAD	SFH	SFH	SCALE	SEE SCALE BAR
	PROJECT NO.	SHEET NO.			
	193806056	2 OF 2			

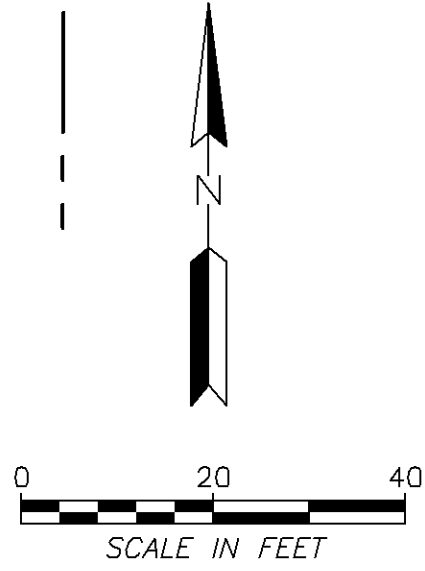

PL202300178

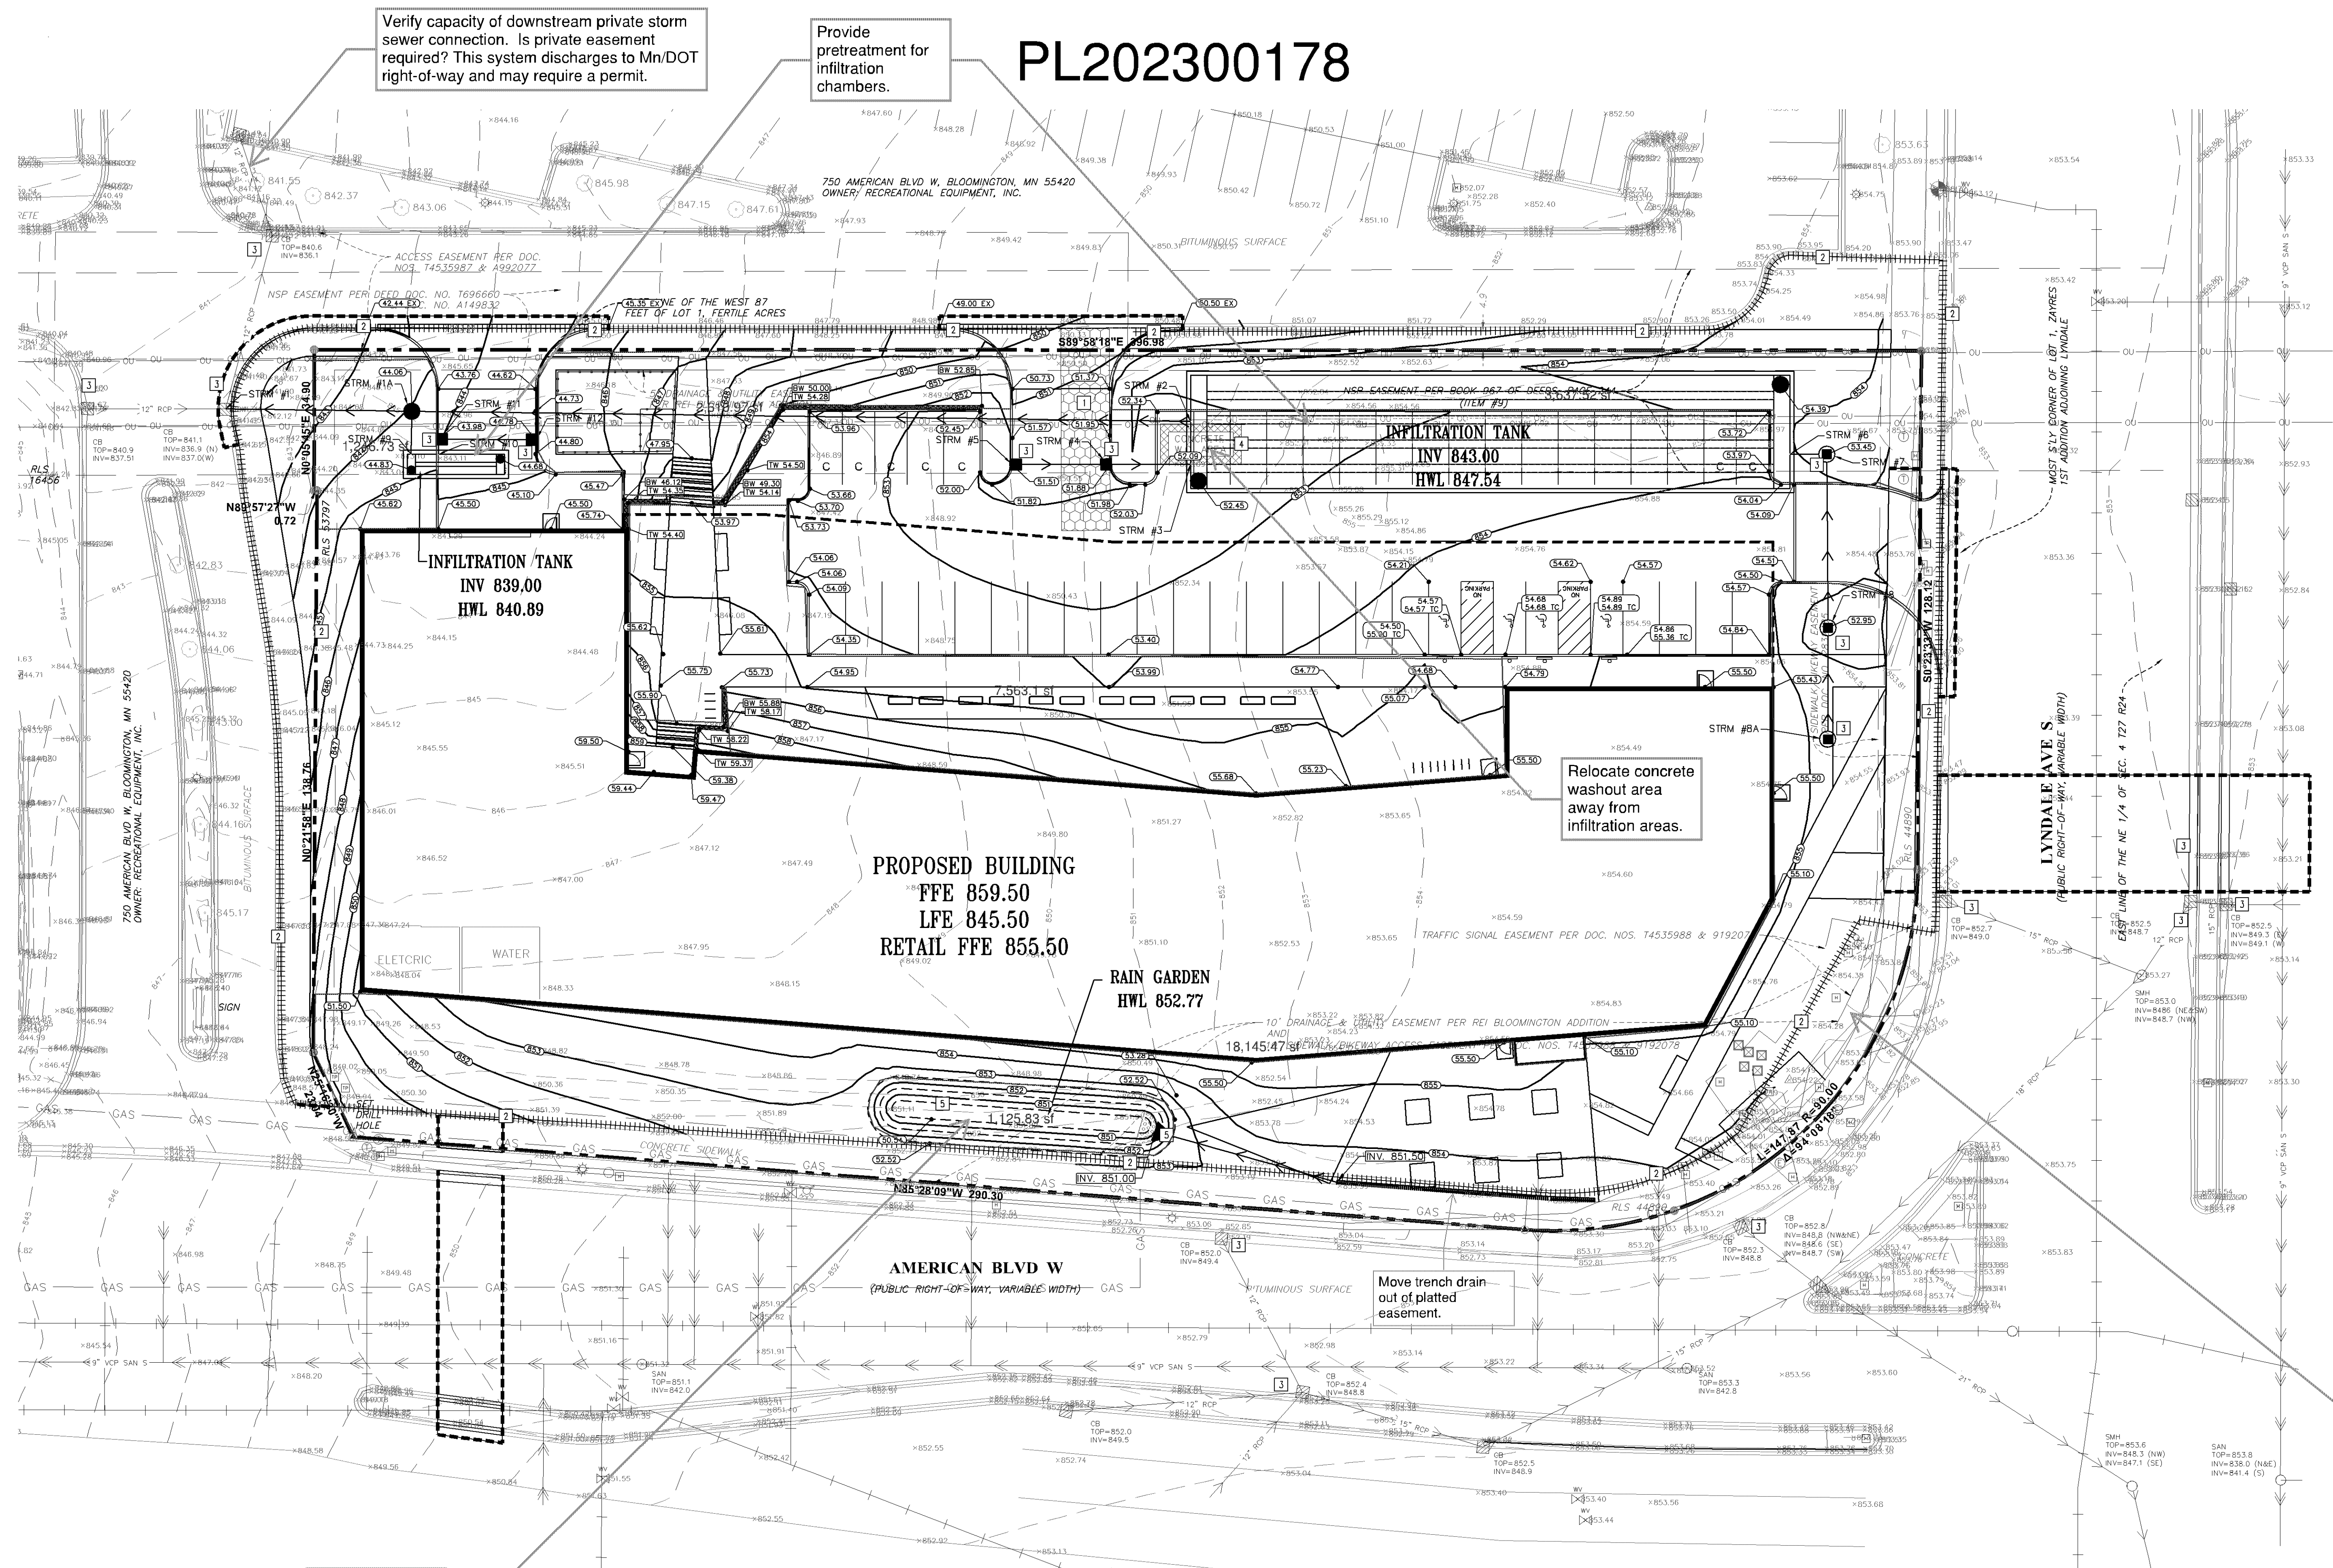

Verify capacity of downstream private storm sewer connection. Is private easement required? This system discharges to Mn/DOT right-of-way and may require a permit.

Provide pretreatment for infiltration chambers.

Relocate concrete washout area away from infiltration areas.

Provide piped overflow connection for rain garden.

ABBREVIATIONS	
BS	Bottom of Step
BW	Bottom of Wall
CB	Catch Basin
E	Electrical Manhole
ELEV	Elevation
EX	Existing
FFE	Finished Floor Elevation
H	Hand Hole
IFE	Invert
LFE	Lower Floor Elevation
MAX	Maximum
MIN	Minimum
OU	Overhead Utility
PVC	Polyvinyl Chloride
RCP	Reinforced Concrete Pipe
STRM	Storm Saver Structure
T	Telephone Manhole
TP	Telephone Pedestal
TC	Top of Curb
TS	Top of Step
TW	Top of Wall
UE	Underground Electric Line
VCP	Victory Clay Pipe
W.O.	Washout


PROPOSED PLAN SYMBOLS	
CONSTRUCTION LIMITS	---
SILTATION FENCE	
SEDIMENT CONTROL LOG	
PROPERTY LINE (APPROX.)	---
PROPOSED CONTOUR	---
DRAIN FILE	---
STORM SEWER	---
CATCH BASIN	○
MANHOLE	○
ROCK CONSTRUCTION ENTRANCE	---
DRAINAGE FLOW ARROW	---
SPOT ELEVATION	○
SOIL BORING	○
CONCRETE WASHOUT AREA	---

NOTE: CONSTRUCTION LIMITS ARE ANTICIPATED TO BE PROPERTY LINE UNLESS OTHERWISE SHOWN.

KEYED NOTES

- 1. INSTALL ROCK CONSTRUCTION ENTRANCE. REFER TO DETAIL 1/C500.0.
- 2. INSTALL PERIMETER EROSION CONTROL. REFER TO DETAILS 2/C500.0 AND 3/C500.0.
- 3. INSTALL INLET SEDIMENT PROTECTION. REFER TO DETAILS 4/C500.0, 5/C500.0, AND 6/C500.0.
- 4. APPROXIMATE LOCATION OF TEMPORARY CONTAINED CONCRETE WASH OUT BIN. REFER TO THE MINNESOTA'S WOODS/SSS GENERAL STORMWATER PERMIT FOR CONSTRUCTION ACTIVITY FOR MORE DETAILS. SELF-CONTAINED CONCRETE WASHOUTS ON CONCRETE DELIVERY TRUCKS IS AN ACCEPTABLE ALTERNATIVE TO ON-SITE CONTAINMENT.
- 5. RAIN GARDEN IS TO BE CONSTRUCTED AT THE END OF GRADING OPERATIONS ONCE THE TRIBUTARY AREA'S FINAL STABILIZATION HAS BEEN INSTALLED. REFER TO DETAIL 10/C500.0 FOR RAIN GARDEN CROSS SECTION. CONSTRUCTION TRAFFIC IN RAIN GARDEN AREA IS NOT ALLOWED AFTER AREA HAS BEEN EXCAVATED. PRIOR TO FINAL STABILIZATION, LOOSE SOIL WITH MECHANICAL TILLER. RAIN GARDEN AREA IS NOT APPROVED BORROW SITES AND IS NOT TO BE USED FOR TEMPORARY SEDIMENT BASIN(S) ONCE BASIN(S) SUBGRADE ELEVATION HAS BEEN EXCAVATED. CONTRACTOR SHALL ENSURE THAT BASIN INFILTRATES AT A MINIMUM RATE OF 0.90-INCHES PER HOUR USING A DOUBLE RING INFILTRATOR TEST BEFORE FINISH ACCEPTANCE. DOUBLE RING INFILTRATOR TEST SHALL BE SIGNED BY A REGISTERED GEOTECHNICAL ENGINEER AND SUBMITTED TO THE CITY AND ENGINEER FOR REVIEW BEFORE FINAL APPROVAL.

Storm sewer needed in SE corner of site to collect snow melt before sheeting across sidewalk.

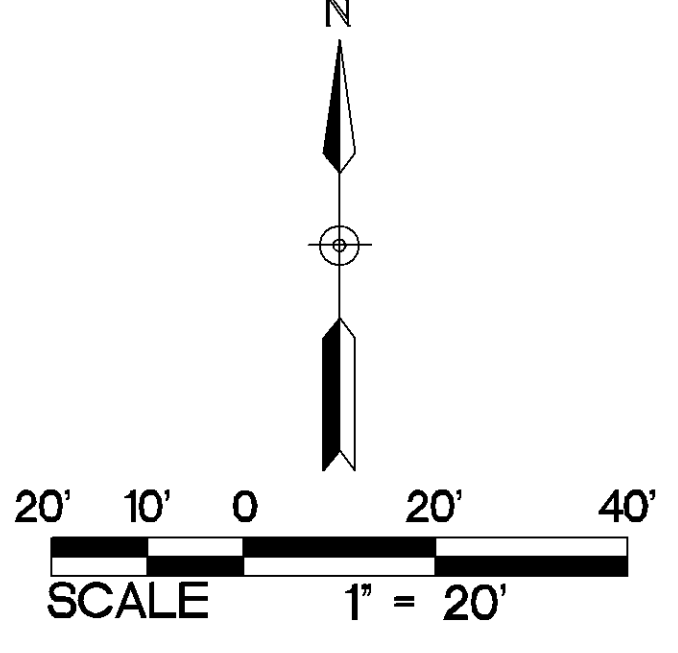

APPROXIMATE DISTURBED AREA IS 1.90 ACRES

NOTE: STORM SEWER INLETS NOT SHOWN ON PLAN MAY RECEIVE RUNOFF FROM CONSTRUCTION ACTIVITIES. INSTALL INLET SEDIMENT PROTECTION PER DETAILS 4/C500.0, 5/C500.0, AND 6/C500.0 ON ALL STORM INLETS THAT MAY RECEIVE RUNOFF.

- ### RETAINING WALL NOTES:
1. ALL TOP AND BOTTOM ELEVATIONS CORRESPOND TO THE RESPECTIVE GRADE ELEVATIONS ON EACH SIDE OF THE WALL.
 2. THE BOTTOM ELEVATION IS THE ELEVATION OF THE LOW-GRADE SIDE OF THE WALL, NOT THE TOP ELEVATION OF THE BURIED BLOCK COURSE.
 3. ALL RETAINING WALLS SHALL HAVE PROTECTIVE FENCING AT THE TOP WHERE THE VERTICAL HEIGHT EXCEEDS 30 INCHES. REFER TO ARCHITECTURAL AND LANDSCAPE PLANS AND SPECIFICATIONS.
 4. MODULAR BLOCK RETAINING WALL SHALL BE DESIGNED AND CERTIFIED BY A LICENSED PROFESSIONAL ENGINEER. DESIGN CALCULATIONS AND SHOP DRAWINGS SHALL BE SUBMITTED TO THE OWNER AND ARCHITECT AT LEAST THREE WEEKS PRIOR TO CONSTRUCTION OF WALL.

- ### WALKWAY NOTES:
1. GRADING CONTRACTOR IS TO COORDINATE WITH PAVING CONTRACTOR SO THAT ALL STEPS AND LANDINGS ARE SLOPED PER CODE.
 2. ALL SIDEWALK LONGITUDINAL AND TRANSVERSE SLOPES ARE TO BE PER CODE.

Show location of all inlet protection on SWPPP. Provide for overflow at low areas.

SR - 700 American
700 W. AMERICAN BLVD. / BLOOMINGTON, MN

URBANWORKS
CONSULTANT

PRELIMINARY
NOT FOR CONSTRUCTION
SCHEMATIC DESIGN
CITY SUBMITTAL
10.11.2023
REVISIONS

1 GRADING, DRAINAGE, AND EROSION CONTROL PLAN


- ### EROSION CONTROL NOTES:
1. ALL EROSION CONTROL FACILITIES SHALL BE INSTALLED PRIOR TO ANY SITE GRADING OPERATIONS. THE CITY ENGINEERING DEPARTMENT AND NINE MILE CREEK WATERSHED DISTRICT MUST BE NOTIFIED UPON COMPLETION OF THE INSTALLATION OF THE REQUIRED EROSION CONTROL FACILITIES AND PRIOR TO ANY GRADING OPERATION BEING COMMENCED. THE CONTRACTOR IS RESPONSIBLE FOR SCHEDULING A PRE-CONSTRUCTION GRADING MEETING ON-SITE WITH THE CITY AND NINE MILE CREEK WATERSHED DISTRICT. IF DAMAGED OR REMOVED DURING CONSTRUCTION, ALL EROSION CONTROL FACILITIES SHALL BE RESTORED AND IN PLACE AT THE END OF EACH DAY.
 2. ANY EROSION CONTROL FACILITIES DEEMED NECESSARY BY THE CITY AND NINE MILE CREEK WATERSHED DISTRICT, BEFORE, DURING, OR AFTER THE GRADING ACTIVITIES, SHALL BE INSTALLED AT THEIR REQUEST.
 3. NO DEVIATIONS SHALL BE MADE FROM THE ELEVATIONS SHOWN ON THE APPROVED GRADING PLAN WITHOUT PRIOR APPROVAL FROM THE CIVIL ENGINEER.
 4. FOR SITES GREATER THAN 1.0 ACRE, AS REQUIRED BY THE MPCA PERMIT REQUIREMENTS, THE PERMIT APPLICANT MUST KEEP AN EROSION CONTROL INSPECTION LOG. INSPECTION MUST BE MADE ONCE EVERY SEVEN DAYS AND WITHIN 24 HOURS AFTER EVERY RAIN EVENT. THE INSPECTION RECORD MUST BE MADE AVAILABLE TO THE CITY AND NINE MILE CREEK WATERSHED DISTRICT WITHIN 24 HOURS OF REQUEST.
 5. FLOWS FROM DIVERSION CHANNELS OR PIPES (TEMPORARY OR PERMANENT) SHALL BE ROUTED TO SEDIMENTATION BASINS OR APPROPRIATE ENERGY DISSIPATORS TO PREVENT TRANSPORT OF SEDIMENT TO OUTFLOW TO LATERAL CONVEYORS AND TO PREVENT EROSION AND SEDIMENTATION WHEN RUNOFF FLOWS INTO THESE CONVEYORS.
 6. SITE ACCESS ROADS SHALL BE GRADED OR OTHERWISE PROTECTED WITH SILT FENCES, DIVERSION CHANNELS, OR DIKES AND PIPES TO PREVENT SEDIMENT FROM EXITS THE SITE VIA THE ACCESS ROADS. SITE-ACCESS ROADS/DRIVEWAYS SHALL BE SURFACED WITH CRUSHED ROCK WHERE THEY ADJOIN EXISTING PAVED ROADWAYS.
 7. SOILS TRACKED FROM THE SITE BY MOTOR VEHICLES OR EQUIPMENT SHALL BE CLEANED DAILY FROM PAVED ROADWAY SURFACES, OR MORE FREQUENTLY IF REQUESTED BY THE CITY AND NINE MILE CREEK WATERSHED DISTRICT, THROUGHOUT THE DURATION OF CONSTRUCTION.
 8. DUST CONTROL MEASURES SHALL BE PERFORMED PERIODICALLY WHEN CONDITIONS REQUIRE AND/OR AS DIRECTED BY THE CITY AND NINE MILE CREEK WATERSHED DISTRICT.
 9. ALL EROSION CONTROL MEASURES SHALL BE USED AND MAINTAINED FOR THE DURATION OF SITE CONSTRUCTION. IF CONSTRUCTION OPERATIONS OR NATURAL EVENTS DAMAGE OR INTERFERE WITH THESE EROSION CONTROL MEASURES, THEY SHALL BE RESTORED TO SERVE THEIR INTENDED FUNCTION AT THE END OF EACH DAY OR AS SOON AS FIELD CONDITIONS ALLOW ACCESS.
 10. ALL AREAS DISTURBED DURING CONSTRUCTION SHALL BE RESTORED AS SOON AS POSSIBLE. ANY AREAS WHICH HAVE BEEN FINISHED GRADED OR AREAS THAT HAVE BEEN DISTURBED AND FOR WHICH GRADING OR SITE BUILDING CONSTRUCTION OPERATIONS ARE NOT ACTIVELY UNDERWAY SHALL BE SEEDED AND MULCHED AS SET FORTH IN THE FOLLOWING PARAGRAPHS WITHIN 14 (7 IF IMPAIRED) DAYS.
 - A. ALL SEEDED AREAS SHALL BE EITHER MULCHED AND DISC-ANCHORED OR COVERED BY FIBROUS BLANKETS TO PROTECT SEEDS AND LIMIT EROSION. TEMPORARY STRAW MULCH SHALL BE DISC-ANCHORED AND APPLIED AT A

- UNIFORM RATE OF NOT LESS THAN TWO TONS PER ACRE AND NOT LESS THAN 80% COVERAGE.
- B. IF THE GRADED AREA IS ANTICIPATED TO BE RE-DISTURBED/DEVELOPED WITHIN SIX MONTHS, PROVIDE A TEMPORARY VEGETATIVE COVER CONSISTING OF MINNESOTA DEPARTMENT OF TRANSPORTATION (MNDOT) SEED MIXTURE 21-111 (GATS), OR 21-112 (WINTER WHEAT), AT A RATE OF 100 POUNDS PER ACRE.
 - C. IF GRADED AREA WILL NOT BE DEVELOPED FOR A PERIOD GREATER THAN SIX MONTHS, PROVIDE A SEMI-PERMANENT VEGETATIVE COVER OF SEED MIXTURE MNDOT 22-112 AT A RATE OF 40 POUNDS PER ACRE.
 - D. GRADING BONDS OR THE EQUIVALENT SECURITIES SHALL BE RETAINED UNTIL TURF HAS GERMINATED AND SURVIVED A 60-DAY GROWING PERIOD.
 - E. ALL AREAS THAT WILL NOT BE MOWED OR MAINTAINED AS PART OF THE ULTIMATE DESIGN WILL BE PERMANENTLY RESTORED USING SEED MIXTURE MNDOT 25-141 AT A RATE OF 59 POUNDS PER ACRE.
 - F. UNLESS SPECIFIED ELSEWHERE WITHIN THE CONSTRUCTION DOCUMENTS (I.E. ARCHITECTURAL SITE PLAN OR LANDSCAPE PLAN), PERMANENT TURF RESTORATION SHALL CONSIST OF 500.
 - G. WHENEVER OTHER EROSION AND SEDIMENT CONTROL PRACTICES ARE INADEQUATE, TEMPORARY ON-SITE SEDIMENT BASINS THAT CONFORM TO THE CRITERIA FOR ON-SITE DETENTION BASINS SHALL BE PROVIDED.
 - H. MULCH, HYDROMULCH, AND TAGCHIPS MAY NOT BE USED FOR STABILIZATION IN SWALES OR DRAINAGE DITCHES UNLESS THE LONGITUDINAL SLOPE IS LESS THAN 2 PERCENT.
 - I. RUNOFF SHALL BE PREVENTED FROM ENTERING ALL STORM SEWER CATCH BASINS PROVIDING THEY ARE NOT NEEDED DURING CONSTRUCTION. WHERE STORM SEWER CATCH BASINS ARE NECESSARY FOR SITE DRAINAGE DURING CONSTRUCTION, SEDIMENT PROTECTION DEVICES AS DETAILD SHALL BE INSTALLED AND MAINTAINED AROUND ALL CATCH BASINS UNTIL THE TRIBUTARY AREA TO THE CATCH BASIN IS RESTORED.
11. GRADING ACTIVITIES PROPOSED TO BEGIN AFTER OCTOBER 15 WILL REQUIRE AN APPROVED SCHEDULING. THE AREA OF LAND THAT THE CITY WILL NOT BE DISTURBED AT THIS TIME OF YEAR WILL BE SEVERELY LIMITED. THE CITY WILL ALSO REQUIRE ADDITIONAL EROSION CONTROL DEVICES, I.E. TEMPORARY SEDIMENT BASINS, DORMANT SEEDING AND HIGH RATES OF APPLICATION OF BOTH SEED AND MULCH.
 12. TO MINIMIZE EROSION, ALL 3/1 SLOPES SHALL BE COVERED WITH A MN/DOT 3885 CATEGORY 20 STRAW EROSION CONTROL BLANKETS OR STAKED SOO.
 13. ACCUMULATION OF ALL SEDIMENT OCCURRING IN STORM SEWERS, AND DITCHES SHALL BE REMOVED PRIOR TO, DURING, AND AFTER COMPLETION OF GRADING ACTIVITIES.
 14. EROSION CONTROL ITEMS AND DEVICES SHALL BE REMOVED ONLY AFTER THE AREA HAS RECEIVED FINAL STABILIZATION OR AS DIRECTED BY THE CITY AND NINE MILE CREEK WATERSHED DISTRICT.


- ### GRADING NOTES:
1. THE CONTRACTOR SHALL VISIT THE SITE, REVIEW ALL CONSTRUCTION DOCUMENTS, AND FIELD VERIFY THE EXISTING CONDITIONS PRIOR TO BIDDING. NO ADDITIONAL COMPENSATION WILL BE GIVEN FOR WORK THAT COULD HAVE BEEN IDENTIFIED BY A SITE VISIT OR CONSTRUCTION DOCUMENT REVIEW.
 2. THE BACKGROUND INFORMATION WAS PREPARED BY STANTEC, (612) 712-2000.
 3. IF IT IS THE CONTRACTOR'S RESPONSIBILITY TO ASCERTAIN THE LOCATION OF ALL EXISTING UTILITIES, THE CONTRACTOR SHALL VERIFY THE LOCATION AND ELEVATION AND MARK ALL EXISTING UTILITIES 48 HOURS BEFORE CONSTRUCTION STARTS. THE ENGINEER, ARCHITECT, OR OWNER DOES NOT GUARANTEE THAT ALL THE UTILITIES ARE MARKED, OR IF MARKED, ARE SHOWN CORRECTLY. CONTACT COPHER STATE ONE CALL AT 651-454-0002 FOR FIELD LOCATING EXISTING UTILITIES.
 4. PROTECT ALL EXISTING STRUCTURES AND UTILITIES WHICH ARE NOT SCHEDULED FOR REMOVAL.
 5. NOTIFY CITY BUILDING INSPECTOR BEFORE TRENCHING AND EXCAVATION WORK COMMENCES. THE CONTRACTOR SHALL OBTAIN ALL APPLICABLE PERMITS PRIOR TO START OF CONSTRUCTION.
 6. ALL SPOT ELEVATIONS SHOWN AS XXX.X, FOR EXAMPLE, ARE TO BE UNDERSTOOD TO MEAN XXX.XX.
 7. ALL SPOT ELEVATIONS ALONG THE CURB-LINE INDICATE THE ELEVATION OF THE GUTTER UNLESS NOTED OTHERWISE.
 8. NO LANDSCAPED SLOPES ARE TO EXCEED 3:1 (3 FEET HORIZONTAL TO 1 FOOT VERTICAL) UNLESS NOTED OTHERWISE.
 9. ACCESSIBLE PARKING AREAS SHALL NOT HAVE SLOPES IN ANY DIRECTION THAT EXCEED 2%.
 10. PROVIDE POSITIVE DRAINAGE FROM BUILDINGS AT ALL TIMES.
 11. UPON COMPLETION OF THE GRADING AND UTILITY WORK, THE CONTRACTOR SHALL CERTIFY THAT ALL GRADING AND UTILITY WORK WAS PERFORMED IN ACCORDANCE WITH THE APPROVED GRADING AND UTILITY PERMITS. AN AS-BUILT GRADING AND UTILITY PLAN SHALL BE PERFORMED BY A REGISTERED LAND SURVEYOR HIRED BY THE CONTRACTOR. SURVEY SHALL BE PROVIDED TO CIVIL ENGINEER.
 12. PRIOR TO ISSUANCE OF BUILDING PERMITS, ALL NECESSARY EROSION CONTROL DEVICES MUST BE IN PLACE AND FUNCTIONING. THE CITY AND NINE MILE CREEK WATERSHED DISTRICT WILL INSPECT THE SITE TO DETERMINE ITS SUITABILITY FOR BUILDING ACTIVITIES. IF THE PUBLIC UTILITIES HAVE NOT BEEN INSTALLED AT THIS POINT, IT MAY BE NECESSARY TO WITHHOLD BUILDING PERMITS FOR VARIOUS LOTS TO ALLOW THE CONTRACTOR ACQUIRE SPACE TO PERFORM THIS WORK.
 13. ALL DEBRIS CREATED IN THE PROCESS OF CLEARING AND GRADING THE SITE SHALL BE REMOVED FROM THE SITE. THIS INCLUDES TREES AND SHRUBS. UNDER NO CIRCUMSTANCES SHALL THIS TYPE OF MATERIAL BE BURIED OR BURNED ON THE SITE.
 14. THE CONTRACTOR MAY STRIP AND SALVAGE TOPSOIL FOR POTENTIAL RE-SPREADING ON THE SITE, IF APPROVED BY THE LANDSCAPE ARCHITECT AND SPECIFICATIONS. SIX INCHES OF TOPSOIL - AFTER COMPACTION - SHALL BE RE-SPREAD PRIOR TO SEEDING AND MULCHING. EXCESS TOPSOIL MAY BE REMOVED FROM THE SITE PROVIDED THERE IS ADEQUATE TOPSOIL REMAINING TO PROPERLY FINISH THE SITE AS NOTED ABOVE. THE TOPSOIL STRIPPING, STOCKPILING, AND RE-SPREADING SHALL BE DONE IN ACCORDANCE WITH, AND NOTED ON, THE APPROVED GRADING PLAN AND

15. ALL GRADING OPERATIONS SHALL BE CONDUCTED IN A MANNER TO MINIMIZE THE POTENTIAL FOR SITE EROSION. EROSION CONTROL MEASURES SHALL BE INSTALLED TO PREVENT SEDIMENT FROM RUNNING OFF ONTO ADJACENT PROPERTIES. ANY DAMAGE TO ADJACENT PROPERTIES MUST BE CORRECTED AND RESTORED AS SOON AS PERMISSION IS OBTAINED FROM THE ADJACENT PROPERTY OWNERS.
16. IF CONSTRUCTION OF THE SITE WORK PROCEEDS THROUGH THE WINTER MONTHS, ANY DISTURBED AREAS OUTSIDE THE BUILDING FOOTPRINTS ARE TO BE MANUALLY STABILIZED PRIOR TO MARCH 1 AS FOLLOWS: AREAS PLANNED TO RECEIVE PAVEMENTS ARE TO HAVE CLASS 5 BASE INSTALLED; ALL OTHER DISTURBED AREAS ARE TO BE SEEDED, STRAW MULCH PLACED, AND DISC-ANCHORED.
17. WINTER MULCHING:
 - 17.A. SNOW MULCHING SHALL BE DEFINED AS MULCH MATERIAL SPREAD OVER THE TOP OF SNOW SO THAT THE MULCH MELTS THROUGH THE SNOW AND STICKS TO THE EXPOSED SOILS.
 - 17.B. FROZEN GROUND MULCHING SHALL BE DEFINED AS MULCH MATERIAL SPREAD OVER FROZEN GROUND. MULCH MATERIALS THAT DO NOT REQUIRE DISC-ANCHORING INTO THE SOIL MAY BE PLACED WITHOUT MODIFICATION. MULCH MATERIALS THAT REQUIRE DISC-ANCHORING INTO THE SOIL MAY BE PLACED WITHOUT MODIFICATION. MULCH MATERIALS THAT REQUIRE DISC-ANCHORING INTO THE SOIL MAY BE PLACED WITHOUT MODIFICATION. MULCH MATERIALS THAT REQUIRE DISC-ANCHORING INTO THE SOIL MAY BE PLACED WITHOUT MODIFICATION. MULCH MATERIALS THAT REQUIRE DISC-ANCHORING INTO THE SOIL MAY BE PLACED WITHOUT MODIFICATION.
18. RETAINING WALLS AND APPROPRIATE SAFETY FENCING ALONG THE TOP OF WALLS ARE TO BE DESIGNED AND CERTIFIED BY A REGISTERED PROFESSIONAL ENGINEER. SUBMIT RETAINING WALL SHOP DRAWINGS TO PROJECT TEAM PRIOR TO CONSTRUCTION.
19. THE CONTRACTOR SHALL LIMIT THE DISTURBED AREA AS MUCH AS POSSIBLE.


GRADING, DRAINAGE, AND EROSION CONTROL PLAN
C200.0

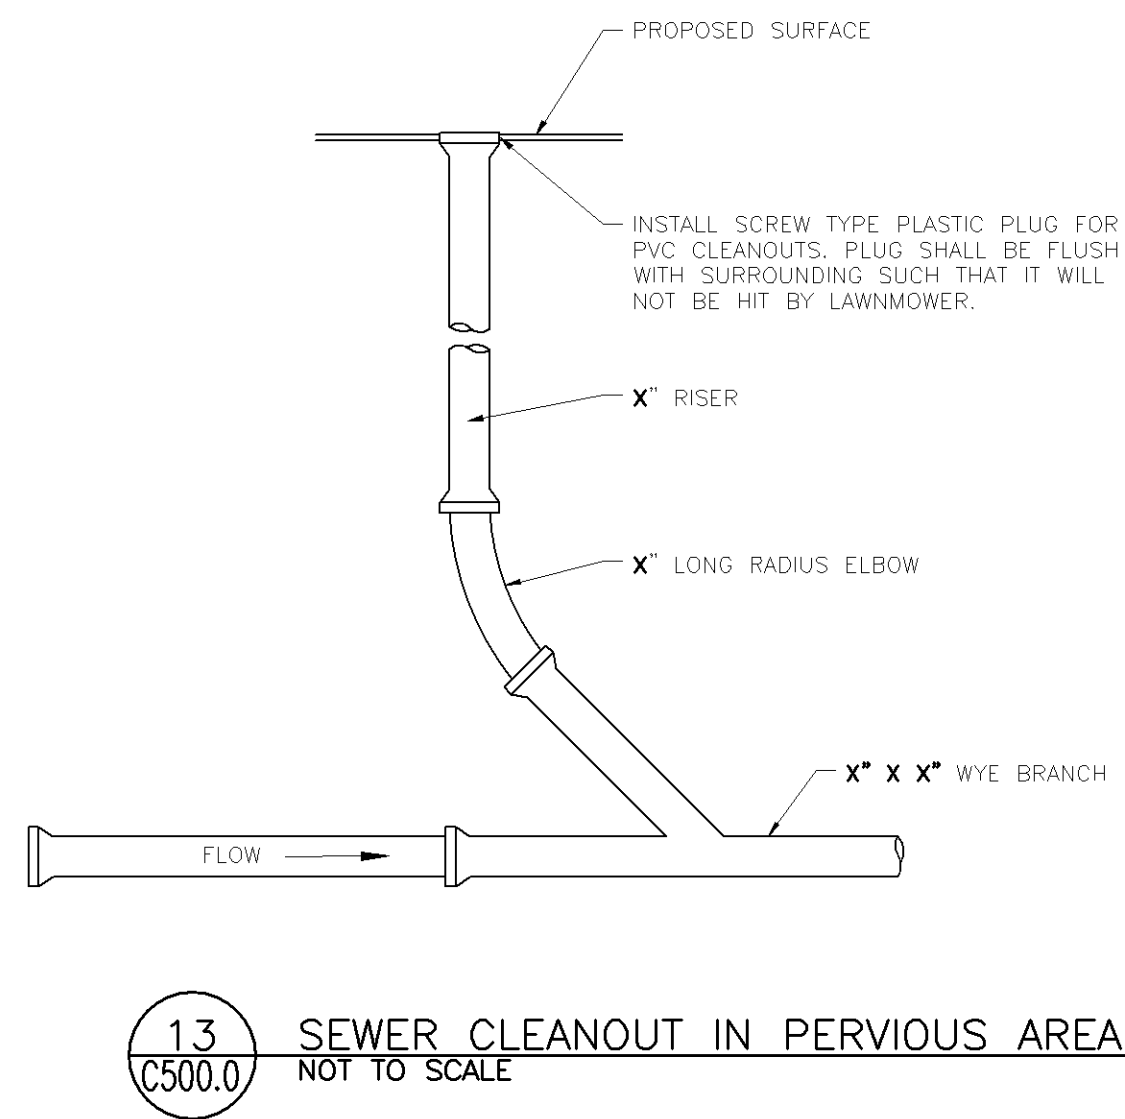


1.3 SEWER CLEANOUT IN PERVIOUS AREA
NOT TO SCALE

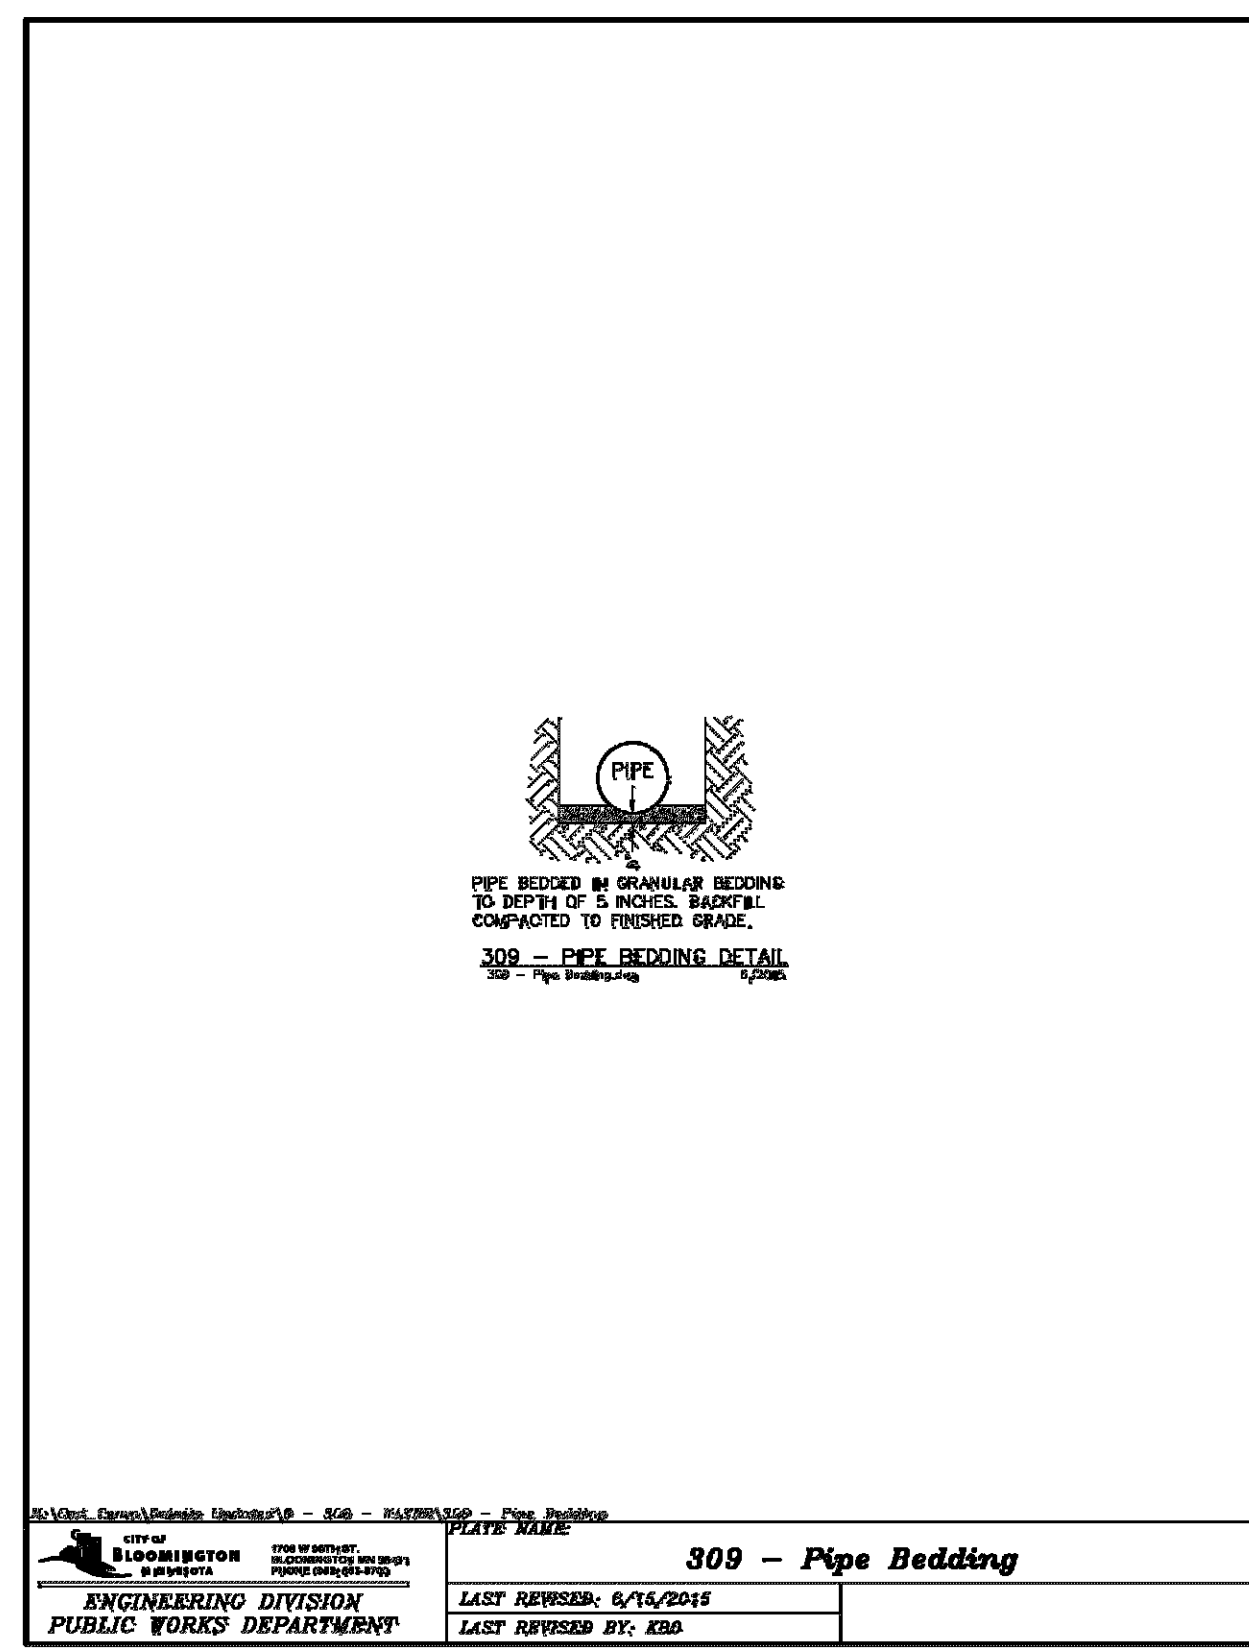


10 PIPE BEDDING
NOT TO SCALE

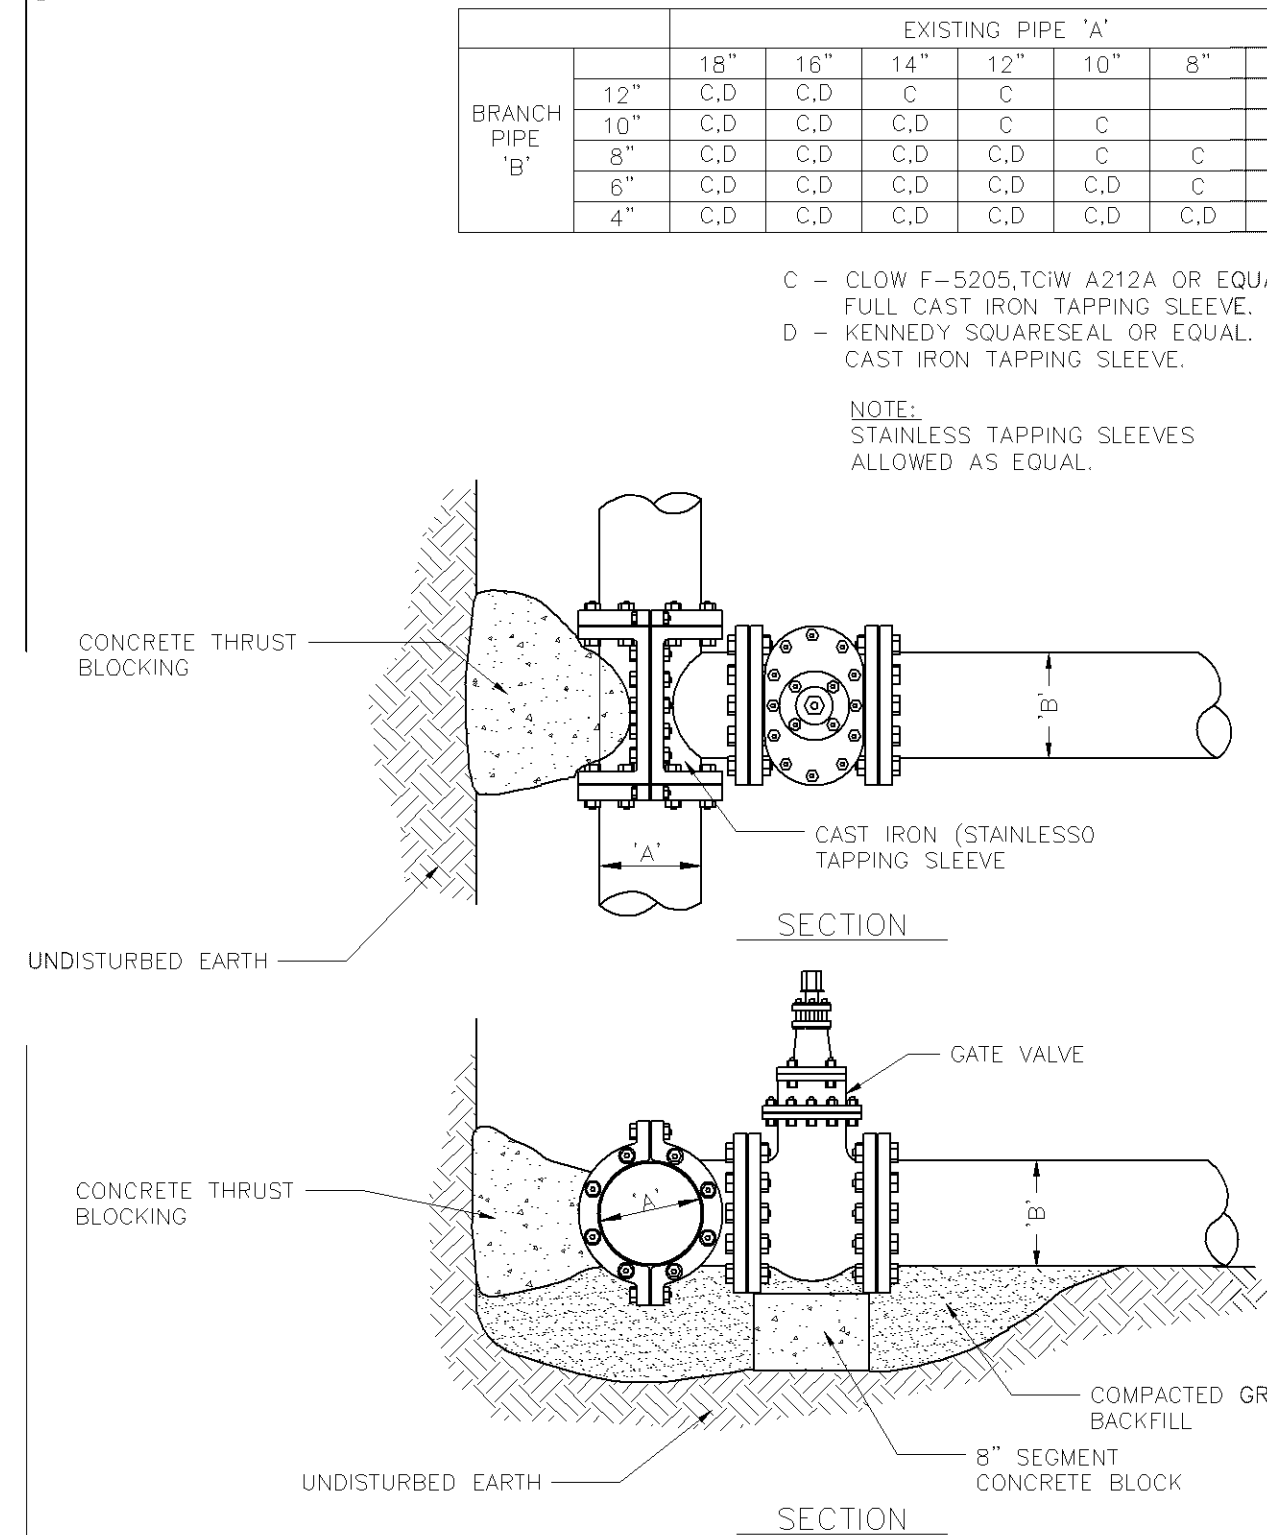


7 WATERMAIN WET TAP (TYP.)
NOT TO SCALE

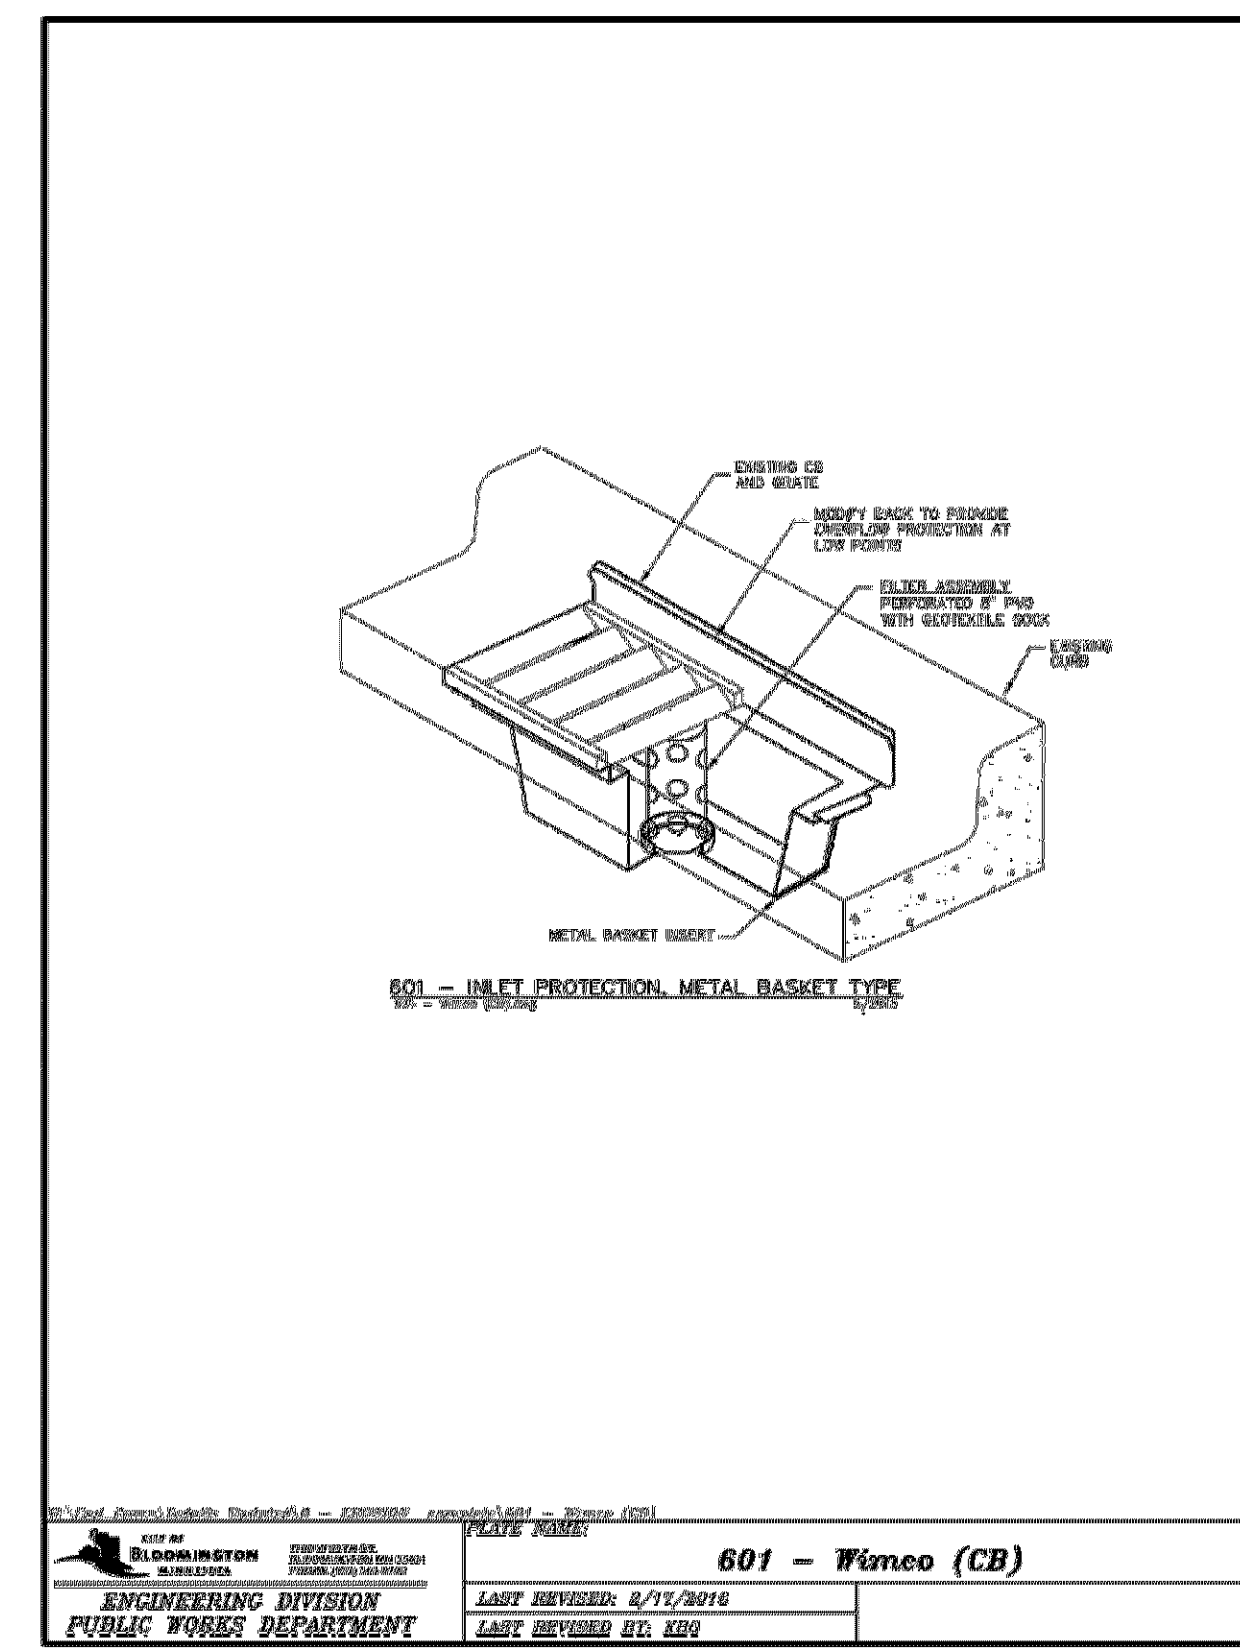


4 INLET PROTECTION
NOT TO SCALE

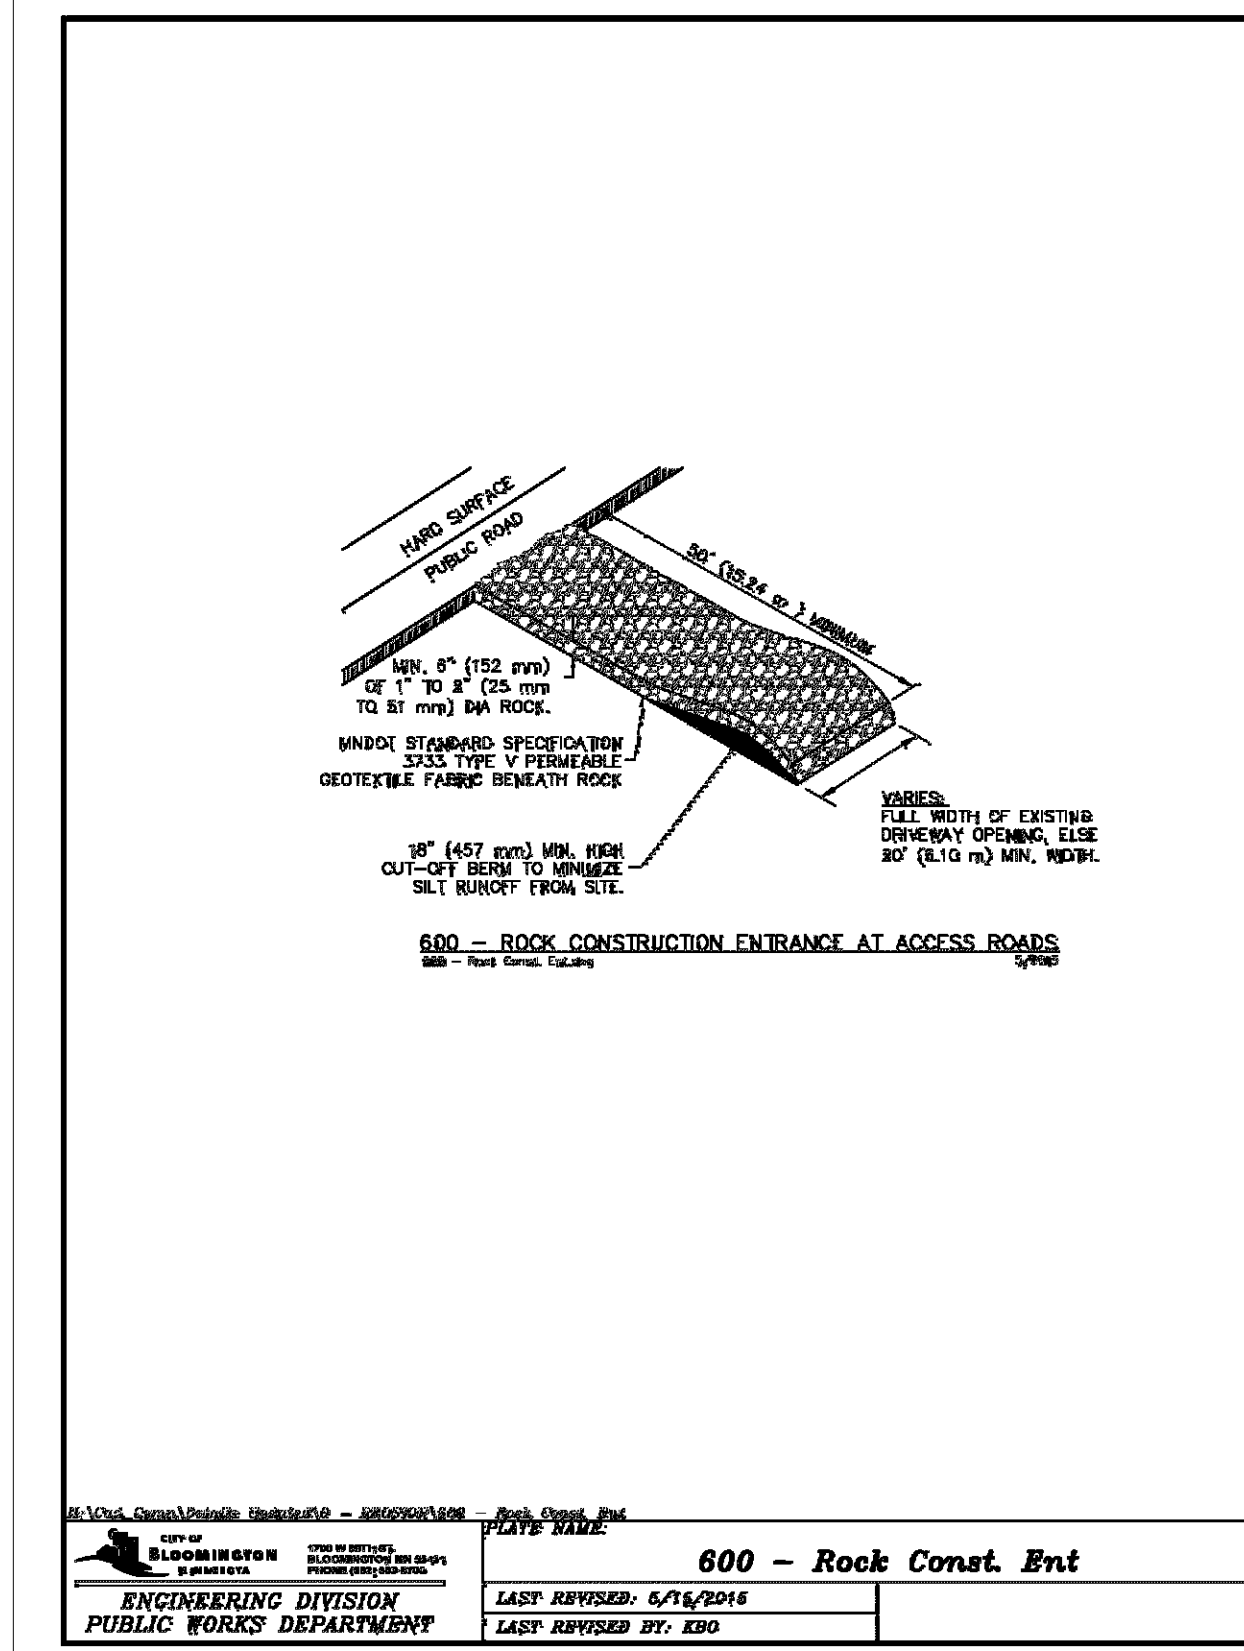


1 ROCK CONSTRUCTION ENTRANCE
NOT TO SCALE

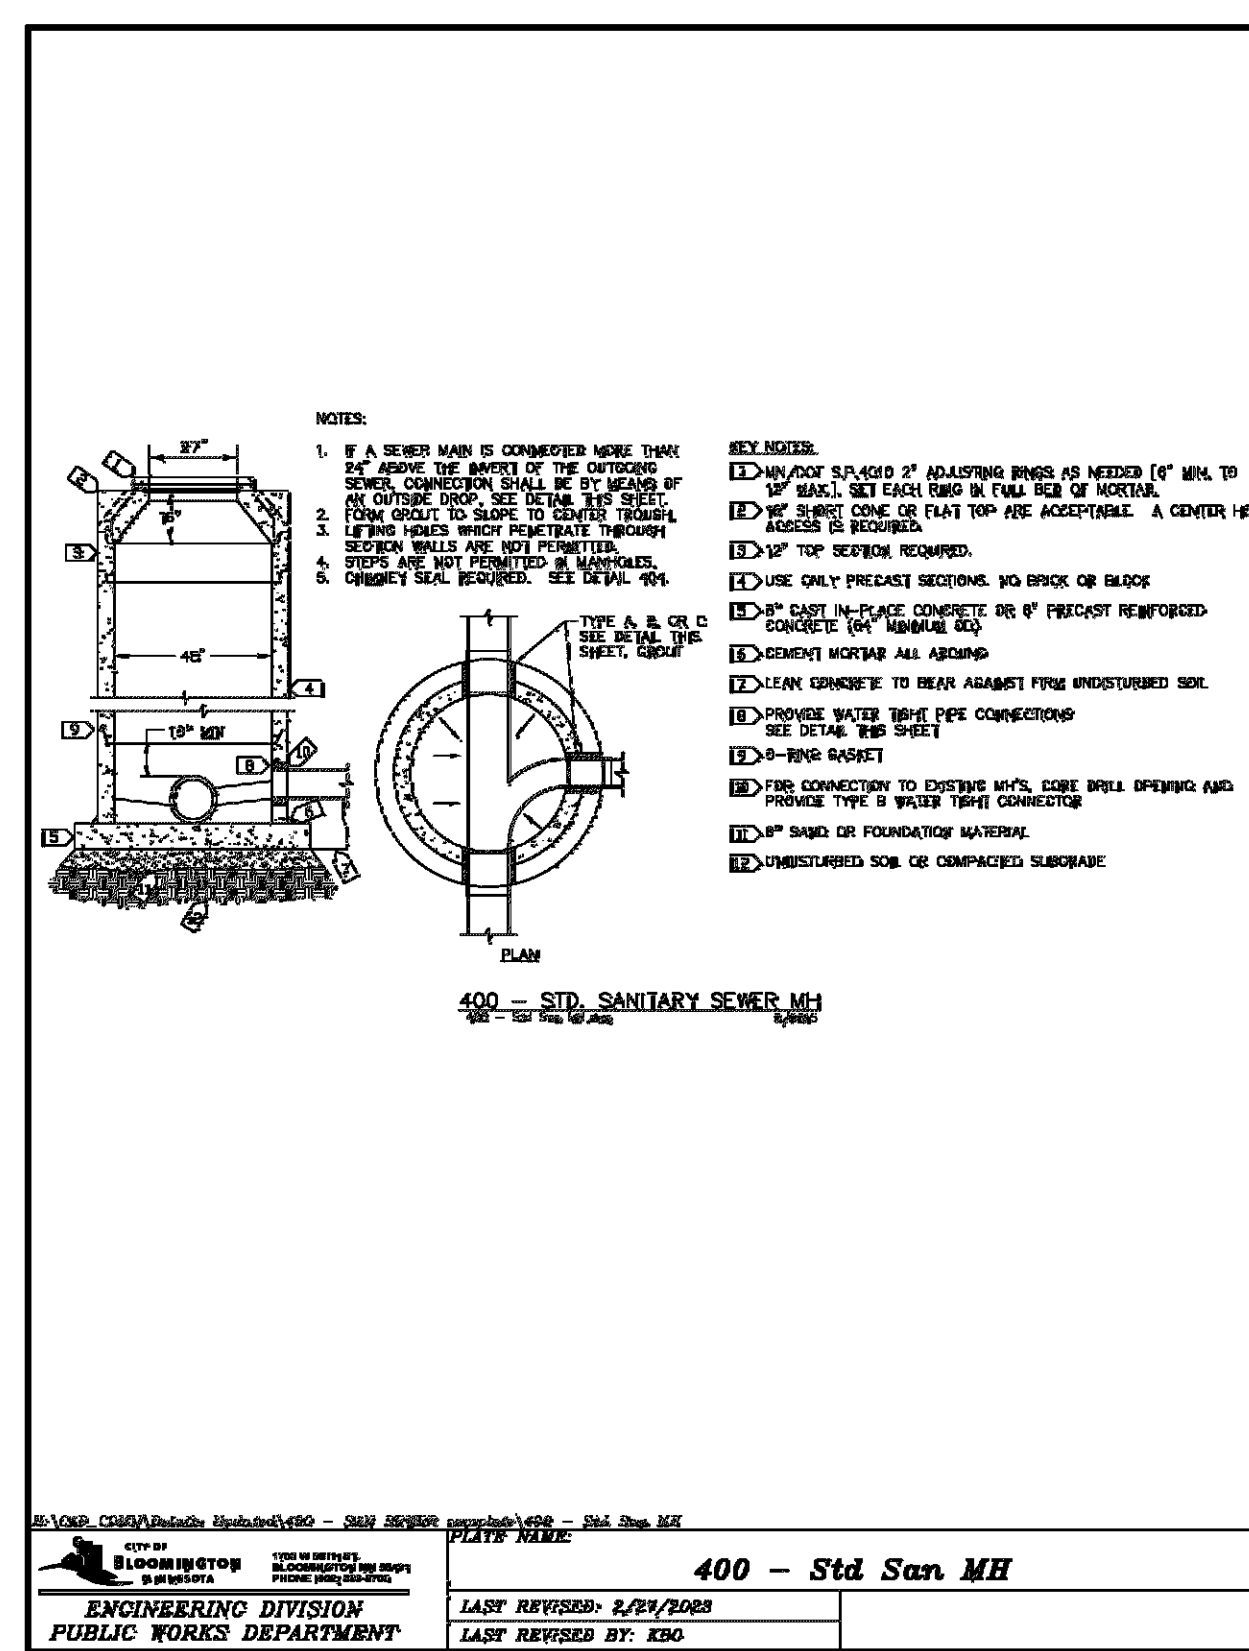


11 SANITARY SEWER MANHOLE
NOT TO SCALE

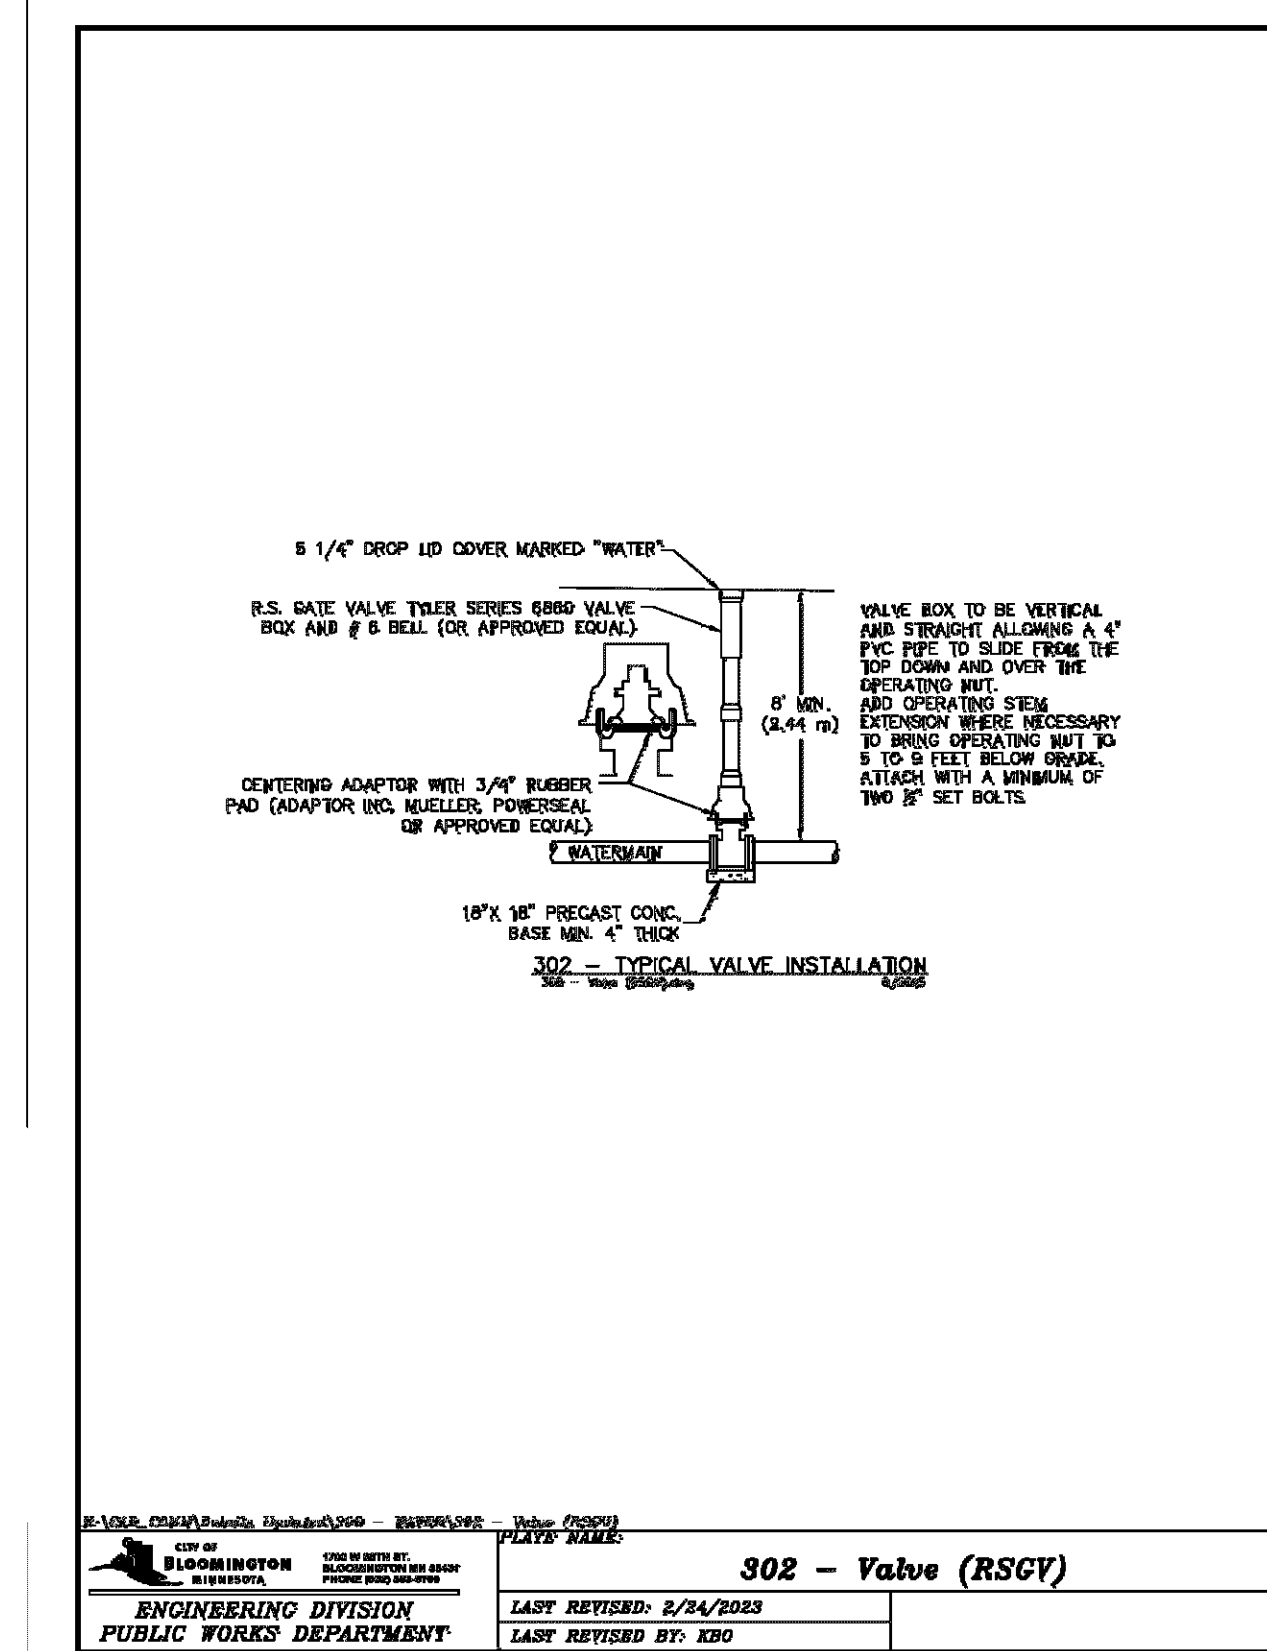


8 GATE VALVE
NOT TO SCALE

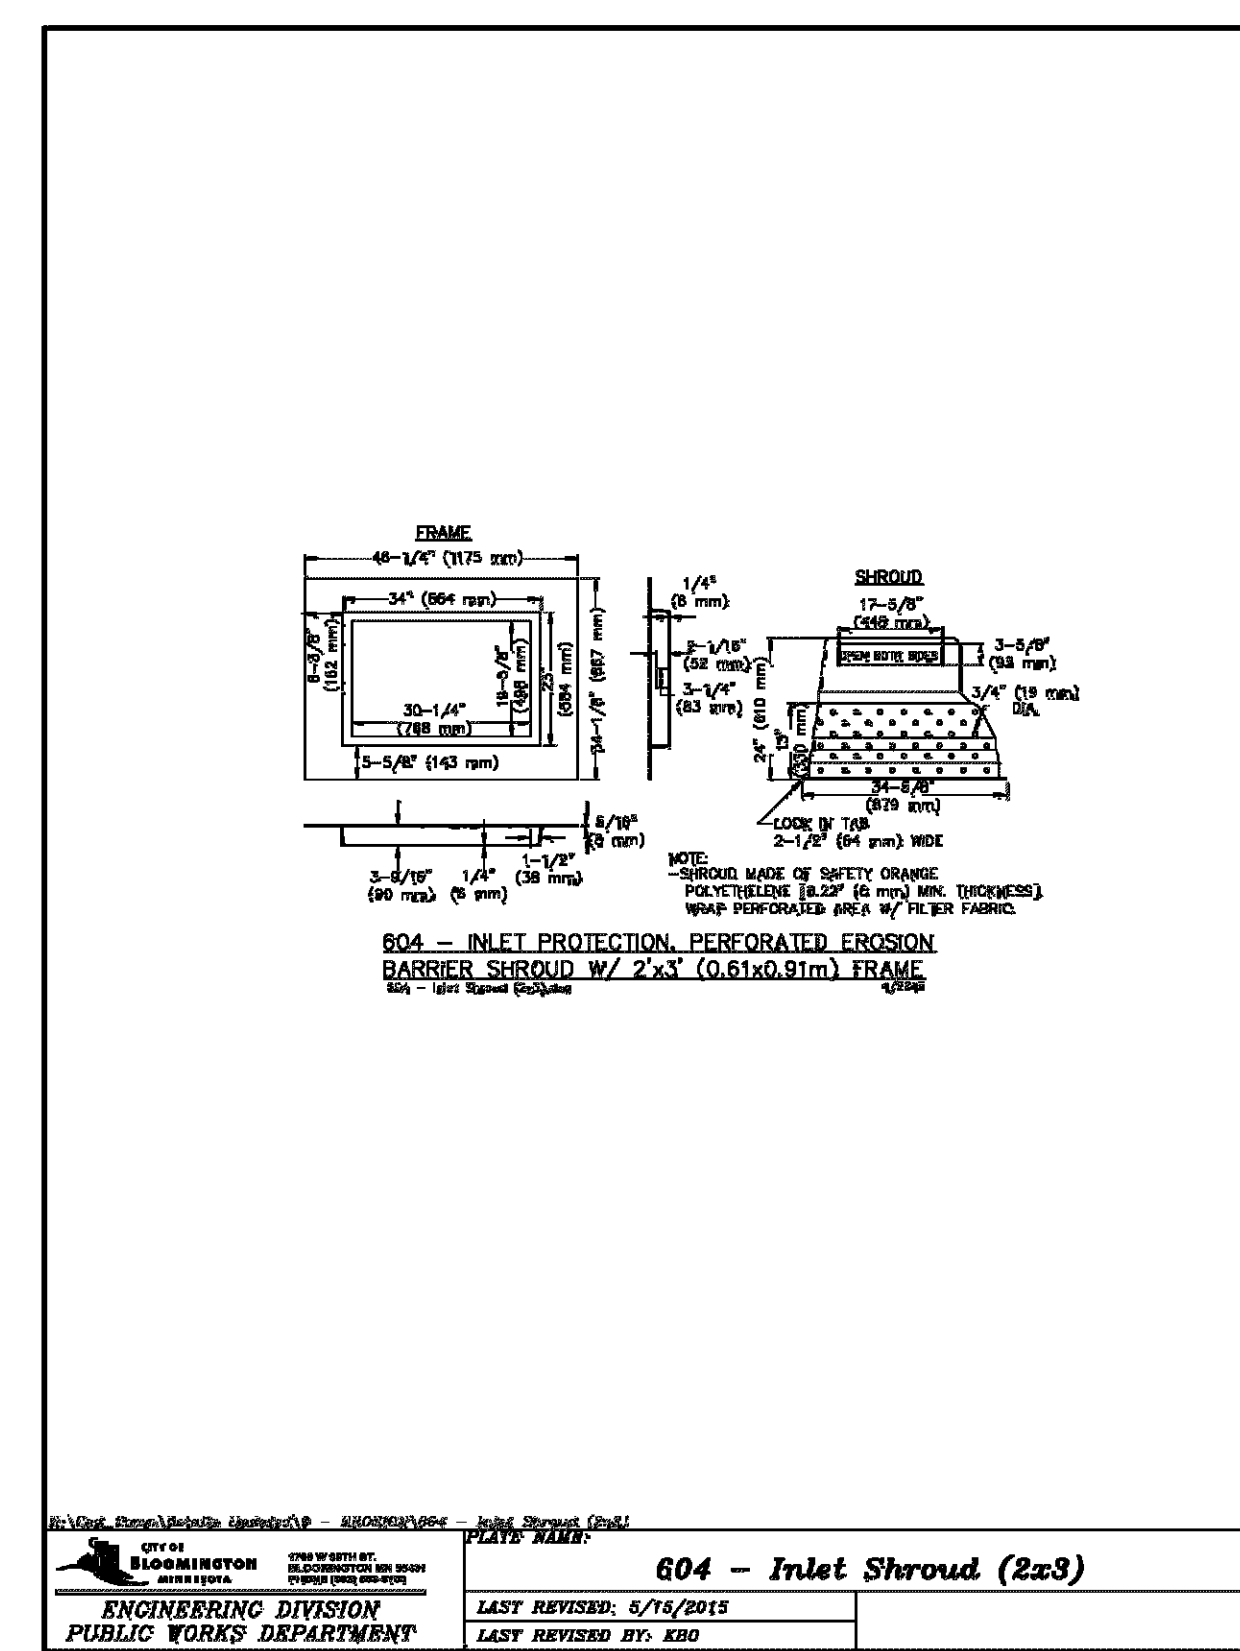


5 INLET PROTECTION
NOT TO SCALE

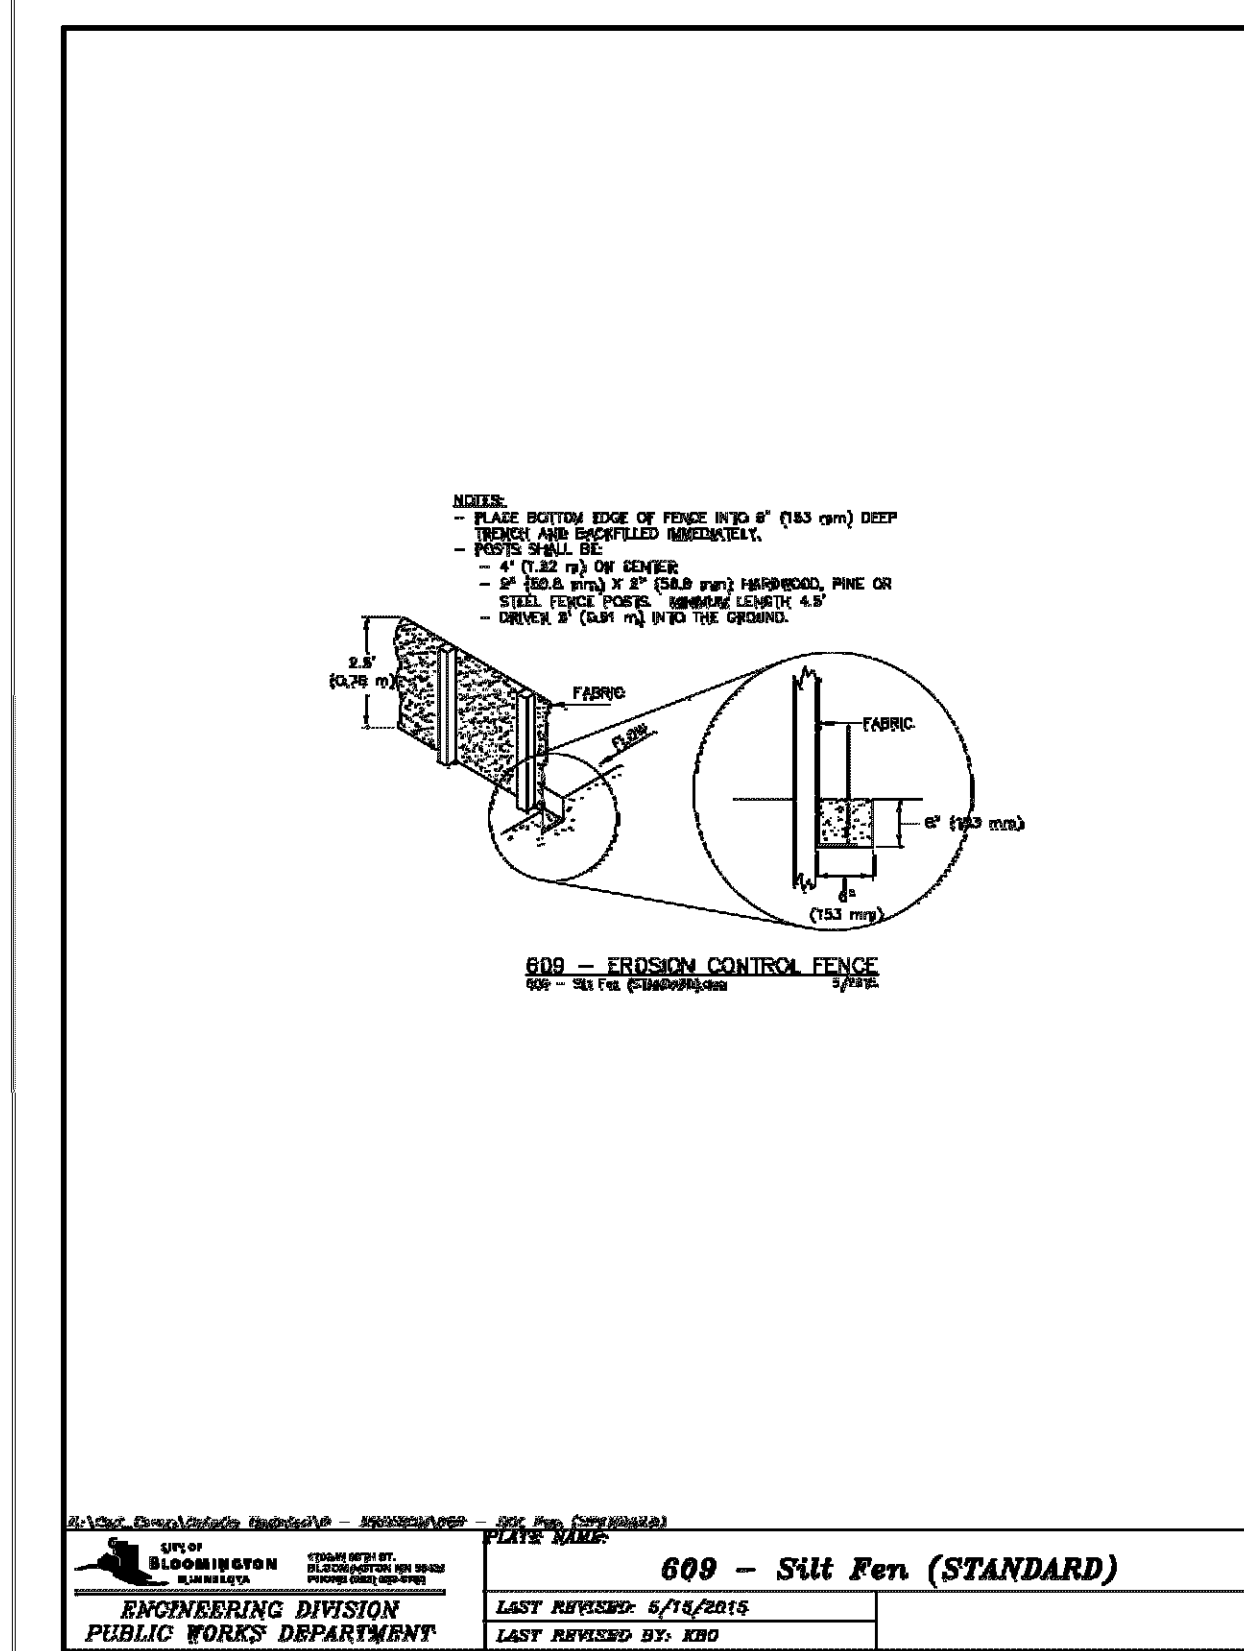


2 SILT FENCE
NOT TO SCALE

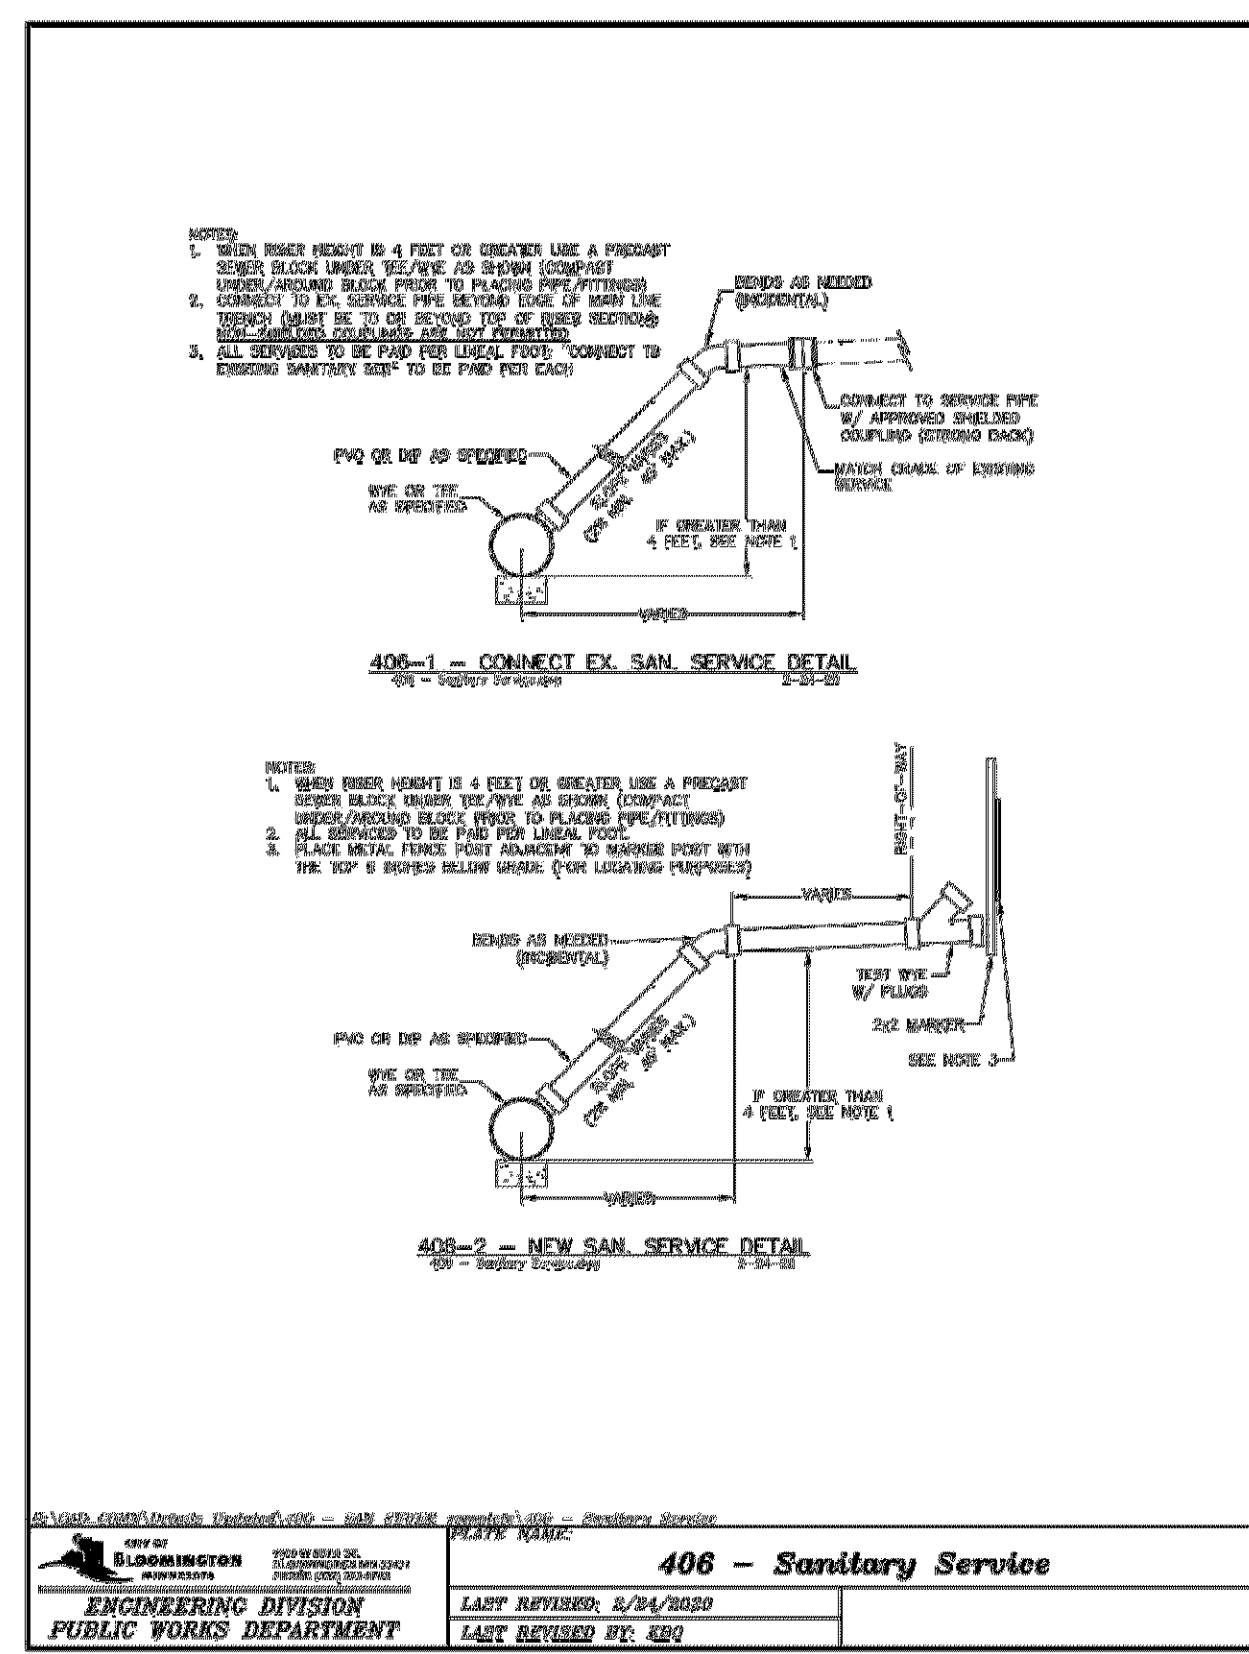


12 SANITARY SEWER SERVICE
NOT TO SCALE

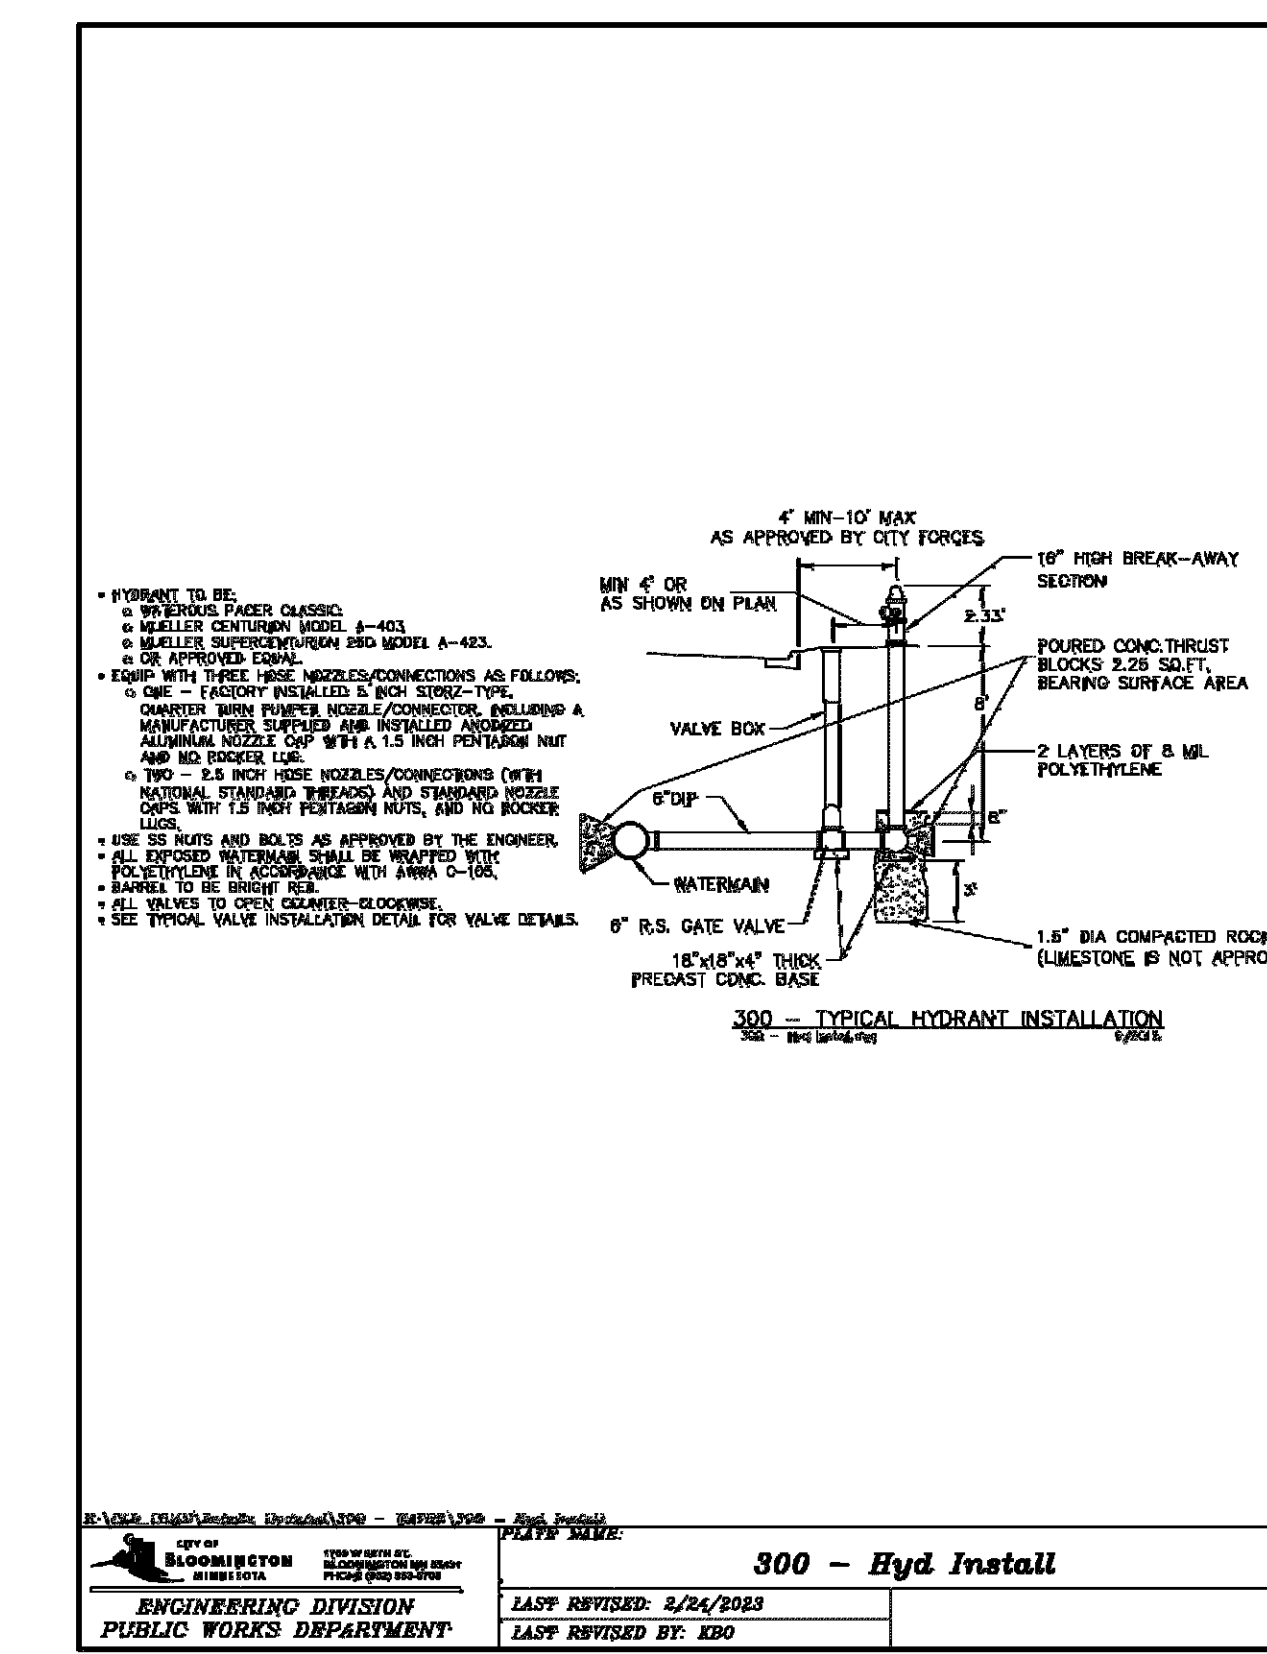

9 HYDRANT INSTALLATION
NOT TO SCALE

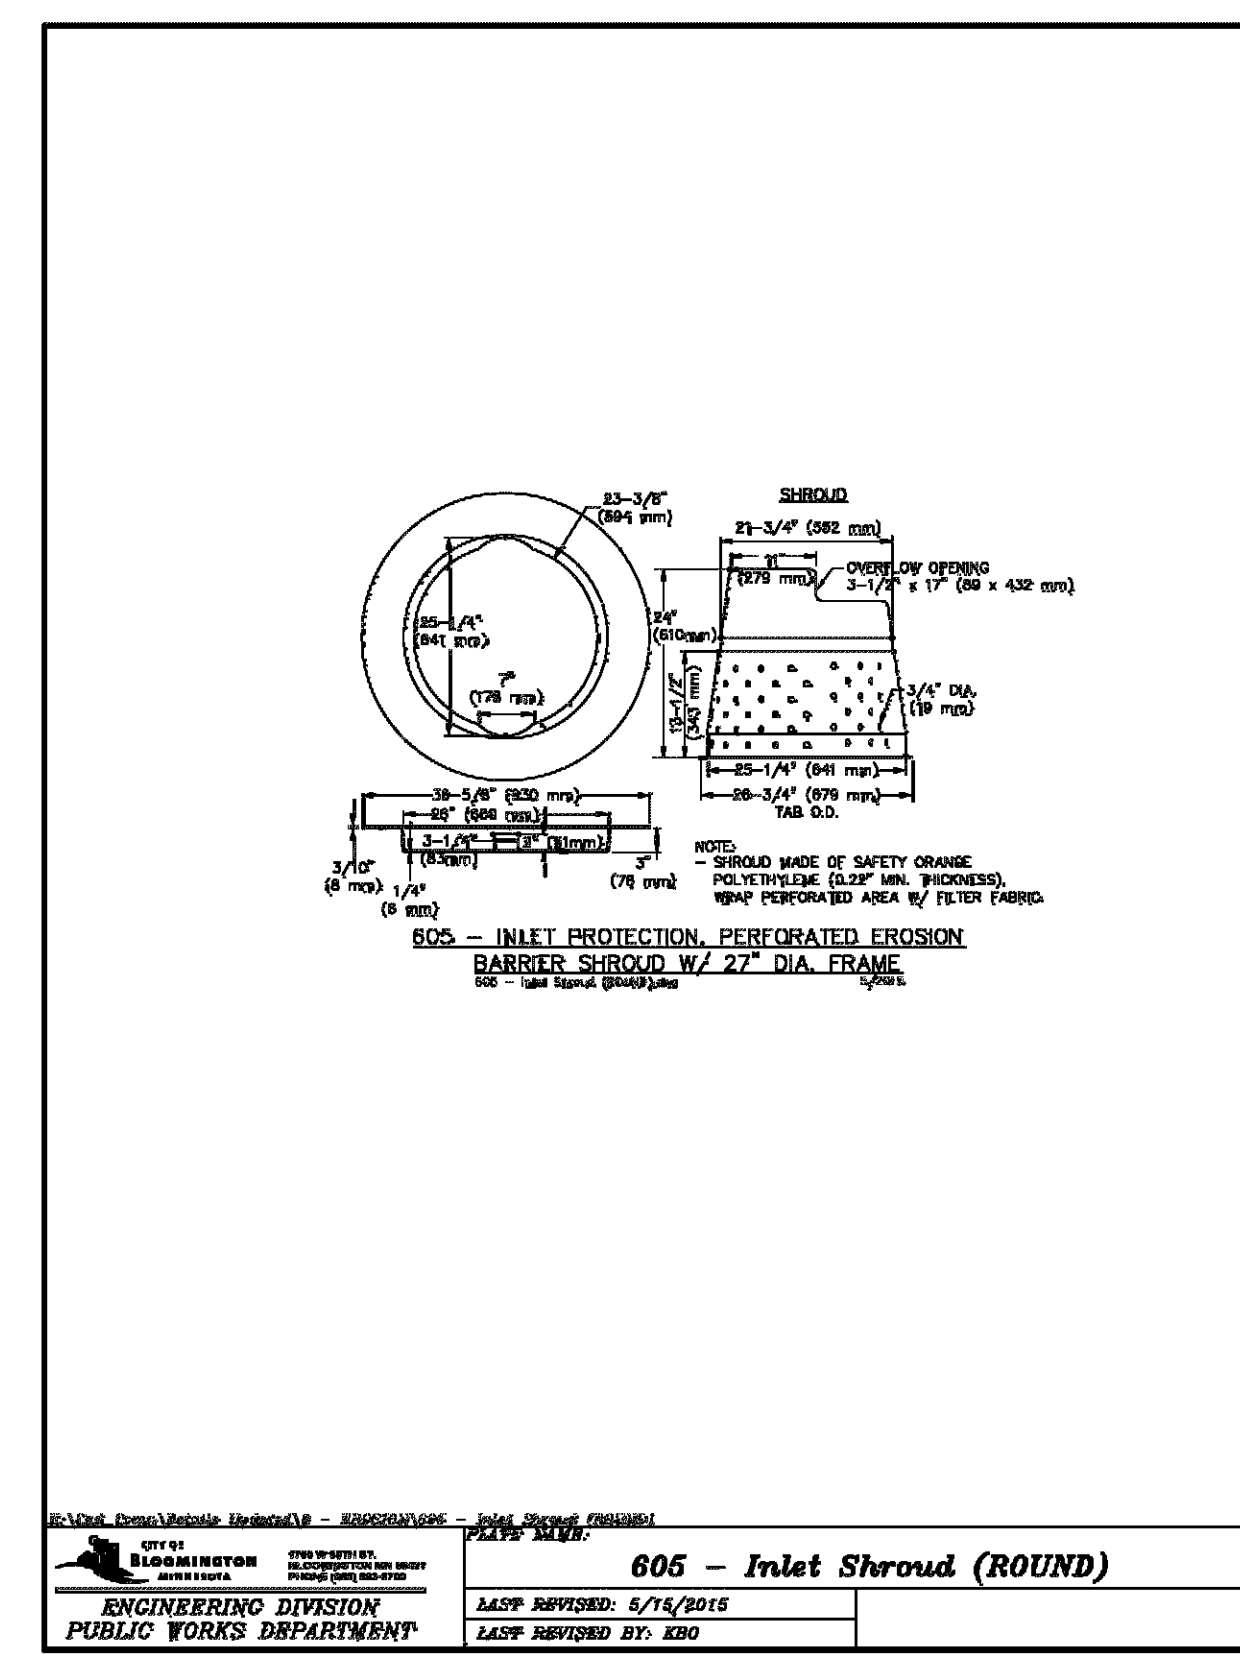

6 INLET PROTECTION
NOT TO SCALE

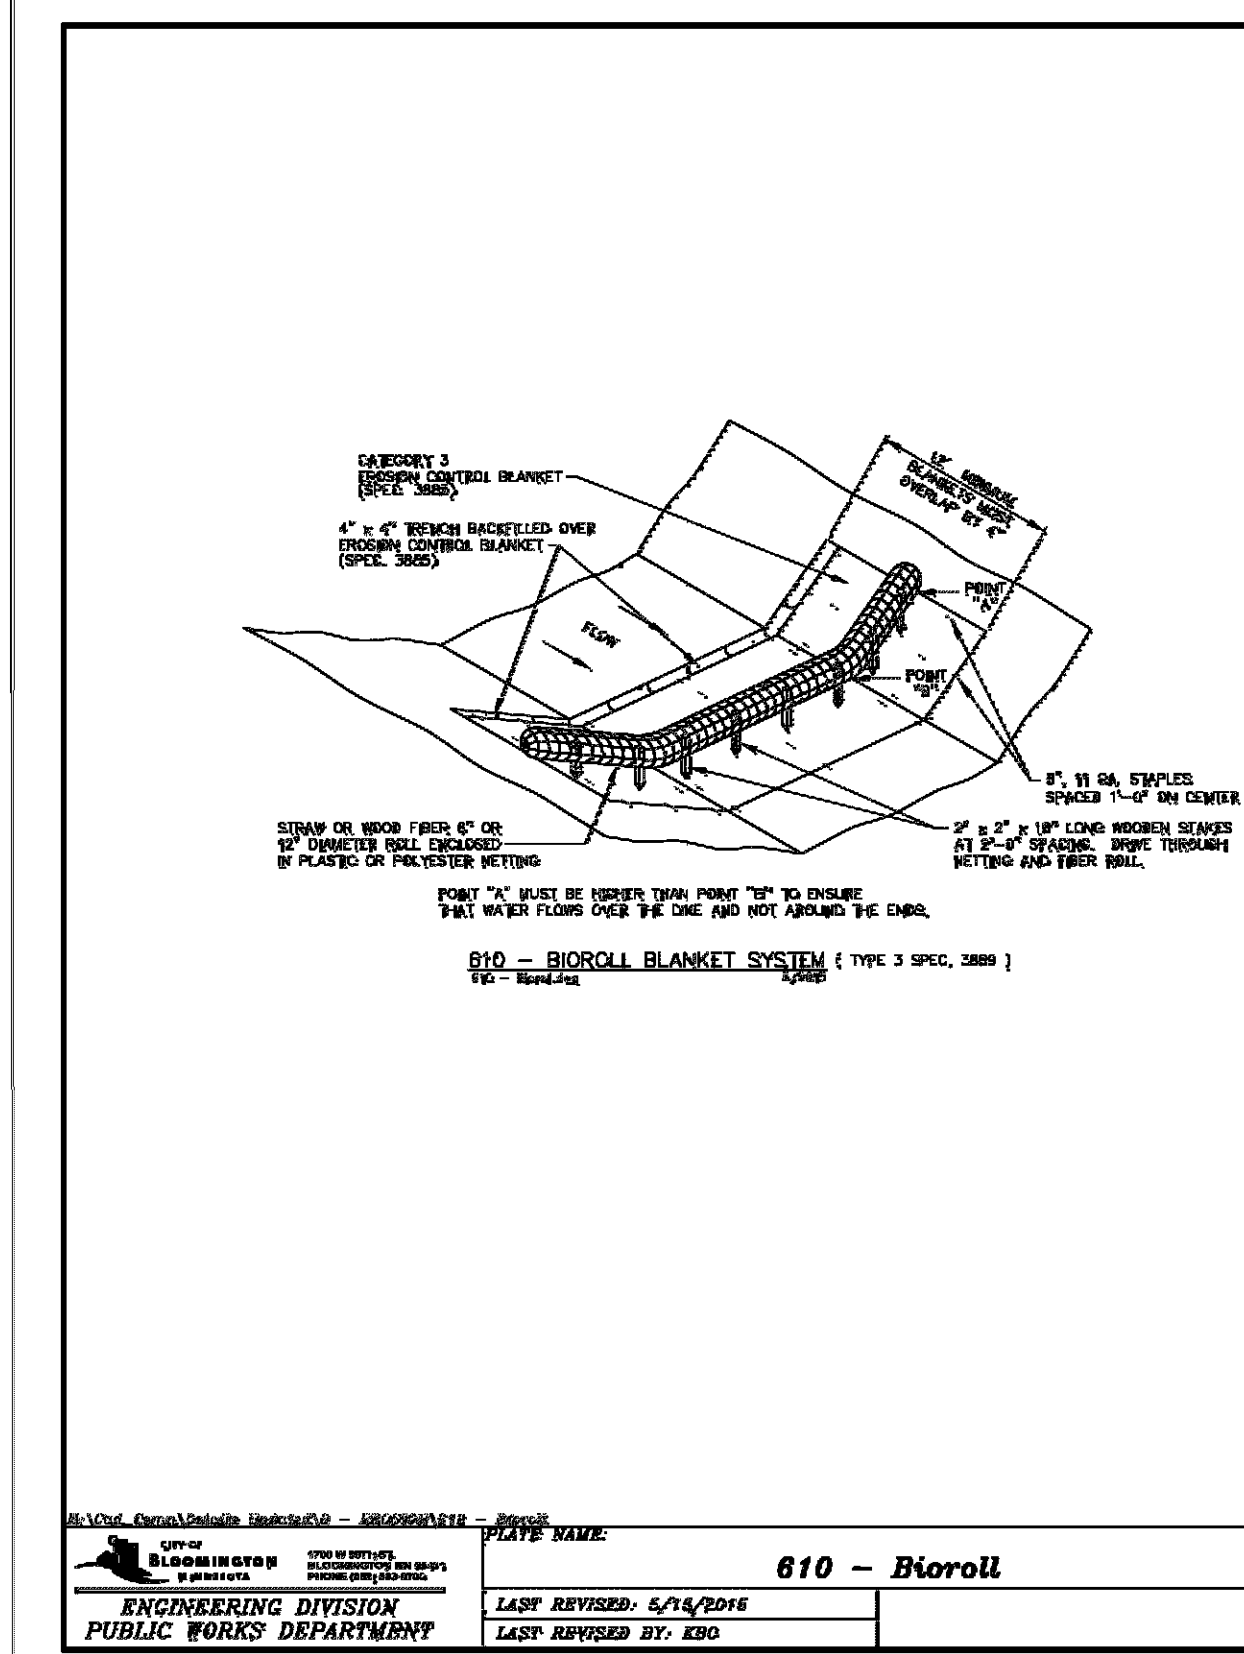

3 BIO ROLL
NOT TO SCALE

URBANWORKS

CONSULTANT

PRELIMINARY
NOT FOR CONSTRUCTION

SCHEMATIC DESIGN
CITY SUBMITTAL
10.11.2023

REVISIONS


DATE 10/11/2023
PROJECT # 23-001
PHASE SO/CITY SUBMITTAL
DRAIN BY WH
CHECKED BY STD

CIVIL DETAILS

C500.0


SR - 700 American
700 W AMERICAN BLVD / BLOOMINGTON, MN
© URBANWORKS ARCHITECTURE, LLC 2019
901 NORTH THIRD STREET, SUITE 145, MINNEAPOLIS, MN 55411

PL202300178

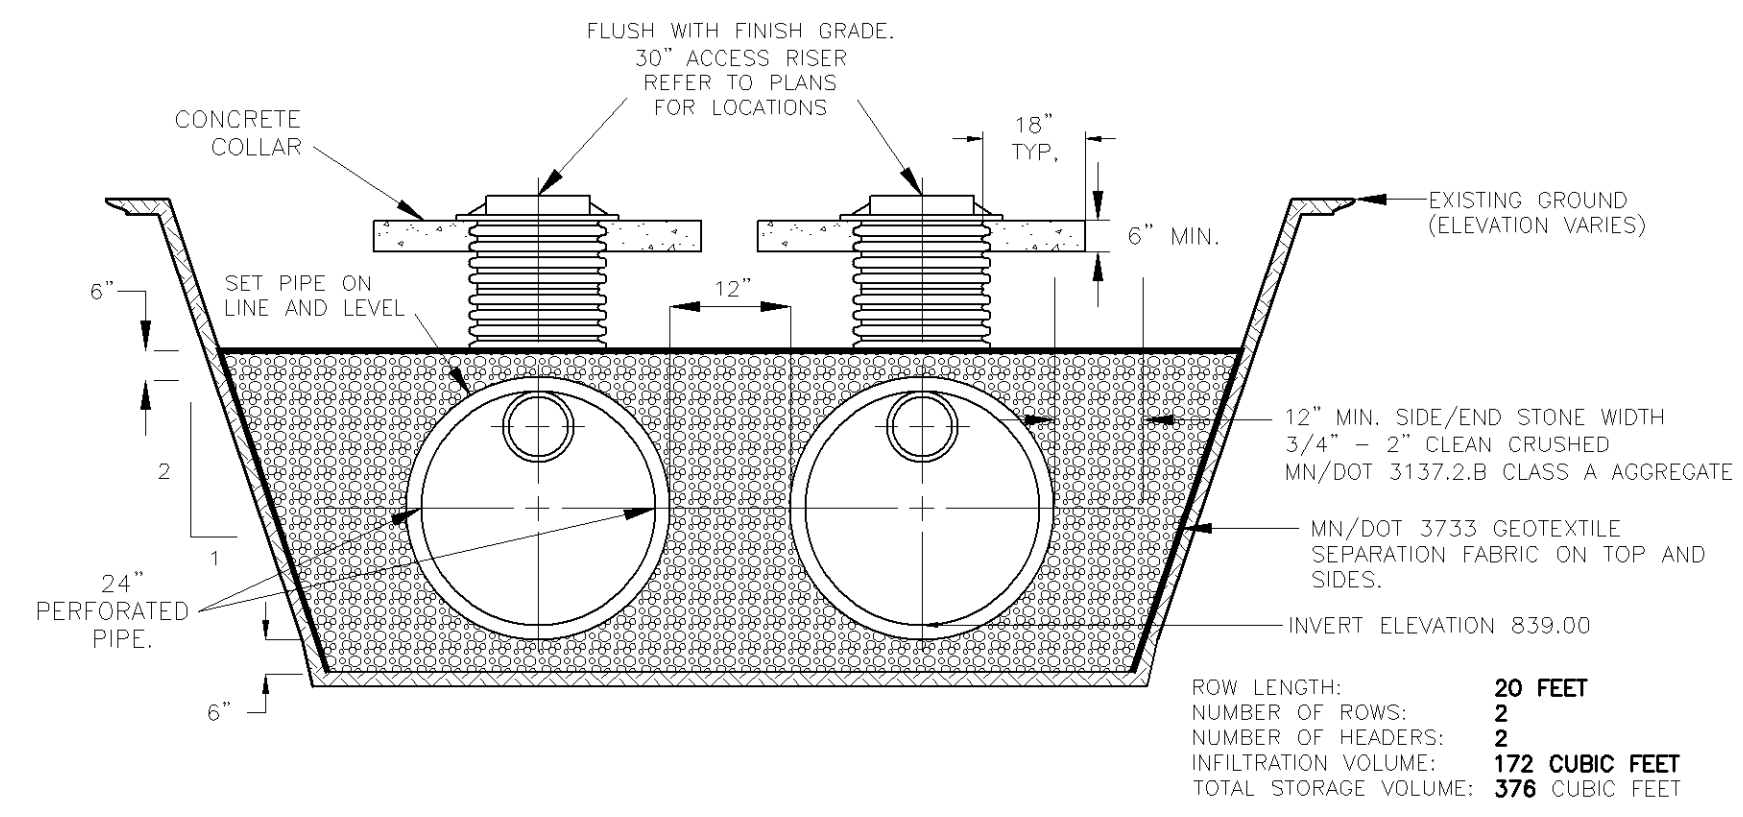


- CONTRACTOR HAS OPTION TO USE CMP OR HOPE PIPE. SYSTEM LAYOUT IS DESIGNED BASED ON CMP PIPE. ANY ALTERNATE DESIGNS MUST BE APPROVED BY CIVIL ENGINEER PRIOR TO CONSTRUCTION.
- UTILIZE CARE WHEN LOWERING UNIT INTO THE TRENCH. HANDLE USING NYLON SLINGS AND TWO PICK POINTS.
- PLACE BACKFILL AROUND THE UNIT IN UNIFORM 8"-12" LIFTS, COMPACTED TO 95% SPD.
- WHEN THE UNIT CONSISTS OF 2 SECTIONS, PLACE THE DOWNSTREAM SECTION FIRST. CONNECT AND HOME THE REMAINING SECTIONS. ALL CONNECTION POINTS ARE TO BE SOIL PROOF.
- ACCESS RISERS AND CONCRETE COLLARS SHALL BE DESIGNED TO WITHSTAND HS25 LOADING.
- PIPE SHALL BE FURNISHED WITH PERFORATIONS 3/8" IN DIAMETER AND PERFORATED FOR THE FULL 360 DEGREE CIRCUMFERENCE OF THE PIPE. MINIMUM OPEN AREA SHALL BE 2.3% OR GREATER.
- CONSTRUCTION TRAFFIC IN TANK BASIN IS NOT ALLOWED AFTER AREA HAS BEEN EXCAVATED. PRIOR TO FINAL STABILIZATION, LOOSEN SOIL WITH MECHANICAL TILLER. TANK BASINS ARE NOT APPROVED BORROW SITES AND ARE NOT TO BE USED AS TEMPORARY SEDIMENT BASIN ONCE BASIN SUBGRADE ELEVATION HAS BEEN EXCAVATED. CONTRACTOR SHALL ENSURE THAT BASIN INFILTRATES AT A MINIMUM RATE AS INDICATED ON PLAN USING A DOUBLE RING INFILTRATOR TEST BEFORE FINAL ACCEPTANCE. DOUBLE RING INFILTRATOR TEST SHALL BE SIGNED BY A REGISTERED GEOTECHNICAL ENGINEER AND SUBMITTED TO THE CITY AND ENGINEER FOR REVIEW BEFORE FINAL APPROVAL.


7 WEST INFILTRATION TANK DETAIL (C500.1) NOT TO SCALE

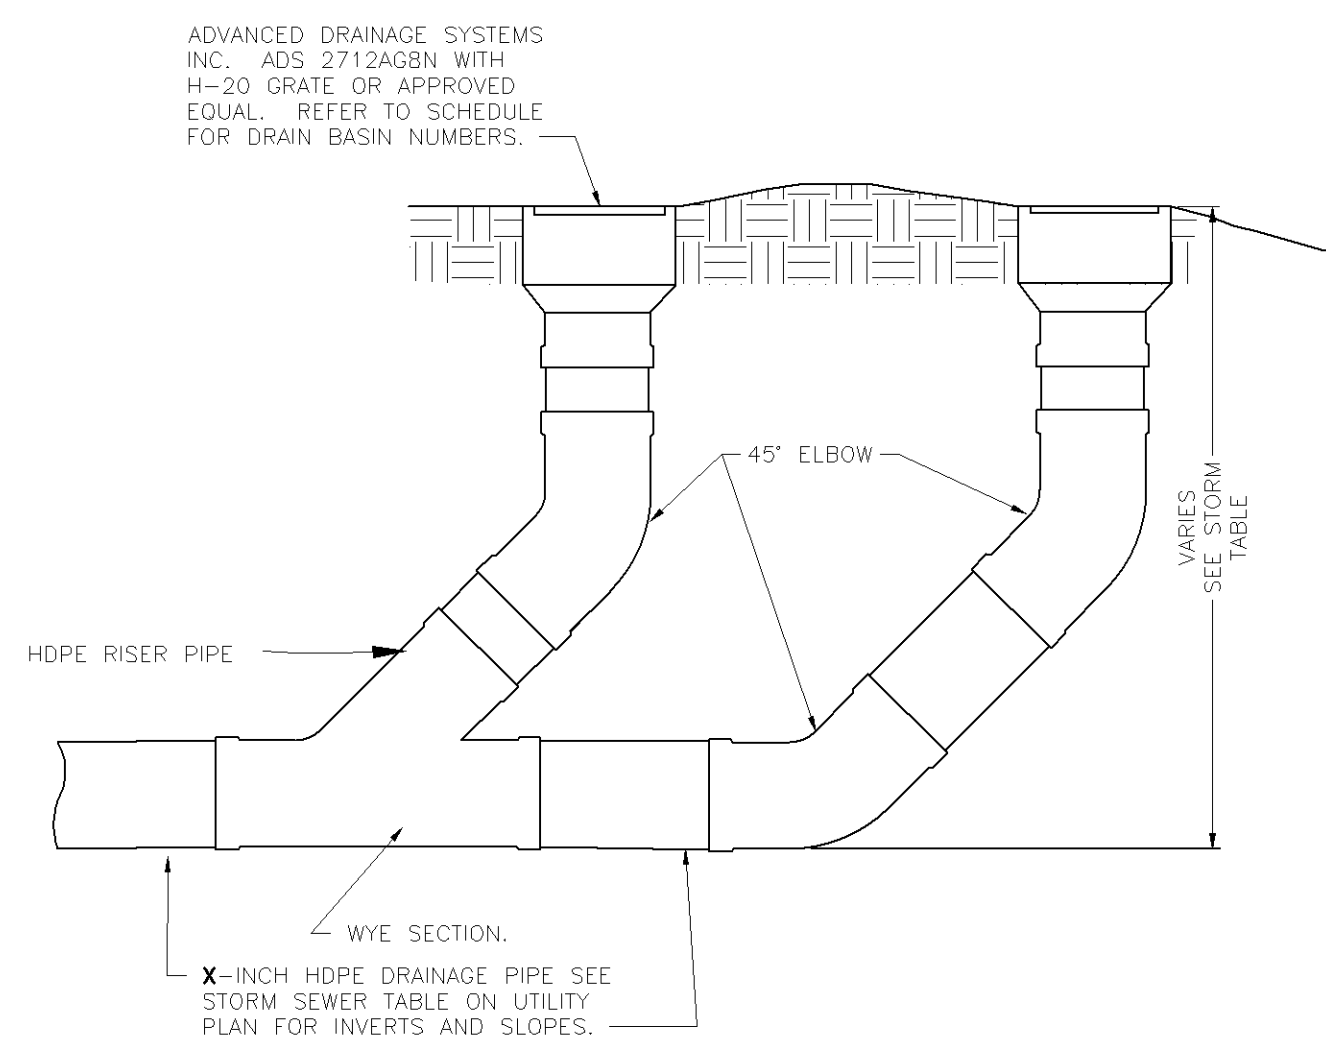

8 TYPICAL YARD DRAIN INLET PIPE (C500.1) NOT TO SCALE

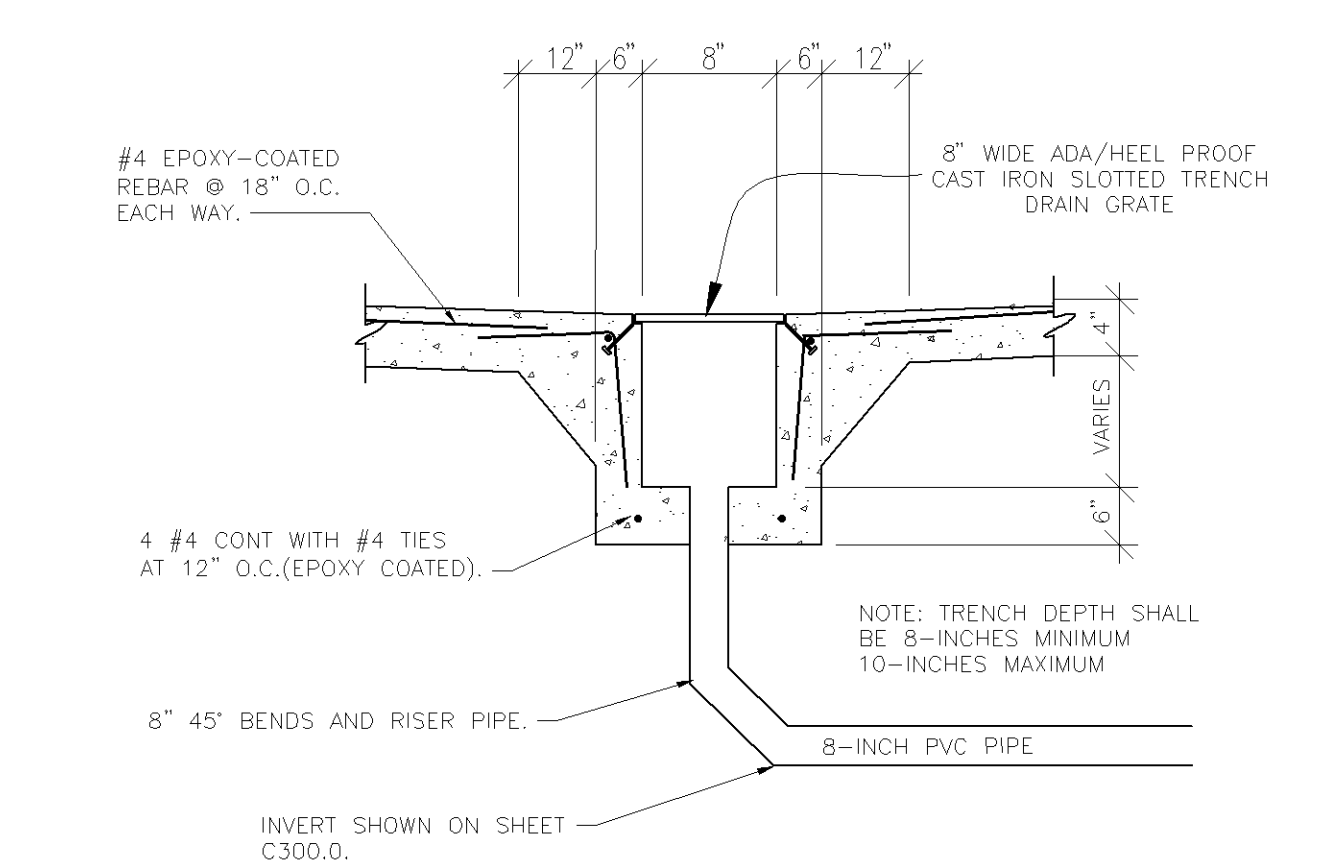


9 TRENCH DRAIN DETAIL (C500.1) NOT TO SCALE

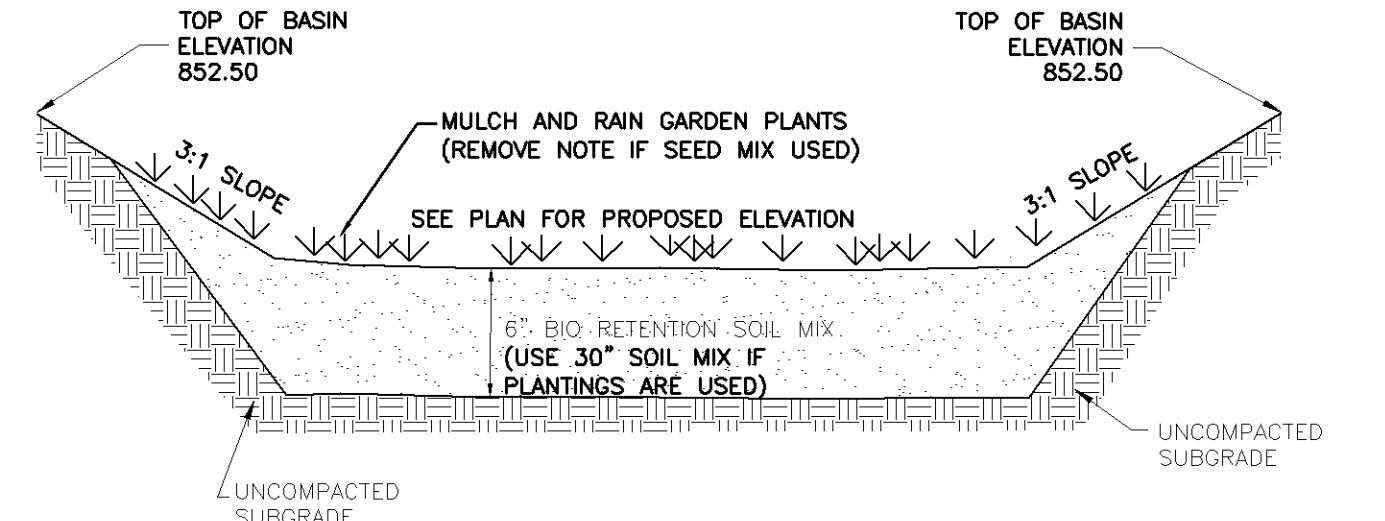


- BIORETENTION SOIL MIX:
- 85-88% SAND BY VOLUME (ASTM C33)
 - 8-12% FINES BY VOLUME (SILT AND CLAY, MAX CLAY CONTENT 5%)
 - 3-5% MV/DOT 3990 GRADE 2 COMPOST BY VOLUME
- NOTES:
- SUBMIT MIX DESIGN SHOP DRAWING FOR APPROVAL.
 - CONSTRUCTION TRAFFIC IN BASIN IS NOT ALLOWED AFTER AREA HAS BEEN EXCAVATED. PRIOR TO FINAL STABILIZATION, LOOSEN SOIL WITH MECHANICAL TILLER. BASINS ARE NOT APPROVED BORROW SITES AND ARE NOT TO BE USED AS TEMPORARY SEDIMENT BASIN ONCE BASIN SUBGRADE ELEVATION HAS BEEN EXCAVATED. CONTRACTOR SHALL ENSURE THAT BASIN INFILTRATES AT A MINIMUM RATE AS INDICATED ON PLAN USING A DOUBLE RING INFILTRATOR TEST BEFORE FINAL ACCEPTANCE. DOUBLE RING INFILTRATOR TEST SHALL BE SIGNED BY A REGISTERED GEOTECHNICAL ENGINEER AND SUBMITTED TO THE CITY AND ENGINEER FOR REVIEW BEFORE FINAL APPROVAL.
 - REFER TO LANDSCAPE ARCHITECTURAL SITE PLAN FOR RAIN GARDEN PLANTINGS. PROVIDE 3-INCHES SINGLE SHRED HARDWOOD MULCH WITH NO WEED MAT. (REMOVE SEED MIX IF USED)


10 RAIN GARDEN SECTION (C500.1) NOT TO SCALE

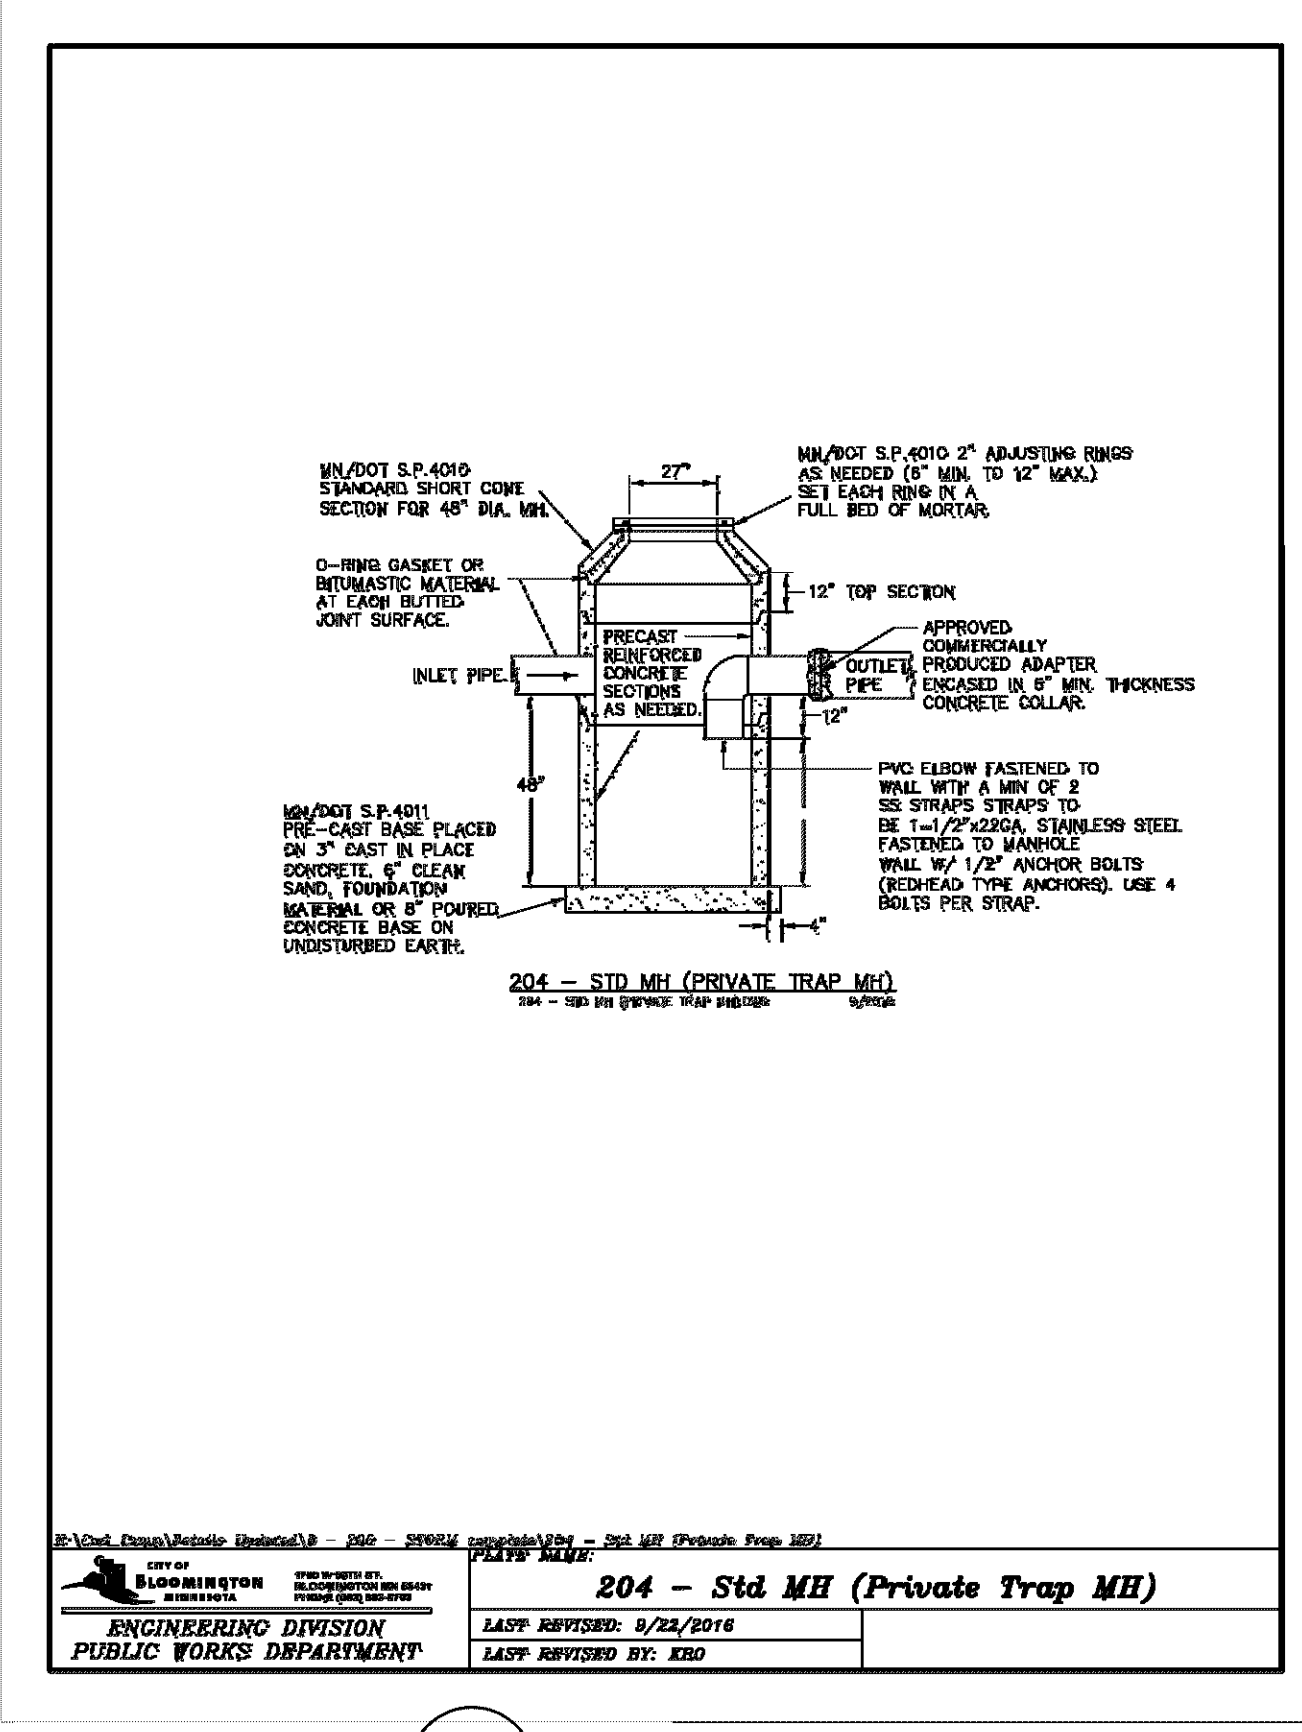

4 SUMP MANHOLE (C500.1) NOT TO SCALE

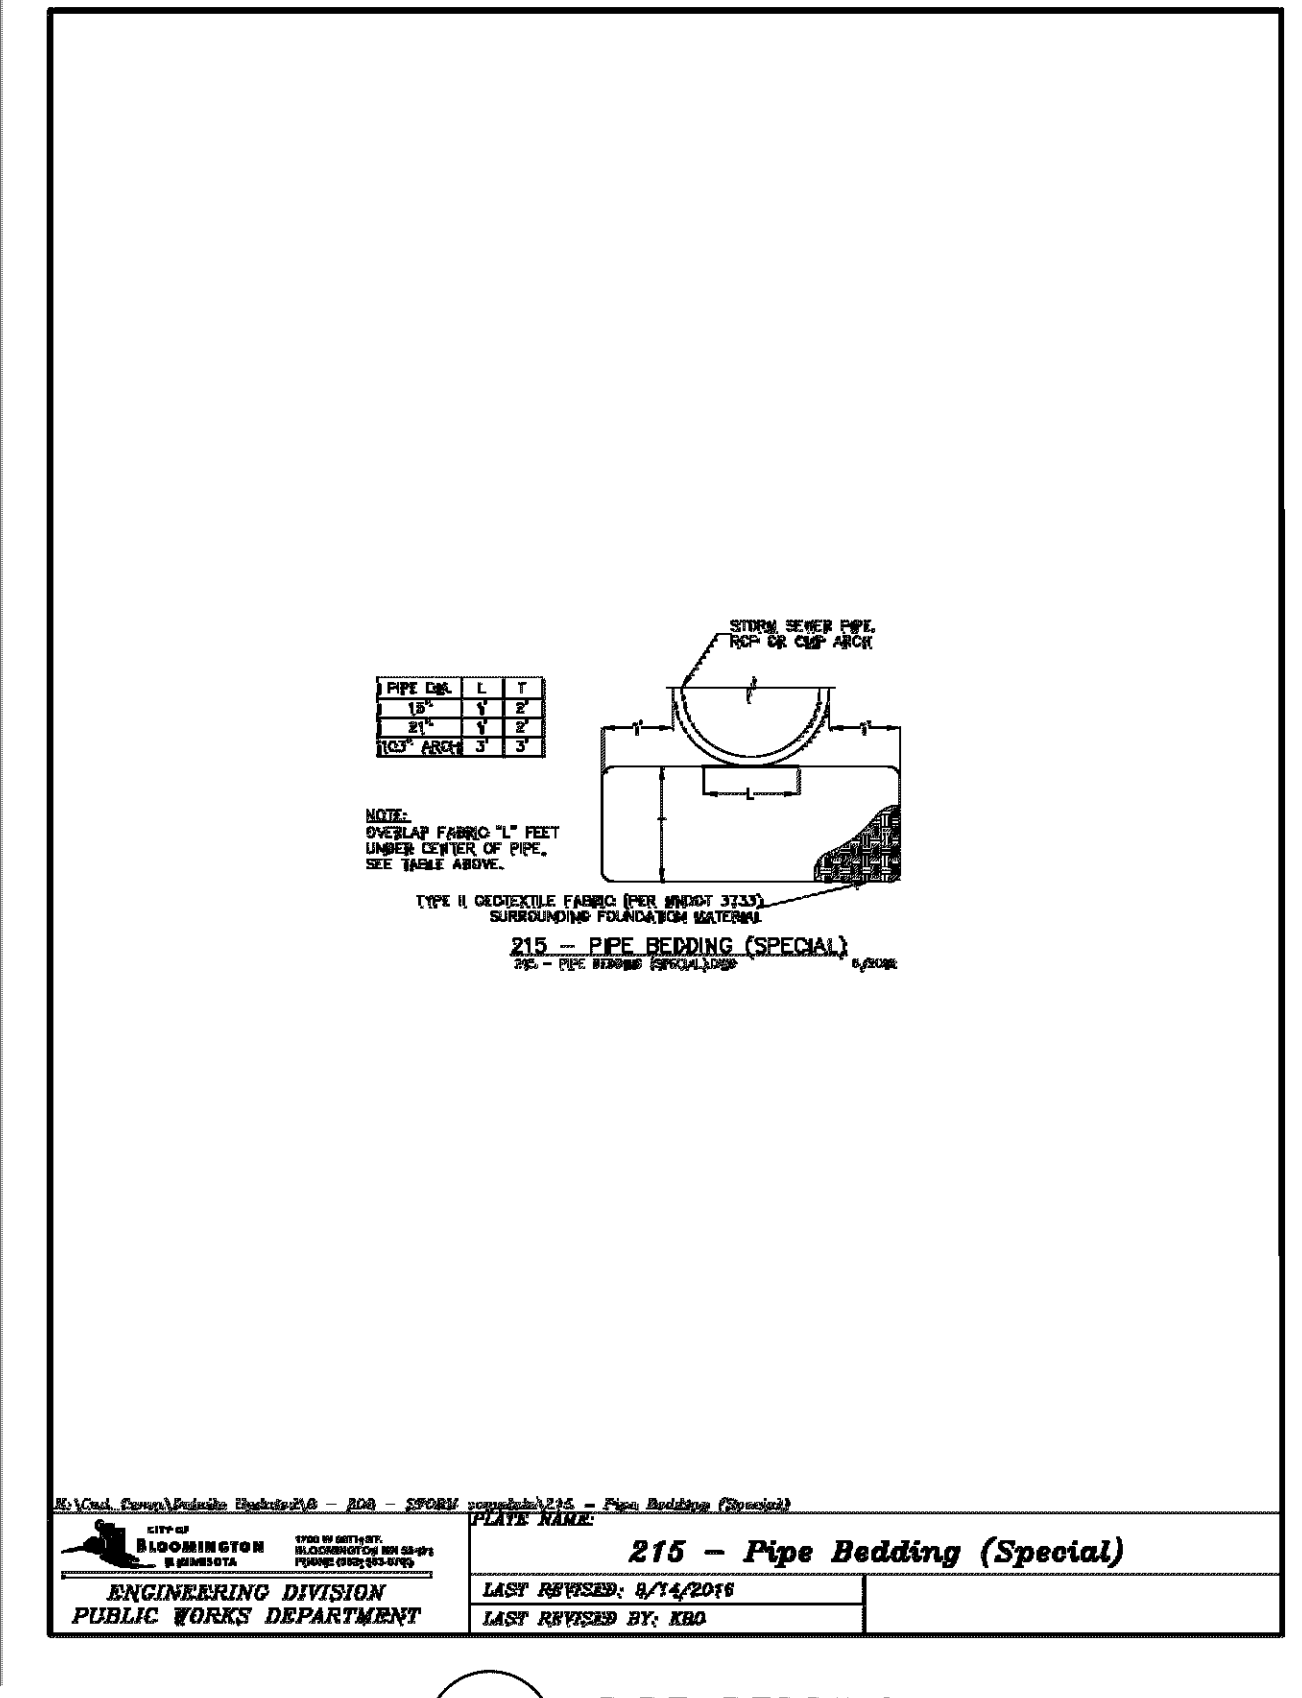


5 PIPE BEDDING (SPECIAL) (C500.1) NOT TO SCALE

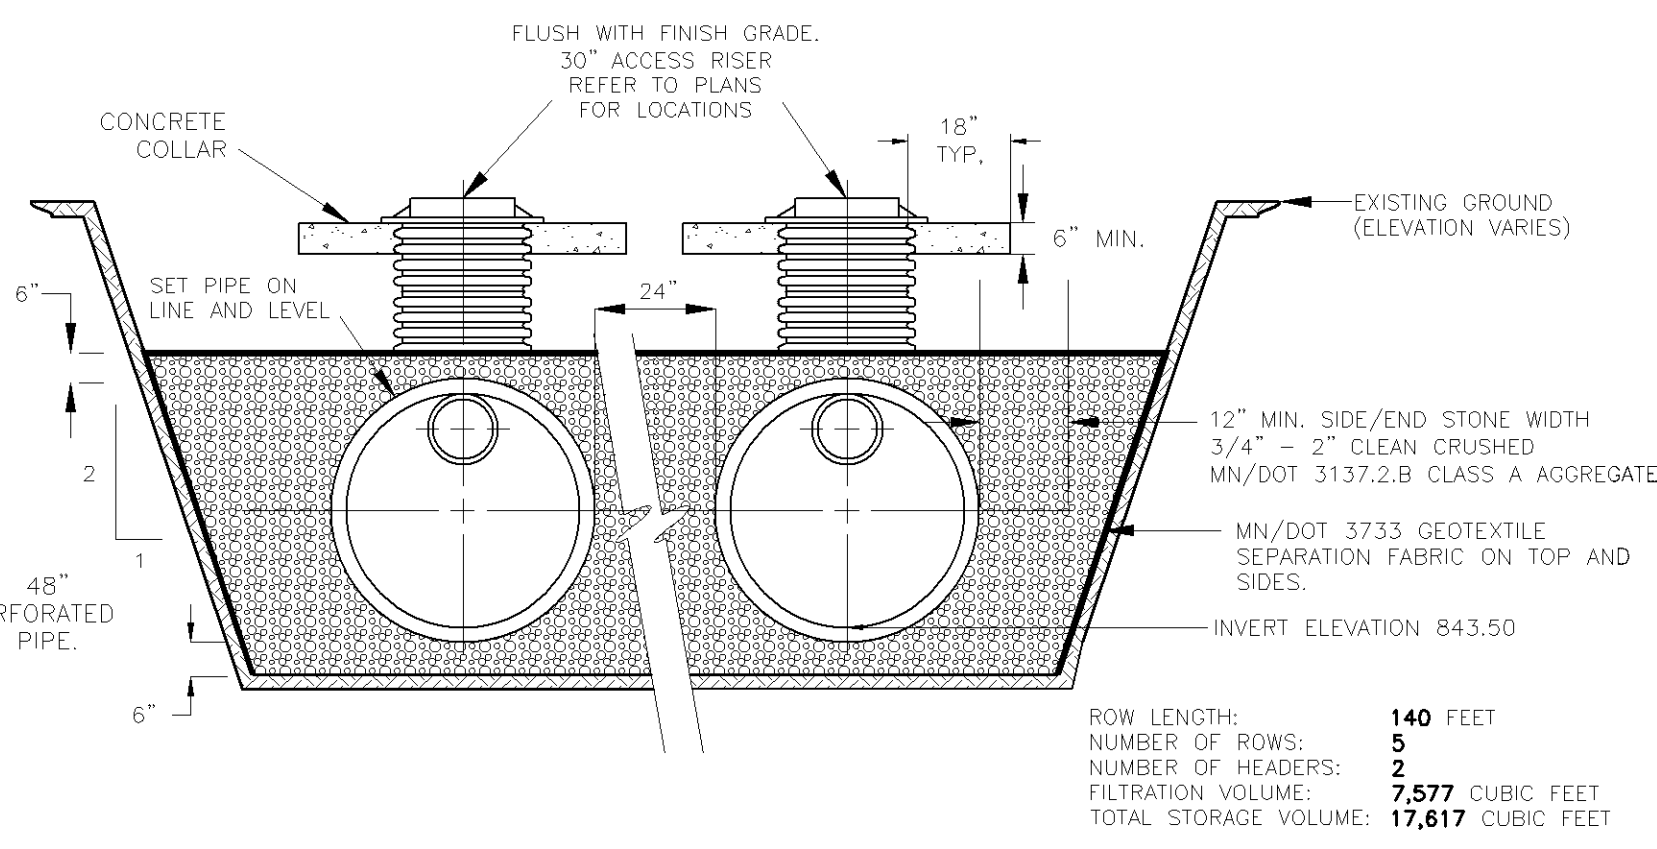


- CONTRACTOR HAS OPTION TO USE CMP OR HOPE PIPE. SYSTEM LAYOUT IS DESIGNED BASED ON CMP PIPE. ANY ALTERNATE DESIGNS MUST BE APPROVED BY CIVIL ENGINEER PRIOR TO CONSTRUCTION.
- UTILIZE CARE WHEN LOWERING UNIT INTO THE TRENCH. HANDLE USING NYLON SLINGS AND TWO PICK POINTS.
- PLACE BACKFILL AROUND THE UNIT IN UNIFORM 8"-12" LIFTS, COMPACTED TO 95% SPD.
- WHEN THE UNIT CONSISTS OF 2 SECTIONS, PLACE THE DOWNSTREAM SECTION FIRST. CONNECT AND HOME THE REMAINING SECTIONS. ALL CONNECTION POINTS ARE TO BE SOIL PROOF.
- ACCESS RISERS AND CONCRETE COLLARS SHALL BE DESIGNED TO WITHSTAND HS25 LOADING.
- PIPE SHALL BE FURNISHED WITH PERFORATIONS 3/8" IN DIAMETER AND PERFORATED FOR THE FULL 360 DEGREE CIRCUMFERENCE OF THE PIPE. MINIMUM OPEN AREA SHALL BE 2.3% OR GREATER.
- CONSTRUCTION TRAFFIC IN TANK BASIN IS NOT ALLOWED AFTER AREA HAS BEEN EXCAVATED. PRIOR TO FINAL STABILIZATION, LOOSEN SOIL WITH MECHANICAL TILLER. TANK BASINS ARE NOT APPROVED BORROW SITES AND ARE NOT TO BE USED AS TEMPORARY SEDIMENT BASIN ONCE BASIN SUBGRADE ELEVATION HAS BEEN EXCAVATED. CONTRACTOR SHALL ENSURE THAT BASIN INFILTRATES AT A MINIMUM RATE AS INDICATED ON PLAN USING A DOUBLE RING INFILTRATOR TEST BEFORE FINAL ACCEPTANCE. DOUBLE RING INFILTRATOR TEST SHALL BE SIGNED BY A REGISTERED GEOTECHNICAL ENGINEER AND SUBMITTED TO THE CITY AND ENGINEER FOR REVIEW BEFORE FINAL APPROVAL.


6 FAST INFILTRATION TANK DETAIL (C500.1) NOT TO SCALE

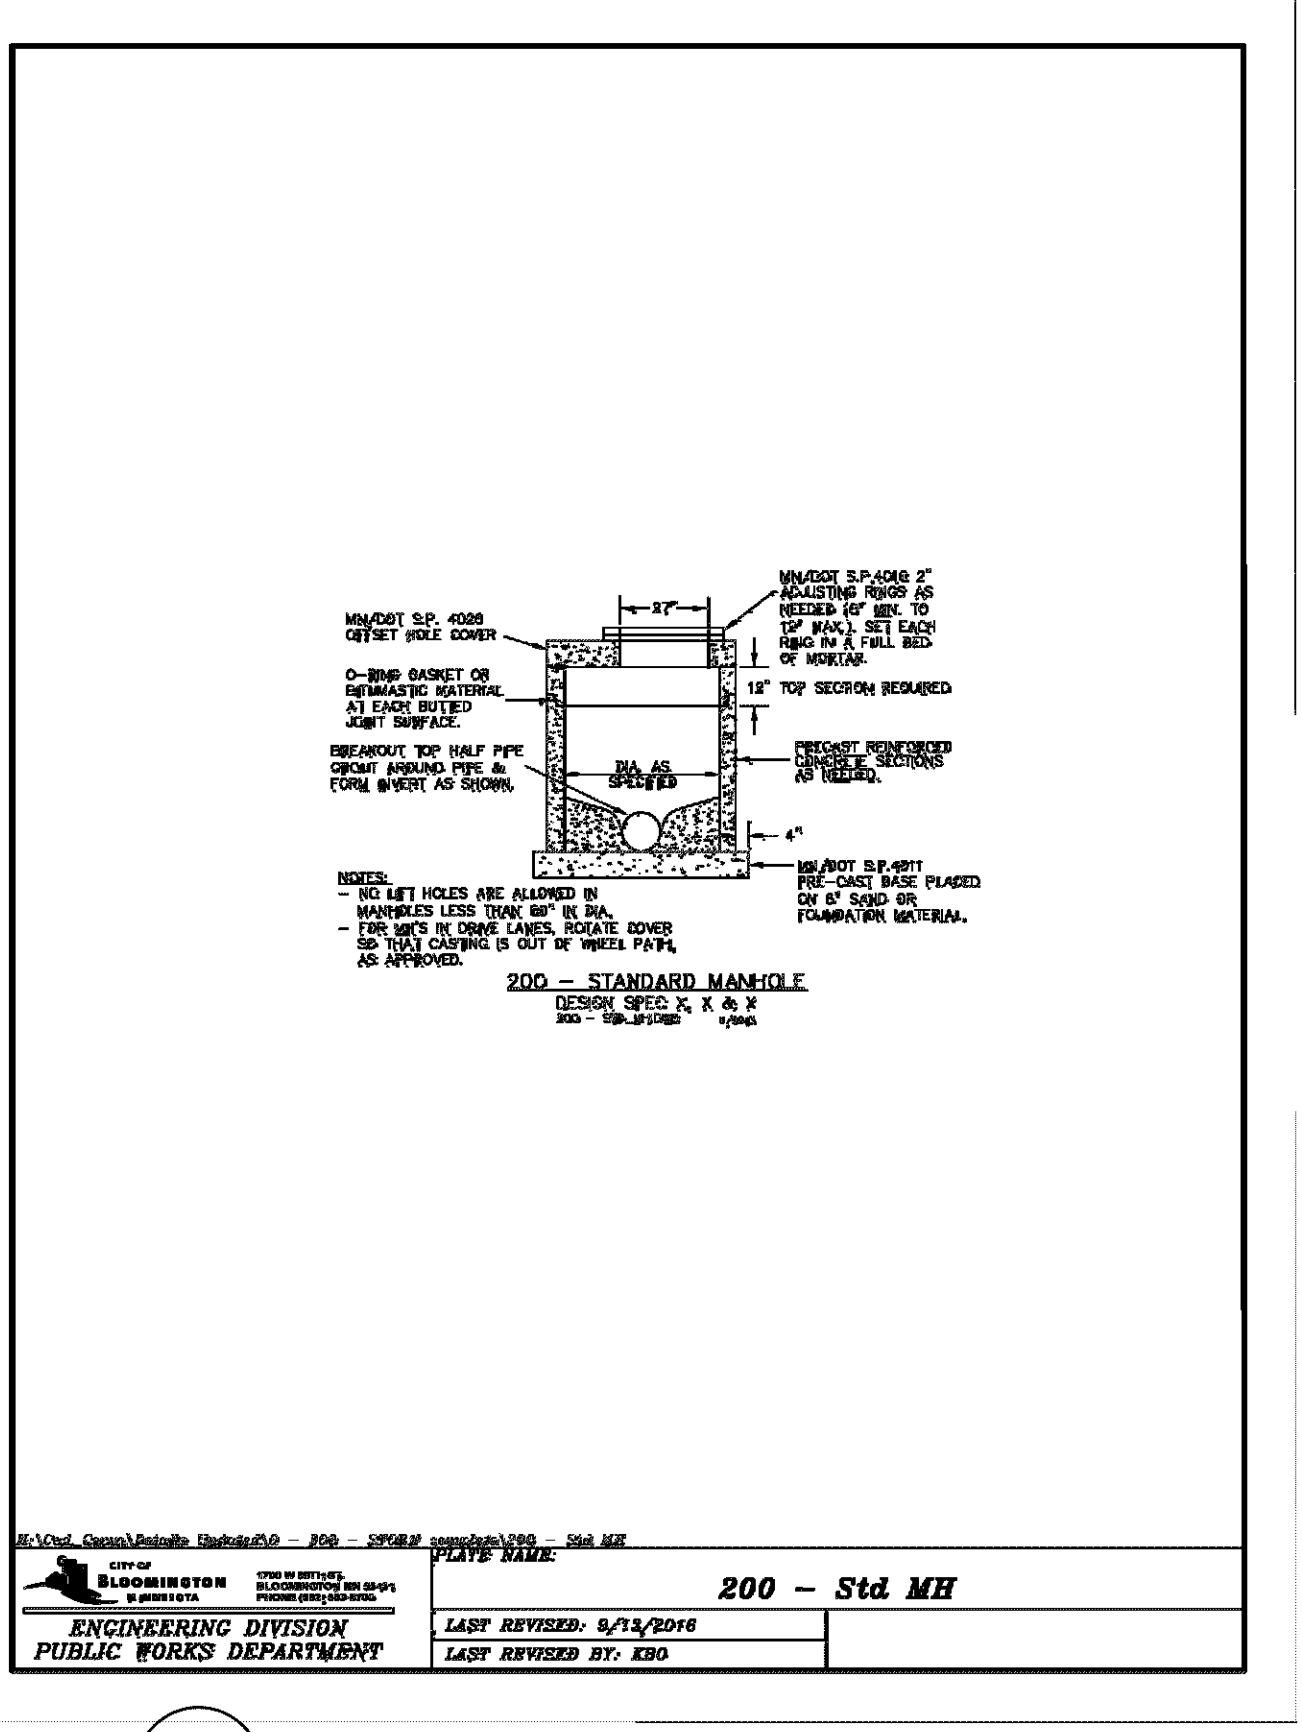

1 STANDARD STORM SEWER MANHOLE (C500.1) NOT TO SCALE

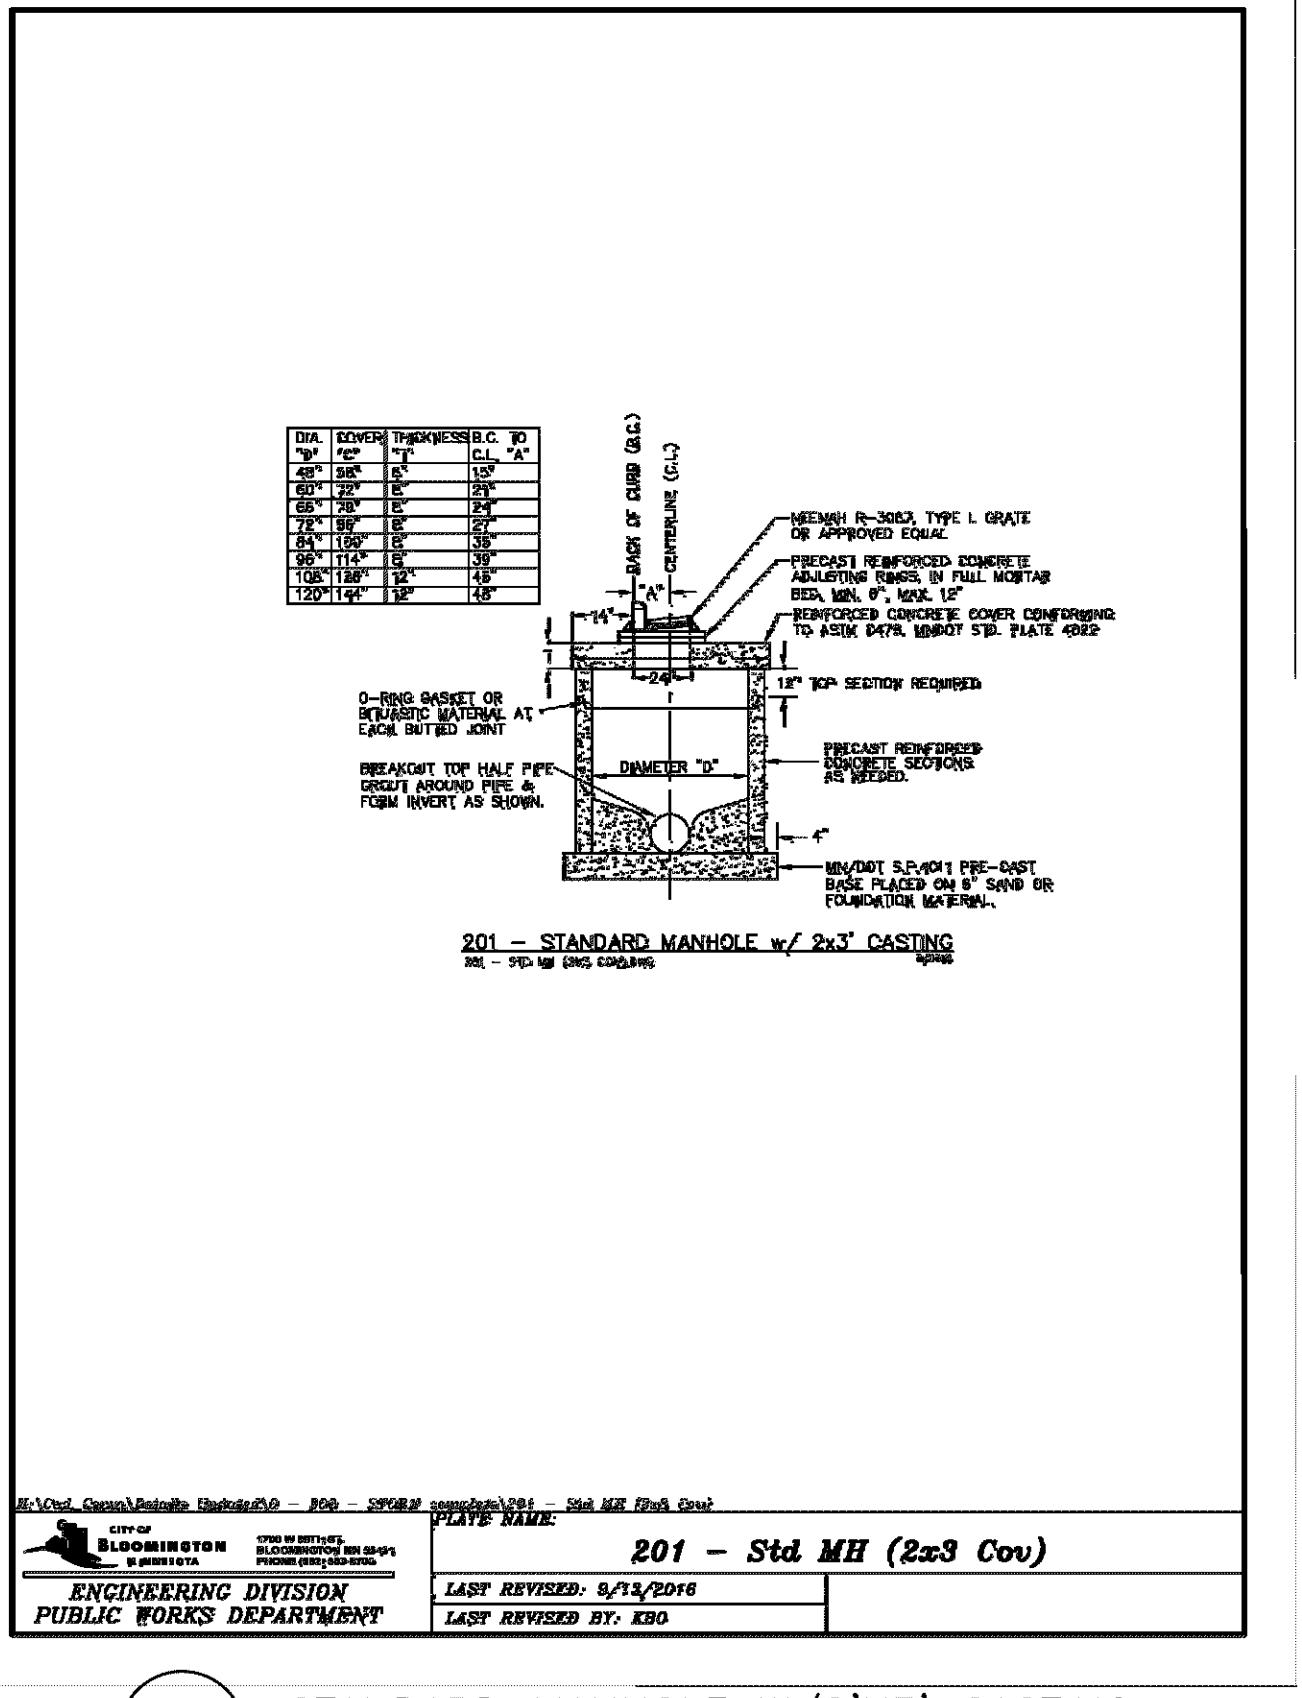

2 STANDARD MANHOLE W/ 2'X3' CASTING (C500.1) NOT TO SCALE

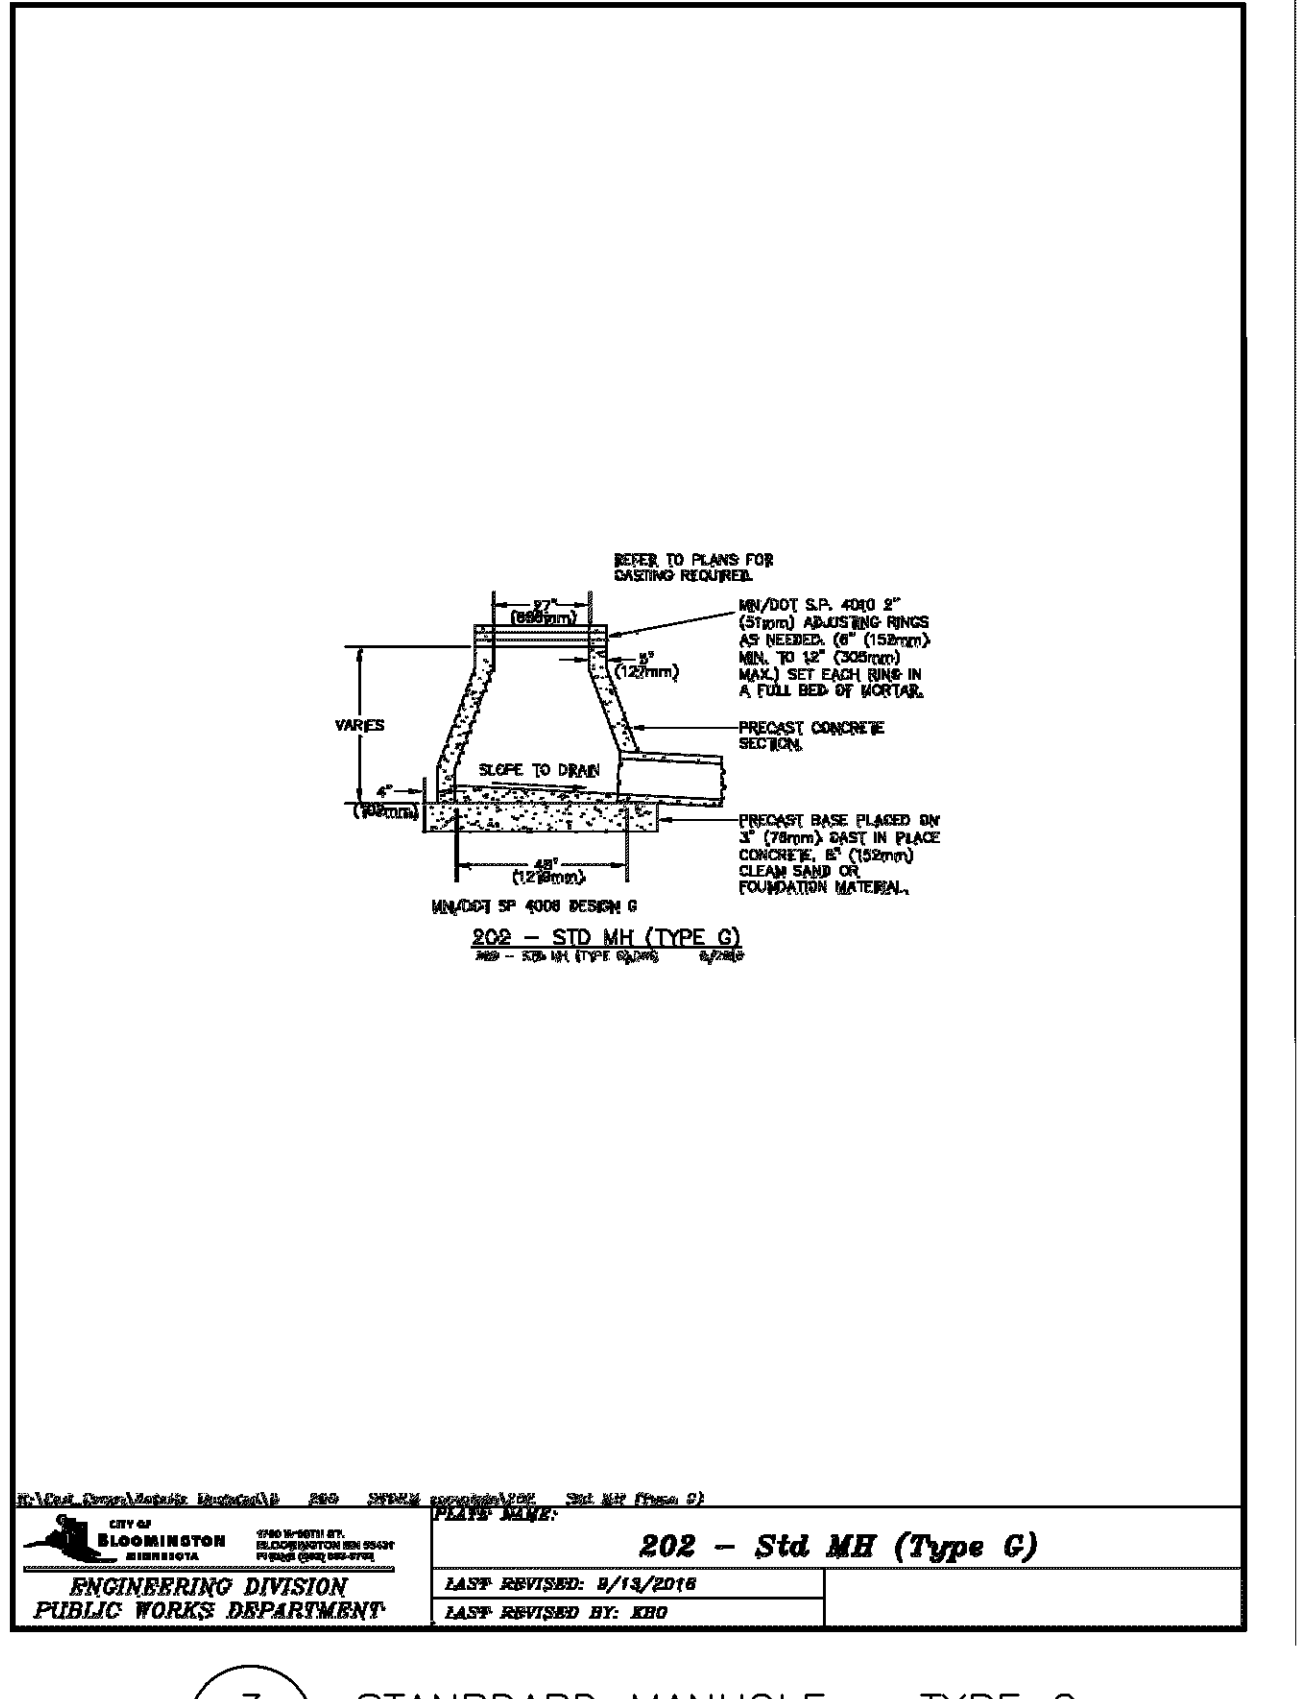

3 STANDARD MANHOLE - TYPE G (C500.1) NOT TO SCALE

SR - 700 American
700 W AMERICAN BLVD / BLOOMINGTON, MN

URBANWORKS
URBANWORKS ARCHITECTURE, LLC 2019
901 NORTH THIRD STREET, SUITE 145, MINNEAPOLIS, MN 55411

CONSULTANT

PRELIMINARY
NOT FOR CONSTRUCTION



SCHEMATIC DESIGN
CITY SUBMITTAL
10.11.2023

REVISIONS

DATE 10/11/2023
PROJECT # 23-001
PHASE SO/CITY SUBMITTAL
DRAWN BY WH
CHECKED BY STD

CIVIL DETAILS

C500.1

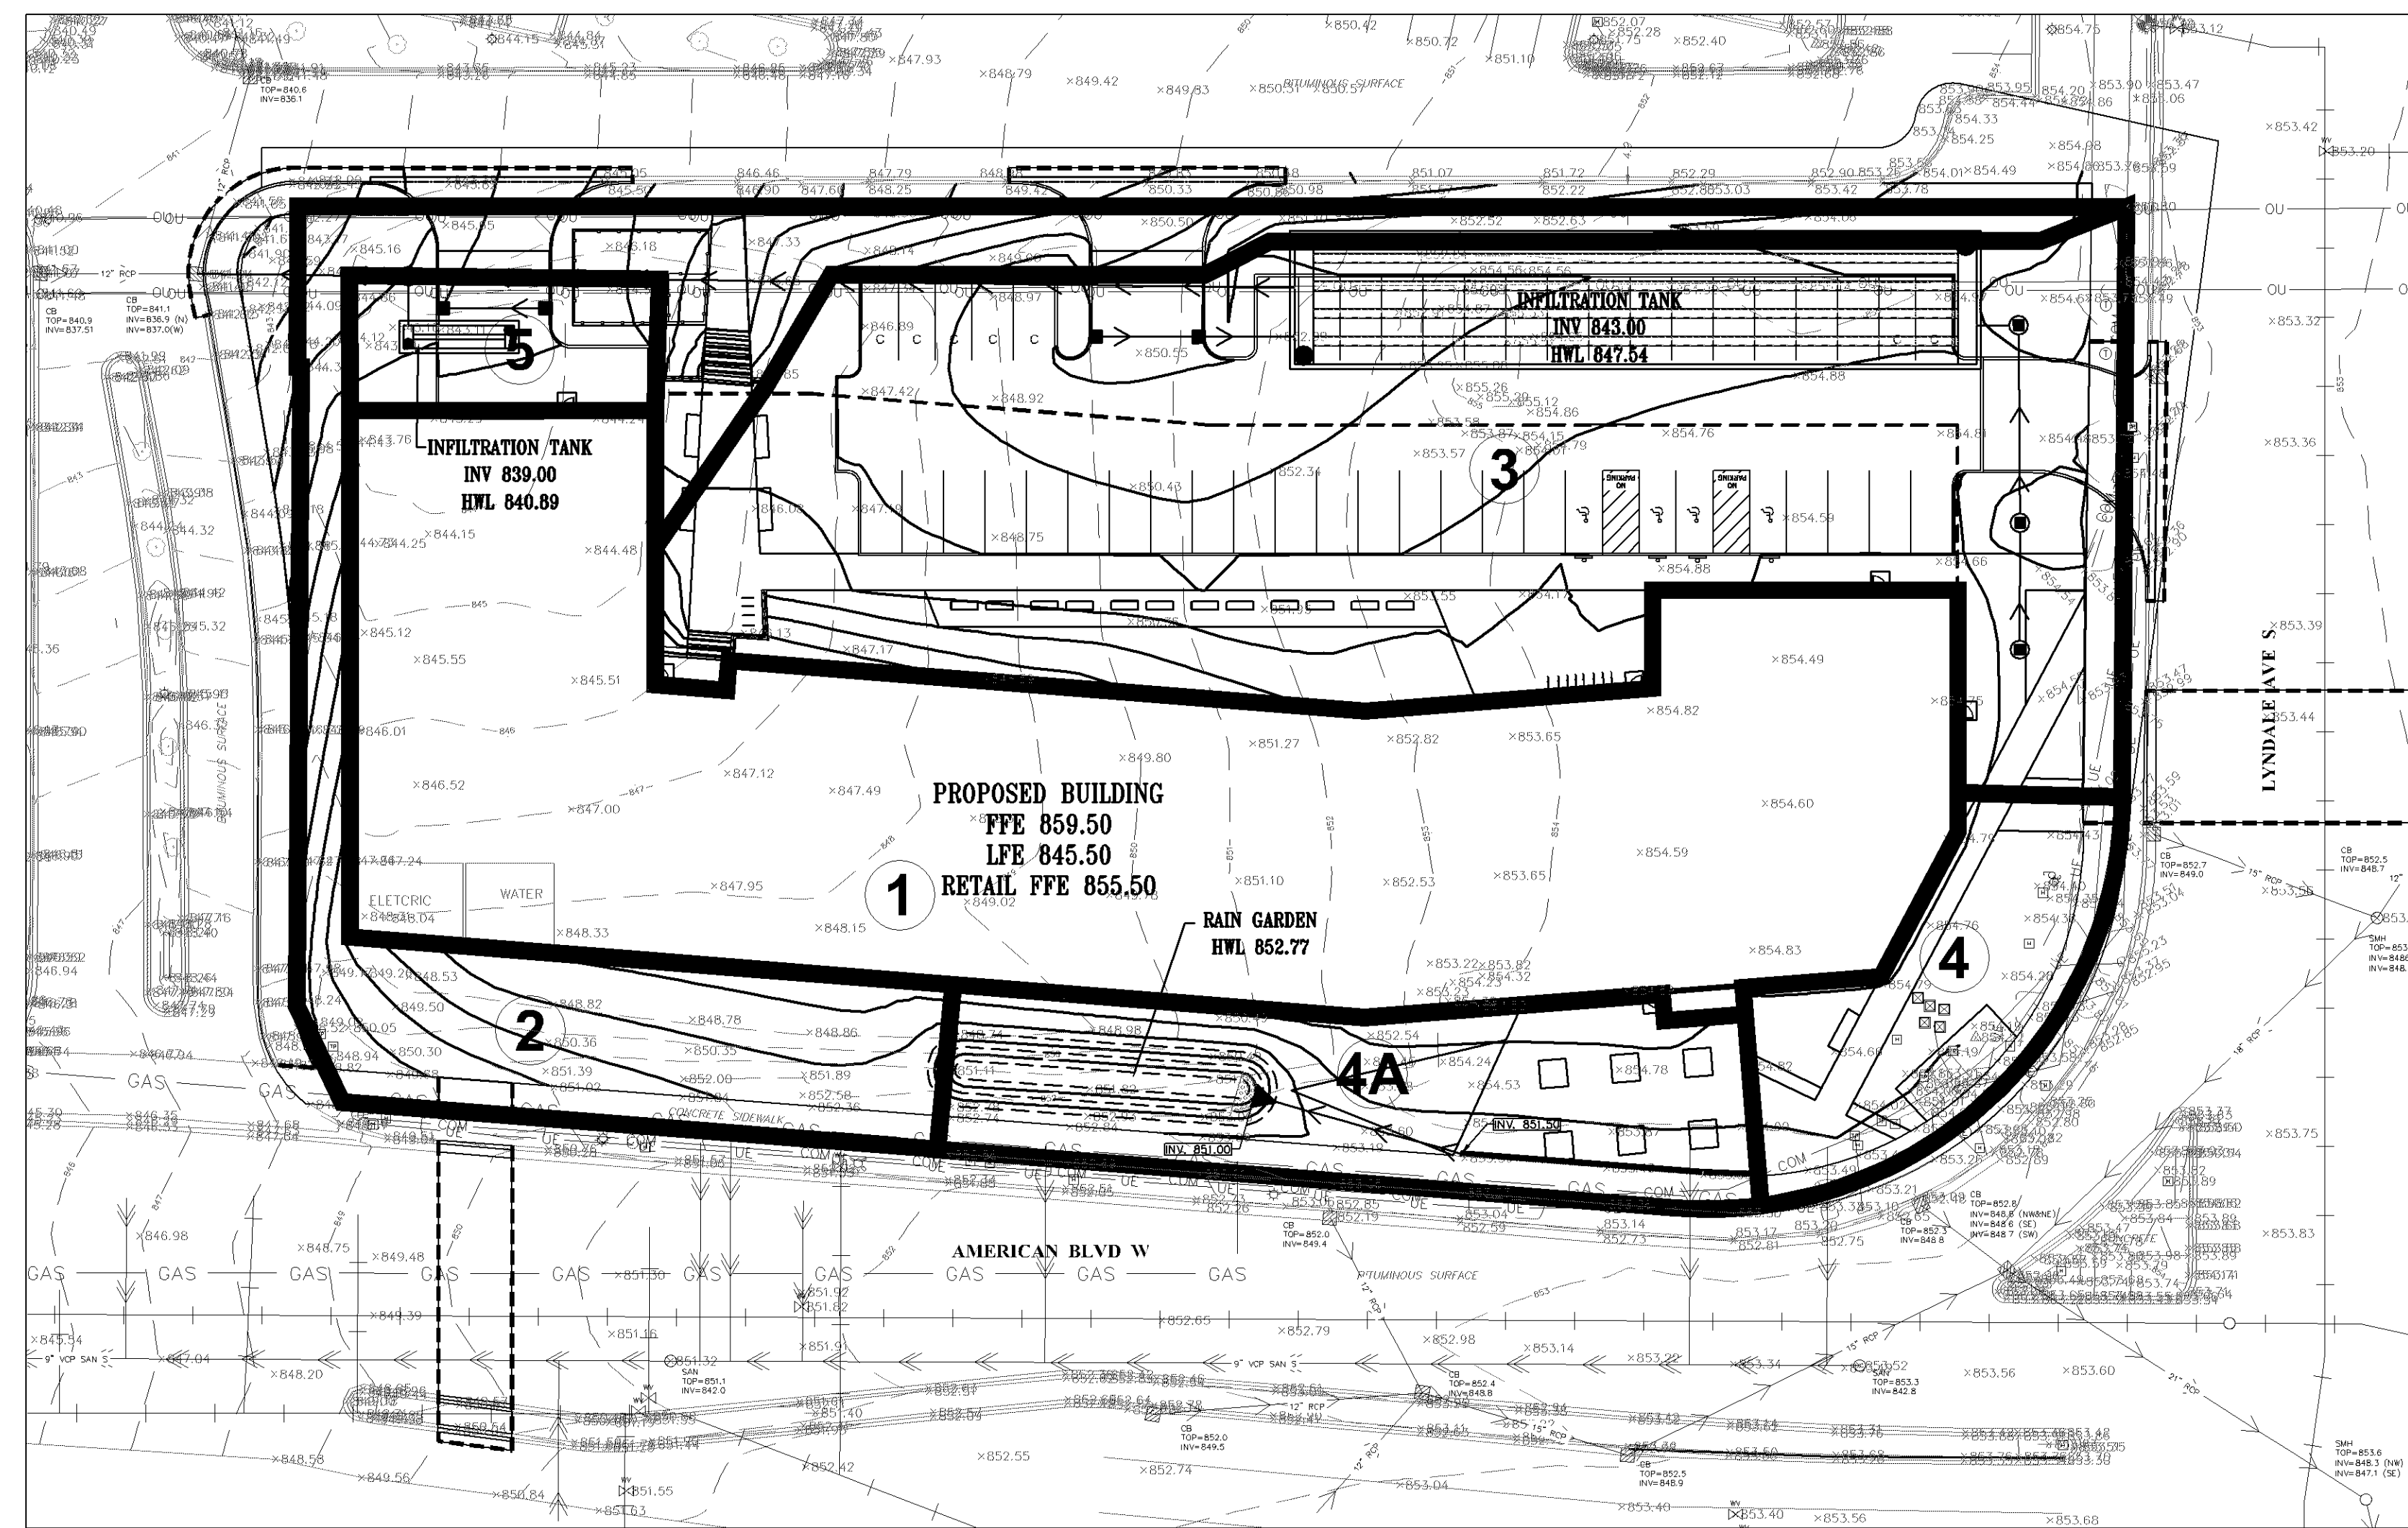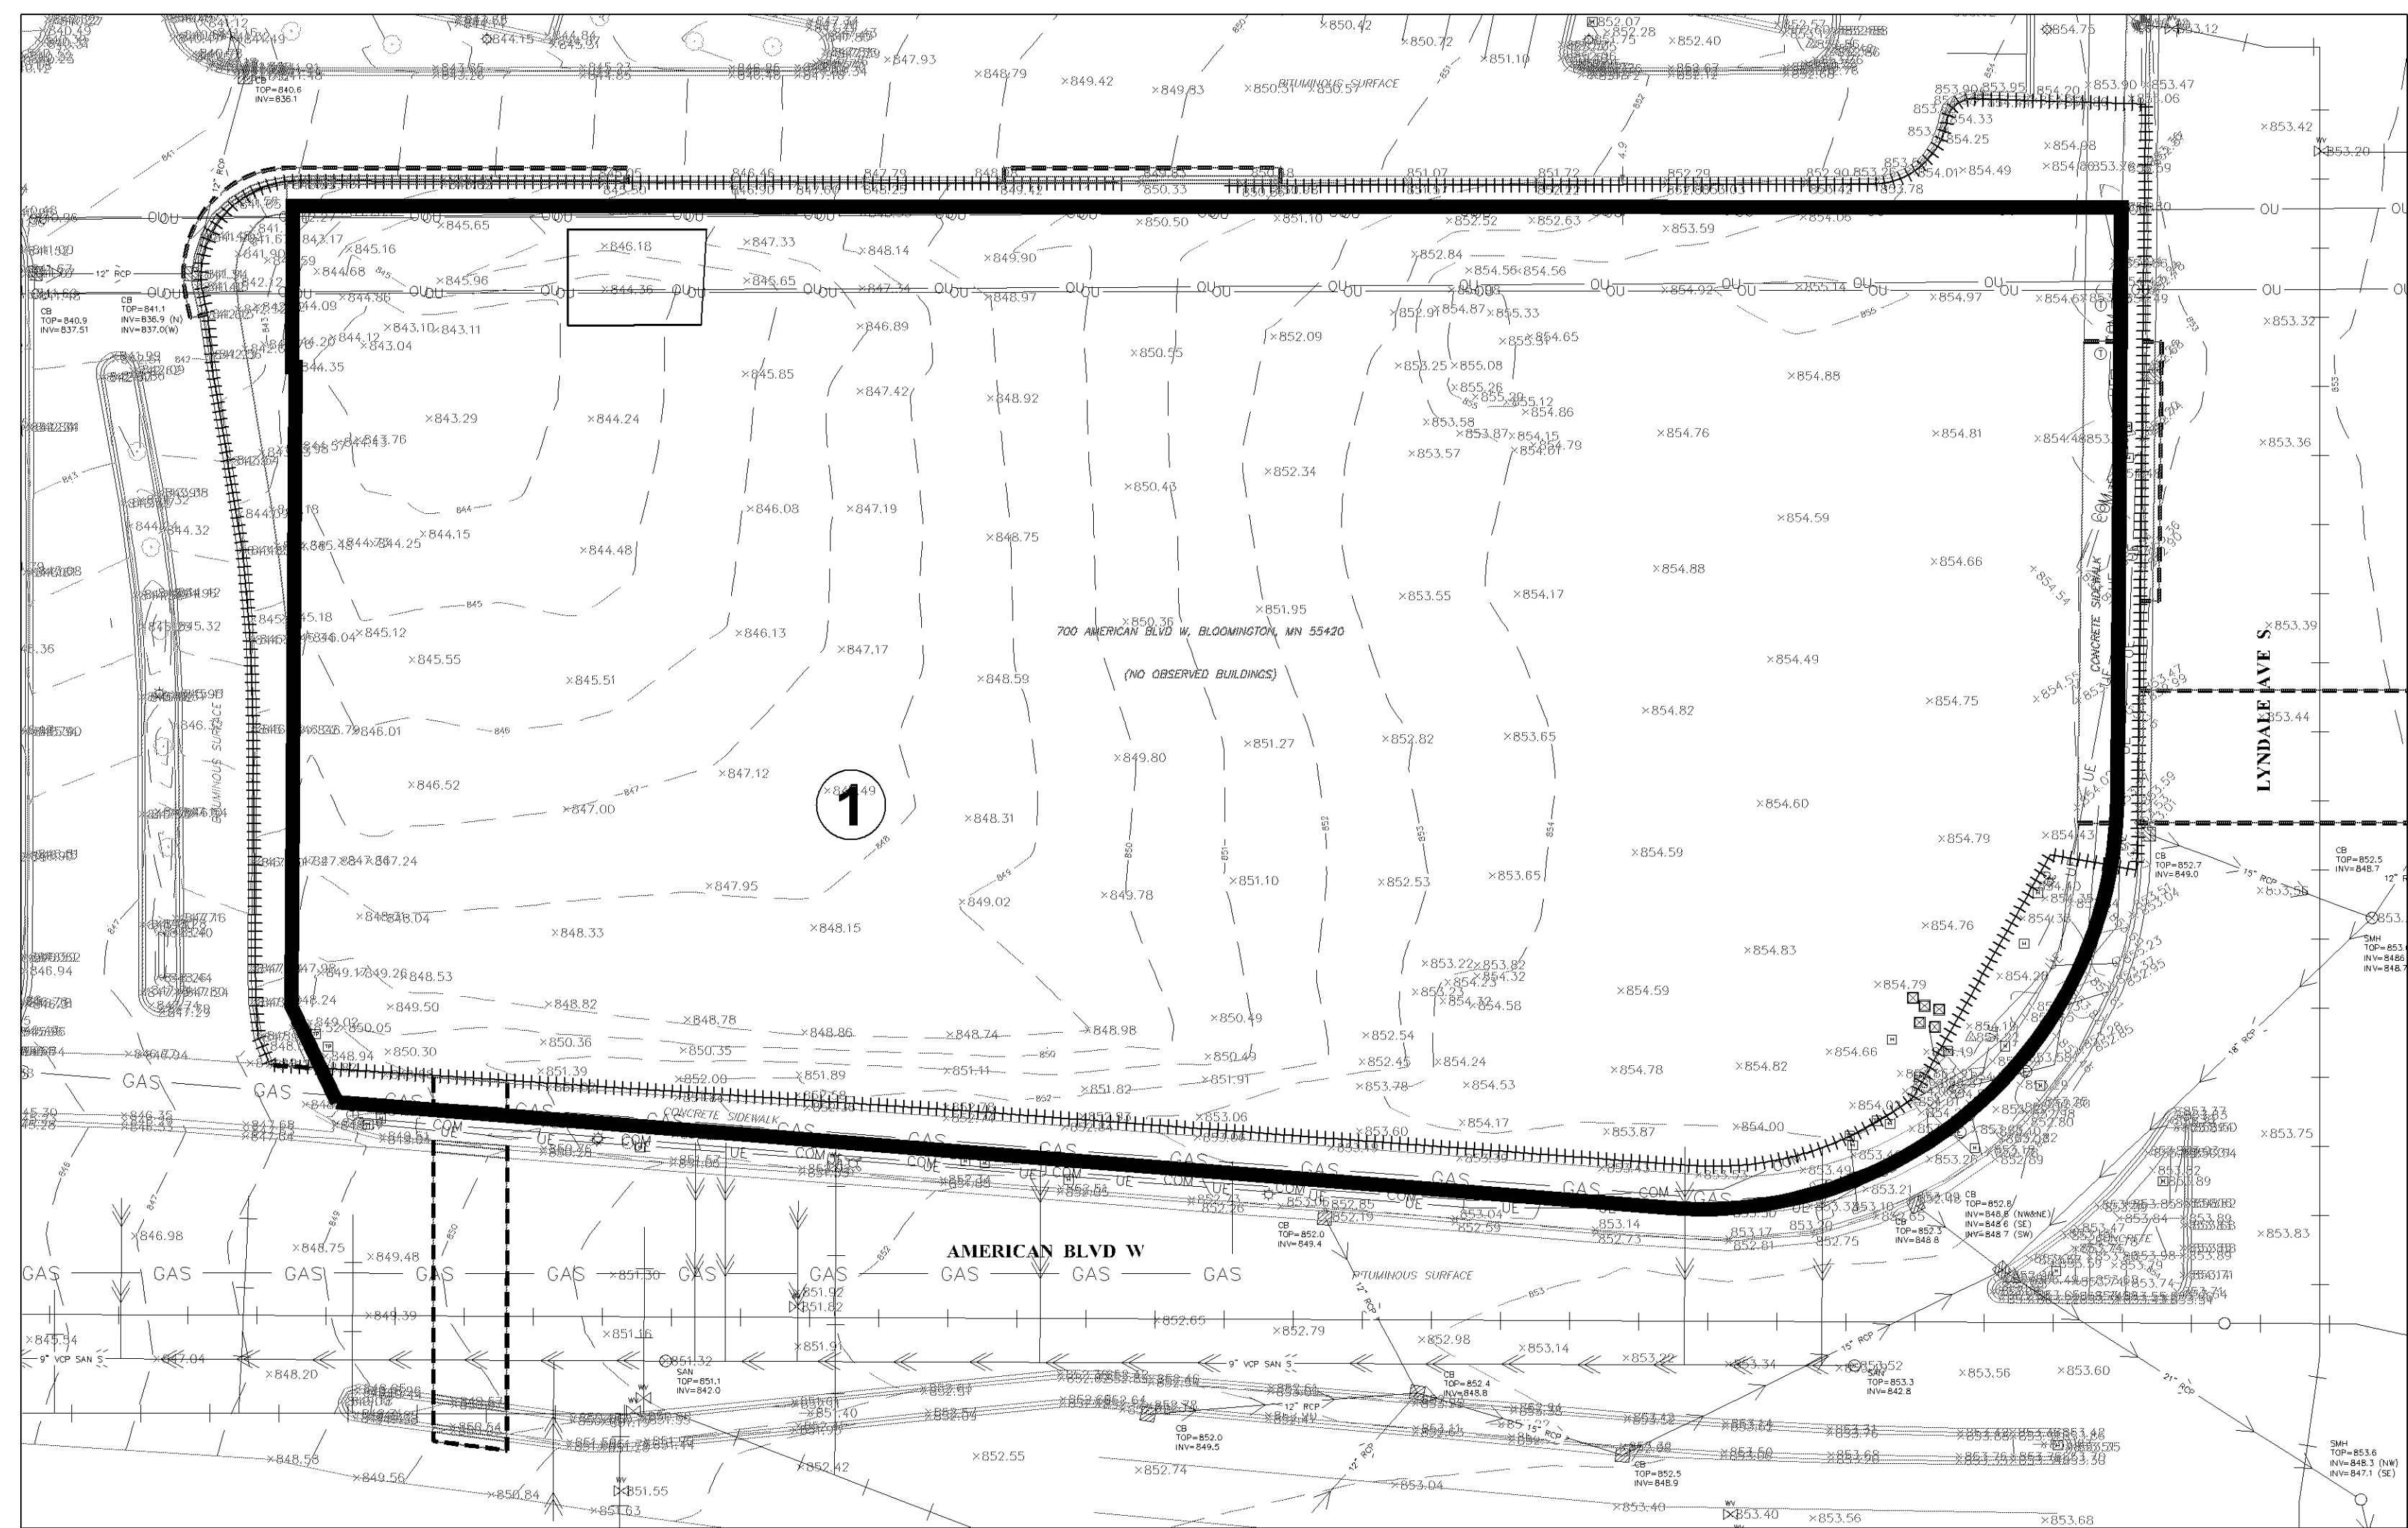

PL202300178

1 EXISTING CONDITIONS
C600.0
1" = 30'

EXISTING DRAINAGE AREAS						
DRAINAGE AREA	IMPERVIOUS AREA (ACRES)	PERVIOUS AREA (ACRES)	TOTAL AREA (ACRES)	2-YEAR (2.84')	10-YEAR (4.25')	100-YEAR (7.49')
1	0.09	1.76	1.85	0.67	2.37	7.89
TOTAL	0.09	1.76	1.85	0.67	2.37	7.89

PROPOSED DRAINAGE AREAS						
DRAINAGE AREA	IMPERVIOUS AREA (ACRES)	PERVIOUS AREA (ACRES)	TOTAL AREA (ACRES)	2-YEAR (2.84')	10-YEAR (4.25')	100-YEAR (7.49')
1	0.63	0.00	0.63	-	-	-
2	0.10	0.37	0.48	0.33	0.74	1.91
3	0.42	0.20	0.62	-	-	-
4	0.02	0.06	0.09	0.10	0.24	0.62
5	0.02	0.02	0.05	-	-	-
TOTAL	1.20	0.65	1.85	0.43	1.36	6.32

STORMWATER RUNOFF SUMMARY			
	2-YR STORM (2.84')	10-YR STORM (4.25')	100-YR STORM (7.49')
EXISTING SITE	0.67	2.37	7.89
PROPOSED SITE	0.43	1.36	6.32



VICINITY MAP
BLOOMINGTON, MINNESOTA

Verify site location on SWPPP.

2 PROPOSED CONDITIONS
C600.0
1" = 30'

30' 15' 0' 30' 60'
SCALE
1" = 30'

INSPECTIONS
EXPOSED SOIL AREAS: ONCE EVERY 7 DAYS AND WITHIN 24 HOURS FOLLOWING A 1/2 INCH OVER STABILIZED AREAS: ONCE EVERY 30 DAYS.
FROZEN GROUND: AS SOON AS RUNOFF OCCURS OR PRIOR TO RESUMING CONSTRUCTION.
RECORDS: A COPY OF THE GRADING, DRAINAGE EROSION CONTROL PLAN AND WATERSHED DATA & SWPPP PLANS AS WELL AS THE INSPECTIONS/MAINTENANCE LOGS ARE TO BE KEPT EITHER IN THE FIELD OFFICE, INSPECTOR'S VEHICLE, OR CONTRACTOR'S VEHICLE.

FINAL STABILIZATION
STABILIZATION BY UNIFORM PERENNIAL VEGETATIVE COVER (50% DENSITY).
DRAINAGE DITCHES STABILIZED.
ALL TEMPORARY SYNTHETIC AND STRUCTURAL BMP'S REMOVED.
CLEAN OUT SEDIMENT FROM CONVEYANCES AND SEDIMENTATION BASINS (RETURN TO DESIGN CAPACITY).

GRADING & SOILS
BASED ON SOIL BORINGS(S) PROVIDED BY BRAUN INTEREST SOILS TYPICALLY FOUND ON THIS PROJECT ARE: FILL SP, AND SP-SM.
REFER TO THE GEOTECHNICAL REPORT FOR ADDITIONAL INFORMATION.

MINIMUM ESTIMATED QUANTITIES FOR EROSION CONTROL		
ITEM DESCRIPTION	ESTIMATED QUANTITY	UNIT
DRAINAGE STRUCT INLET FILTER	13	EACH
ROCK CONSTRUCTION ENTRANCE	1	EACH
CONCRETE WASHOUT	1	EACH
BIO LOG	1216	LF

NOTE: QUANTITIES SHOWN ARE THE MINIMUM REQUIRED. ADDITIONAL QUANTITIES MAY BE NEEDED IF REQUIRED BY THE MPCA, WATERSHED DISTRICT, OR CITY. CONTRACTOR IS RESPONSIBLE FOR FINAL DETERMINATION OF QUANTITIES PRIOR TO CONSTRUCTION.

CONSTRUCTION ACTIVITY EROSION PREVENTION PRACTICES
CONTRACTOR SHALL STABILIZE ALL EXPOSED SOIL AREAS (INCLUDING STOCKPILES). STABILIZATION MUST BE INITIATED IMMEDIATELY TO LIMIT SOIL EROSION WHENEVER ANY CONSTRUCTION ACTIVITY HAS TEMPORARILY OR PERMANENTLY CEASED ON ANY PORTION OF THE SITE AND WILL NOT RESUME FOR A PERIOD EXCEEDING 7 CALENDAR DAYS. STABILIZATION MUST BE COMPLETED NO LATER THAN 7 CALENDAR DAYS AFTER THE CONSTRUCTION ACTIVITY IN THAT PORTION OF THE SITE HAS TEMPORARILY OR PERMANENTLY CEASED.

PIPE OUTLETS MUST BE PROVIDED WITH TEMPORARY OR PERMANENT ENERGY DISSIPATION WITHIN 24-HOURS AFTER CONNECTION TO A SURFACE WATER.
SEEDMENT CONTROL MEASURES MUST BE INSTALLED ON ALL DOWN GRADING PERIMETERS BEFORE ANY UPGRADING LAND DISTURBING ACTIVITIES BEGIN.

PORTABLE TOILET NOTES:
1. PORTABLE TOILETS POSE AN ENVIRONMENTAL HAZARD WHEN PLACED IN THE VICINITY OF STORM DRAINS OR BODIES OF WATER.
PORTABLE TOILET CLEANING ACTIVITIES CAN ALSO GENERATE POLLUTANTS THAT CAN DEGRADE WATER QUALITY.
2.1. PLACE PORTABLE TOILETS ON FLAT STABLE GROUND WITH CLEAR ACCESS TO THE UNITS.
2.2. LOCATE TOILETS A MINIMUM OF 20 FEET FROM ANY WATER BODY AND 10 FEET FROM ANY CURB AND GUTTER. IF UNDESIRABLE AN EARthen BERM OR SAND BAG BERM SHALL BE PLACED AROUND THE UNIT FOR SPILL AND LEAK CONTAINMENT.
2.3. AVOID PLACING TOILETS ON IMPERVIOUS SURFACES THAT WILL QUICKLY DRAIN TO STORM SEWERS.
2.4. LOCATE TOILETS SO THAT EXPOSURE TO TRAFFIC AND MOVING EQUIPMENT IS MINIMIZED.
2.5. SECURE TOILETS TO THE GROUND WITH STRAPES OR CABLES.
2.6. RINSE WATER FROM CLEANING ACTIVITIES SHALL NOT BE DISPOSED ON SITE.
3. REGULARLY CHECK TOILETS FOR DAMAGE, LEAKS AND SPILLS AS PART OF THE WEEKLY STORMWATER SITE INSPECTION.
4. OWNER IDENTIFICATION AND CONTACT INFORMATION SHALL BE DISPLAYED IN A PROMINENT LOCATION ON EACH UNIT.

HANDLING AND STORAGE OF HAZARDOUS MATERIALS:
IF THE CONTRACTOR INTENDS TO USE POLYMERS, FLOCCULANTS, OR OTHER SEDIMENTATION TREATMENT CHEMICALS ON THE PROJECT SITE, THE CONTRACTOR MUST COMPLY WITH THE FOLLOWING MINIMUM REQUIREMENTS:
1. THE CONTRACTOR MUST USE CONVENTIONAL EROSION AND SEDIMENT CONTROLS PRIOR TO CHEMICAL APPLICATION TO ENSURE EFFECTIVE TREATMENT. CHEMICALS MAY ONLY BE APPLIED WHERE TREATED STORMWATER IS DIRECTED TO A SEDIMENT CONTROL SYSTEM WHICH ALLOWS FOR FILTRATION OR SETTLEMENT OF THE FLOC PRIOR TO DISCHARGE.
2. CHEMICALS MUST BE SELECTED THAT ARE APPROPRIATELY SUITED TO THE TYPES OF SOILS LIKELY TO BE EXPOSED DURING CONSTRUCTION, AND TO THE EXPECTED TURBIDITY, PH, AND FLOW RATE OF STORMWATER FLOWING INTO THE CHEMICAL TREATMENT SYSTEM OR AREA.
3. CHEMICALS MUST BE USED IN ACCORDANCE WITH ACCEPTED ENGINEERING PRACTICES, AND WITH DOSING PROCEDURES, HYDRAULIC REMOVAL DESIGN SPECIFICATIONS PROVIDED BY THE MANUFACTURER OR PRODUCER/SUPPLIER OF THE APPLICABLE CHEMICALS.

ON-SITE FUEL TANKS REQUIRE SECONDARY CONTAINMENT AS REQUIRED BY THE PERMIT. PORTABLE FUEL TANKS SHALL HAVE THEIR SPILL KITS AVAILABLE DURING FUELING. SPILLS GREATER THAN 5 GALLONS MUST BE REPORTED TO THE PROPER AUTHORITIES.

POLLUTION PREVENTION MANAGEMENT MEASURES:
SOLID WASTE DISPOSED PROPERLY, COMPLY WITH MPCA REQUIREMENTS.
HAZARDOUS WASTE STORED (SECONDARY CONTAINMENT, RESTRICTED ACCESS) AND DISPOSED IN COMPLIANCE WITH MPCA REQUIREMENTS.
NO EXTERNAL WASHING OF TRUCKS AND OTHER CONSTRUCTION EQUIPMENT ON-SITE.
CONCRETE WASHOUT ON-SITE: ALL LIQUID AND SOLID WASTES GENERATED BY CONCRETE WASHOUT OPERATIONS MUST BE CONTAINED IN A LEAK-PROOF CONTAINMENT FACILITY OR IMPERVIOUS LINER. A CONTRACTED CLAY LINER THAT DOES NOT ALLOW LIQUIDS TO ENTER GROUND WATER IS CONSIDERED AN IMPERVIOUS LINER. THE LIQUID AND SOLID WASTES MUST NOT CONTACT THE GROUND, AND THERE MUST NOT BE RUNOFF FROM THE CONCRETE WASHOUT OPERATIONS OR AREAS. LIQUID AND SOLID WASTES MUST BE DISPOSED OF PROPERLY AND IN COMPLIANCE WITH MPCA REGULATIONS. A SIGN MUST BE INSTALLED ADJACENT TO EACH WASHOUT FACILITY TO INFORM CONCRETE EQUIPMENT OPERATORS TO UTILIZE THE PROPER FACILITIES.
THE CONCRETE WASHOUT AREA INDICATED ON THE PLANS IS SHOWN IN AN APPROXIMATE LOCATION. PRIOR TO THE START OF CONSTRUCTION, THE CONTRACTOR SHALL DETERMINE THE EXACT LOCATION IN ACCORDANCE WITH MPCA REQUIREMENTS.

STORAGE HANDLING AND DISPOSAL OF CONSTRUCTION PRODUCTS, MATERIALS, AND WASTES:
BUILDING PRODUCTS THAT HAVE THE POTENTIAL TO LEACH POLLUTANTS MUST BE UNDER COVER.
PESTICIDES, HERBICIDES, INSECTICIDES, FERTILIZERS, TREATMENT CHEMICALS, AND LANDSCAPE MATERIALS MUST BE UNDER COVER.
HAZARDOUS MATERIALS, TOXIC WASTE (INCLUDING OIL, DIESEL FUEL, GASOLINE, HYDRAULIC FLUIDS, PAINT SOLVENTS, PETROLEUM-BASED PRODUCTS, WOOD PRESERVATIVES, ADHESIVES, CURING COMPOUNDS, AND ACIDS) MUST BE PROPERLY STORED IN SEALED CONTAINERS TO PREVENT SPILLS, LEAKS, OR OTHER DISCHARGES.

OTHER NOTES:
1. LONG TERM MAINTENANCE OF THE SITE WILL BE PERFORMED BY THE OWNER, XXXXX. INCLUDED MAINTENANCE FOR STORMWATER DEVICES SHALL BE:
1.1. INSPECT SUMP CATCH BASINS OF SEDIMENT AND DEBRIS ANNUALLY OR WHEN SEDIMENTS FILL 1/3 OF THE STORAGE VOLUME.
1.2. INSPECT UNDERGROUND TANK SYSTEM ON AN ANNUAL BASIS FOR SEDIMENT BUILD-UP AND/OR STANDING WATER. REMOVAL SEDIMENT AS NECESSARY.
1.3. THIS SWPPP DOCUMENT MUST BE AMENDED AS NECESSARY DURING CONSTRUCTION IN ORDER TO KEEP IT CURRENT WITH THE POLLUTION CONTROL MEASURES UTILIZED AS THE SITE. THE SITE MAP SHOWING LOCATIONS OF ALL STORM WATER CONTROLS MUST BE POSTED ON THE SITE AND UPDATED TO REFLECT THE PROGRESS OF CONSTRUCTION.

SEDIMENT AND EROSION CONTROL MAINTENANCE
PERIMETER SEDIMENT CONTROL PRACTICES: WHEN SEDIMENT REACHES 1/3 THE HEIGHT OF THE BMP, THE SEDIMENT MUST BE REMOVED WITHIN 24 HOURS. IF PERIMETER SEDIMENT CONTROL HAS BEEN DAMAGED OR IS NOT FUNCTIONING PROPERLY, IT MUST BE REPAIRED AND/OR REPLACED WITHIN 24 HOURS. PERIMETER BMP MEASURES MAY INCLUDE SILT FENCING.
CONSTRUCTION SITE VEHICLE EXIT LOCATIONS: ALL TRACKED SEDIMENT CONTROL PRACTICES MUST BE REMOVED WITHIN 24 HOURS OF DISCOVERY OR REPLACED WITHIN 24 HOURS. PERIMETER BMP MEASURES MAY INCLUDE SILT FENCING.
CONSTRUCTION SITE DEWATERING: THE CONTRACTOR SHALL BE RESPONSIBLE FOR OBTAINING ALL DEWATERING PERMITS. DISCHARGE FROM ALL DEWATERING OPERATIONS SHALL BE DIRECTED TO ON-SITE DEPRESSIONS, NO DISCHARGE FROM DEWATERING OPERATIONS SHALL BE DIRECTED TOWARDS A WATER OF THE STATE.

PROJECT NARRATIVE
EXISTING SITE DESCRIPTION -- THE EXISTING SITE IS APPROXIMATELY 1.8 ACRES IN SIZE AND IS UNDEVELOPED. STORMWATER RUNOFF GENERALLY SHEET FLOWS FROM EAST TO WEST, WHERE IT ENTERS EXISTING STORM SEWER IN THE ACCESS DRIVE. THERE IS NO EXISTING STORMWATER MANAGEMENT ON SITE.
PROPOSED SITE DESCRIPTION -- THE PROPOSED DEVELOPMENT WILL CONSIST OF A NEW BUILDING, BITUMINOUS PARKING LOT, CONCRETE SIDEWALK, AND GREEN SPACE. THE PROPOSED WORK IS EXPECTED TO ADD 1.11 ACRES IMPERVIOUS AREA TO MEET THE STORMWATER MANAGEMENT STANDARDS. AN UNDERGROUND INFILTRATION TANK IS PROPOSED TO BE INSTALLED UNDERNEATH THE PROPOSED PARKING LOT. STORMWATER RUNOFF WILL BE COLLECTED BY PROPOSED STORM SEWER IN THE BITUMINOUS PARKING LOT AND PIPED TO THE UNDERGROUND INFILTRATION TANK SYSTEM.

SWPPP IMPLEMENTATION, INSTALLATION, INSPECTION, AND MAINTENANCE SHALL BE PERFORMED BY THE CONTRACTOR.
NAME: _____
CERTIFICATION #: _____
DATE: _____

NOTE:
AN AS-BUILT SURVEY OF ALL STORMWATER BMP'S INFILTRATION TANK SYSTEM, OUTLET STRUCTURES, CLEAN OUTFITS, SUMP CATCH BASINS, ETC.) SHALL BE SUBMITTED TO NINE MILE CREEK WATERSHED DISTRICT PRIOR TO PROJECT CLOSURE. THE AS-BUILT SURVEY SHALL INCLUDE THE INFILTRATION TANK LAYOUT FOR VERIFICATION THAT THE SYSTEM WAS INSTALLED PROPERLY.

MECHANICAL AND NON-STORMWATER DISCHARGES, EXISTING AND PROPOSED
1. WATER LINE FLUSHING
2. LANDSCAPE IRRIGATION
3. DISCHARGE FROM POTABLE WATER SOURCES
4. FOUNDATIONAL DRAINS
5. AIR CONDITIONING CONDENSATION
6. INDIVIDUAL RESIDENT CAR WASHING
7. STREET WASH WATERS
8. RESIDENTIAL BUILDING WASH WATERS WITHOUT DETERGENTS.

AGENCY CONTACTS
CITY OF BLOOMINGTON
ENGINEERING DEPARTMENT
PHONE: (952) 563-4870
MINNESOTA POLLUTION CONTROL AGENCY
PHONE: (651) 296-4300
NINE MILE CREEK WATERSHED DISTRICT
PHONE: (952) 835-2078
OWNER COMPANY ADDRESS PHONE: (XXX) XXX-XXXX

NOTE:
THE CONTRACTOR MUST COMPLETE SIGN, OBTAIN OWNERS SIGNATURE, PAY FEE, AND SEND IN THE NPDES PERMIT APPLICATION. CONTRACTOR SHALL PROVIDE A CERTIFIED EROSION CONTROL SUPERVISOR. SWPPP DOCUMENTATION, INCLUDING INSPECTION REPORTS SHALL BE RETAINED FOR A PERIOD OF THREE (3) YEARS. DESIGN CALCULATIONS ARE ON FILE AT BQRM.
THE OWNER AND CONTRACTOR ARE RESPONSIBLE FOR IMPLEMENTATION OF THE SWPPP AND INSTALLATION, INSPECTION, AND MAINTENANCE OF THE EROSION PREVENTION AND SEDIMENT CONTROL BMP'S BEFORE, DURING, AND AFTER CONSTRUCTION UNTIL THE NOTICE OF TERMINATION HAS BEEN FILED.
STOCKPILES:
ON-SITE STOCKPILES OF SOIL SHALL HAVE PERIMETER SEDIMENT CONTROL. STOCKPILES SHALL BE STABILIZED WITH BLANKETS, TAPPS, OR HYDRO MULCH IF LEFT ON-SITE FOR MORE THAN 7 DAYS.
TEMPORARY SEDIMENT BASINS:
TEMPORARY SEDIMENT BASINS SHALL BE PROVIDED PER APPENDIX A, SECTION C-1.B OF THE MPCA GENERAL STORMWATER PERMIT.
ENGINEER ANTICIPATES THAT PRIOR TO EXCAVATION FOR INFILTRATION TANK, CONTRACTOR WILL USE PROPOSED INFILTRATION TANK AREA AS TEMPORARY SEDIMENT BASIN PRIOR TO USE. SURFACE TEMPORARY BASINS SHALL BE REMOVED WITHIN 24 HOURS OF DISCOVERY OR REPLACED WITHIN 24 HOURS. PERIMETER BMP MEASURES MAY INCLUDE SILT FENCING.
IN LIEU OF USING TEMPORARY SEDIMENT BASINS, THE CONTRACTOR MAY PHASE THEIR CONSTRUCTION SO THAT NOT MORE THAN 5 ACRES OF AREA IS UNDEVELOPED AT ONE TIME. THE FULL STABILIZATION OF THE DISTURBED AREA IS REQUIRED PRIOR TO DISTURBING ADDITIONAL AREAS. (IMPAIRED ONLY)

MATERIALS SCHEDULE			
EDGING			
SYMBOL	DESCRIPTION	QTY	DETAIL
ED-01	EDGING TYPE 1 - STEEL EDGER	986 LF	
FENCE & GUARDRAIL			
SYMBOL	DESCRIPTION	QTY	DETAIL
FE-01	FENCE TYPE 1 - CHAIN LINK - 4.5'	282 LF	
FE-02	FENCE TYPE 2 - GUARDRAIL	97 LF	
LANDSCAPE AMENITY			
SYMBOL	DESCRIPTION	QTY	DETAIL
LA-01	COMMUNITY GARDEN PLANTER	12	
PAVING			
SYMBOL	DESCRIPTION	QTY	DETAIL
P-01	PAVING TYPE 1 - CONCRETE WALK	10,040 SF	
P-02	PAVING TYPE 2 - PERVIOUS PAVERS	1,282 SF	
P-03	PAVING TYPE 3 - CRUSHED STONE	2,284 SF	
SITE FURNITURE			
SYMBOL	DESCRIPTION	QTY	DETAIL
SF-01	BENCH TYPE 1 - LANDSCAPE FORMS BANCAL - DOUBLE	1	
SF-02	BENCH TYPE 2 - LANDSCAPE FORMS BANCAL - SINGLE	7	
SF-03	BIKE RACK	14	

PLANT SCHEDULE									
DECIDUOUS TREES	CODE	QTY	BOTANICAL / COMMON NAME	SIZE	CONT.	NOTES			REMARKS
	AL	16	ACER RUBRUM 'ARMSTRONG' / ARMSTRONG MAPLE	2.5" CAL.	B&B				
	BF	6	BETULA PLATYPHYLLA 'FARGO' TM / DAKOTA PINNACLE WHITE BIRCH	2" CAL.	B&B	SINGLE STEM			
	TI-B2	13	TILIA AMERICANA 'BOULEVARD' / BOULEVARD LINDEN	2.5" CAL.	B&B				
EVERGREEN TREES	CODE	QTY	BOTANICAL / COMMON NAME	SIZE	CONT.	NOTES			REMARKS
	PD	2	PICEA GLAUCA 'DENSATA' / BLACK HILLS SPRUCE	6" HT.	B&B				
	PC2	2	PINUS CEMBRA / SWISS STONE PINE	6" HT.	B&B	NATURAL FORM, SINGLE LEADER			
ORNAMENTAL TREES	CODE	QTY	BOTANICAL / COMMON NAME	SIZE	CONT.	NOTES			REMARKS
	AG	6	AMELANCHIER X GRANDIFLORA 'AUTUMN BRILLIANCE' / 'AUTUMN BRILLIANCE' SERVICEBERRY	8" HT. CLUMP	B&B				
DECIDUOUS SHRUBS	CODE	QTY	BOTANICAL / COMMON NAME	SIZE	CONT.	NOTES		SPACING	REMARKS
	HL2	36	HYDRANGEA PANICULATA 'LITTLE LIME' / LITTLE LIME HYDRANGEA	#2	CONT.			48" o.c.	
	RG	99	RHUS AROMATICA 'GRO-LOW' / GRO-LOW FRAGRANT SUMAC	#5	POT			60" o.c.	
	RI-A	70	RIBES ALPINUM / ALPINE CURRANT	#2	POT	SPACE 4'-0" O.C.		48" o.c.	
	SP2	70	SALIX PURPUREA 'NANA' / DWARF ARCTIC WILLOW	#2	CONT.			54" o.c.	
	SS4	119	SORBARIA SORBIFOLIA 'SEM' / SEM ASH LEAF SPIREA	#2	CONT.			36" o.c.	
EVERGREEN SHRUBS	CODE	QTY	BOTANICAL / COMMON NAME	SIZE	CONT.	NOTES		SPACING	REMARKS
	JT	59	JUNIPERUS CHINENSIS 'MONLEP' / MINT JULEP® CHINESE JUNIPER	#5	POT			48" o.c.	
	TT2	33	TAXUS X MEDIA 'TAUNTONII' / TAUNTON YEW	#2				48" o.c.	
GRASSES	CODE	QTY	BOTANICAL / COMMON NAME	SIZE	CONT.	NOTES		SPACING	REMARKS
	CK	133	CALAMAGROSTIS X ACUTIFLORA 'KARL FOERSTER' / FEATHER REED GRASS	#1				24" o.c.	
	PA-H	67	PANICUM VIRGATUM 'HEAVY METAL' / HEAVY METAL SWITCH GRASS	#1	POT	SPACE 2'-6" O.C.		30" o.c.	
	SB	143	SCHIZACHYRIUM SCOPARIUM 'BLUE HEAVEN' / BLUE HEAVEN LITTLE BLUESTEM	1 GAL	CONT.	SPACE 2'-0" O.C.		24" o.c.	
PERENNIALS	CODE	QTY	BOTANICAL / COMMON NAME	SIZE	CONT.	NOTES		SPACING	REMARKS
	AT-S	49	ALLIUM TANGUTICUM 'SUMMER BEAUTY' / SUMMER BEAUTY GLOBE LILY	#1	POT	SPACE 1'-6" O.C.		18" o.c.	
GROUND COVERS	CODE	QTY	BOTANICAL / COMMON NAME	SIZE	CONT.	NOTES		SPACING	REMARKS
	SOD	10,779 SF	SOD						
NATIVE PERENNIALS	CODE	QTY	BOTANICAL / COMMON NAME	SIZE	CONT.	NOTES		SPACING	REMARKS
	SM1	1,494 SF	RAIN GARDEN PLANTING MIX	SEED		10 LBS PER ACRE, SEE SPECIFICATIONS			




SITE AND LANDSCAPE NOTES

SITE PREPARATION NOTES

- CONTRACTOR SHALL INSPECT THE SITE AND BECOME FAMILIAR WITH EXISTING CONDITIONS RELATING TO THE NATURE AND SCOPE OF WORK.
 - CONTRACTOR SHALL VERIFY PLAN LAYOUT AND BRING TO THE ATTENTION OF THE LANDSCAPE ARCHITECT DISCREPANCIES WHICH MAY COMPROMISE THE DESIGN OR INTENT OF THE LAYOUT.
 - CONTRACTOR SHALL ASSURE COMPLIANCE WITH APPLICABLE CODES AND REGULATIONS GOVERNING THE WORK AND MATERIALS SUPPLIED.
 - CONTRACTOR SHALL PROTECT EXISTING ROADS, CURBS/GUTTERS, TRAILS, TREES, LAWNS AND SITE ELEMENTS DURING CONSTRUCTION OPERATIONS. DAMAGE TO SAME SHALL BE REPAIRED AT NO ADDITIONAL COST TO THE OWNER.
 - CONTRACTOR SHALL VERIFY ALIGNMENT AND LOCATION OF UNDERGROUND AND ABOVE GRADE UTILITIES AND PROVIDE THE NECESSARY PROTECTION FOR SAME BEFORE CONSTRUCTION BEGINS (MINIMUM 10' CLEARANCE).
 - CONTRACTOR SHALL COORDINATE THE PHASES OF CONSTRUCTION AND PLANTING INSTALLATION WITH OTHER CONTRACTORS WORKING ON SITE.
 - UNDERGROUND UTILITIES SHALL BE INSTALLED SO THAT TRENCHES DO NOT CUT THROUGH ROOT SYSTEMS OF EXISTING TREES TO REMAIN.
 - EXISTING CONTOURS, TRAILS, VEGETATION, CURB/GUTTER AND OTHER ELEMENTS ARE BASED UPON INFORMATION SUPPLIED TO THE LANDSCAPE ARCHITECT BY OTHERS. CONTRACTOR SHALL VERIFY DISCREPANCIES PRIOR TO CONSTRUCTION AND NOTIFY LANDSCAPE ARCHITECT OF SAME.
 - HORIZONTAL AND VERTICAL ALIGNMENT OF PROPOSED WALKS, TRAILS OR ROADWAYS ARE SUBJECT TO FIELD ADJUSTMENT REQUIRED TO CONFORM TO LOCALIZED TOPOGRAPHIC CONDITIONS AND TO MINIMIZE TREE REMOVAL AND GRADING. CHANGES IN ALIGNMENT AND GRADES MUST BE APPROVED BY THE LANDSCAPE ARCHITECT PRIOR TO IMPLEMENTATION.
 - CONTRACTOR SHALL REVIEW THE SITE FOR DEFICIENCIES IN SITE CONDITIONS WHICH MIGHT NEGATIVELY AFFECT PLANT ESTABLISHMENT, SURVIVAL OR WARRANTY. UNDESIRABLE SITE CONDITIONS SHALL BE BROUGHT TO THE ATTENTION OF THE LANDSCAPE ARCHITECT PRIOR TO COMMENCEMENT OF WORK.
 - EXISTING TREES OR SIGNIFICANT SHRUB MASSINGS FOUND ON SITE SHALL BE PROTECTED AND SAVED UNLESS NOTED TO BE REMOVED OR ARE LOCATED IN AN AREA TO BE GRADED. QUESTIONS REGARDING EXISTING PLANT MATERIAL SHALL BE BROUGHT TO THE ATTENTION OF THE LANDSCAPE ARCHITECT PRIOR TO REMOVAL.
 - CONTRACTOR SHALL PREPARE AND SUBMIT A WRITTEN REQUEST FOR THE SUBSTANTIAL COMPLETION INSPECTION OF LANDSCAPE AND SITE IMPROVEMENTS PRIOR TO SUBMITTING FINAL PAY REQUEST.
 - CONTRACTOR SHALL PREPARE AND SUBMIT REPRODUCIBLE AS-BUILT DRAWING(S) OF LANDSCAPE INSTALLATION, IRRIGATION AND SITE IMPROVEMENTS UPON COMPLETION OF CONSTRUCTION INSTALLATION AND PRIOR TO SUBSTANTIAL COMPLETION.
 - SYMBOLS ON PLAN DRAWING TAKE PRECEDENCE OVER SCHEDULES IF DISCREPANCIES IN QUANTITIES EXIST. SPECIFICATIONS AND DETAILS TAKE PRECEDENCE OVER NOTES.
- PLANTING**
- SPRING PLANT MATERIAL INSTALLATION IS FROM APRIL 15 TO JUNE 15.
 - FALL CONIFEROUS PLANTING IS ACCEPTABLE FROM AUGUST 21 TO SEPTEMBER 30.
 - FALL DECIDUOUS PLANTING IS ACCEPTABLE FROM AUGUST 15 UNTIL NOVEMBER 15.
 - ADJUSTMENTS TO PLANTING DATES MUST BE APPROVED IN WRITING BY THE LANDSCAPE ARCHITECT.
 - STAKE PROPOSED PLANTING LOCATIONS PER PLAN FOR REVIEW AND APPROVAL BY LANDSCAPE ARCHITECT PRIOR TO INSTALL.
 - PLANT MATERIAL SHALL COMPLY WITH THE CURRENT EDITION OF THE AMERICAN STANDARD FOR NURSERY STOCK, ANSI Z60.1. UNLESS NOTED OTHERWISE, DECIDUOUS SHRUBS SHALL HAVE AT LEAST 5 CANES AT THE SPECIFIED HEIGHT. ORNAMENTAL TREES SHALL HAVE NO 'V' CROTCHES AND SHALL BEGIN BRANCHING NO LOWER THAN 3' FEET ABOVE THE ROOT BALL. STREET AND BOULEVARD TREES SHALL BEGIN BRANCHING NO LOWER THAN 6' ABOVE PAVED SURFACE.
 - INSTALL PLANT MATERIAL AFTER FINAL GRADING AND CONSTRUCTION HAS BEEN COMPLETED IN THE IMMEDIATE AREA.
 - INSTALL PLANT MATERIALS PER PLANTING DETAILS.
 - SUBSTITUTION REQUESTS FOR PLANT MATERIAL TYPE & SIZE SHALL BE SUBMITTED TO THE LANDSCAPE ARCHITECT FOR CONSIDERATION PRIOR TO BIDDING. SUBSTITUTIONS AFTER BIDDING MUST BE APPROVED BY LANDSCAPE ARCHITECT AND ARE SUBJECT TO CONTRACT ADJUSTMENTS.
 - ADJUSTMENTS IN LOCATION OF PROPOSED PLANT MATERIALS MAY BE NEEDED IN FIELD. LANDSCAPE ARCHITECT MUST BE NOTIFIED PRIOR TO ADJUSTMENT OF PLANTS.

- FERTILIZE PLANT MATERIAL UPON INSTALLATION WITH DRIED BONE MEAL AND OTHER APPROVED FERTILIZER MIXED IN WITH THE PLANTING SOIL (PER THE MANUFACTURER'S INSTRUCTIONS) OR TREAT FOR SUMMER AND FALL INSTALLATION WITH AN APPLICATION OF GRANULAR 10-0-5 OF 12 OZ. PER 2.5" CALIPER TREE AND 6 OZ. PER SHRUB WITH AN ADDITIONAL APPLICATION OF 10-0-10 THE FOLLOWING SPRING IN THE TREE SAUCER.
 - INSTALL 18" DEPTH OF PLANTING SOIL IN AREAS RECEIVING GROUND COVER, PERENNIALS, AND ANNUALS. PLANTING SOIL SHALL CONSIST OF MIDOT 3877-B MODIFIED TO CONTAIN A MAXIMUM OF 30% SAND, A PH OF 7.1 MAX. OR AS OTHERWISE SPECIFIED IN THE PROJECT SPECIFICATIONS MANUAL.
 - TREE WRAPPING MATERIAL SHALL BE TWO-WALLED PLASTIC SHEETING APPLIED FROM TRUNK FLARE TO FIRST BRANCH. WRAP SMOOTH-BARKED DECIDUOUS TREES PLANTED IN THE FALL PRIOR TO DECEMBER 1 AND REMOVE WRAPPING AFTER MAY 1.
 - APPLY PRE-EMERGENT HERBICIDE (PREEN OR APPROVED EQUAL) IN ANNUAL, PERENNIAL, AND SHRUB BEDS FOLLOWED BY SHREDDED HARDWOOD MULCH. REFER TO SPECIFICATIONS FOR ADDITIONAL INFORMATION REGARDING USE OF HERBICIDES.
- MULCHING**
- INSTALL 4" DEEP SHREDDED HARDWOOD MULCH RINGS AT CONIFEROUS & DECIDUOUS TREES WITH NO MULCH IN DIRECT CONTACT WITH TREE TRUNK.
 - INSTALL 3" DEEP SHREDDED HARDWOOD MULCH RINGS AT SHRUB PLANTING AREAS WITH NO MULCH IN DIRECT CONTACT WITH SHRUB STEMS.
 - INSTALL 3" DEEP FINELY SHREDDED MULCH IN PERENNIAL PLANTING BEDS. REMOVE ALL MULCH FROM STEMS OF PERENNIALS - PLANT STEMS SHOULD NOT BE IN DIRECT CONTACT WITH MULCH.
- WATERING**
- PLANTED MATERIALS SHALL BE WATERED BY TEMPORARY MEANS UNTIL PLANTS ARE ESTABLISHED.
 - TEMPORARY WATERING MEANS, METHODS, AND SCHEDULING SHALL BE THE CONTRACTOR'S RESPONSIBILITY. REMOVE TEMPORARY WATERING EQUIPMENT UPON PLANT ESTABLISHMENT.
- WARRANTY**
- WARRANTY NEW PLANT MATERIAL THROUGH [ONE] CALENDAR YEAR FROM THE DATE OF SUBSTANTIAL COMPLETION. NO PARTIAL ACCEPTANCE WILL BE CONSIDERED.
- TURF NOTES**
- SOD AREAS DISTURBED DUE TO GRADING UNLESS NOTED OTHERWISE.
 - WHERE SOD ABUTS PAVED SURFACES, FINISHED GRADE OF SOD/SEED SHALL BE HELD 1" BELOW SURFACE ELEVATION OF TRAIL, SLAB, CURB, ETC.
 - SOD SHALL BE LAID PARALLEL TO THE CONTOURS AND SHALL HAVE STAGGERED JOINTS. ON SLOPES STEEPER THAN 3:1 OR IN DRAINAGE SWALES, SOD SHALL BE STAKED SECURELY.
 - UNLESS NOTED OTHERWISE, THE APPROPRIATE DATES FOR SPRING SEED & SOD PLACEMENT IS FROM THE TIME GROUND HAS THAWED TO JUNE 15.
 - FALL SODDING IS ACCEPTABLE FROM AUGUST 15 TO NOVEMBER 1. FALL SEEDING IS ACCEPTABLE FROM AUGUST 15 TO SEPTEMBER 15. ADJUSTMENTS TO SOD/SEED PLANTING DATES MUST BE APPROVED IN WRITING BY THE LANDSCAPE ARCHITECT.
- IRRIGATION NOTES**
- CONTRACTOR SHALL BE RESPONSIBLE FOR PROVIDING AN IRRIGATION LAYOUT PLAN AND SPECIFICATION THAT MEETS THE REQUIREMENTS OF THE PROVIDED PERFORMANCE SPECIFICATION AS PART OF THE SCOPE OF WORK. SUBMIT LAYOUT PLAN AND SPECIFICATIONS FOR APPROVAL BY THE LANDSCAPE ARCHITECT PRIOR TO ORDER AND/OR CONSTRUCTION. IT SHALL BE THE CONTRACTOR'S RESPONSIBILITY TO ENSURE THAT SODDED/SEEDED AND PLANTED AREAS ARE IRRIGATED PROPERLY, INCLUDING THOSE AREAS DIRECTLY AROUND AND ABUTTING BUILDING FOUNDATION.
 - CONTRACTOR SHALL FIELD VERIFY WATER SUPPLY, VOLUME, PRESSURE AND LOCATION FOR SYSTEM TAP PRIOR TO SYSTEM DESIGN.
 - CONTRACTOR SHALL CONFIRM COMPLETE LIMITS OF IRRIGATION WITH LANDSCAPE ARCHITECT PRIOR TO SUPPLYING SHOP DRAWINGS.
 - CONTRACTOR SHALL CONTACT LANDSCAPE ARCHITECT FOR INSPECTION AND APPROVAL OF AREAS RECEIVING DRIP IRRIGATION PRIOR TO INSTALLATION OF MULCH.
 - CONTRACTOR SHALL PROVIDE THE OWNER AND LANDSCAPE ARCHITECT WITH AS-BUILT DRAWINGS, DETAILED SYSTEM OPERATION INSTRUCTIONS AND AN IRRIGATION SCHEDULE APPROPRIATE TO THE PROJECT SITE CONDITIONS AND PLANTED MATERIAL GROWTH REQUIREMENTS.
 - IRRIGATION SYSTEM SHALL BE DESIGNED SO THAT NO WATER DIRECTED TOWARDS OR IS IN CONTACT WITH VERTICAL HARDSCAPE AND/OR STRUCTURES.

PL202300178

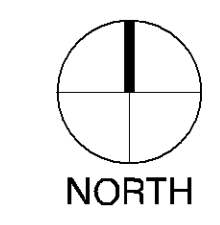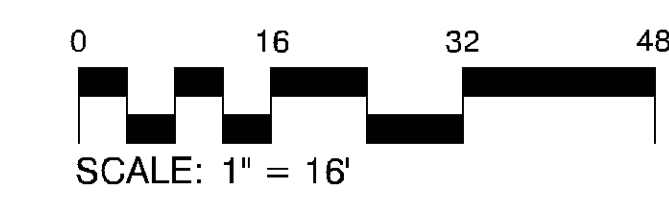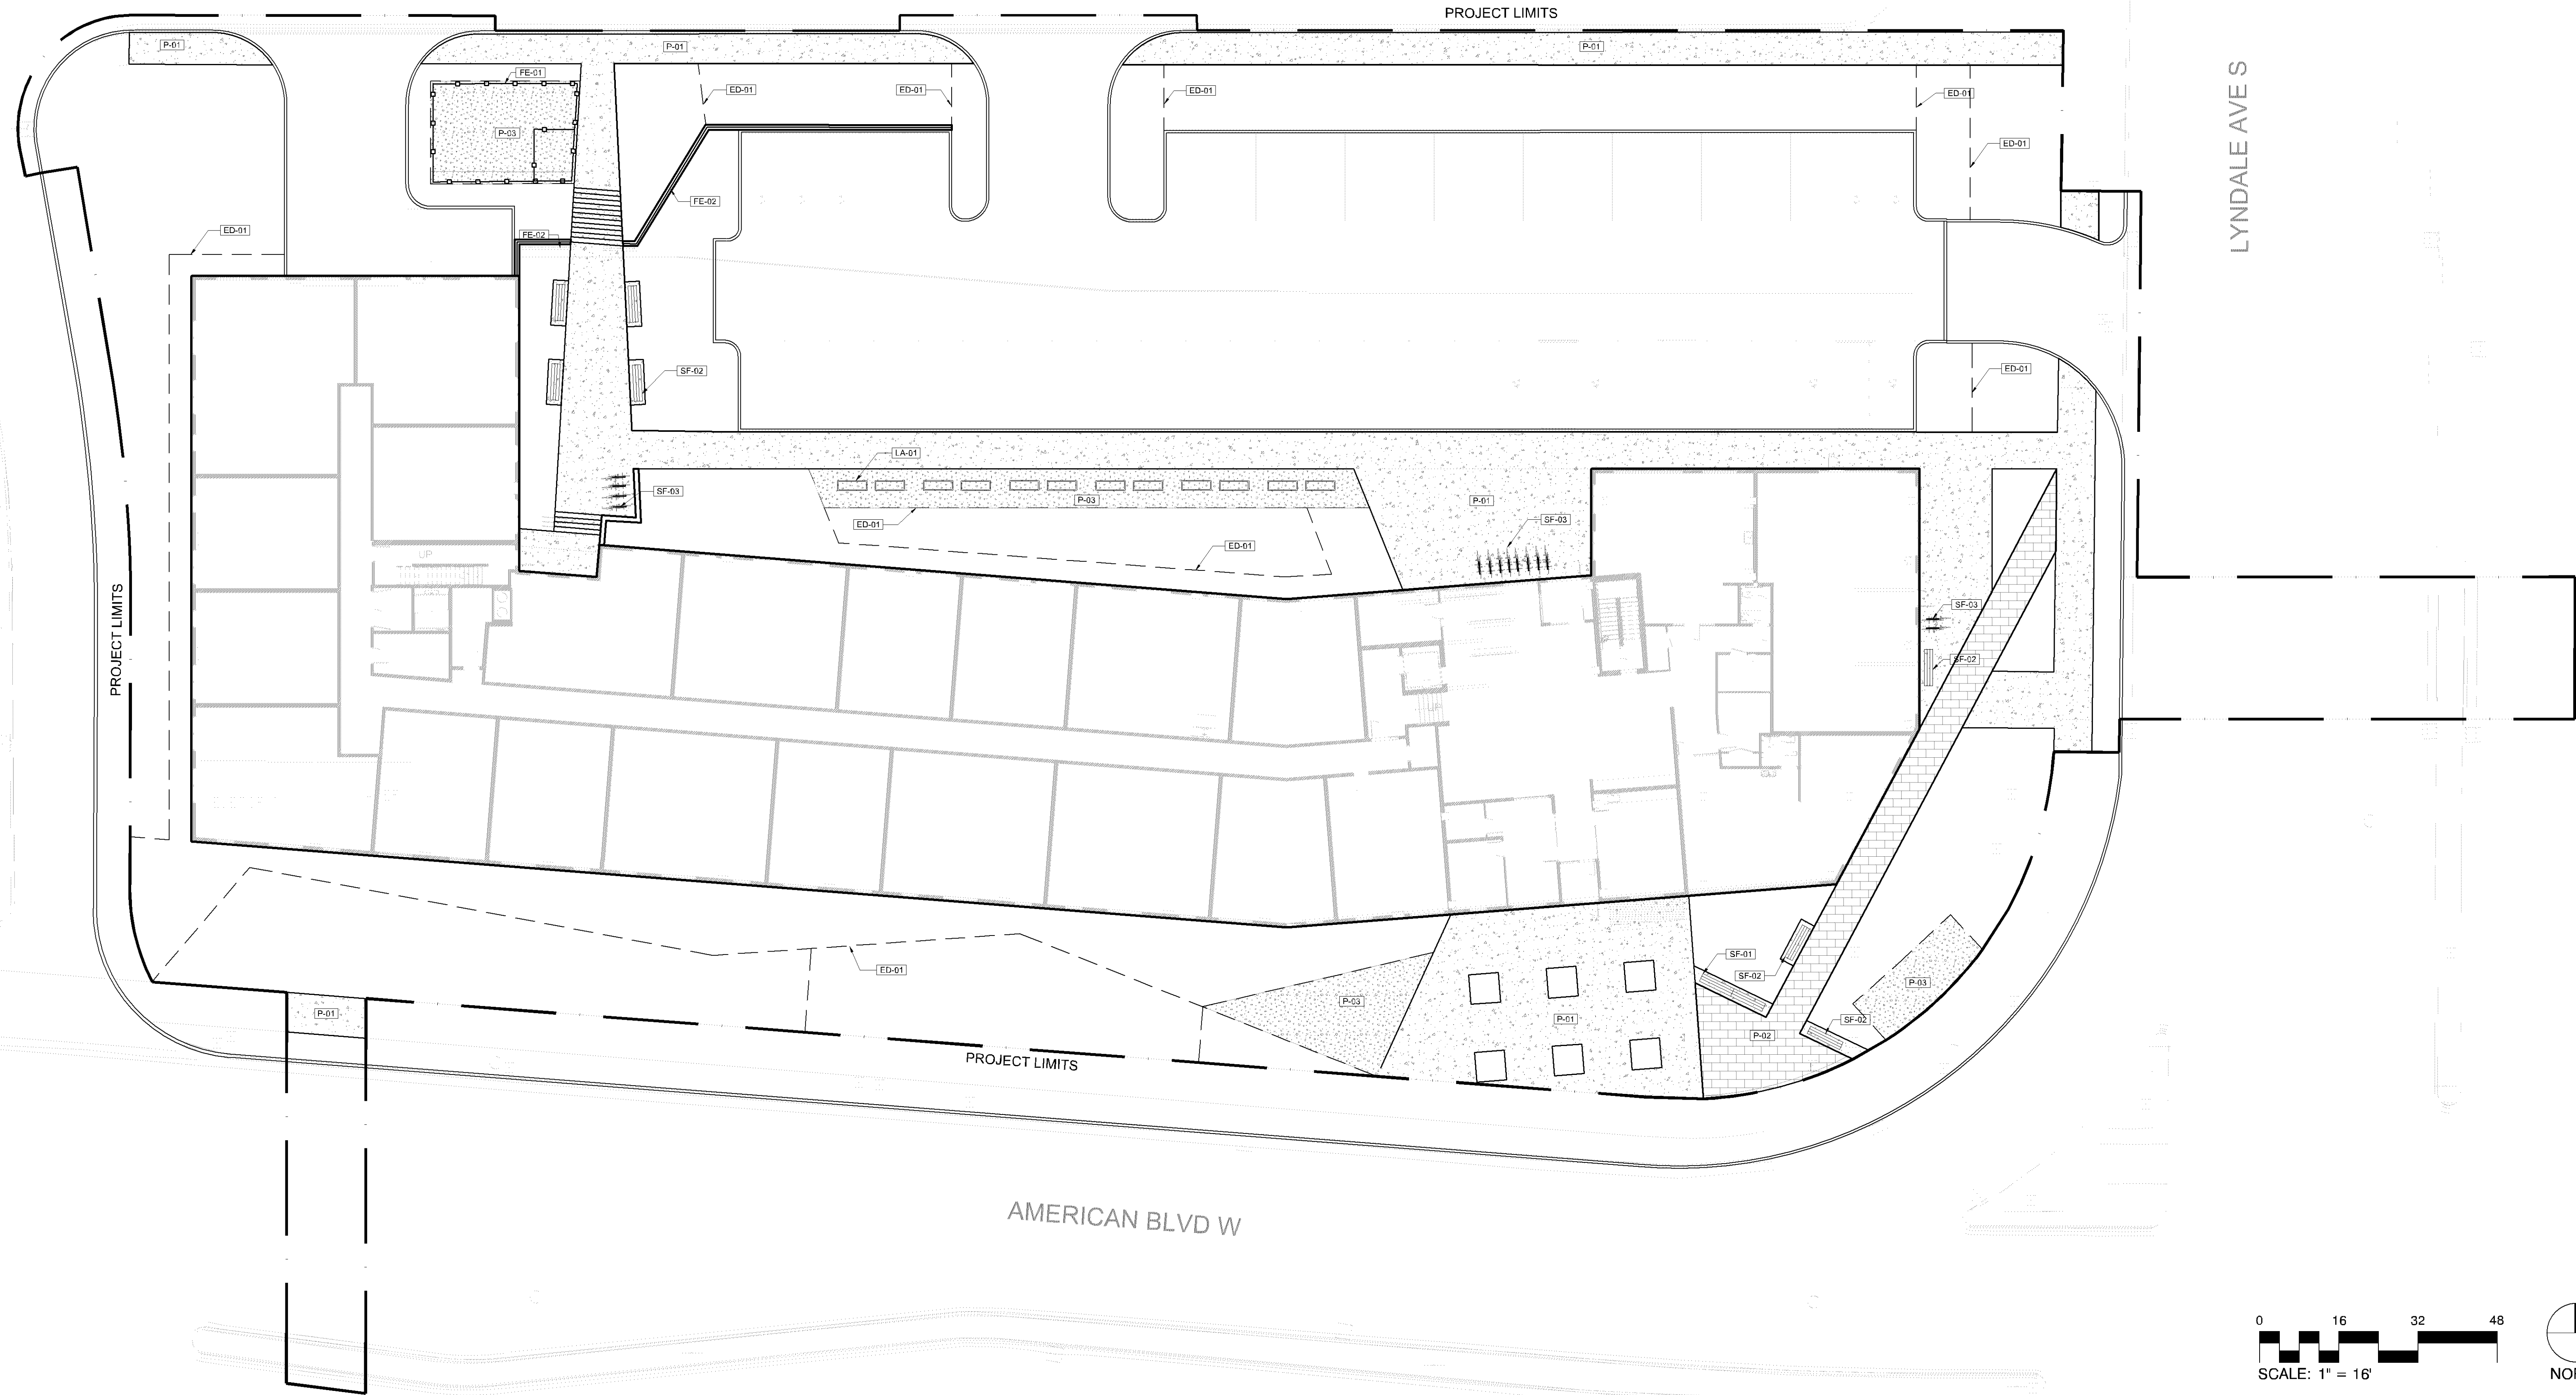

MATERIALS LEGEND

SYMBOL	EDGING DESCRIPTION	QTY	DETAIL	SYMBOL	SITE FURNITURE DESCRIPTION	QTY	DETAIL
ED-01	EDGING TYPE 1 - STEEL EDGER	986 LF		SF-01	BENCH TYPE 1 - LANDSCAPE FORMS BANCAL - DOUBLE	1	
	FENCE & GUARDRAIL DESCRIPTION	QTY	DETAIL	SF-02	BENCH TYPE 2 - LANDSCAPE FORMS BANCAL - SINGLE	7	
FE-01	FENCE TYPE 1 - CHAIN LINK - 4.5'	282 LF		SF-03	BIKE RACK	14	
FE-02	FENCE TYPE 2 - GUARDRAIL	97 LF					
	LANDSCAPE AMENITY DESCRIPTION	QTY	DETAIL				
LA-01	COMMUNITY GARDEN PLANTER	12					
	PAVING DESCRIPTION	QTY	DETAIL				
P-01	PAVING TYPE 1 - CONCRETE WALK	10,040 SF					
P-02	PAVING TYPE 2 - PERVIOUS PAVERS	1,282 SF					
P-03	PAVING TYPE 3 - CRUSHED STONE	2,284 SF					

SR - 700 American
700 W AMERICAN BLVD / BLOOMINGTON, MN

URBANWORKS
© URBANWORKS ARCHITECTURE LLC 2023
901 NORTH THIRD STREET, SUITE 45, MINNEAPOLIS, MN 55401

CONSULTANT
DF/
DAMON FARBER
LANDSCAPE ARCHITECTS

PRELIMINARY
NOT FOR CONSTRUCTION

SCHEMATIC DESIGN
CITY SUBMITTAL
10.11.2023


REVISIONS

DATE 10/11/2023
PROJECT # 23-001
PHASE SCHEMATIC DESIGN
DRAWN BY BMS
CHECKED BY JS

HARDSCAPE PLAN

10/25/2023 3:31:54 PM C:\Users\Project\Files\23-001_AZ2_Central_Arch\dwg\l110.dwg

PL202300178

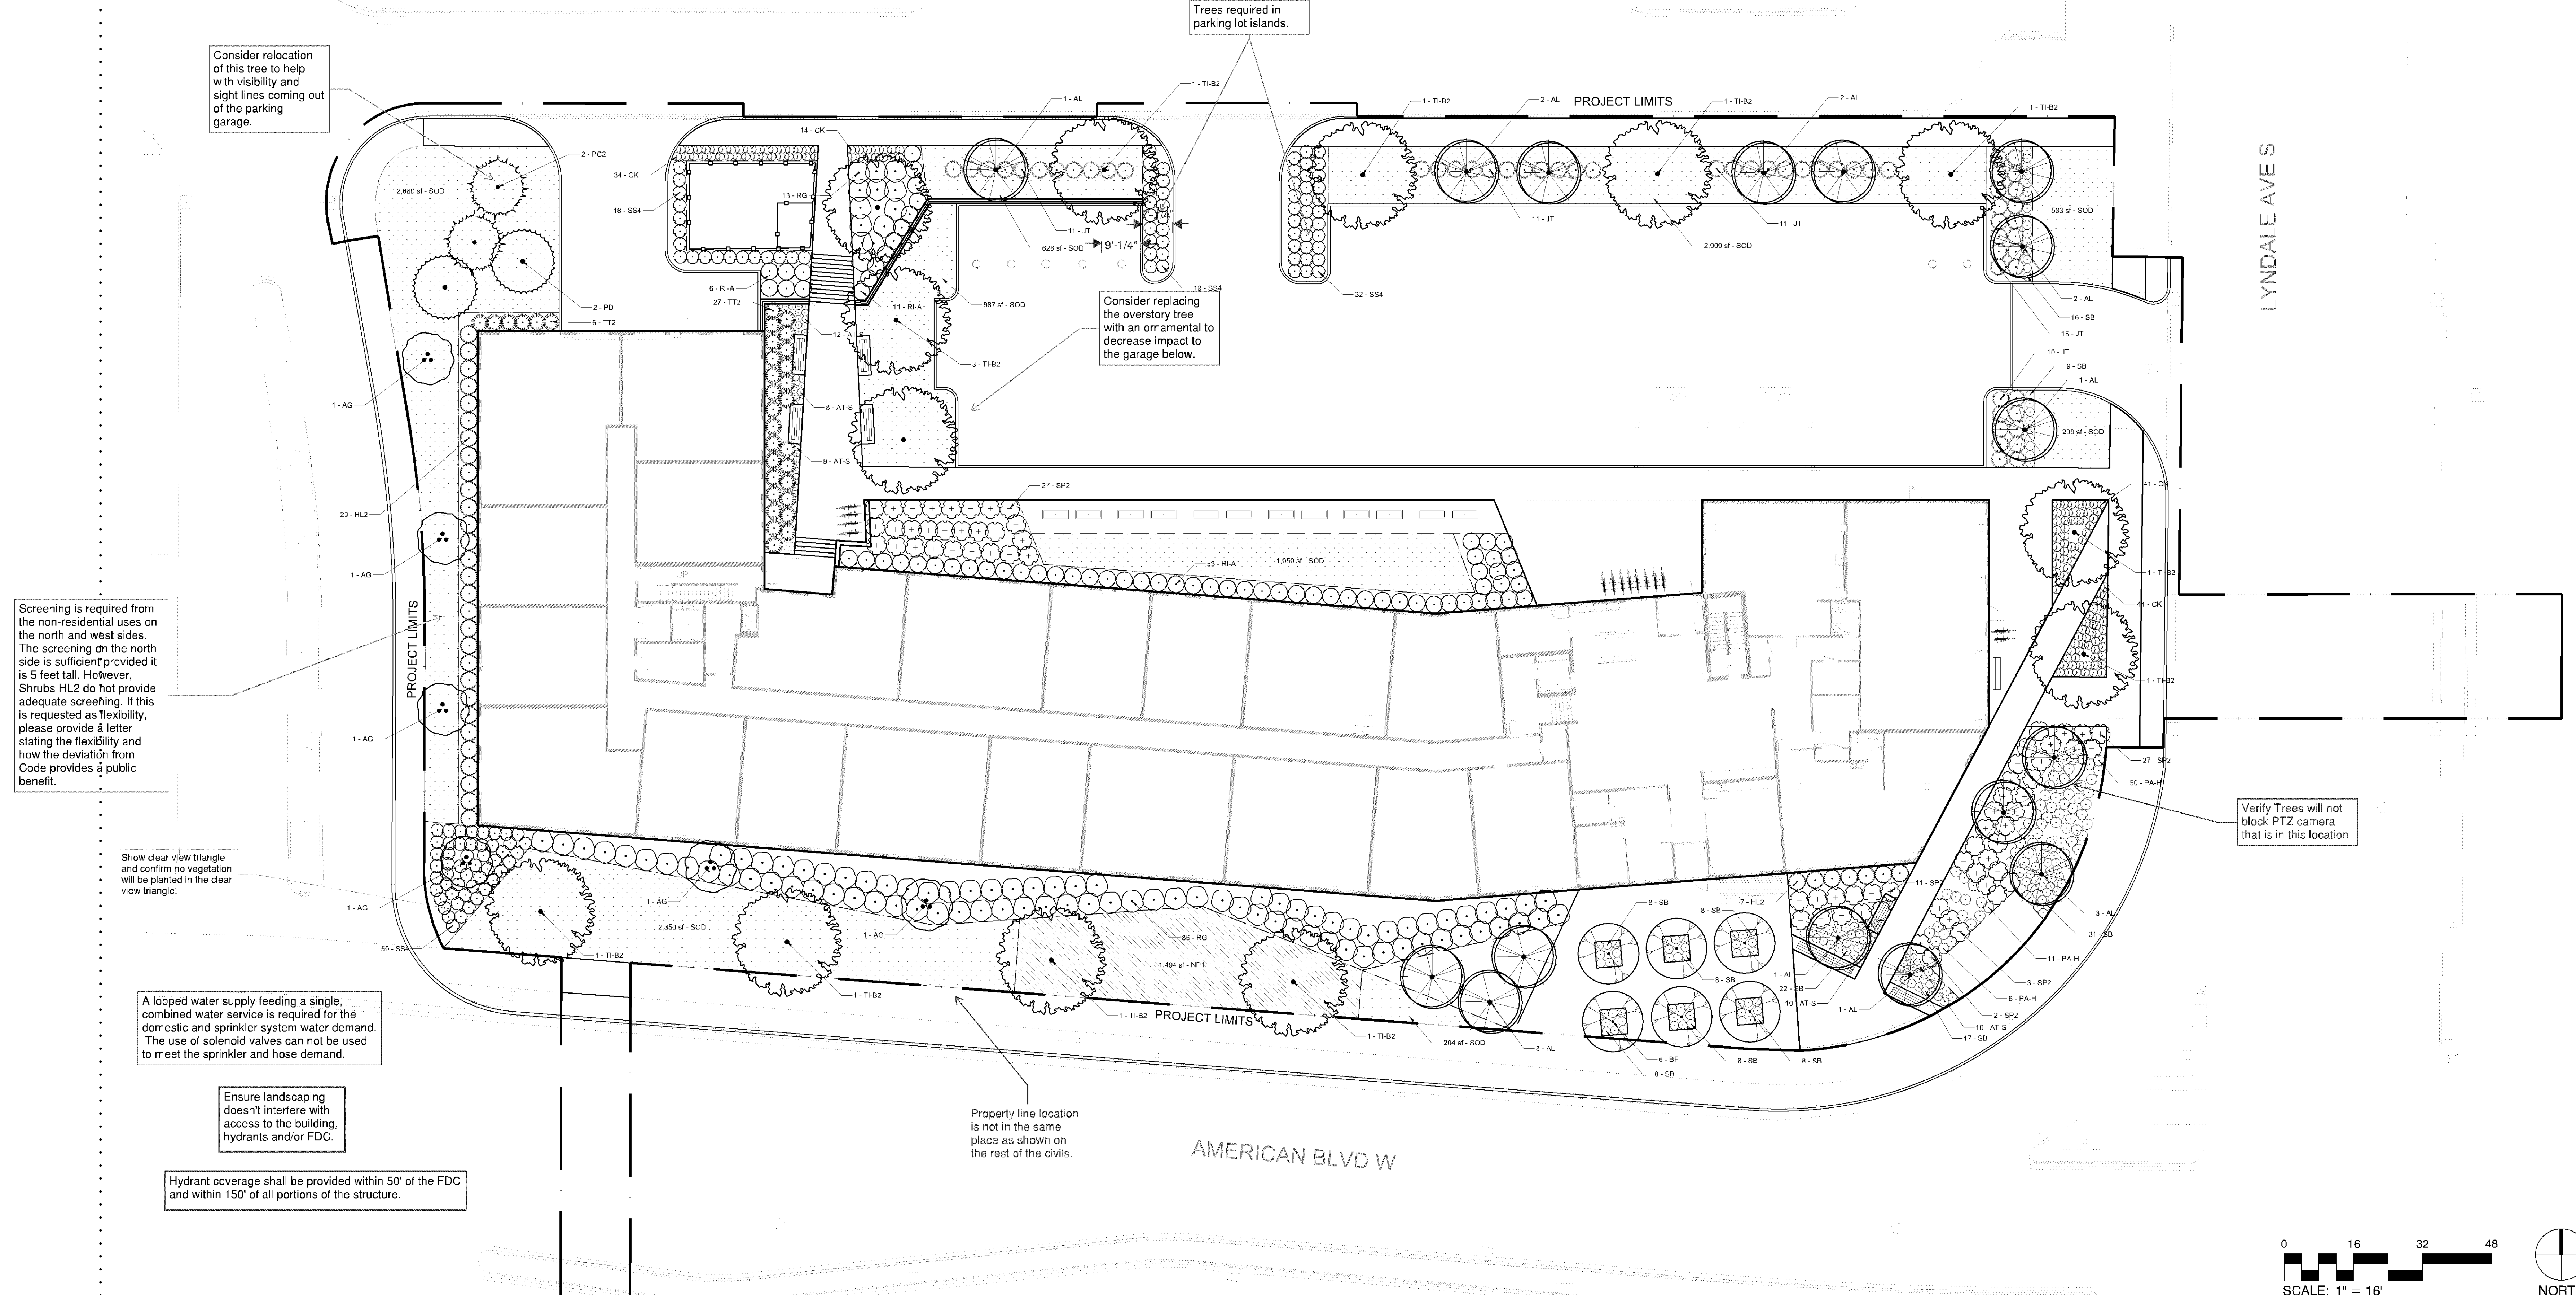

Consider relocation of this tree to help with visibility and sight lines coming out of the parking garage.

Screening is required from the non-residential uses on the north and west sides. The screening on the north side is sufficient provided it is 5 feet tall. However, Shrubs HL2 do not provide adequate screening. If this is requested as flexibility, please provide a letter stating the flexibility and how the deviation from Code provides a public benefit.

Show clear view triangle and confirm no vegetation will be planted in the clear view triangle.

A looped water supply feeding a single, combined water service is required for the domestic and sprinkler system water demand. The use of solenoid valves can not be used to meet the sprinkler and hose demand.

Ensure landscaping doesn't interfere with access to the building, hydrants and/or FDC.

Hydrant coverage shall be provided within 50' of the FDC and within 150' of all portions of the structure.


Trees required in parking lot islands.

Consider replacing the overstory tree with an ornamental to decrease impact to the garage below.

LYNDALE AVE S

AMERICAN BLVD W

Verify Trees will not block PTZ camera that is in this location

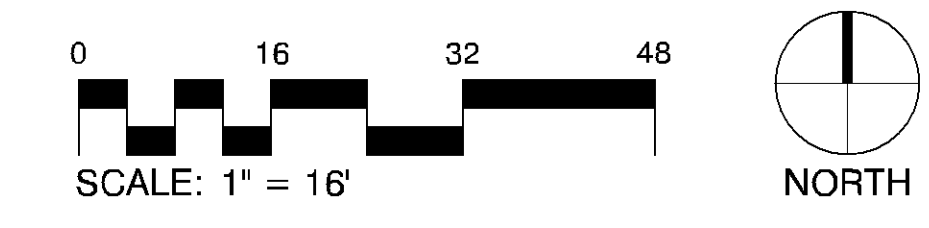

PLANT LEGEND

DECIDUOUS TREES	CODE	QTY	BOTANICAL / COMMON NAME
	AL	16	ACER RUBRUM 'ARMSTRONG' / ARMSTRONG MAPLE
	BF	6	BETULA PLATYPHYLLA 'FARGO' TM / DAKOTA PINNACLE WHITE BIRCH
	TI-B2	13	TILIA AMERICANA 'BOULEVARD' / BOULEVARD LINDEN
EVERGREEN TREES	CODE	QTY	BOTANICAL / COMMON NAME
	PD	2	PICEA GLAUCA 'DENSATA' / BLACK HILLS SPRUCE
	PC2	2	PINUS CEMBRA / SWISS STONE PINE
ORNAMENTAL TREES	CODE	QTY	BOTANICAL / COMMON NAME
	AG	6	AMELANCHIER X GRANDIFLORA 'AUTUMN BRILLIANCE' / 'AUTUMN BRILLIANCE' SERVICEBERRY
DECIDUOUS SHRUBS	CODE	QTY	BOTANICAL / COMMON NAME
	HL2	36	HYDRANGEA PANICULATA 'LITTLE LIME' / LITTLE LIME HYDRANGEA
	RG	99	RHUS AROMATICA 'GRO-LOW' / GRO-LOW FRAGRANT SUMAC
	RI-A	70	RIBES ALPINUM / ALPINE CURRANT
	SP2	70	SALIX PURPUREA 'NANA' / DWARF ARCTIC WILLOW
	SS4	119	SORBARIA SORBIFOLIA 'SEM' / SEM ASH LEAF SPIREA

EVERGREEN SHRUBS	CODE	QTY	BOTANICAL / COMMON NAME
	JT	59	JUNIPERUS CHINENSIS 'MONLEP' / MINT JULEP® CHINESE JUNIPER
	TT2	33	TAXUS X MEDIA 'TAUNTONII' / TAUNTON YEW
GRASSES	CODE	QTY	BOTANICAL / COMMON NAME
	CK	133	CALAMAGROSTIS X ACUTIFLORA 'KARL FOERSTER' / FEATHER REED GRASS
	PA-H	67	PANICUM VIRGATUM 'HEAVY METAL' / HEAVY METAL SWITCH GRASS
	SB	143	SCHIZACHYRIUM SCOPARIUM 'BLUE HEAVEN' / BLUE HEAVEN LITTLE BLUESTEM
PERENNIALS	CODE	QTY	BOTANICAL / COMMON NAME
	AT-S	49	ALLIUM TANGUTICUM 'SUMMER BEAUTY' / SUMMER BEAUTY GLOBE LILY
GROUND COVERS	CODE	QTY	BOTANICAL / COMMON NAME
	SOD	10,779 SF	SOD
NATIVE PERENNIALS	CODE	QTY	BOTANICAL / COMMON NAME
	SM1	1,494 SF	RAIN GARDEN PLANTING MIX

SR - 700 American
700 W AMERICAN BLVD / BLOOMINGTON, MN

URBANWORKS
© URBANWORKS ARCHITECTURE LLC 2023
901 NORTH THIRD STREET, SUITE 445, MINNEAPOLIS, MN 55401

CONSULTANT
DF/
DAMON FARBER
LANDSCAPE ARCHITECTS

PRELIMINARY
NOT FOR CONSTRUCTION

SCHEMATIC DESIGN
CITY SUBMITTAL
10.11.2023


REVISIONS

DATE 10/11/2023
PROJECT # 23-001
PHASE SCHEMATIC DESIGN
DRAWN BY SMS
CHECKED BY JS


LANDSCAPE PLAN

L140


bike rack detail not included - Site plan references this sheet for bike rack detail

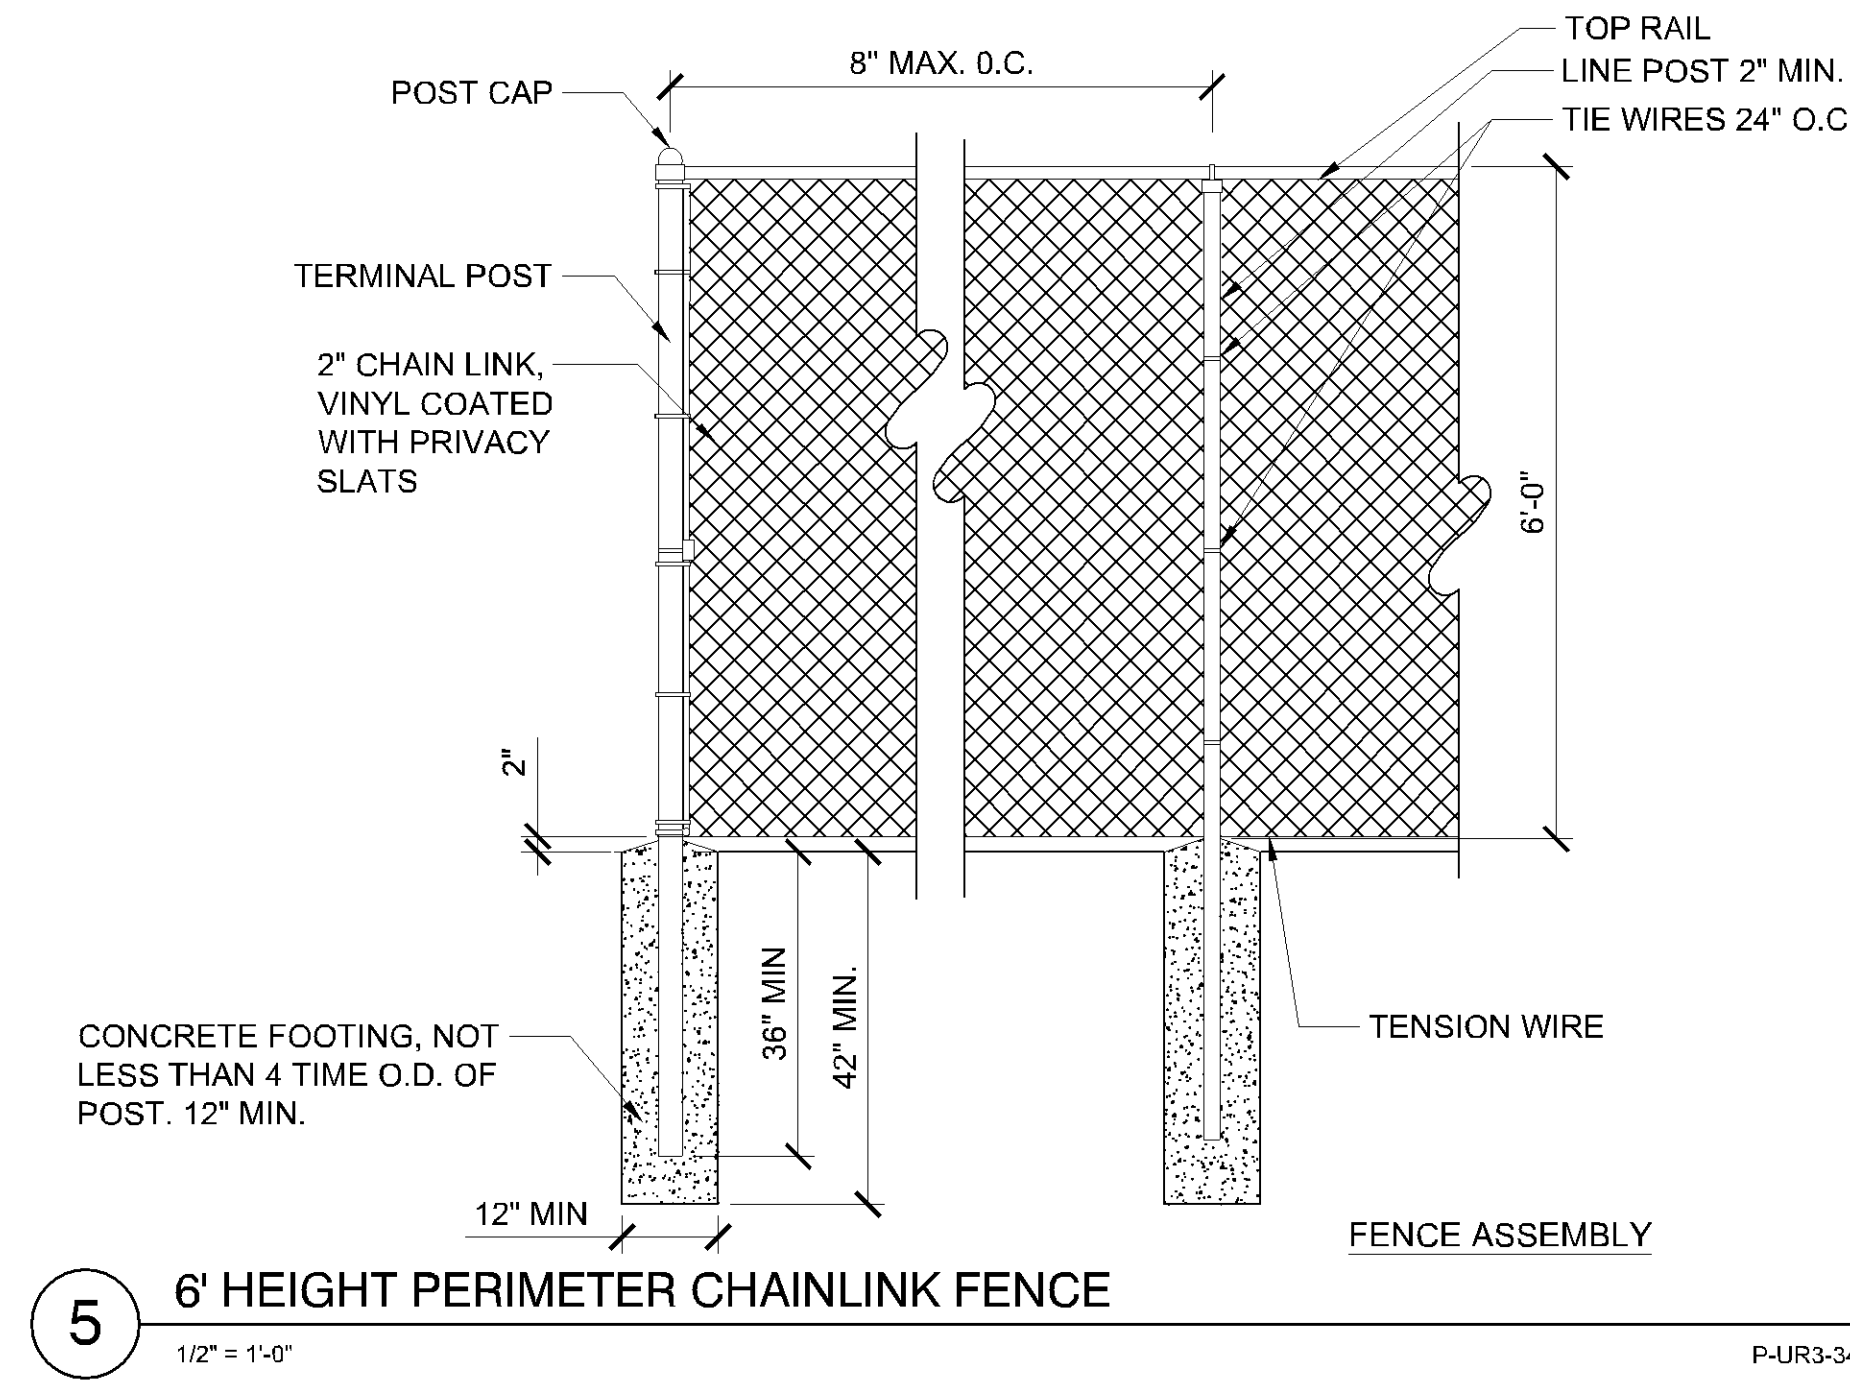


5 6' HEIGHT PERIMETER CHAINLINK FENCE
1/2" = 1'-0" P-UR3-34

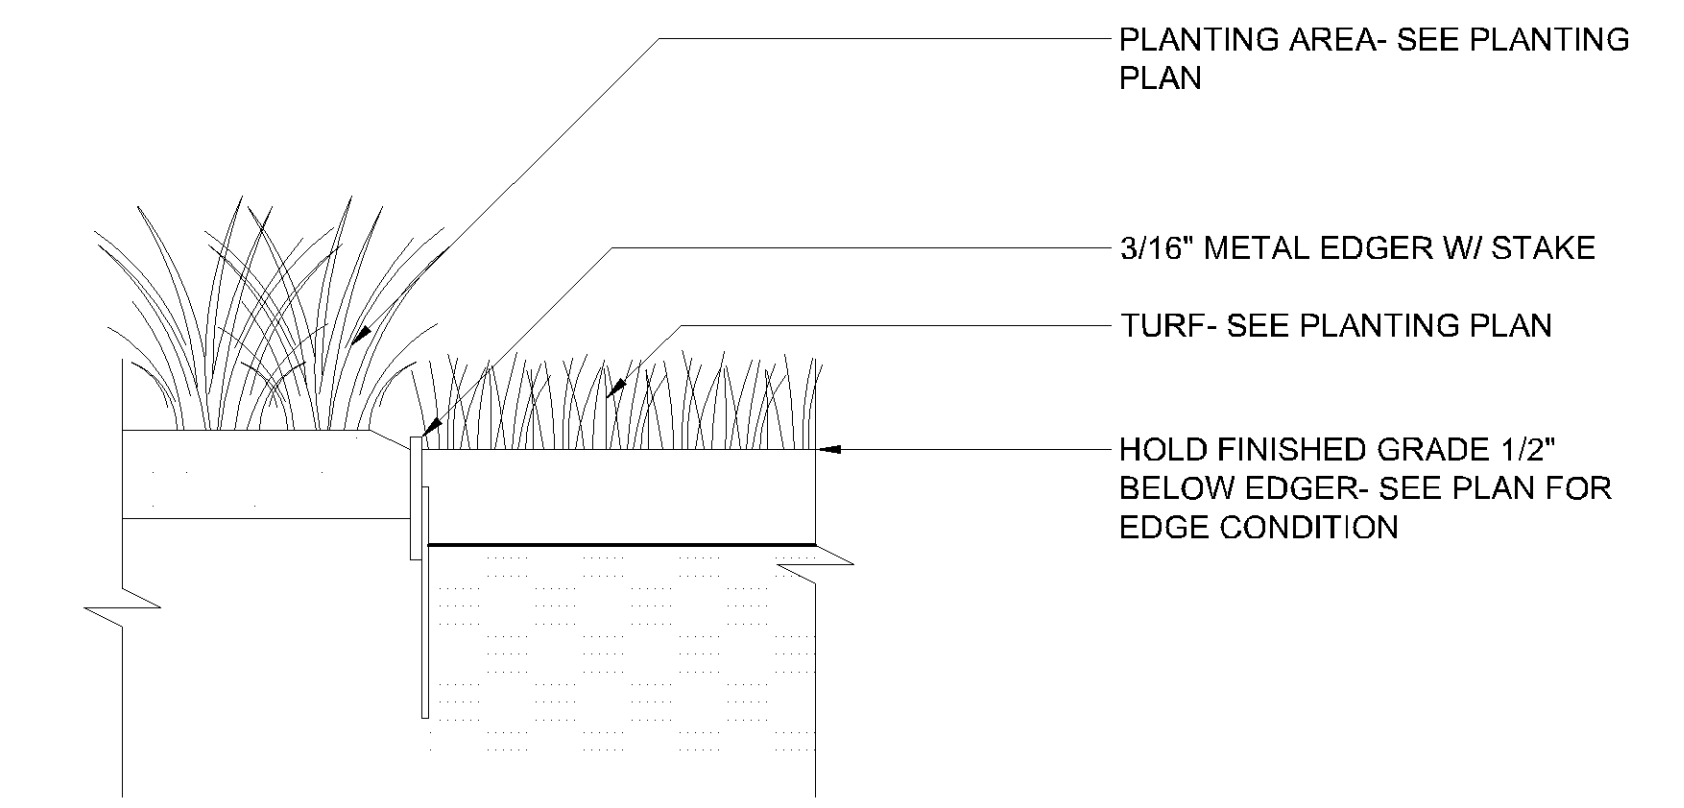


4 DETAIL - STEEL EDGER
1 1/2" = 1'-0" P-UR3-09

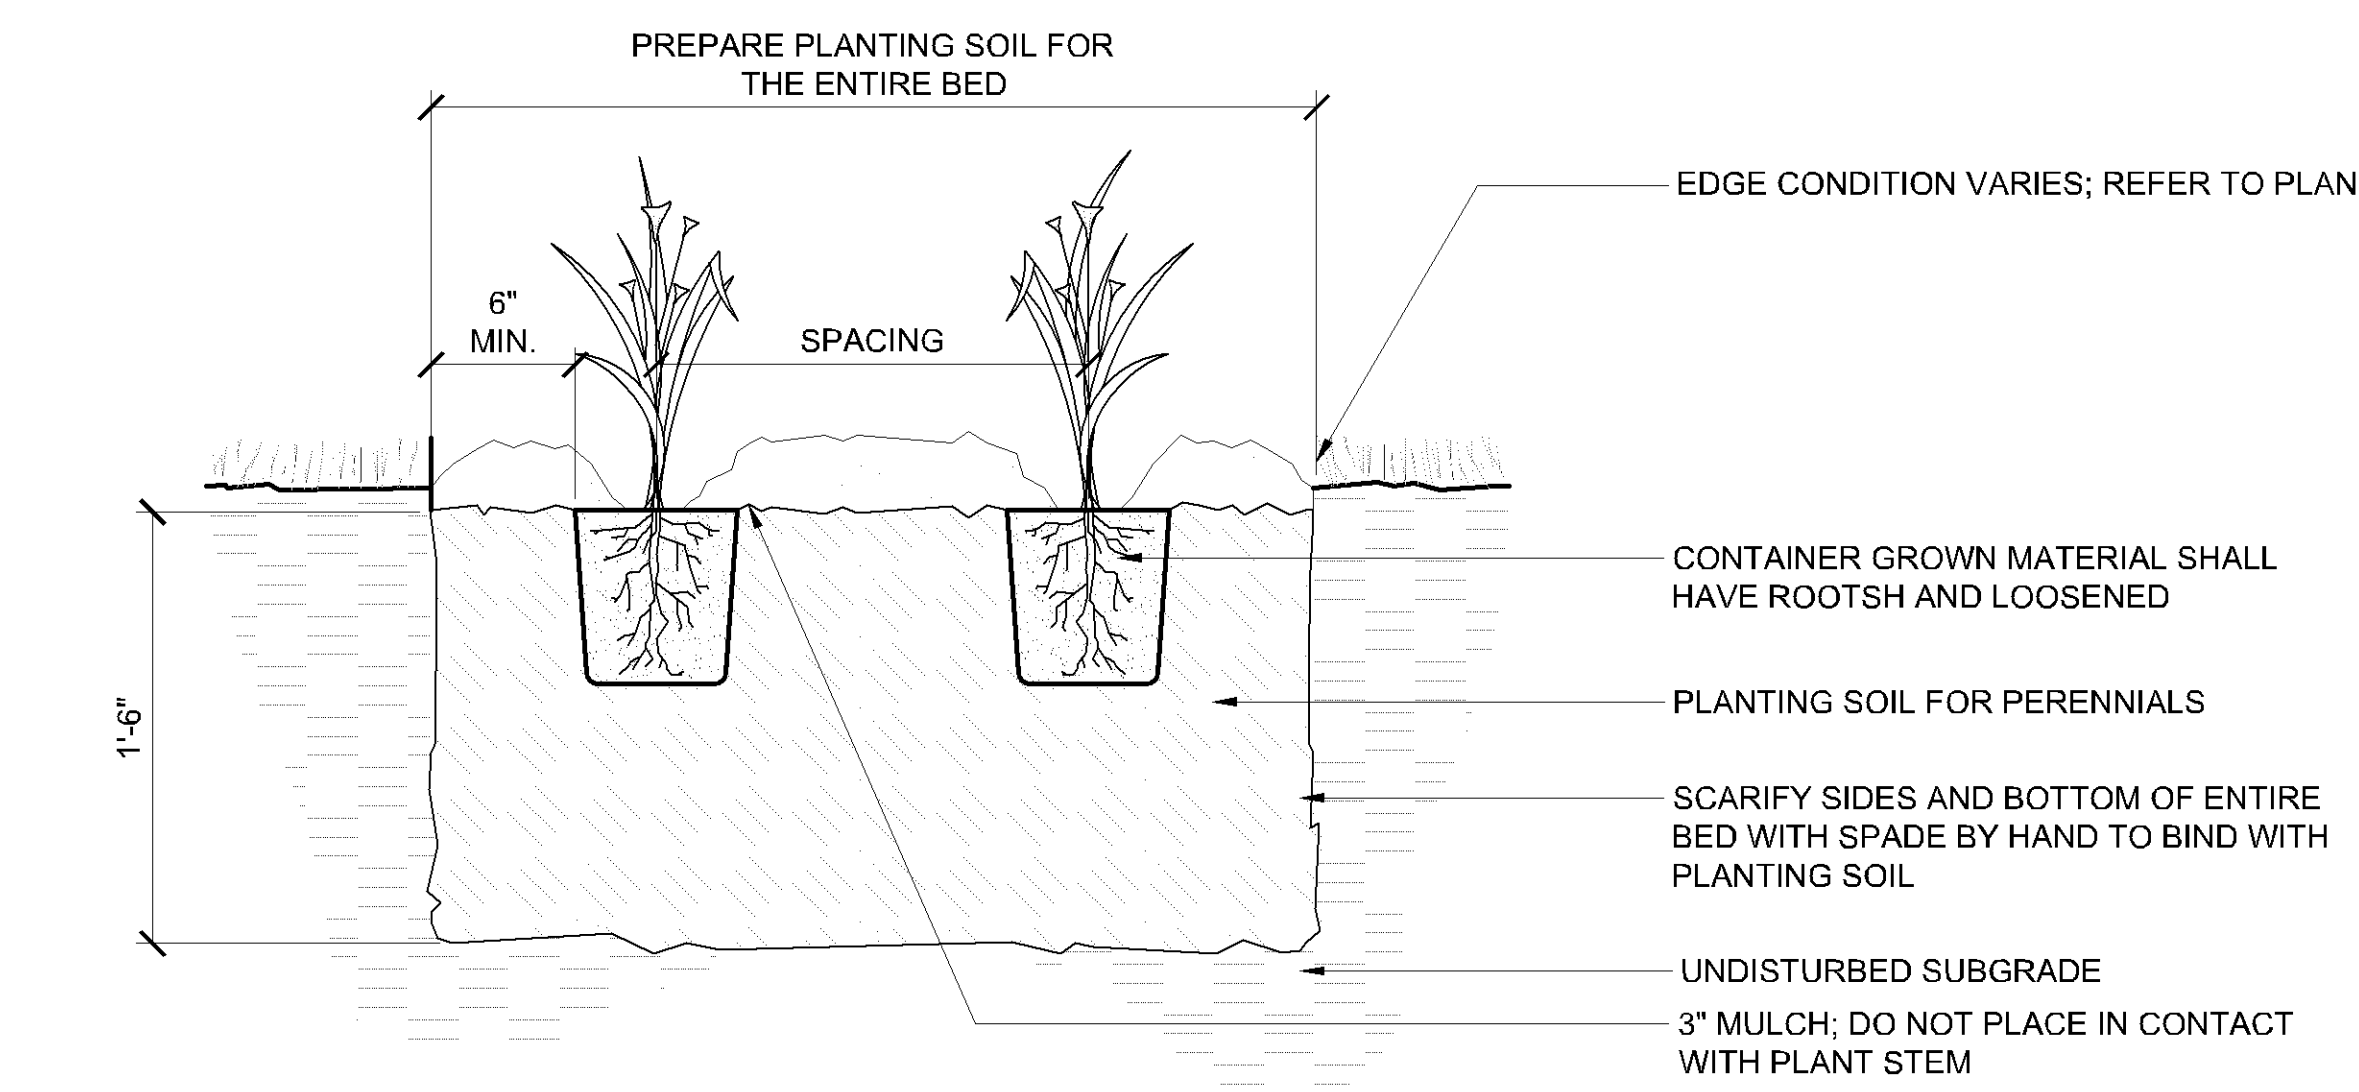

3 DETAIL - PERENNIAL PLANTING
1 1/2" = 1'-0" P-UR3-04

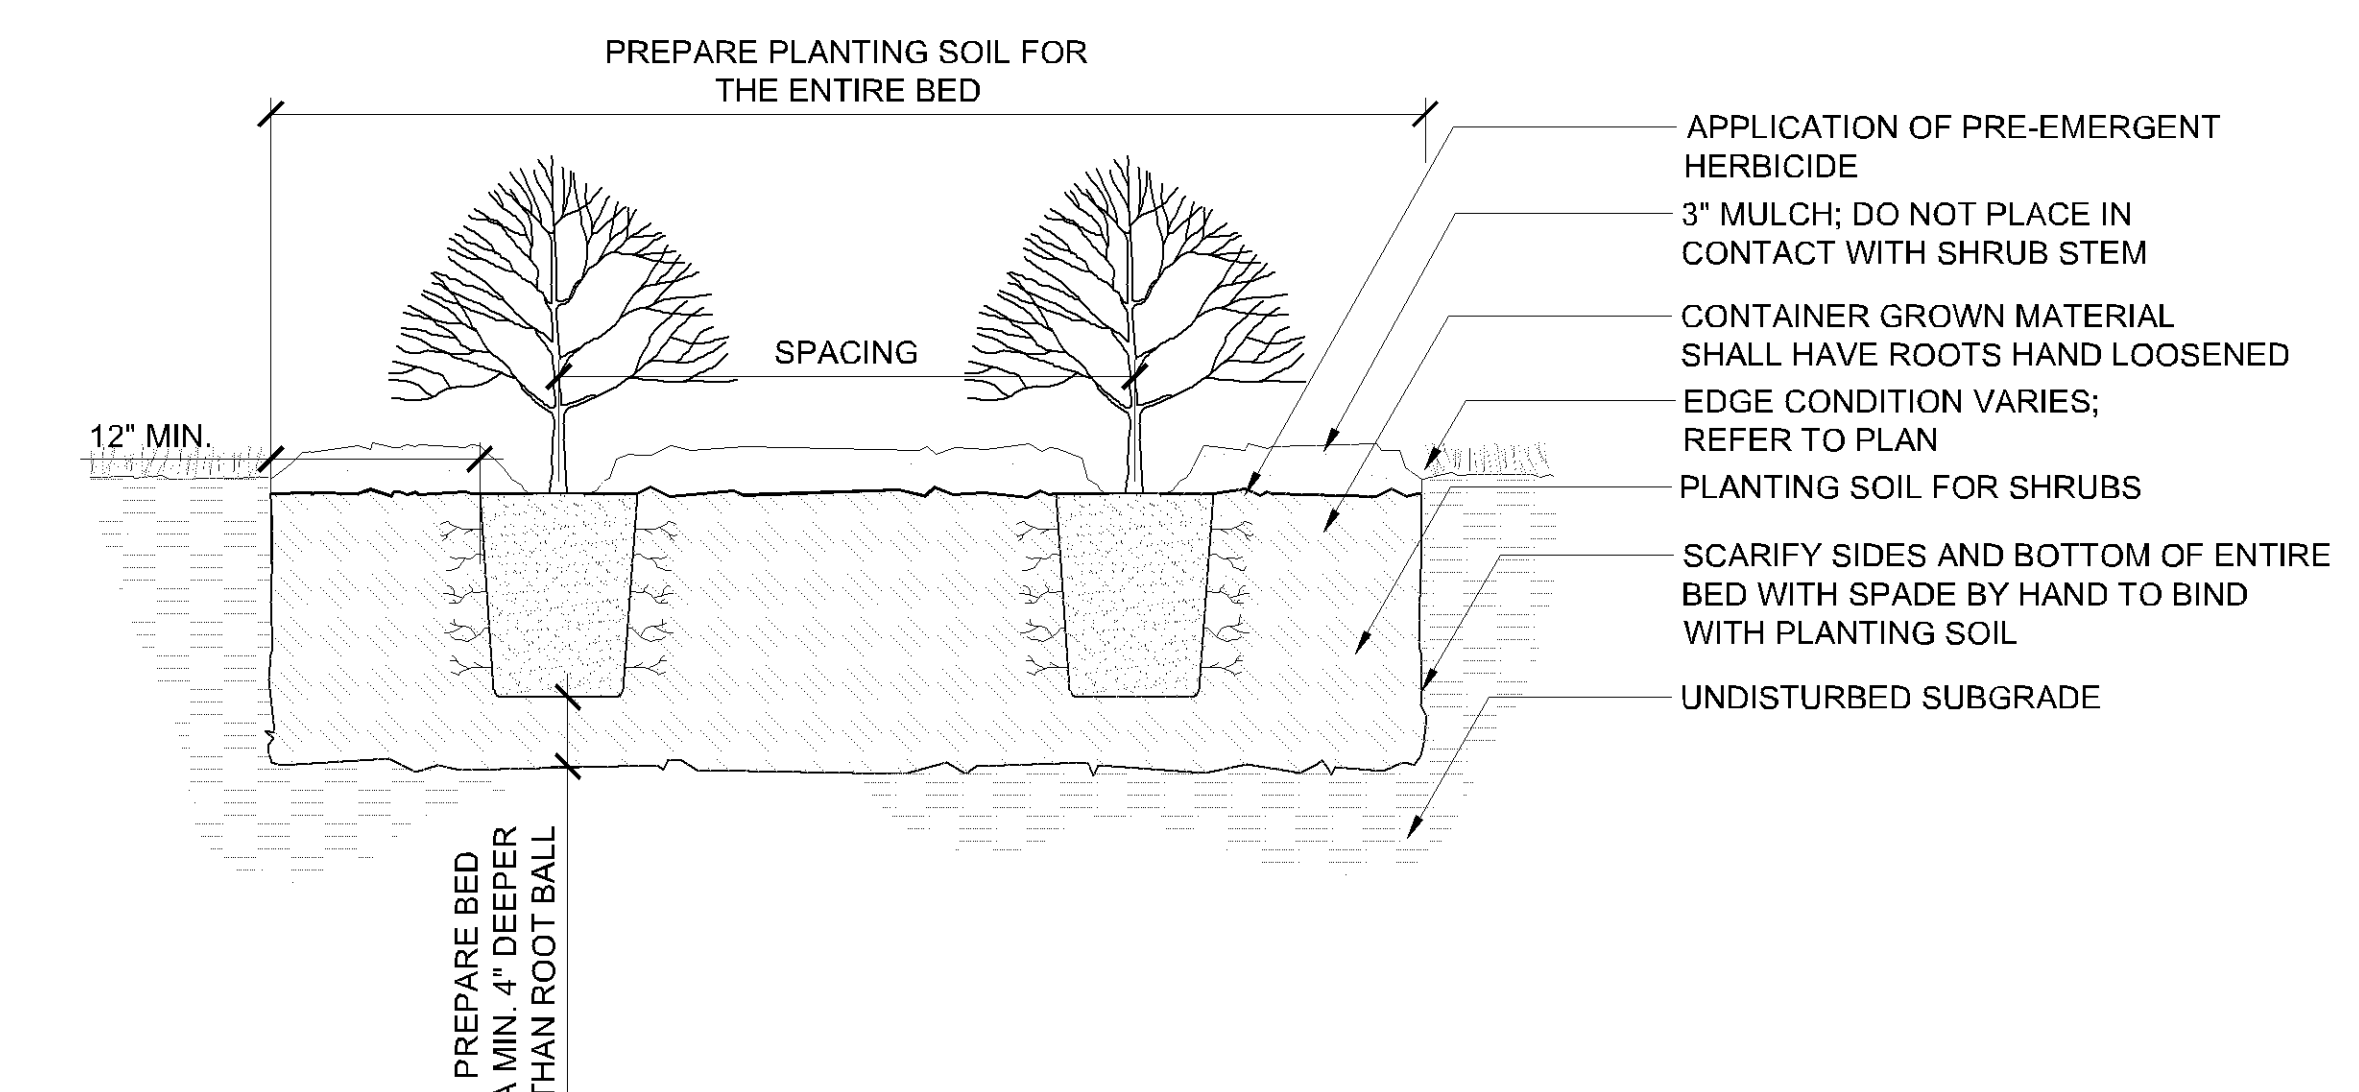

2 DETAIL - SHRUB PLANTING
1" = 1'-0" P-UR3-02

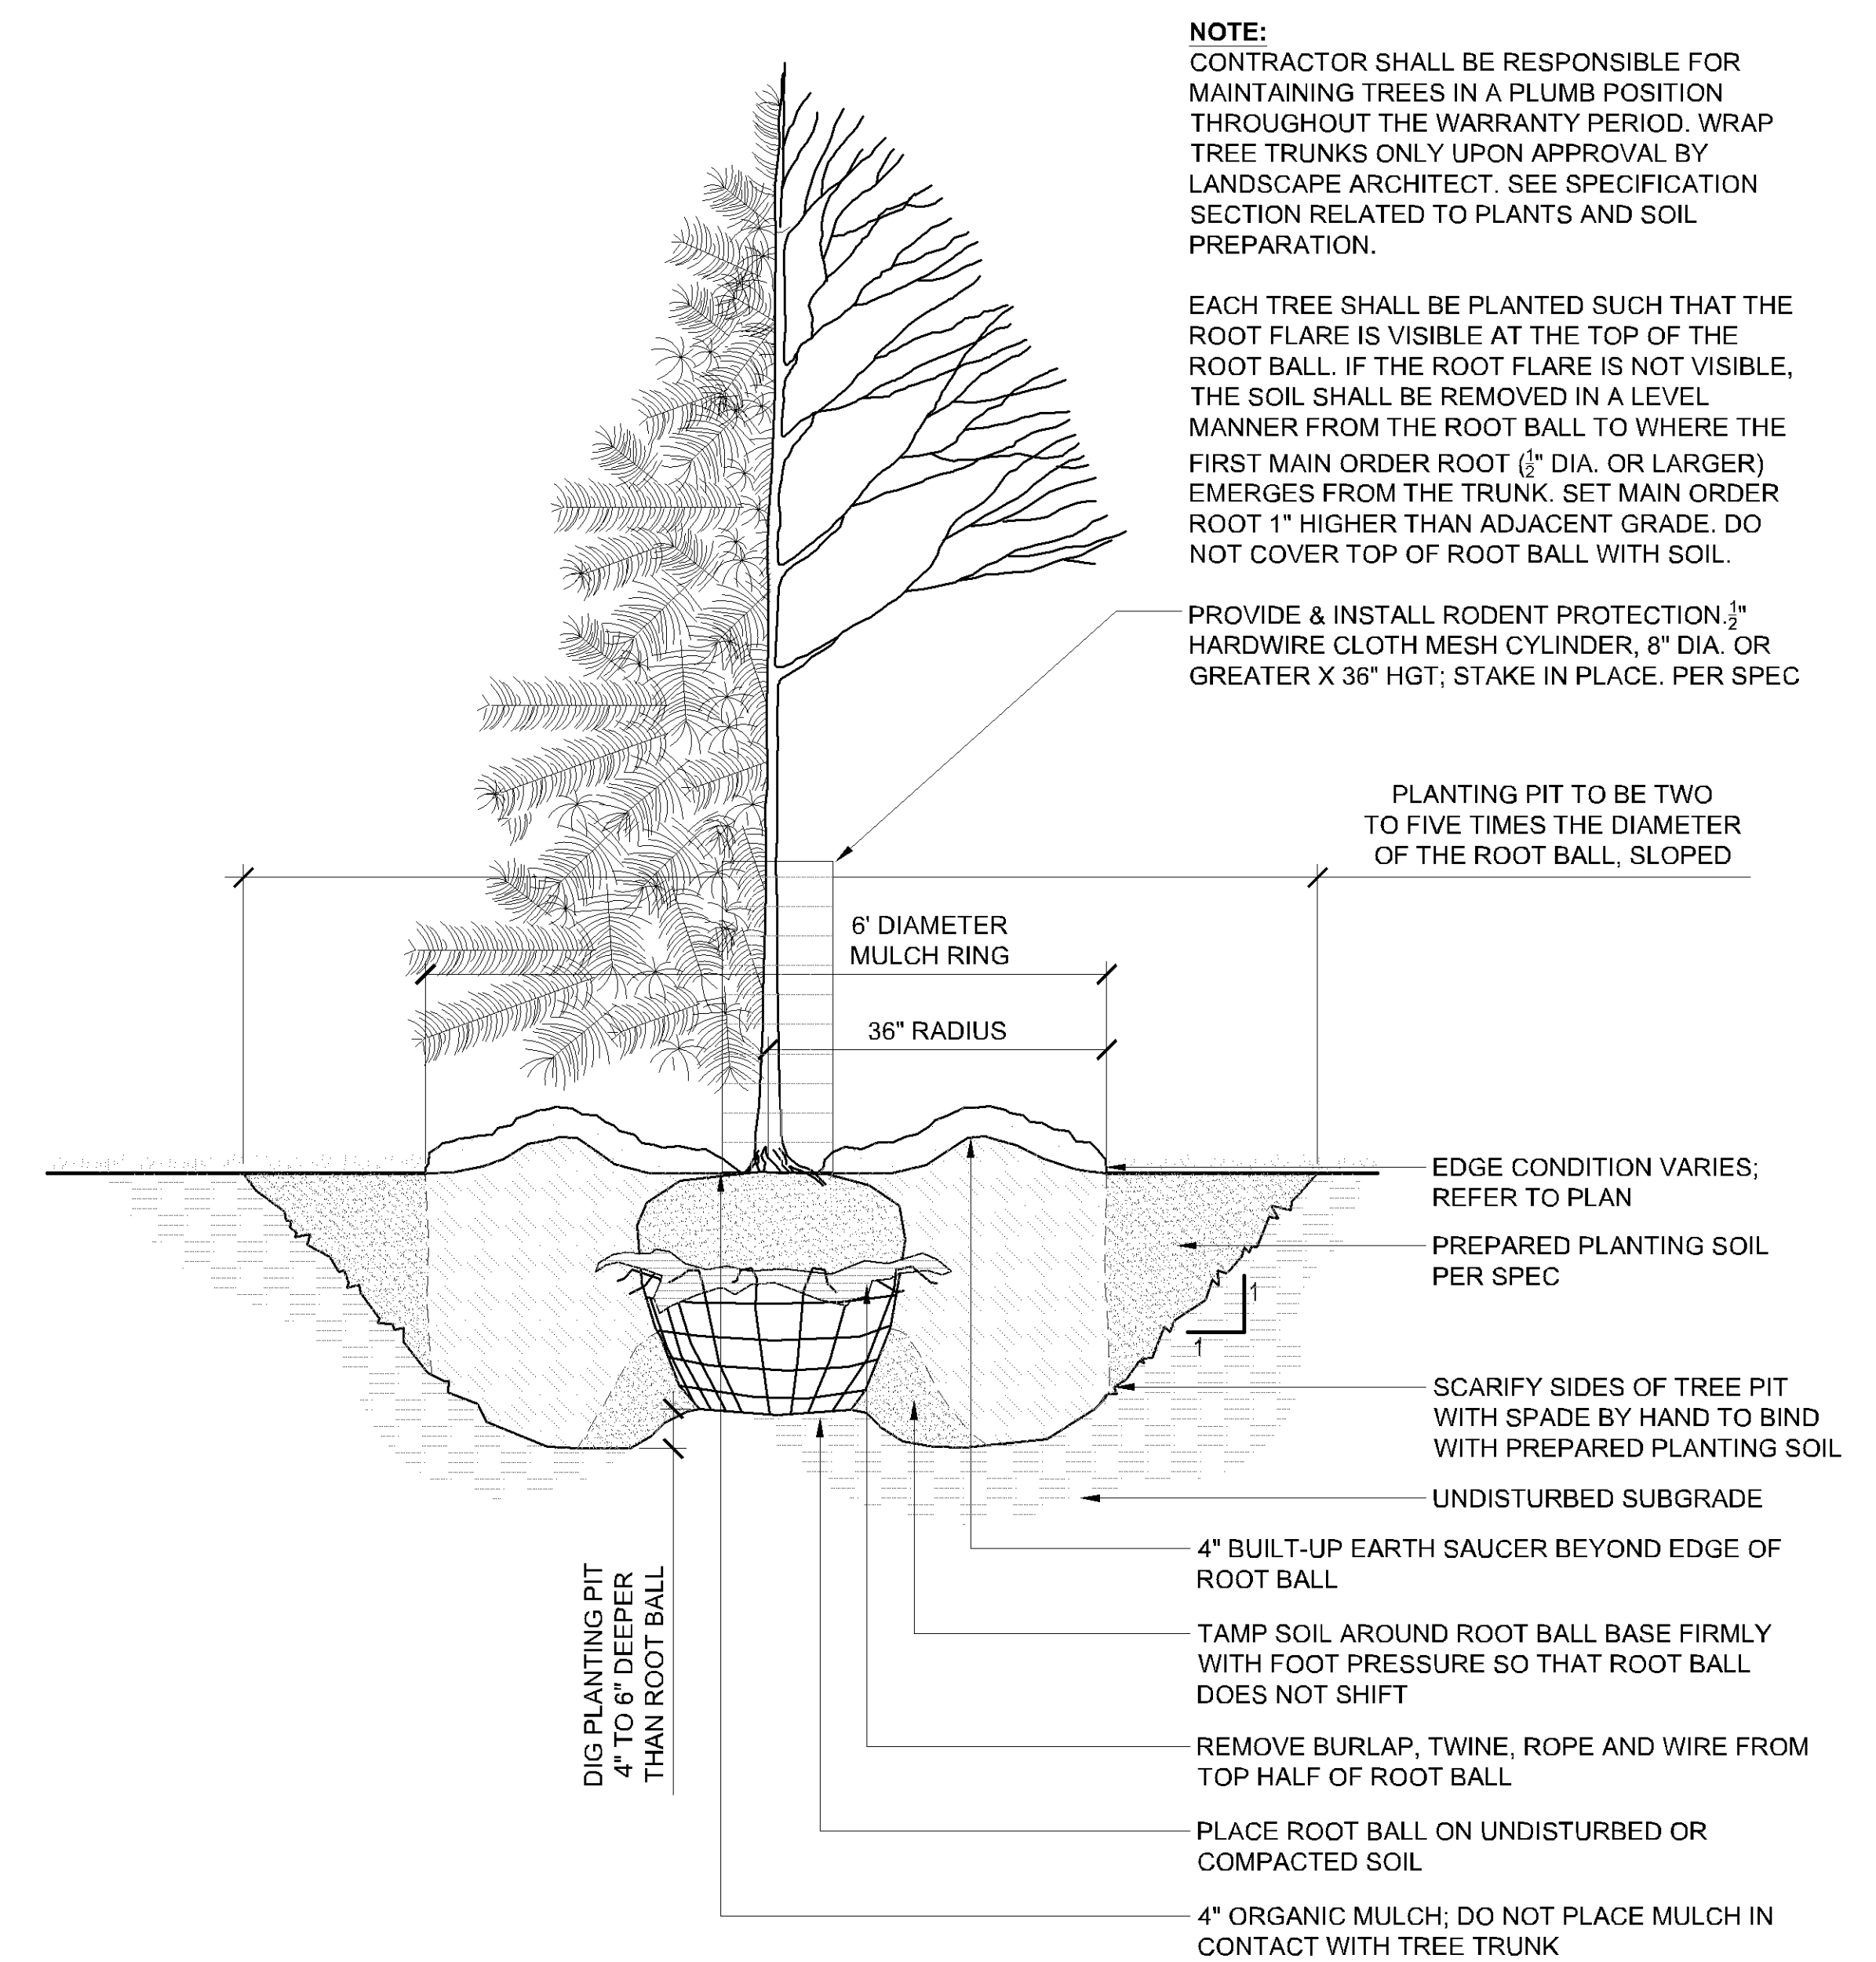

1 DETAIL - TREE PLANTING
3/4" = 1'-0" P-UR3-01

SR - 700 American
700 W AMERICAN BLVD / BLOOMINGTON, MN

URBANWORKS

CONSULTANT
DF/
DAMON FARBER
LANDSCAPE ARCHITECTS
PRELIMINARY
NOT FOR CONSTRUCTION
SCHEMATIC DESIGN
CITY SUBMITTAL
10.11.2023

REVISIONS

DATE	10/11/2023
PROJECT #	23-001
PHASE	SCHEMATIC DESIGN
DRAWN BY	BMS
CHECKED BY	JS

LANDSCAPE DETAILS
L500