

- EXISTING CONDITIONS**
- Background information shown in this survey by Landform, Minneapolis, MN, on August 02, 2022, expressly for this project. City of Bloomington, MN record drawings and utility service providers. Landform offers no warranty, expressed or written, for information provided in this survey. Existing project conditions shall be verified prior to beginning construction. Errors, omissions, or omissions discovered shall be reported to the Engineer IMMEDIATELY.
 - Geotechnical boring locations are approximate and are based on information provided in the Geotechnical Report prepared by NTL, Ramsey, MN, on June 08, 2011.
- DEMOLITION AND CLEARING NOTES**
- Obtain permits for demolition, clearing, and disposal prior to beginning.
 - Contact city service providers for field location of services 72 hours prior to beginning demolition and clearing.
 - See Sheet C3.1 for erosion prevention and sediment control measures that must be in place prior to disturbances to site.
 - Building condition: verify with owner that building has been cleared of regulated materials requiring special handling or disposal. Remove structures, columns, canopies, footings, foundations, and any associated construction in its entirety. Refer to Architectural and Structural for removal limits.
 - Dimensions shown for removal are approximate. Coordinate with new construction to ensure appropriate removal of existing facilities.
 - Pavement sawcut. Remove concrete walks and curbing to the nearest existing joint beyond construction limits.
 - Complete demolition with minimal disruption of traffic. Coordinate lane closures with the regulatory authority and provide advance notification to affected emergency response providers.
 - Provide barricades, lights, signs, traffic control, and other measures necessary for protection and safety of the public and maintain throughout construction.
 - Protect structures, utilities, trees, adjacent material, soil, and adjacent property from damage during construction unless noted for removal. Damage shall be repaired to equal or better condition at no additional cost.
 - Abandon walls and remove on-site sewage facilities prior to any other demolition in accordance with requirements of regulatory authorities.
 - Remove trees noted, including root structures, from the site. Coordinate with owner to mark trees to be saved or transplanted prior to clearing. Protect trees indicated with tree protection fencing per Detail C7.19.
 - Remove existing site features including, but not limited to, underground utilities, paving, curbing, sidewalks, fencing, retaining walls, screen walls, aprons, lighting, related foundations, signage, bollards, landscaping, and stormwater within the construction limits unless noted otherwise.
 - Coordinate removal, relocation, termination, and re-use of existing private utility services and appurtenances with the utility companies. Restore electric handholes, pullboxes, powerlines, guywires, and structures disturbed by construction in accordance with utility owner requirements.
 - Existing piping and conduits may be abandoned in-place if filled with sand and if not in location of proposed building or in conflict with proposed utilities or structures. Terminate existing services at the supply side in conformance with provider's standards.
 - Hour demolition debris off-site to a facility approved by regulatory authorities for the handling of demolition debris, unless noted otherwise.
 - Remove and salvage light pole for re-use. Refer to sheet C2.1 for proposed relocations.
 - All construction and post-construction parking and storage of equipment and materials must be on-site. Use of public streets for private construction parking, loading/unloading, and storage will not be allowed.

LEGEND

- Tree Removal
- Soil Boring
- Curb Removal
- Utility Line Removal
- Tree Protection per Detail C7.19

DEVELOPER
THE LUTHER COMPANY, LLLP
 3701 ALABAMA AVENUE SOUTH
 ST. LOUIS PARK, MN
 TEL: (612)252-8800 - FAX: (612) 252-8800

MUNICIPALITY

BLOOMINGTON

PROJECT
LUTHER HYUNDAI
BLOOMINGTON, MN
ISSUE/REVISION HISTORY

DATE	ISSUE/REVISION	REVIEW
10/02/2022	DWG SUBMITTAL	SES
11/09/2022	CITY SUBMITTAL	SES
08/MAR/2023	PERMITS	SES
30/MAR/2023	CITY INTERFERED/REQUIREMENT	SES
06/JUN/2023	CITY INTERFERED/REQUIREMENT	SES
11/JUL/2023	BULLETIN 05	SES
02/NOV/2023	BULLETIN 05	SES

CERTIFICATION

I hereby certify that this plan was prepared by me, or under my direct supervision, and that I am a duly Licensed Professional Engineer under the laws of the State of MINNESOTA.

S.P. Schulz

Steven E. Schulz
 License No. 47165 Date: 11/03/2022

Signature must be a legible reproduction of original. Not valid for other jobs or for a Landform Professional Services, LLC office and a valid license upon request.

IF THE SIGNATURE, SEAL OR EXPIRES DIRECTLY ABOVE ARE NOT VALID, THIS SHEET HAS BEEN REPRODUCED WITHOUT AUTHORITY. REQUESTER HAS NO LIABILITY TO ANY DOCUMENTS IN THIS CONTRACT. THE ENGINEER TO REQUEST ADDITIONAL DOCUMENTS.

BULLETIN 05
 NOVEMBER 03, 2023

LANDFORM
 From Site to Finish

105 South Fifth Avenue Tel: 612-252-9070
 Suite 513 Fax: 612-252-9077
 Minneapolis, MN 55401 Web: landform.net

FILE NAME: C101LUT2054.DWG
 PROJECT NO: LUT2054

811
 Know what's Below.
 Call before you dig.


NORTH

0 30 60

EXISTING CONDITIONS & DEMOLITION
C1.1

Landform and Steve Schulz are registered professional engineers of Landform Professional Services, LLC.

PL202300187

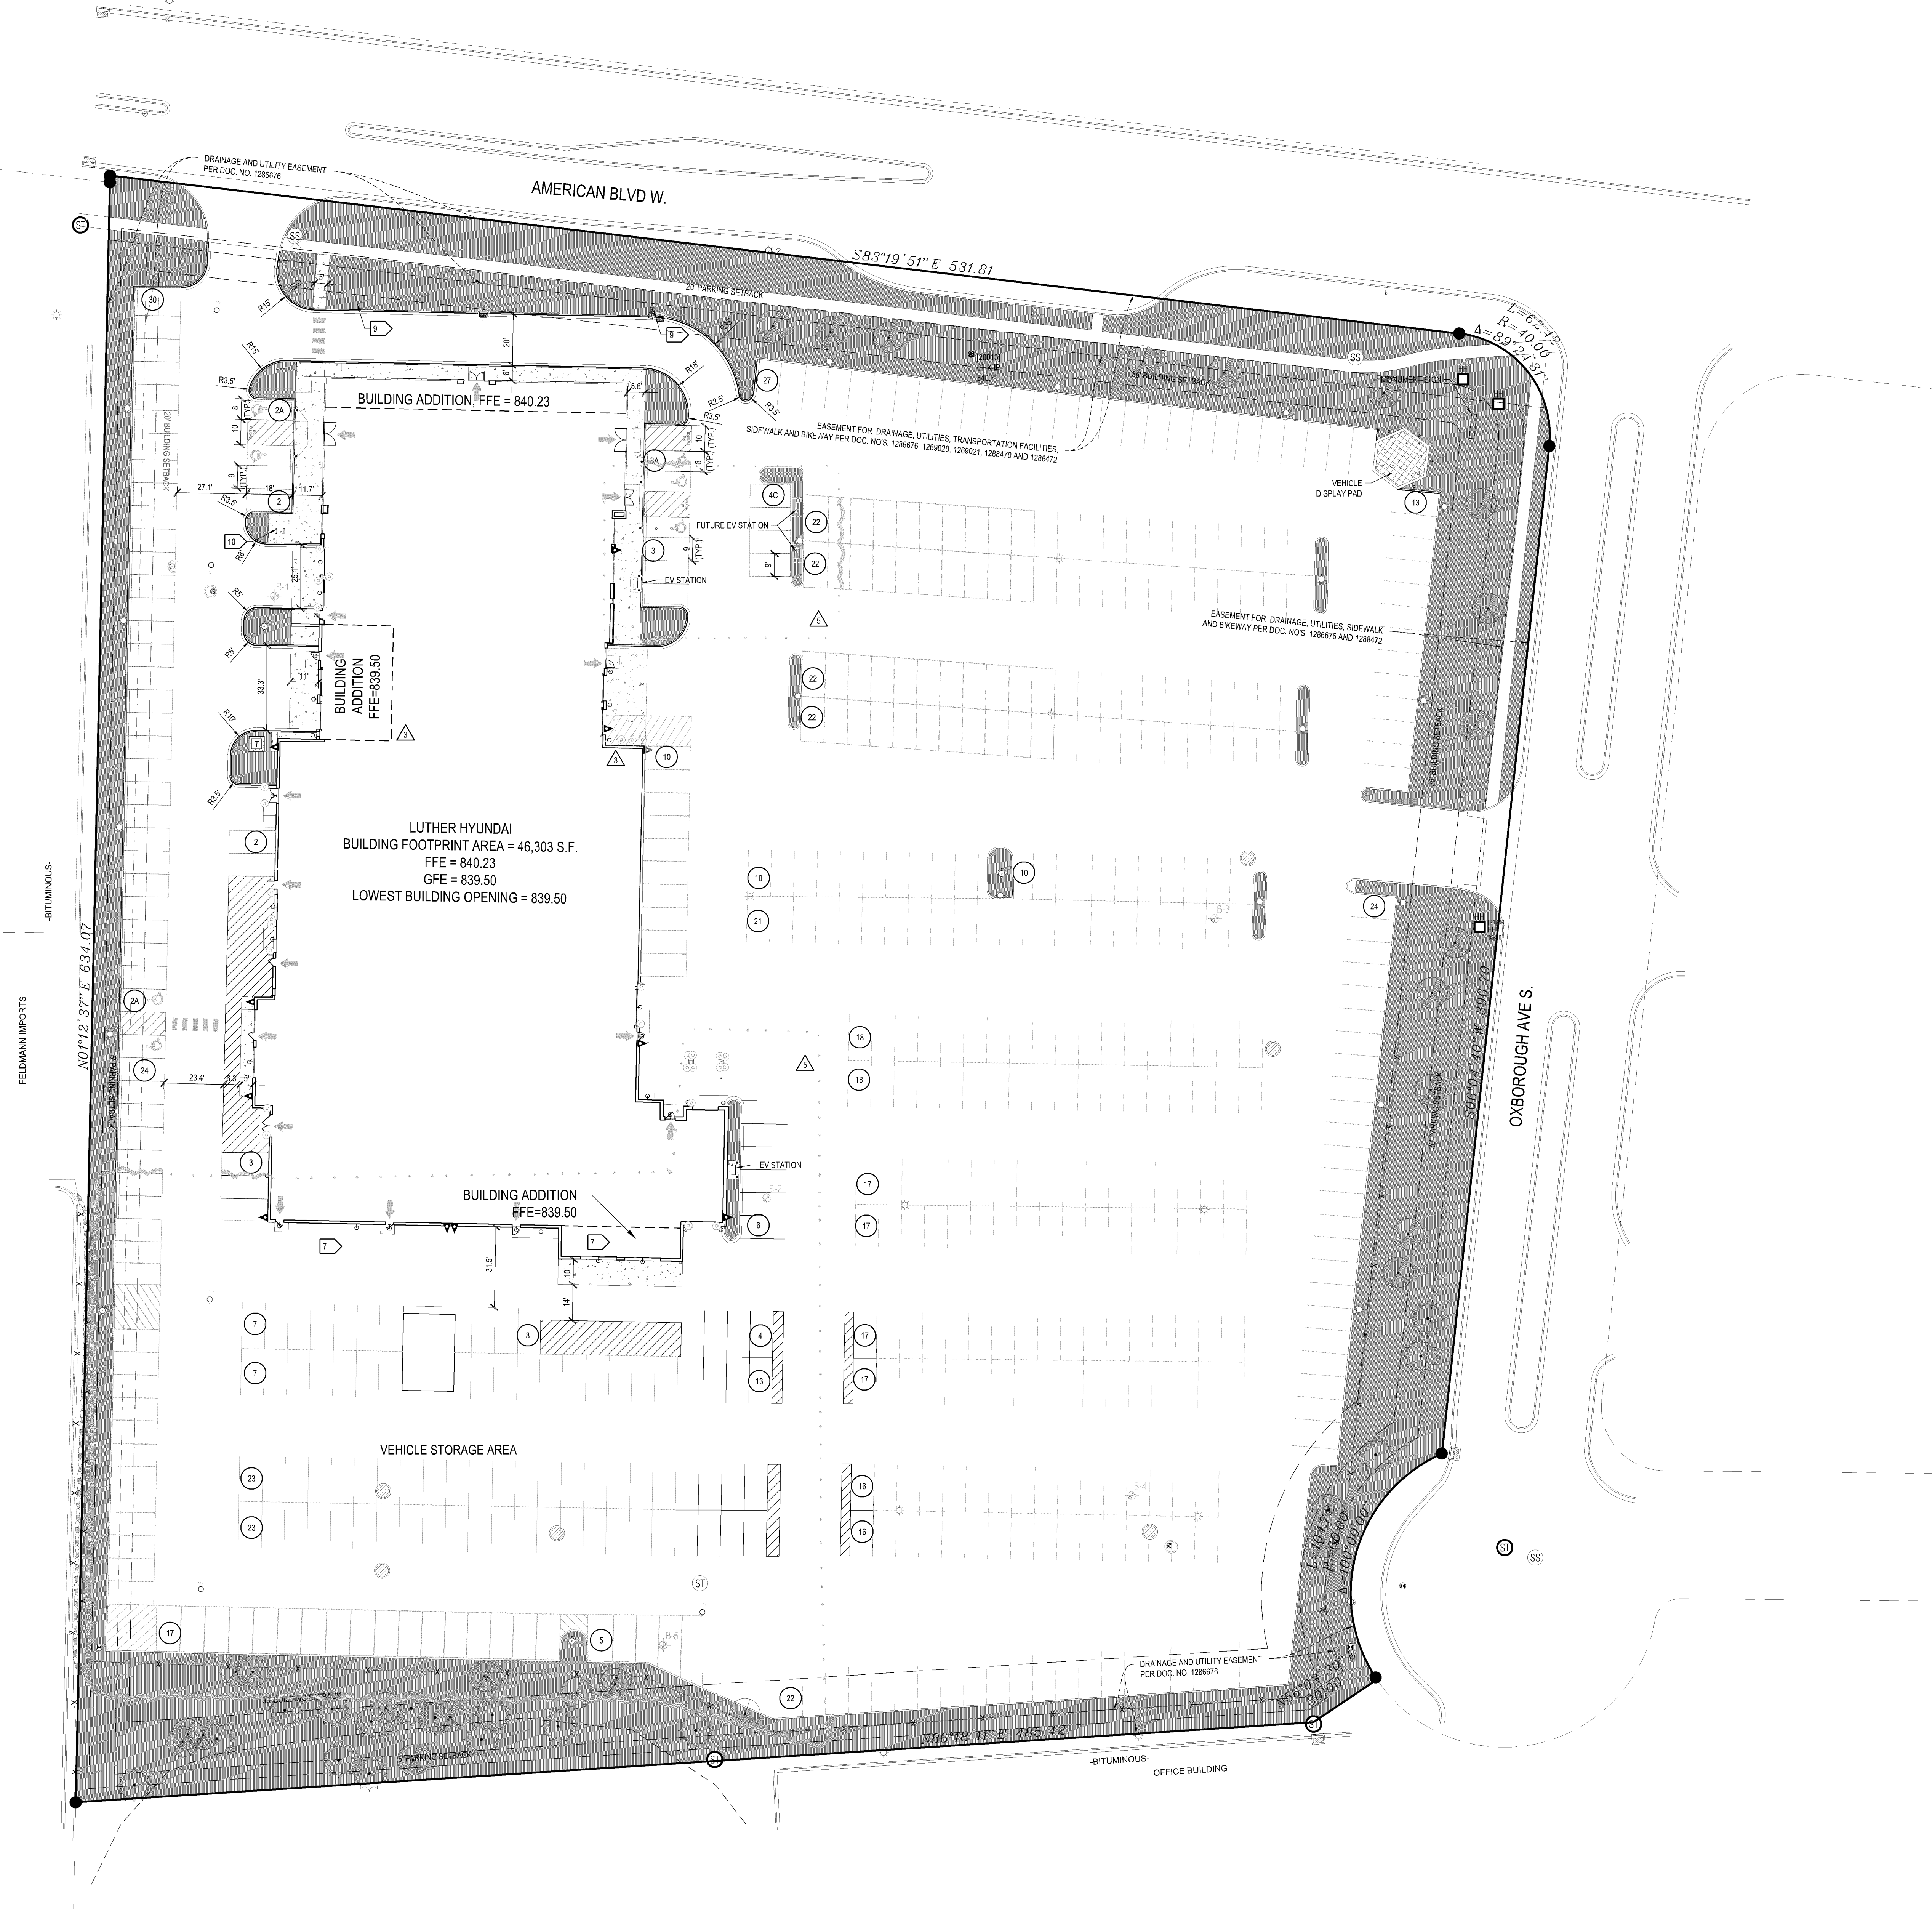

GENERAL NOTES

- For construction staging and sequencing services contact Landform at 612.252.9070.
 - Obtain all necessary permits for construction within, or use of, public right-of-way.
 - The digital file, which can be obtained from the Engineer, shall be used for staking. Discrepancies between the drawings and the digital file shall be reported to the Engineer. The building footprint, as shown on these drawings, and the digital file, shall be compared to the structural drawings prior to staking.
 - Reserved.
 - Dimensions shown are to face of curb and exterior face of building unless noted otherwise.
 - Delimitate parking stalls with a 4 inch wide white painted stripe. Delimitate access aisles with 4-inch wide white painted stripes 18 inches on center and at 45 degree angle to direction of travel.
- ① Trash Enclosure. Refer to Architectural plans for details.
 - ② Recycled salvaged fence.
 - ③ Recycled salvaged light pole.
 - ④ 4-space bike rack. See sheet L2.1 for detail.

PROPOSED ZONING AND SETBACK SUMMARY

The Existing Property is Currently Zoned: Commercial Service (C-S-0.5)
 Proposed Zoning: Freeway Office and Service (C-1)
 Building Setback Information is as follows:
 Front Yard = 35 ft.
 Rear = 5 ft.
 Side = 5 ft.
 Parking Setback Information is as follows:
 Front Yard = 20 ft.
 Rear = 5 ft.
 Side (interior) = 5 ft.
 Side (exterior) = 20 ft.

AREA SUMMARY

Category	Area (sq. ft.)	Area (ac.)	Percentage
Existing			
Previous	58,149	1.33	18.3%
Improvements	259,820	5.96	81.7%
Total	317,969	7.29	100.0%
Proposed			
Previous	57,706	1.32	18.2%
Improvements	260,303	5.97	81.8%
Total	317,969	7.29	100.0%
Building expansion:			
Existing	42,969	n/a	
Additions	3,334	n/a	
Total	46,303	n/a	

PARKING SUMMARY

Service Area	Requirement	Provided	Remaining
Required Parking	Three stalls for each enclosed "major service" bay	24	72 Stalls
	Two stalls for each enclosed "minor service" bay	9	18 Stalls
Car Wash	One stall per 300 SF of GFA excluding service bays	9,070 SF Service Area	30 Stalls
	One stall per 375 SF of GFA	776 SF Car Wash	2 Stalls
Office	One stall per 285 SF of office GFA	8,824 SF Office Area	31 Stalls
	One stall per 180 SF of retail GFA	3,208 SF Showroom Area	18 Stalls
Warehouse	One stall per 1,000 SF of warehouse GFA	6,848 SF Warehouse Area	7 Stalls
	Total Parking Stalls Required		175 Stalls
Provided Parking	Inventory Stalls (Bx15)	358	
	Customer / Employee / Service stalls (Bx15)	119	
	Accessible Stalls (Bx15)	7	
	Contact Stalls (Bx15)	4	
Total Parking Stalls Provided		544	

LEGEND

- Green Space (Landscape Area)
- Customer / Employee / Service parking (remainder of stalls are sales / inventory)

DEVELOPER

THE LUTHER COMPANY, LLLP
 3701 ALABAMA AVENUE SOUTH
 ST. LOUIS PARK, MN
 TEL: (612)252-9800 - FAX: (612) 252-9800

MUNICIPALITY



PROJECT

LUTHER HYUNDAI
 BLOOMINGTON, MN

ISSUE / REVISION HISTORY

DATE	ISSUE / REVISION	REVIEW
11/09/2022	DEC. 5/2022	RES
11/09/2022	CITY 6/2022	RES
04/04/2023	PERM SET	RES
04/04/2023	CITY 7/2023	RES
04/04/2023	CITY 7/2023	RES
11/03/2023	BULLETIN 05	RES
02/07/2024	BULLETIN 05	RES

CERTIFICATION

I hereby certify that this plan was prepared by me, or under my direct supervision, and that I am a duly Licensed Professional Engineer under the laws of the State of MINNESOTA.


S.P. Schulz
 Steven E. Schulz
 License No. 47115 Date: 11/03/2022

BULLETIN 05
 NOVEMBER 03, 2023

LANDFORM
 From Site to Finish

105 South Fifth Avenue Tel: 612-252-9070
 Suite 513 Fax: 612-252-9077
 Minneapolis, MN 55401 Web: landform.net

FILE NAME: C201LUT22054.DWG
 PROJECT NO.: LUT22054
SITE PLAN
C2.1

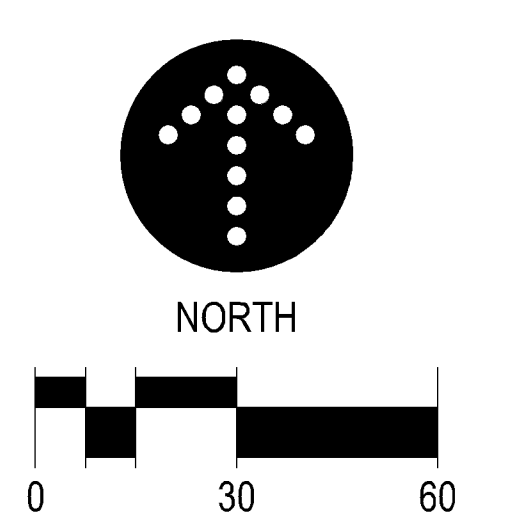

NPDES PERMIT AND SWPPP COMPONENTS

1. The current Minnesota Construction Stormwater General Permit (Permit) dated August 1, 2018 is referenced in this document as the Permit.
 The SWPPP includes the following components:
 • Construction Documents prepared by Landform
 • Stormwater Management Plan prepared by Landform
 • Maintenance Plan for permanent stormwater BMPs
 • Geotechnical Report prepared by VTI
 All components must be kept onsite by the Operator. The Operator shall contact Civil Engineer if they do not have all of the above documents.

SITE INFORMATION

Site location: Latitude: 44.85714, Longitude: -93.34152
 Disturbed area = 3.16 ac.
 Pre-construction impervious area within disturbed area = 1.07 ac.
 Post-construction impervious area within disturbed area = 2.00 ac.
 Net change in impervious area within disturbed area = 0.93 ac.
 Type of stormwater management:
 • Infiltration
 Erosion prevention and sediment control quantities are on sheets C3.1

SITE EVALUATION / ASSESSMENT / PLANNING

1. The Operator shall have primary responsibility and significant authority for the development, implementation, maintenance, inspection and amendments to the approved SWPPP. Duties include but are not limited to:
 • Ensuring full compliance with the SWPPP and the Permit
 • Implementing all elements of the SWPPP, including but not limited to:
 • Implementing storm and erosion control and sediment control measures
 • Implementing all non-storm water management, and good housekeeping BMPs ensuring that no materials other than storm water are discharged in quantities, which will have an adverse effect on receiving waters or storm drain systems, etc.
 • Conducting routine inspections and maintenance
 • Ensuring elimination of all unauthorized discharges
 • Coordinating to ensure all of the necessary corrections / repairs are made immediately, and that the project complies with the SWPPP, the Permit, and approved plans at all times.

STORMWATER POLLUTION PREVENTION MANAGEMENT MEASURES

1. Operator must develop pollution prevention management measures, implement good housekeeping BMPs, must follow all applicable federal, state, and local building codes, Occupational Safety and Health Act (OSHA), and the general conditions and general requirements of the construction contract.
 2. The Operator shall minimize the exposure to stormwater of any of the products, material, or wastes stored on site that may wash downstream or contaminate stormwater.
 3. Building products that have the potential to leach pollutants must be under cover.
 4. Chemicals and landscape materials shall be under cover to prevent the discharge of pollutants.
 5. Operator to track progress of the following items on site maps: portable toilets, material storage areas, vehicle and equipment fueling and maintenance areas, concrete washouts, paint and sludge washouts, dumpsters or other trash and debris containers, oil kits, stockpiles, any other non-structural non-storm water management BMPs, any temporary removed structural BMPs, any changes to the structure BMPs.
 6. Solid waste: collected sediment, asphalt and concrete millings, floating debris, paper, plastic, fabric, construction and demolition debris and other wastes must be disposed of properly and must comply with MPCA disposal requirements.
 7. Hazardous waste: oil, gasoline, paint and any hazardous substances must be properly stored in sealed containers to prevent spills, leaks or other discharges. Restricted access to storage areas must be provided to prevent vandalism. Storage and disposal of hazardous waste or materials must be in compliance with Minn. R. Ch. 7045 including secondary containment as applicable.
 8. Portable toilets must be positioned so that they are secure and will not be tipped or recycled over.
 9. Concrete and other washout waste: operator must provide effective containment for all liquid and solid wastes generated by washout operations. The liquid and solid wastes must not contact the ground, and the containment must be designed so that it does not result in runoff from the washout operations or areas. Liquid and solid wastes must be disposed of properly and in compliance with MPCA rules. A sign must be installed adjacent to each washout facility that requires site personnel to utilize the proper facilities for disposal of concrete and other washout wastes.
 10. External vehicle washing: external washing of trucks and other construction vehicles must be limited to a defined area of the site. Runoff must be contained and waste properly disposed of. No engine degreasing is allowed on site.
 11. Operator shall take reasonable steps to prevent the discharge of spilled or leaked chemicals, including fuel, from any area where they will be loaded or unloaded as detailed in the Permit.

SWPPP CONTACT AND TRAINING INFORMATION

1. Owner:
 The Luther Company, LLLP
 c/o: Linda McGary
 3701 Alabama Avenue S
 St. Louis Park, MN 55416
 (952) 258-8803
 2. Operator:
 To Be Determined. Contact Owner until Contractor is Selected.
 3. Long Term Maintenance And Operation:
 To Be Determined. Contact Owner until Contractor is Selected.
 4. SWPPP Designer:
 Steve Sabrasak, P.E.
 Landform Professional Services
 105 South Fifth Avenue, Suite 513
 Minneapolis, MN 55401
 612-252-9077
 hsab@landform.com
 Certification: USTW, MN, Design Of Construction SWPPP, Exp. May 31, 2025
 5. SWPPP Inspector / Manager:
 Nick Dow (SWPPP Certified)
 ndow@landform.com
 612-499-7368
 6. BMP Installation And Repair:
 Nick Dow (SWPPP Certified)
 ndow@landform.com
 612-499-7368.


DESCRIPTION OF CONSTRUCTION ACTIVITY

1. Construction activity includes erosion and sediment control BMPs installation, clearing and grubbing, site grading, utility installation, building construction, paving, and landscaping.

SCHEDULE OF BMP INSTALLATION AND CONSTRUCTION ACTIVITY

1. Install perimeter sediment control BMPs prior to start of other site work. Refer to Grading, Drainage, Paving and Erosion Control sheet for initial locations of BMPs.
 2. Protect infiltration areas with construction fencing. Install fencing prior to site grading or within 24-hours of excavating an infiltration basin.
 3. Construct temporary / permanent sedimentation basins prior to upland disturbance. Install perimeter sediment control BMPs around normal water levels within 48-hours of completion of basin grading.
 4. Stabilize cutbanks from temporary / permanent sedimentation basins within 24-hours of outlet construction.
 5. Perform work in phases to minimize disturbed areas at any one time. Operator to develop phasing plan prior to start of work.
 6. Strip topsoil from areas to be disturbed and stockpile with perimeter sediment control BMPs. Provide stabilization if stockpile is left longer than 14 days.
 7. Rough grade site.
 8. Install utilities.
 9. Install small utilities (gas, electric, communications).
 10. Final grade pavement areas and compact subgrade.
 11. Lay down pavement aggregate and compact.
 12. Install curb and gutter. Backfill after a minimum of three days and provide a minimum of two rolls of soil at the back of curb.
 13. Construct building / addition and site features.
 14. Construct site walks and paths.
 15. Provide final stabilization.
 16. Connect infiltration / filtration practices to storm sewer system.
 17. Remove temporary BMPs and dispose of properly.

WATERS WITHIN ONE MILE OF SITE

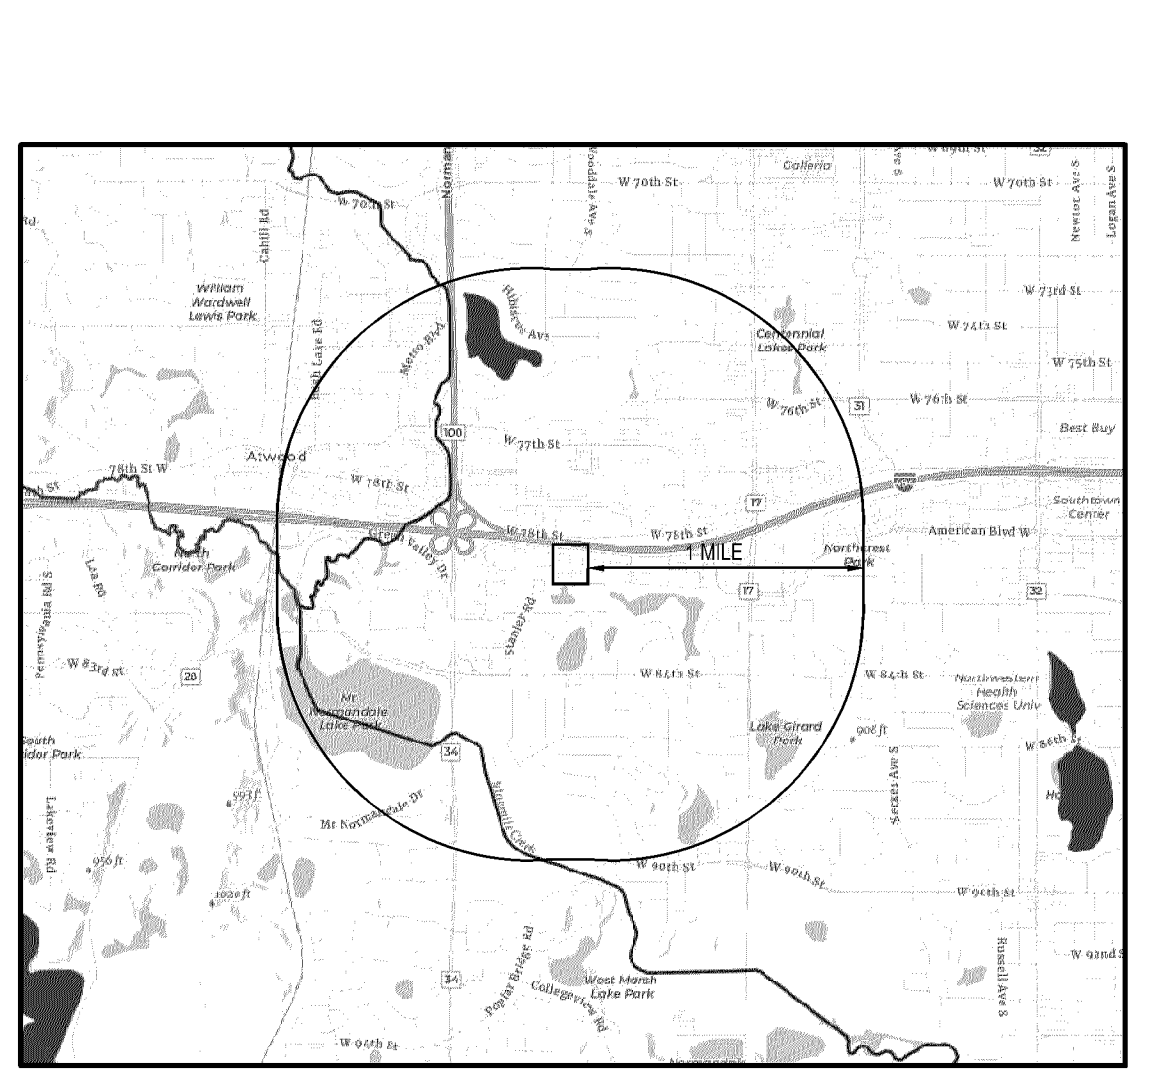

MN SPECIAL (PROHIBITED, RESTRICTED, OTHER) & IMPAIRED WATERS

1. Lake Edina is impaired by nutrients based on the current USEPA 303(d) clean water act list, is within 1 mile of this site, and stormwater does not discharge to it. Impairments are for Aquatic Consumption
 2. Nine Mile Creek is impaired for aquatic life by elevated chloride concentrations based on the current USEPA 303(d) clean water act list, is within 1 mile of this site, and stormwater does not discharge to it. Impairments are for Aquatic Life.

EROSION PREVENTION AND SEDIMENT CONTROL

1. See Grading, Drainage, Paving and Erosion Control sheets for the location and type of temporary erosion prevention and sediment control BMPs. See Grading and Drainage, Utility, and Landscapes sheets for the location and type of permanent erosion prevention and sediment control BMPs.
 2. Minimize Disturbed Areas and Protect Natural Features and Soil
 Appropriate construction practices (e.g. construction phasing, vegetative buffer strips, horizontal slope grading) shall be used to minimize erosion.
 Areas not to be disturbed (buffers, infiltration basins, etc.) shall be protected with construction or all fences before work begins.
 Operator shall develop methods to minimize soil compaction outside of building pads, pavement areas and utility trenches and shall use heeled equipment whenever practicable.
 Topsoil shall be salvaged and reused to the extent practicable.
 3. Phase Construction Activity
 Operator must not disturb more land than can be effectively inspected and maintained.
 Sediment control practices shall be established on all down gradient perimeters before any upgradient land disturbing activities begin. These practices shall remain in place until final stabilization has been established in accordance with the Permit.
 The timing of the installation of sediment control practices may be adjusted to accommodate short-term activities such as clearing or grubbing, or passage of vehicles. Any short-term activity must be completed as quickly as possible and the sediment control practices shall be installed immediately after the activity is completed. However, sediment control practices shall be installed before the next precipitation event even if the activity is not complete.
 4. Control Stormwater Flowing onto and Through the Project
 The normal wetted perimeter of any temporary or permanent drainage ditch or swale that drains water from any portion of the construction site, or diverts water around the site, shall be stabilized within 200 linear feet from the property edge, or from the point of discharge to any surface water.
 Stabilization of the last 200 linear feet shall be completed within 24 hours after connecting to a surface water.
 Stabilization of the remaining portions of any temporary or permanent ditches or swales shall be completed within 14 days after connecting to a surface water and construction in that portion of the ditch has temporarily or permanently ceased.
 Temporary or permanent ditches or swales that are being used as a sediment containment system (with properly designed rock ditch checks, bio rolls, bio disks, etc.) do not need to be stabilized. These areas shall be stabilized within 24 hours after no longer being used as a sediment containment system.
 5. Stabilize Soils
 All exposed soil areas, including stockpiles, must be stabilized.
 Stabilization must be initiated immediately to limit soil erosion when the construction activity in that portion of the site has temporarily or permanently ceased and will not resume for 14 calendar days. Stabilization must be complete within 14 days of cessation of construction activity.
 Temporary soil stockpiles shall have all fences or other effective sediment controls, and cannot be placed in surface waters, including storm water conveyances such as curb and gutter systems, or conduits and ditches unless there is a bypass in place for the storm water.
 Temporary stockpiles without significant silt, clay or organic components (e.g. clean aggregate stockpiles, demolition concrete stockpiles, sand stockpiles) and the constructed base components of roads, parking lots and similar surfaces, are exempt from this requirement.

6. Protect Slopes
 Operator shall avoid work on slopes with a grade of 3:1 or greater when practicable. Grading on slopes with a grade of 3:1 or steeper will require techniques such as phasing and stabilization practices designed for steep slopes (e.g. slope draining and terracing).
 7. Protect Storm Drain Intakes
 All storm drain inlets shall be protected by appropriate BMPs during construction until all sources with potential for discharging to the inlet have been stabilized. Inlet protection may be temporarily removed if a specific safety concern has been identified.
 8. Provide Energy Dissipation at All Pipe Discharges within 24 Hours
 After connection to a surface water or permanent stormwater treatment system.
 9. Establish Perimeter Controls and Sediment Barriers
 Prior to disturbing soils on a project site, establish sediment control BMPs on all down-gradient perimeters and where site discharges to public waters.
 10. Retain Sediment On-site and Control Downstream Practices
 Discharge shall not cause nuisance conditions, erosion in receiving channels, adversely affect receiving water or impact wetlands, or downstream properties. Discharge points shall be adequately protected from erosion and scour by accepted energy dissipation measures.
 Discharge water containing oil or grease shall be treated to remove oil or grease prior to discharge to surface waters.
 Refer to Permit requirements for temporary or permanent sediment basins.
 11. Establish Stabilized Construction Exit
 Vehicle tracking pads shall be established as shown on the Grading, Drainage, Paving and Erosion Control sheet to minimize tracking of sediment from the construction site onto adjacent streets.
 12. Infiltration Basin Protection
 Operator shall not excavate infiltration systems to final grade or within three (3) feet of final grade until the contributing drainage area has been constructed and fully stabilized unless rigorous erosion prevention and sediment controls have been installed.
 When excavating an infiltration system within three (3) feet of final grade, operator shall mark off and protect the area from heavy construction equipment to prevent compaction of soils.
 13. Dewatering and Basin Drains
 Permitted discharge turbidity or sedimentation waters related to dewatering or basin draining to a temporary or permanent sediment basin. Discharges must not cause erosion or scour near the discharge points.
 14. Remove Sediment from Surface Waters
 All sediment deposits and debris must be removed from surface waters, including drainage ways, catch basins, and other drainage systems, and the removal areas restabilized within seven (7) days.

TEMPORARY SEDIMENTATION BASIN(S)

1. This project does not have more than five (5) disturbed areas draining to a common location and the site does not drain to an inland or special water, therefore a temporary sediment basin is not required.
 2. Temporary sediment basins shall provide treatment to runoff before it leaves the construction site or enters surface waters. The contractor shall comply with the following requirements:
 A. Sedimentation basins must provide live storage of runoff resulting from the 2-year 24-hour rainfall event from each acre drained to the basin, with a minimum of 1,800 cu ft/acre live storage volume. (When no calculation has been performed, each basin shall provide at least 3,000 cu ft/acre live storage.) Sedimentation basins must include a stabilized emergency overflow to prevent basin priority failure.
 B. Discharge from temporary sedimentation basins will be withdrawn from the surface in order to minimize the discharge of pollutants.
 3. Discharge from basin draining shall not adversely affect the receiving water or downstream properties. Contractor will visually check to ensure adequate treatment has been obtained and that nuisance conditions will not result from the discharge.
 4. Any discharge observed to be occurring during the inspection shall be recorded, described, and photographed.
 5. If any proposed temporary BMPs are not working as intended refer to the "Stormwater Compliance Assistance Toolkit for Small Construction Operations" MPCA, 2017 for additional information. Operator shall contact the SWPPP Designer for additional requirements and information.

POST CONSTRUCTION / PERMANENT BMPS

1. See Grading and Drainage, Utility, and Landscapes sheets for post construction and permanent stormwater BMPs.

INSPECTIONS AND MAINTENANCE

1. Permits must ensure that a trained person will inspect the entire construction site at least once every seven (7) days during active construction and within 24 hours after a rainfall event greater than 0.5 inches in 24 hours.
 2. Inspections shall include stabilized areas, erosion prevention and sediment control BMPs, and infiltration areas.
 3. Surface waters on or adjacent to the site must be inspected for evidence of erosion or sediment deposition.
 4. Permits must record all inspection and maintenance activities within 24 hours of being conducted as detailed in the Permit.
 5. Inspection Records content shall include:
 A. Date and time of inspection.
 B. Name of persons conducting inspections.
 C. Findings of inspections, including specific locations where corrective actions are needed.
 D. Corrective actions taken including dates, times, and the party taking the corrective action.
 E. Dates of all rainfall events greater than 0.2 inch in 24 hours (refer to Permit for measurement requirements).
 F. Any discharges must be recorded, including photographs, descriptions of discharge (color, odor, surface or suspended solids, oil, silt, or other obvious indicators of pollution), and specific location of discharge location.
 G. Any amendments to the Permit as a result of inspections must be documented within seven calendar days as described in the Permit.
 6. BMP Maintenance
 A. Non-functional BMPs must be repaired or replaced by the end of the next business day after discovery unless a different time frame is indicated.
 B. Follow the designer's or manufacturer's recommended maintenance procedures for all BMPs.
 C. Remove sediment from BMPs when the depth of sediment has reached 1/2 the height of the BMP and properly dispose of sediment into controlled areas to prevent soil from returning to the BMP during subsequent rain events.
 D. Remove sediment from paved drainage within one calendar day of discovery.
 E. Remove sediment from around BMPs protecting storm drain inlets.
 F. Surface waters with evidence of sediment deposition must be stabilized and sediment removed within seven calendar days of discovery, or as stated by the Permit.
 G. Ensure that construction support activities, including borrow areas, waste areas, contractor work areas, and material storage areas and dedicated concrete and asphalt batch plants are cleaned and maintained.
 H. Replace damaged BMPs that no longer operate effectively.
 7. All BMPs are needed during construction to minimize erosion and prevent sediment from leaving the site.

RECORD KEEPING / RECORD RETENTION

1. The SWPPP (original or copies), including all changes to it, and inspection and maintenance records, shall be kept at the site during construction by the Owner / Operator who has operational control of that portion of the site. The SWPPP can be kept in either the field office or in an on-site vehicle during normal working hours.
 2. All Owners must keep the SWPPP, along with the following additional records, on file for three (3) years after submittal of the Notice of Termination (NOT). This does not include any records after submittal of the NOT.
 3. The following is a list of records that shall be kept at the project site available for inspectors to review:
 • Copy of the SWPPP, with any modifications;
 • Inspection and maintenance records;
 • Permanent operation and maintenance agreements;
 • Calculations for the design of temporary and permanent stormwater management systems;
 • Any other permits required for the project;
 • Records of all inspection and maintenance conducted during construction; and
 • All permanent operation and maintenance agreements that have been implemented, including all right-of-way, contracts, covenants and other binding requirements regarding perpetual maintenance.

LOG OF CHANGES TO THE SWPPP / AMENDMENTS

1. The Owner / Operator must amend the SWPPP as necessary to include additional requirements, such as additional or modified BMPs, designed to correct problems identified or address situations as detailed in the Permit.

FINAL STABILIZATION

1. The Owner / Operator must ensure final stabilization of the site. Final stabilization includes:
 A. Clearing all areas having permanent cover.
 B. Vegetative areas must have potential cover with a density of 70% of expected final growth.

TERMINATION OF COVERAGE

1. Owner / Operator(s) wishing to terminate coverage under the Permit must submit a Notice of Termination (NOT) to the MPCA. Compliance with the Permit is required until a NOT is submitted. Refer to the Permit for details. Conditions for submitting a NOT include:
 A. Site must have achieved final stabilization (refer to section above).
 B. The permanent stormwater treatment and conveyance systems must be clean and all accumulated sediment removed.
 C. All temporary synthetic erosion prevention and sediment control BMPs must be removed from the site and disposed of properly.

DEVELOPER

THE LUTHER COMPANY, LLLP
 3701 ALABAMA AVENUE SOUTH
 ST. LOUIS PARK, MN
 TEL: (952)258-8800 / FAX: (952) 258-8800

MUNICIPALITY



PROJECT

LUTHER HYUNDAI
 BLOOMINGTON, MN

ISSUE / REVISION HISTORY

DATE	ISSUE / REVISION	REVIEW
10/20/2022	DRG SUBMITTAL	SES
11/09/2022	CTD SUBMITTAL	SES
08/MAR/2023	PERMITS	SES
08/MAR/2023	CTD / INTERFERED / RESUBMITTAL	SES
08/JUN/2023	CTD / INTERFERED / RESUBMITTAL	SES
11/24/2023	BULLETIN 05	SES
02/NOV/2023	BULLETIN 05	SES

CERTIFICATION


I hereby certify that this plan was prepared by me, or under my direct supervision, and that I am a duly Licensed Professional Engineer under the laws of the State of MINNESOTA.

Steve E. Sabrasak
 Steve E. Sabrasak
 License No. 47163 Date: 11/03/2022

Operator must be a USPA-licensed engineer. See sheet C01 for job on file at Landform Professional Services, LLC and a suitable upon request.

IF THE SIGNATURE, SEAL OR FOUR-LINE DIRECTLY ABOVE ARE NOT VISIBLE, THIS SHEET MAY BE REPRODUCED BEYOND ANY LIMITS, PROVIDED THAT NO CHANGES TO THIS DOCUMENT TO DATE CONTACT THE ENGINEER TO REQUEST ADDITIONAL DOCUMENTS.

BULLETIN 05
 NOVEMBER 03, 2023

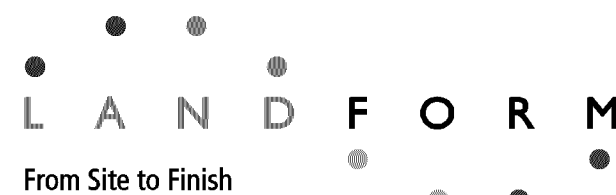


105 South Fifth Avenue Tel: 612-252-9070
 Suite 513 Fax: 612-252-9077
 Minneapolis, MN 55401 Web: landform.net

FILE NAME: C302LUT54.DWG
 PROJECT NO: LUT22054

MN SWPPP NOTES

C3.2

Landform and Steve Sabrasak are equal licensed engineers at Landform Professional Services, LLC.

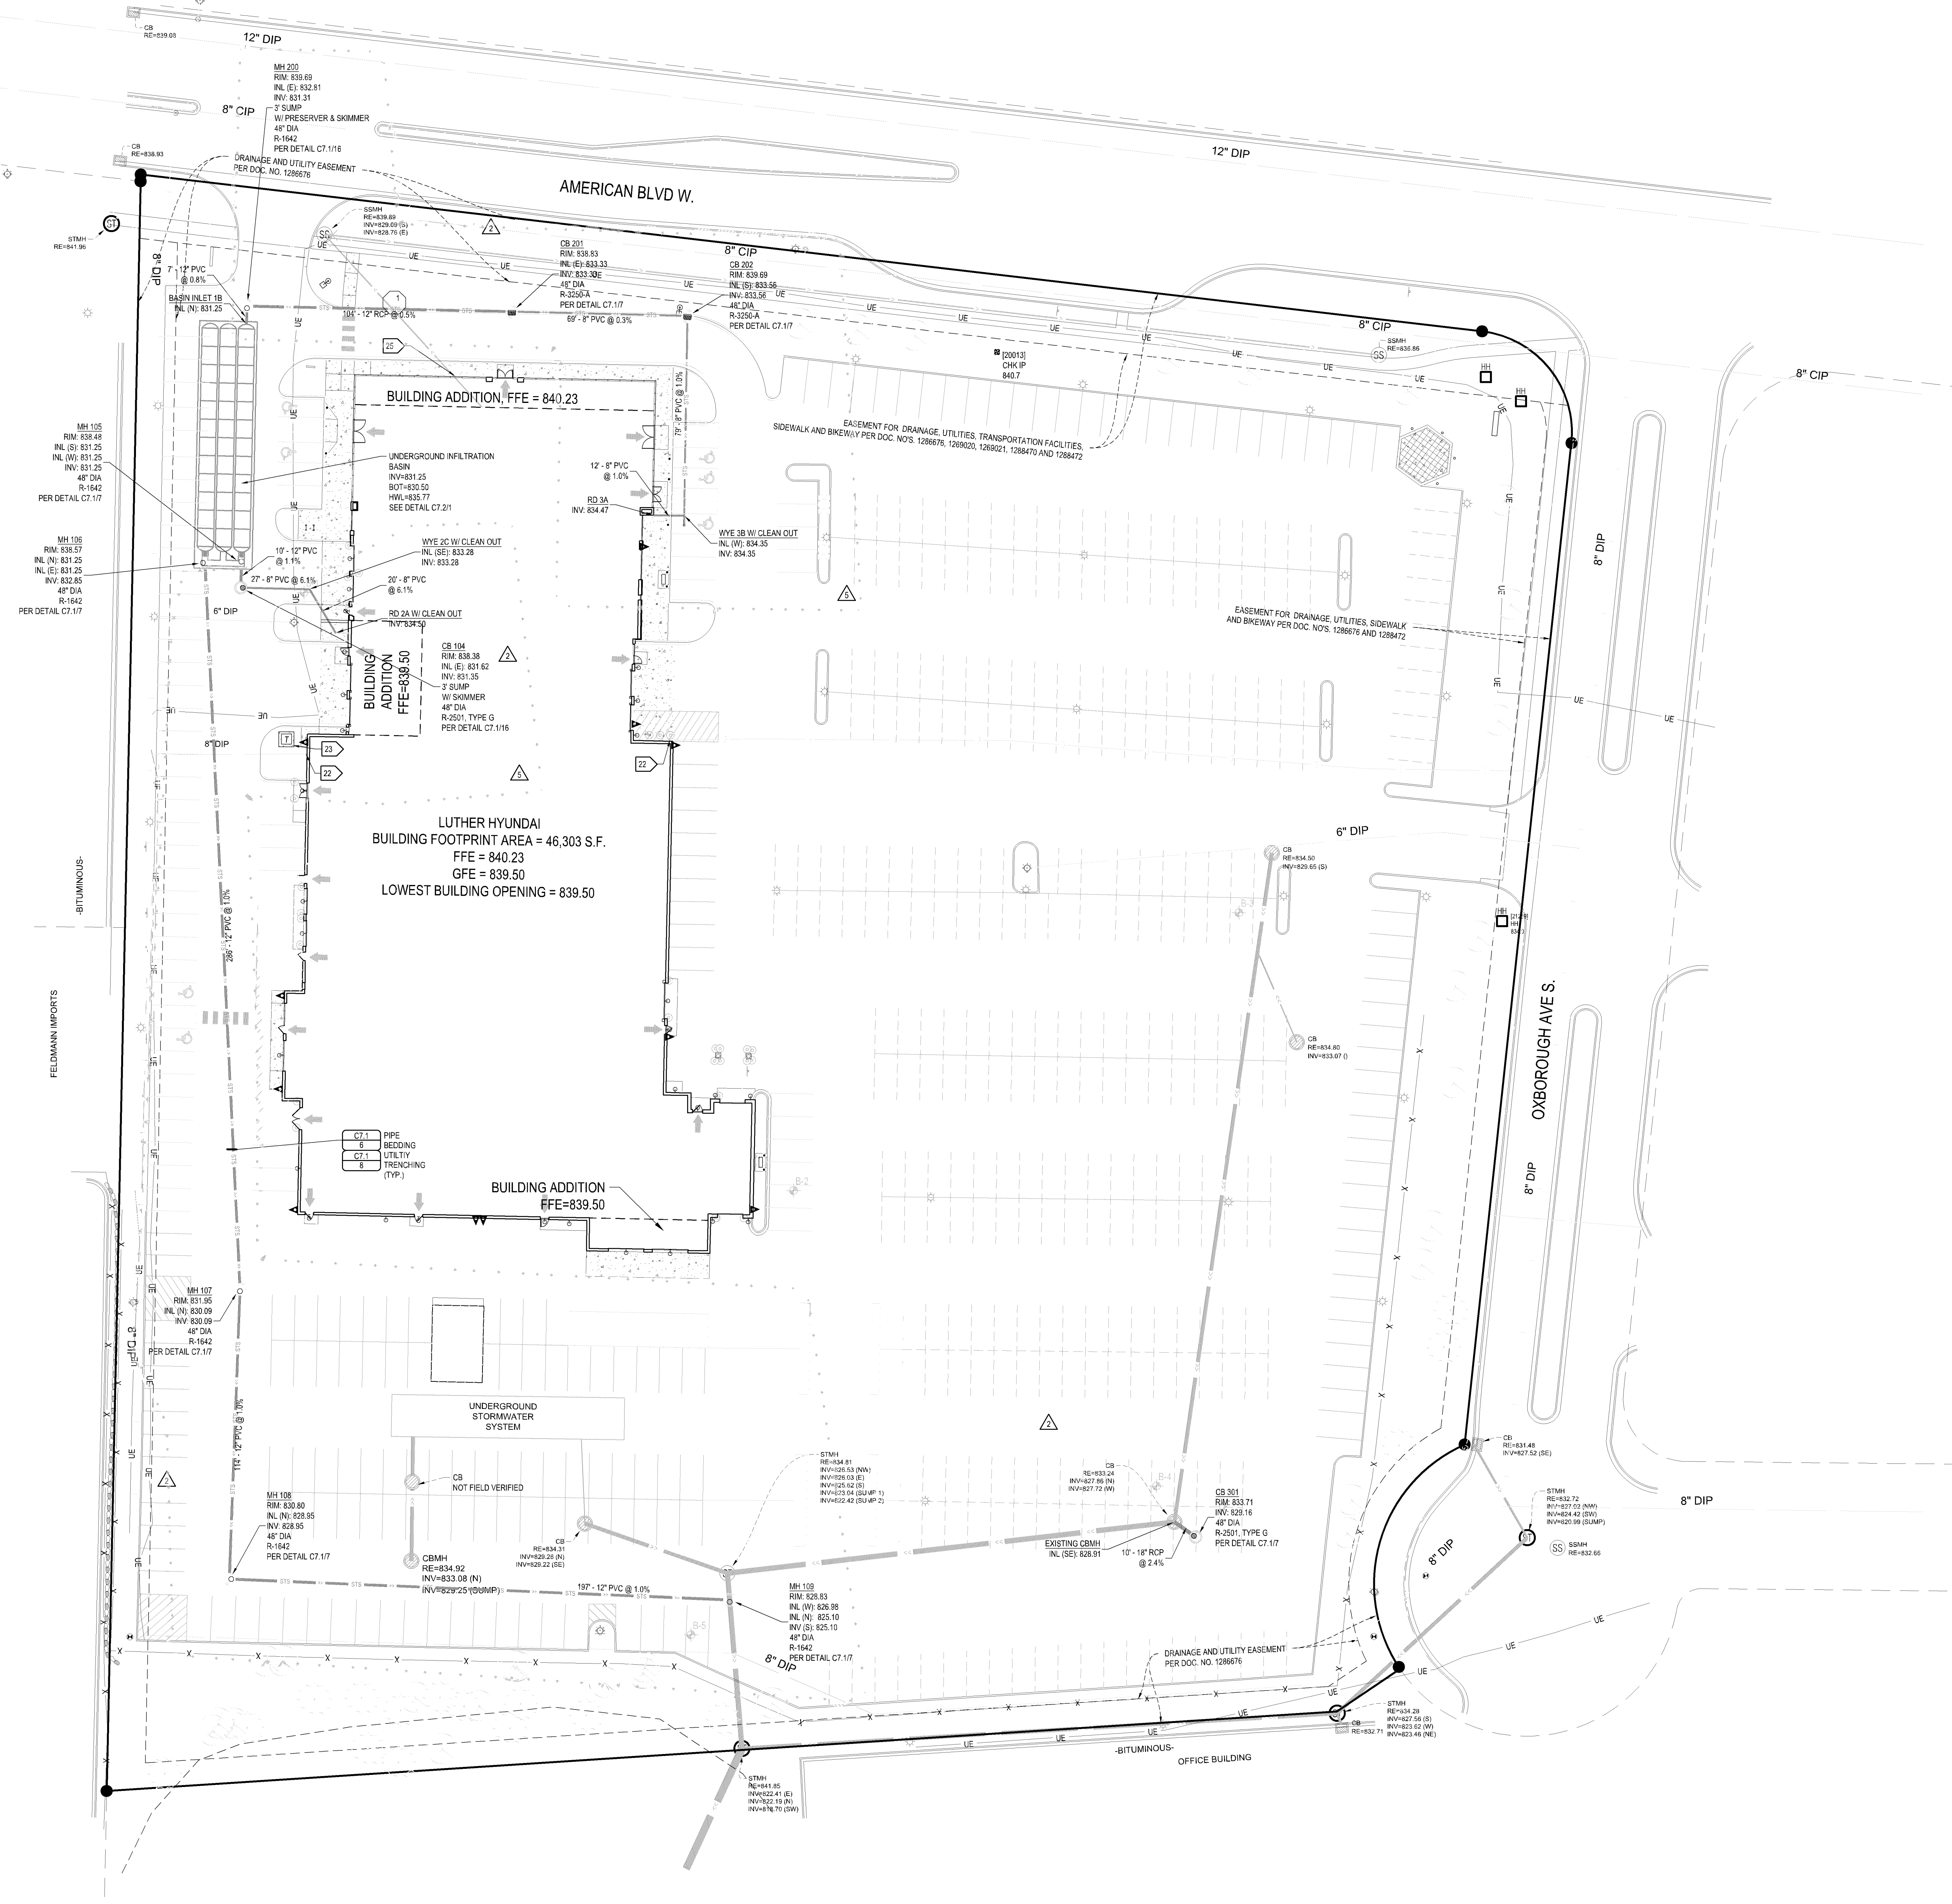

- GENERAL NOTES**
- For construction staking and surveying services contact Landform at 612.252.9070.
- UTILITY NOTES**
- Pipe Materials:
 - Storm Sewer: PVC Schedule 40 (ASTM D1785, C2665, F794, & F1886) RCP 12" 18" Class 5 (ASTM C71)
 - Drain Tile: HDPE - Compugated & Perforated (ASTM F405 & F667)
 - Contact utility services providers for field location of services 72 hours prior to beginning.
 - Contractor to field verify location and elevation of all utility points of connection to any proposed utilities. Contractor to notify Engineer immediately if there is any discrepancy.
 - Contractor to provide all utility crossings prior to construction of new utilities to verify depths of existing lines. Contact Engineer immediately if any conflicts are discovered.
 - Provide means and measures to protect adjacent property from damage during utility installation.
 - Pipe lengths shown are from center of structure to center of structure or end of end section.
 - Install tracer wire with all non-conductive utilities in accordance with City of Bloomington Standards.
 - Connect to City utilities in accordance with City of Bloomington Standards.
 - HDPE pipe connections into all concrete structures must be made with water tight materials utilizing an A-Lok or WaterStop gasket or boot, cast in place rubber foot, or approved equal. Where the alignment precludes the use of the above approved watertight methods, Contact City WaterStop specialist, or approved equal will only be allowed as approved by the Engineer.
 - Utility permits are required for connection to the public storm, sanitary, and water system. Contact utilities (952-563-8777) for permit information.
 - Deflect water to maintain 18-inch minimum outside separation at sewer crossings. Center pipe lengths to provide gradual separation between joints.
 - Contact City of Bloomington Utilities Department Department, at 952.563.8777 for flushing and pressure test inspections.
 - Reserved.
 - Reserved.
 - Reserved.
 - Reserved.
 - All joints and connections in the storm sewer system shall be gasketed or water tight. Approved resilient rubber joints must be used to make watertight connections to manholes, catch basins, and other structures.
 - Rock media in infiltration or filtration systems shall be angular, non-calcareous rock.
 - Infiltration shall be to a 4 inch Schedule 80 PVC buried 24" below grade. Extend sleeves 3-feet beyond the edge of pavement. Mark each end of sleeves with 3/8-inch steel 1 1/2 inches below finish grade. (Coordinate with installer contractor.)
 - Coordinate with Private Utilities to provide electric, natural gas, and communications services to building.
 - The primary electric load, transformer, and meter are provided and installed by Xcel Energy. The transformer pad design is provided by the Utility and construction is by the Contractor. Contact Utility for pad details. The secondary electric and conduits shall be installed by the Electrical Contractor.
 - See site lighting plan for additional information.
 - Protect sanitary service line. Contractor to inspect line after construction to ensure it has not been damaged.
 - Reserved.
 - Provide conduits for cable television and other electronic communication.
 - Coordinate with Mechanical, Plumbing, and Electrical Drawings for locations of service connections and construction of services within building.
 - Contact satellite soils in paved areas to 85% of maximum dry density. Standard Proctor (ASTM D1557) except the top 3 feet which shall be compacted to 100% compact to 95% density where fill depth exceeds 10 feet. The soils shall be within 2% of optimum moisture content. In granular soils all portions of the embankment shall be compacted to not less than 95% of Modified Proctor Density (ASTM D1557).
 - Adjust structures to final grade where disturbed. Comply with requirements of Utility. Meet requirements for traffic loading in paved areas.
- INFILTRATION / FILTRATION BASIN REQUIREMENTS**
- Refer to the C3.1 sheet notes for requirements.
- UTILITY CROSSINGS**
- 1 Crossing 1
Storm Sewer Bottom=832.93
Sanitary Sewer Top=832.47
Clearance = 0.46'

DEVELOPER
THE LUTHER COMPANY, LLLP
3701 ALABAMA AVENUE SOUTH
ST. LOUIS PARK, MN
TEL: (612)252-9800 - FAX: (612) 252-9800

MUNICIPALITY
BLOOMINGTON

PROJECT
LUTHER HYUNDAI
BLOOMINGTON, MN

ISSUE REVISION HISTORY

DATE	ISSUE / REVISION	REVIEW
10/20/2022	DRG SUBMITTAL	SES
11/09/2022	CITY PRESENTED	SES
16/MAR/2023	FORW SET	SES
30/MAR/2023	CITY PRESENTED/REJUBMITTAL	SES
06/JUN/2023	CITY PRESENTED/REJUBMITTAL	SES
11/JUL/2023	BULLETIN #05	SES
02/OCT/2023	BULLETIN #05	SES
02/NOV/2023	BULLETIN #05	SES

CERTIFICATION

I hereby certify that this plan was prepared by me, or under my direct supervision, and that I am a duly Licensed Professional Engineer under the laws of the State of MINNESOTA.

S.P. Schulz

Steven E. Salvo
License No. 47163 Date: 11/03/2022

Signature must be a digital reproduction of original. See attached copy of this plan on file at Landform Professional Services, LLC office and a scanned copy returned.

IF THE SIGNATURE, SEAL OR EXPIRES DIRECTLY ABOVE ARE NOT VALID, THIS SHEET HAS BEEN REPRODUCED BEYOND AUTHORITY. REPRODUCED AND/OR COPIED IN ANY MANNER WITHOUT THE WRITTEN CONSENT OF THE ENGINEER IS PROHIBITED.

BULLETIN 05
NOVEMBER 03, 2023

LANDFORM
From Site to Finish

105 South Fifth Avenue Tel: 612-252-9070
Suite 513 Fax: 612-252-9077
Minneapolis, MN 55401 Web: landform.net

FILE NAME: C401LUT2054.DWG
PROJECT NO: LUT2054

811
Know what's Below.
Call before you dig.

UTILITIES
C4.1

0 30 60


NORTH

DATE	ISSUE / REVISION	REVIEW
15 JUL 2022	DISC SUBMITTAL	DES
11 APR 2022	CITY SUBMITTAL	DES
08 MAR 2022	PERM SET	DES
02 MAR 2022	CITY PREPARED REQUEST	DES
02 JAN 2022	CITY PREPARED REQUEST	DES
11 JUL 2021	BULLETIN 102	DES
02 NOV 2020	BULLETIN 81	DES

ACCEPTABLE FILL MATERIALS: STORMTECH MC-3500 CHAMBER SYSTEMS

MATERIAL LOCATION	DESCRIPTION	AASHTO MATERIAL CLASSIFICATIONS	COMPACTION / DENSITY REQUIREMENT
D	FINAL FILL: FILL MATERIAL FOR LAYER 'D' STARTS FROM THE TOP OF THE 'C' LAYER TO THE BOTTOM OF FLEXIBLE PAVEMENT OR UNPAVED FINISHED GRADE ABOVE. NOTE THAT PAVEMENT SUBBASE MAY BE PART OF THE 'D' LAYER.	ANY SOIL/ROCK MATERIALS, NATIVE SOILS, OR PER ENGINEER'S PLANS. CHECK PLANS FOR PAVEMENT SUBGRADE REQUIREMENTS.	N/A
C	INITIAL FILL: FILL MATERIAL FOR LAYER 'C' STARTS FROM THE TOP OF THE EMBEDEDMENT STONE (B' LAYER) TO 24" (600 mm) ABOVE THE TOP OF THE CHAMBER. NOTE THAT PAVEMENT SUBBASE MAY BE A PART OF THE 'C' LAYER.	GRANULAR WELL-GRADED SOIL/AGGREGATE MIXTURES, <35% FINES OR PROCESSED AGGREGATE. MOST PAVEMENT SUBBASE MATERIALS CAN BE USED IN LIEU OF THIS LAYER.	PREPARE PER SITE DESIGN ENGINEER'S PLANS. PAVED INSTALLATIONS MAY HAVE STRINGENT MATERIAL AND PREPARATION REQUIREMENTS. BEGIN COMPACTIONS AFTER 24" (600 mm) OF MATERIAL OVER THE CHAMBERS IS REACHED. COMPACT ADDITIONAL LAYERS IN 12" (300 mm) MAX LIFTS TO A MIN. 95% PROCTOR DENSITY FOR WELL GRADED MATERIAL AND 90% RELATIVE DENSITY FOR PROCESSED AGGREGATE MATERIALS.
B	EMBEDEDMENT STONE: FILL SURROUNDING THE CHAMBERS FROM THE FOUNDATIONSTONE (A' LAYER) TO THE 'C' LAYER ABOVE.	CLEAN, CRUSHED, ANGULAR STONE	NO COMPACTION REQUIRED.
A	FOUNDATION STONE: FILL BELOW CHAMBERS FROM THE SUBGRADE UP TO THE FOOT (BOTTOM) OF THE CHAMBER.	CLEAN, CRUSHED, ANGULAR STONE	PLATE COMPACT OR ROLL TO ACHIEVE A FLAT SURFACE. ^{2,3}

PLEASE NOTE:
 1. THE LISTED AASHTO DESIGNATIONS ARE FOR GRADATIONS ONLY. THE STONE MUST ALSO BE CLEAN, CRUSHED, ANGULAR. FOR EXAMPLE, A SPECIFICATION FOR #4 STONE WOULD STATE: "CLEAN, CRUSHED, ANGULAR NO. 4 (AASHTO M43) STONE."
 2. STORMTECH COMPACTION REQUIREMENTS ARE MET FOR ALL LOCATION MATERIALS WHEN PLACED AND COMPACTED IN 6" (150 mm) MAX LIFTS USING TWO FULL COVERS WITH A VIBRATORY COMPACTOR.
 3. WHERE INFILTRATION SURFACES MAY BE COMPROMISED BY COMPACTION, FOR STANDARD DESIGN LOAD CONDITIONS, A FLAT SURFACE MAY BE ACHIEVED BY RAKING OR DRAGGING WITHOUT COMPACTION EQUIPMENT. FOR SPECIAL LOAD DESIGNS, CONTACT STORMTECH FOR COMPACTION REQUIREMENTS.
 4. ONCE LAYER 'C' IS PLACED, ANY SOIL/MATERIAL CAN BE PLACED IN LAYER 'D' UP TO THE FINISHED GRADE. MOST PAVEMENT SUBBASE SOILS CAN BE USED TO REPLACE THE MATERIAL REQUIREMENTS OF LAYER 'C' OR 'D' AT THE SITE DESIGN ENGINEER'S DISCRETION.

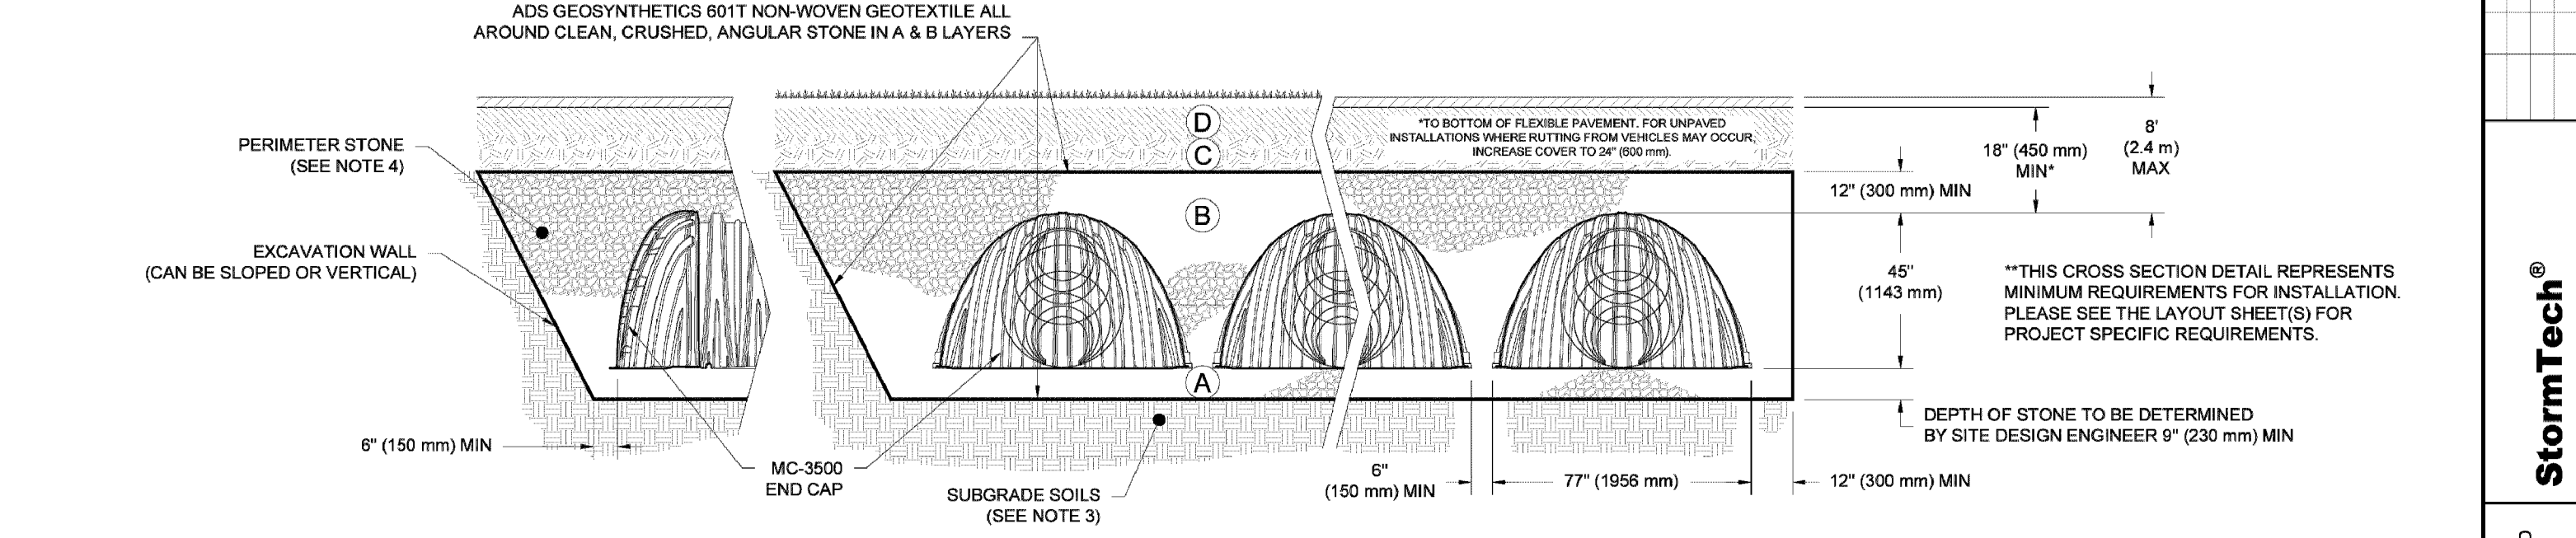

ADD GEOSYNTHETICS 6011 NON-WOVEN GEOTEXTILE ALL AROUND CLEAN, CRUSHED, ANGULAR STONE IN A & B LAYERS.

PERIMETER STONE (SEE NOTE 4)
 EXCAVATION WALL (CAN BE SLOPED OR VERTICAL)
 MC-3500 END CAP
 SUBGRADE SOILS (SEE NOTE 3)
 6" (150 mm) MIN
 7" (178 mm)
 12" (300 mm) MIN
 12" (300 mm) MIN
 18" (450 mm) MIN
 24" (600 mm) MAX
 45°
 1143 mm
 DEPTH OF STONE TO BE DETERMINED BY SITE DESIGN ENGINEER 6" (150 mm) MIN
 12" (300 mm) MIN

FOR COVER DEPTHS GREATER THAN 8.0' (2.4 m) PLEASE CONTACT ADS

NOTES:
 1. CHAMBERS SHALL MEET THE REQUIREMENTS OF ASTM F2418, "STANDARD SPECIFICATION FOR POLYPROPYLENE (PP) CORRUGATED WALL STORMWATER COLLECTION CHAMBERS" CHAMBER CLASSIFICATION 45/78 DESIGNATION SS.
 2. MC-3500 CHAMBERS SHALL BE DESIGNED IN ACCORDANCE WITH ASTM F3787 "STANDARD PRACTICE FOR STRUCTURAL DESIGN OF THERMOPLASTIC CORRUGATED WALL STORMWATER COLLECTION CHAMBERS".
 3. THE SITE DESIGN ENGINEER IS RESPONSIBLE FOR ASSESSING THE BEARING RESISTANCE (ALLOWABLE BEARING CAPACITY) OF THE SUBGRADE SOILS AND THE DEPTH OF FOUNDATION STONE WITH CONSIDERATION FOR THE RANGE OF EXPECTED SOIL MOISTURE CONDITIONS.
 4. PERIMETER STONE MUST BE EXTENDED HORIZONTALLY TO THE EXCAVATION WALL FOR BOTH VERTICAL AND SLOPED EXCAVATION WALLS.
 5. REQUIREMENTS FOR HANDLING AND INSTALLATION:
 • TO MAINTAIN THE WIDTH OF CHAMBERS DURING SHIPPING AND HANDLING, CHAMBERS SHALL HAVE INTEGRAL, INTERLOCKING STACKING LUGS.
 • TO ENSURE A SECURE JOINT DURING INSTALLATION AND BACKFILL, THE HEIGHT OF THE CHAMBER JOINT SHALL NOT BE LESS THAN 3".
 • TO ENSURE THE INTEGRITY OF THE ARCH SHAPE DURING INSTALLATION, 4) THE ARCH STIFFNESS CONSTANT AS DEFINED IN SECTION 4.2.2 OF ASTM F2418 SHALL BE GREATER THAN OR EQUAL TO 500 LB/FT². AND 5) TO RESIST CHAMBER DEFORMATION DURING INSTALLATION AT ELEVATED TEMPERATURES (ABOVE 73° F / 23° C), CHAMBERS SHALL BE PRODUCED FROM REFLECTIVE GOLD OR YELLOW COLORS.

1 SHEET OF 1

CERTIFICATION

I hereby certify that this plan was prepared by me, or under my direct supervision, and that I am a duly Licensed Professional Engineer under the laws of the State of MINNESOTA.

S.P. Schulz
 Steven E. Schulz
 License No. 47163 Date: 11/03/2022

Signature must be a 100% reproduction of original. 100% original copy of this plan on file at Landform Professional Services, LLC office and a scanned copy required.

IF THE SIGNATURE, SEAL OR FOUR LINES DIRECTLY ABOVE ARE NOT VALID, THIS SHEET HAS BEEN REPRODUCED WITHOUT AUTHORIZED PERMISSION AND THE ENGINEER HAS NO LIABILITY FOR THIS DOCUMENT. TO AVOID CONTACT THE ENGINEER TO REQUEST ADDITIONAL DOCUMENTS.

BULLETIN 05
 NOVEMBER 03, 2023

LANDFORM
 From Site to Finish


105 South Fifth Avenue Tel: 612-252-9070
 Suite 513 Fax: 612-252-9077
 Minneapolis, MN 55401 Web: landform.net

FILE NAME: C701LUT22054.DWG
 PROJECT NO: LUT22054

CIVIL CONSTRUCTION
 DETAILS
C7.2

Landform Professional Services, LLC



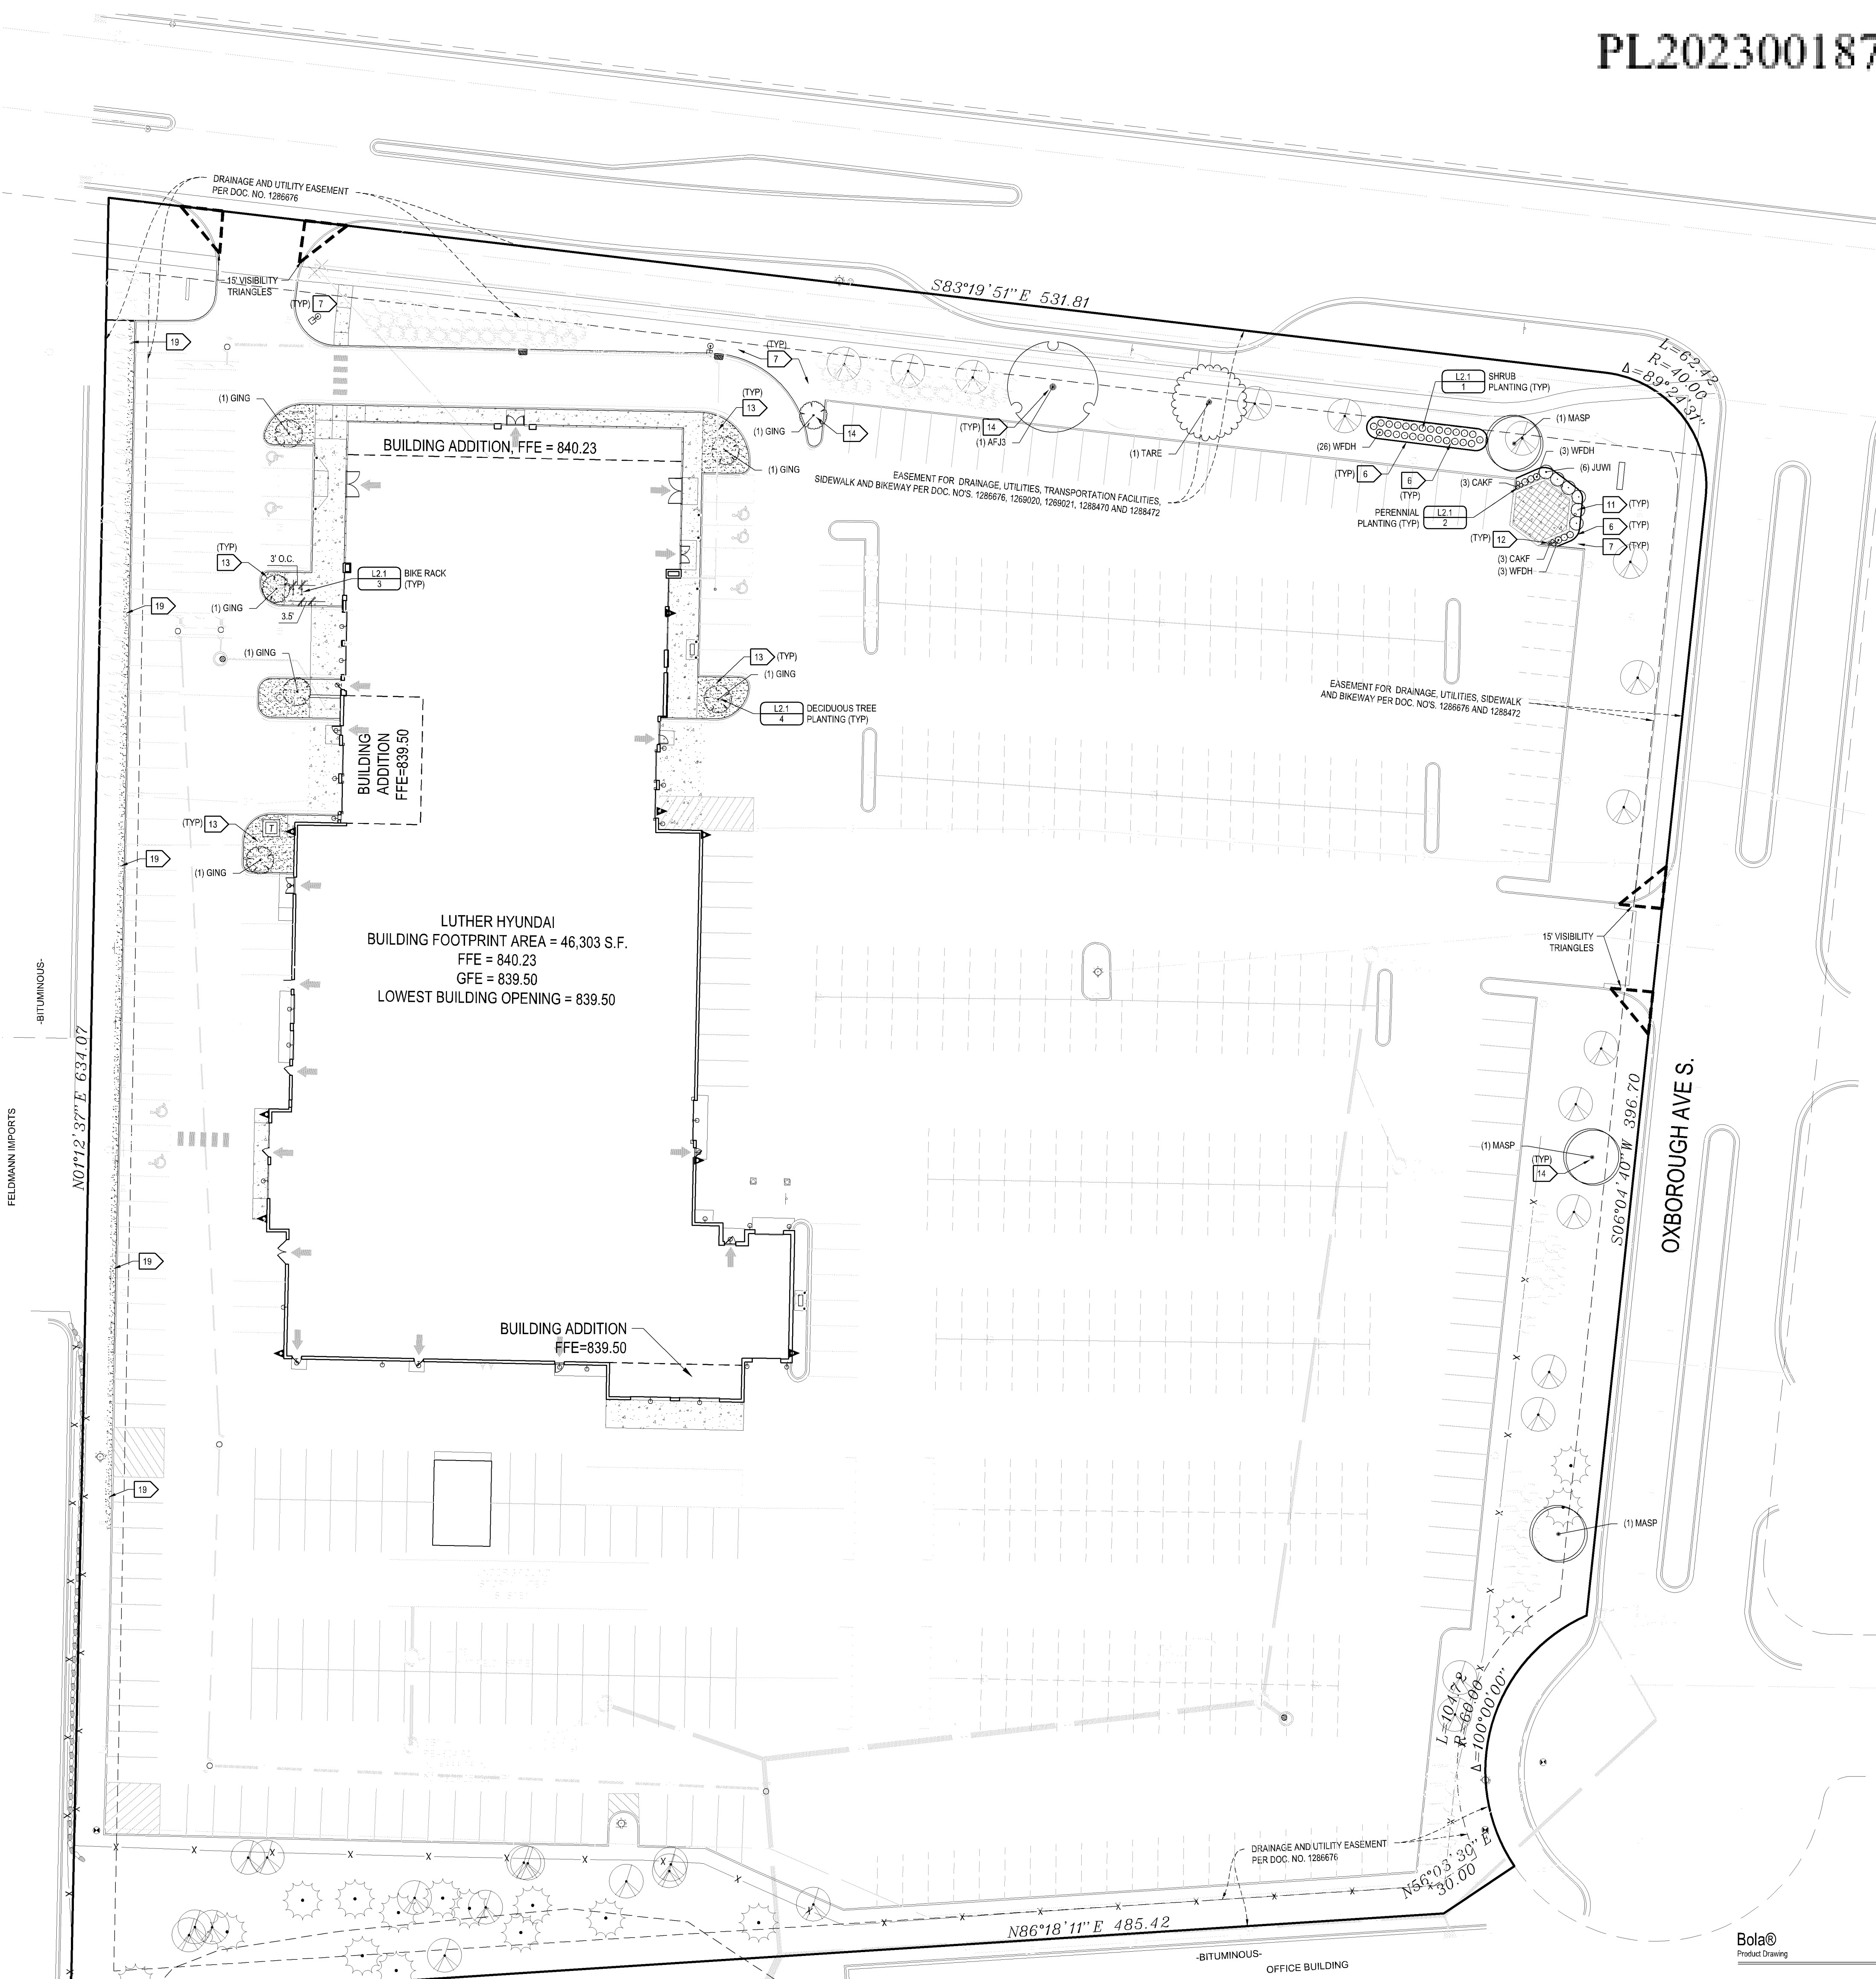

PLANT SCHEDULE						
DECIDUOUS TREES	CODE	QTY	BOTANICAL NAME	COMMON NAME	MATURE SIZE	PLANTING SIZE
	AFJ3	1	Acer x freemanii 'Jeffersred'	Aurum Blaze Maple	50'H x 40'W	3'CAL
	GNG	7	Ginkgo biloba 'JNF'	Sky Tower™ Mastodonic Tree	20'H x 10'W	2.5' CAL
	TARE	1	Tilia americana 'Redmond'	Ridmond American Linden	60'H x 40'W	2.5' CAL

GENERAL NOTES						
1. For construction Staking and Surveying services contact Landform at 612.252.9070.						
2. Contact Utility Service providers for field locations of services 72 hours prior to beginning.						
3. Coordinate installation with Contractors performing related work.						
4. Plant materials shall conform to the American Association of Nurserymen Standards and be of hardy stock, free from disease, infestation, damage, and self-pruning.						
5. All existing deciduous/coniferous trees are to be trimmed of dead wood and pruned to a natural uniform shape.						
6. Planting soil shall consist of 4 parts topsoil to 1 part peat humus, with 3 pounds of commercial fertilizer added per cubic yard.						
7. Spread a minimum of 4 inches of topsoil and soil all turf areas disturbed by construction.						
8. Edge planting beds with 8-inch Black Vinyl Edging (Black Diamond or approved equal) except where adjacent to curbing, walks or buildings.						
9. Place plants according to layout with proper nominal spacing. For discrepancy between the number of plants on the Schedule and the number shown on the Drawing, the Drawing shall govern.						
10. See Details for depth of planting soil.						
11. Install 4 inch depth of triple-shredded hardwood mulch in Street Bed Areas.						
12. Install 2 to 3 inch depth of triple-shredded hardwood mulch in Perennial Bed Areas.						
13. Install rock mulch to match existing. Landscape fabric shall be installed under all areas of rock mulch. Secure all edges and seams of fabric with 6-inch landscape staples.						
14. Install 4-foot diameter triple-shredded hardwood mulch dish around tree. Edging is not required.						
15. Irrigation is not required. Irrigation shall be designed by irrigation contractor. Contractor shall submit design plan and all shop drawings and system components to Landscape Architect for review, prior to purchase and installation. Contractor shall follow all applicable codes and obtain all necessary permits from local jurisdiction.						
16. All plant material shall have a 2-year warranty. The warranty shall begin after the last plant has been installed and the Landscape Architect has approved the installation. Landscape contractor is responsible for replacing any and all plant material that dies during the warranty period. Landscape contractor shall assume all costs to all to any replacements. All replacements shall be same species and size and equal or better vigor as original installation.						
17. Reserved.						
18. Reserved.						
19. Restore existing rock mulch to match existing conditions. Maintain depth of mulch to blend with adjacent grades.						

REPLACEMENT PLANT SCHEDULE			
SHRUBS	BOTANICAL NAME	COMMON NAME	PLANTING SIZE
	Cornus racemosa	Gray Dogwood	#5 Pot
	Cornus alba sibirica 'Red Gnome'	Red Gnome Dogwood	#2 Pot
	Viburnum lentana 'Molitor'	Monahan Viburnum	#2 Pot
	Acer ginnala 'Compact'	Compact Amur Maple	#2 Pot
	Spiraea x bumalda 'Goldflame'	Goldflame Spiraea	#2 Pot
	Viburnum trilobum 'Bailey Compact'	Compact Viburnum	#2 Pot
	Dierilla verticillata 'Bailey Compact'	Dwarf Bush Honeysuckle	#2 Pot
	Juniperus horizontalis 'Hugobon'	Hugobon Juniper	#5 Pot
	Juniperus horizontalis 'Wilton'	Wilton Carpet Juniper	#5 Pot

Replacement Plant Schedule symbols are representative of previously approved landscape plan. Replace any missing plants with the species and size listed above.

REQUIREMENTS			
Existing shrubs	218	Existing trees	54
Proposed shrubs	45	Proposed trees	12
Total shrubs	263	Total trees	66

(Shrubs on previously approved plan - 244)
(Trees on previously approved plan - 41)

LANDSCAPE NOTES		
1	DOUBLE STRAND 14 GA. WIRE, 2' @ 10" CLOSURE INTERVALS (TYP.)	
2	18" POLYPROPYLENE OR POLYETHYLENE (40 MIL, 1-1/2" WIDE STRAP TYP.)	
3	TREE WRAP TO FIRST BRANCH	
4	TREE SHALL BE PLANTED WITH ROOT FLARE EVEN WITH SOIL LINE OR FIRST MAJOR BRANCHING ROOT ONE (1) INCH BELOW SOIL LINE. IF ROOT FLARE IS NOT APPARENT IT MAY BE COVERED BY BURLAP OR SOIL. ADJUST PLANT AS NEEDED TO MAINTAIN APPROPRIATE DEPTH.	
5	FLAGGING: ONE (1) FLAG PER WIRE	
6	FOUR (4") INCHES MAX. SHREDDED HARDWOOD MULCH	
7	CUT TOP OF WIRE BASKET 10 (MIN.) FROM TOP OF ROOTBALL. CUT TWINE FROM AROUND TOP 10 (MIN.) OF ROOTBALL. CUT AND ROLL BACK BURLAP 10 (MIN.) FROM TOP OF ROOTBALL.	
8	PLANTING SOIL (SEE PLANS)	
9	EXISTING SOIL LOOSENED	
10	EDGE CONDITION VARIES (SEE PLANS)	
11	2" X 2" X 24" WOOD STAKE SET AT ANGLE PRIOR TO PLANTING	
12	SCARIFY BOTTOM AND SIDES OF HOLE PRIOR TO PLANTING	
13	SUBGRADE	
14	NOTES: INSPECT FOR ENCRUING ROOTS TO MITIGATE FUTURE STEM GROWING. REJECT ANY TREES THAT ARE SEVERELY AFFECTED. TWO ALTERNATE METHODS OF TREE STAKING ARE ILLUSTRATED AND TO BE UTILIZED IF NECESSARY. MAINTAIN TREES IN A PLUMB POSITION THROUGHOUT THE GUARANTEE PERIOD. SEE SPECIFICATIONS.	


LEGEND	
[Symbol]	Soil area
[Symbol]	Rock mulch

Final plant quantities shall meet quantities listed below (shown in parentheses). Existing shrubs have not been field verified. Replace any missing shrubs using species from Replacement Plant Schedule above.

REQUIREMENTS			
Existing shrubs	218	Existing trees	54
Proposed shrubs	45	Proposed trees	12
Total shrubs	263	Total trees	66

(Shrubs on previously approved plan - 244)
(Trees on previously approved plan - 41)

LEGEND		
[Symbol]	Soil area	
[Symbol]	Rock mulch	

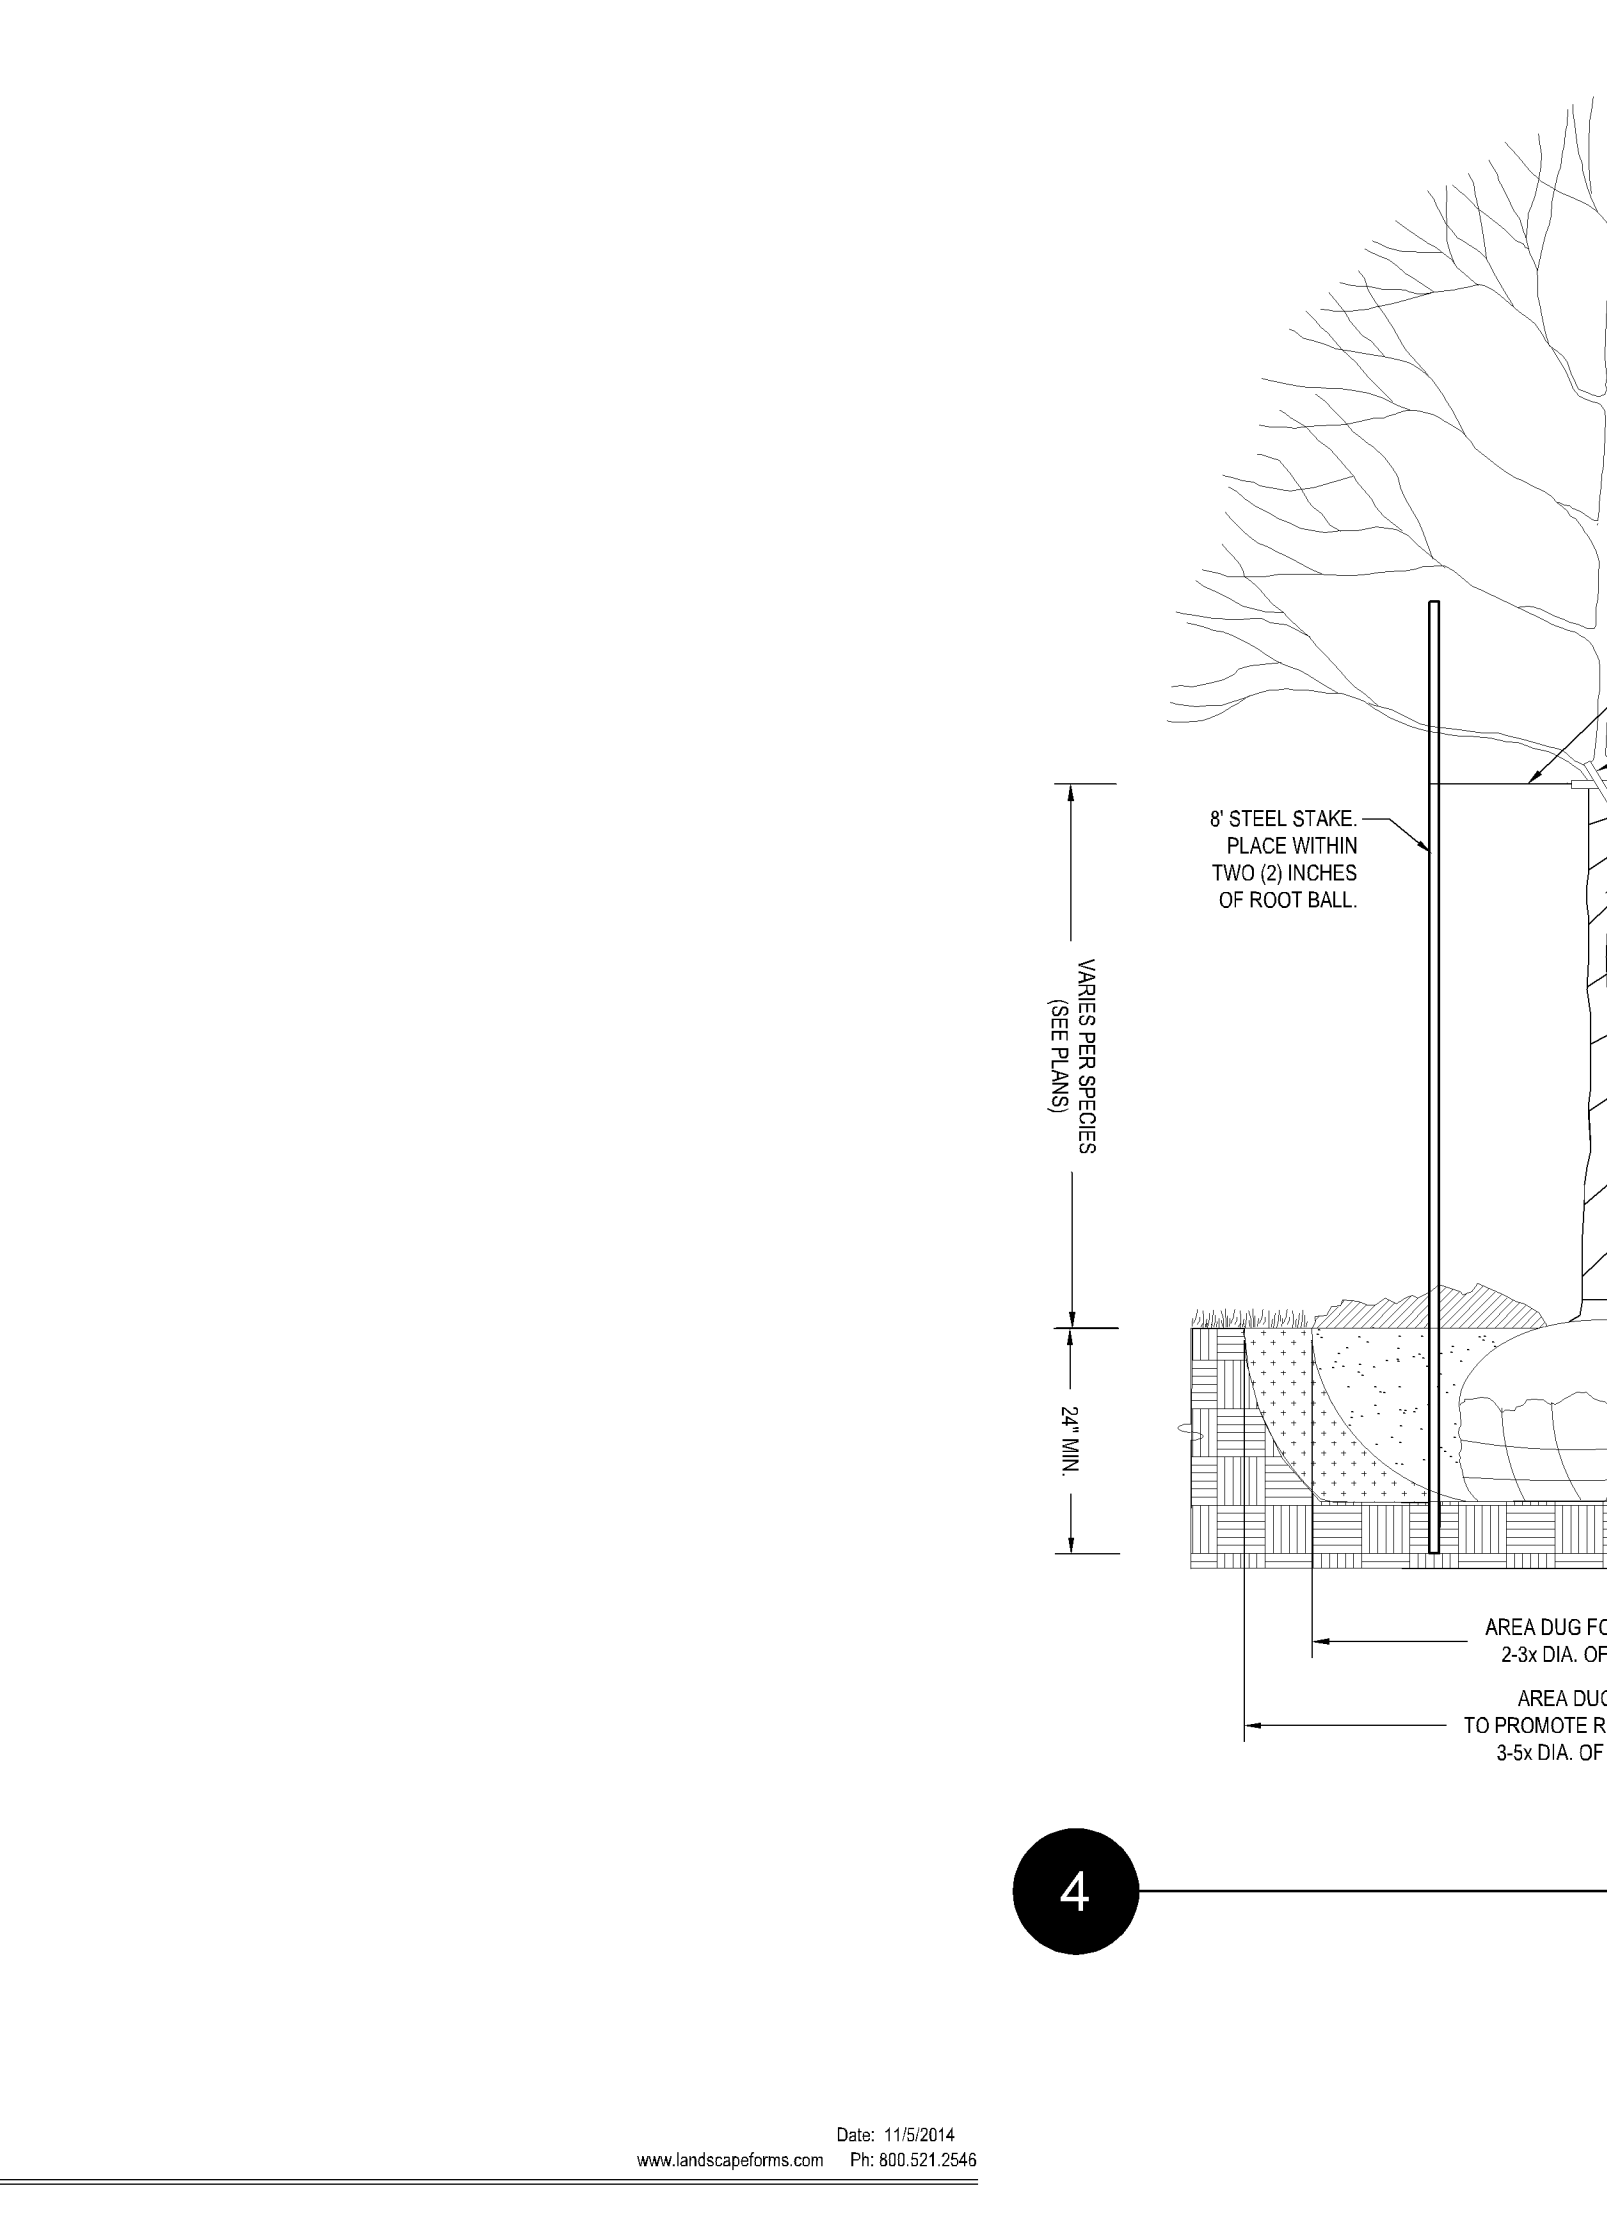

DECIDUOUS TREE PLANTING
NO SCALE

1. PLACE PLANT AS SHOWN ON PLAN

2. TOP OF ROOT MASS SHALL BE LEVEL WITH FINISHED GRADE

3. FINISHED GRADE

4. ROOT BALL SITS ON EXISTING OR RECOMPACTED SUBGRADE

5. FOUR (4) INCH-HIGH SOIL BERM CONSTRUCTED AROUND ENTIRE ROOT BALL. BERM SHALL BEGIN AT ROOT BALL EDGE

6. MULCH (SEE PLANS)

7. PLANTING SOIL (SEE PLANS)

8. EDGING (SEE PLANS)

9. REFER TO LANDSCAPE PLANS FOR GROUNDCOVER OUTSIDE SHRUB BEDS

10. EXISTING SUBGRADE

11. SCARIFY BOTTOM AND SIDES OF HOLE PRIOR TO PLANTING

12. SUBGRADE

13. NOTES:
IF ROOTS ARE PRESENT AROUND THE EDGES OF ROOTBALL, UNCOIL OR CUT AS MANY AS POSSIBLE WITHOUT DESTROYING SOIL MASS.
DIG PLANTING PIT NO DEEPER THAN HEIGHT OF ROOT BALL.

14. PLANT MATERIAL SHALL NOT BE FLAGGED CLOSER THAN ONE (1) FOOT FROM EDGES OF PLANTING BED

15. SPACING VARIES (SEE PLANS)

16. PERENNIAL

17. CREATE SAUCER AROUND PLANT WITH PLANTING SOIL

18. MULCH




19. EDGING

20. REFER TO LANDSCAPE PLANS FOR GROUNDCOVER OUTSIDE PLANTING BED

21. BACKFILL WITH PLANTING SOIL THAT IS THOROUGHLY TILLED AND LOOSENED (SEE PLANS)

22. EXISTING SUBGRADE


23. NOTES:
IF ROOTS ARE PRESENT AROUND THE EDGES OF ROOTBALL, UNCOIL OR CUT AS MANY AS POSSIBLE WITHOUT DESTROYING SOIL MASS.

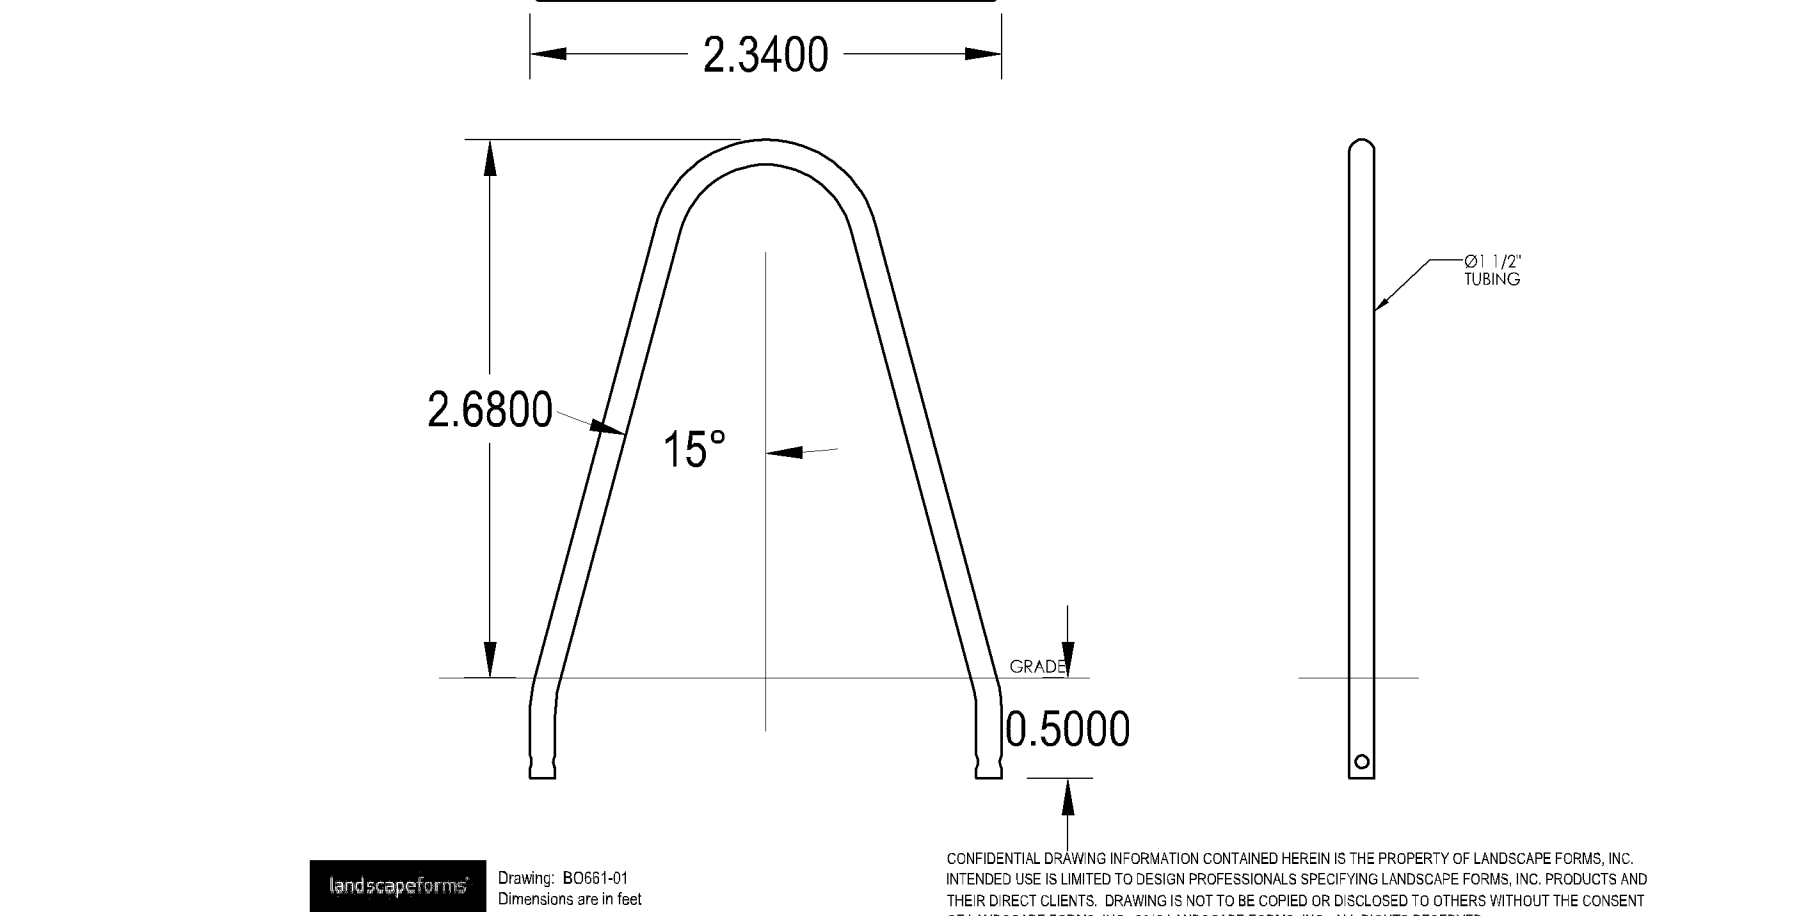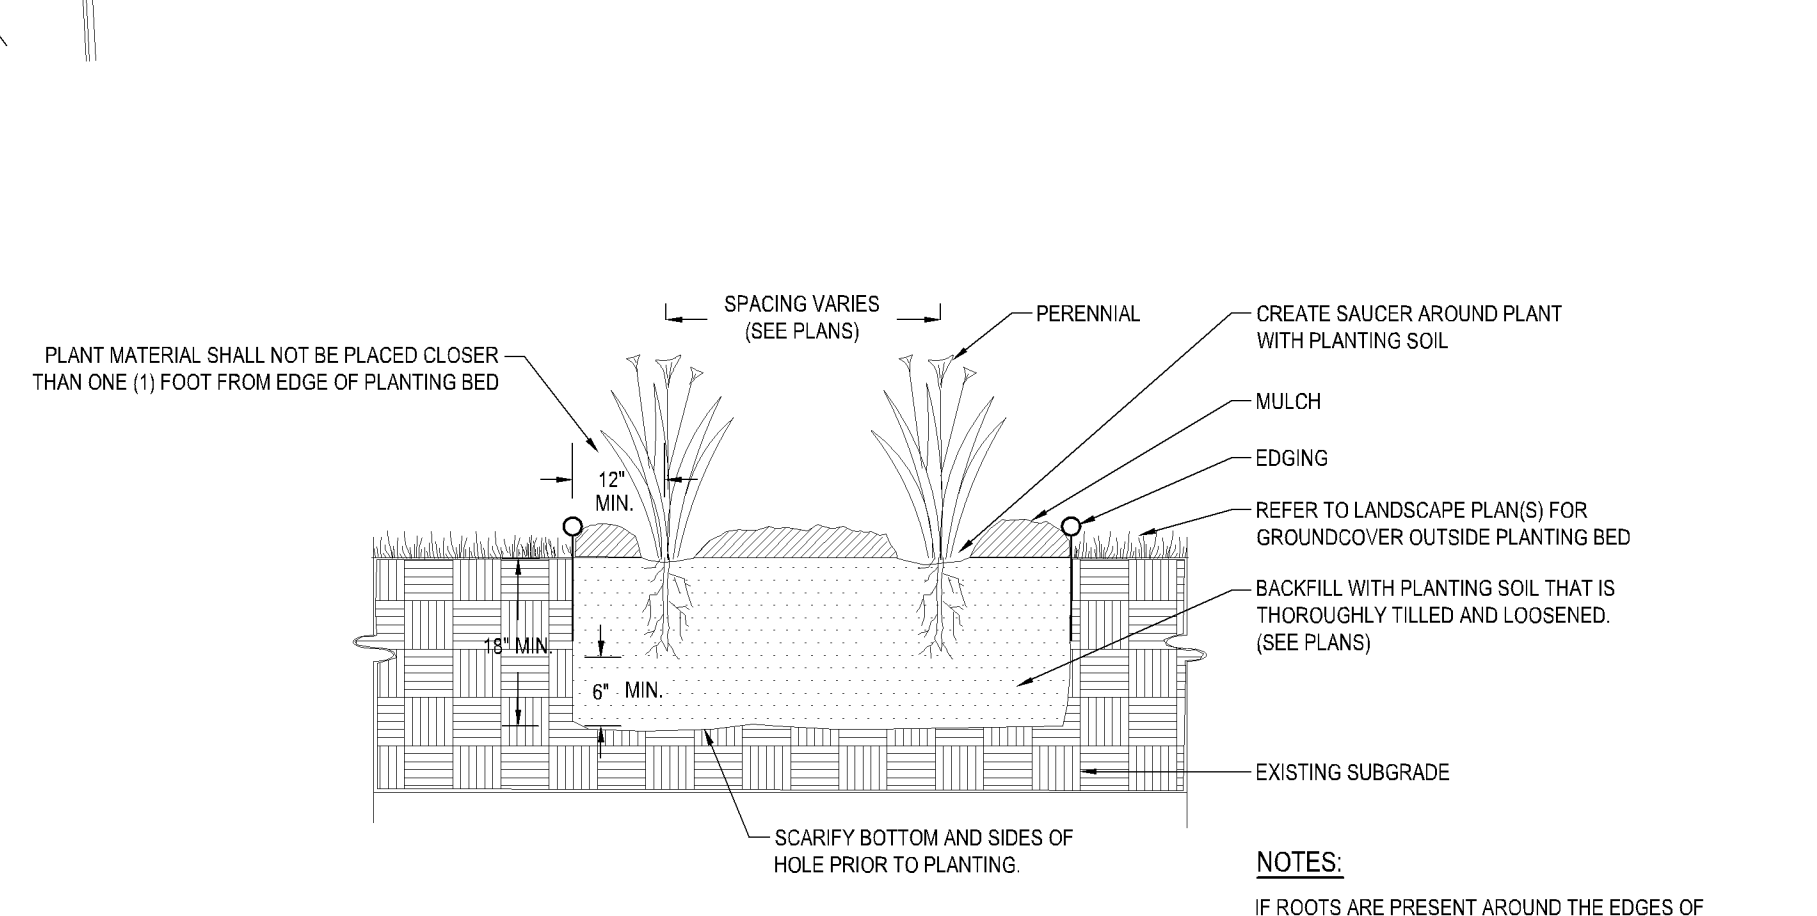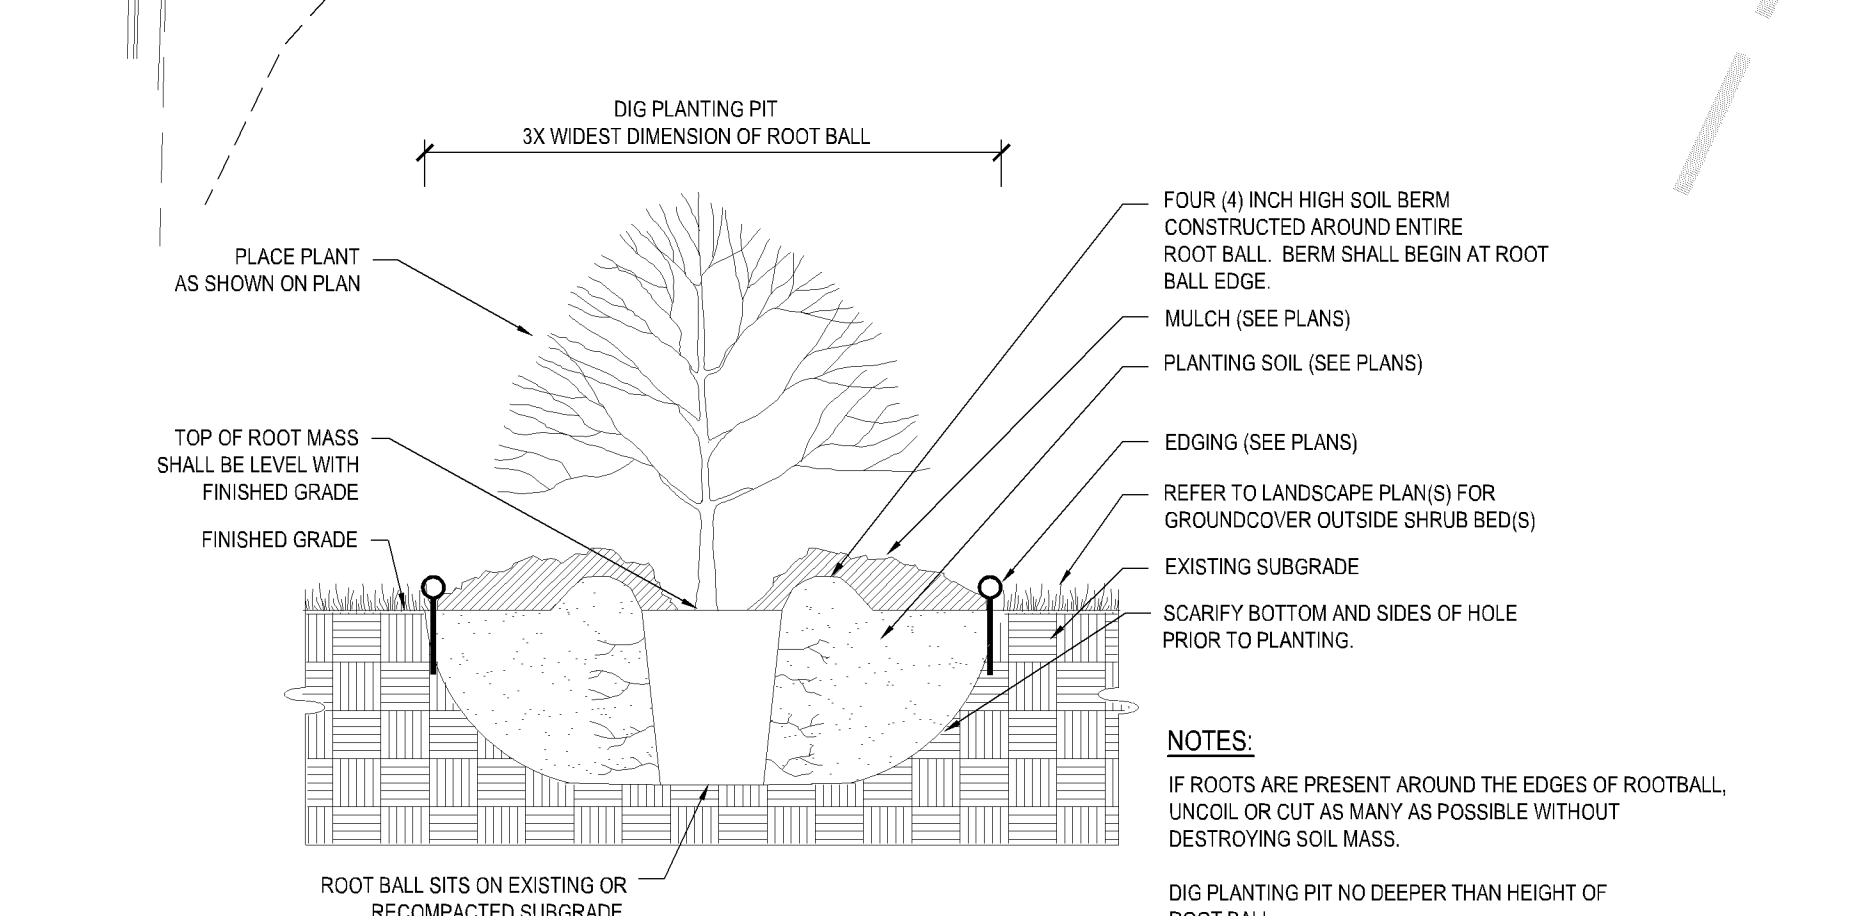

1 SHRUB PLANTING
NO SCALE

2 PERENNIAL PLANTING
NO SCALE

3 BIKE RACK
NO SCALE

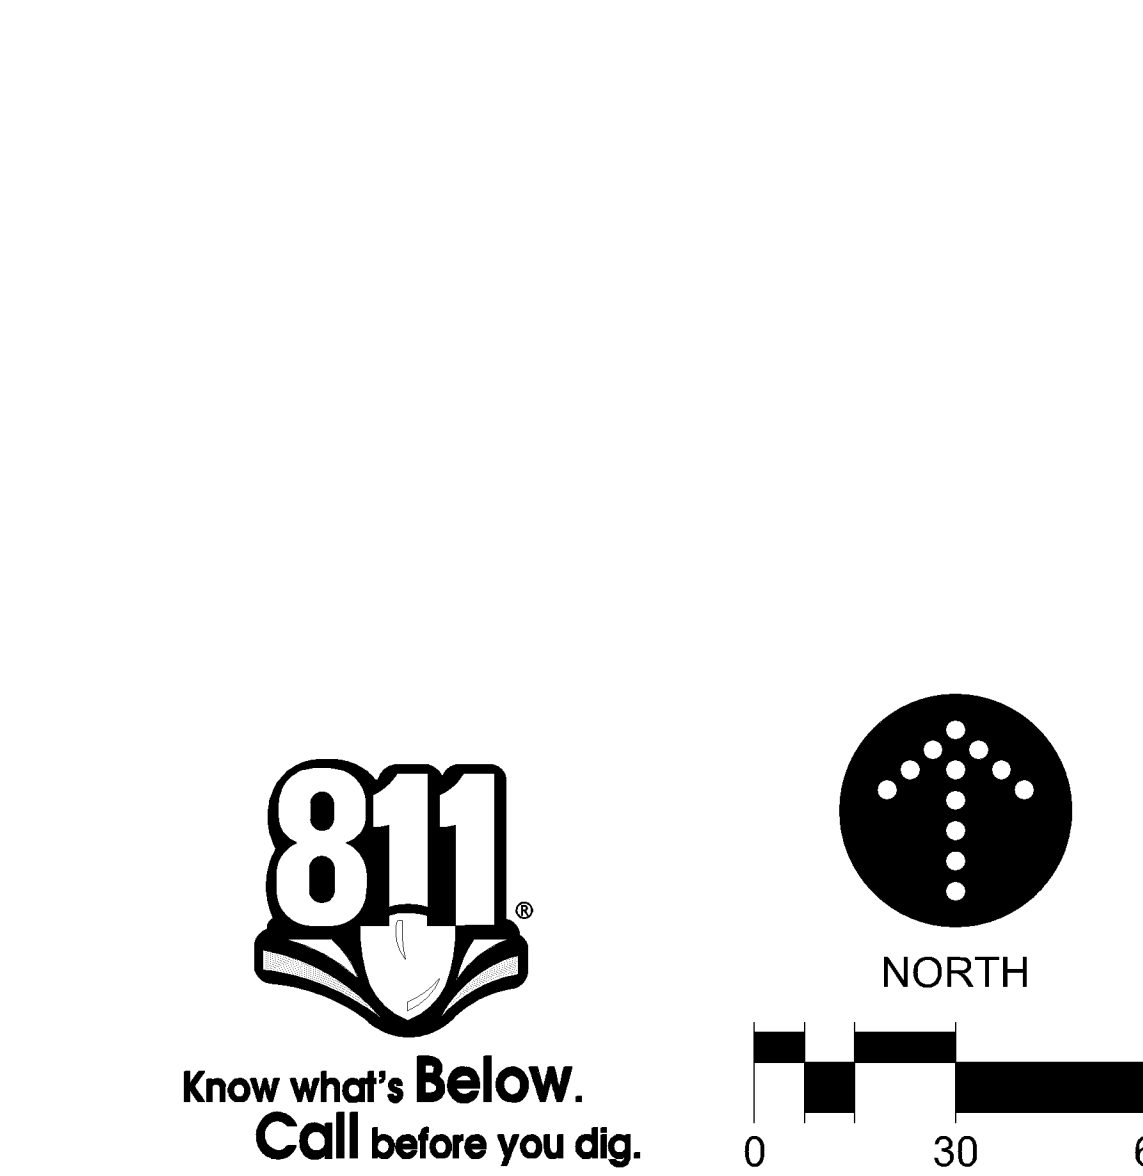

4 DECIDUOUS TREE PLANTING
NO SCALE

DEVELOPER
THE LUTHER COMPANY, LLLP
3701 ALABAMA AVENUE SOUTH
ST. LOUIS PARK, MN
TEL: (612)252-9800 • FAX: (612) 252-9800

MUNICIPALITY
BLOOMINGTON

PROJECT
LUTHER HYUNDAI
BLOOMINGTON, MN

ISSUE REVISION HISTORY

DATE	ISSUE / REVISION	REVIEW
10/20/2022	DISC SUBMITTAL	RES
11/08/2022	CITY SUBMITTAL	RES
18/MAR/2023	PERMITS	RES
30/MAR/2023	CITY PERMITTED/RESUBMITTAL	RES
06/JUN/2023	CITY PERMITTED/RESUBMITTAL	RES
12/JUL/2023	BULLETIN 05	RES
02/AUG/2023	BULLETIN 05	RES
02/NOV/2023	BULLETIN 05	RES

CERTIFICATION

I hereby certify that this plan was prepared by me, or under my direct supervision, and that I am a duly Licensed Landscape Architect under the laws of the State of Minnesota.

John K. Poppe

John K. Poppe
License No: 4-0553 Date: 08/20/2023

Prepared under a design professional's original seal and signature on this plan as required by Minnesota Statutes, Chapter 83B, and the rules of the Board of Landscape Architects, L.L.C. and the Minnesota State Board of Landscape Architects.

BULLETIN 05
NOVEMBER 03, 2023

LANDFORM
From Site to Finish

105 South Fifth Avenue Tel: 612-252-9070
Suite 513 Fax: 612-252-9077
Minneapolis, MN 55401 Web: landform.net

FILE NAME: L201LUT054.DWG
PROJECT NO: LUT2054


LANDSCAPE PLAN
L2.1

Landform and Site Form™ are registered trademarks of Landform Professional Services, LLC.

811
Know what's Below.
Call before you dig.

NORTH

0 30 60

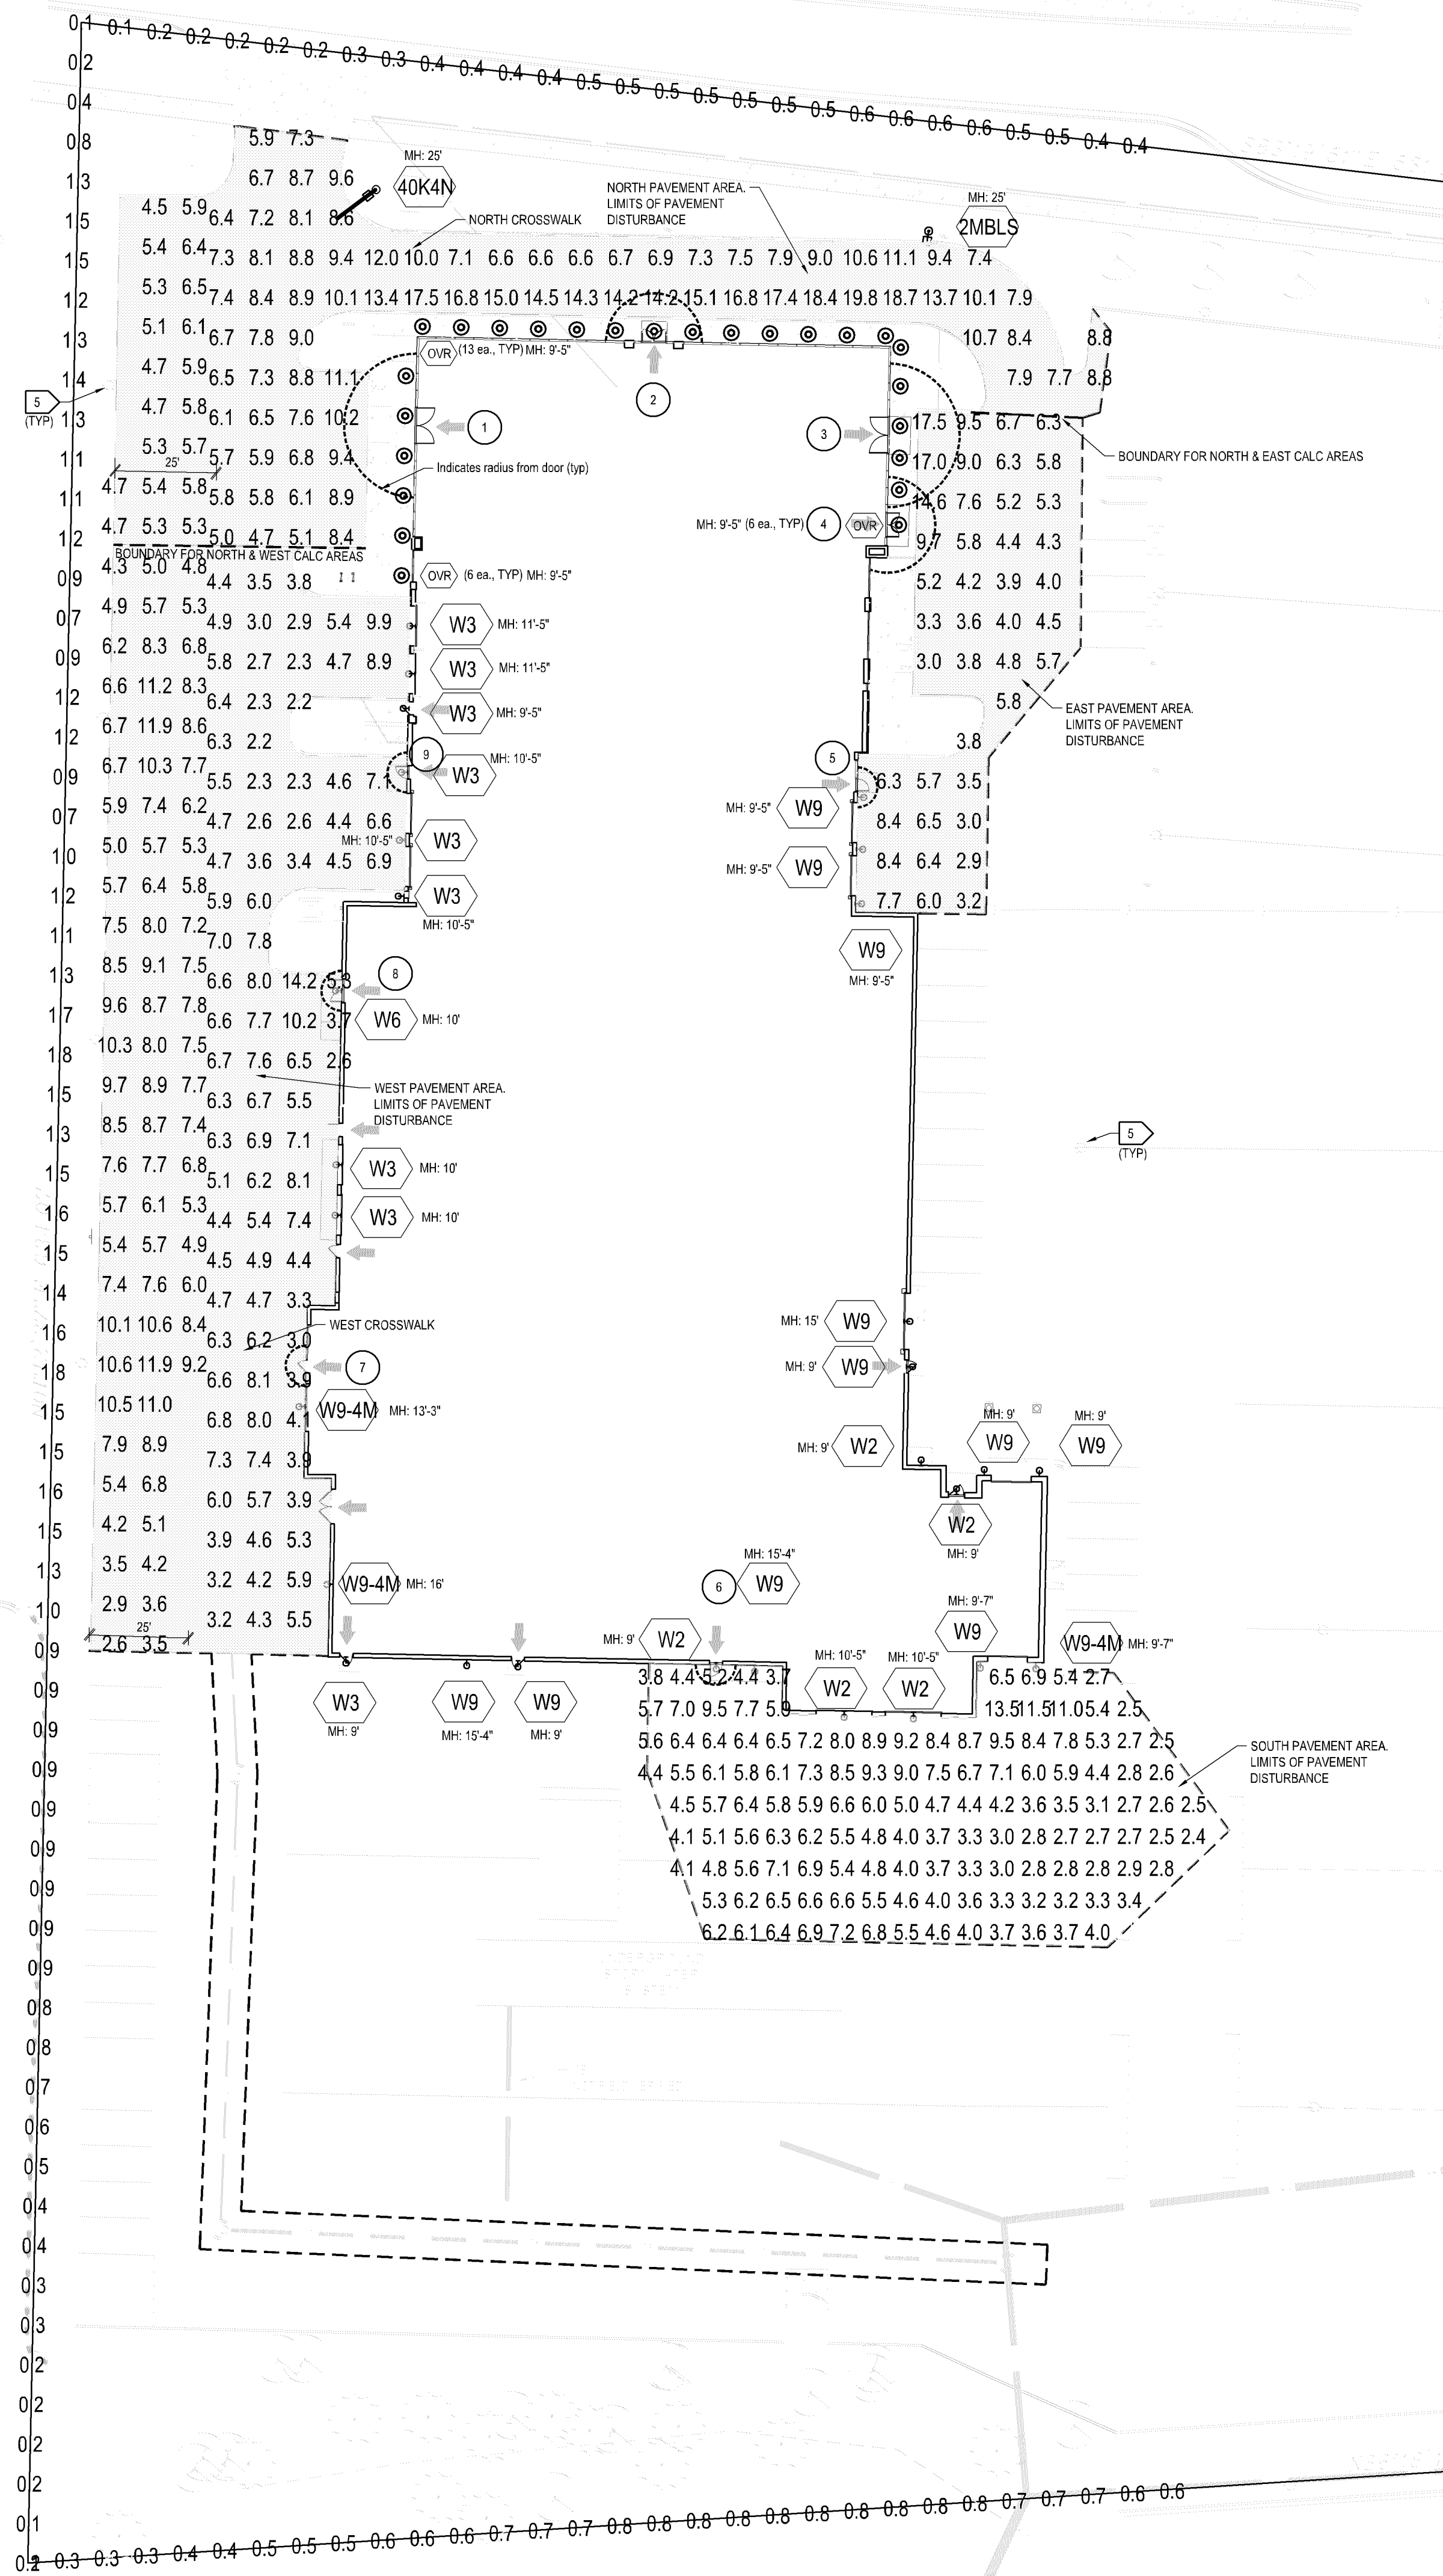

XSP Series

Product Description: The XSP Series is a high-performance, adjustable luminaire designed for outdoor use. It features a die-cast aluminum housing and a clear polycarbonate lens. The luminaire is available in multiple mounting heights and is suitable for a variety of applications, including street lighting and area lighting.

Performance Summary: The XSP Series provides a high level of performance, with a maximum beam spread of 120 degrees and a maximum mounting height of 10 feet. It is designed to provide uniform illumination and is suitable for use in a variety of environments.

Accessories: The XSP Series is available with a variety of accessories, including mounting brackets, junction boxes, and power leads. These accessories are designed to provide a complete lighting solution for your application.

Ordering Information: The XSP Series is available in a variety of configurations, including different mounting heights and beam spreads. Please refer to the product catalog for more information on the available options.

CREE LIGHTING

OSQ Series

Product Description: The OSQ Series is a high-performance, adjustable luminaire designed for outdoor use. It features a die-cast aluminum housing and a clear polycarbonate lens. The luminaire is available in multiple mounting heights and is suitable for a variety of applications, including street lighting and area lighting.

Performance Summary: The OSQ Series provides a high level of performance, with a maximum beam spread of 120 degrees and a maximum mounting height of 10 feet. It is designed to provide uniform illumination and is suitable for use in a variety of environments.

Accessories: The OSQ Series is available with a variety of accessories, including mounting brackets, junction boxes, and power leads. These accessories are designed to provide a complete lighting solution for your application.

Ordering Information: The OSQ Series is available in a variety of configurations, including different mounting heights and beam spreads. Please refer to the product catalog for more information on the available options.

CREE LIGHTING

- ### GENERAL NOTES
- Coordinate with electrical contractor to provide conduits for site lighting.
 - Light pole base shall be designed and provided by others. All bases in green space shall be eight (8) inch height. All bases in pavement shall be thirty-six (36) inch height.
 - Mounting height listed in luminaire schedule includes height of the pole base.
 - Calculations based on site lighting fixtures. Any substitutions need to meet city code requirements.
 - Existing light poles and luminaires.
 - Quantities shown on this sheet are total quantities for design.
- ### BLOOMINGTON CODE REQUIREMENTS
- 22' - maximum pole height
 - 10:1 - maximum uniformity ratio (50% reduction for perimeter 25')
 - 2.0 fc - minimum foot candles (pavement surface)
 - 2.0 fc - minimum foot candles (sidewalk)
 - 10.0 fc - minimum foot candles (primary building entrance); radius of 2x door opening
 - 2.0 fc - minimum foot candles (secondary building entrance); 8' radius
 - 3.0 fc - minimum foot candles (pedestrian access surface from primary building entrance, within 30')
 - 2.0 fc - minimum foot candles (pedestrian access surface to primary building entrance, beyond 30')
 - 4.0 fc - minimum foot candles (pedestrian crosswalk, 2x fc level of pavement)
 - 50,000 maximum lumens (per single fixture, initial lumens)

LUMINAIRE SCHEDULE

CALLOUT	SYMBOL	QUANTITY	MOUNTING	MODEL	LUMENS / LAMP
ZMBSF		2	POLE	Cree Lighting OSQ-S-300-180-2M-UL-xxx-xxxx w/ OSQ-BLSLF	2880
ZKAN		1	POLE	Cree Lighting OSQ-S-300-180-2M-UL-xxx-xxxx w/ OSQ-BLSLF CONFIGURED FROM OSQ-S-300-180-2M-UL-xxx-xxxx w/ OSQ-BLSLF	0
OVR		50	RECESSED	C-Uln_C-CP-B-8RD-ST-SCCT-xx (40K)	0
W2		10	WALL	Cree Inc XSPW-B-3M-3E-4K-4K-UL CONFIGURED FROM XSPW-B-3M-3E-4K-4K-UL	0
W3		20	WALL	Cree Inc XSPW-B-3M-3E-4K-4K-UL-VM	0
W6		2	WALL	Cree Inc XSPW-B-3M-3E-4K-4K-UL-VM	0
W9		20	WALL	Cree Inc XSPW-B-3M-3E-4K-4K-UL CONFIGURED FROM XSPW-B-3M-3E-4K-4K-UL	8475
W9-4M		6	WALL	Cree Lighting XSPW-B-3M-3E-4K-4K-UL-xxxx	8475


FOOT CANDLE CALCULATIONS

Area	Average Foot-Candles	Maximum Foot-Candles	Minimum Foot-Candles	Minimum to Maximum FC Ratio	Maximum to Minimum FC Ratio	Average to Minimum FC Ratio
SOUTH PAVEMENT	5.31	13.5	2.4	0.16	5.86	2.22
NORTH PAVEMENT	9.43	19.8	4.7	0.24	4.23	2.01
WEST PAVEMENT	5.38	14.2	2.9	0.17	6.45	2.46
EAST PAVEMENT	6.25	17.5	2.9	0.17	6.03	2.16
NORTH CROSSWALK	15.2	21	6.8	0.31	17.42	1.95
WALKWAY	22.34	40.9	2.3	0.06	17.42	9.52
WEST CROSSWALK	6.18	6.5	2.6	0.69	1.44	1.38
25' ZONE - WEST	6.79	11.9	2.6	0.22	4.58	2.62

Door	Average Foot-Candles	Maximum Foot-Candles	Minimum Foot-Candles	Minimum to Maximum FC Ratio	Maximum to Minimum FC Ratio	Average to Minimum FC Ratio
Door 1	16.46	20.7	10.4	0.5	1.99	1.59
Door 2	17.89	26.2	13.4	0.68	1.51	1.34
Door 3	16.42	25.2	12.4	0.49	2.04	1.48
Door 7	3.91	4.2	3.6	0.85	1.17	1.1
Door 8	7.47	7.7	7	0.9	1.11	1.07
Door 9	3.6	3.7	3.4	0.92	1.08	1.05

Door	Average Foot-Candles	Maximum Foot-Candles	Minimum Foot-Candles	Minimum to Maximum FC Ratio	Maximum to Minimum FC Ratio	Average to Minimum FC Ratio
Door 4	13.49	19.9	7.9	0.4	2.51	1.7
Door 5	3.11	3.4	2.8	0.8	1.24	1.13
Door 6	4.39	4.5	4.3	0.96	1.04	1.02

Property line	Average Foot-Candles	Maximum Foot-Candles	Minimum Foot-Candles	Minimum to Maximum FC Ratio	Maximum to Minimum FC Ratio	Average to Minimum FC Ratio
Property line - North	0.27	0.6	0	0.03	37.67	16.21
Property line - SOUTH	0.47	0.8	0	0.06	17.27	10.31
Property line - WEST	0.99	1.8	0.1	0.06	17.13	9.41

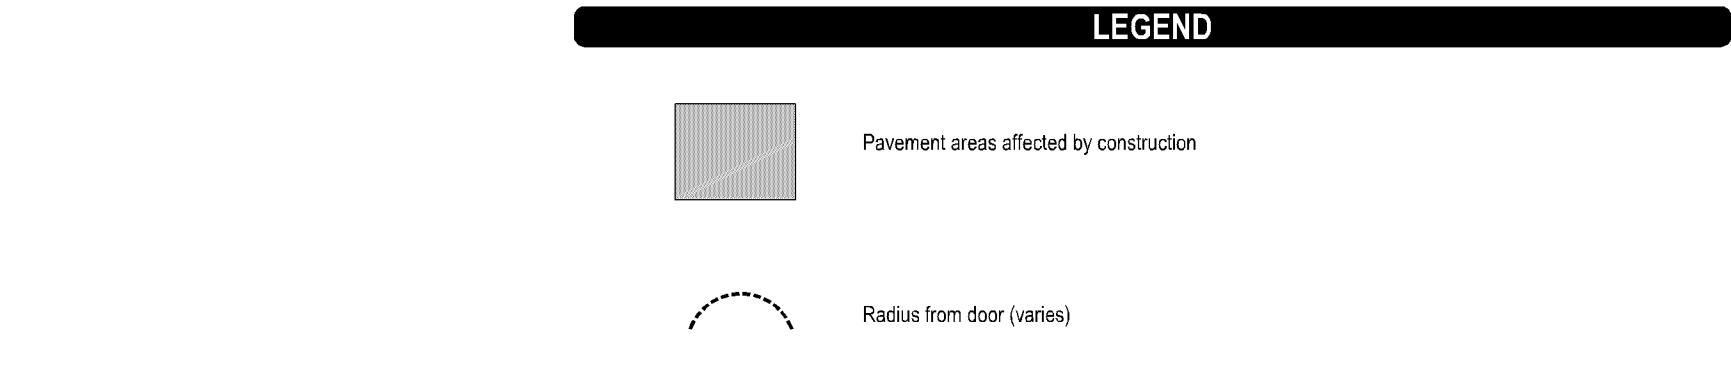

DEVELOPER
THE LUTHER COMPANY, LLLP
 3701 ALABAMA AVENUE SOUTH
 ST. LOUIS PARK, MN
 TEL: (612) 252-9800 • FAX: (612) 252-9800

MUNICIPALITY

BLOOMINGTON

PROJECT
LUTHER HYUNDAI
BLOOMINGTON, MN
ISSUE REVISION HISTORY

DATE	ISSUE	REVISION
10/30/2022	DISC 5/REVISION	REV 1
11/09/2022	DISC 5/REVISION	REV 2
08/04/2023	DISC 5/REVISION	REV 3
08/04/2023	DISC 5/REVISION	REV 4
08/04/2023	DISC 5/REVISION	REV 5
08/04/2023	DISC 5/REVISION	REV 6
08/04/2023	DISC 5/REVISION	REV 7
08/04/2023	DISC 5/REVISION	REV 8
08/04/2023	DISC 5/REVISION	REV 9
08/04/2023	DISC 5/REVISION	REV 10

CERTIFICATION

IF THE SIGNATURE, SEAL OR FOUR-LINE DIRECTLY ABOVE ARE NOT VALID, THIS SHEET HAS BEEN REPRODUCED WITHOUT AUTHORITY. REPRODUCING THIS DOCUMENT WITHOUT THE WRITTEN CONSENT OF THE ENGINEER IS ILLEGAL AND UNETHICAL.

BULLETIN 05
 NOVEMBER 03, 2023

LANDFORM
 From Site to Finish

105 South Fifth Avenue, Suite 513, Minneapolis, MN 55401
 Tel: 612-252-9070, Fax: 612-252-9077, Web: landform.net

FILE NAME: L401LUT054.DWG
 PROJECT NO: LUT2054

PHOTOMETRICS PLAN - INSTALLED VALUES
L4.1

