

DETAILS



PROJECT
MALL OF AMERICA®
2131 Lindau Lane - Suite 500
Bloomington, MN 55425


The information in this document is confidential and a proprietary trade secret of the Landlord. It may not be copied, distributed, published or disclosed without the Landlord's prior written consent. Landlord retains the right to design, arrange, lease, let, sublease, or otherwise dispose of any or all of the Center or any of the buildings, structures, spaces, rooms, hallways, corridors, Kiosks, tenant spaces or other areas of the Center, including, but not limited to, the identity, number, location, size and arrangement of any of the foregoing. Landlord reserves the right to make any contract or obligation by the Landlord, Landlord retains no liability, any premises contained therein, or the premises described in this document. Gross Leasable Area is defined in the Mall of America ZES 5-2010 Retail Building Standard. It is the responsibility of the Tenant's contractor to field verify existing site conditions and dimensions.



PARK & FLY - PARKING RAMP P7 GATE

Mall of America PARCS
P7 East Garage


Long island dimensions:
42'L x 36'W x 5.5'H

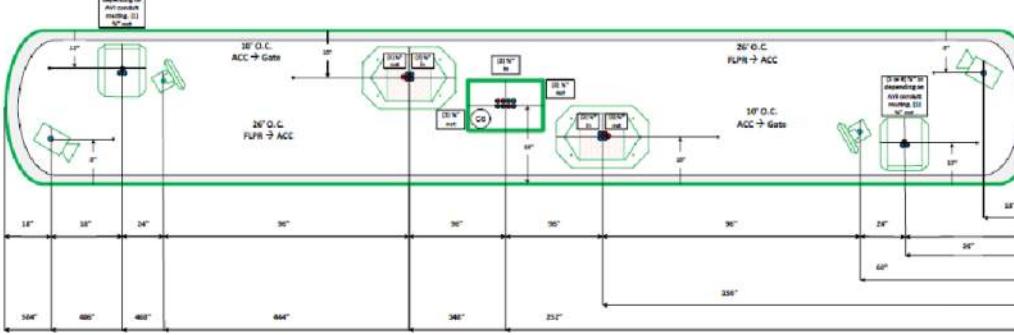

DATE	SCALE	Mall of America	REV	Date Reviewed	Reviewer	TD SYSTEMS	TD Systems, Inc. 8000 Krocus Crossing Indooroopilly, Qld 4054	Conduit - 2-way Island FLPR/AVI w/Network Locker
02/06/2024	NTS	Rob Kirby	00-01					

Mall of America PARCS
P7 East Garage


Standard island dimensions:
16'L x 30'W x 5.5'H

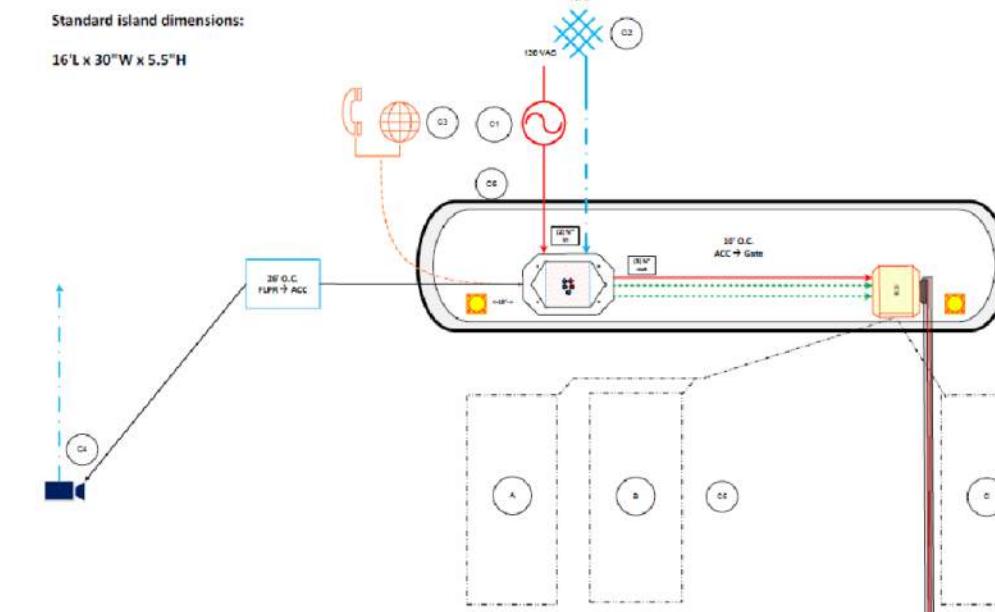

DATE	SCALE	Mall of America	REV	Date Reviewed	Reviewer	TD SYSTEMS	TD Systems, Inc. 8000 Krocus Crossing Indooroopilly, Qld 4054	UK Cancer Center - FLPR Ceiling Mount
02/06/2024	NTS	Rob Kirby	00-01					

Mall of America PARCS
P7 East Garage

Long Island dimensions:
42'L x 36'W x 5.5'H

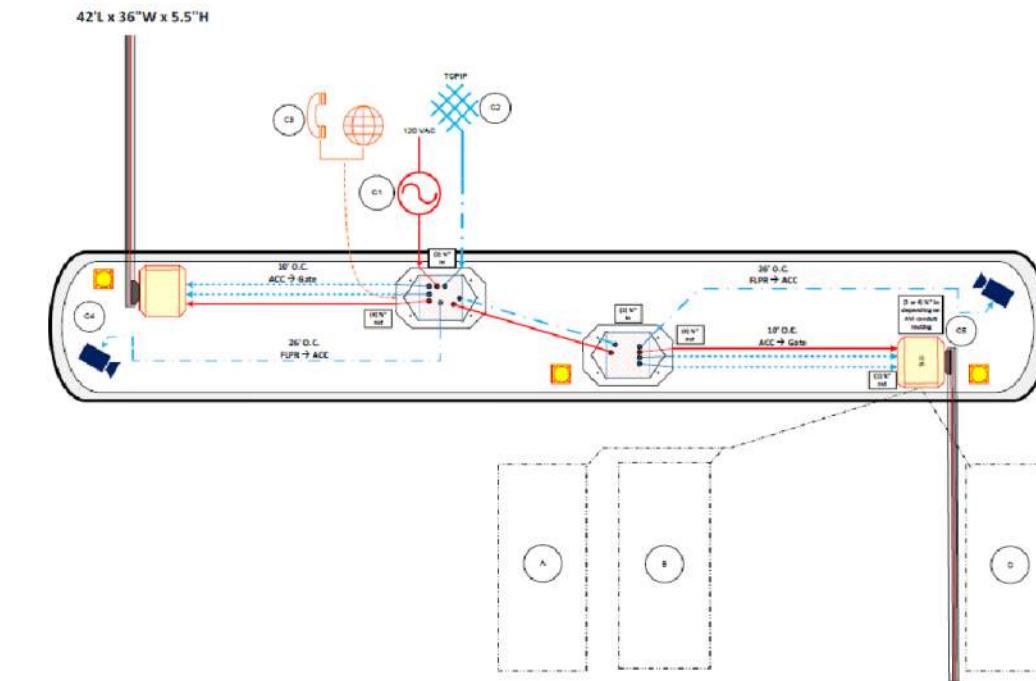

DATE	SCALE	Mall of America	REV	Date Reviewed	Reviewer	TD SYSTEMS	TD Systems, Inc. 8000 Krocus Crossing Indooroopilly, Qld 4054	Double Island - Typical
02/06/2024	NTS	Rob Kirby	00-01					


SEPARATE TRADE PERMITS REQUIRED

Install per Manufacturer's Instructions


Mall of America PARCS
P7 East Garage

Mall of America PARCS
P7 East Garage

P7 East Garage

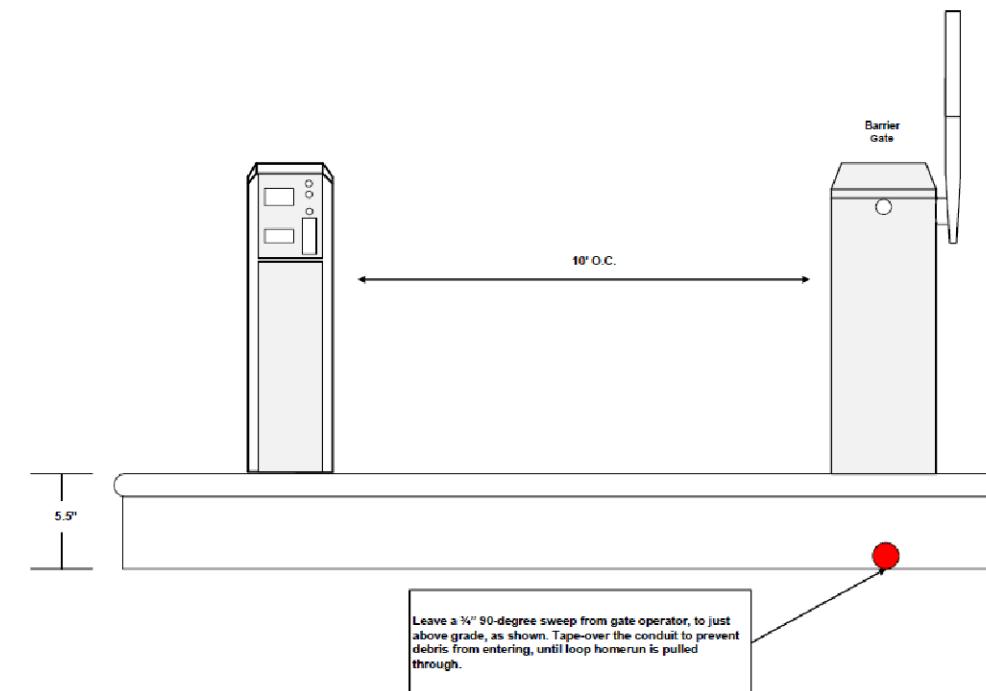


DATE	SCALE	Mall of America	REV	Date Reviewed	Reviewer	TD SYSTEMS	TD Systems, Inc. 8000 Krocus Crossing Indooroopilly, Qld 4054	Loop Homerun Note
02/06/2024	NTS	Rob Kirby	00-01					

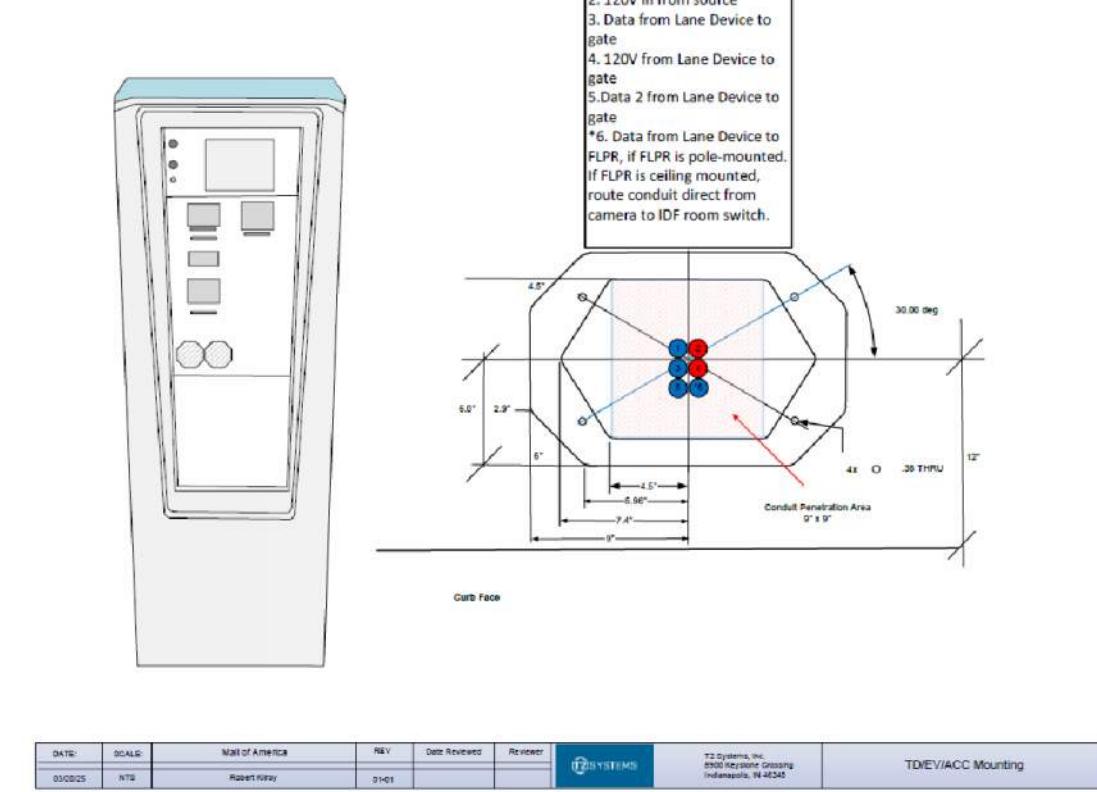

DATE	SCALE	Mall of America	REV	Date Reviewed	Reviewer	TD SYSTEMS	TD Systems, Inc. 8000 Krocus Crossing Indooroopilly, Qld 4054	TD/EV/ACC Mounting
02/06/2024	NTS	Rob Kirby	00-01					

Mall of America PARCS
P7 East Garage

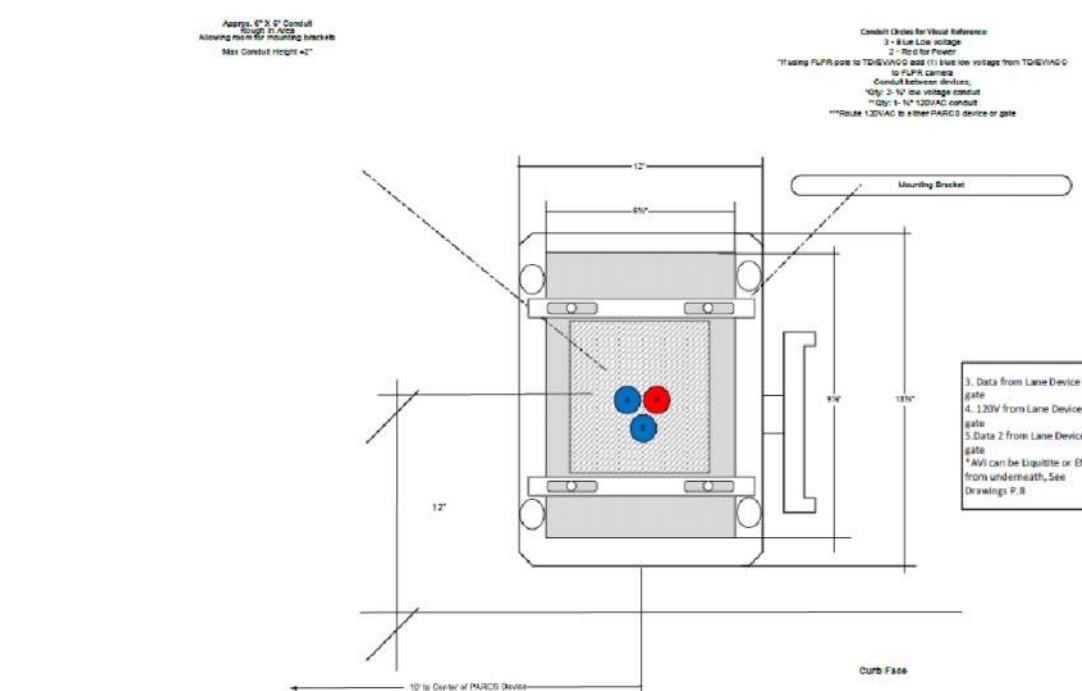

DATE	SCALE	Mall of America	REV	Date Reviewed	Reviewer	TD SYSTEMS	TD Systems, Inc. 8000 Krocus Crossing Indooroopilly, Qld 4054	Gate Mounting
02/06/2024	NTS	Rob Kirby	00-01					

LEASE PLAN
Modified: 09/16/2025
SCALE
NOT TO SCALE




PROJECT
MALL OF AMERICA®
2131 Lindau Lane - Suite 500
Bloomington, MN 55425

The information in this document is confidential and a proprietary trade secret of the Landlord and may not be copied, distributed, published or disclosed to any third party. The Landlord and/or Tenant retain the right to design, change, alter or modify (without prior written notice) the size and configuration of any or all of the Center or any of its buildings, premises, hallways, malls, corridors, kiosks, tenant spaces or common areas contained therein, including, but not limited to, the identity, size, configuration, location or arrangement of any of the foregoing. This document does not constitute any contract or obligation by the Landlord. Landlord makes no representations or warranties concerning the Center, any buildings contained therein or the accuracy of the information contained in this document. Gross Leasable Area is calculated pursuant to ANSI/BOMA 65.5-2010 Retail Building Standard. It is the responsibility of Tenant or Tenant's contractor to field verify existing site conditions and dimensions.



NOT TO SCALE

PARK & FLY - MOA ON PROPERTY DMS

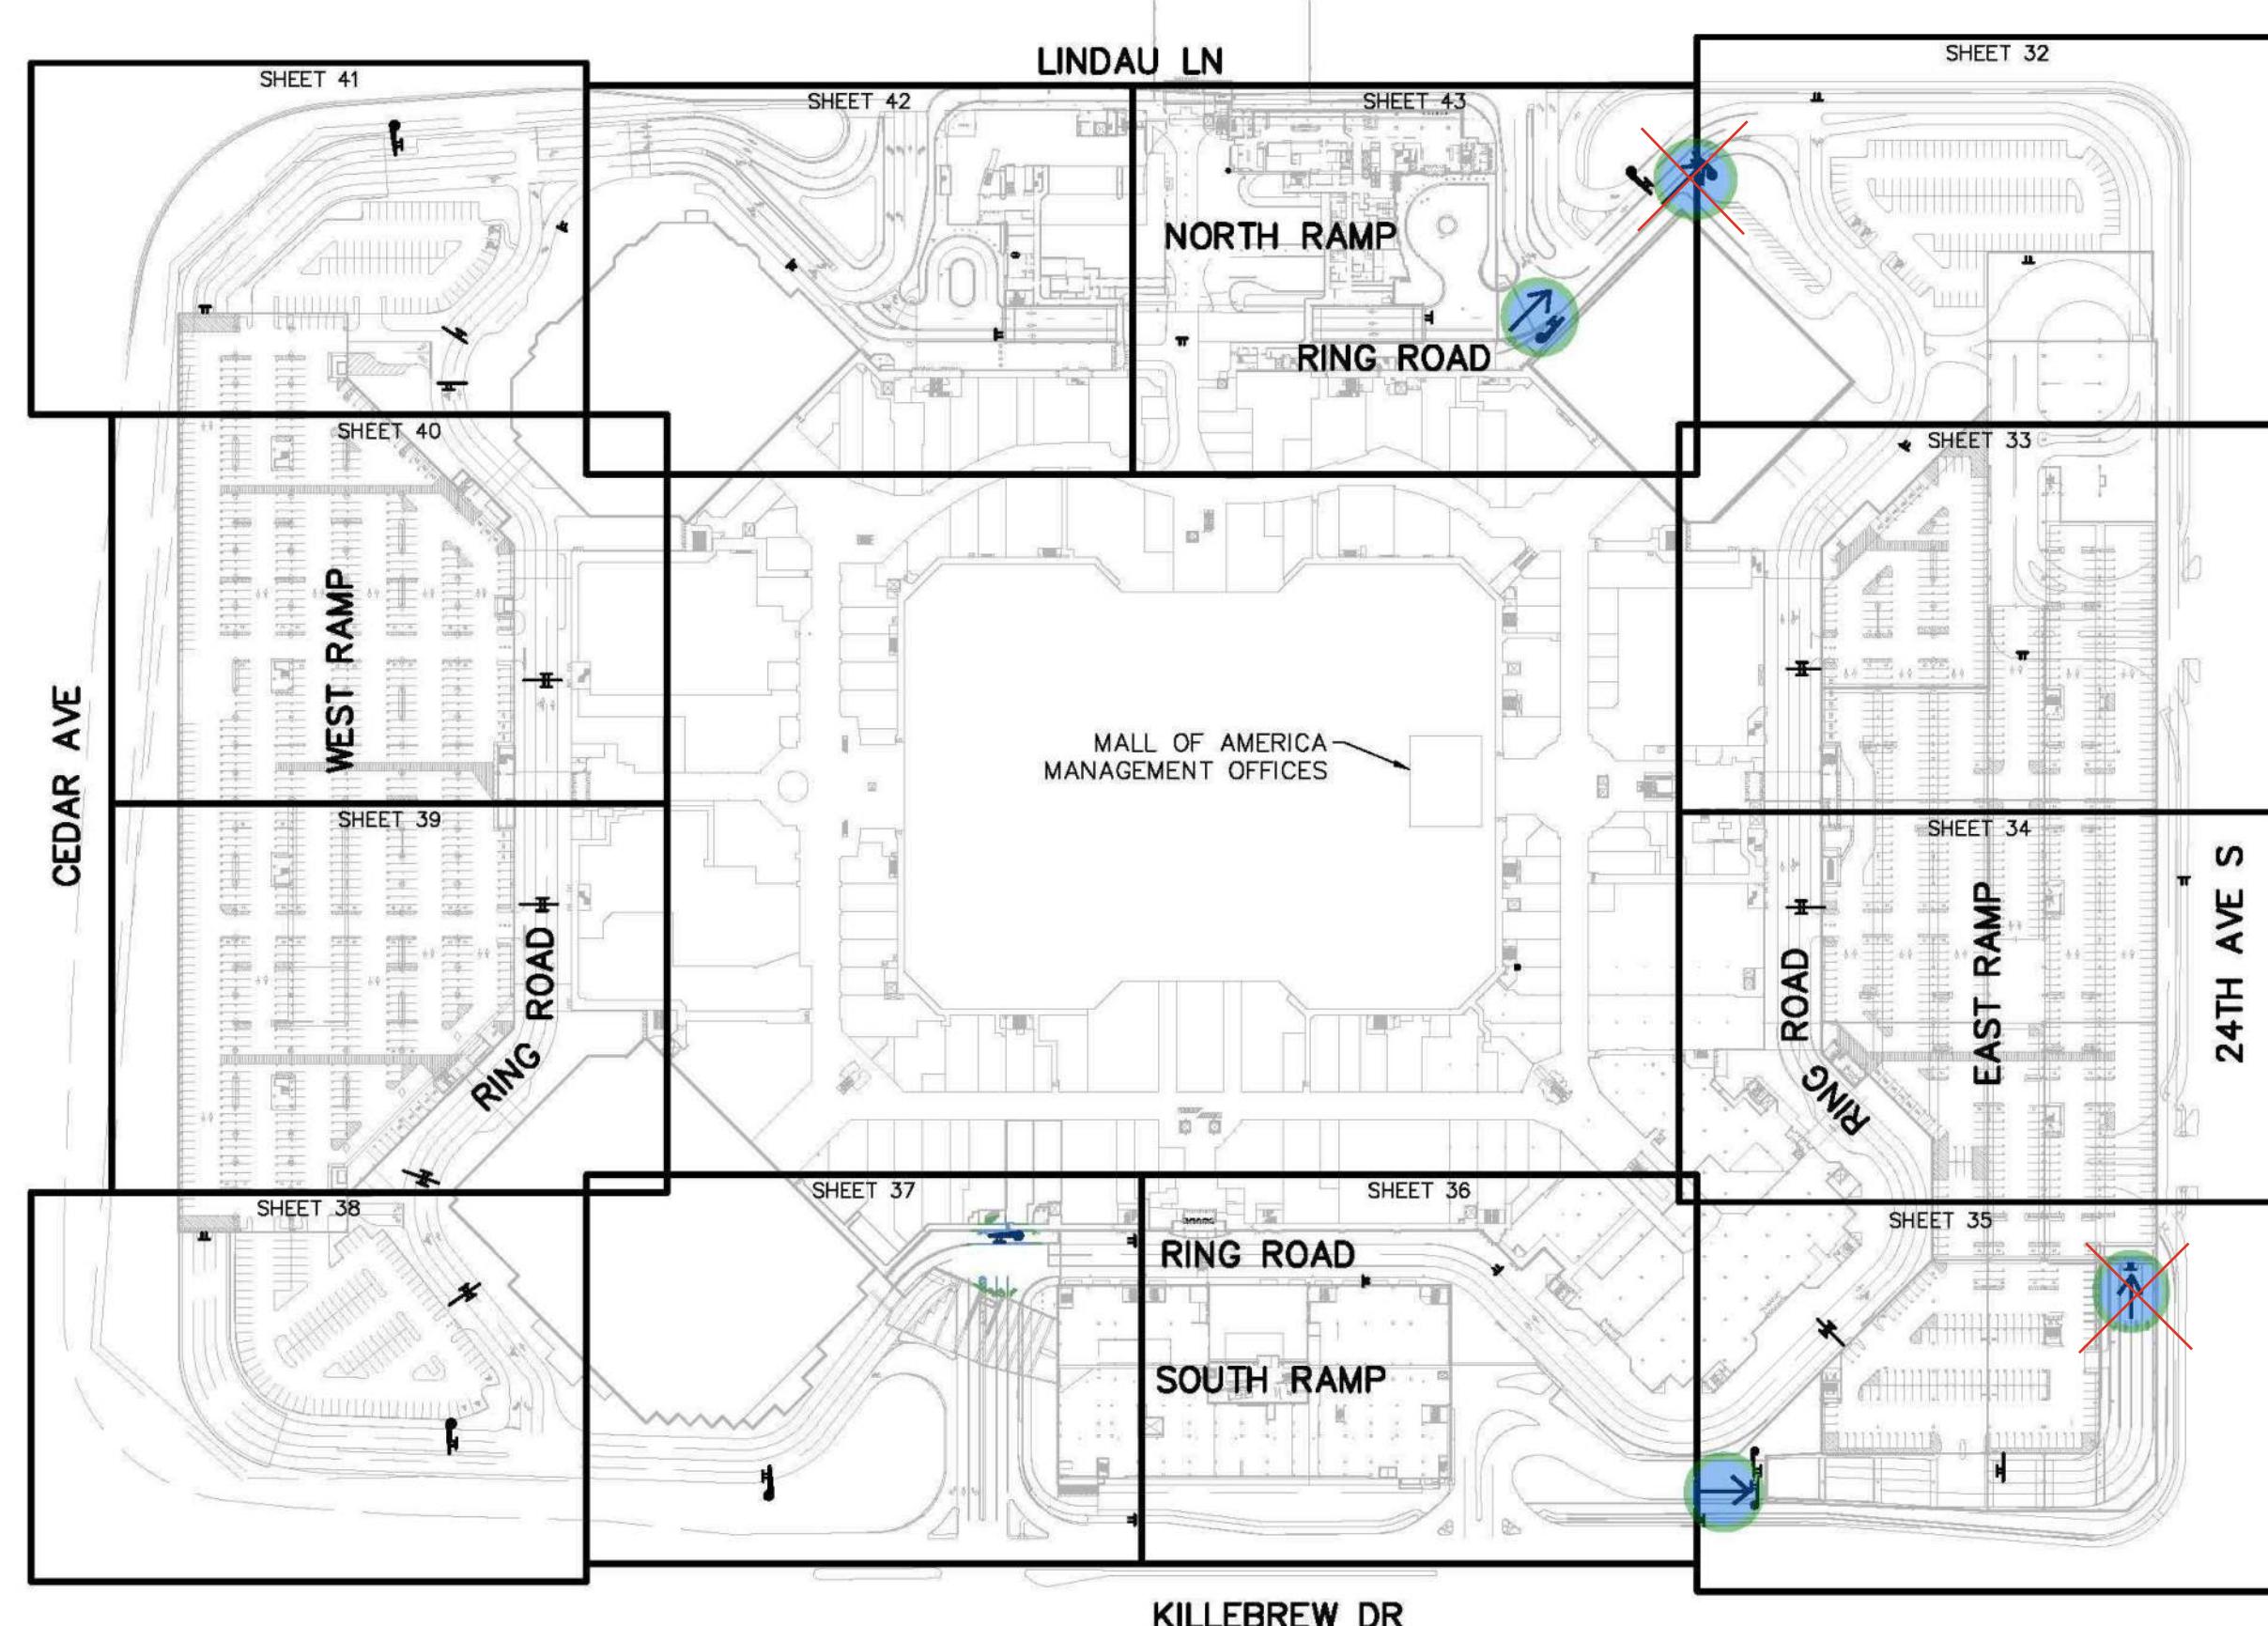

Drawing name: x:\2014\140095\DESIGN\PlanSheets\140095-gerloy.dwg -- Printed: Mar 02, 2016 - 2:03pm


DATE	REVISIONS		Design File:	Designed By:			GENERAL LAYOUT Mall of America - Park & Fly	
			Dwg Name:	Drawn By:				
			Date:	Checked By:				

GENERAL LAYOUT

LEASE PLAN
Modified: 09/16/2025
NOT TO SCALE




2131 LINDAU LANE - SUITE 500 BLOOMINGTON, MN 55425

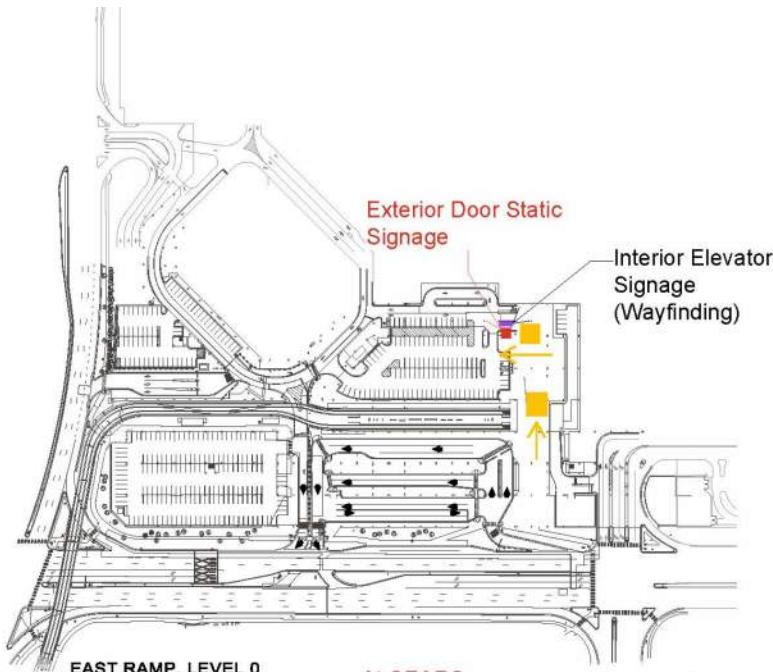

EAST RAMP, LEVEL 0

Key:

- Park Assist Sign Modification
- Hi-Vis Directional Static Signage
- Wall Mounted Static Signage
- Column Directional Signage to Elevator
- Interior Elevator Graphics

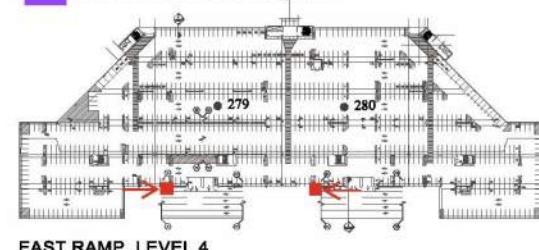


EAST RAMP, LEVEL 4



EAST RAMP, LEVEL 1

PA Signage Alteration

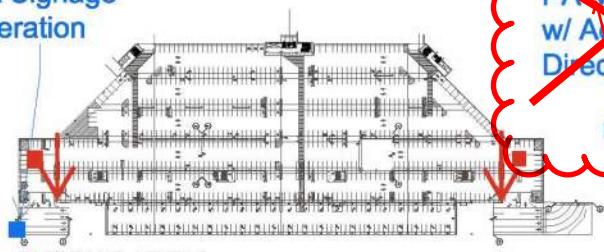


EAST RAMP, LEVEL 2


~~PA Monument Sign w/ Additional Directional Signage~~



EAST RAMP, LEVEL 5

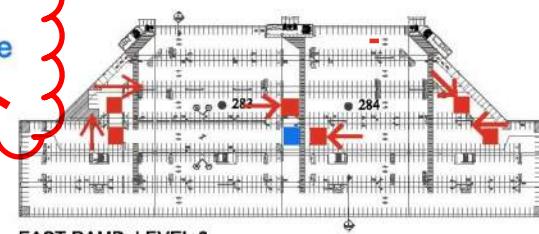


EAST RAMP, LEVEL 6

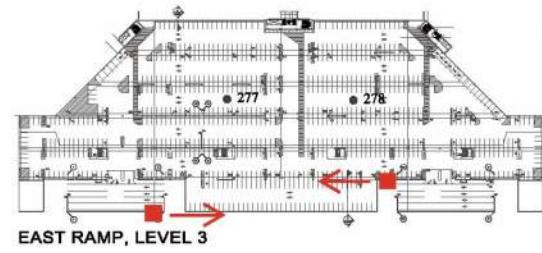

EAST RAMP, LEVEL 3

~~Park & Fly Signage~~

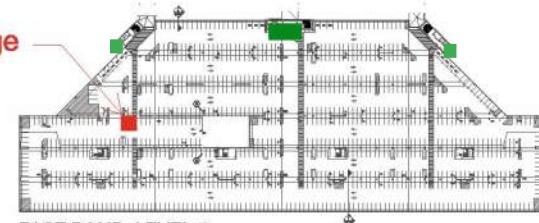

EAST RAMP, LEVEL 7

Notes:

- 1.) Park Assist Signage Modifications: Level 7 / Park 8

Monument Sign not approved as part of this permit. Separate permit & engineering required.

The information in this document is confidential and a proprietary trade secret of the Landlord and may not be copied, distributed, published or disclosed without prior written permission. Landlord retains the right to design, change, alter or modify (without prior written notice) the size and configuration of any or all of the Center or any of the buildings, premises, hallways, malls, corridors, kiosks, tenant spaces or common areas contained therein, including, but not limited to, the identity, size, configuration, location or arrangement of any of the foregoing. This document does not constitute any contract or obligation by the Landlord. Landlord makes no representations or warranties regarding the Center, any premises contained therein, or the accuracy of the information contained in this document. Gross Leasable Area is calculated pursuant to ANSI/BOMA Z65.5-2010 Retail Building Standard. It is the responsibility of Tenant or Tenant's contractor to field verify existing site conditions and dimensions.

DBA Name: PARK & FLY
Unit No. N/A

0-P7 East Ramp Signage Plan

Date: 09/16/2025
Scale: NOT TO SCALE