



This area updated in 2022.
See pages below

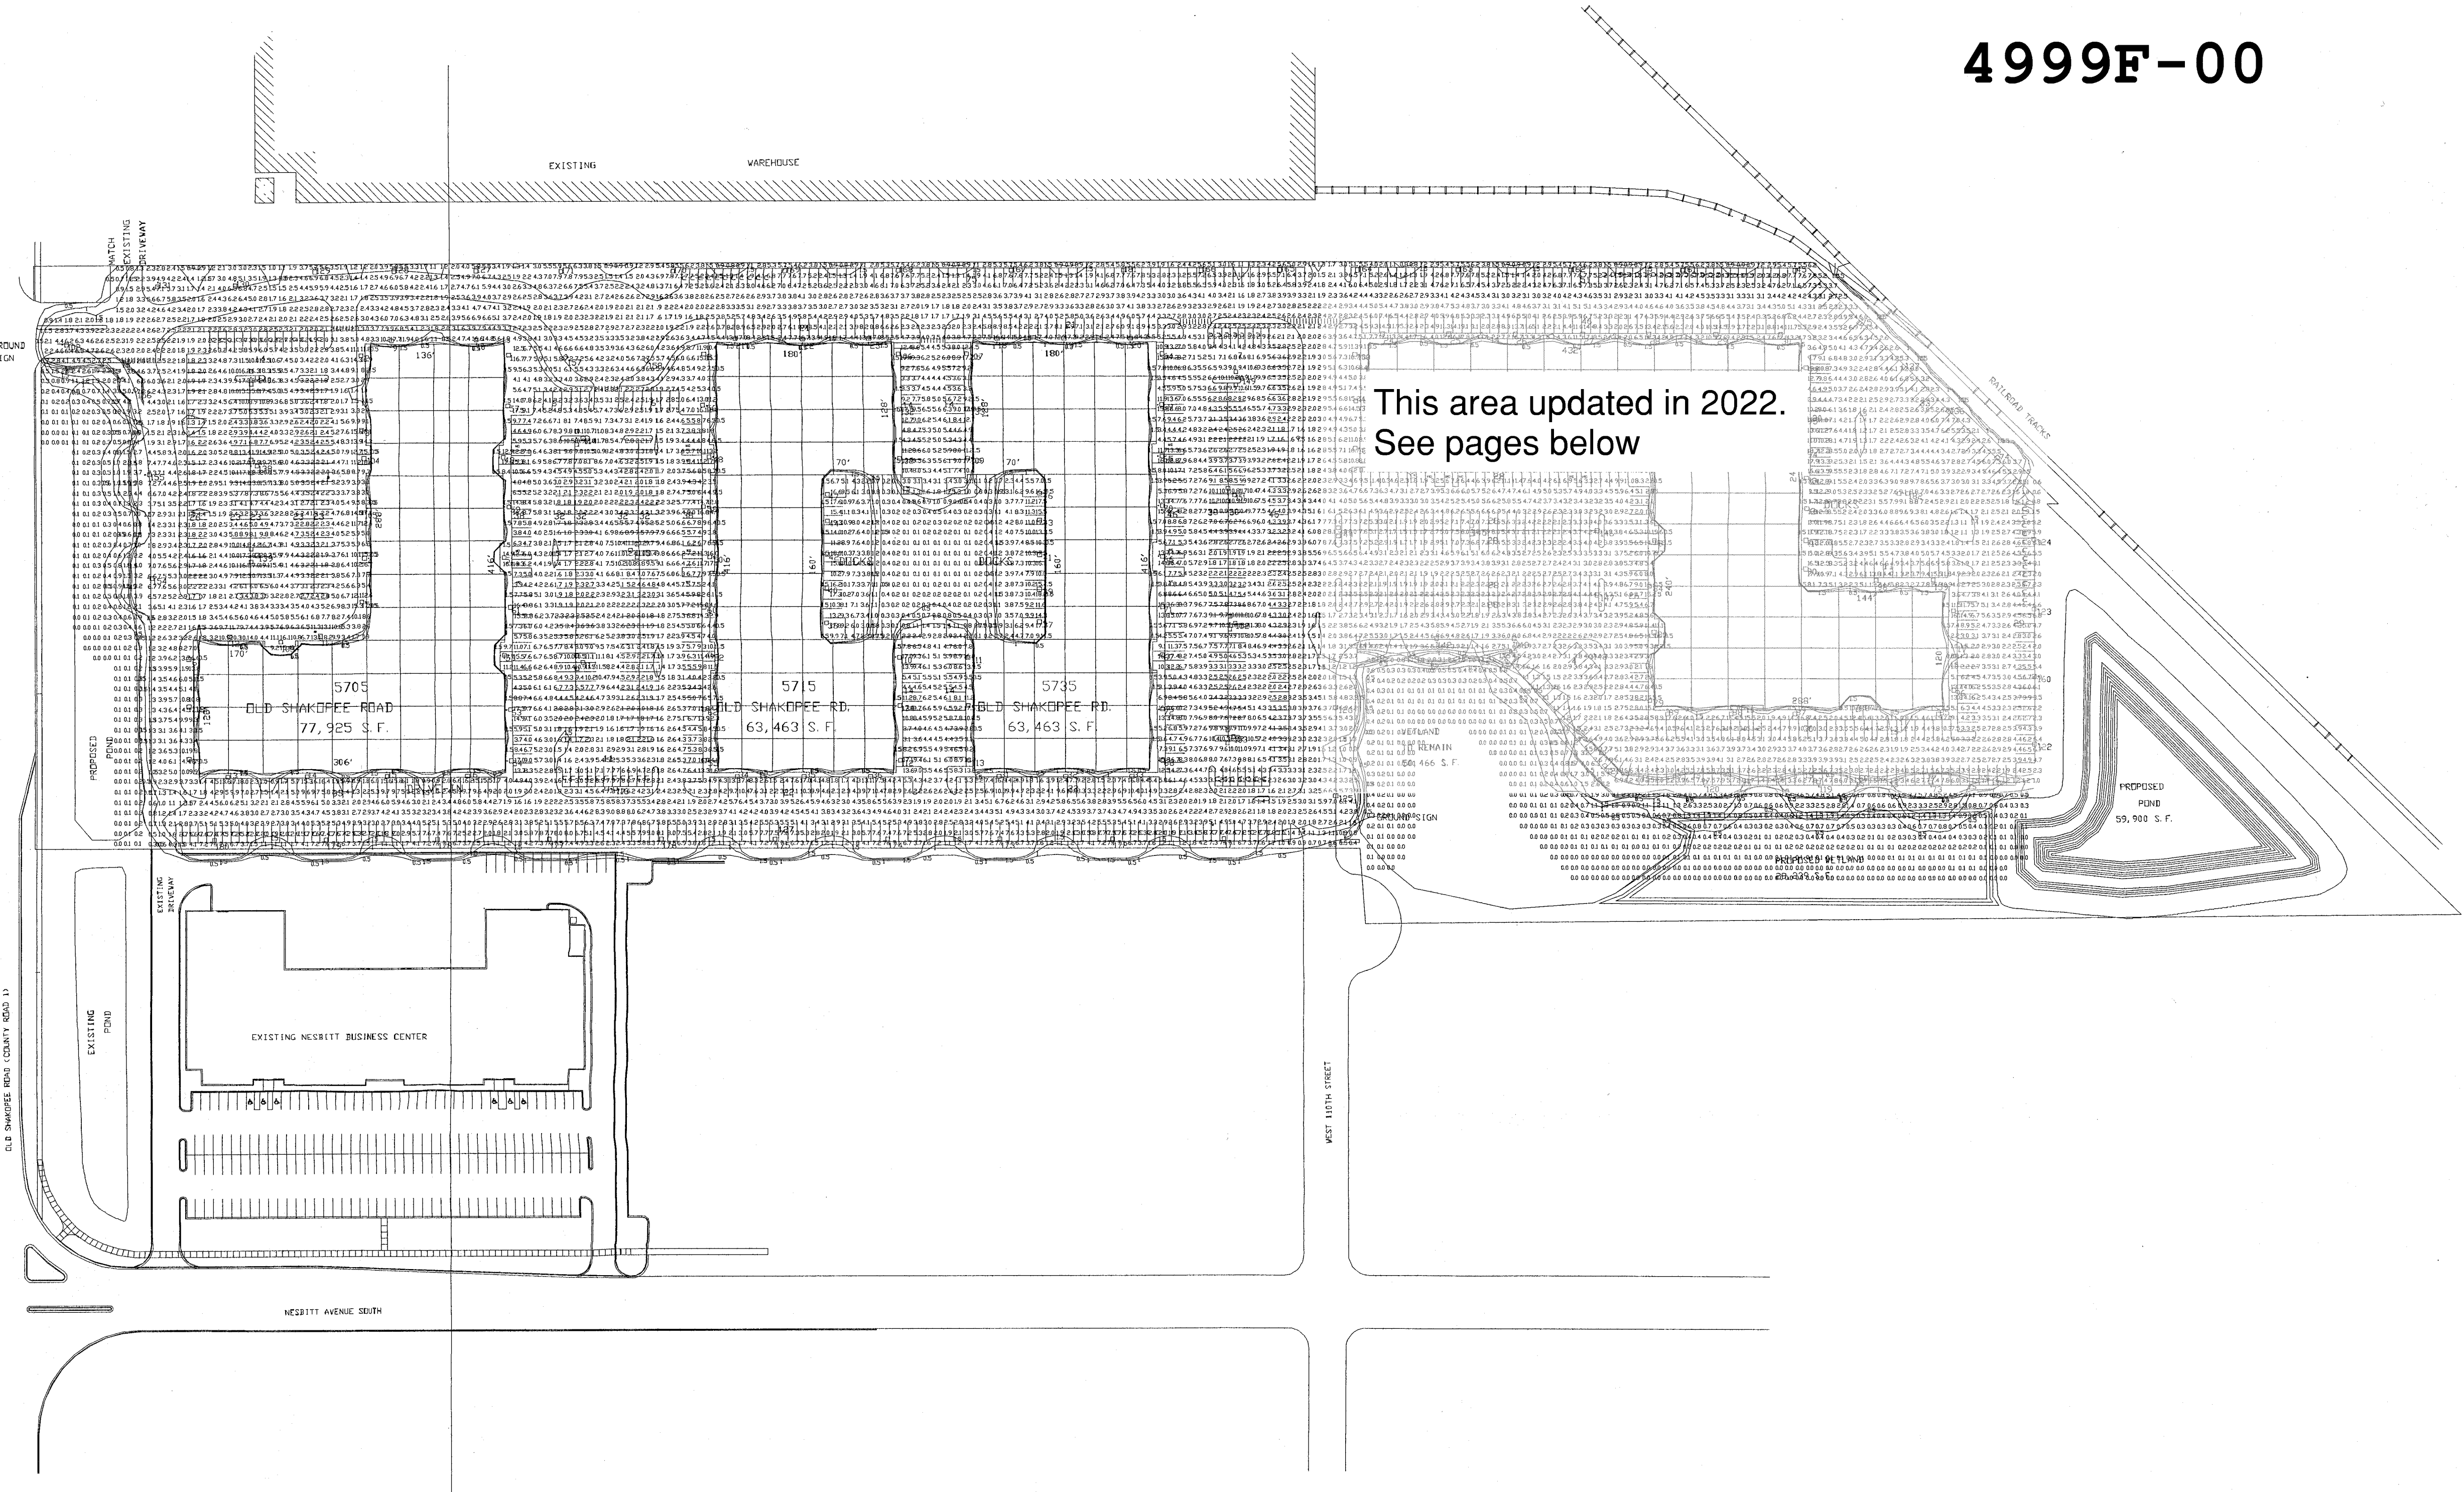

LUMINAIRE SCHEDULE						
Symbol	Label	Qty	Catalog Number	Description	Lamp	LF
A	30 KAD 400M RS	1	9204002.ES	DIS-CAST CUTOFF LUMINAIRE	400 WATT METAL HALIDE	4000 0.75
B	30 20 KAD 400M RS	1	9204002.ES	DIS-CAST CUTOFF LUMINAIRE	400 WATT METAL HALIDE	4000 0.75
C	06W KAD 400M RS	114	9110101.ES	DIS-CAST TYPE IV SHORT CUTOFF LUMINAIRE	400 WATT METAL HALIDE - HORIZONTAL BURN	4000 0.75
D	30 10 KAD 400M RS	7	9204002.ES	DIS-CAST CUTOFF LUMINAIRE	400 WATT METAL HALIDE	4000 0.75
E	22 KAD 400M RS	26	9204002.ES	DIS-CAST CUTOFF LUMINAIRE	400 WATT METAL HALIDE	4000 0.75
F	22 20 KAD 400M RS	1	9204002.ES	DIS-CAST CUTOFF LUMINAIRE	400 WATT METAL HALIDE	4000 0.75
G	22 10 KAD 400M RS	9	9204002.ES	DIS-CAST CUTOFF LUMINAIRE	400 WATT METAL HALIDE	4000 0.75
H	22 KAD 400M RS	25	9110101.ES	DIS-CAST TYPE IV SHORT CUTOFF LUMINAIRE	400 WATT METAL HALIDE - HORIZONTAL BURN	4000 0.75
I	06W KAD 400M RS	0	9204002.ES	DIS-CAST CUTOFF LUMINAIRE	400 WATT METAL HALIDE	4000 0.75
J	30 10 KAD 400M RS	3	9204002.ES	DIS-CAST CUTOFF LUMINAIRE	400 WATT METAL HALIDE	4000 0.75
K	30 KAD 400M RS	3	9110101.ES	DIS-CAST TYPE IV SHORT CUTOFF LUMINAIRE	400 WATT METAL HALIDE - HORIZONTAL BURN	4000 0.75

STATISTICS					
Description	Avg	Max	Min	Max/Min	Avg/Min
spacing	4.7%	20.6%	0.1%	209.01	47.21
wireless	0.5%	6.3%	0.0%	N/A	N/A
pond	0.7%	5.9%	0.0%	N/A	N/A

Plan View
Scale: 1"=60'-0"

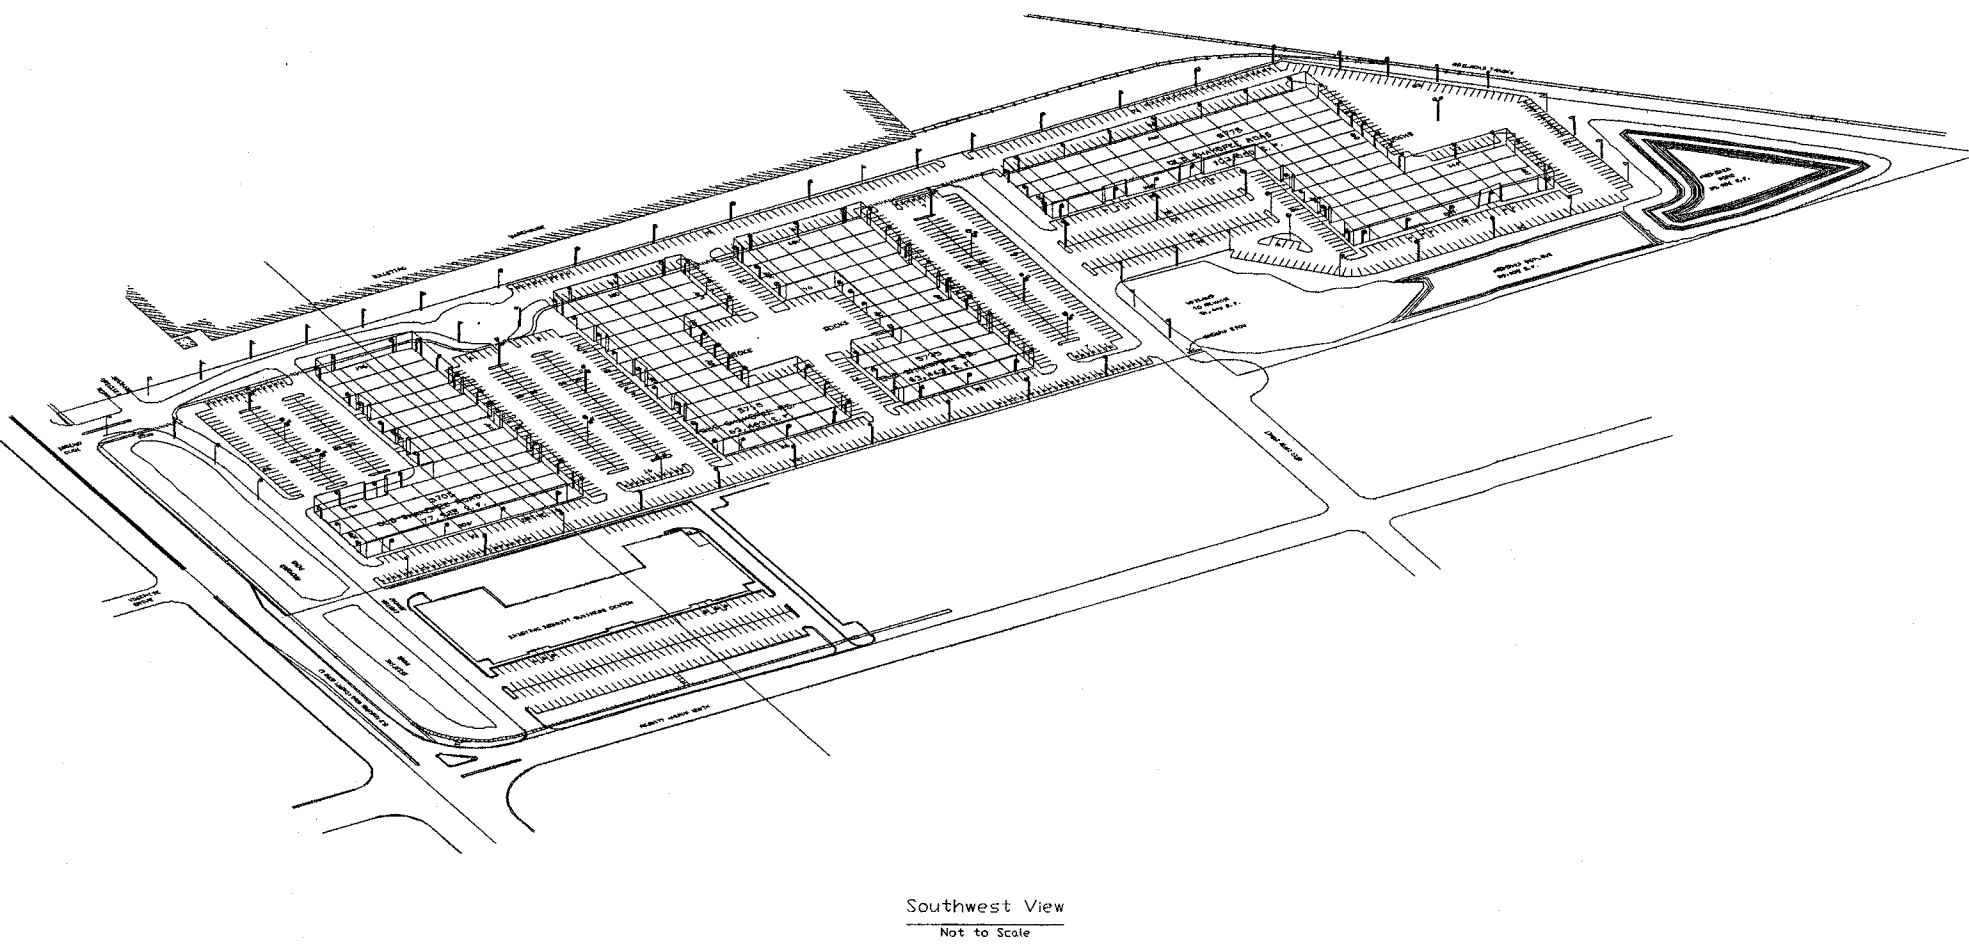

Southwest View
Not to Scale

WEST BLOOMINGTON TECH CENTER

Designer
McNAMARA
Date
Aug 7 2000
Scale
1"=60'-0"
Drawing No.
SPM080700

Approved
11-1-06
Paul B.
(Power)

RECEIVED
OCT 6 2006
City of Bloomington
Inspection Division

Symbol	Qty	Label	Arrangement	LMF	Lum. Lumens	Lum. Watts	Part Number	BUG Rating
□	2	OQ13	SINGLE	0.810	22100	132	OSQL-B-22L-40K7-3M-UL-NM-__ w/OSQ-ML-B-DA__	B3-U0-G3
□	6	OQ13-16L	SINGLE	0.810	16100	104	OSQL-B-16L-40K7-3M-UL-NM-__ w/OSQ-ML-B-DA__	B3-U0-G3
□	5	OQ13b-16L	SINGLE	0.810	12700	104	OSQL-B-16L-40K7-3M-UL-NM-__ w/OSQ-ML-B-DA__ - OSQ-BLSLF	B2-U0-G2
□	9	OQ14	SINGLE	0.810	22100	132	OSQL-B-22L-40K7-4M-UL-NM-__ w/OSQ-ML-B-DA__	B3-U0-G3
□	3	OQ14-16L	SINGLE	0.810	16100	104	OSQL-B-16L-40K7-4M-UL-NM-__ w/OSQ-ML-B-DA__	B3-U0-G3
□	9	OQ14b-16L	SINGLE	0.810	12350	104	OSQL-B-16L-40K7-4M-UL-NM-__ w/OSQ-ML-B-DA__ - OSQ-BLSLF	B2-U0-G2
□	3	OQ25Q	2 @ 180°	0.810	22900	132	OSQL-B-22L-40K7-5Q-UL-NM-__ w/OSQ-ML-B-DA__	B5-U0-G3
□	28	XP4	SINGLE	0.810	8475	72	XSPW-B-WM-4ME-8L-40K-UL-__	B1-U0-G2


LIGHTING PLAN
APPROVED
 No changes in fixture or location
 without a revised plan review.
 12/31/2021
 lpeace

Label	Units	Avg	Max	Min	Avg/Min	Max/Min
CalcPts	Fc	1.32	9.5	0.0	N.A.	N.A.
EAST PROPERTY LINE	Fc	0.92	2	0	N.A.	N.A.
10' From Entrances	Fc	7.20	7.8	6.9	1.04	1.13
PAVED AREA	Fc	2.90	9.5	1.2	2.42	7.92

Fixtures to be mounted on existing poles.

Additional Equipment:
 (40) OSQ-ML-B-DA__ (Direct Arm Mount)
 (14) OSQ-BLSLF (Backlight Shield)
 (9) WM-DM (Wall Mount Plate)

*** CUSTOMER TO VERIFY ORDERING INFORMATION AND CATALOGUE NUMBER PRIOR TO PLACING ORDER ***

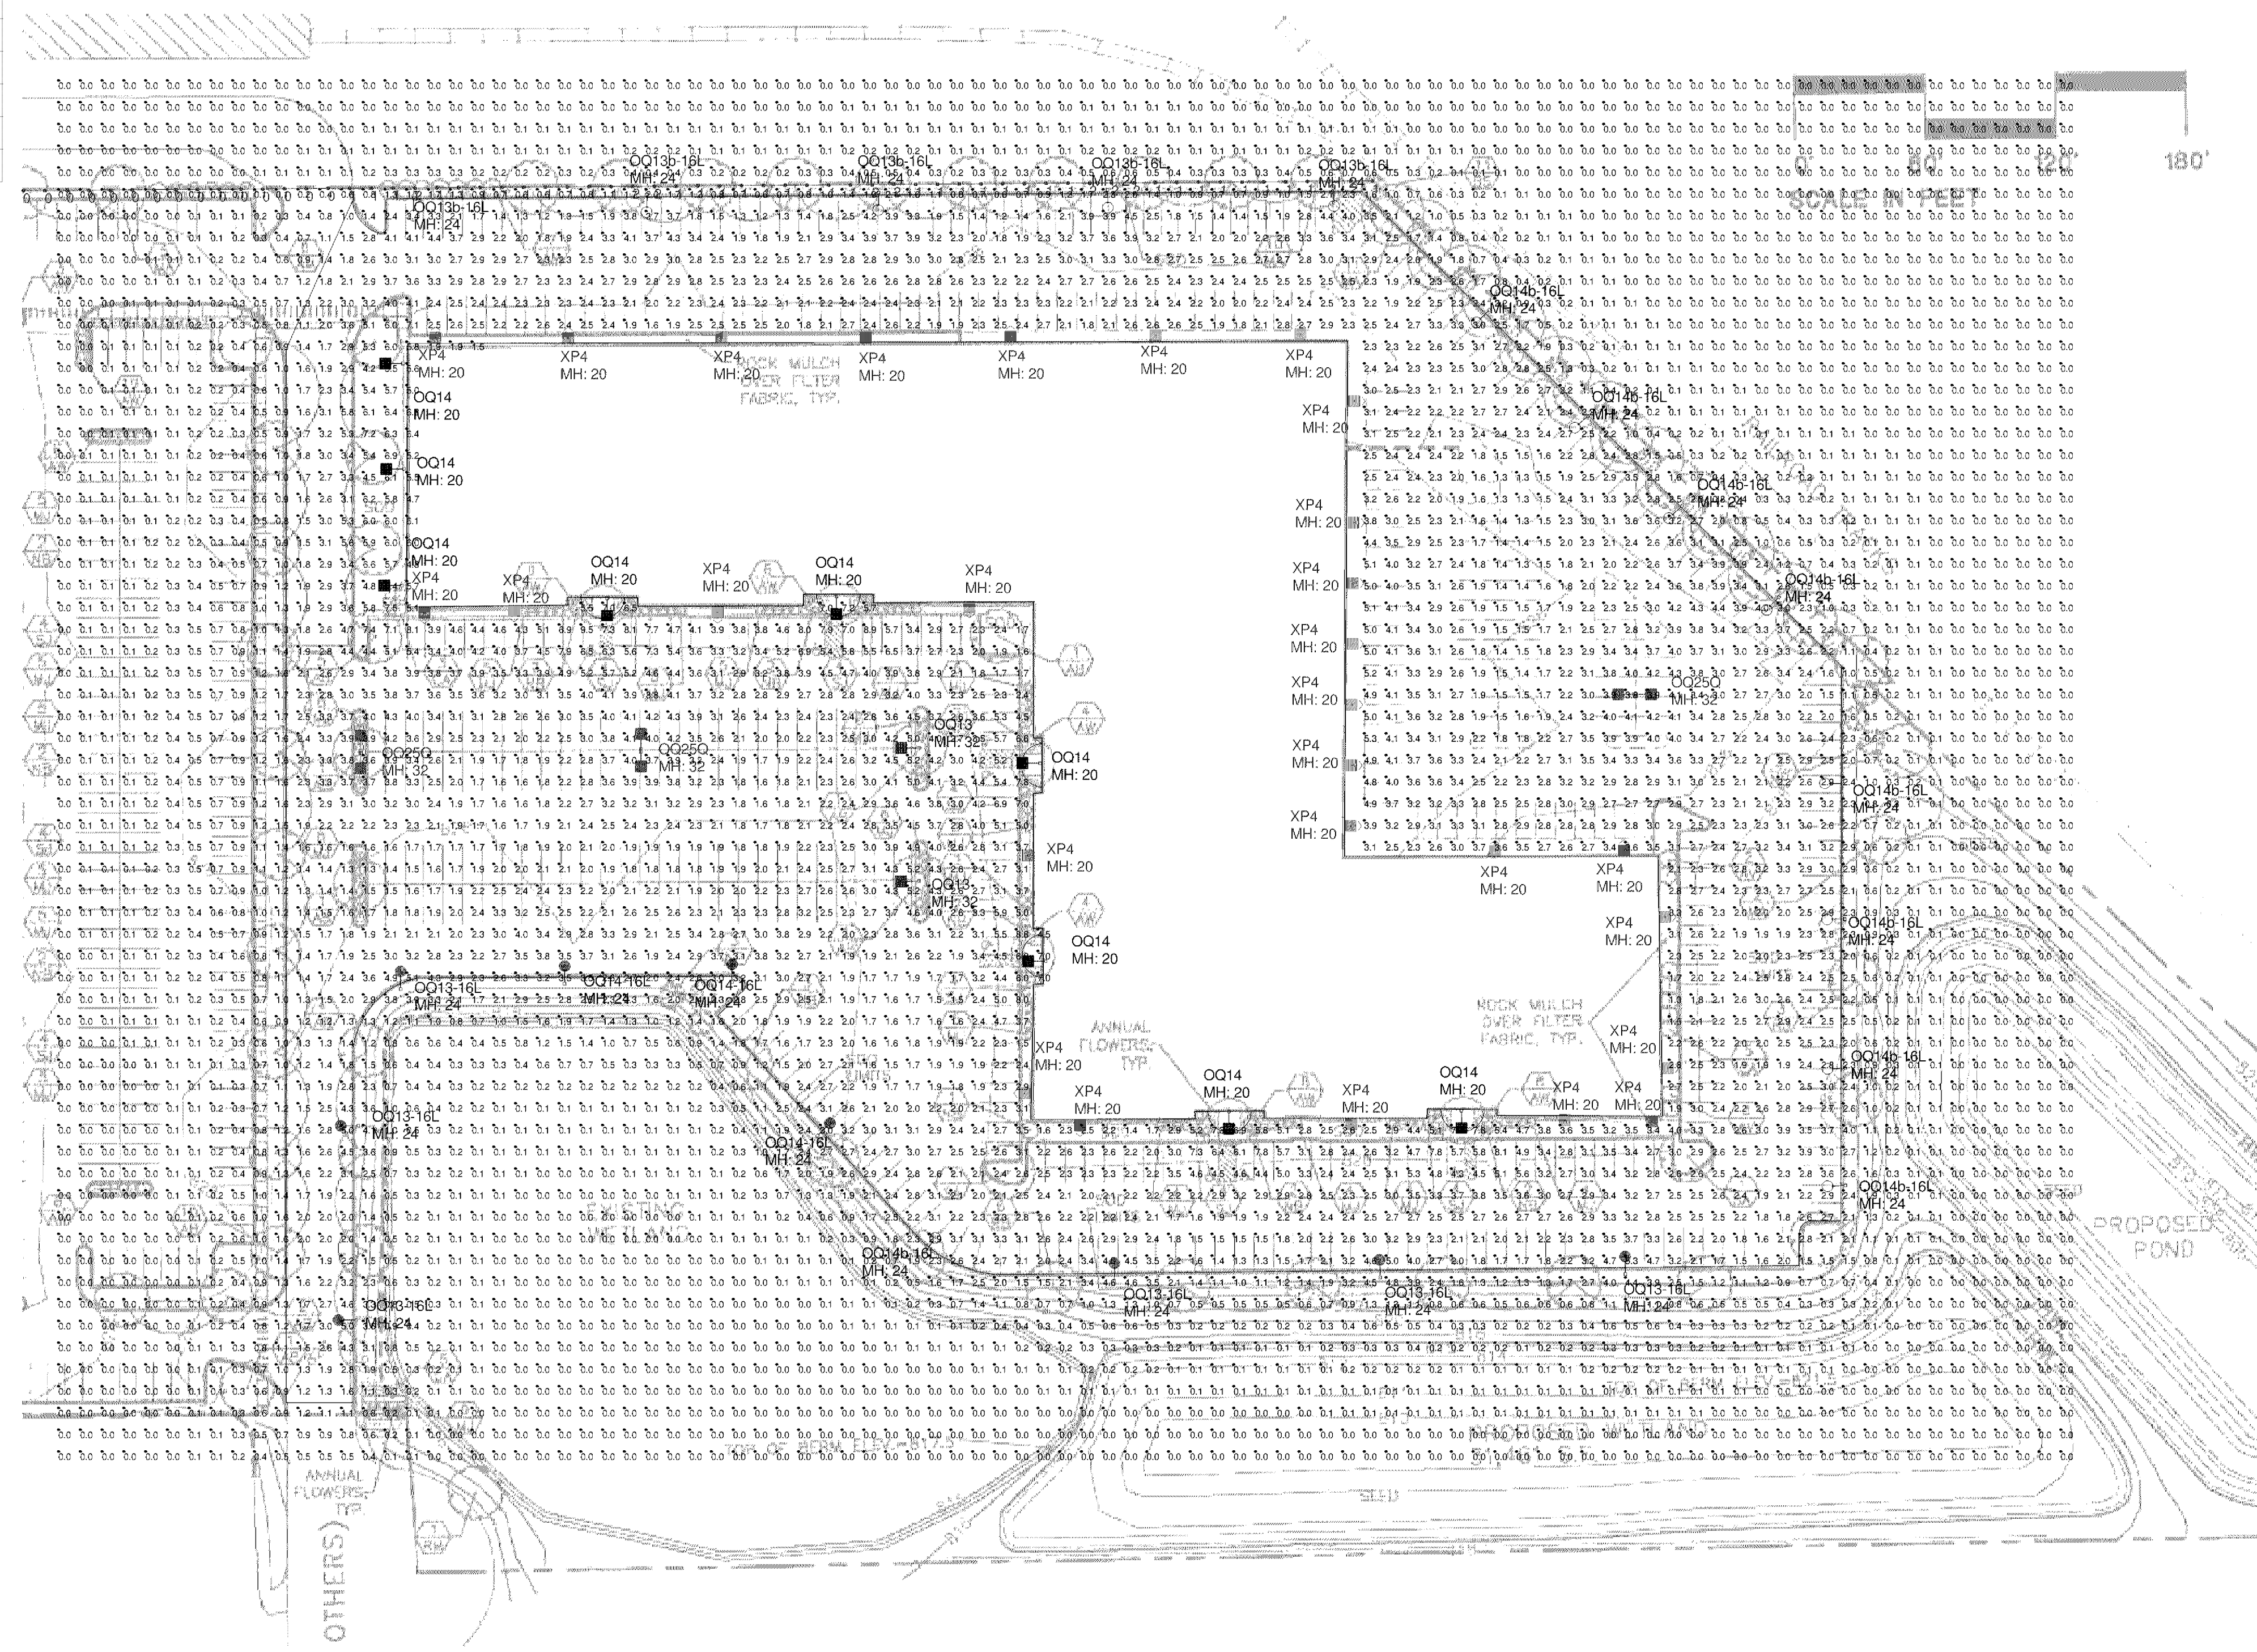

CREE LIGHTING
 A COMPANY OF IDEAL INDUSTRIES, INC.
 5201 Washington Ave, Racine, WI 53406
 Duane Henderson, LC
 Manager and Lead Lighting Educator
 Racine Lighting Experience Center
 5201 Washington Avenue
 Racine, WI 53406
 dhenderson@creeled.com

CREE LIGHTING
 A COMPANY OF IDEAL INDUSTRIES, INC.
 5201 Washington Ave, Racine, WI 53406

Illumination results shown on this lighting design are based on project parameters provided to Cree Lighting used in conjunction with luminaire test procedures conducted under laboratory conditions. Actual project conditions differing from these design parameters may affect field results. The customer is responsible for verifying dimensional accuracy along with compliance with any applicable electrical, lighting, or energy code.

Project Name: West Bloomington 5575 Old Shakopee Rd West, Bloomington, MN
 SR-36585 || Footcandles calculated at grade || Filename: 210921DJ1CISR1.AGI

Layout By: Chris Schlitz
 Date: 10/1/2021


Scale 1" = 50'
 0 100 200
 Approved Plan

Symbol	Qty	Label	Arrangement	LMF	Lum. Lumens	Lum. Watts	Part Number	BUG Rating
□	2	OQ13	SINGLE	1.000	22100	132	OSQL-B-22L-40K7-3M-UL-NM- w/OSQ-ML-B-DA	B3-U0-G3
□	6	OQ13-16L	SINGLE	1.000	16100	104	OSQL-B-16L-40K7-3M-UL-NM- w/OSQ-ML-B-DA	B3-U0-G3
○	5	OQ13b-16L	SINGLE	1.000	12700	104	OSQL-B-16L-40K7-3M-UL-NM- w/OSQ-ML-B-DA - OSQ-BLSLF	B2-U0-G2
□	9	OQ14	SINGLE	1.000	22100	132	OSQL-B-22L-40K7-4M-UL-NM- w/OSQ-ML-B-DA	B3-U0-G3
□	3	OQ14-16L	SINGLE	1.000	16100	104	OSQL-B-16L-40K7-4M-UL-NM- w/OSQ-ML-B-DA	B3-U0-G3
○	9	OQ14b-16L	SINGLE	1.000	12350	104	OSQL-B-16L-40K7-4M-UL-NM- w/OSQ-ML-B-DA - OSQ-BLSLF	B2-U0-G2
□	3	OQ25Q	2 @ 180°	1.000	22900	132	OSQL-B-22L-40K7-5Q-UL-NM- w/OSQ-ML-B-DA	B5-U0-G3
□	28	XP4	SINGLE	1.000	8475	72	XSPW-B-WM-4ME-8L-40K-UL-	B1-U0-G2

LIGHTING PLAN
APPROVED

No changes in fixture or location
without a revised plan review.

12/31/2021
lpease

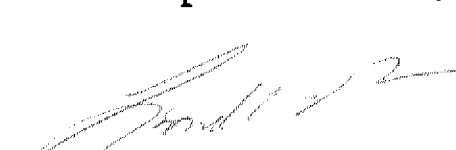


Label	Units	Avg	Max	Min	Avg/Min	Max/Min
CalcPts	Fc	1.63	11.8	0.0	N.A.	N.A.
EAST PROPERTY LINE	Fc	1.05	2	0	N.A.	N.A.
10' From Entrances	Fc	8.88	9.6	8.5	1.04	1.13
PAVED AREA	Fc	3.58	11.8	1.5	2.39	7.87

Fixtures to be mounted on existing poles.

Additional Equipment:
 (40) OSQ-ML-B-DA (Direct Arm Mount)
 (14) OSQ-BLSLF (Backlight Shield)
 (9) WM-DM (Wall Mount Plate)

*** CUSTOMER TO VERIFY ORDERING INFORMATION AND CATALOGUE NUMBER PRIOR TO PLACING ORDER ***

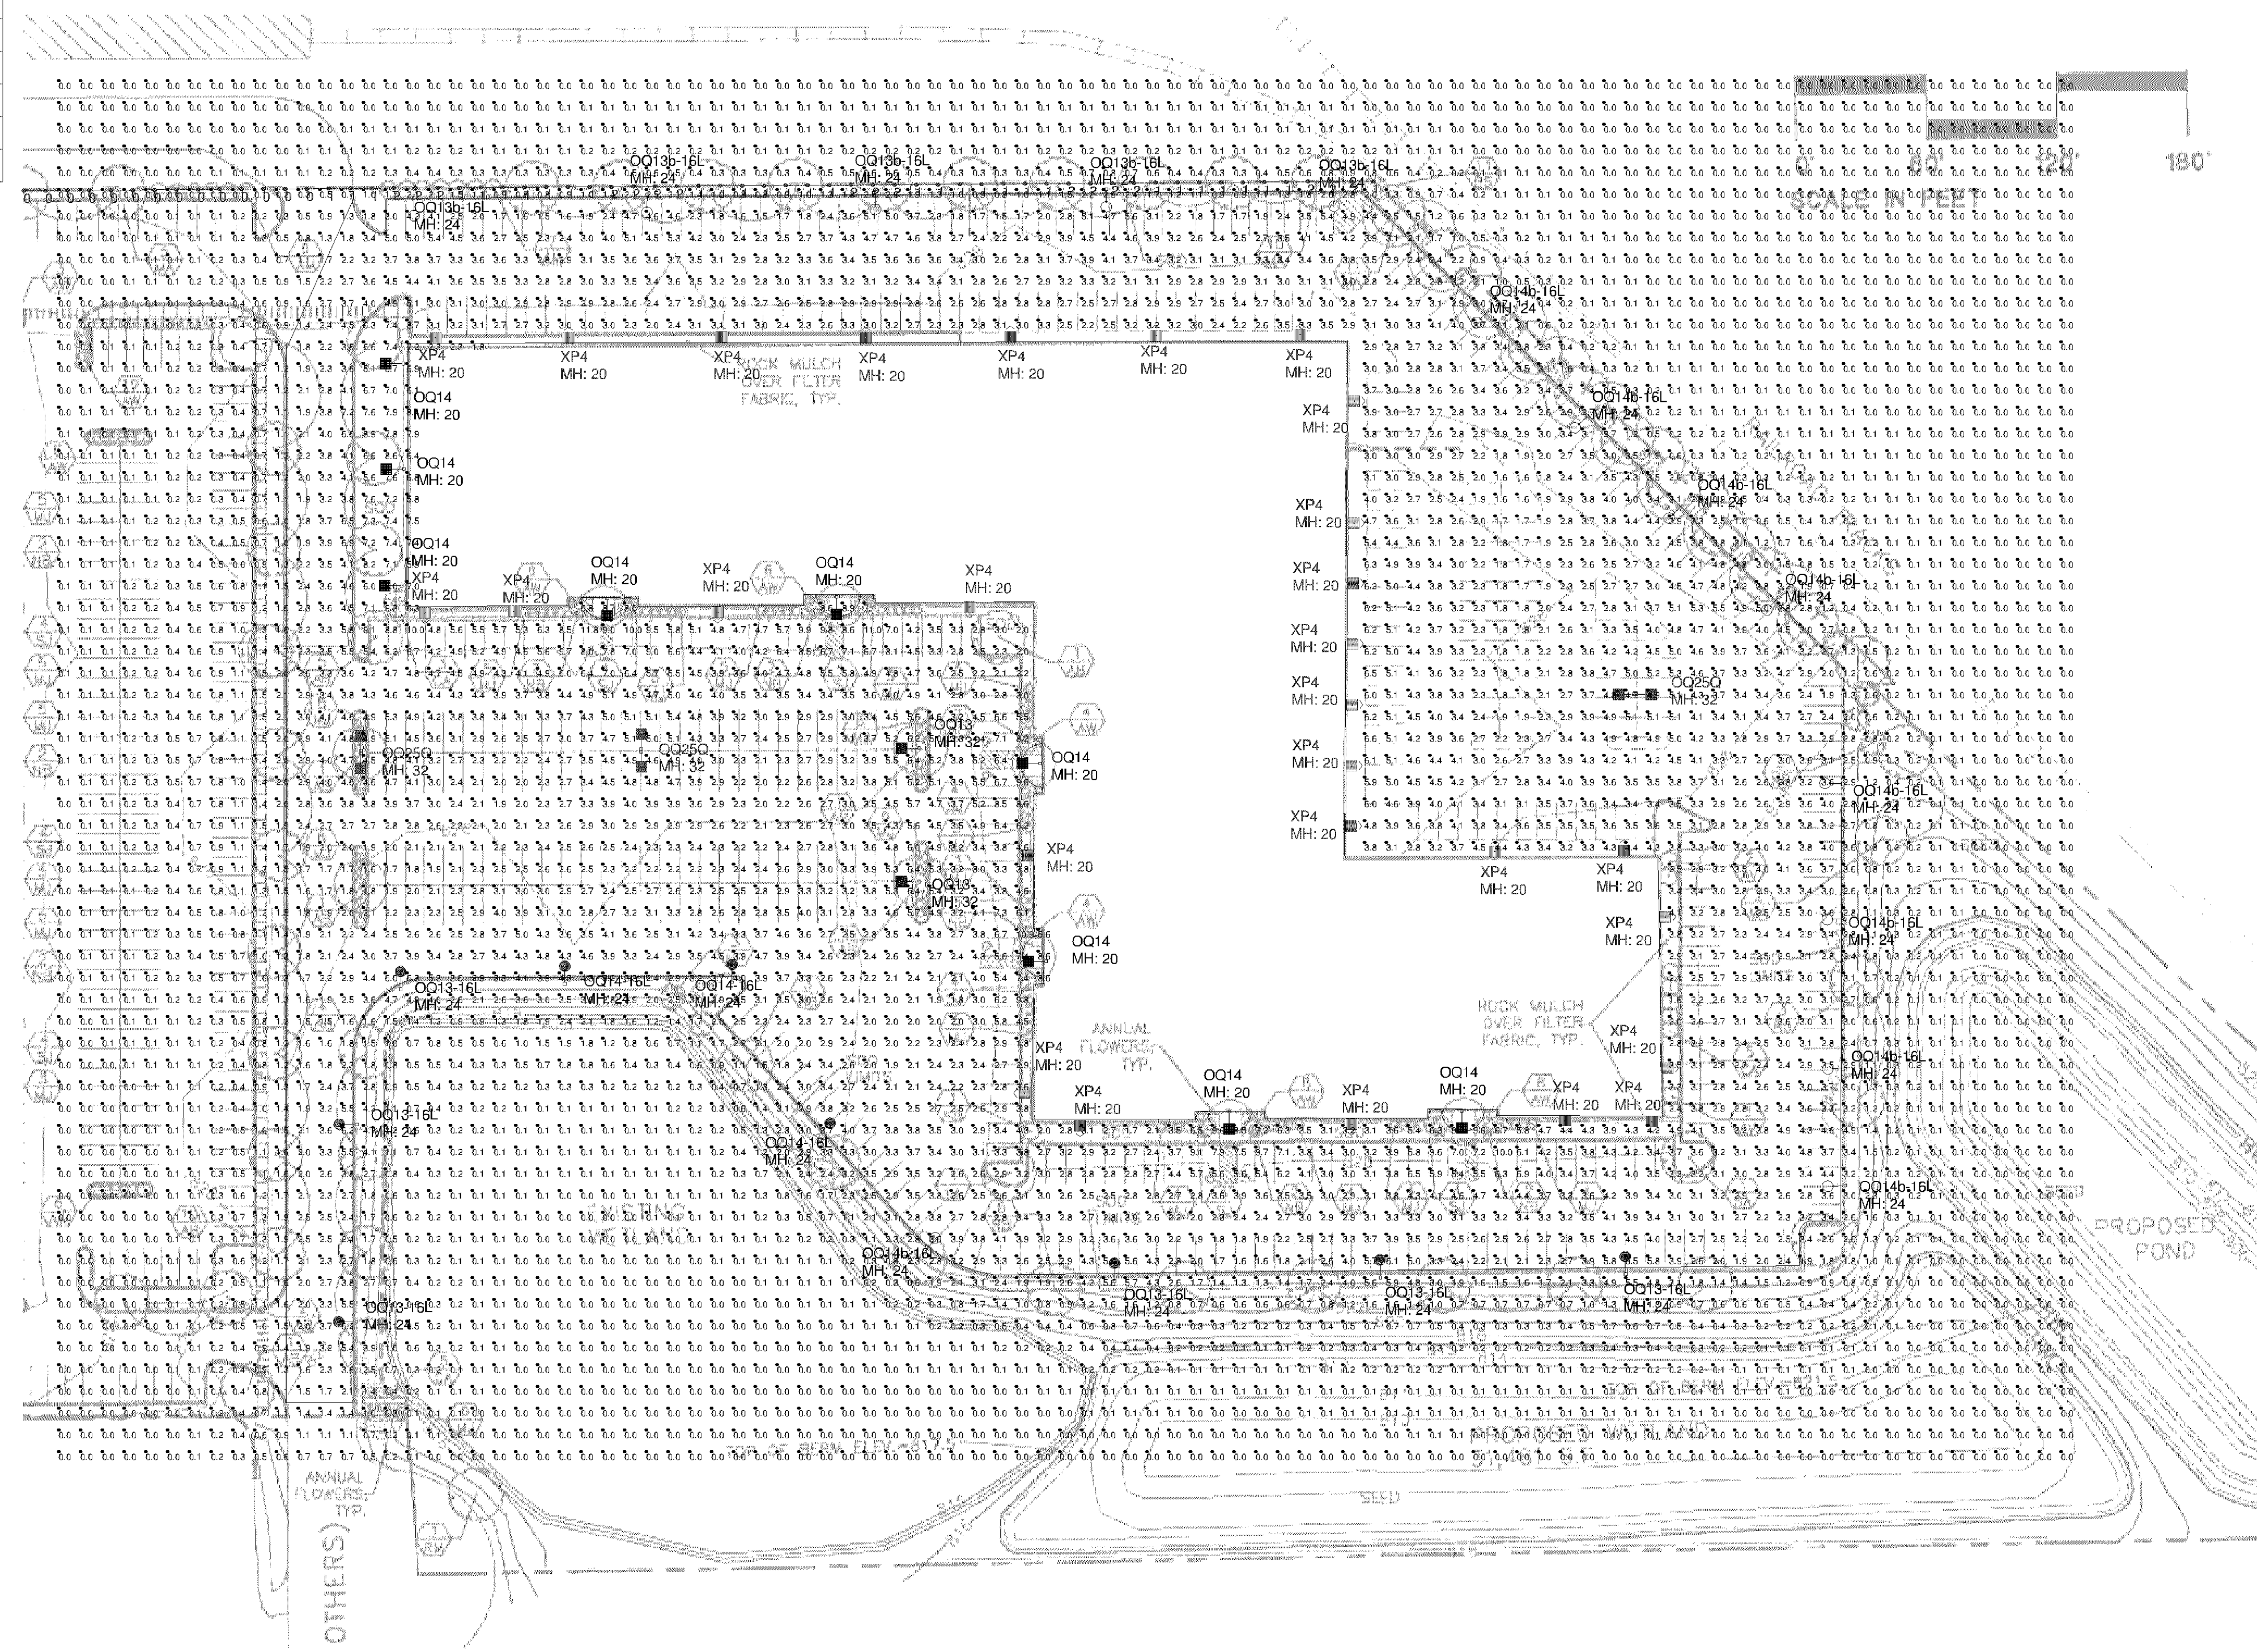

CREE LIGHTING
A COMPANY OF IDEAL INDUSTRIES, INC.
6001 Washington Ave. Racine, WI 53406 (800) 236-6800

Chris Anderson
Chris Anderson, P.E.
Manager and Lead Lighting Educator
Racine Lighting Experience Center

6221 Washington Avenue
Racine, WI 53406
chanderson@creeighting.com Office +1 262 784 2211


CREE LIGHTING
A COMPANY OF IDEAL INDUSTRIES, INC.
9201 Washington Ave, Racine, WI 53406 https://creeighting.com (800) 236-6800

Illumination results shown on this lighting design are based on project parameters provided to Cree Lighting used in conjunction with Luminaire test procedures conducted under laboratory conditions. Actual project conditions differing from these design parameters may affect field results. The customer is responsible for verifying dimensional accuracy along with compliance with any applicable electrical, lighting, or energy code.


Project Name: West Bloomington 5575 Old Shakopee Rd West, Bloomington, MN
 SR-36585 || Footcandles calculated at grade || Filename: 210921DJ1CISR2.AGI

Layout By: Chris Schlitz
Date: 10/1/2021

Scale 1" = 50'



Approved Plan

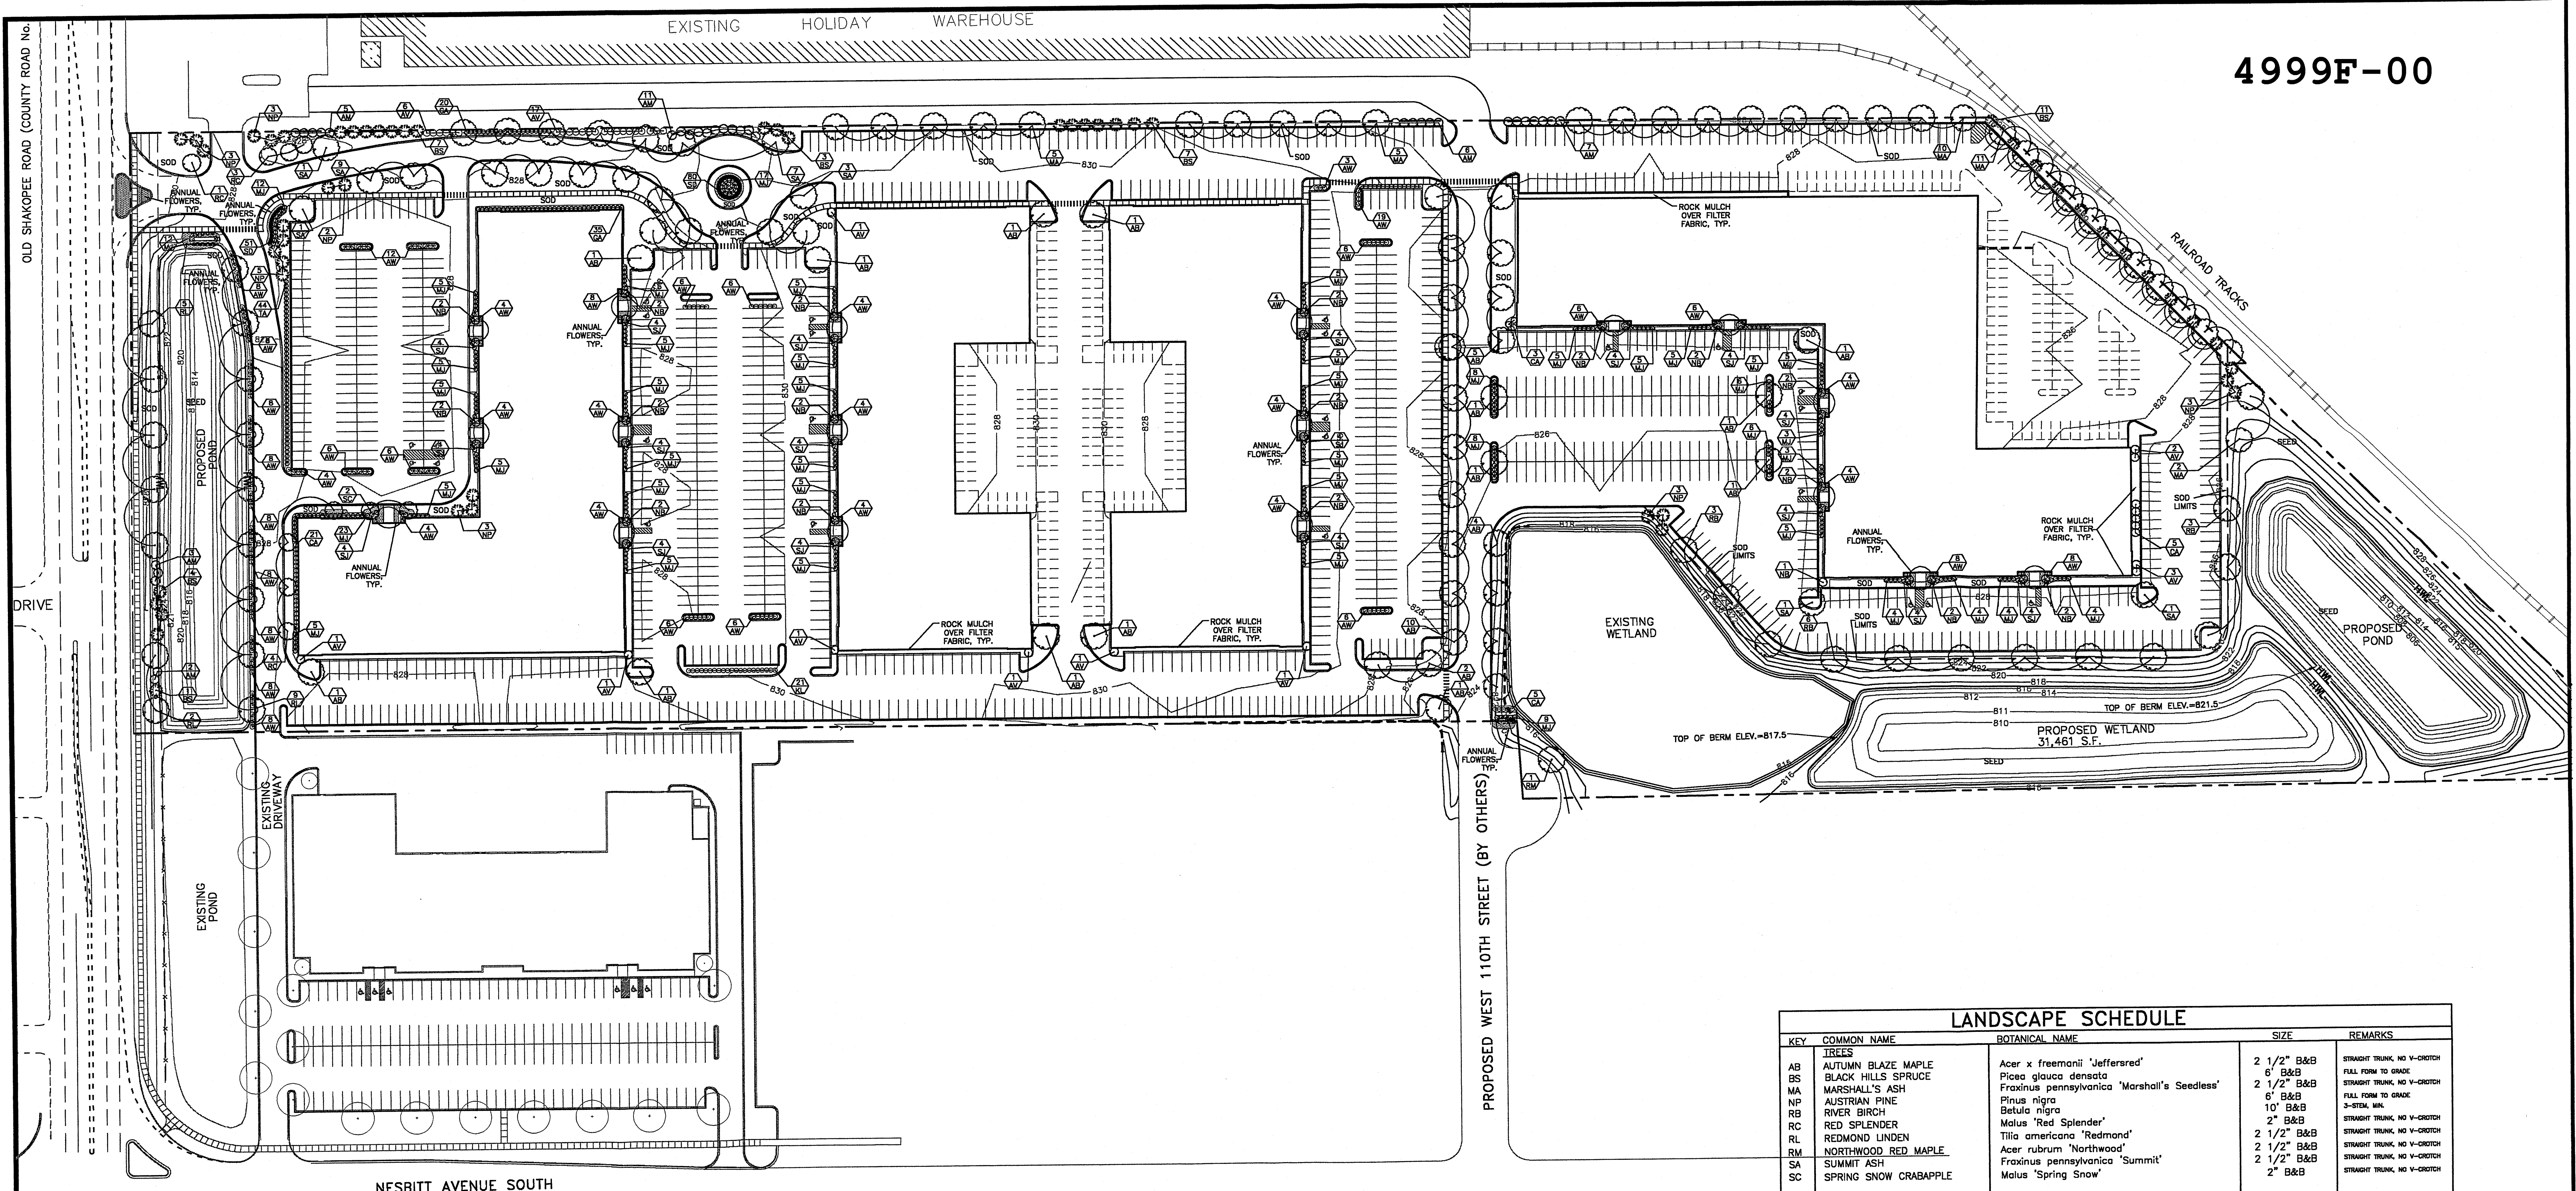

PLANTING NOTES:

LANDSCAPE CONTRACTOR SHALL VISIT SITE PRIOR TO SUBMITTING BID TO BECOME COMPLETELY FAMILIAR WITH SITE CONDITIONS.

INSTALL 4" MIN. BLACK DIRT TO ALL SOD AND SHRUB AREAS. CONTRACTOR RESPONSIBLE FOR FINE GRADING OF SOD AREAS.

CONTRACTOR WILL STAKE OR MARK ALL PLANT MATERIAL LOCATIONS PRIOR TO INSTALLATION. CONTRACTOR SHALL HAVE OWNERS REPRESENTATIVE APPROVE ALL STAKING PRIOR TO INSTALLATION.

ALL SHRUB AREAS TO BE BED MULCHED WITH 3" DEPTH OF 1 1/2" BUFF COLOR ROCK OVER WEED BARRIER. VERIFY ROCK COLOR WITH OWNER PRIOR TO INSTALLATION. POLY-EDGER TO BE VALLEY VIEW BLACK DIAMOND OR APPROVED EQUAL.

INSTALL 18" BUFF ROCK MULCH AND EDGER IN NON SHRUB AREAS AROUND BUILDING FOUNDATIONS. INSTALL SOD FROM EDGER TO BACK OF CURB UNLESS OTHERWISE NOTED.

INSTALL 3" BUFF ROCK MULCH OVER WEED BARRIER TO PARKING LOT ISLANDS.

INSTALL 3" DEPTH DOUBLE GROUND OAK MULCH AROUND ALL TREES ISOLATED FROM PLANT BEDS.

PLANTING SOIL SHALL CONSIST OF 50% SELECT LOAMY TOPSOIL, 25% PEAT MOSS, 25% PIT RUN SAND.

CONTRACTOR WILL COMPLETELY GUARANTEE ALL WORK FOR A PERIOD OF ONE YEAR BEGINNING AT THE DATE OF ACCEPTANCE. CONTRACTOR WILL MAKE ALL REPLACEMENTS PROMPTLY (AS PER DIRECTION OF OWNER).

ANY MATERIAL WHICH DIES, OR DEFOLIATES (PRIOR TO ACCEPTANCE OF THE WORK) WILL BE PROMPTLY REMOVED AND REPLACED.

ALL MATERIAL SHALL COMPLY WITH THE LATEST EDITION OF THE AMERICAN STANDARDS FOR NURSERY STOCK, AMERICAN ASSOCIATION OF NURSERYMEN.

THE OWNERS REPRESENTATIVE RESERVES THE RIGHT TO REJECT ANY PLANT MATERIAL NOT MEETING SPECIFICATIONS.

ALL TREE TRUNKS SHALL BE WRAPPED WITH BROWN CREPE TREE WRAP. APPLY WRAP IN NOVEMBER AND REMOVE IN APRIL.

LANDSCAPE CONTRACTOR TO WATER AND MAINTAIN ALL PLANT MATERIALS AND SOD UNTIL INITIAL ACCEPTANCE.

REPAIR AT NO COST TO OWNER ALL DAMAGE TO PROPERTY RESULTING FROM LANDSCAPE WORK.

CONTRACTOR IS RESPONSIBLE FOR CALLING GOPHER STATE ONE AT 851-454-0002 AND FOR LOCATING ALL UNDERGROUND UTILITIES AND SHALL AVOID DAMAGE TO UTILITIES DURING THE COURSE OF THE WORK. CONTRACTOR IS RESPONSIBLE FOR REPAIRING ANY DAMAGE TO UTILITIES, SITE STRUCTURES, ETC., RESULTING FROM LANDSCAPE CONSTRUCTION.

LANDSCAPE CONTRACTOR IS TO BE RESPONSIBLE FOR WATERING ALL PLANT MATERIALS UNTIL THE TIME THE PERMANENT IRRIGATION SYSTEM IS FULLY FUNCTIONAL.

CHEMICAL WEED CONTROL MUST BE APPLIED TO ALL LANDSCAPE AREAS PRIOR TO ANY PLANT INSTALLATION.

LANDSCAPE CONTRACTORS TO COORDINATE INSTALLATION WITH GENERAL CONTRACTOR.

STAKING AND GUYING OF TREES OPTIONAL: LANDSCAPE CONTRACTOR SHALL MAINTAIN PLUMBNESS OF TREES FOR DURATION OF WARRANTY PERIOD.

INSTALL SOD FROM BACK OF CURB ON OLD SHAKOPEE ROAD.

SWEEP AND WASH ALL PAVED SURFACES AND REMOVE ALL DEBRIS RESULTING FROM LANDSCAPE OPERATIONS.



CONTRACTOR TO SUPPLY DESIGN AND INSTALLATION OF AN IRRIGATION PLAN. USE RAINBIRD OR APPROVED EQUAL. SUBMIT PLAN TO PROPERTY OWNER FOR APPROVAL PRIOR TO INSTALLATION.

NOTE:


ALL PLANT MATERIAL TO BE PURCHASED FROM BACHMAN'S

SEED PLANTING NOTES:

GENERAL CONTRACTOR TO SEED AREAS SHOWN AT THE FOLLOWING RATES: M/DOOT # 40A SEED MIXTURE DESIGNATIONS - 15 LBS PER ACRE. RE-SEED AFTER 60 DAYS ALL AREAS NOT MORE THAN 75% GERMINATION. INSTALL EROSION CONTROL BLANKET ON ALL SLOPES 3:1 OR GREATER.

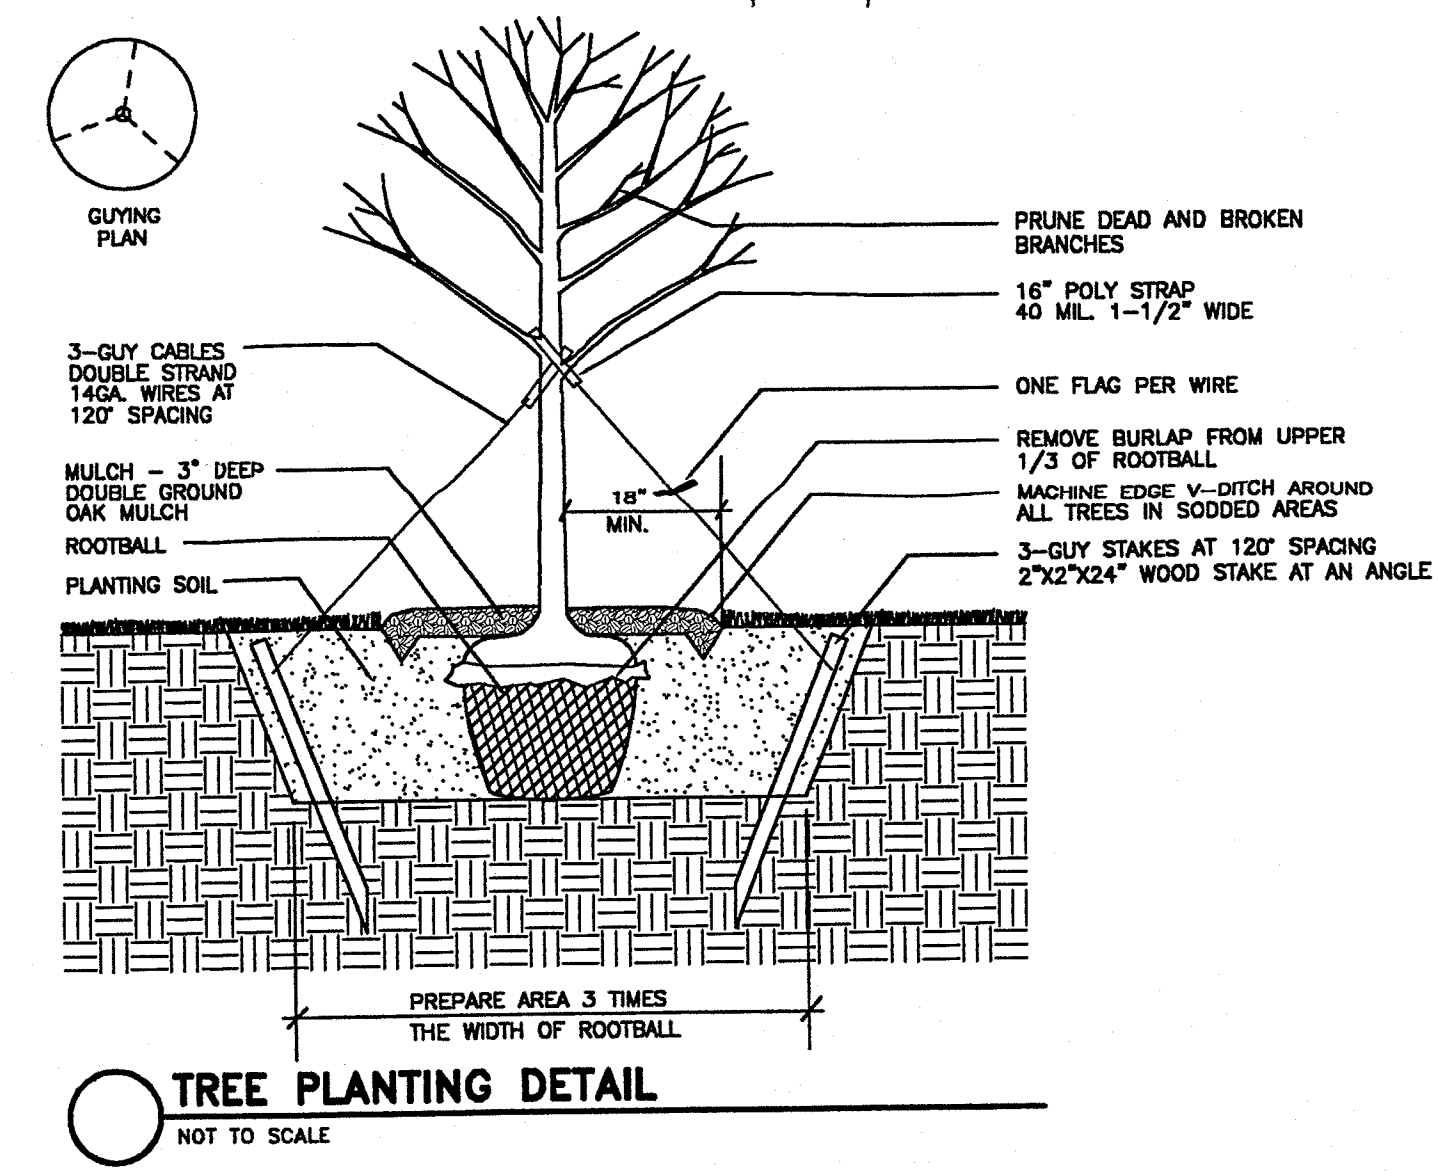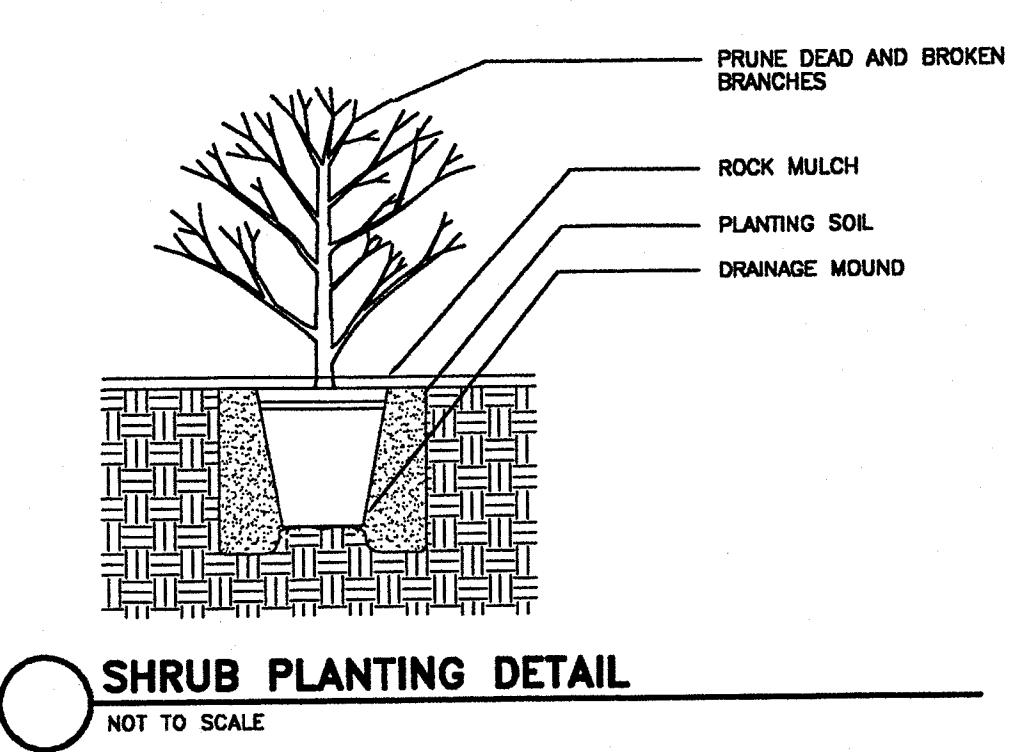

LANDSCAPE SCHEDULE				
KEY	COMMON NAME	BOTANICAL NAME	SIZE	REMARKS
TREES				
AB	AUTUMN BLAZE MAPLE	Acer x freemanii 'Jeffersred'	2 1/2" B&B	STRAIGHT TRUNK, NO V-CROTCH
BS	BLACK HILLS SPRUCE	Picea glauca densata	6" B&B	FULL FORM TO GRADE
MA	MARSHALL'S ASH	Fraxinus pennsylvanica 'Marshall's Seedless'	2 1/2" B&B	STRAIGHT TRUNK, NO V-CROTCH
NP	AUSTRIAN PINE	Pinus nigra	6" B&B	FULL FORM TO GRADE
RB	RIVER BIRCH	Betula nigra	10" B&B	3-STEM, MIN.
RC	RED SPLENDER	Morus 'Red Splendor'	2" B&B	STRAIGHT TRUNK, NO V-CROTCH
RL	REDMOND LINDEN	Tilia americana 'Redmond'	2 1/2" B&B	STRAIGHT TRUNK, NO V-CROTCH
RM	NORTHWOOD RED MAPLE	Acer rubrum 'Northwood'	2 1/2" B&B	STRAIGHT TRUNK, NO V-CROTCH
SA	SUMMIT ASH	Fraxinus pennsylvanica 'Summit'	2 1/2" B&B	STRAIGHT TRUNK, NO V-CROTCH
SC	SPRING SNOW CRABAPPLE	Morus 'Spring Snow'	2" B&B	STRAIGHT TRUNK, NO V-CROTCH
SHRUBS				
AM	AMUR MAPLE	Acer ginnala	4" B&B	MIN. 5 CANES
AV	ARROWWOOD VIBURNUM	Viburnum dentatum	3" HT., CONT.	MIN. 5 CANES
AW	ANTHONY WATERER SPIREA	Spiraea japonica 'Anthony Waterer'	15" HT., CONT.	MIN. 5 CANES
CA	COMPACT AMERICAN CRANBERRY	Viburnum trilobum 'Baily Compact'	18" HT., CONT.	MIN. 5 CANES
FS	FROBEL SPIREA	Spiraea bumalda 'Froebel'	18" HT., CONT.	MIN. 5 CANES
GA	GLOBE ARBORVITAE	Tuja occidentalis 'Techny Globe'	24" DIA., B&B	FULL FORM TO GRADE
KL	DWARF KOREAN LILAC	Syringa meyeri 'Paladin'	18" HT., CONT.	MIN. 5 CANES
MJ	MINT JULEP JUNIPER	Spiraea chinensis 'Mint Julep'	18" DIA., CONT.	MIN. 5 CANES
NB	NANNYBERRY	Viburnum lentago	4" HT., B&B	MIN. 5 CANES
SJ	SCANDIA JUNIPER	Juniperus sabinia 'Scandia'	24" DIA., CONT.	MIN. 5 CANES
TA	TECHNY GLOBE ARBORVITAE	Tuja occidentalis 'Techny Globe'	30" HT., B&B	FULL FORM TO GRADE
PERENNIALS				
SD	STELLA DE ORO DAYLILY	Hemerocallis 'Stella de Oro'	1 GAL. CONT.	

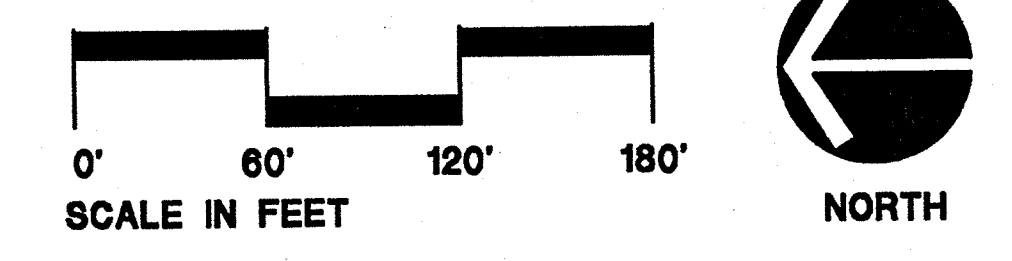

ALLIANT ENGINEERING
INCORPORATED
212 SECOND STREET SE.
ST. ANTHONY MAIN
SUITE 300
MINNEAPOLIS, MN 55414
(612)362-0432
(612)876-2787 FAX

I hereby certify that this plan, specification or report was prepared by me or under my direct supervision and that I am a duly registered Landscape Architect under the laws of the State of MINNESOTA


Michael J. Hill
Signature
26222 9-18-00
Date Registration Number

WEST BLOOMINGTON TECHNOLOGY PARK
5705 - 5775 OLD SHAKOPEE ROAD
BLOOMINGTON, MN

LANDSCAPE PLAN

REVISIONS SITE PLAN REVISION 8.8.00 SITE PLAN REVISION 8.15.00 CITY COMMENTS 8.23.00 SITE PLAN REVISION 8.31.00 SITE PLAN REVISION 9.8.00	DRAWN BY: MK CHECKED BY: MA DATE ISSUED: 8-11-00 SCALE: 1"=60' JOB NO.: 0000B SHEET: OF
--	--

5705 WORK
Approved Plan

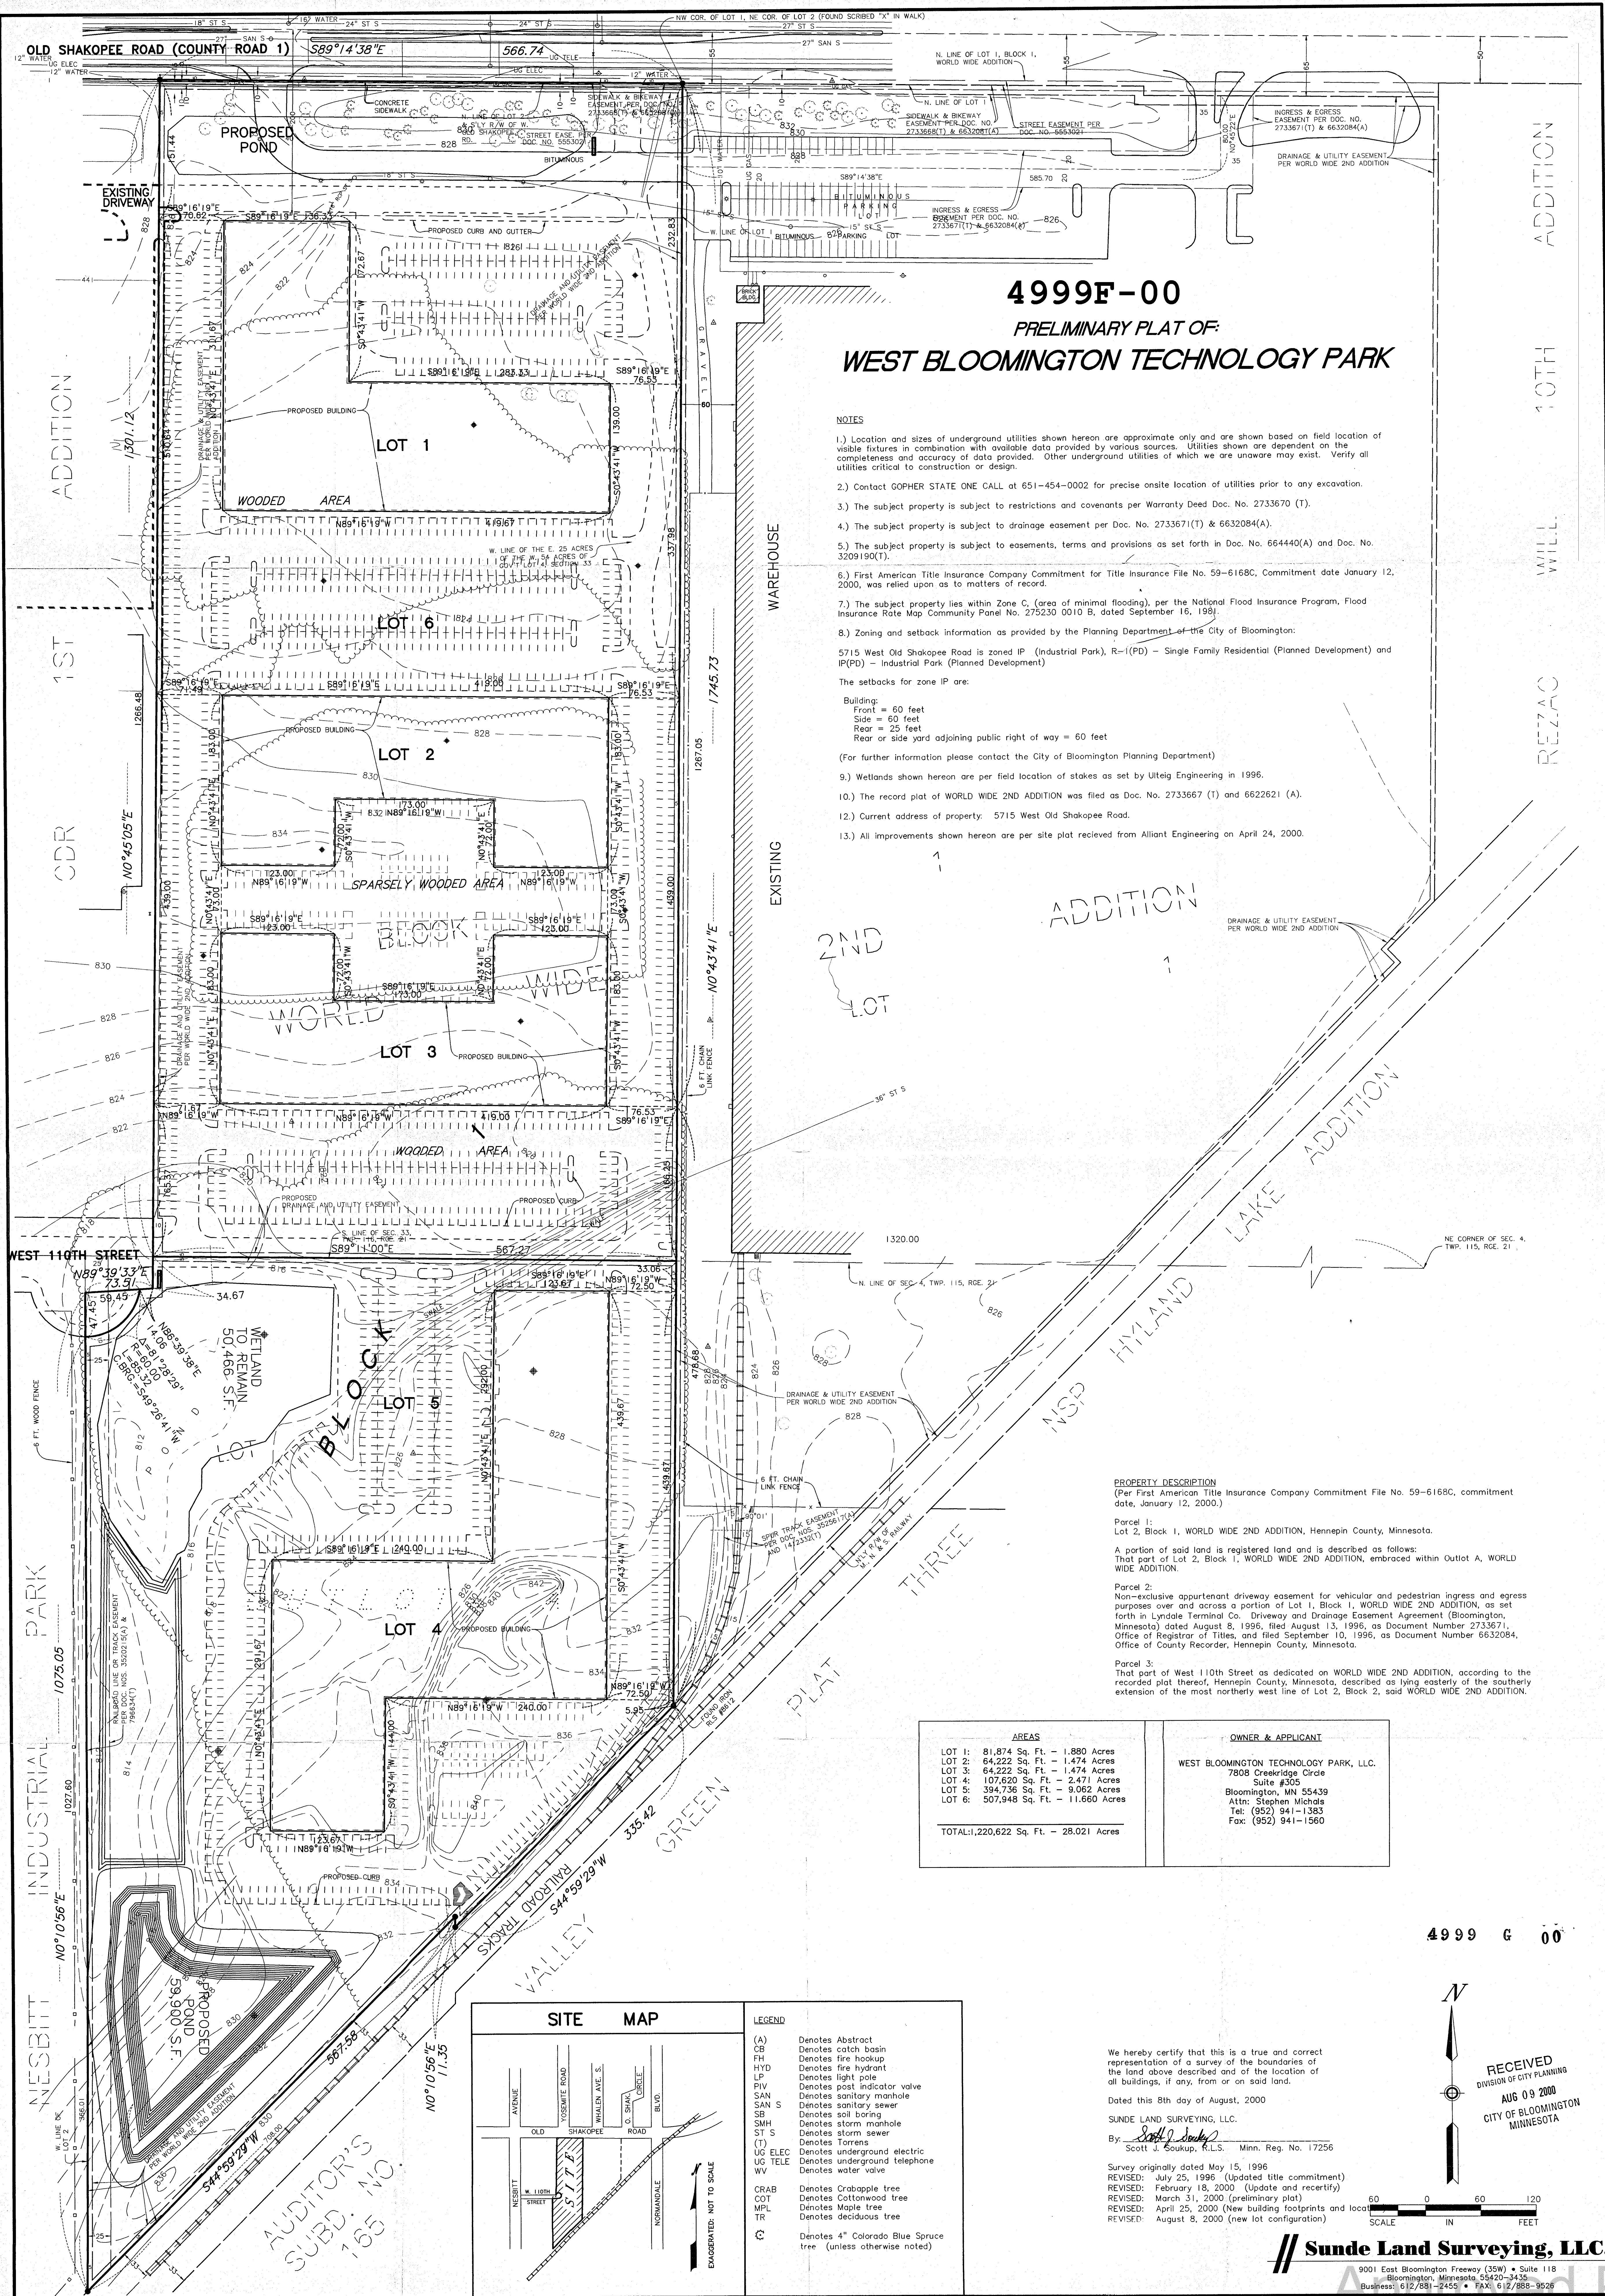

4999F-00
PRELIMINARY PLAT OF:
WEST BLOOMINGTON TECHNOLOGY PARK

- NOTES**
- 1.) Location and sizes of underground utilities shown hereon are approximate only and are shown based on field location of visible fixtures in combination with available data provided by various sources. Utilities shown are dependent on the completeness and accuracy of data provided. Other underground utilities of which we are unaware may exist. Verify all utilities critical to construction or design.
 - 2.) Contact GOPHER STATE ONE CALL at 651-454-0002 for precise onsite location of utilities prior to any excavation.
 - 3.) The subject property is subject to restrictions and covenants per Warranty Deed Doc. No. 2733670 (T).
 - 4.) The subject property is subject to drainage easement per Doc. No. 2733671(T) & 6632084(A).
 - 5.) The subject property is subject to easements, terms and provisions as set forth in Doc. No. 664440(A) and Doc. No. 3209190(T).
 - 6.) First American Title Insurance Company Commitment for Title Insurance File No. 59-6168C, Commitment date January 12, 2000, was relied upon as to matters of record.
 - 7.) The subject property lies within Zone C, (area of minimal flooding), per the National Flood Insurance Program, Flood Insurance Rate Map Community Panel No. 275230 0010 B, dated September 16, 1998.
 - 8.) Zoning and setback information as provided by the Planning Department of the City of Bloomington:
 5715 West Old Shakopee Road is zoned IP (Industrial Park), R-1(PD) - Single Family Residential (Planned Development) and IP(PD) - Industrial Park (Planned Development)
 The setbacks for zone IP are:
 Building:
 Front = 60 feet
 Side = 60 feet
 Rear = 25 feet
 Rear or side yard adjoining public right of way = 60 feet
 (For further information please contact the City of Bloomington Planning Department)
 - 9.) Wetlands shown hereon are per field location of stakes as set by Ulteig Engineering in 1996.
 - 10.) The record plat of WORLD WIDE 2ND ADDITION was filed as Doc. No. 2733667 (T) and 6622621 (A).
 - 12.) Current address of property: 5715 West Old Shakopee Road.
 - 13.) All improvements shown hereon are per site plat received from Alliant Engineering on April 24, 2000.


PROPERTY DESCRIPTION
 (Per First American Title Insurance Company Commitment File No. 59-6168C, commitment date, January 12, 2000.)

Parcel 1:
 Lot 2, Block 1, WORLD WIDE 2ND ADDITION, Hennepin County, Minnesota.
 A portion of said land is registered land and is described as follows:
 That part of Lot 2, Block 1, WORLD WIDE 2ND ADDITION, embraced within Outlot A, WORLD WIDE ADDITION.

Parcel 2:
 Non-exclusive appurtenant driveway easement for vehicular and pedestrian ingress and egress purposes over and across a portion of Lot 1, Block 1, WORLD WIDE 2ND ADDITION, as set forth in Lyndate Terminal Co., Driveway and Drainage Easement Agreement (Bloomington, Minnesota) dated August 8, 1996, filed August 13, 1996, as Document Number 2733671, Office of Registrar of Titles, and filed September 10, 1996, as Document Number 6632084, Office of County Recorder, Hennepin County, Minnesota.

Parcel 3:
 That part of West 110th Street as dedicated on WORLD WIDE 2ND ADDITION, according to the recorded plat thereof, Hennepin County, Minnesota, described as lying easterly of the southerly extension of the most northerly west line of Lot 2, Block 2, said WORLD WIDE 2ND ADDITION.

AREAS	OWNER & APPLICANT
LOT 1: 81,874 Sq. Ft. - 1.880 Acres	WEST BLOOMINGTON TECHNOLOGY PARK, LLC. 7808 Creekridge Circle Suite 305 Bloomington, MN 55439 Attn: Stephen Michals Tel: (952) 941-1383 Fax: (952) 941-1560
LOT 2: 64,222 Sq. Ft. - 1.474 Acres	
LOT 3: 64,222 Sq. Ft. - 1.474 Acres	
LOT 4: 107,620 Sq. Ft. - 2.471 Acres	
LOT 5: 394,736 Sq. Ft. - 9.062 Acres	
LOT 6: 507,948 Sq. Ft. - 11.660 Acres	
TOTAL: 220,622 Sq. Ft. - 28.021 Acres	

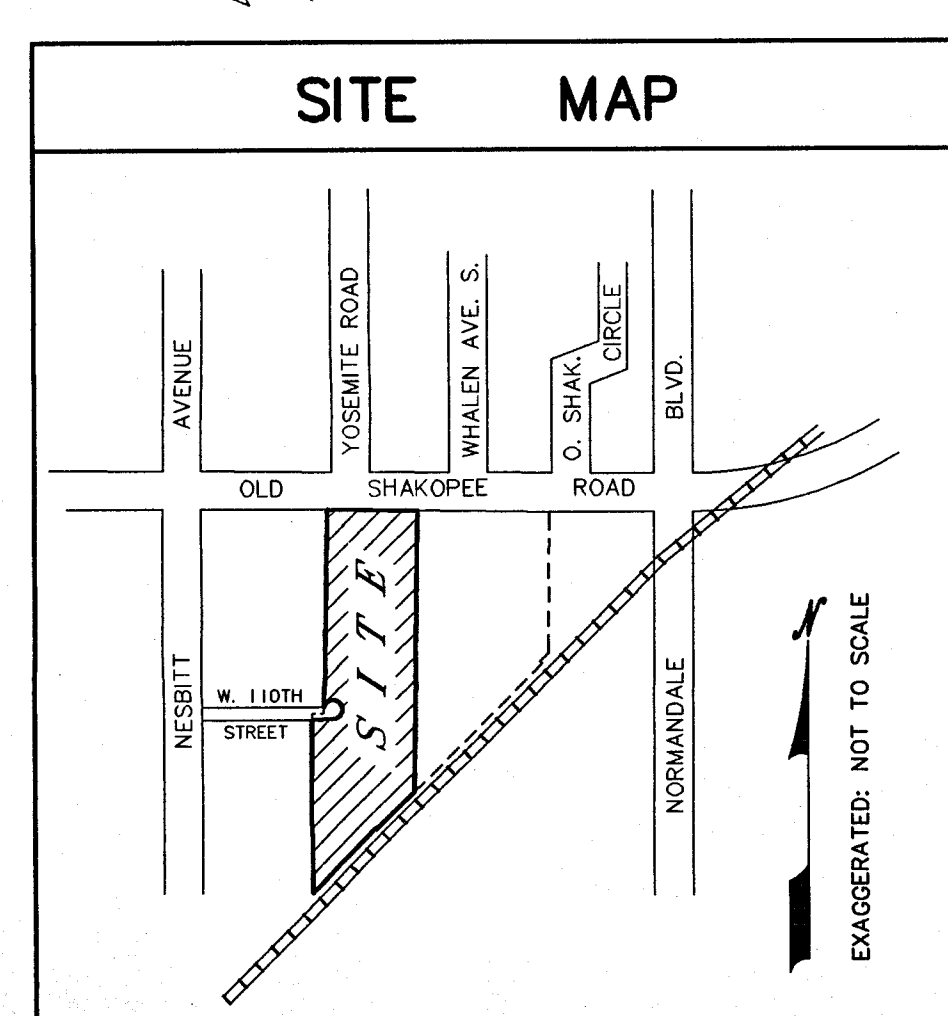

- LEGEND**
- (A) Denotes Abstract
 - CB Denotes catch basin
 - FH Denotes fire hookup
 - HD Denotes hydrant
 - LP Denotes light pole
 - PIV Denotes post indicator valve
 - SAN Denotes sanitary manhole
 - SAN S Denotes sanitary sewer
 - SB Denotes soil boring
 - SMH Denotes storm manhole
 - SS Denotes storm sewer
 - (T) Denotes Torrens
 - US ELEC Denotes underground electric
 - US TELE Denotes underground telephone
 - WV Denotes water valve
 - CRAB Denotes Crabapple tree
 - COT Denotes Cottonwood tree
 - MPL Denotes Maple tree
 - TR Denotes deciduous tree
 - C Denotes 4" Colorado Blue Spruce tree (unless otherwise noted)

We hereby certify that this is a true and correct representation of a survey of the boundaries of the land above described and of the location of all buildings, if any, from or on said land.


Dated this 8th day of August, 2000

SUNDE LAND SURVEYING, LLC.
 By: *Scott J. Soukup*
 Scott J. Soukup, R.L.S., Minn. Reg. No. 17256

Survey originally dated May 15, 1996
 REVISED: July 25, 1996 (Updated title commitment)
 REVISED: February 18, 2000 (Update and recertify)
 REVISED: March 31, 2000 (preliminary plat)
 REVISED: April 25, 2000 (New building footprints and location)
 REVISED: August 8, 2000 (new lot configuration)

Sunde Land Surveying, LLC.
 9001 East Bloomington Freeway (35W) • Suite 118
 Bloomington, Minnesota 55420-3435
 Business: 612/881-2455 • FAX: 612/888-9526

4999 G 00

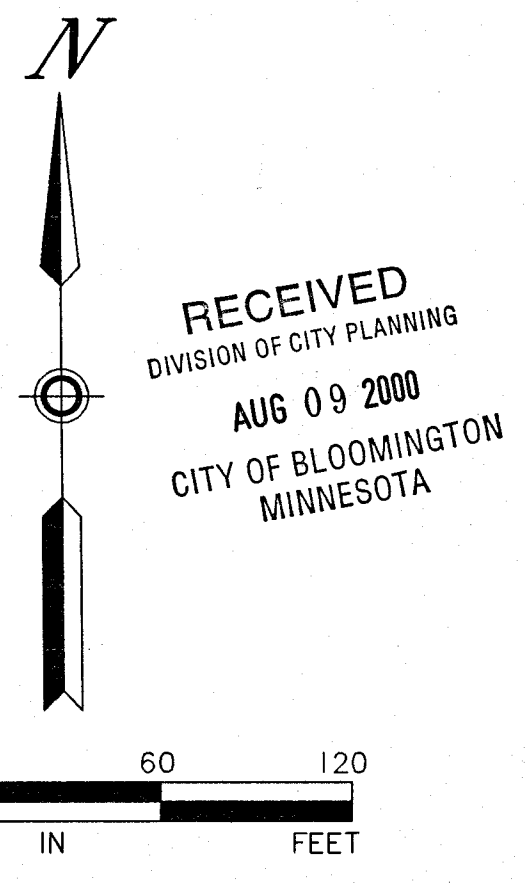

RECEIVED
 DIVISION OF CITY PLANNING
 AUG 09 2000
 CITY OF BLOOMINGTON
 MINNESOTA